

Symbol	Description	Date	Approved

Points represent shallowest depth value shown from 40-foot grid.
Map Document Grid U. 1000 x 1000

U.S. ARMY ENGINEER DISTRICT CORPS OF ENGINEERS	Designed By:	Date: 5/1/2015
	Drawn By:	File No:
	Checked By:	U.S.O. Sheet File Name:
	Reviewed By:	Specification Number:




Sheet
Reference
Number
1 of 1

NOTES:
 Survey Date: April 28, 2015
 Conducted by: Matt M, Lee S, Steve B

 Survey Vessel: MV Hinds
 Flat Pool: 603
 Water Surface: 606.2
 Stage: +3.2
 Upstream Gage: Lock 10 Tail RM 615.1
 Downstream Gage: Waupeton RM 599.9


Horizontal Projection: State Plane, NAD 1983
 Illinois West - 1202, U.S. Survey Feet
 Vertical Datum: MSL 1912 U.S. Survey Feet.
 Imagery: 2014 USDA NAIP

The information depicted on this map represents the results of a survey conducted on the date indicated and can only be considered to represent the general condition existing at that time.

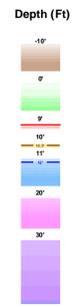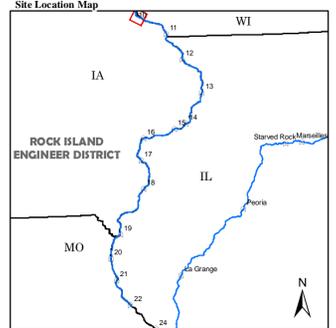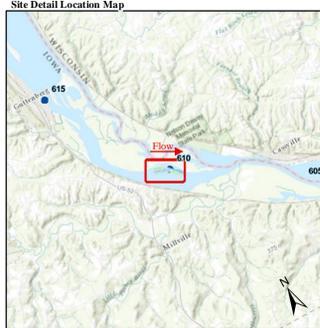


- River Mile**
 - Mile: Pink circle
 - Tenth: Blue circle
- River Features**
 - Wing Dam Location: Red line
- Lights**
 - Green: Green circle
 - Red: Red circle
 - White: White circle
 - Yellow: Yellow circle

- Daybeacon**
 - NR: Rhombus, Red and White
 - NG: Rhombus, Green and White
 - SG: Square, Green
 - TR: Triangle, Red
- Lateral Buoys**
 - Green: Green diamond
 - Red: Red diamond

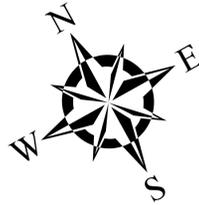

**US ARMY CORPS OF ENGINEERS
 ROCK ISLAND DISTRICT
 CEMVR - OD-T
 WATERWAY: UPPER MISSISSIPPI RIVER
 POOL: 11
 REACH: Island 189
 REACH MILES: 609.5 to 610.7
 SURVEY TYPE: CONDITION**

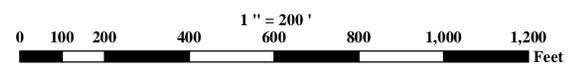

SURVEYED RIVER MILES: 609.5-610.5

UPSTREAM

DOWNSTREAM