




Symbol	Description	Date	Approved

Designed By:	Date: 4/28/2015
Drawn By:	File No:
Checked By:	I.S.O. Sheet File Name:
Reviewed By:	Specification Number:

Sheet Reference Number
1 of 1



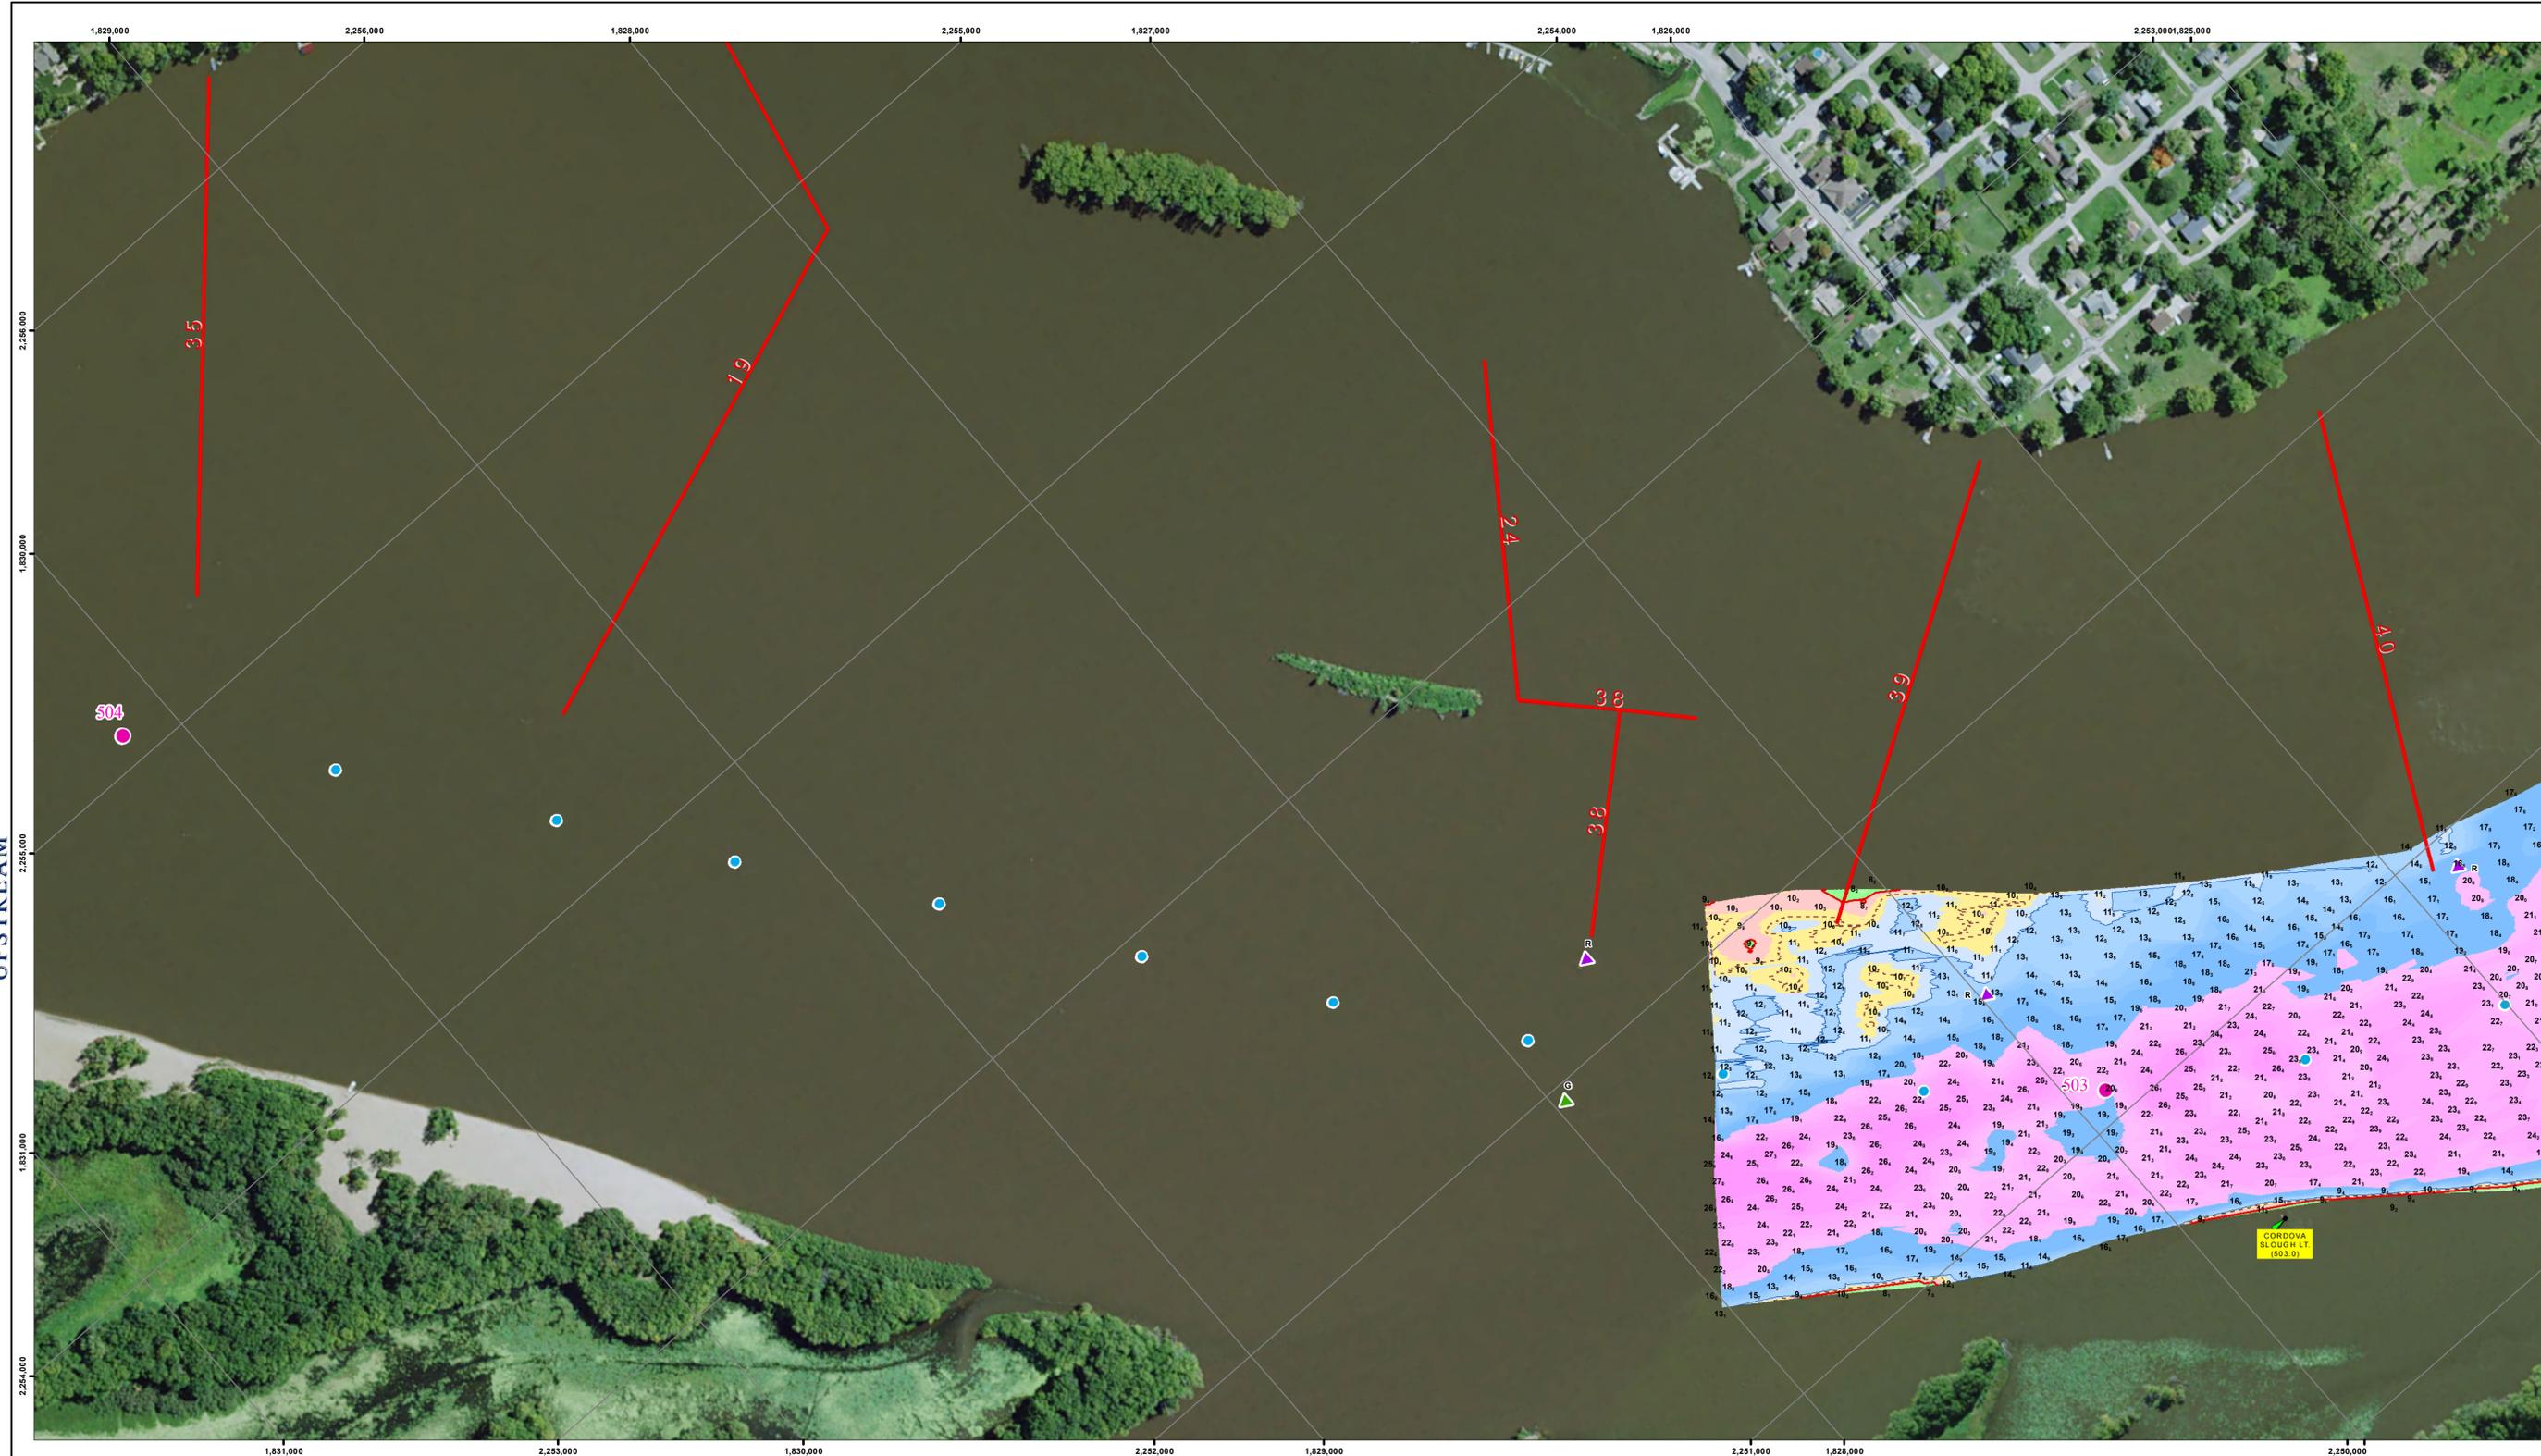


NOTES:
 Survey Date: April 27, 2015
 Conducted by: Cory B, Rick A

 Survey Vessel: Launch Coot
 Flat Pool: 572
 Water Surface: 572.8
 Stage: +0.8
 Upstream Gage: Camanche RM 511.8
 Downstream Gage: Lock 14 Pool RM 493.3

Horizontal Projection: State Plane, NAD 1983
 Illinois West - 1202, U.S. Survey Feet
 Vertical Datum: MSL 1912 U.S. Survey Feet.
 Imagery: 2014 USDA NAIP

The information depicted on this map represents the results of a survey conducted on the date indicated and can only be considered to represent the general condition existing at that time.

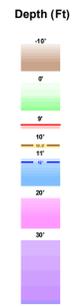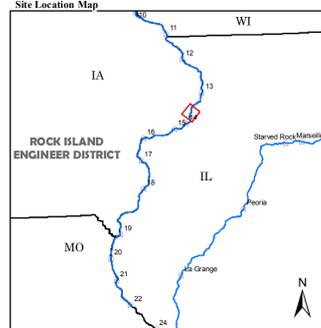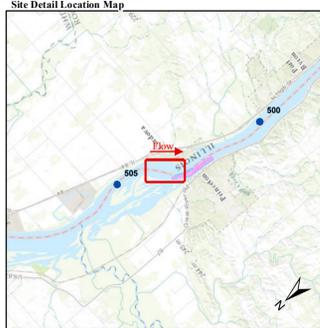


- River Mile**
 - Mile: Pink circle
 - Tenth: Blue circle
- River Features**
 - Wing Dam Location: Red line
- Lights**
 - Green: Green circle
 - Red: Red circle
 - White: White circle
 - Yellow: Yellow circle

- Daybeacon**
 - NR: Rhombus, Red and White
 - NG: Rhombus, Green and White
 - SG: Square, Green
 - TR: Triangle, Red
- Lateral Buoys**
 - Green: Green diamond
 - Red: Red diamond



US ARMY CORPS OF ENGINEERS
 ROCK ISLAND DISTRICT
 CEMVR - OD-T
 WATERWAY: UPPER MISSISSIPPI RIVER
 POOL: 14
 REACH: Cordova to Steamboat
 REACH MILES: 502.8 to 504
 SURVEY TYPE: CONDITION

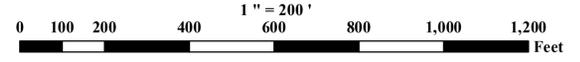

SURVEYED RIVER MILES: 501.8-503.2

UPSTREAM

DOWNSTREAM

