

ILLINOIS WATERWAY  
RIVER MILES 124-128

**LAKE CHAUTAUQUA  
REHABILITATION AND ENHANCEMENT**

MASON COUNTY, ILLINOIS

U.S. ARMY CORPS OF ENGINEERS  
UPPER MISSISSIPPI RIVER SYSTEM  
ENVIRONMENTAL MANAGEMENT PROGRAM

---

**OPERATION AND MAINTENANCE MANUAL**

**AS-BUILT DRAWINGS**

APRIL 2005

---



**US Army Corps  
of Engineers**  
Rock Island District



THIS PROJECT WAS DESIGNED BY THE ROCK ISLAND DISTRICT OF THE U.S. ARMY CORPS OF ENGINEERS. THE INITIALS OF THE DESIGNER AND THE DATE OF THE DESIGN ARE SHOWN IN THE TOP RIGHT CORNER OF THIS SHEET. THE INITIALS OF THE CHECKER AND THE DATE OF THE CHECK ARE SHOWN IN THE TOP LEFT CORNER OF THIS SHEET. THE INITIALS OF THE REVIEWER AND THE DATE OF THE REVIEW ARE SHOWN IN THE TOP CENTER OF THIS SHEET. THE INITIALS OF THE APPROVER AND THE DATE OF THE APPROVAL ARE SHOWN IN THE TOP RIGHT CORNER OF THIS SHEET. THE INITIALS OF THE DESIGNED BY AND THE DATE OF THE DESIGN ARE SHOWN IN THE TOP LEFT CORNER OF THIS SHEET. THE INITIALS OF THE CHECKED BY AND THE DATE OF THE CHECK ARE SHOWN IN THE TOP CENTER OF THIS SHEET. THE INITIALS OF THE REVIEWED BY AND THE DATE OF THE REVIEW ARE SHOWN IN THE TOP RIGHT CORNER OF THIS SHEET. THE INITIALS OF THE APPROVED BY AND THE DATE OF THE APPROVAL ARE SHOWN IN THE TOP LEFT CORNER OF THIS SHEET.

| Symbol | Description | Date   | Appr. |
|--------|-------------|--------|-------|
| 1      | Design      | 2/3/97 |       |
| 2      | Check       | 2/3/97 |       |
| 3      | Review      | 2/3/97 |       |
| 4      | Approve     | 2/3/97 |       |

| U.S. Army Engineer District | Rock Island District | Date     | Scale    | Sheet        | Revision     | Drawn | Checked | Reviewed | Appr. |
|-----------------------------|----------------------|----------|----------|--------------|--------------|-------|---------|----------|-------|
| U.S. Army Engineer District | Rock Island District | MAR 1999 | AS SHOWN | 1-L-1-3-1/67 | 1-L-1-3-1/67 | JJC   | JJC     | JJC      | JJC   |

ILLINOIS WATERWAY  
ENVIRONMENTAL MANAGEMENT PROGRAM  
LA GRANGE POOL, MILE 124 TO 129.5  
LAKE CHAUTAUQUA  
OPERATIONS AND MAINTENANCE  
COVER SHEET

Sheet  
Reference  
Number:  
**X10**  
Sheet 1 of 84

AS OF 4/10/01

ILLINOIS WATERWAY  
ENVIRONMENTAL MANAGEMENT PROGRAM  
LA GRANGE POOL, RIVER MILE 124 - 129.5  
LAKE CHAUTAUQUA  
AS-BUILTS



# GENERAL NOTES

- THE SCOPE OF WORK GENERALLY CONSISTS OF FOLLOWING:
  - CONSTRUCT NEW STOPLOG WATER CONTROL STRUCTURE IN LOWER LAKE.
  - CONSTRUCT ACCESS ROAD, BOAT RAMP, AND PARKING AREA.
  - REPAIR AND RAISE CROSS DIKE.
  - REPAIR AND RAISE UPPER LAKE PERIMETER LEVEE.
  - CONSTRUCT NEW SHEET PILE CELLULAR WATER CONTROL STRUCTURE WITH THREE 10 FT X 10 FT SLUICE GATES.
  - INSTALL 41,000 GPM ELECTRICAL PUMP STATION.
  - EXCAVATE DRAINAGE CHANNELS IN LOWER LAKE.
  - CHANNEL EXCAVATION TO PUMP STATION.
  - CONSTRUCT A RIPRAP CLOSURE STRUCTURE.
  - CONSTRUCT LOWER LAKE DRAINAGE CHANNEL AND SPOIL BERM FROM STATION 2+000 TO STATION 188+000.
  - SHAPE AND PLACE APPROXIMATELY 400 TONS OF BEDDING AND 750 TONS OF RIPRAP.
- THE LAYOUT OF PROJECT FEATURES AS SHOWN SHALL BE FIELD STAKED BY CONTRACTOR AND APPROVED BY THE CONTRACTING OFFICER REPRESENTATIVE (COR). COR MAY MAKE MINOR ALIGNMENT CHANGES.
- CONSTRUCTION IS RESTRICTED BY HIGH AND/OR LOW WATER LEVELS. ACCESS SHALL BE ASCERTAINED BY THE BIDDER DURING ADVERTISEMENT.
- THE CONTRACTOR SHOULD SCHEDULE ITS WORK TO COINCIDE WITH SUMMER AND EARLY FALL DRAIN-DOWN PERIODS. THE DRAIN-DOWN PERIOD IS FROM JUNE 1 TO OCTOBER 15. HOWEVER, HIGH RIVER LEVELS CAN PREVENT THE USFWS FROM DEWATERING THE LAKE. THE GOVERNMENT HAS NO RESPONSIBILITY TO OPERATE THE PUMP AT ITS EXPENSE. SEE SPECIFICATIONS.
- NATURAL SPRINGS ADD WATER TO UPPER AND LOWER LAKE.
- CONTOUR LINES ARE COMPUTER GENERATED. CONTRACTOR MAY FIND DEVIATIONS FROM ACTUAL CONDITIONS.

1:355,000 N

1:350,000 N

1:345,000 N

## SITE PLAN

1000 500 0 1000 2000 FT  
SCALE: 1" = 1000'



| Symbol | Description         | Revisions |
|--------|---------------------|-----------|
| AS     | AS CONSTRUCTED      |           |
| MD     | MD - MINOR REVISION |           |
| AP     | APPROVED            |           |
| DATE   | DATE                |           |

|             |              |                     |                  |
|-------------|--------------|---------------------|------------------|
| DESIGNED BY | DRC          | DATE                | MAR 1999         |
| DRAWN BY    | AS SHOWN     | SCALE               | AS SHOWN         |
| CHECKED BY  | 1-L-1-3-1/67 | DRAWING CODE        | 1-L-1-3-1/67     |
| REVIEWED BY | JUC          | SOLICITATION NUMBER | DACW25-97-B-0032 |

|                                                                           |
|---------------------------------------------------------------------------|
| U.S. ARMY ENGINEER DISTRICT<br>CORPS OF ENGINEERS<br>ROCK ISLAND DISTRICT |
|---------------------------------------------------------------------------|

|                                                                                                                                                       |
|-------------------------------------------------------------------------------------------------------------------------------------------------------|
| ILLINOIS WATERWAY<br>ENVIRONMENTAL MANAGEMENT PROGRAM<br>LA GRANGE POOL, MILE 124 TO 129.5<br>LA GRANGE LAKE CHAUTAUQUA<br>OPERATIONS AND MAINTENANCE |
|-------------------------------------------------------------------------------------------------------------------------------------------------------|

|                                                              |
|--------------------------------------------------------------|
| SHEET<br>REFERENCE<br>NUMBER:<br><b>X30</b><br>Sheet 3 of 84 |
|--------------------------------------------------------------|

CELLULAR WATER CONTROL  
STRUCTURE. SEE SHEETS  
C90, C100, S10 - S120.

RIPRAP PLACEMENT FOR  
FLOOD PROTECTION  
(PERFORMED THROUGH JOB  
ORDER CONTRACT)  
SEE C180 AND C190

1:355,000 N  
HORIZONTAL CONTROL POINTS  
SEE C10-C40 AND C70 FOR TIE OFFS

CONSTRUCT NEW LIVERPOOL  
CLOSURE STRUCTURE. SEE C160

LIVERPOOL DITCH  
EXCAVATION  
SEE SHEET C150

## UPPER LAKE CHAUTAUQUA

STAGE I  
CONTRACT - DACW25-92-C-0079  
CONTRACTOR - D&M EARTHMOVING  
PLYMOUTH, IL

STAGE II  
CONTRACT - DACW25-97-C-0036  
CONTRACTOR - HILLIER INC.  
MACOMB, IL

STAGE III  
CONTRACT - DACA25-00-D-0001-004  
JOB ORDER CONTRACT  
CONTRACTOR - DEL-JEN INC.  
MOLINE, IL

STAGE IV  
CONTRACT - DACW25-01-C-0013  
CONTRACTOR - RJS CONSTRUCTORS, INC.  
PEORIA, IL

NOTE: USFWS PLACED RIPRAP ON THE  
LANDSIDE OF THE ENTIRE  
NORTHERN PERIMETER LEVEE.

BENCH MARK Z-238 STANDARD CAP, TOP OF CONCRETE POST AT  
SOUTH EDGE OF GOOFY RIDGE 329' WEST OF SE CORNER, CORNER  
SECTION 36. EL. 476.09

HORIZONTAL TRAVERSE CONTROL POSITION C.L. #12.5" PIN  
WITH BRASS CAP 1,350,718.597 N, 553,241.932 E. C.L. #13.5" PIN  
WITH BRASS CAP 1,350,164.111 N, 552,765.884 E.

CHISELED "X": TOP CENTER OF PUMP STATION  
1,354,198.19 N, 549,572.51 E

CHISELED "□": TOP SE CORNER OF PUMP STATION EL. 450.80

CHISELED "□": WEST END, NORTH ABUTMENT BRIDGE AT IL  
NATURAL HISTORY SURVEY EL. 448.78 FT.



## LOWER LAKE NOTES

- THE USFWS CONSTRUCTED THE LOWER LAKE  
LEVEE AND THE 2 OVERFLOW STRUCTURES.  
SEE SHEETS F180 AND F260.
- THE LEVEE PROFILE WAS COMPLETED  
WITH GPS SURVEY EQUIPMENT IN AUGUST 2000.
- CENTERLINES OF CROSSINGS FOR DEWATERING CHANNEL  
#1 60+74E  
#2 99+43E  
#3 132+99E  
#4 151+20E  
EXTRA DITCH TO LOW SPOT - 151+20E
- THE LOWER LAKE OVERFLOW STRUCTURE CREST  
(LEVEE HEIGHT) IS AT ELEVATION 441.2 FT. FLAT  
POOL IS AT ELEVATION 429.4 FT. THE RIVER SELDOM  
DROPS BELOW ELEVATION 430.0 FT. SEE HYDROGRAPHS.  
THE SILL OF THE LOWER LAKE STOP LOG STRUCTURE  
IS ELEVATION 429.0 FT.







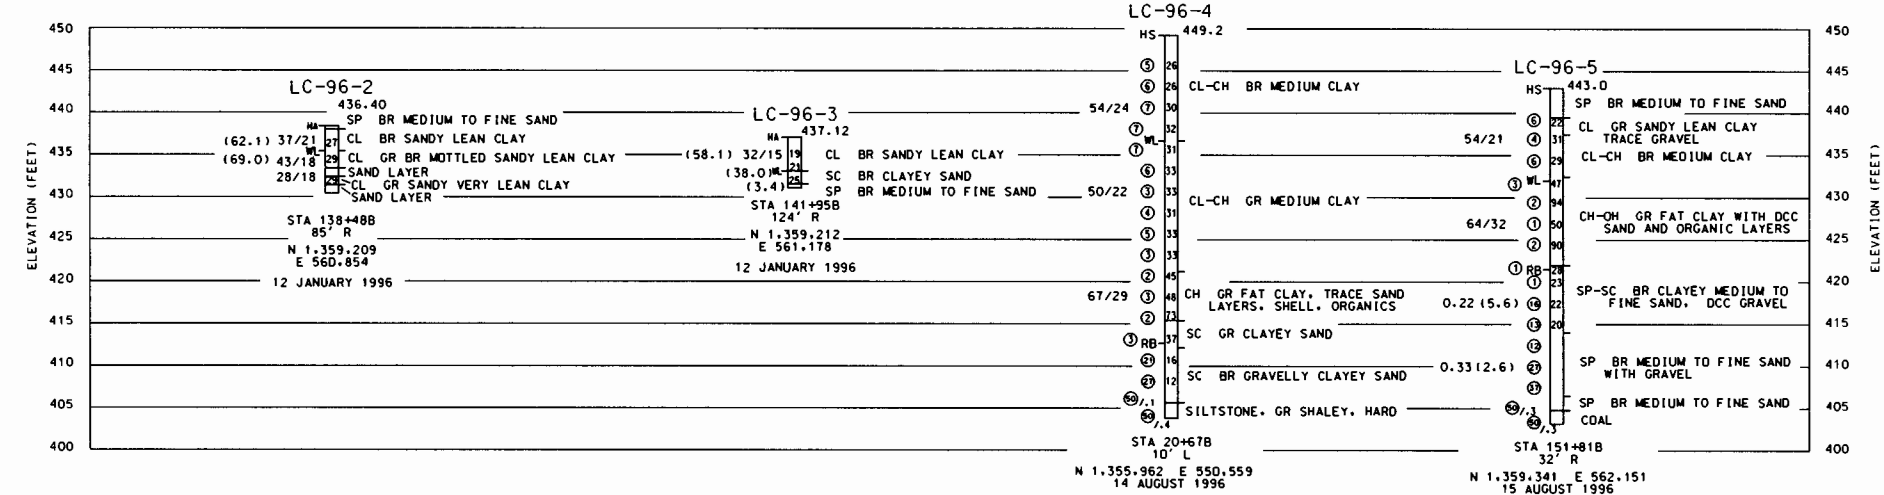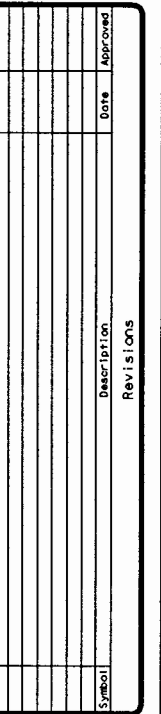

NOTE: TDP ELEVATIONS OF BDRINGS ARE APPROXIMATE.

## BORING NUMBER

SEE PLAN SHEET X30 FOR  
APPROXIMATE LOCATION OF  
BORINGS

STA AND OFFSET REFER TO STAGE I  
ALIGNMENT.



|                                                                            |               |                  |                      |                 |                                       |
|----------------------------------------------------------------------------|---------------|------------------|----------------------|-----------------|---------------------------------------|
| U.S. ARMY ENGINEER DISTRICT<br>CORPS OF ENGINEERS<br>ROCK ISLAND, ILLINOIS | Drawn By: CAB | Checked By: TGH  | Drawn Date: MAR 1999 | Scale: AS SHOWN | Drawing Code: 1-L-1-3-1/67            |
|                                                                            |               | Reviewed By: JJC |                      |                 | Solicitation Number: DACW25-97-B-0032 |

ENVIRONMENTAL MANAGEMENT PROGRAM  
LA GRANGE POOL, MILE 124 TO 129.5  
LAKE CHAUTAUQUA  
OPERATIONS AND MAINTENANCE


**BORING LOGS III**

Sheet  
Reference  
Number:  
**B30**  
Sheet 6 of 84




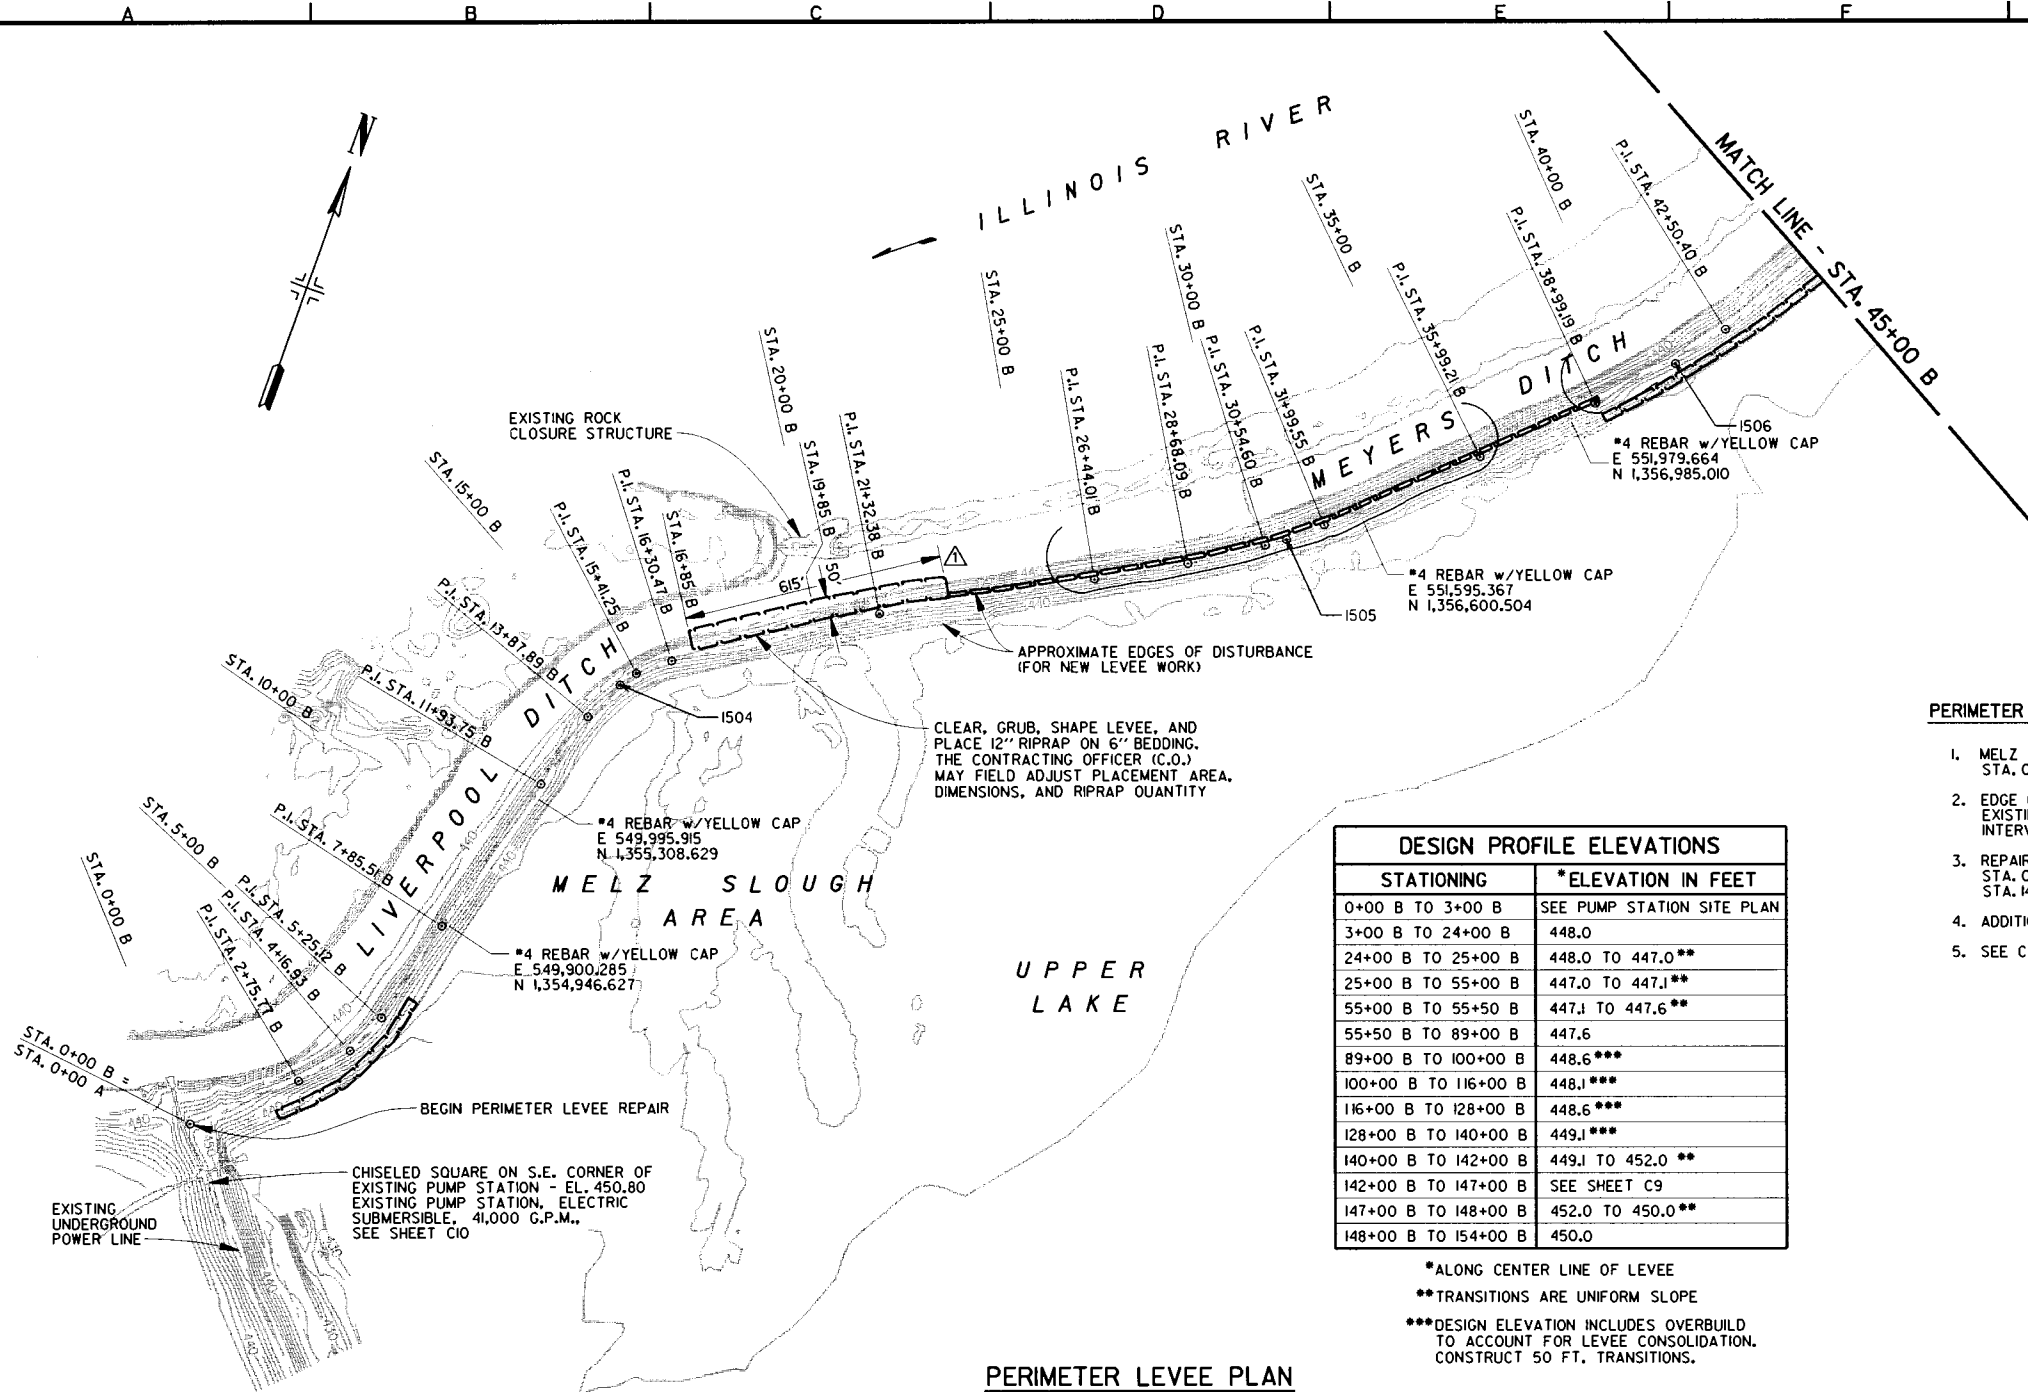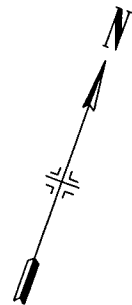


HORIZONTAL CONTROL POINT TIE OFFS  
NOTE: ALL TIES ARE MAG NAIL IN TREE  
\* 3/8" REBAR - 48" LONG W/ WHZ CAP  
(NOT TO SCALE)

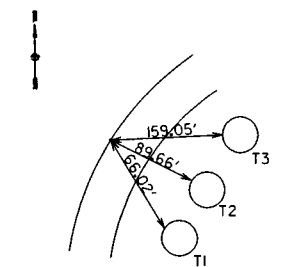

CONTROL POINT # 1504  
APPROX. STA 14+95  
E 550,102.57846 - N 1,355,628.27339

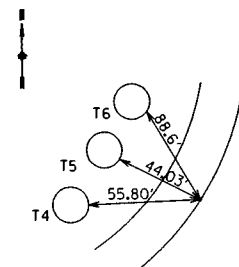


CONTROL POINT # 1505  
APPROX. STA 31+06  
E 551,456.83836 - N 1,356,480.1488

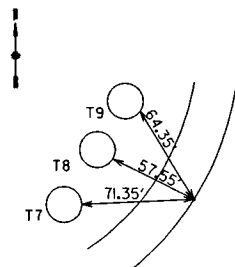

CONTROL POINT # 1506  
APPROX. STA 41+14  
E 552,169.74244 - N 1,357,177.56363

### PERIMETER LEVEE PLAN

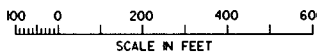


| DESIGN PROFILE ELEVATIONS |                            |
|---------------------------|----------------------------|
| STATIONING                | *ELEVATION IN FEET         |
| 0+00 B TO 3+00 B          | SEE PUMP STATION SITE PLAN |
| 3+00 B TO 24+00 B         | 448.0                      |
| 24+00 B TO 25+00 B        | 448.0 TO 447.0**           |
| 25+00 B TO 55+00 B        | 447.0 TO 447.1**           |
| 55+00 B TO 55+50 B        | 447.1 TO 447.6**           |
| 55+50 B TO 89+00 B        | 447.6                      |
| 89+00 B TO 100+00 B       | 448.6***                   |
| 100+00 B TO 116+00 B      | 448.1***                   |
| 116+00 B TO 128+00 B      | 448.6***                   |
| 128+00 B TO 140+00 B      | 449.1***                   |
| 140+00 B TO 142+00 B      | 449.1 TO 452.0**           |
| 142+00 B TO 147+00 B      | SEE SHEET C9               |
| 147+00 B TO 148+00 B      | 452.0 TO 450.0**           |
| 148+00 B TO 154+00 B      | 450.0                      |

\*ALONG CENTER LINE OF LEVEE  
\*\*TRANSITIONS ARE UNIFORM SLOPE  
\*\*\*DESIGN ELEVATION INCLUDES OVERBUILD  
TO ACCOUNT FOR LEVEE CONSOLIDATION.  
CONSTRUCT 50 FT. TRANSITIONS.

| DESIGN ALIGNMENT<br>CONTROL POINTS |                                 |
|------------------------------------|---------------------------------|
| P.I. STATION                       | COORDINATE LOCATION             |
| 0+00 B                             | E 549,501.569 - N 1,354,302.448 |
| 2+75.77 B                          | E 549,707.860 - N 1,354,485.459 |
| 4+16.93 B                          | E 549,798.025 - N 1,354,594.073 |
| 5+25.12 B                          | E 549,839.825 - N 1,354,691.255 |
| 7+85.51 B                          | E 549,901.656 - N 1,354,946.443 |
| 11+93.75 B                         | E 550,005.317 - N 1,355,341.307 |
| 13+87.89 B                         | E 550,054.454 - N 1,355,529.125 |
| 15+41.25 B                         | E 550,126.971 - N 1,355,664.251 |
| 16+30.47 B                         | E 550,195.888 - N 1,355,720.916 |
| 21+32.38 B                         | E 550,617.81 - N 1,355,992.75   |
| 26+44.01 B                         | E 551,064.853 - N 1,356,241.588 |
| 28+68.09 B                         | E 551,260.000 - N 1,356,351.724 |
| 30+54.60 B                         | E 551,416.021 - N 1,356,453.922 |
| 31+99.55 B                         | E 551,528.252 - N 1,356,545.650 |
| 35+99.21 B                         | E 551,816.858 - N 1,356,822.115 |
| 38+99.19 B                         | E 552,030.187 - N 1,357,033.018 |
| 42+50.40 B                         | E 552,256.848 - N 1,357,301.303 |

### PERIMETER LEVEE GENERAL NOTES:

- MELZ SLOUGH AREA SHALL NOT BE DISTURBED. ADJACENT BORROW BETWEEN STA. 0+00B AND STA. 40+00B IS NOT ALLOWED.
- EDGE OF DISTURBANCE MAY VARY FROM THAT SHOWN. CONTOURS SHOW GENERAL EXISTING TOPOGRAPHY. ACTUAL GROUND ELEVATIONS MAY VARY. CONTOUR INTERVAL IS 2.0 FEET.
- REPAIR PERIMETER LEVEE ALONG THE DESIGN ALIGNMENT FROM STA. 0+00B TO STA. 154+00B. CELLULAR SHEET PILE CELLS EXTEND FROM STA. 142+76.33B TO STA. 146+13.29B. SEE TYPICAL SECTIONS ON SHEET C10.
- ADDITIONAL CONTROL POINTS ARE AVAILABLE UPON REQUEST.
- SEE CROSS SECTIONS ON SHEET C120 FOR BORROW REQUIREMENTS.

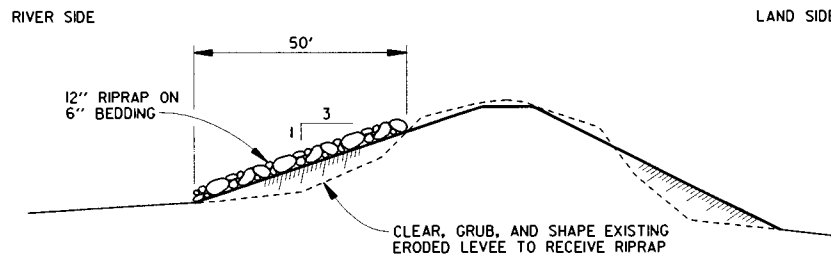

### TYPICAL RIPRAP SECTION

STA. 16+85 B TO STA. 23+00 B

NO SCALE






| DESIGN ALIGNMENT<br>CONTROL POINTS |                                 |
|------------------------------------|---------------------------------|
| P.I. STATION                       | COORDINATE LOCATION             |
| 0+00 B                             | E 549,501.569 - N 1,354,302.448 |
| 2+75.77 B                          | E 549,707.860 - N 1,354,485.459 |
| 4+16.93 B                          | E 549,798.025 - N 1,354,594.073 |
| 5+25.12 B                          | E 549,839.825 - N 1,354,691.255 |
| 7+85.51 B                          | E 549,901.656 - N 1,354,946.443 |
| 11+93.75 B                         | E 550,005.317 - N 1,355,341.307 |
| 13+87.89 B                         | E 550,054.454 - N 1,355,529.125 |
| 15+41.25 B                         | E 550,126.971 - N 1,355,664.251 |
| 16+30.47 B                         | E 550,195.888 - N 1,355,720.916 |
| 21+32.38 B                         | E 550,617.81 - N 1,355,992.75   |
| 26+44.01 B                         | E 551,064.853 - N 1,356,241.588 |
| 28+68.09 B                         | E 551,260.000 - N 1,356,351.724 |
| 30+54.60 B                         | E 551,416.021 - N 1,356,453.922 |
| 31+99.55 B                         | E 551,528.252 - N 1,356,545.650 |
| 35+99.21 B                         | E 551,816.858 - N 1,356,822.115 |
| 38+99.19 B                         | E 552,030.187 - N 1,357,033.018 |
| 42+50.40 B                         | E 552,256.848 - N 1,357,301.303 |

|                                                  |                                                                                |                                                                                                          |
|--------------------------------------------------|--------------------------------------------------------------------------------|----------------------------------------------------------------------------------------------------------|
| U.S. ARMY ENGINEER DISTRICT<br>CHICAGO, ILLINOIS | DESIGNED BY: DRC<br>DRAWN BY: RLC - CAB<br>CHECKED BY: ERK<br>REVIEWED BY: JJC | DATE: MAR 1999<br>SCALE: AS SHOWN<br>DRAWING CODE: 1-1-1-3-1/67<br>SOLICITATION NUMBER: DACW25-97-B-0032 |
|--------------------------------------------------|--------------------------------------------------------------------------------|----------------------------------------------------------------------------------------------------------|

ILLINOIS WATERWAY  
ENVIRONMENTAL MANAGEMENT PROGRAM  
LA GRANGE POOL, MILE 124 TO 129.5  
LAKE CHAUTAUQUA  
OPERATIONS AND MAINTENANCE  
PERIMETER LEVEE PLAN  
STA. 0+00 B TO  
STA. 45+00 B

Sheet  
Reference  
Number:  
**C10**  
Sheet 7 of 84



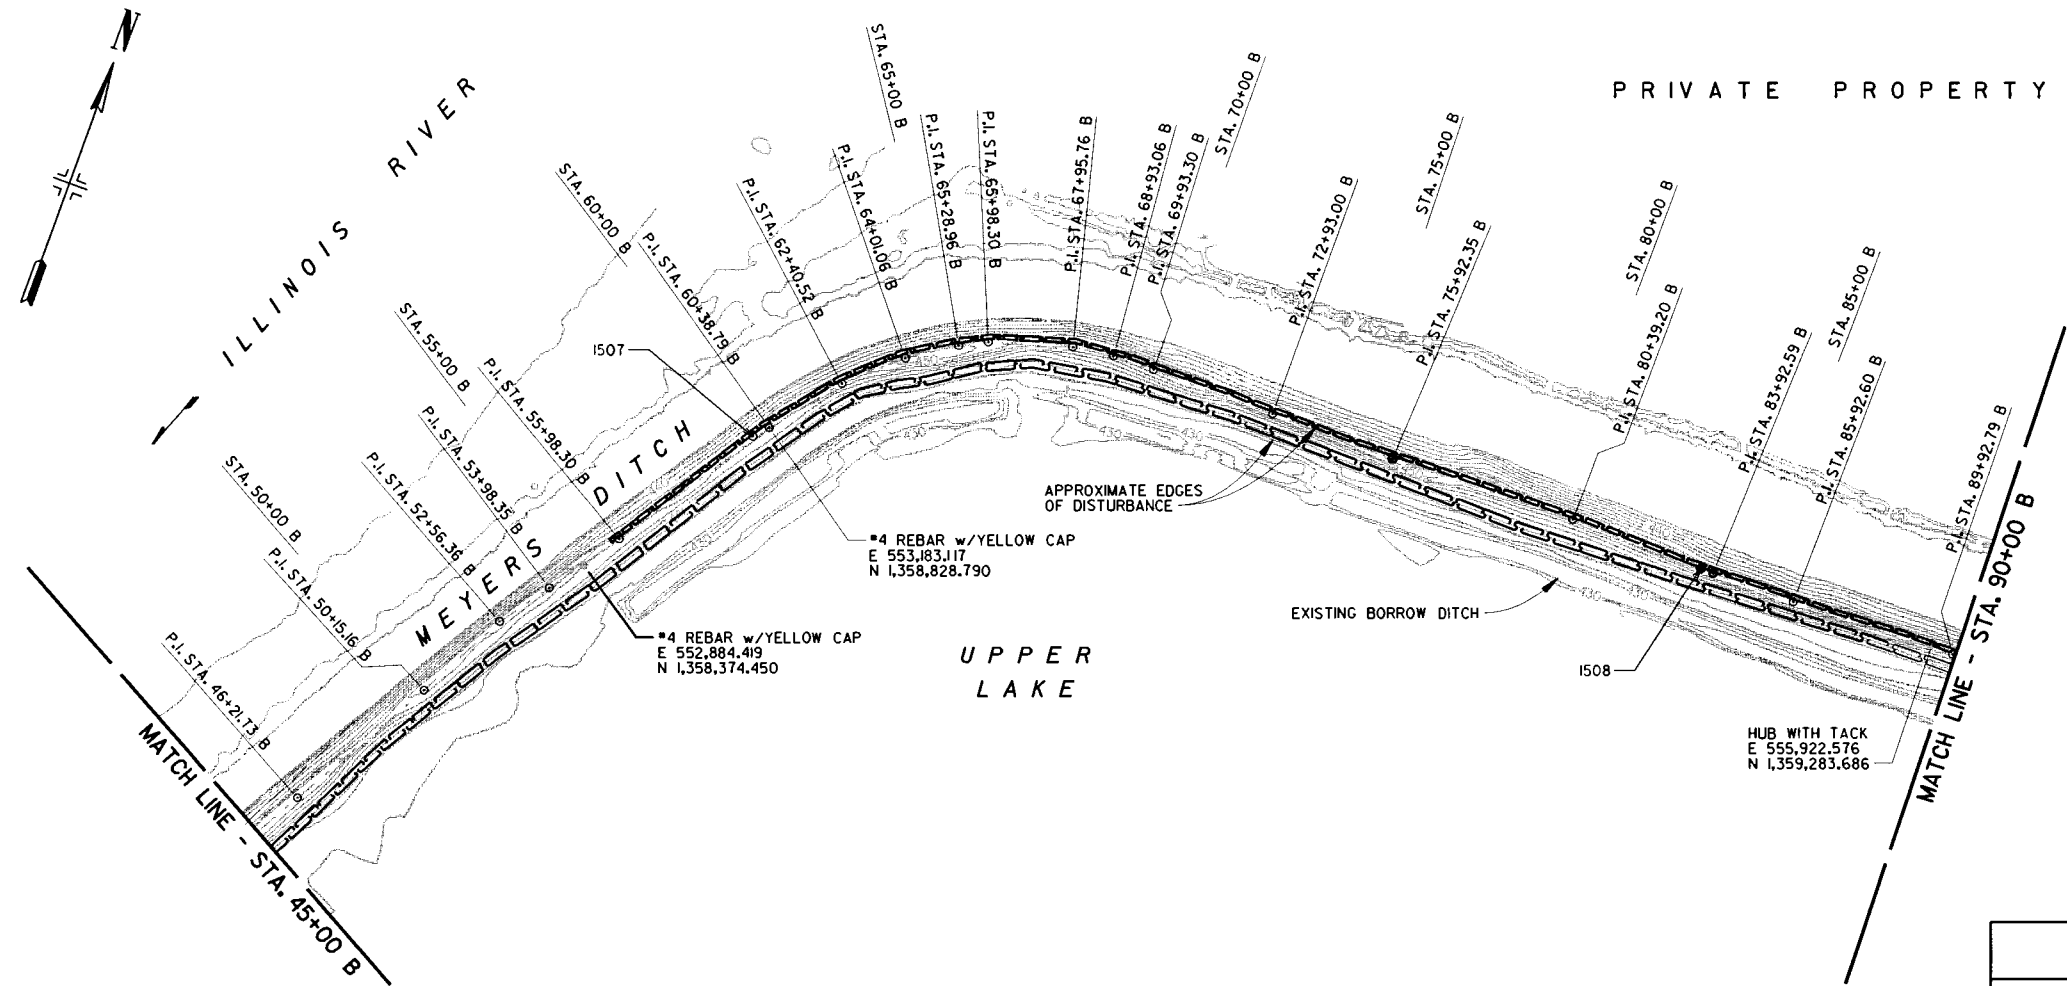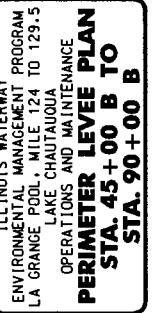
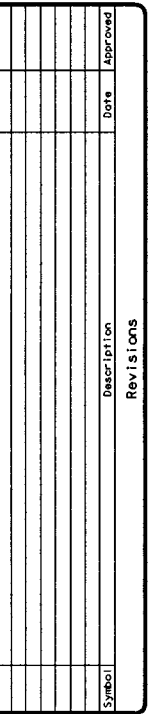


| DESIGN ALIGNMENT<br>CONTROL POINTS |                                 |
|------------------------------------|---------------------------------|
| P.I. STATION                       | COORDINATE LOCATION             |
| 46+21.73 B                         | E 552,438.807 - N 1,357,624.993 |
| 50+15.16 B                         | E 552,633.029 - N 1,357,967.139 |
| 52+56.36 B                         | E 552,744.325 - N 1,358,181.24  |
| 53+98.35 B                         | E 552,827.645 - N 1,358,296.104 |
| 55+98.30 B                         | E 552,941.317 - N 1,358,460.722 |
| 60+38.79 B                         | E 553,183.117 - N 1,358,828.790 |
| 62+40.52 B                         | E 553,309.757 - N 1,358,985.817 |
| 64+01.06 B                         | E 553,429.260 - N 1,359,093.017 |
| 65+28.96 B                         | E 553,535.812 - N 1,359,163.771 |
| 65+98.30 B                         | E 553,597.518 - N 1,359,195.399 |
| 67+95.76 B                         | E 553,786.715 - N 1,359,251.922 |
| 68+93.06 B                         | E 553,883.236 - N 1,359,264.187 |
| 69+93.30 B                         | E 553,983.459 - N 1,359,265.866 |
| 72+93.00 B                         | E 554,283.158 - N 1,359,264.787 |
| 75+92.35 B                         | E 554,582.481 - N 1,359,260.850 |
| 80+39.20 B                         | E 555,029.239 - N 1,359,270.172 |
| 83+92.59 B                         | E 555,382.593 - N 1,359,265.071 |
| 85+92.60 B                         | E 555,582.602 - N 1,359,265.345 |
| 89+92.79 B                         | E 555,982.649 - N 1,359,276.092 |


| DESIGN PROFILE ELEVATIONS |                            |
|---------------------------|----------------------------|
| STATIONING                | *ELEVATION IN FEET         |
| 0+00 B TO 3+00 B          | SEE PUMP STATION SITE PLAN |
| 3+00 B TO 24+00 B         | 448.0                      |
| 24+00 B TO 25+00 B        | 448.0 TO 447.0 **          |
| 25+00 B TO 55+00 B        | 447.0 TO 447.1 **          |
| 55+00 B TO 55+50 B        | 447.1 TO 447.6 **          |
| 55+50 B TO 89+00 B        | 447.6                      |
| 89+00 B TO 100+00 B       | 448.6 ***                  |
| 100+00 B TO 116+00 B      | 448.1 ***                  |
| 116+00 B TO 128+00 B      | 448.6 ***                  |
| 128+00 B TO 140+00 B      | 449.1 ***                  |
| 140+00 B TO 142+00 B      | 449.1 TO 452.0 **          |
| 142+00 B TO 147+00 B      | SEE SHEET C9               |
| 147+00 B TO 148+00 B      | 452.0 TO 450.0 **          |
| 148+00 B TO 154+00 B      | 450.0                      |

\*ALONG CENTER LINE OF LEVEE  
\*\*TRANSITIONS ARE UNIFORM SLOPE  
\*\*\*DESIGN ELEVATION INCLUDES OVERBUILD  
TO ACCOUNT FOR LEVEE CONSOLIDATION.  
CONSTRUCT 50 FT. TRANSITIONS.

**NOTE:**  
SEE PERIMETER LEVEE GENERAL NOTES ON SHEET C10.

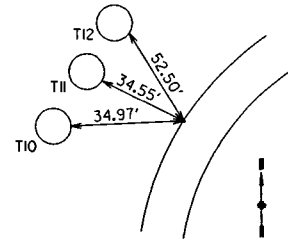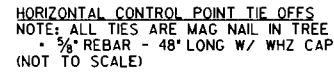


CONTROL POINT \* 1507  
APPROX. STA 59+96  
E 553,157.1443 - N 1,358,800.15935

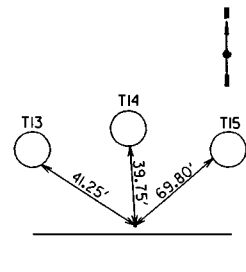


CONTROL POINT \* I508  
APPROX. STA 83+62  
E 555,053.71434 - N 1,359,276.47195


## PERIMETER LEVEE PLAN

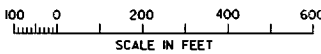




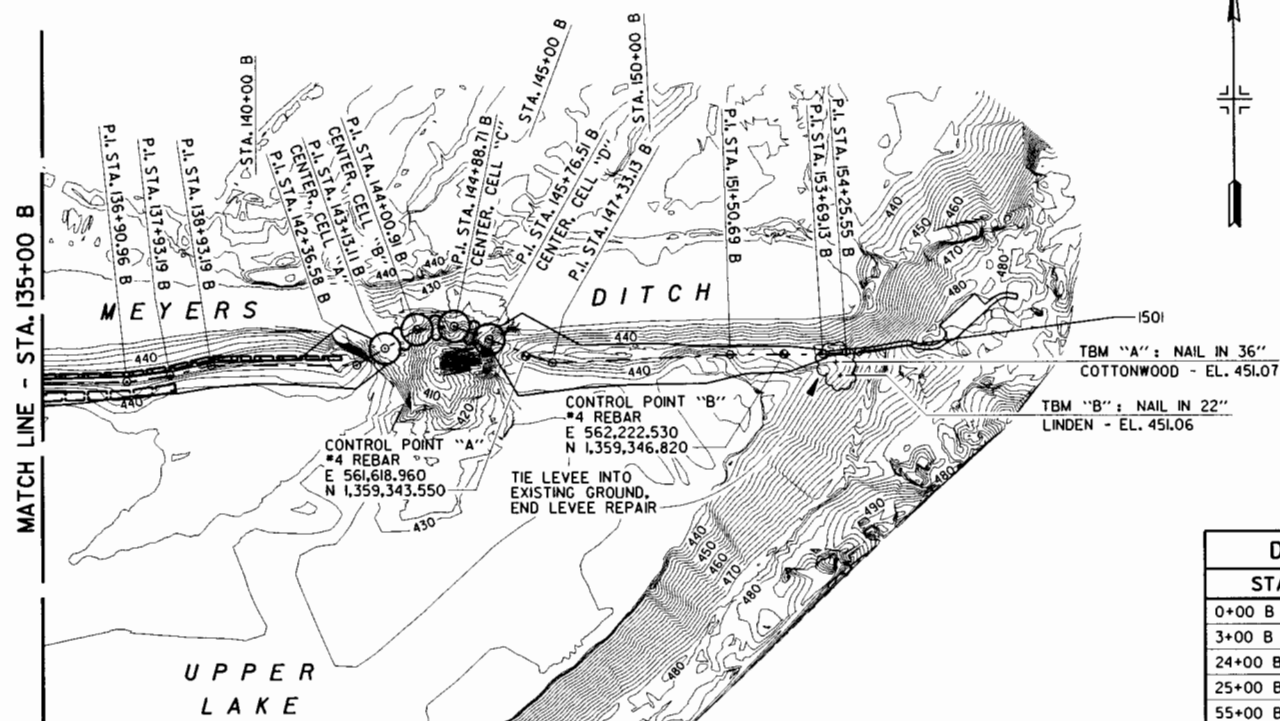

PERIMETER LEVEE PLAN

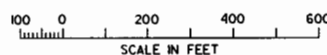

HORIZONTAL CONTROL POINT TIE OFFS  
NOTE: ALL TIES ARE MAG NAIL IN TREE  
• 5/8\"

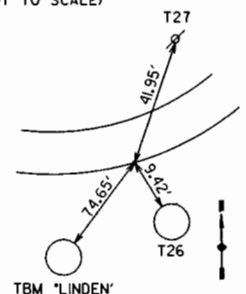


CONTROL POINT # 1501  
APPROX. STA 154+55  
E 562,400.88751 - N 1,359,332.001

| DESIGN ALIGNMENT<br>CONTROL POINTS |                                 |                  |
|------------------------------------|---------------------------------|------------------|
| P.I. STATION                       | COORDINATE LOCATION             | NOTES            |
| 136+90.96 B                        | E 560,679.921 - N 1,359,285.857 |                  |
| 137+93.19 B                        | E 560,781.124 - N 1,359,300.303 |                  |
| 138+93.19 B                        | E 560,878.434 - N 1,359,323.342 |                  |
| 142+36.58 B                        | E 561,221.824 - N 1,359,323.342 |                  |
| 143+13.11 B                        | E 561,287.670 - N 1,359,362.355 | CENTER, CELL "A" |
| 144+00.91 B                        | E 561,363.207 - N 1,359,407.110 | CENTER, CELL "B" |
| 144+88.71 B                        | E 561,450.680 - N 1,359,414.680 | CENTER, CELL "C" |
| 145+76.51 B                        | E 561,532.783 - N 1,359,383.568 | CENTER, CELL "D" |
| 147+33.13 B                        | E 561,679.233 - N 1,359,328.063 |                  |
| 151+50.69 B                        | E 562,096.390 - N 1,359,346.376 |                  |
| 153+69.16 B                        | E 562,314.863 - N 1,359,347.253 |                  |
| 154+25.55 B                        | E 562,371.007 - N 1,359,352.478 |                  |

| DESIGN PROFILE ELEVATIONS |                            |
|---------------------------|----------------------------|
| STATIONING                | *ELEVATION IN FEET         |
| 0+00 B TO 3+00 B          | SEE PUMP STATION SITE PLAN |
| 3+00 B TO 24+00 B         | 448.0                      |
| 24+00 B TO 25+00 B        | 448.0 TO 447.0 **          |
| 25+00 B TO 55+00 B        | 447.0 TO 447.1 **          |
| 55+00 B TO 55+50 B        | 447.1 TO 447.6 **          |
| 55+50 B TO 89+00 B        | 447.6                      |
| 89+00 B TO 100+00 B       | 448.6 ***                  |
| 100+00 B TO 116+00 B      | 448.1 ***                  |
| 116+00 B TO 128+00 B      | 448.6 ***                  |
| 128+00 B TO 140+00 B      | 449.1 ***                  |
| 140+00 B TO 142+00 B      | 449.1 TO 452.0 **          |
| 142+00 B TO 147+00 B      | SEE SHEET C9               |
| 147+00 B TO 148+00 B      | 452.0 TO 450.0 **          |
| 148+00 B TO 154+00 B      | 450.0                      |

\*ALONG CENTER LINE OF LEVEE  
\*\*TRANSITIONS ARE UNIFORM SLOPE  
\*\*\*DESIGN ELEVATION INCLUDES OVERBUILD  
TO ACCOUNT FOR LEVEE CONSOLIDATION.  
CONSTRUCT 50 FT. TRANSITIONS.

NOTE:  
SEE PERIMETER LEVEE GENERAL NOTES ON SHEET C10.

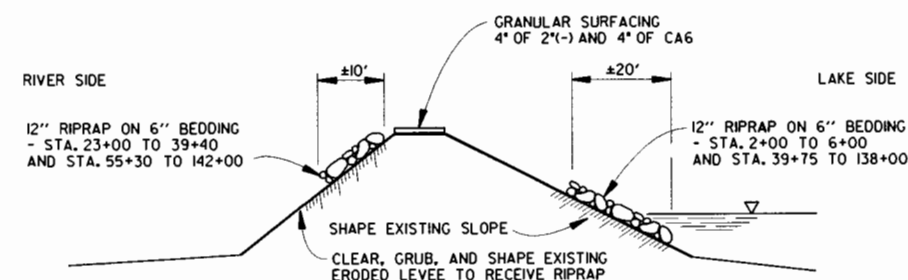


TYPICAL RIPRAP SECTION  
USFWS PROJECT

NO SCALE

|                                                                            |                                                                                |                                                                                                           |
|----------------------------------------------------------------------------|--------------------------------------------------------------------------------|-----------------------------------------------------------------------------------------------------------|
| U.S. ARMY ENGINEER DISTRICT<br>CORPS OF ENGINEERS<br>ROCK ISLAND, ILLINOIS | Designed By: DRC<br>Drawn By: RLC - CAB<br>Checked By: ERK<br>Reviewed By: JJC | Date: MAR 1999<br>Scale: AS SHOWN<br>Drawing Code: 1-L-1-3-1/67<br>Specification Number: DACN25-97-B-0032 |
|----------------------------------------------------------------------------|--------------------------------------------------------------------------------|-----------------------------------------------------------------------------------------------------------|

ILLINOIS WATERWAY  
ENVIRONMENTAL MANAGEMENT PROGRAM  
LA GRANGE POOL - MILE 124 TO 129.5  
LAKE CHAUTAUQUA  
OPERATIONS AND MAINTENANCE  
PERIMETER LEVEE PLAN  
STA. 135+00 B TO  
STA. 154+10.67 B

Sheet  
Reference  
Number:  
**C40**  
Sheet 10 of 84

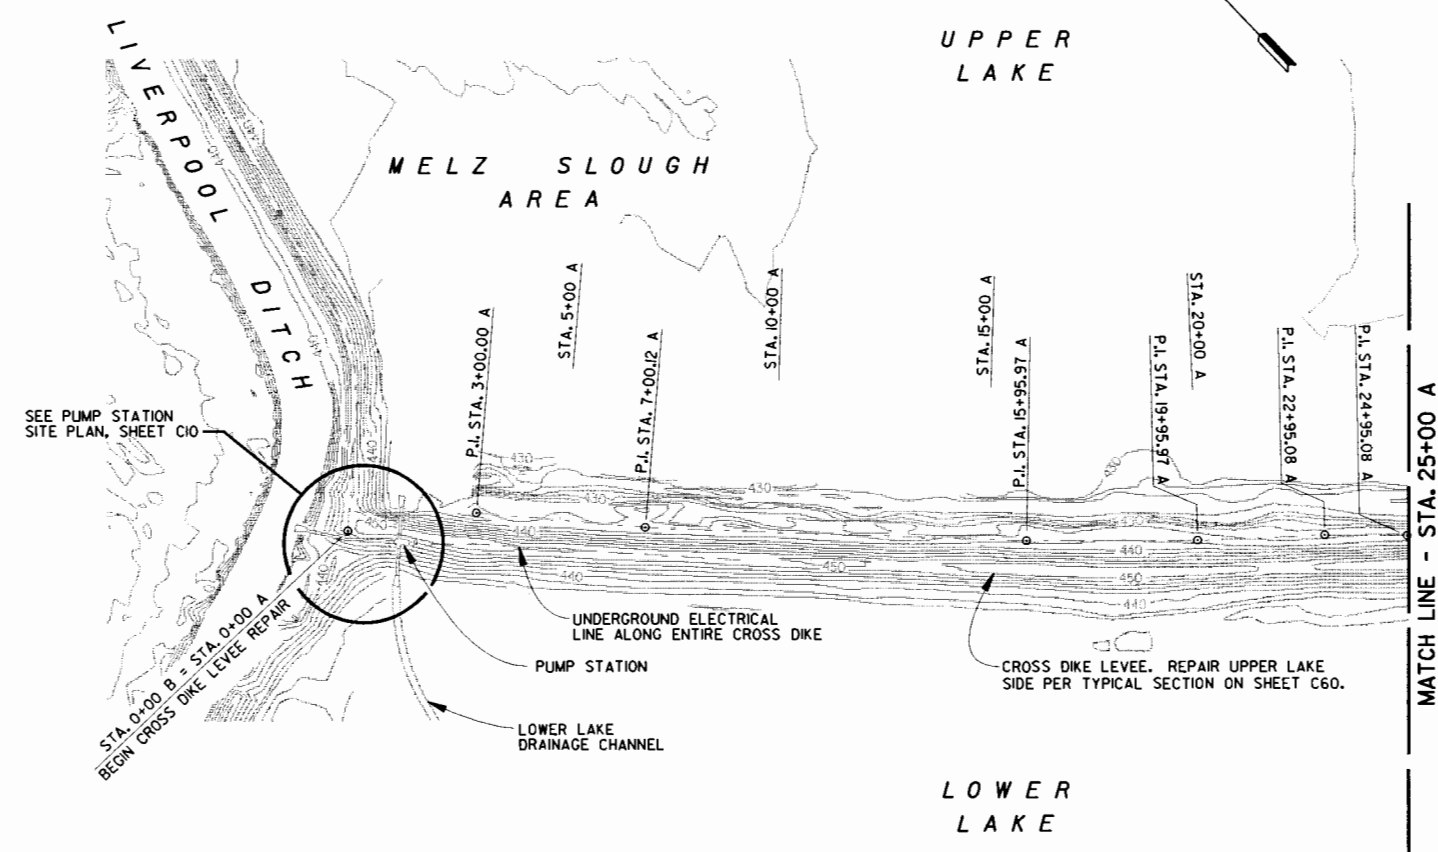

| DESIGN ALIGNMENT<br>TOE OF UPPER LAKE LEVEE SLOPE |                                 |
|---------------------------------------------------|---------------------------------|
| P.I. STATION                                      | COORDINATE LOCATION             |
| 3+00.00 A                                         | E 549,750.787 - N 1,354,124.583 |
| 7+00.12 A                                         | E 550,016.181 - N 1,353,825.147 |
| 15+95.97 A                                        | E 550,642.949 - N 1,353,185.058 |
| 19+95.97 A                                        | E 550,933.754 - N 1,352,910.408 |
| 22+95.08 A                                        | E 551,039.032 - N 1,352,713.648 |
| 24+95.08 A                                        | E 551,302.976 - N 1,352,574.791 |

**CONTROL POINTS:**

C.L. #12: 5/8" PIN WITH BRASS CAP  
E 553,241.932 - N 1,350,718.597

C.L. #13: 5/8" PIN WITH BRASS CAP  
E 552,765.884 - N 1,350,164.116

CHISELED "X": LOCATED TOP CENTER OF PUMP STATION  
E 549,572.51 - N 1,354,198.19

CHISELED "□": LOCATED ON S.E. CORNER OF EXISTING  
PUMP STATION - EL. 450.80

CROSS DIKE GENERAL NOTES:

1. EDGE OF DISTURBANCE MAY VARY FROM THAT SHOWN. CONTOURS SHOW GENERAL EXISTING TOPOGRAPHY. ACTUAL GROUND ELEVATIONS MAY VARY, CONTOUR INTERVAL IS 2.0 FEET. THE CROSS DIKE LEVEE WAS GRADED AND SEEDED AFTER THE 1996 SURVEY. ROCK SURFACING WAS PLACED ALONG LEVEE TOP.
2. REPAIR CROSS DIKE LEVEE ALONG THE DESIGN ALIGNMENT FROM STA. 0+00A TO APPROXIMATE STA. 45+00A. SEE TYPICAL SECTION ON SHEET C60 AND PUMP STATION SITE PLAN ON SHEET C10A. SEE PARKING AREA PLAN AND BOAT RAMP FOR ADDITIONAL WORK.
3. EXISTING CONTRACT DACW25-92-C-0079 IS ON-GOING. THE PUMP STATION IS BEING COMPLETED AS WELL AS OTHER MISCELLANEOUS ITEMS. U.S.F.W.S. IS PERFORMING THE DESIGN AND CONSTRUCTION OF THE LOWER CROSS DIKE. CONTRACTOR SHALL COORDINATE ITS WORK WITH THE EXISTING CONTRACTOR AND U.S.F.W.S. SO THAT ON-GOING WORK IS NOT INTERRUPTED. SEE SPECIFICATIONS.
4. SEE REFERENCE DRAWINGS FOR LEVEE SECTION SURVEY INFORMATION.

[illegible]

|                                                                               |                     |                            |
|-------------------------------------------------------------------------------|---------------------|----------------------------|
| U.S. ARMY ENGINEER DISTRICT<br>FORT MONROE, VIRGINIA<br>ROCK ISLAND, ILLINOIS | Designed By: DRC    | Date: MAR 1989             |
|                                                                               | Drawn By: RLC - CAB | Scale: AS SHOWN            |
|                                                                               | Checked By: ERK     | Drawing Code: 1-L-1-3-1/67 |
|                                                                               | Reviewed By: LUC    | Scale: 1/8"=1'-0" R-40003  |

ILLINOIS WATERWAY  
ENVIRONMENTAL MANAGEMENT PROGRAM  
LA GRANGE POOL, MILE 124 TO 129.5  
LAKE CHATAQUA  
OPERATIONS AND MAINTENANCE  
**CROSS DIKE PLAN**  
**STA. 0+00 A TO**  
**STA. 25+00 A**


Sheet  
Reference  
Number:

**C50**  
Sheet 11 of 84


| DESIGN ALIGNMENT<br>TOE OF UPPER LAKE LEVEE SLOPE |                                 |
|---------------------------------------------------|---------------------------------|
| P.L. STATION                                      | COORDINATE LOCATION             |
| 38+70.92 A                                        | E 552,328.427 - N 1,351,657.528 |
| 43+93.34 A                                        | E 552,712.679 - N 1,351,303.583 |

NOTES:

1. SEE CROSS DIKE GENERAL NOTES ON SHEET C50.
2. SEE SHEET C50 FOR DESCRIPTION OF CONTROL POINTS C.L. #12 AND C.L. #13.
3. SEE SHEET C10 FOR WORK FROM STA. 0+00 A TO STA. 5+00 A.
4. SEE SHEET C70 FOR WORK FROM STA. 45+00 A TO EXISTING ACCESS ROAD.

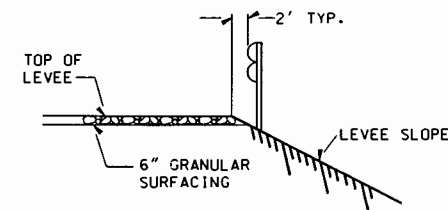


SECTION A-A  
NO SCALE

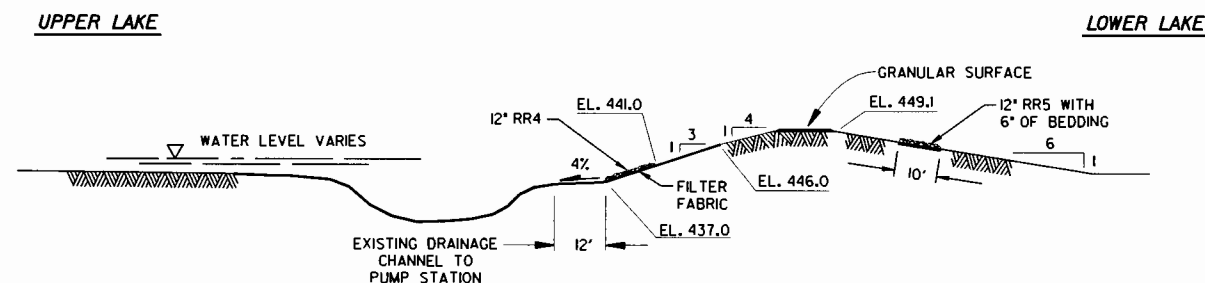


CROSS DIKE LEVEE TYPICAL SECTION  
APPROXIMATE STA. 3+00A TO STA. 45+00A

SCALE IN FEET

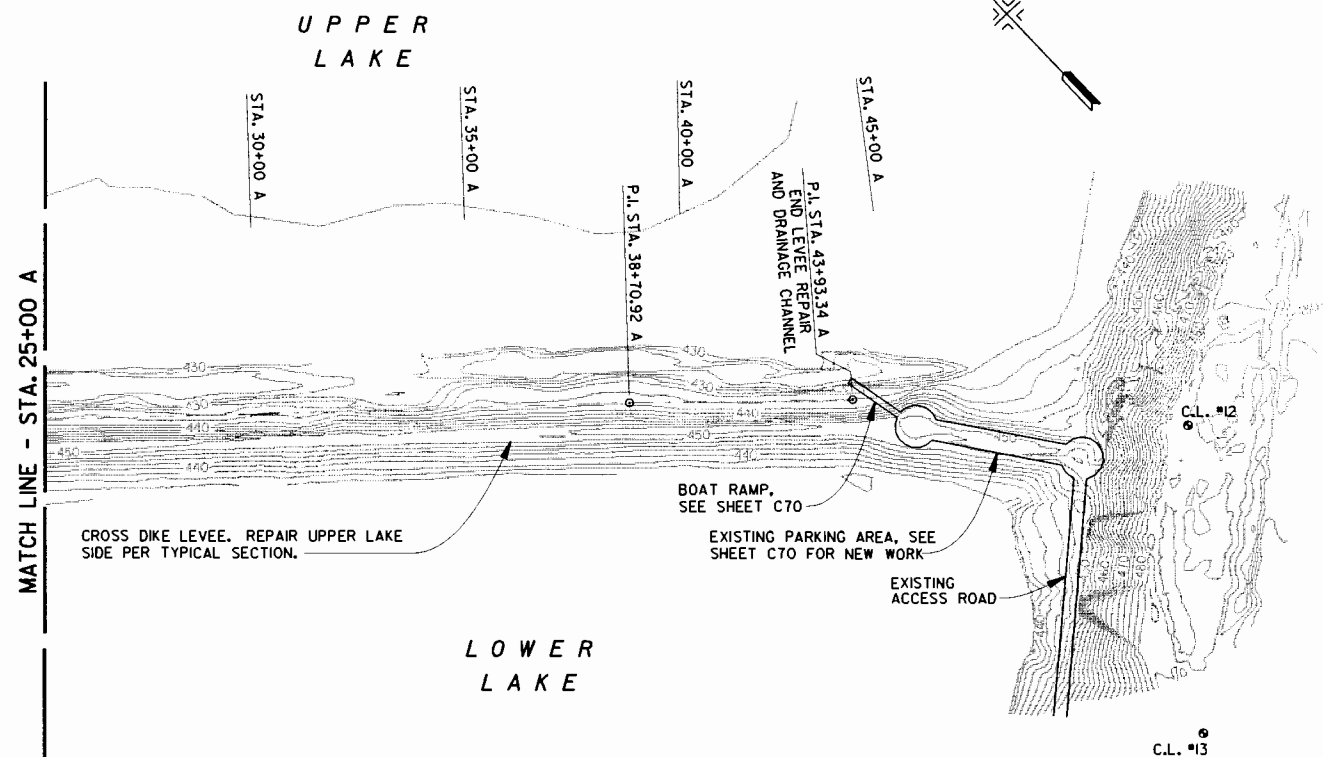

CROSS DIKE PLAN

SCALE IN FEET

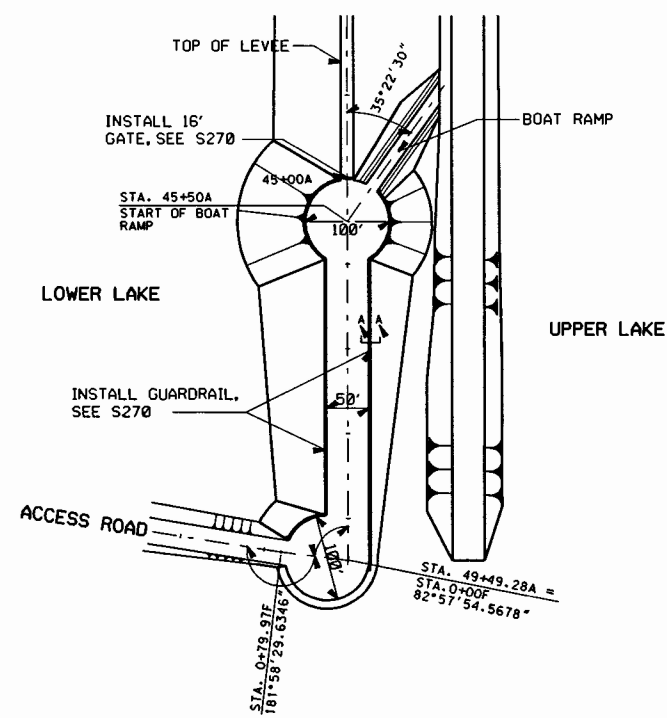

PARKING AREA DETAIL

SCALE IN FEET

| Symbol         | Description | Revisions |
|----------------|-------------|-----------|
| AS CONSTRUCTED |             |           |
| 26AUG00DRC/RAI | Date        | Approved  |

|                                                                            |                                                                                |                                                                                                           |
|----------------------------------------------------------------------------|--------------------------------------------------------------------------------|-----------------------------------------------------------------------------------------------------------|
| U.S. ARMY ENGINEER DISTRICT<br>CORPS OF ENGINEERS<br>ROCK ISLAND, ILLINOIS | Designed By: DRC<br>Drawn By: RLC - CAB<br>Checked By: ERK<br>Reviewed By: JJC | Date: MAR 1999<br>Scale: AS SHOWN<br>Drawing Code: 1-L-1-3-1/67<br>Specification Number: DACW25-97-B-0032 |
|----------------------------------------------------------------------------|--------------------------------------------------------------------------------|-----------------------------------------------------------------------------------------------------------|

ILLINOIS WATERWAY  
ENVIRONMENTAL MANAGEMENT PROGRAM  
LA GRANGE POOL, MILE 124 TO 129.5  
LAKE CHAUTAUQUA  
OPERATIONS AND MAINTENANCE  
CROSS DIKE PLAN  
STA. 25+00 A TO  
STA. 44+93.88 A


Sheet  
Reference  
Number:  
**C60**  
Sheet 12 of 84

| Symbol            | Description | Revisions |
|-------------------|-------------|-----------|
| AS CONSTRUCTED    |             |           |
| 26 AUG 00 R/C/RAI |             |           |


|              |           |                       |                 |
|--------------|-----------|-----------------------|-----------------|
| Designed By: | DRC       | Date:                 | MAR 1999        |
| Drawn By:    | BOJ - CAB | Scale:                | AS SHOWN        |
| Checked By:  | ERK       | Drawing Code:         | 1-L-1-3-1/67    |
| Reviewed By: | JUC       | Soil Test Log Number: | DAC25-97-B-0035 |

ILLINOIS WATERWAY  
ENVIRONMENTAL MANAGEMENT PROGRAM  
LA GRANGE POOL, MILE 124 TO 129.5  
LAKE CHATAUGUA  
OPERATIONS AND MAINTENANCE  
**BOAT RAMP**  
**PLAN AND DETAILS**



Sheet  
Reference  
Number:  
**C70**  
Sheet 13 of 84

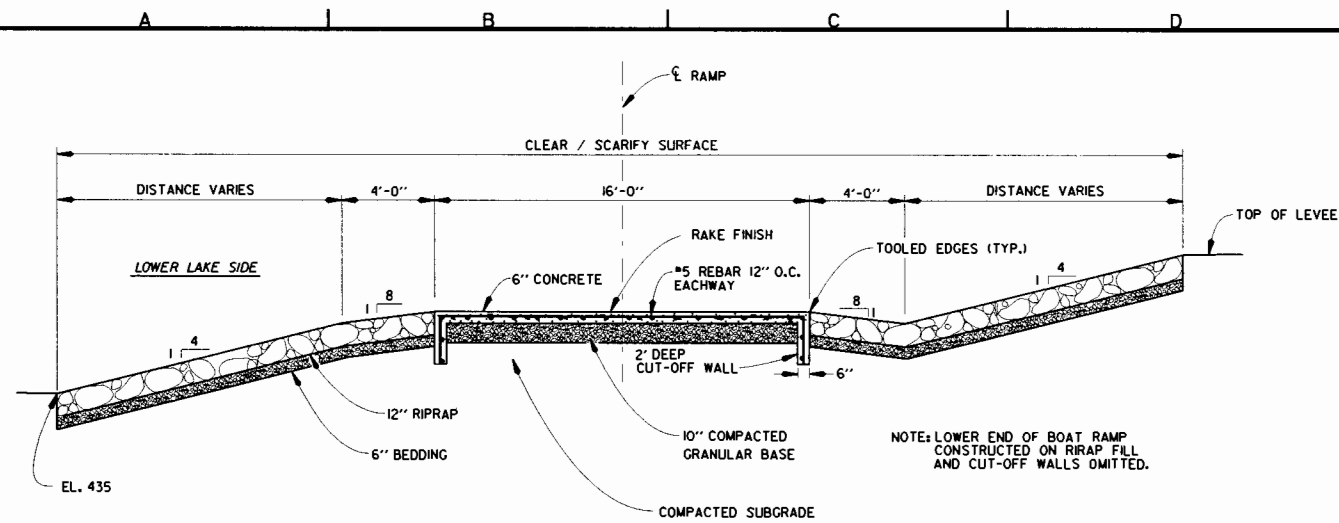


**BOAT RAMP SECTION**  
NO SCALE

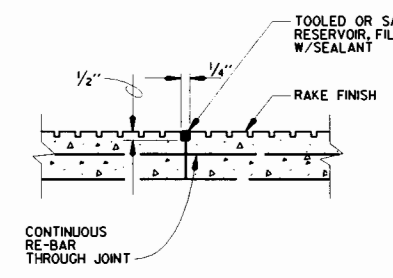


**CONSTRUCTION JOINT (CJ)**  
NO SCALE

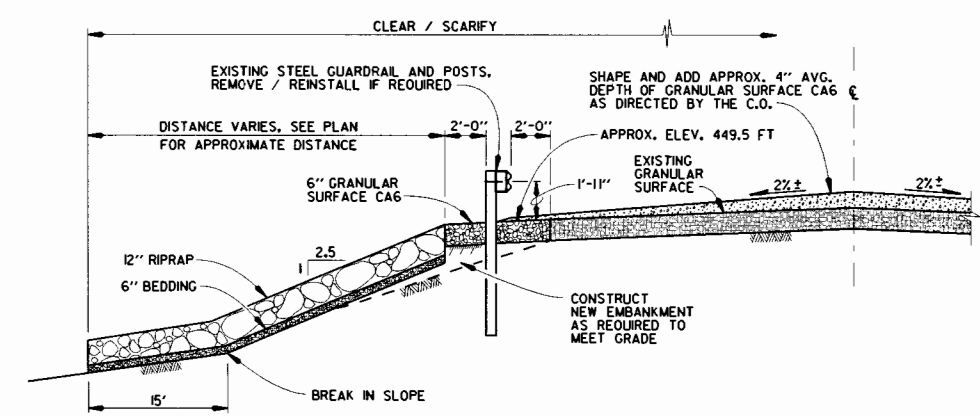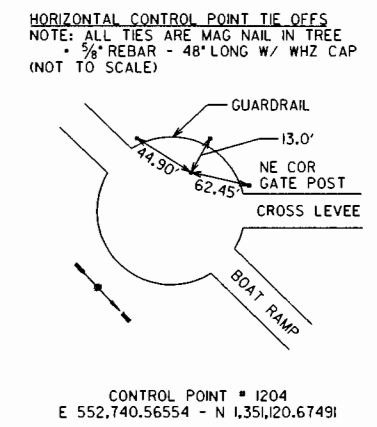

**PARKING AREA REPAIR SECTION**  
NO SCALE

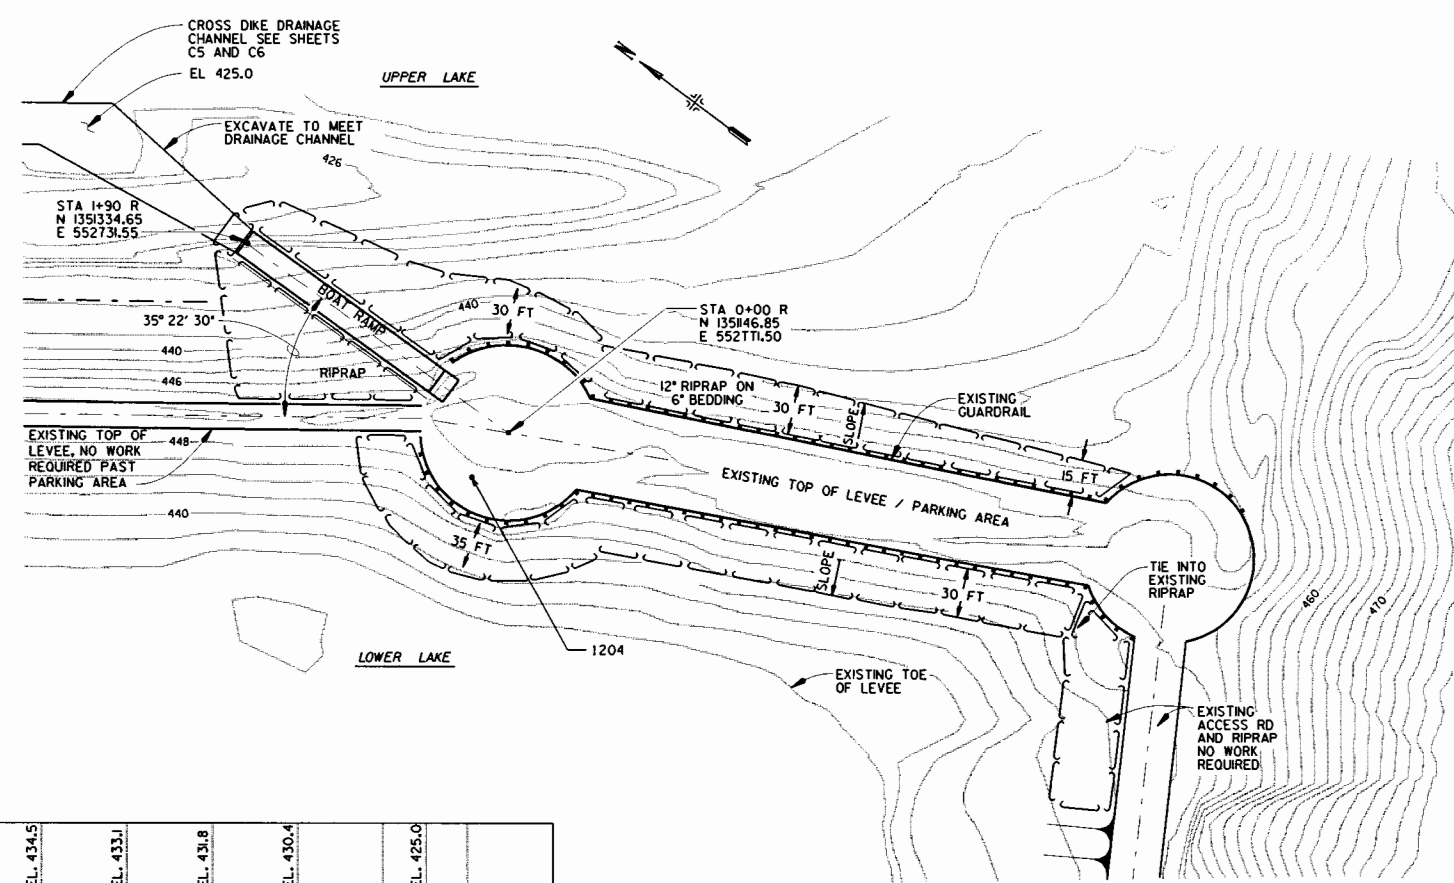

**PARKING AREA REPAIR / BOAT RAMP - PLAN**  
SCALE IN FEET  
100 50 0 100

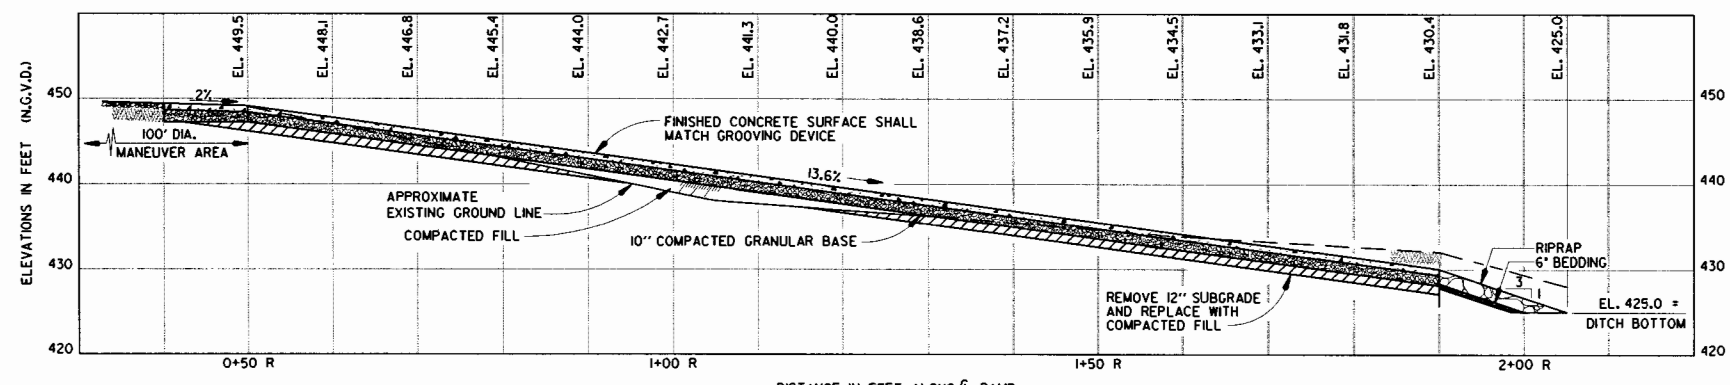

**BOAT RAMP PROFILE**




| Symbol | Description                | Revisions |
|--------|----------------------------|-----------|
| Δ      | REVISED AS CONSTRUCTED     |           |
| Δ      | ΔND. #1 - REVISED CONTOURS |           |


|              |         |                      |                  |
|--------------|---------|----------------------|------------------|
| Designed By: | DRC     | Date:                | MAR 1999         |
| Drawn By:    | TPD/HDC | Scale:               | AS SHOWN         |
| Checked By:  | DL      | Drawing Code:        | 1-L1-3-1-1/67    |
| Reviewed By: | DJH     | Solicitation Number: | DACW59-97-B-0032 |

ILLINOIS WATERWAY  
ENVIRONMENTAL MANAGEMENT PROGRAM  
LA GRANGE POOL, MILE 124 TO 129.5  
LAKE CHAUTAUQUA  
OPERATIONS AND MAINTENANCE  
**ACCESS ROAD PLAN AND  
SECTION STA. 0+00F TO  
STA. 12+19.77F**


Sheet  
Reference  
Number:  
**C80**  
Sheet 14 of 84

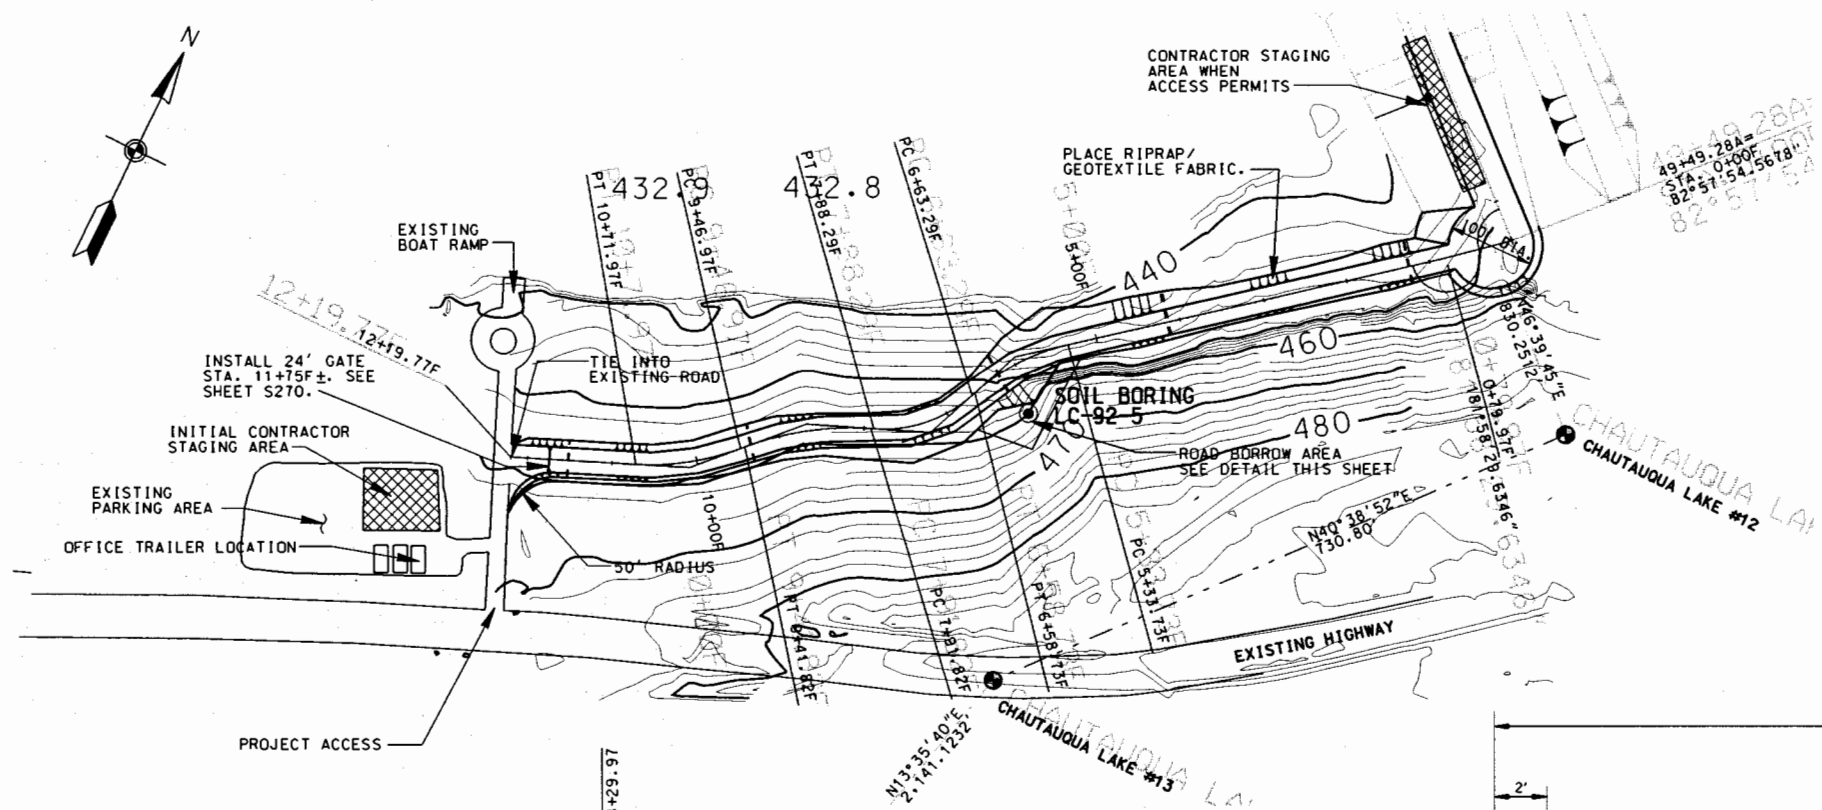

**ACCESS ROAD PLAN**  
SCALE: 1" = 100'

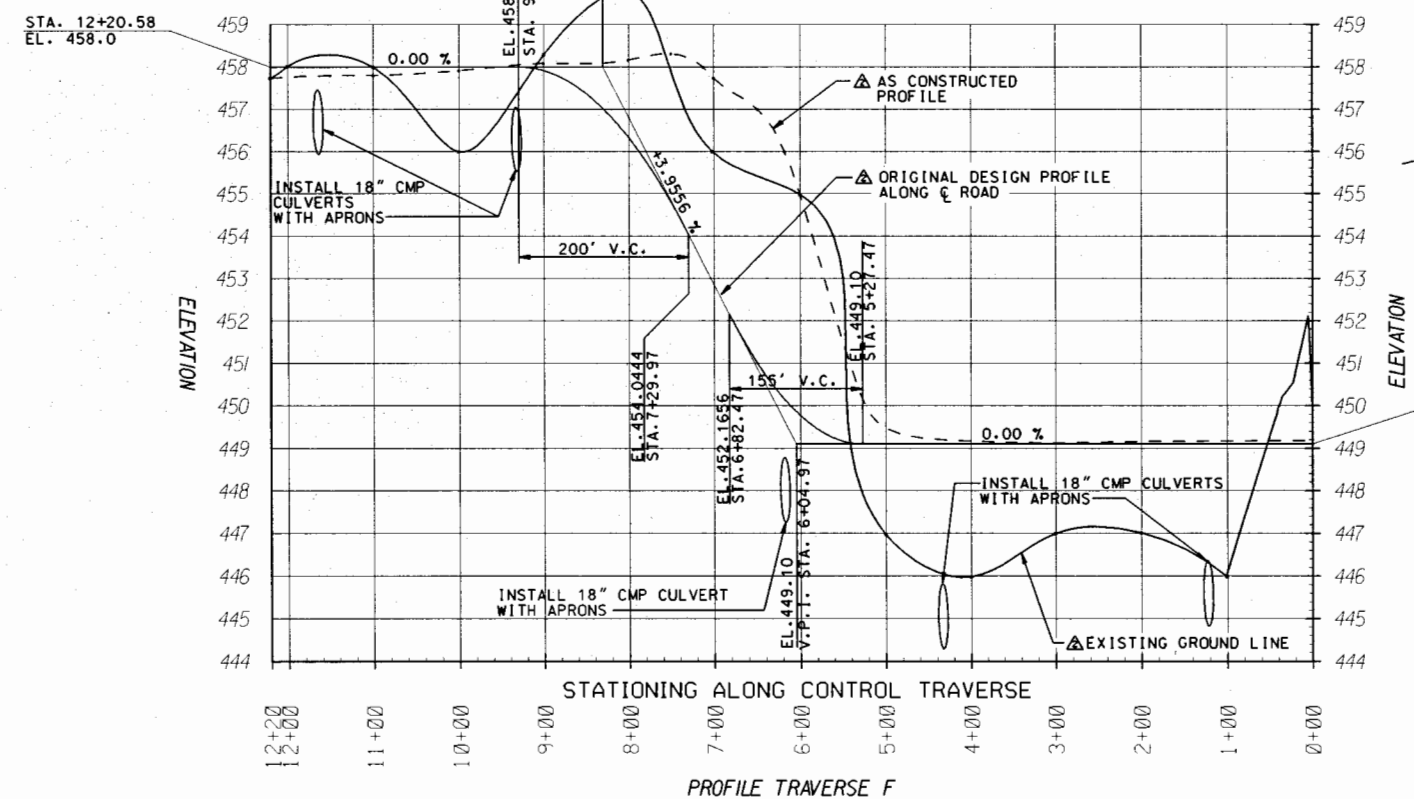

PROFILE TRAVERSE F

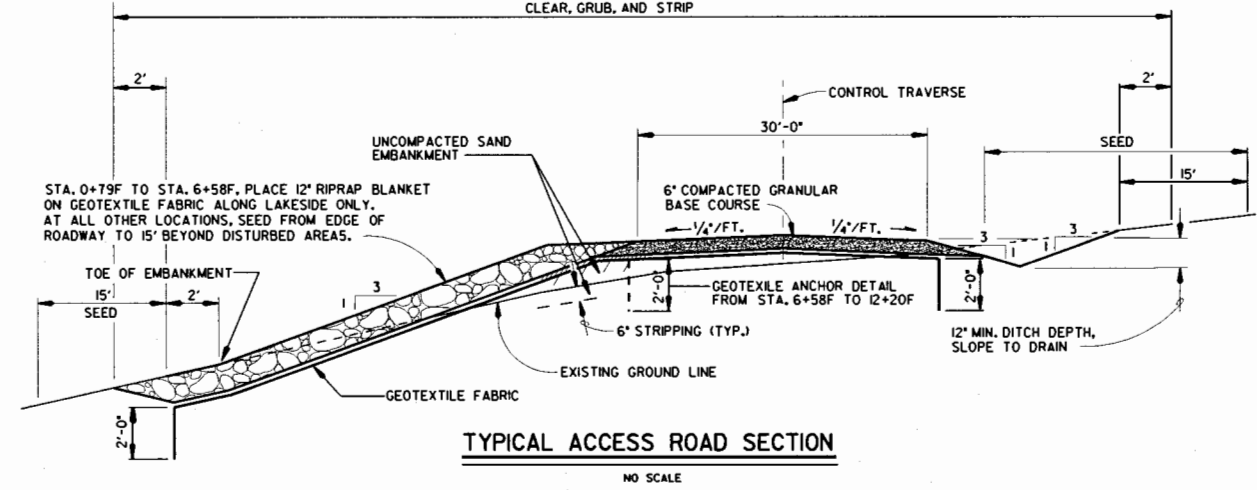

STA. 0+00  
EL. 449.10

P.I. STA. 5+97.5627F  
Δ = 28°39'55"  
D = 22°55'57"  
R = 249.8488'  
T = 63.8371'  
L = 125'  
E = 8.03'  
P.C. STA. 5+33.7256F  
P.T. STA. 6+58.7256F

P.I. STA. 7+29.3146F  
Δ = 45°37'18"  
D = 36°29'51"  
R = 156.99'  
T = 66.03'  
L = 125'  
E = 13.32'  
P.C. STA. 6+63.29F  
P.T. STA. 7+88.29F


P.I. STA. 8+68.00F  
Δ = 24°39'31"  
D = 16°26'20"  
R = 348.26'  
T = 76.18'  
L = 150'  
E = 6.23'  
P.C. STA. 7+91.82F  
P.T. STA. 9+41.82F

P.I. STA. 10+10.30F  
Δ = 24°00'45"  
D = 19°12'36"  
R = 298.26'  
T = 63.43'  
L = 125'  
E = 6.67'  
P.C. STA. 9+46.97F  
P.T. STA. 10+71.97F

- NOTES:**
- ROAD ALIGNMENT SHALL BE FIELD ADJUSTED. CONTRACTOR SHALL NOT BEGIN EARTHWORK UNTIL C.O.R. APPROVES LAYOUT.
  - CULVERT LOCATIONS WILL BE FIELD ADJUSTED.

HORIZONTAL TRAVERSE CONTROL POSITION  
C. L. #12: 5/8" PIN WITH BRASS CAP  
1.350.718.5968N 553.241.9318E  
C. L. #13: 5/8" PIN WITH BRASS CAP  
1.350.164.1155N 552.765.8840E




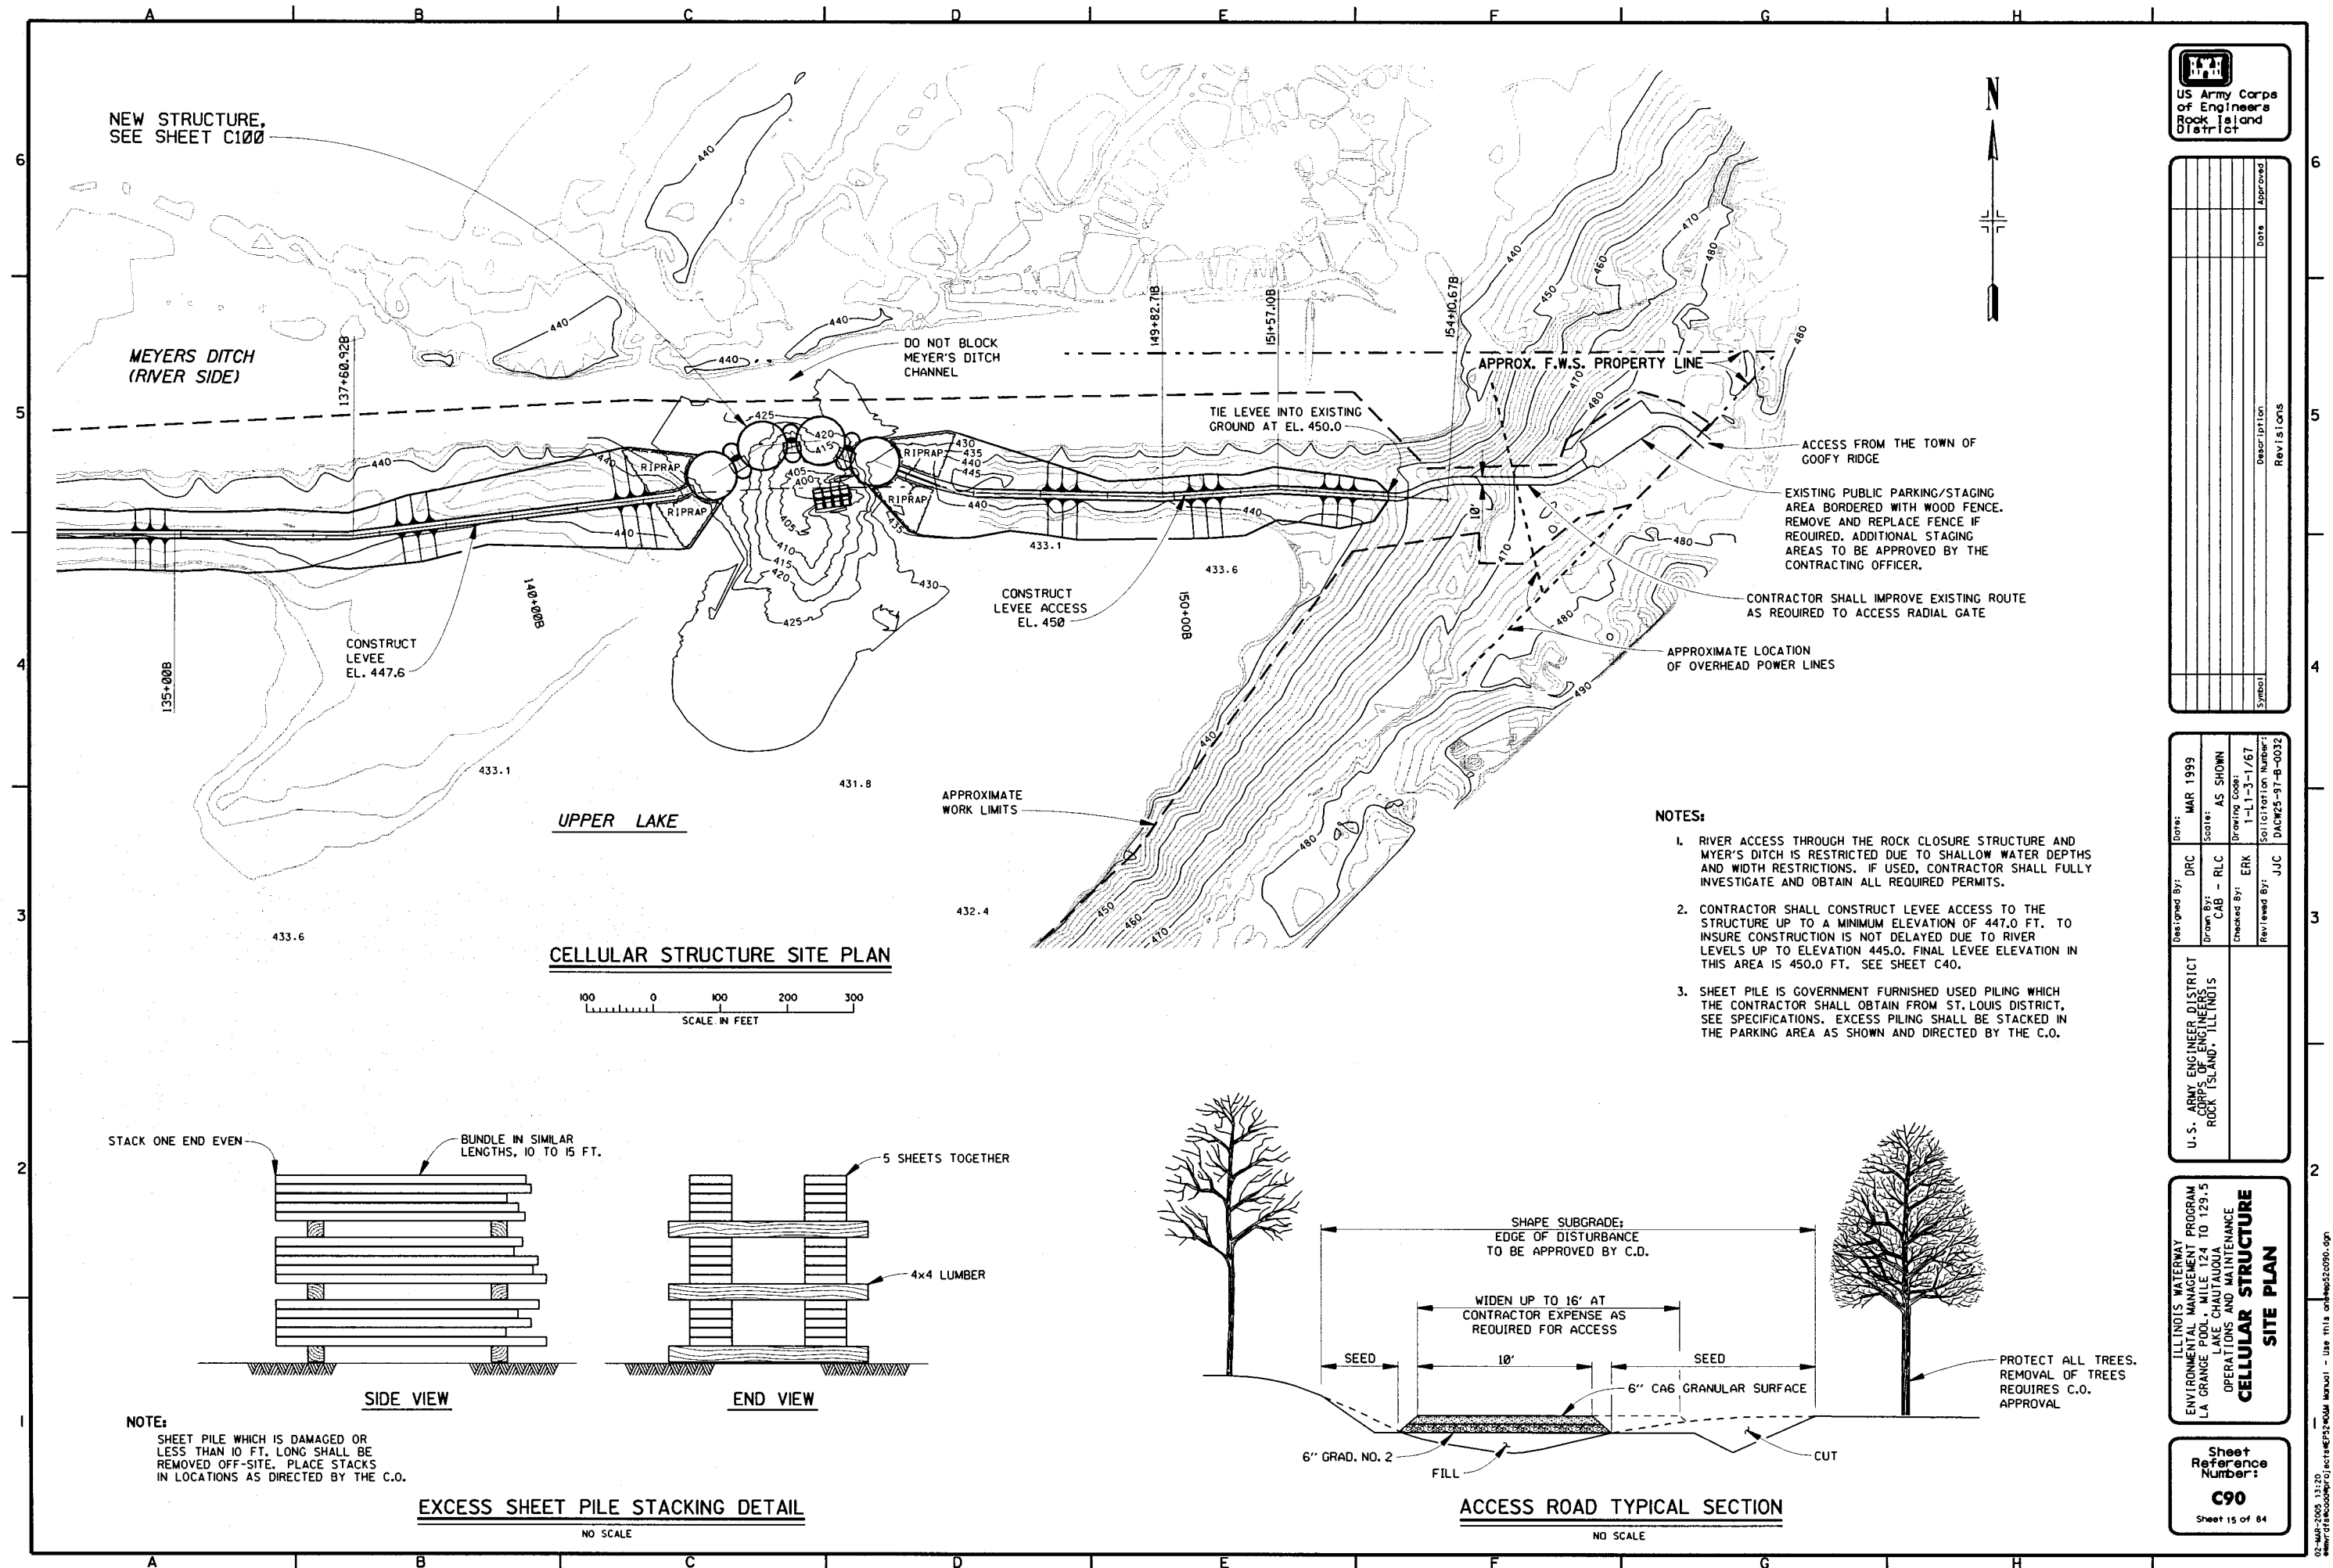




U.S. ARMY ENGINEER DISTRICT  
CORPS OF ENGINEERS  
ROCK ISLAND, ILLINOIS


Sheet  
Reference  
Number:  
**C100**  
Sheet 16 of 84

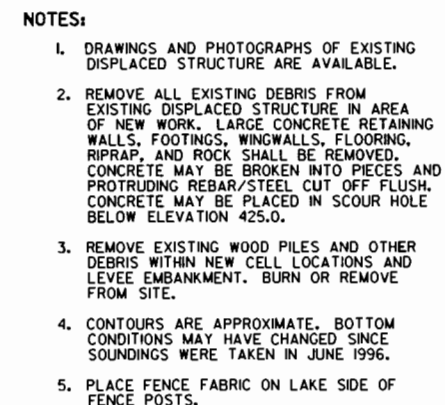

A horizontal scale bar labeled "SCALE IN FEET". The bar has major tick marks at 10, 0, 20, 40, and 60. There are also minor tick marks between the major ones, indicating increments of 5 units.

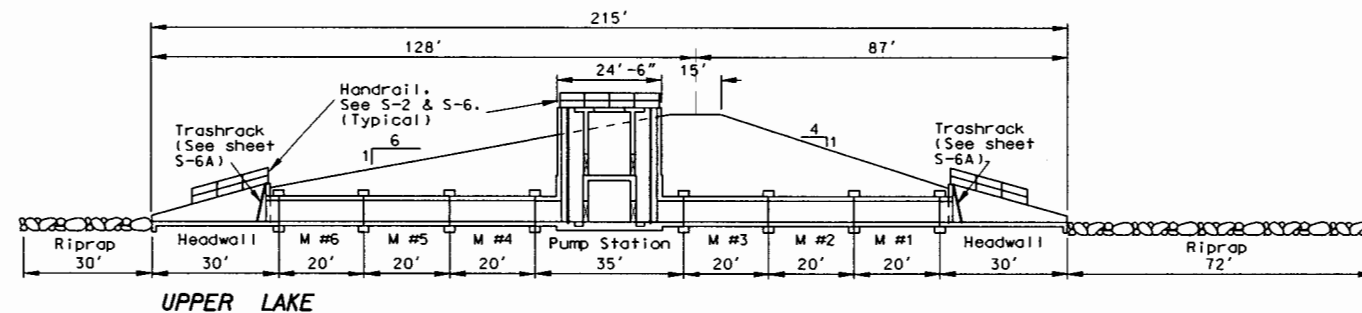

## SECTION B

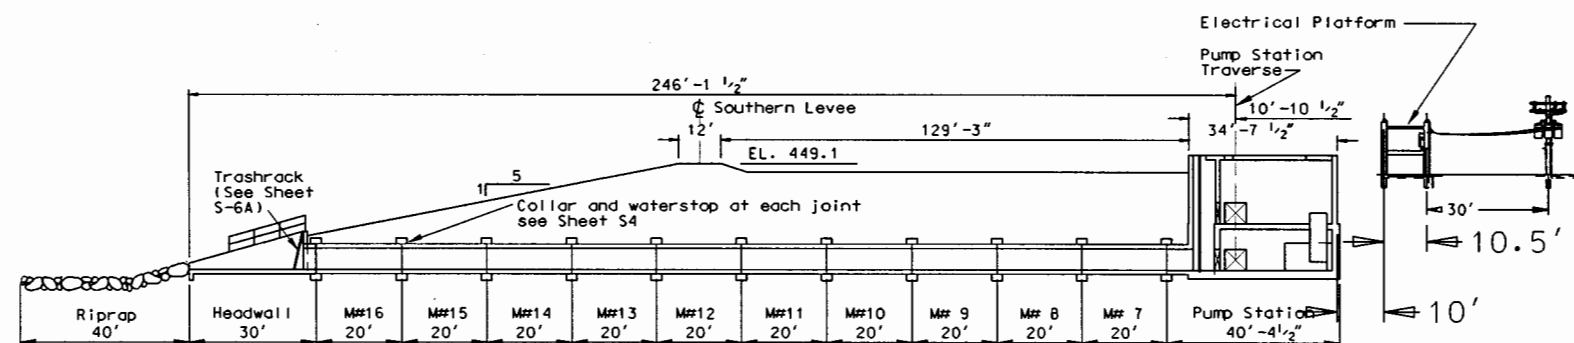

1. CONTRACTOR SHALL PRELOAD PUMP STATION SITE FOR 6 MONTHS WITH UNCOMPACTED EMBANKMENT. DEPTH OF PRE-LOAD SHALL BE 4' ABOVE FINAL GRADE.
2. CONTRACTOR SHALL BACKFILL WITH COMPACTED CLAY EMBANKMENT UP TO FINAL GRADE WITHIN LIMITS OF PRELOAD BOUNDARY.
3. CONTRACTOR SHALL BUILD PUMP STATION AS SOON AS ACCESS PERMITS AND PRELOAD IS COMPLETE.
4. CONTOURS NOT SHOWN IN UPPER AND LOWER LAKE, LIVERPOOL DITCH, AND MEYERS DITCH.
5. CONTOUR INTERVAL IS 2 FEET.
6. LEVEE FROM STA 0+00A TO 5+00A AND STATION 0+00B TO 3+00B SHALL REQUIRE FINAL DRESSING, SHAPING AND SEEDING. AREAS TO RECEIVE RIPRAP SHALL BE SHAPED.
7. THE C.O. MAY FIELD ADJUST RIPRAP AREA DIMENSIONS AND / OR QUANTITY TO MAXIMIZE RIPRAP EFFECTIVENESS.
8. PUMP STATION CONSISTS OF A 41,000 GPM, 250HP SUBMERSIBLE ELECTRIC PUMP. THE SUMP FLOOR IS AT ELEVATION 424.0. WHEN COMPLETED, THE PUMP IS CAPABLE OF LOWERING WATER ELEVATION TO 430.0 FT IN THE SUMP AREA. THE PUMP MAY ONLY BE USED ONE TIME FOR INITIAL DEWATERING. THERE WILL STILL BE WATER IN THE BORROW/DRAINAGE DITCHES AND SUMP. SEE SPECIFICATIONS FOR DEWATERING REQUIREMENTS. THE PUMP WILL NOT BE AVAILABLE UNTIL 1 JULY 1998.
9. PRELOAD PUMP STATION AND CULVERT AREA 6 MONTHS PRIOR TO EXCAVATION AND CONSTRUCTION.







——— DESIGN TEMPLATE  
 - - - - EXISTING GROUND  
 (VARIES ALONG LEVEE)

- Δ1. NO BORROW ADJACENT TO LEVEE FROM STA. 0+00B TO STA. 40+00B AND STA. 141+75B TO STA. 154+00B.
2. ORIGINAL LEVEE HAS GENERALLY BEEN CLEARED AND GRUBBED, HOWEVER, SOME GRUBBING WILL BE REQUIRED. LEVEE SHALL BE CLEARED OF ALL DEBRIS AND SCARIFIED PRIOR TO ADDITIONAL EARTHWORK, FINAL SHAPING, AND SEEDING.
3. EXCESS EXISTING MATERIAL ON LEVEE SHALL NOT BE MOVED MORE THAN 3 STATIONS ALONG LEVEE. EXCESS LEVEE MATERIAL SHALL BE USED ALONG UPPER LAKE SIDE OF LEVEE TO FLATTEN SLOPE.
- Δ4. CONTRACTOR SHALL CONSTRUCT LEVEE BREACH AND REPAIR WITH MATERIAL FROM OFF-SITE SOURCES AS DESCRIBED IN THE SPECIFICATIONS.
5. SEE REFERENCE DRAWING CROSS SECTIONS.
6. DEWATER UPPER LAKE TO CONSTRUCT LEVEE EMBANKMENT. SEE SPECIFICATIONS.





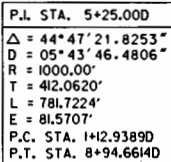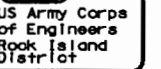

1. CONTRACTOR WILL ONLY EXCAVATE ONE DRAINAGE CHANNEL AT A TIME IN ORDER TO LIMIT DISRUPTION TO WILDLIFE.

HORIZONTAL TRAVERSE CONTROL POSITION  
LAKE #6; 5/8" PIN WITH BRASS CAP  
STA. 3+63.46513A 41.52654' RIGHT

U.S. ARMY ENGINEER DISTRICT  
CORPS OF ENGINEERS  
ROCK ISLAND, ILLINOIS

**DEWATERING CHANNEL  
PLAN & DETAILS  
STA 156+00 TO 189+00**

Sheet  
Reference  
Number:  
**C140**  
Sheet 20 of 84


[illegible]

|              |                                          |
|--------------|------------------------------------------|
| Drawn By:    | MAR 1999                                 |
| Checked By:  | Scale: AS SHOWN                          |
| Reviewed By: | Drawing Code:<br>1-L1-3-1/67             |
|              | Solicitation Number:<br>DACW25-97-B-0032 |



| Revisions | Description                        | Date      | By  | Appr. |
|-----------|------------------------------------|-----------|-----|-------|
| 1         | AS BUILT                           | 17 MAR 01 | MP  |       |
| 2         | AND. #1 - SHEET NUMBER CHANGE ONLY | 29 JAN 01 | DRC |       |

|              |     |                      |                  |
|--------------|-----|----------------------|------------------|
| Designed By: | DRC | Date:                | APR 2001         |
| Drawn By:    | DWP | Scale:               | AS SHOWN         |
| Checked By:  | KNM | Project Code:        | 1-L1-3-1/67      |
| Reviewed By: | JJC | Solicitation Number: | DACW25-01-B-0012 |

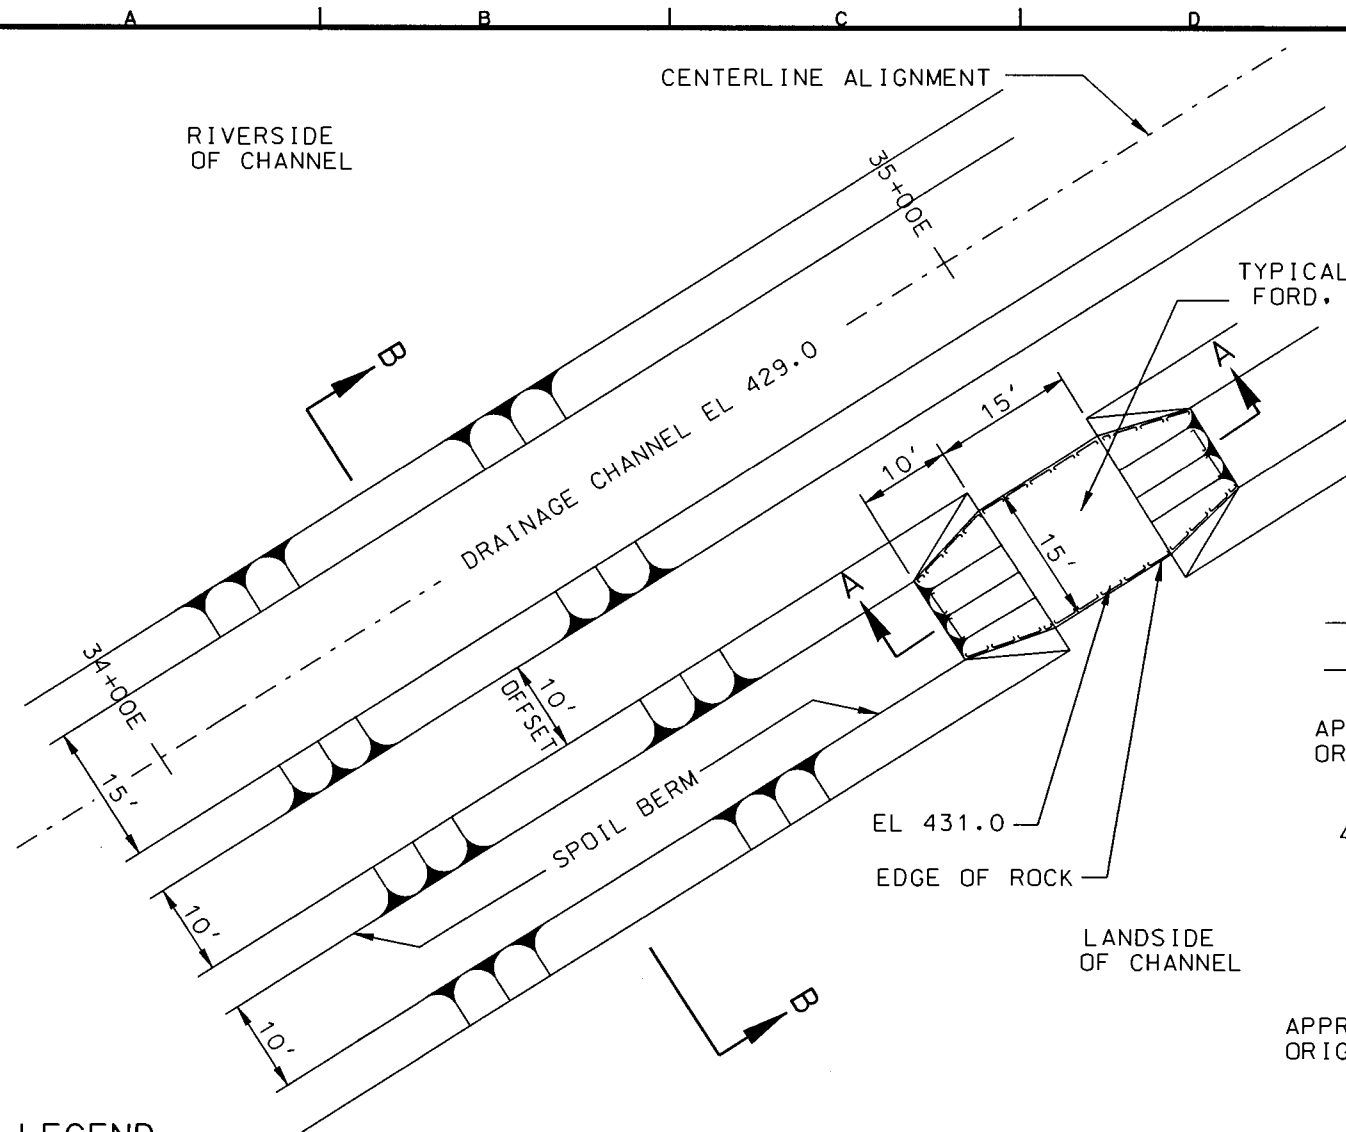

# LEGEND

- SLOPE SYMBOL
- RIPRAP SYMBOL
- EXISTING MATERIAL/LAKEBED
- SPOIL BERM CONSTRUCTION


# TYPICAL PLAN



| ALIGNMENT DATA |            |            |           |         |
|----------------|------------|------------|-----------|---------|
| PI             | STATION    | NORTHING   | EASTING   | CURVE # |
| BOP            | 0+00.00E   | 1342622.56 | 536752.05 |         |
| 1              | 2+01.54E   | 1342823.55 | 536767.02 | N/A     |
| 2              | 5+27.60E   | 1343145.27 | 536820.04 | 2       |
| 3              | 18+58.75E  | 1344093.92 | 537784.60 | 3       |
| 4              | 32+65.29E  | 1345250.23 | 538586.37 | 4       |
| 5              | 48+14.21E  | 1346289.09 | 539736.62 | 5       |
| 6              | 78+18.24E  | 1347805.21 | 542339.34 | 6       |
| 7              | 104+18.24E | 1348670.25 | 544784.03 | 7       |
| 8              | 129+52.07E | 1349181.83 | 547265.89 | 8       |
| 9              | 150+97.86E | 1350156.33 | 549179.44 | 9       |
| 10             | 162+03.93E | 1351416.52 | 549092.44 | N/A     |
| 11             | 185+01.22E | 1353708.50 | 549195.28 | 11      |
| 12             | 187+45.37E | 1353927.21 | 549328.14 | N/A     |
| EOP            | 191+59.75E | 1354302.45 | 549501.57 |         |

# GENERAL NOTES:

- CONTRACTOR SHALL BEGIN EXCAVATION AND SPOIL BERM CONSTRUCTION AT APPROXIMATE STATION 2+00E AND WORK TO STATION 188+00E. THE LAKE WILL GRAVITY DRAIN THROUGH THE STOP LOG STRUCTURE AT STA. 0+00E WHEN THE RIVER IS LOWER THAN THE LAKE. SEE HYDROGRAPHS IN THE SPECIFICATIONS.
- MINOR ALIGNMENT CHANGES MAY BE REQUIRED TO TIE INTO EXISTING DRAINAGE CHANNELS AT UPPER END AND LOWER END OF THE LAKE AND TO FOLLOW THE DEEPEST PARTS OF THE LAKE. ANY ALIGNMENT CHANGES SHALL BE COORDINATED THROUGH THE CONTRACTING OFFICER.
- ALL CURVES HAVE A RADIUS OF 1,000 FT. CURVE DATA IS AVAILABLE. SEE SPECIFICATIONS

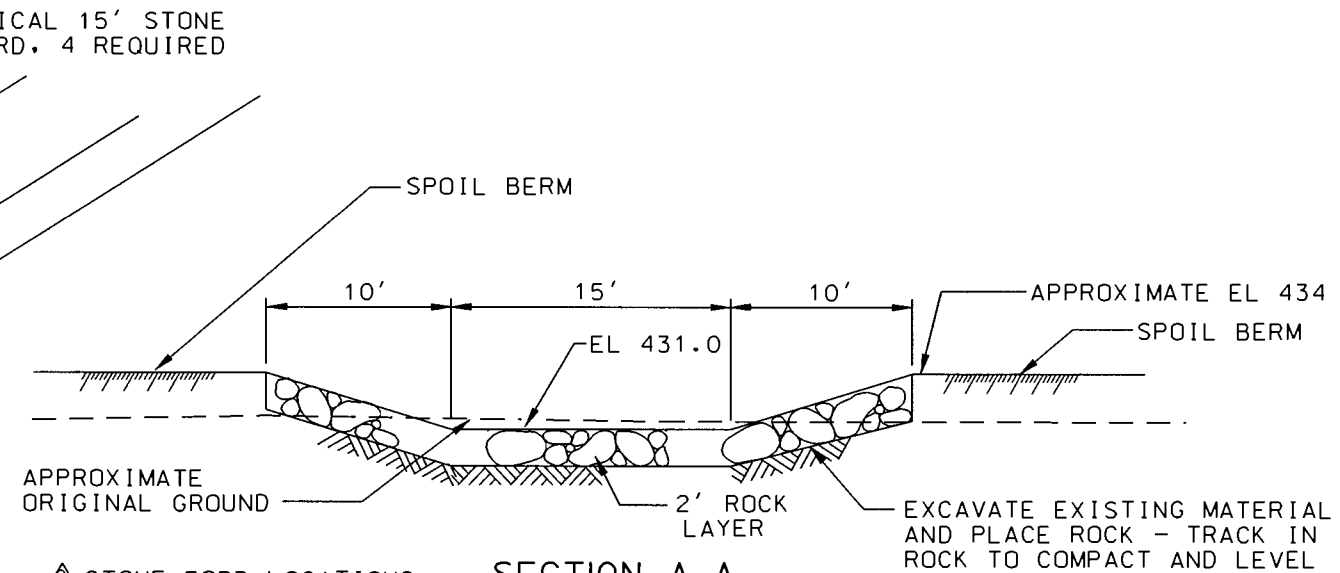


# SECTION A-A

NO SCALE

NOTE: LOCATE AND CONSTRUCT THE 4 TYPICAL STONE FORDS AT STATIONS: 35+00E, 72+00E, 102+00E, AND 145+00E.

- STONE FORD LOCATIONS
- #1 60+74E
  - #2 99+43E
  - #3 132+99E
  - #4 151+20E
- EXTRA DITCH TO LOW AREA 151+20E


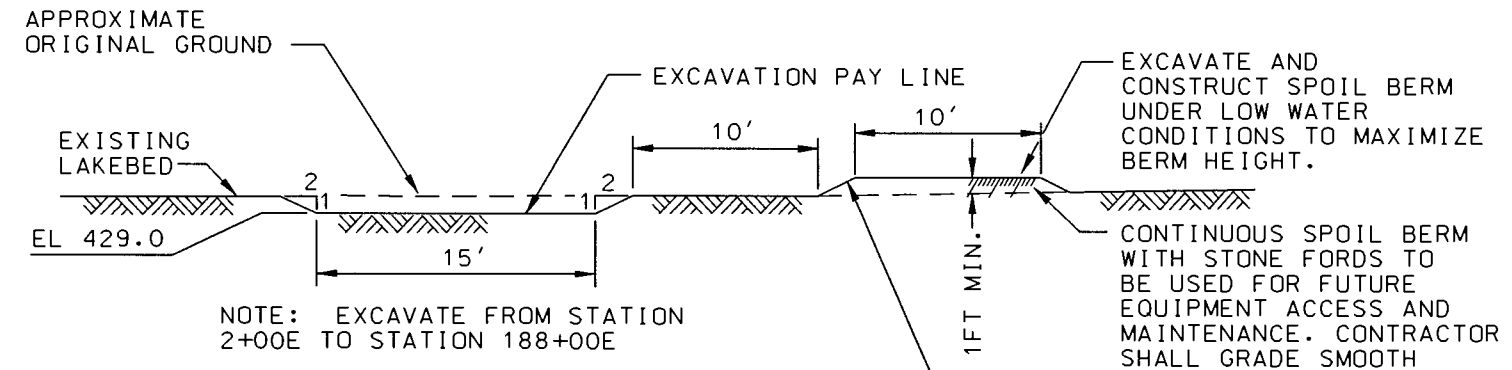


# SECTION B-B


NO SCALE





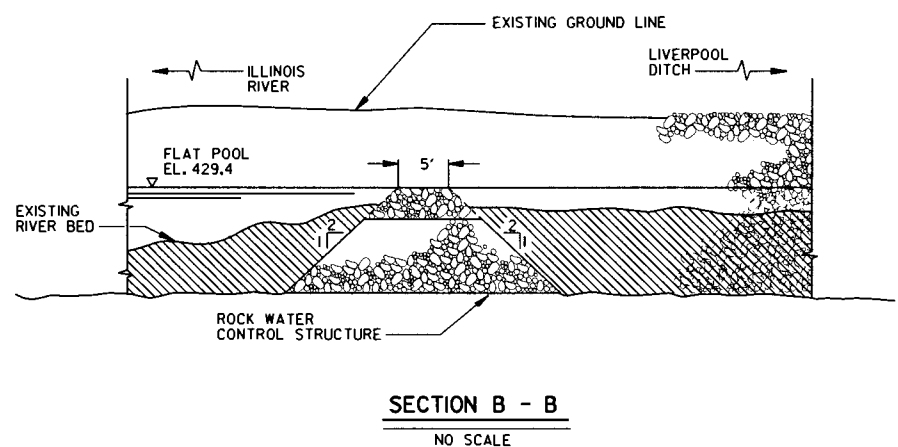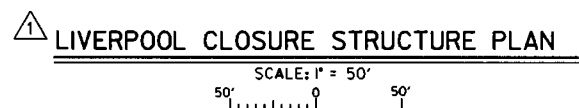

Sheet  
Reference  
Number:  
**C170**  
Sheet 23 of 84

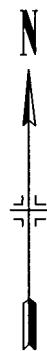

PLACE 12" OF RR4 RIPRAP  
OVER 6" OF IDOT GRADATION  
NO.1 BEDDING IN AREA APPROX.  
400' BY 30' AS SHOWN.

TOP OF LEVEE WITH  
GRASS SURFACE

MEYERS

DITCH

UPPER  
LAKE

CELLULAR WATER CONTROL STRUCTURE  
AND CONCRETE BRIDGES. LOAD LIMIT ON  
BRIDGES IS 45,000 LBS.


FWS PARKING LOT  
COORDINATE SITE ACCESS  
WITH MR. ROSS ADAMS  
(309) 535-2290

TBM "A" : NAIL IN 36"  
COTTONWOOD - EL. 451.07

TBM "B" : NAIL IN 22"  
LINDEN - EL. 451.06

GRANULAR ACCESS ROAD ALONG TOP  
OF LEVEE TO STRUCTURE

PERIMETER LEVEE PLAN

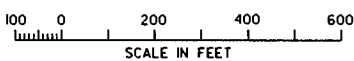

GENERAL SCOPE OF WORK:

SHAPE BANK AND PLACE APPROXIMATELY  
400 TONS OF BEDDING AND 750 TONS OF  
RIPRAP.

CONSTRUCTION TONNAGE TOTALS

BEDDING - 340.67 TONS  
RIPRAP - 798.25 TONS

NOTES:

1. THE TOWNSHIP AND COUNTY PLACES TEMPORARY LOAD LIMITS  
ON LOCAL ROADS.
2. THE CONTRACTOR SHOULD SCHEDULE THE WORK DURING DRY  
CONDITIONS TO MINIMIZE DAMAGE TO LEVEE EMBANKMENTS.
3. THE RIPRAP AREA SHALL BE STAKED IN THE FIELD. THE  
CONTRACTING OFFICER MAY ADJUST THE RIPRAP LIMITS TO  
BETTER COVER THE ERODED AREAS.
4. USE CORPS APPROVED ROCK SOURCES




| Symbol    | Description | Revisions |
|-----------|-------------|-----------|
| AS        | CONSTRUCTED |           |
| 31 MAR 04 | DRP/DRG     | Approved  |

|              |     |                       |                  |
|--------------|-----|-----------------------|------------------|
| Designed By: | DRC | Date:                 | X XX XXXX        |
| Drawn By:    | MRC | Scale:                | AS SHOWN         |
| Checked By:  | RAL | Drawing Code:         | LFP XXXXX        |
| Reviewed By: | DRR | Specification Number: | DACW25-99-B-XXXX |

ILLINOIS WATERWAY  
ENVIRONMENTAL MANAGEMENT PROGRAM  
LA GRANGE PROJECT  
LA GRANGE PROJECT  
OPERATIONS AND MAINTENANCE  
MEYER'S DITCH  
RIPRAP PLACEMENT  
LOCATIONS

Sheet  
Reference  
Number:  
**C180**  
Sheet 24 of 84



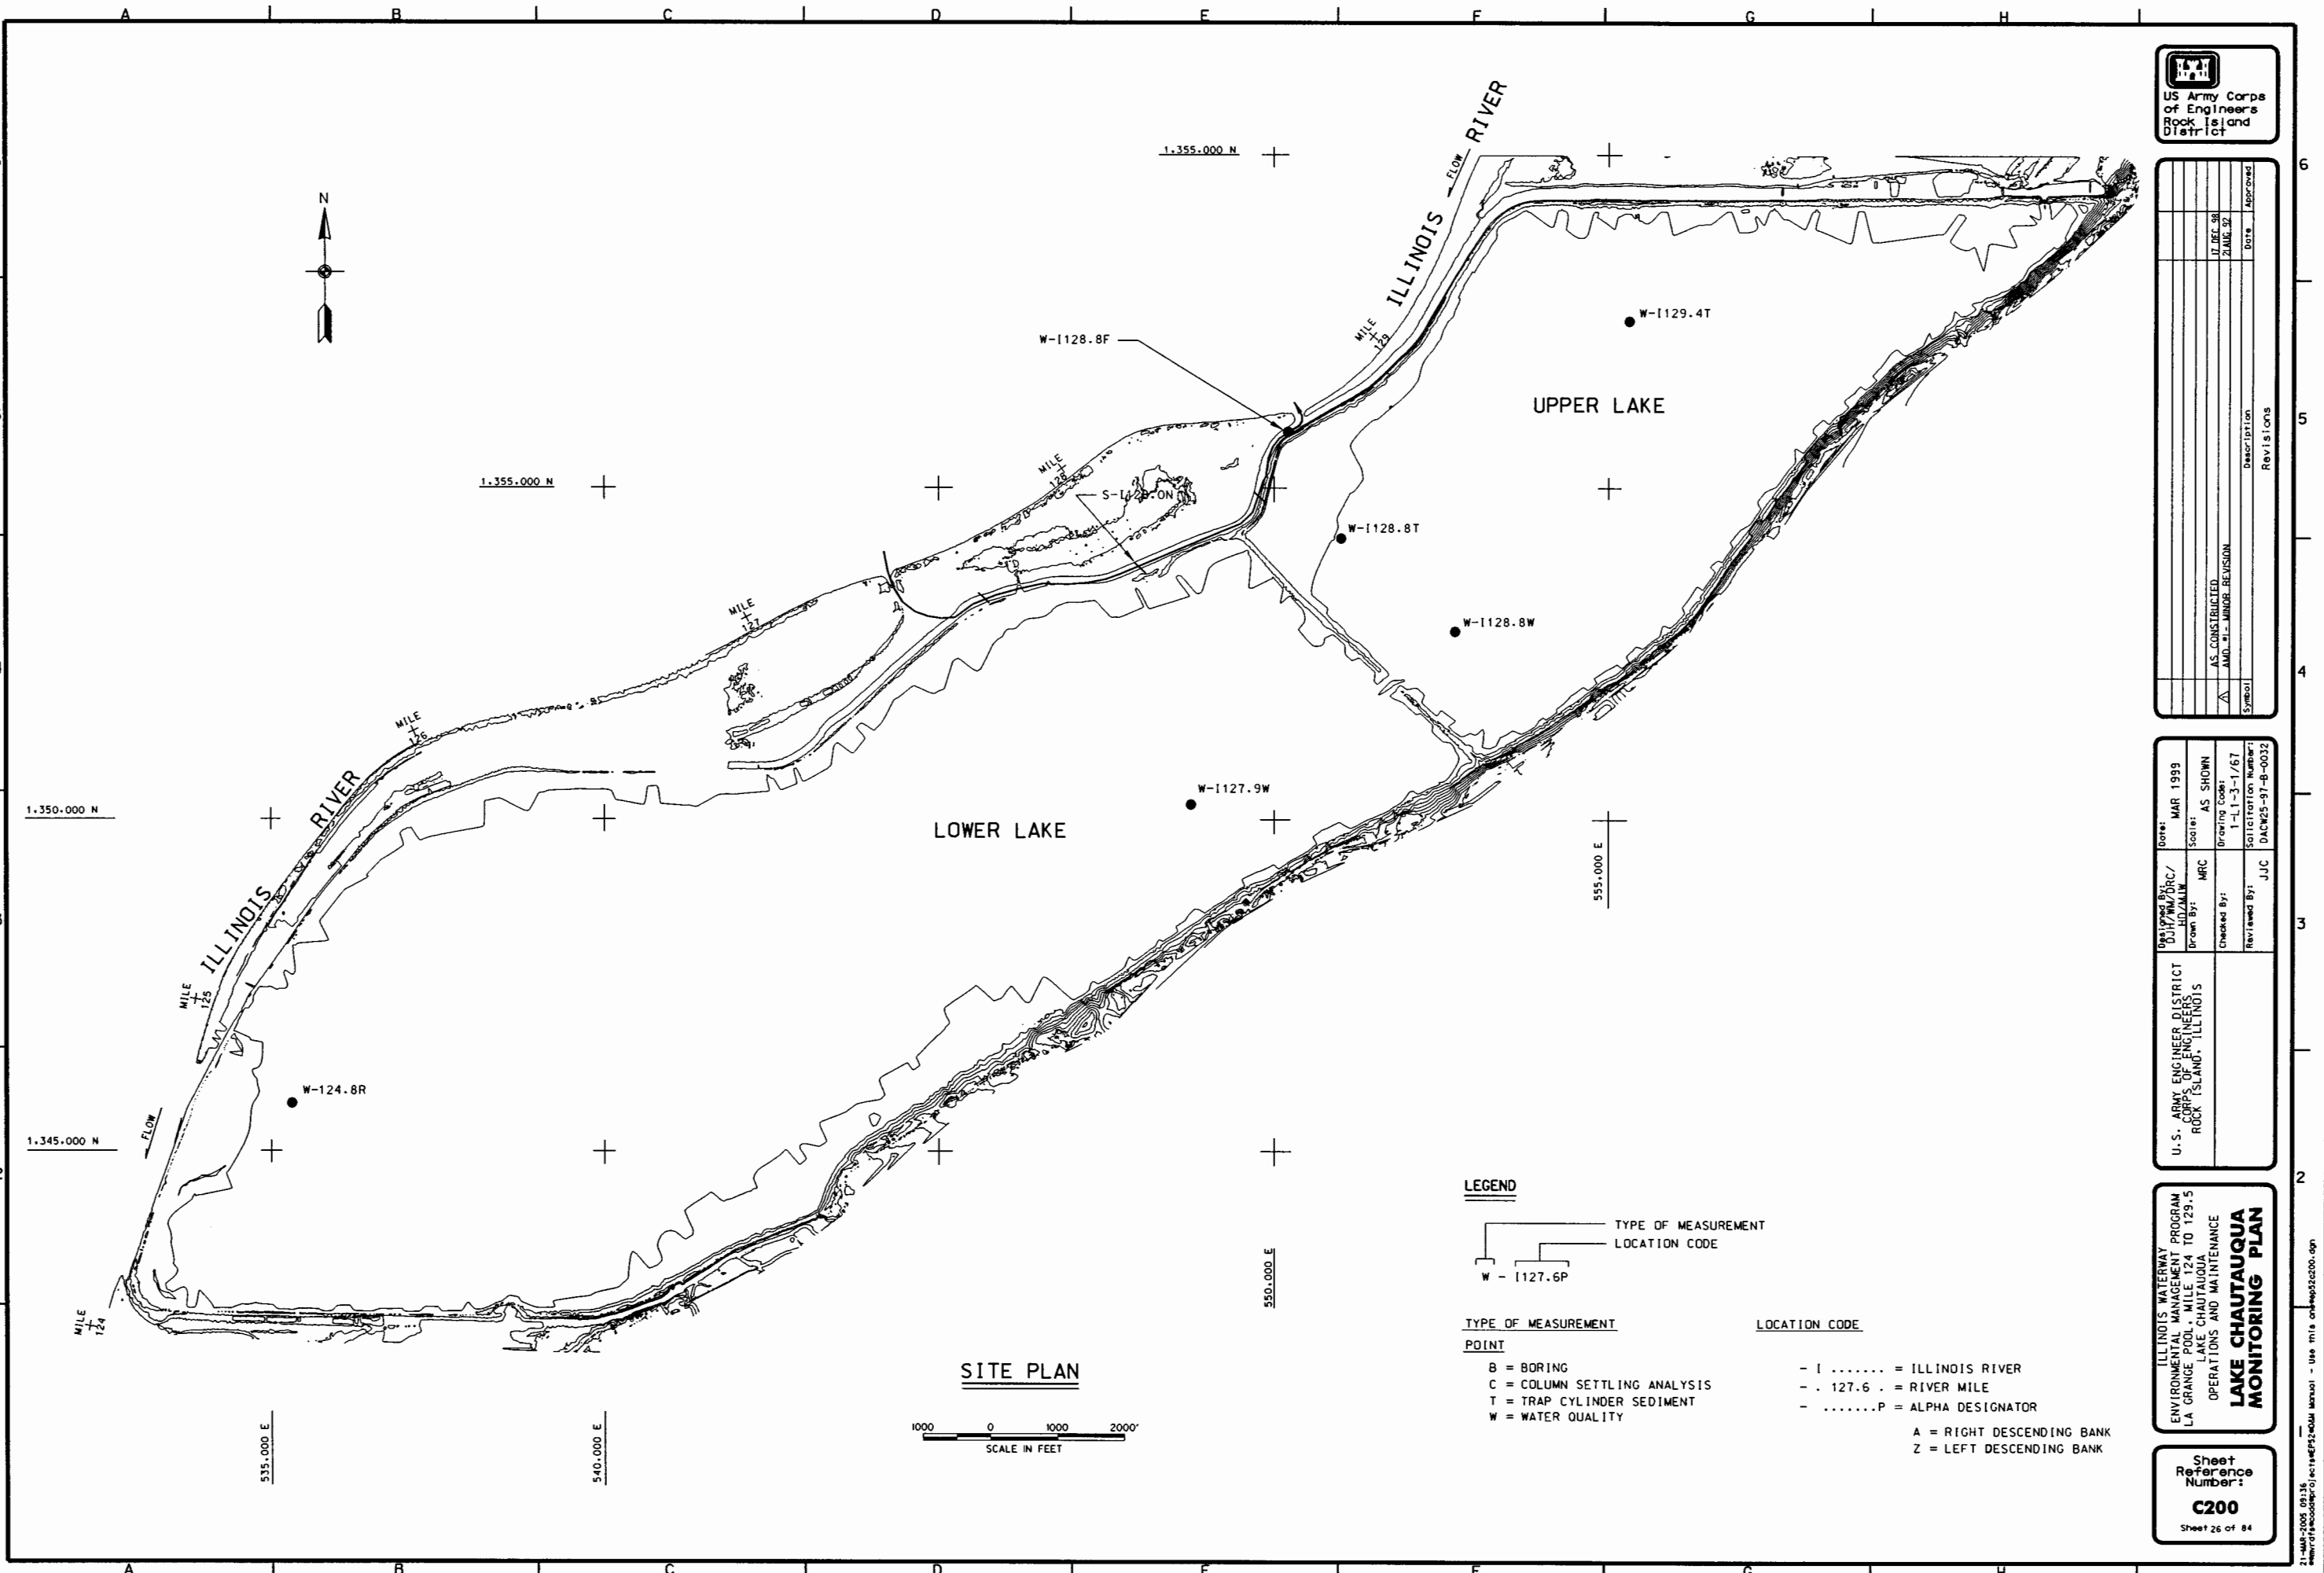


| Symbol   | Description    | Revisions |
|----------|----------------|-----------|
| AS       | AS CONSTRUCTED |           |
| AM       | AMENDMENT      |           |
| DATE     | DATE           |           |
| APPROVED | APPROVED       |           |

|                                                      |                                                                          |                                                                                                        |
|------------------------------------------------------|--------------------------------------------------------------------------|--------------------------------------------------------------------------------------------------------|
| U.S. ARMY ENGINEER DISTRICT<br>ROCK ISLAND, ILLINOIS | DESIGNED BY: JJC<br>DRAWN BY: JJC<br>CHECKED BY: JJC<br>REVIEWED BY: JJC | DATE: MAR 1999<br>SCALE: AS SHOWN<br>DRAWING CODE: 1-1-3-1/67<br>SOLICITATION NUMBER: DACW25-97-B-0032 |
|------------------------------------------------------|--------------------------------------------------------------------------|--------------------------------------------------------------------------------------------------------|

ILLINOIS WATERWAY PROGRAM  
ENVIRONMENTAL MANAGEMENT  
LA GRANGE POOL - MILE 124 TO 129.5  
LAKE CHAUTAUQUA  
OPERATIONS AND MAINTENANCE  
**LAKE CHAUTAUQUA  
MONITORING PLAN**

Sheet  
Reference  
Number:  
**C200**  
Sheet 26 of 84

**LEGEND**

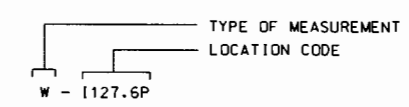

- TYPE OF MEASUREMENT**
- POINT**
- B = BORING
  - C = COLUMN SETTLING ANALYSIS
  - T = TRAP CYLINDER SEDIMENT
  - W = WATER QUALITY

- LOCATION CODE**
- I ..... = ILLINOIS RIVER
  - . 127.6 . = RIVER MILE
  - .....P = ALPHA DESIGNATOR
  - A = RIGHT DESCENDING BANK
  - Z = LEFT DESCENDING BANK

**SITE PLAN**





|              |     |                      |              |
|--------------|-----|----------------------|--------------|
| Designed By: | WM  | Date:                | MAR 1999     |
| Drawn By:    | BLL | Scale:               | AS SHOWN     |
| Checked By:  | HD  | Drawing Code:        | 1-L-1-3-1/67 |
| Reviewed By: |     | Solicitation Number: |              |


U.S. ARMY ENGINEER DISTRICT  
CORPS OF ENGINEERS  
ROCK ISLAND, ILLINOIS

ILLINOIS WATERWAY  
ENVIRONMENTAL MANAGEMENT PROGRAM  
A GRANGE POOL, MILE 124 TO 129.5  
LAKE CHAUTAUQUA  
OPERATIONS AND MAINTENANCE  
**LEFT SIDE  
CELL STRUCTURE  
LAYOUT**



Sheet  
Reference  
Number:  
**S10**  
Sheet 27 of 84



- NOTES:
1. PILES SHALL BE DRIVEN TO REFUSAL. REQUIRED LENGTH OF SHEET PILES IN MAIN CELLS IS ESTIMATED TO BE 55 FEET.
  2. ALL SHEET PILE IS USED AND FURNISHED BY THE GOVERNMENT. ALL WYE AND TEE PILES SHALL BE REFURBISHED OR FABRICATED BY THE CONTRACTOR FROM FURNISHED PILES. SEE SPECIFICATIONS 02411.
  3. MATERIAL SHALL BE PLACED IN THE CELLS SUCH THAT UNEVEN PRESSURES ON THE CELL ARE MINIMIZED DURING THE FILLING OPERATION.
  4. TOP ELEVATION OF MAIN CELL SHEET PILES IS 452.0. TOP ELEVATION OF CUTOFF WALLS IS 452.0 AT TEES AND 450.0 AT FREE ENDS. TOP OF SHEET PILE IN ARC CELLS WILL MATCH ADJACENT CONCRETE. SEE SHEET S4.

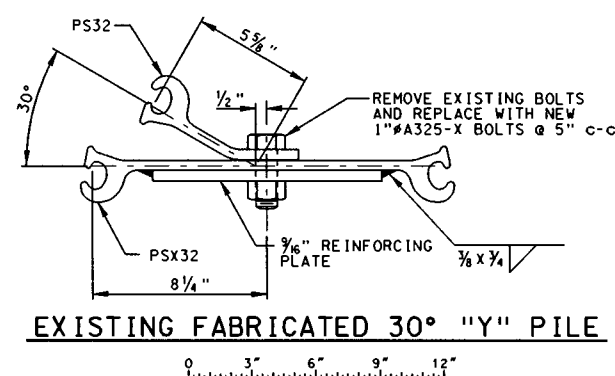



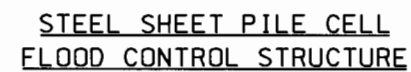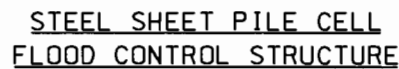

| DESIGN ALIGNMENT<br>CONTROL POINTS |                                 |                |
|------------------------------------|---------------------------------|----------------|
| P.J. STATION                       | COORDINATE LOCATION             | NOTES          |
| 144+88.71 B                        | E 561,450.680 - N 1,359,414.680 | CENTER, CELL " |
| 145+76.51 B                        | E 561,532.783 - N 1,359,383.568 | CENTER, CELL " |

TOTAL SHEET PILE SHOWN ON S1 AND S2:

|     |       |                       |
|-----|-------|-----------------------|
| 2   | TEE   | (SEE DETAIL SHEET S1) |
| 12  | WYE   | (SEE DETAIL SHEET S1) |
| 658 | PSX32 |                       |
| 282 | PS32  |                       |

[illegible]

|                                                                            |                  |                                       |
|----------------------------------------------------------------------------|------------------|---------------------------------------|
| U.S. ARMY ENGINEER DISTRICT<br>CORPS OF ENGINEERS<br>ROCK ISLAND, ILLINOIS | Designed By: WM  | Date: MAR 1999                        |
|                                                                            | Drawn By: BLL    | Scale: AS SHOWN                       |
|                                                                            | Checked By: HD   | Drawing Code: 1-1-1-3-1/67            |
|                                                                            | Reviewed By: RCA | Solicitation Number: DACW25-97-B-0032 |

**ILLINOIS WATERWAY  
ENVIRONMENTAL MANAGEMENT PROGRAM  
LA GRANGE POOL, MILE 124 TO 129.5  
LAKE CHAUTAUQUA  
OPERATIONS AND MAINTENANCE  
RIGHT SIDE  
CELL STRUCTURE  
LAYOUT**

Sheet  
Reference  
Number:  
**S20**  
Sheet 28 of 84



| Symbol         | Description | Date | Approved |
|----------------|-------------|------|----------|
| AS CONSTRUCTED |             |      |          |



|                                                                            |                                                                        |                                                                                                            |
|----------------------------------------------------------------------------|------------------------------------------------------------------------|------------------------------------------------------------------------------------------------------------|
| U.S. ARMY ENGINEER DISTRICT<br>CORPS OF ENGINEERS<br>ROCK ISLAND, ILLINOIS | DESIGNED BY: WM<br>DRAWN BY: BLL<br>CHECKED BY: HD<br>REVIEWED BY: RCA | DATE: MAR 1999<br>SCALE: AS SHOWN<br>DRAWING CODE: 1-1.1-3-1-1/67<br>SOLICITATION NUMBER: DACW25-97-R-0032 |
|----------------------------------------------------------------------------|------------------------------------------------------------------------|------------------------------------------------------------------------------------------------------------|

ILLINOIS WATERWAY  
ENVIRONMENTAL MANAGEMENT PROGRAM  
LA GRANGE POOL, MILE 124 TO 129.5  
LAKE CHAUTAUQUA  
OPERATIONS AND MAINTENANCE  
**FLOODWAY  
PLAN AND ELEVATION**

Sheet  
Reference  
Number:  
**S30**  
Sheet 29 of 84


- NOTE:
1. THE JIB CRANE SHALL BE FULL ROTATION EXCEPT BOOM SHALL BE PREVENTED FROM APPROACHING WITHIN ONE FOOT OF SLUICE GATE STEM FROM EITHER DIRECTION (APPROXIMATELY 315 DEGREES ROTATION).
  2. THE CRANE SHALL HAVE A SECURITY DEVICE TO RESTRAIN THE BOOM IN THE STORED POSITION (OVER THE GATE PLATFORM, AS SHOWN) WHEN THE OPERATOR IS NOT PRESENT.
  3. THE CRANE HOIST SHALL BE CAPABLE OF PICKING A STOPLOG FROM THE BOTTOM OF THE STOPLOG SLOTS, MOVING THE STOPLOG TO A POINT SEVEN FEET ABOVE THE MIDDLE (SIDE-TO-SIDE, NOT LENGTHWISE) OF THE BRIDGE SURFACE, PLACING THE STOPLOG IN A TRUCK BED, AND REVERSING THE ENTIRE OPERATION.
  4. ONE JIB CRANE SHALL BE DELIVERED AND INSTALLED AT THE MIDDLE FLOODWAY. ANCHORS FOR IDENTICAL CRANES SHALL BE INSTALLED AT OTHER FLOODWAYS.
  5. H-PILES AND SHEET PILES SHALL BE DRIVEN TO REFUSAL.

- AS-BUILT NOTES:
1. SURFACE MOUNTED JIB CRANE WAS DELETED FROM PROJECT.
  2. PROVIDE TRUCK MOUNTED JIB CRANE TO BE USED TO INSTALL AND REMOVE ALUMINUM STOP LOGS. MOUNT CRANE ON USFWS FLAT BED TRUCK.

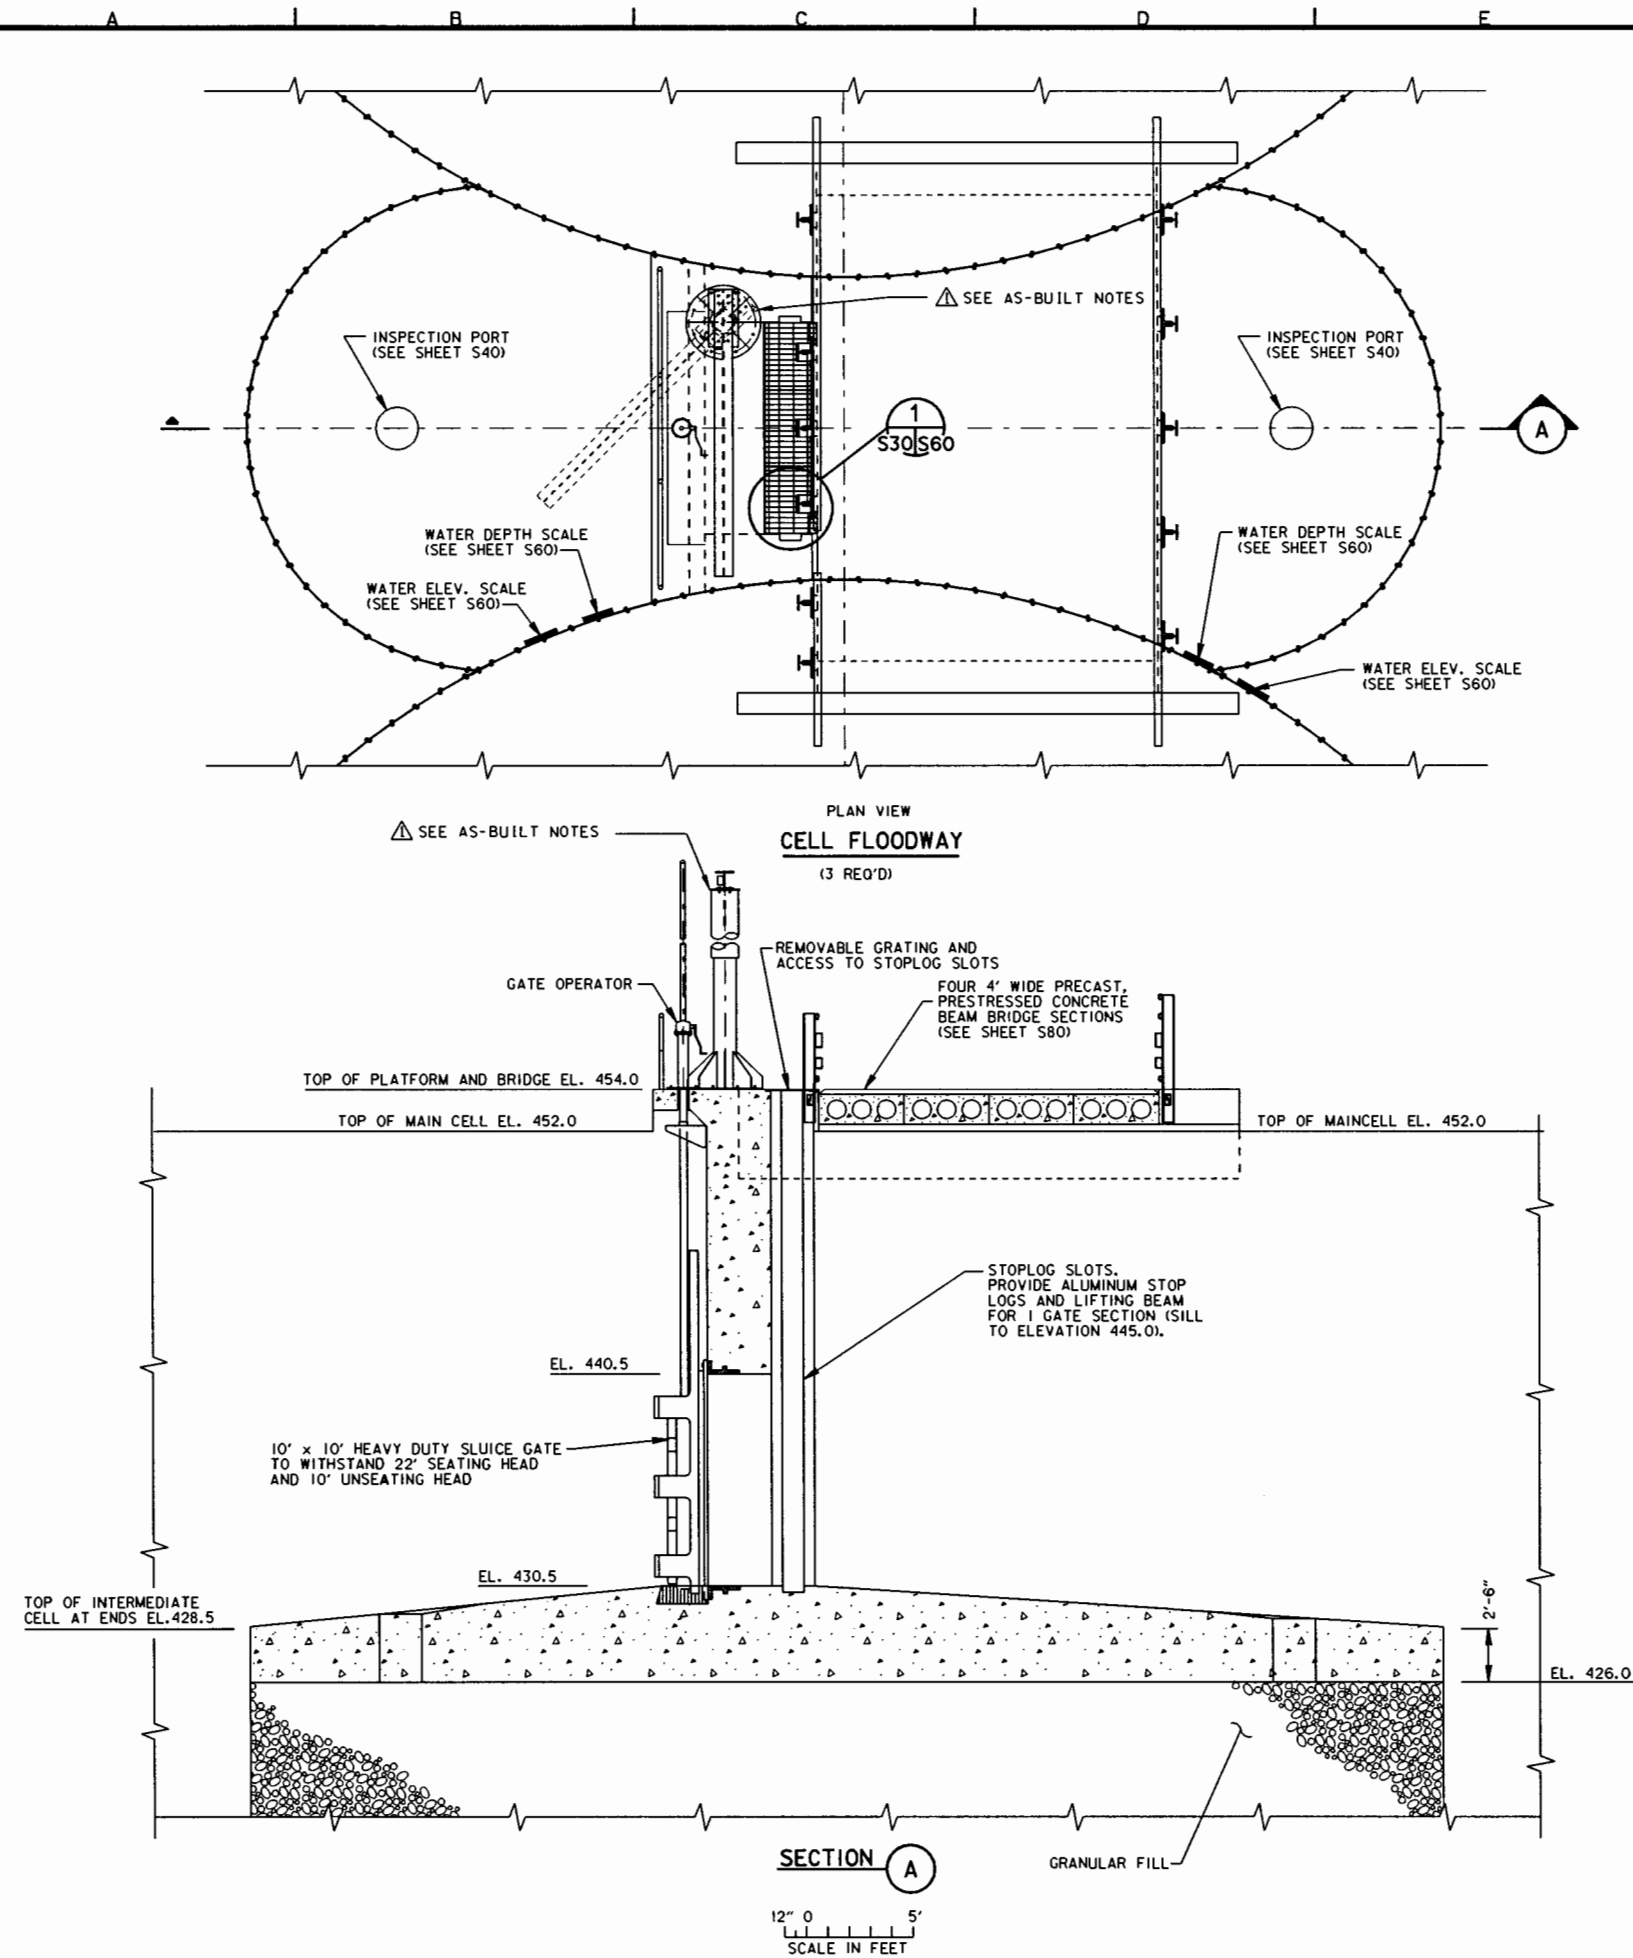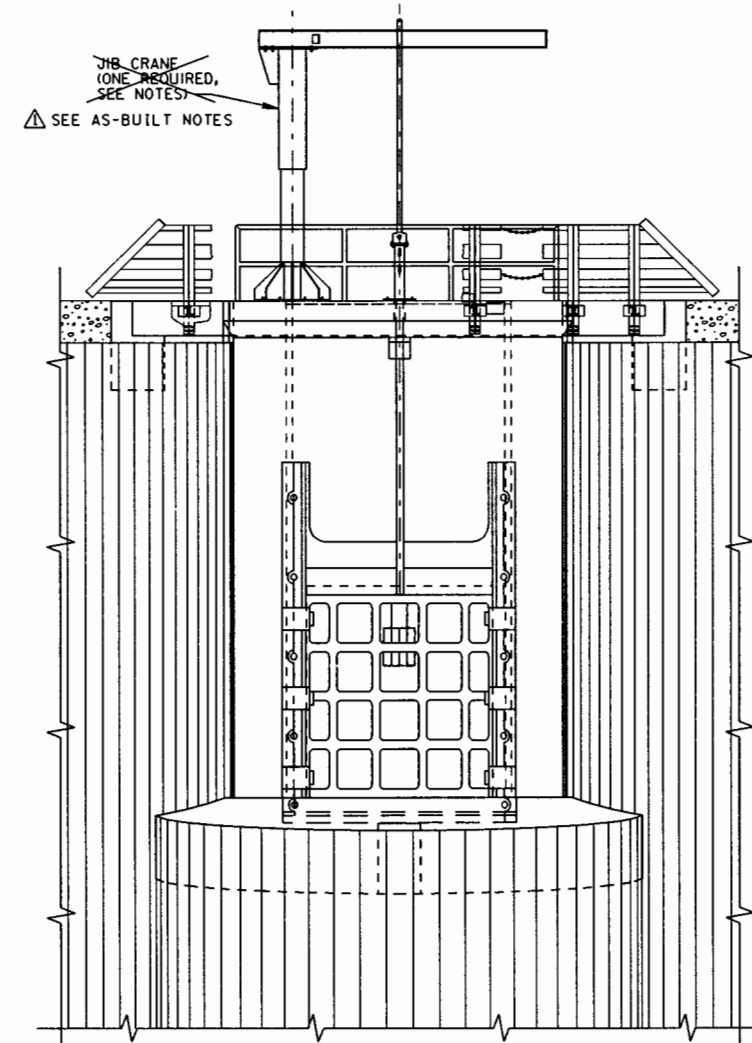


NOTES:

1. REINFORCING STEEL MAY BE SHIFTED TO CLEAR H-PILE AND FIELD BENT AT INSPECTION PORTS.
2. INSPECTION PORTS ARE 24 INCH DIA. WATERTIGHT, WITH BOLTED LID (NEENAH R-1916 OR R-6461 OR EQUIVALENT).
3. H-PILES AND GATE NOT SHOWN ON THIS SHEET.
4. HYDROPHILIC WATER STOP (SEE SPECIFICATIONS SECTION 03150) SHALL BE ATTACHED TO SHEET PILES AROUND PERIMETER OF SLAB AND TO SHEET PILE ADJACENT TO WALL BEFORE PLACEMENT OF CONCRETE.
5. ARC CELL SHEET PILE SHALL EXTEND TO AT LEAST ELEVATION 445 FOR FLOOD PROTECTION DURING CONSTRUCTION. IT MUST BE BRACED; BRACING MUST BE DESIGNED BY A PROFESSIONAL ENGINEER AND DESIGN MUST BE SUBMITTED FOR APPROVAL.

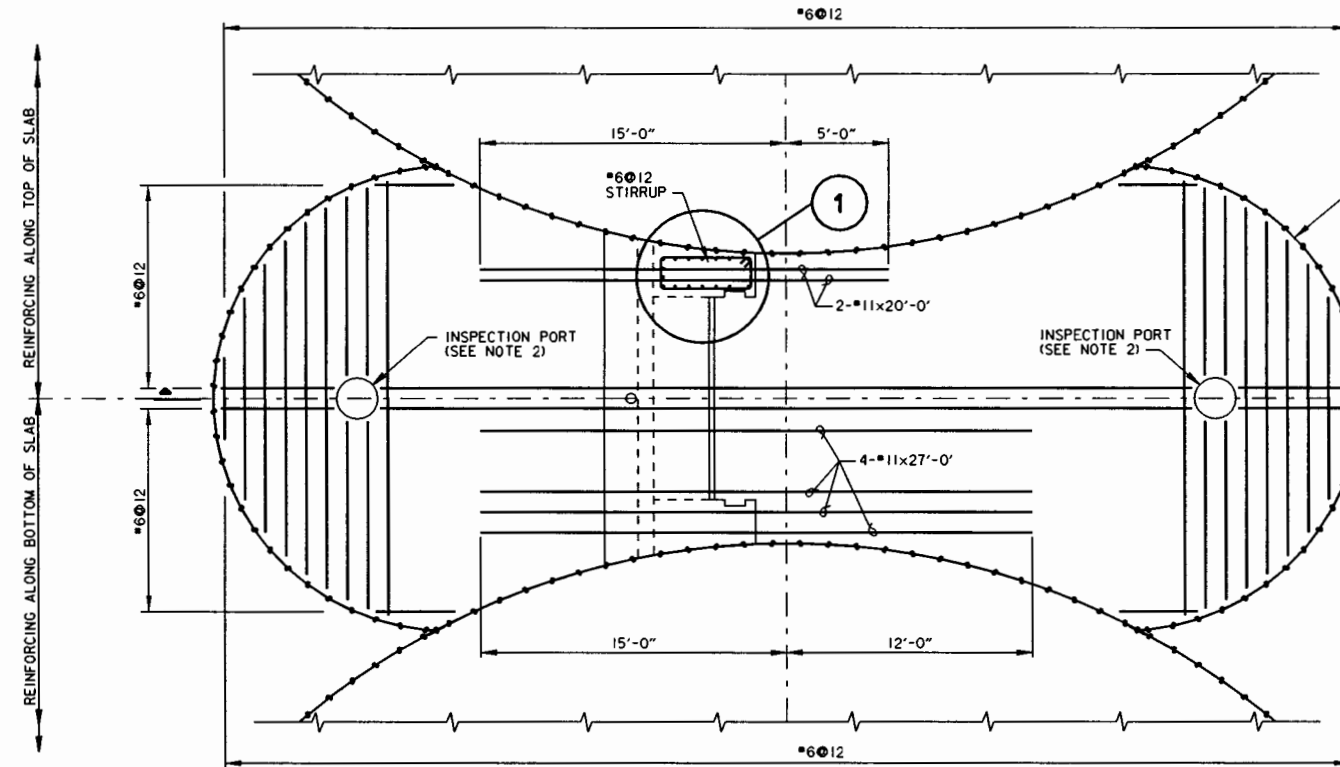


PLAN  
CELL FLOODWAY  
(3 REQ'D)

12' 0' 5'

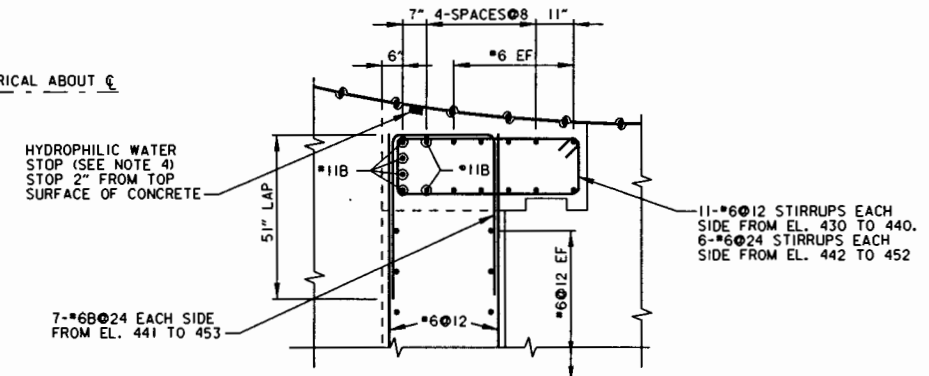


DETAIL 1

12' 0' 5'

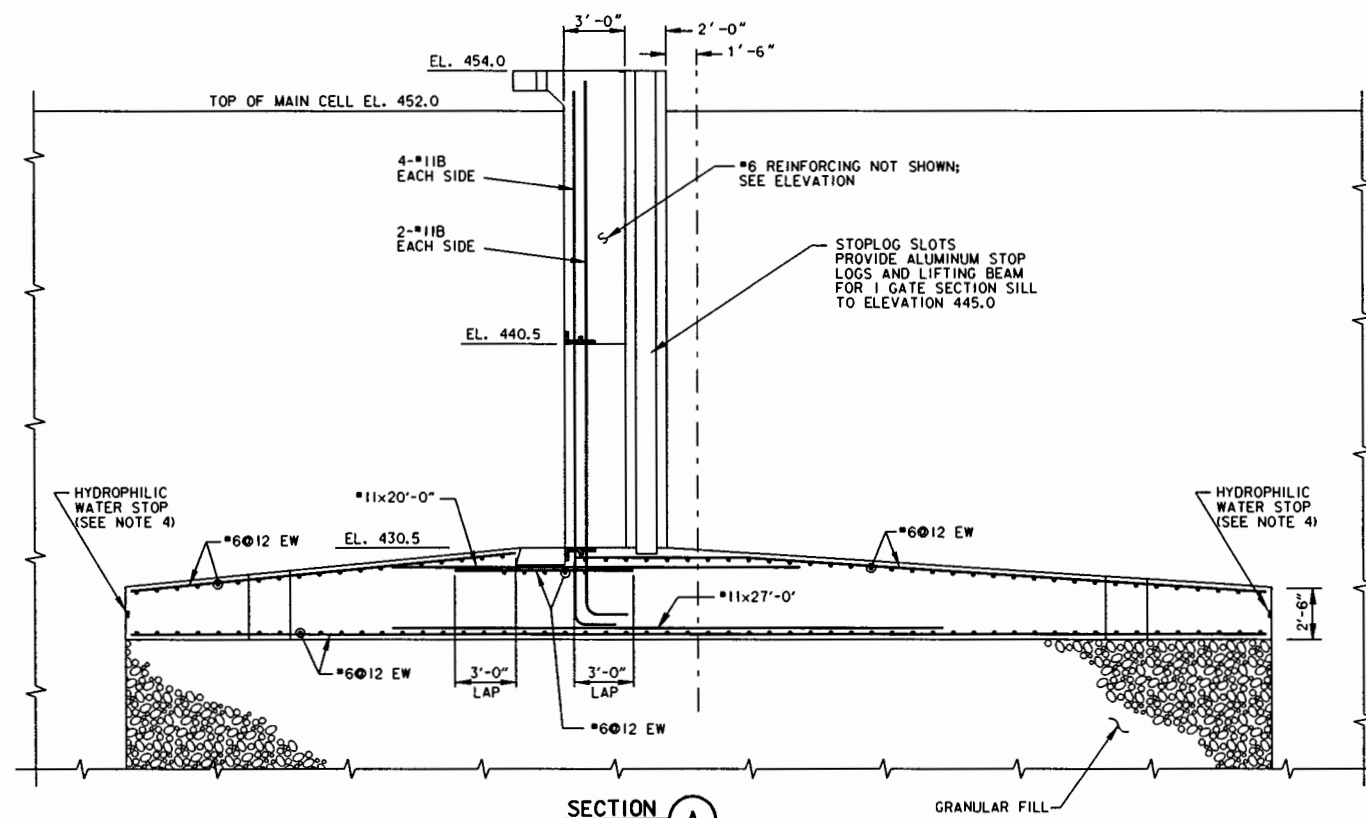

SECTION A

12' 0' 5'

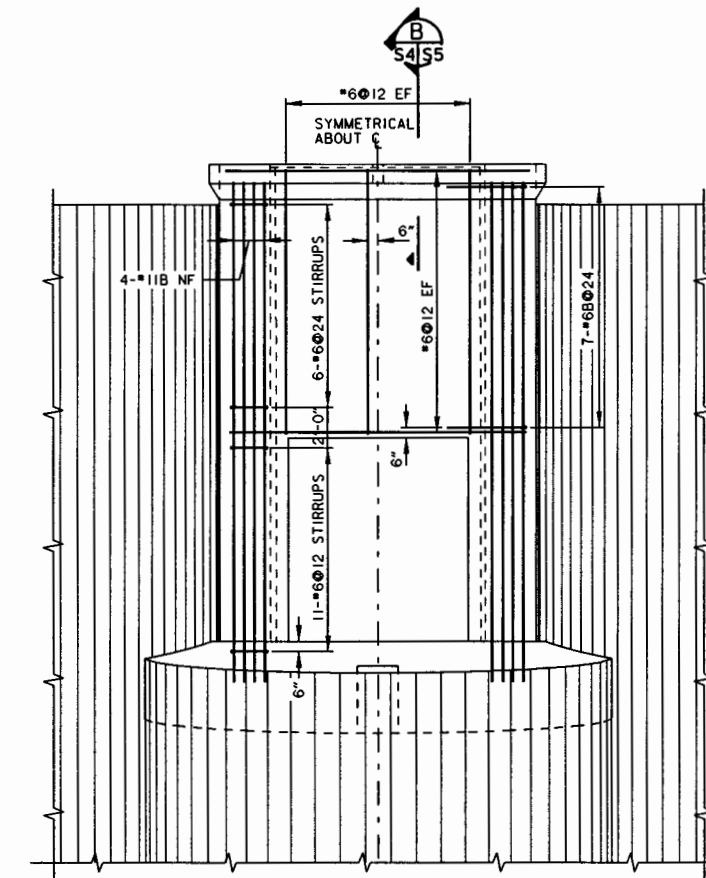

ELEVATION  
CELL FLOODWAY  
(3 REQ'D)


12' 0' 5'

| Designated By:                                                             | Drawn By: | Checked By: | Reviewed By: | Date:    | Scale:   | Revision:  | Symbol: | Description: | Revisions: |
|----------------------------------------------------------------------------|-----------|-------------|--------------|----------|----------|------------|---------|--------------|------------|
| WM                                                                         | DAP       | HD          | RCA          | MAR 1999 | AS SHOWN | 1-1-3-1/67 |         |              |            |
| U.S. ARMY ENGINEER DISTRICT<br>CORPS OF ENGINEERS<br>ROCK ISLAND, ILLINOIS |           |             |              |          |          |            |         |              |            |

ILLINOIS WATERWAY  
ENVIRONMENTAL MANAGEMENT PROGRAM  
LA GRANGE POOL, MILE 124 TO 129.5  
LAKE CHATAQUA  
OPERATIONS AND MAINTENANCE  
SLAB AND WALL  
REINFORCEMENT

Sheet  
Reference  
Number:  
**S40**  
Sheet 30 of 84



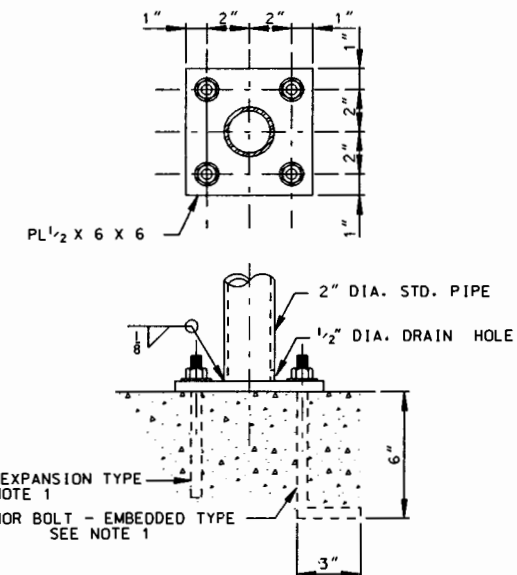


### TYPICAL HANDRAIL SECTIONS


ANCHOR BOLT - EXPANSION TYPE →  
SEE NOTE 1

ANCHOR BOLT - EMBEDDED TYPE  
SEE NOTE 1

### BASE PLATE DETAIL

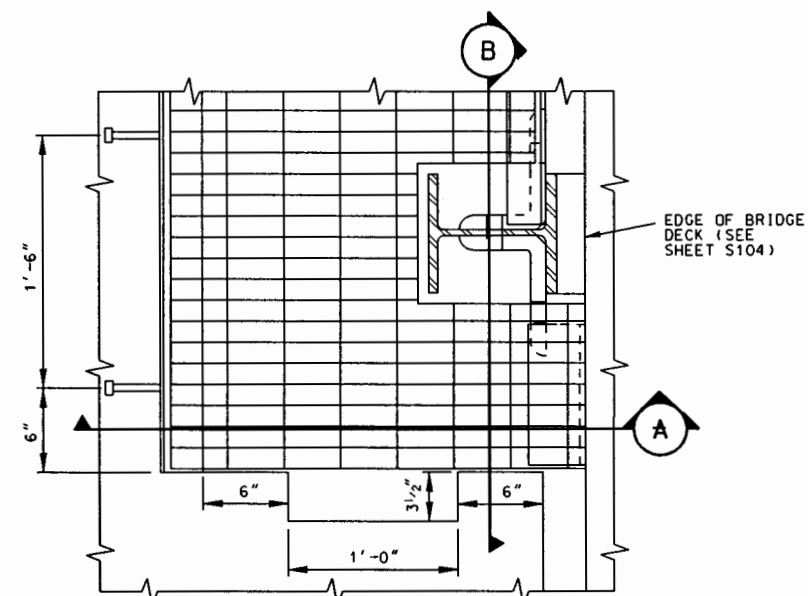

GRATE PLATFORM DETAIL (1)

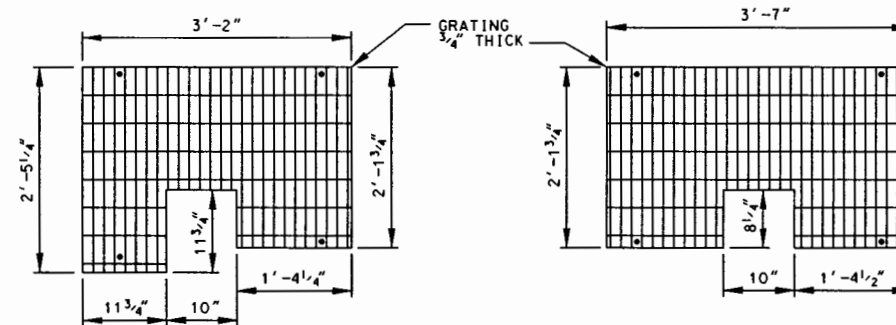


END GRATE

3 (6 REQ'D)  
3 THUS, 3 OPPOSITE HAND




## GRATING

CENTER GRATE

(3 REQ'D)

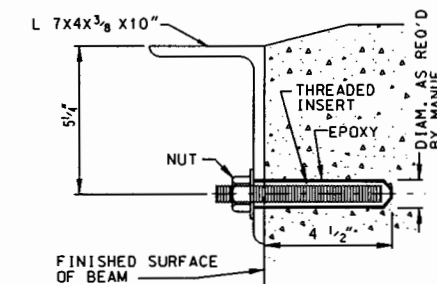


TYPICAL - ANCHOR BOLT DETAIL

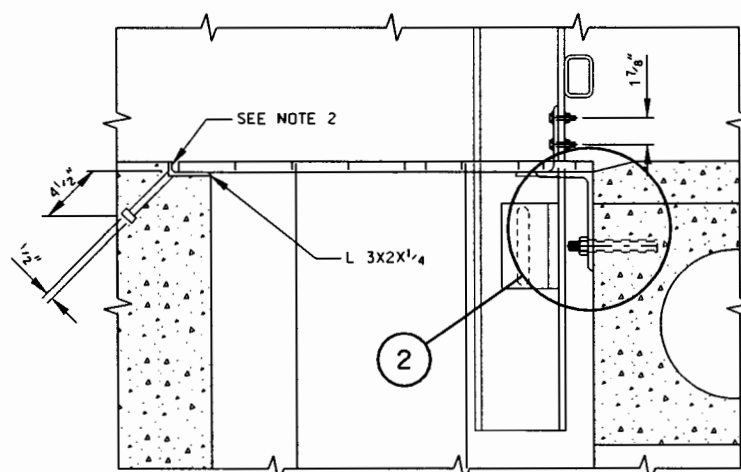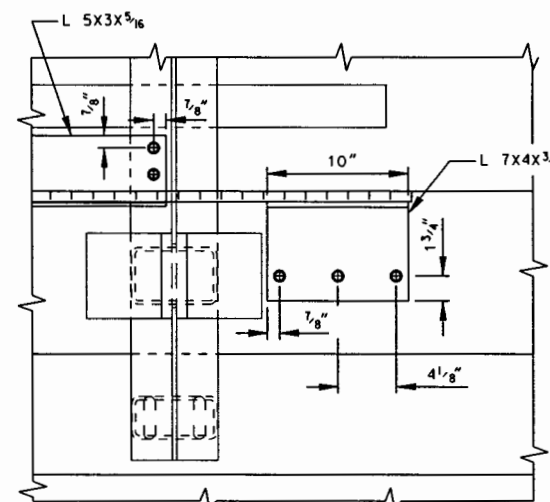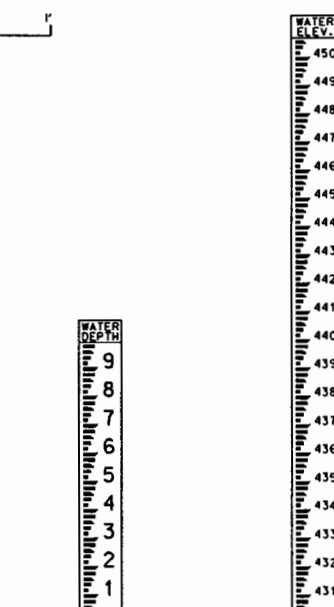SECTION           SECTION B

WATER DEPTH  
(2 REQ'D)

WATER ELEVATION  
(2 REQ'D)

GAUGES  
(NO SCALE)

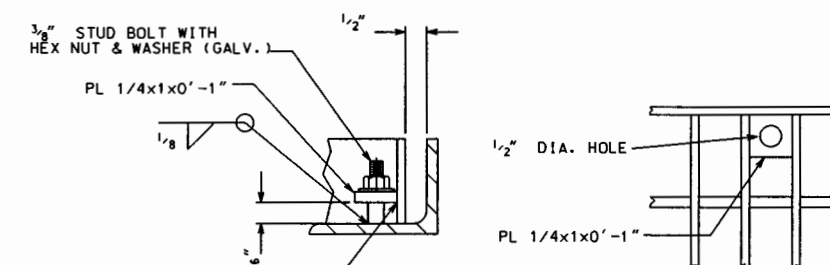

## GRATING FASTENER DETAILS

GRATING NOTES:  
BAND ENDS OF BEARING BARS WITH BAR  $\frac{3}{4} \times \frac{1}{8}$   
BEARING BARS ARE  $\frac{3}{4} \times \frac{1}{8}$  ON  $\frac{1}{16}$  CENTERS.  
CROSS BARS ARE AT 4".  
PROVIDE FASTENER AT EACH CORNER AS SHOWN.  
THE FRAME AND GRATING ARE TO BE STEEL HOT DIP  
GALVANIZED IN ACCORDANCE WITH ASTM-123, AFTER  
FABRICATION.

NOTES:

1. ANCHOR BOLTS  $1\frac{1}{2}$ " DIAMETER, EITHER EMBEDDED OR EXPANSION TYPE. EXPANSION BOLTS SHALL BE A MINIMUM EMBEDMENT OF 5 INCHES, 4000 LB ULTIMATE PULLOUT, AND 6000 LB ULTIMATE SHEAR. ALL ANCHOR BOLTS AND NUTS SHALL BE GALVANIZED.
2. SAW CUT VERTICAL (2") LEG TO MATCH DEPTH OF SUPPLIED GRATING, SO THAT GRATING IS FLUSH WITH PLATFORM AND ROAD SURFACE.
3. WELD ALL PIPE JOINTS WITH CONTINUOUS BEAD, SIZE EQUAL TO PIPE WALL THICKNESS, AND DRESS SMOOTH. GALVANIZE SUPPORT ANGLES AND HANDRAIL AFTER FABRICATION.



US Army Corps  
of Engineers  
Rock Island  
District

[illegible]

|                                                                            |                  |                                          |
|----------------------------------------------------------------------------|------------------|------------------------------------------|
| U.S. ARMY ENGINEER DISTRICT<br>CORPS, FORT MONROE<br>ROCK ISLAND, ILLINOIS | Designed By: MM  | Date: MAR 1999                           |
|                                                                            | Drawn By: BILL   | Scale: AS SHOWN                          |
|                                                                            | Checked By: HD   | Drawing Code: 1/67                       |
|                                                                            | Reviewed By: RCA | Solicitation Number:<br>DACW25-92-R-0013 |


**ILLINOIS WATERWAY  
ENVIRONMENTAL MANAGEMENT PROGRAM  
LA GRANGE POOL, MILE 124 TO 129.5  
LAKE CHAUTAUQUA  
OPERATIONS AND MAINTENANCE**

Sheet  
Reference  
Number:  
**S60**  
Sheet 32 of 84













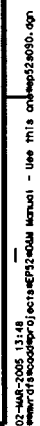



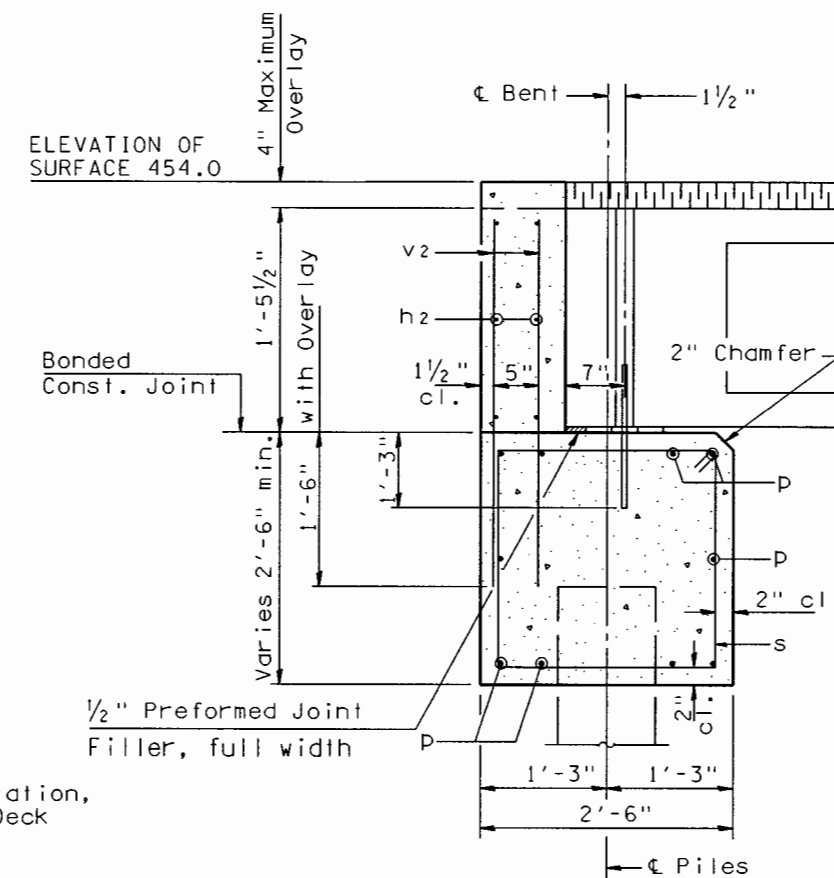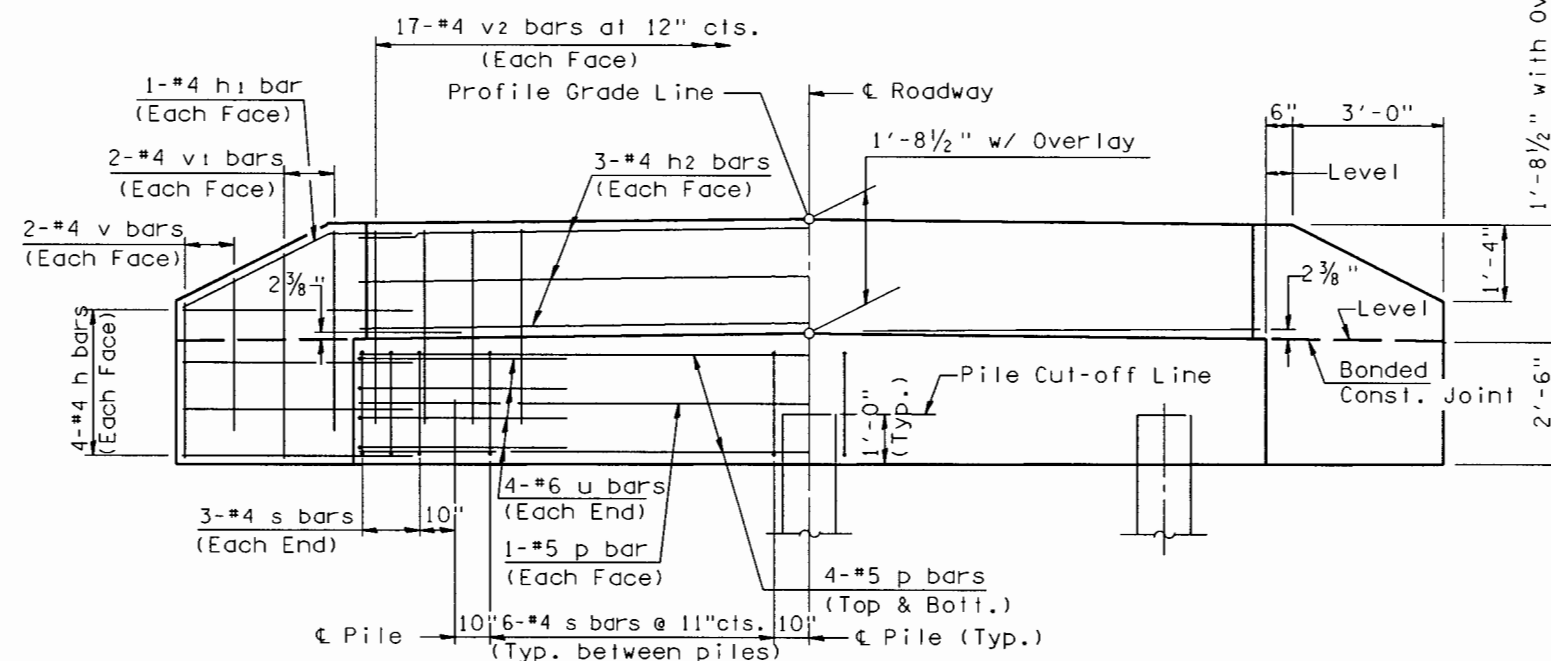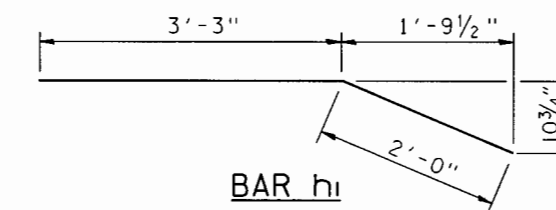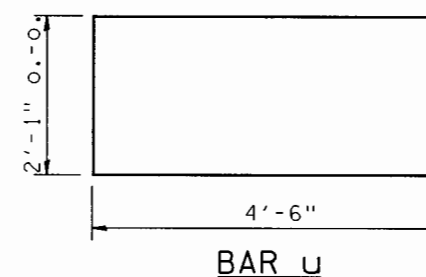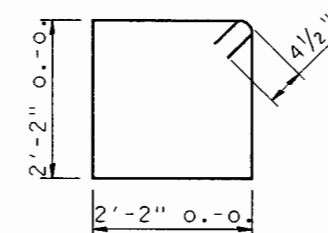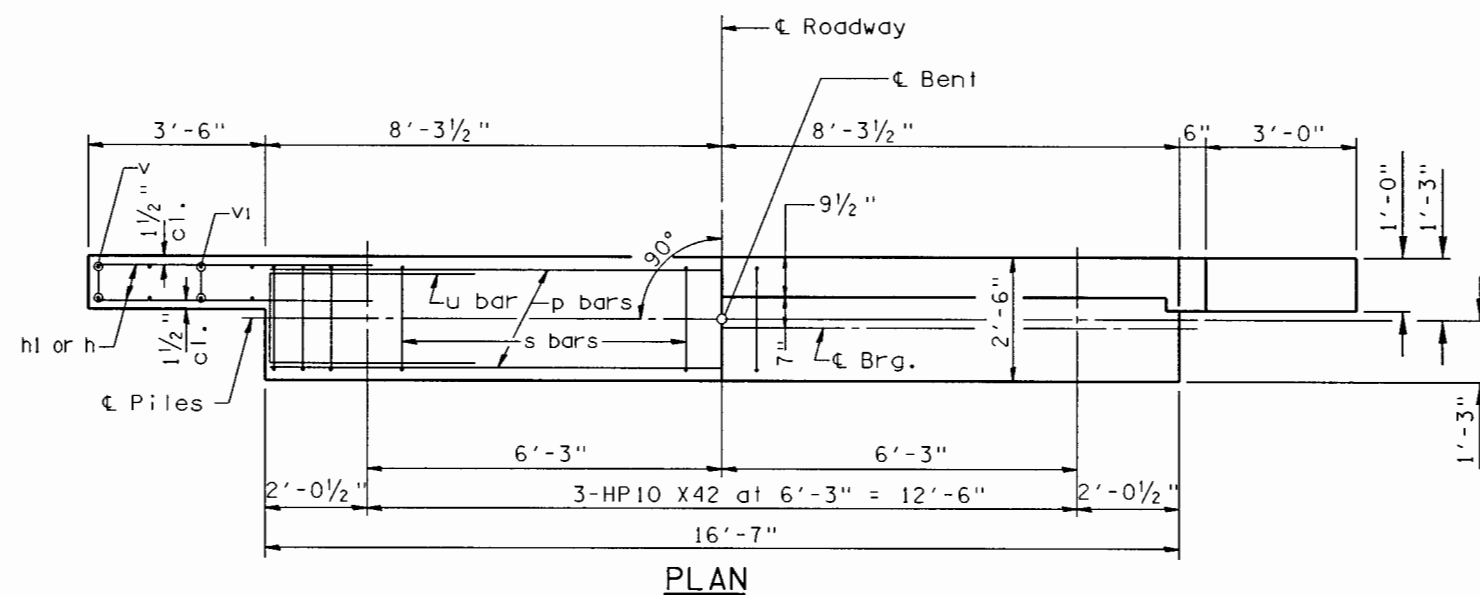

BILL OF MATERIAL  
FOR ONE ABUTMENT

| Bar            | No. | Size | Length | Shape |
|----------------|-----|------|--------|-------|
| h              | 16  | #4   | 5'-0"  | —     |
| h <sub>1</sub> | 4   | #4   | 5'-3"  | —     |
| h <sub>2</sub> | 6   | #4   | 16'-3" | —     |
|                |     |      |        |       |
| p              | 10  | #5   | 16'-3" | —     |
|                |     |      |        |       |
| s              | 18  | #4   | 9'-5"  | □     |
|                |     |      |        |       |
| u              | 8   | #6   | 11'-1" | —     |
|                |     |      |        |       |
| v              | 8   | #4   | 2'-6"  | —     |
| v <sub>1</sub> | 8   | #4   | 3'-5"  | —     |
| v <sub>2</sub> | 34  | #4   | 3'-1"  | —     |

|                     |             |
|---------------------|-------------|
| Concrete Structures | 8.3 Cu.Yds. |
| Reinforcement Bars  | 860 Lbs.    |





### DESIGN STRESSES

$f'_c = 3,500$  psi  
 $f_y = 60,000$  psi



NOTES:

1. Base drawing copied from Illinois Department of Transportation, Standard Plans, Volume I: Precast Prestressed Concrete Deck Beam Bridges, 1 Nov 1995.
2. The Backwall and the portion of the Wingwalls above the bonded construction joint shall be cast against the in-place beam.
3. Reinforcement bars shall conform to Grade 60, AASHTO M31, M42 or M53.



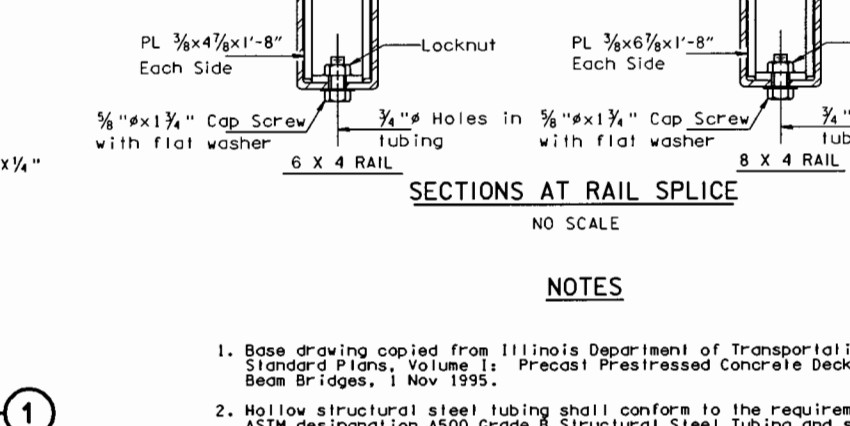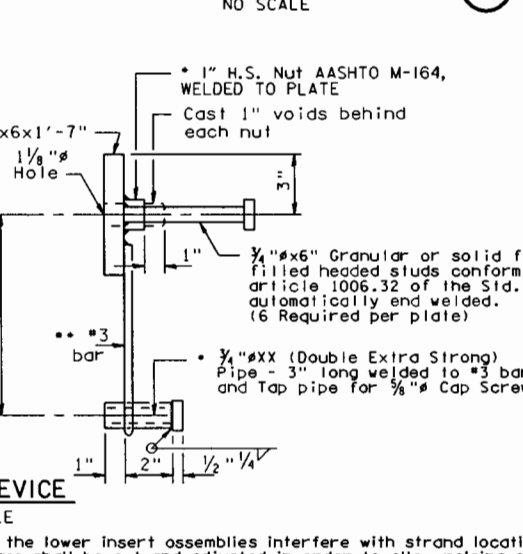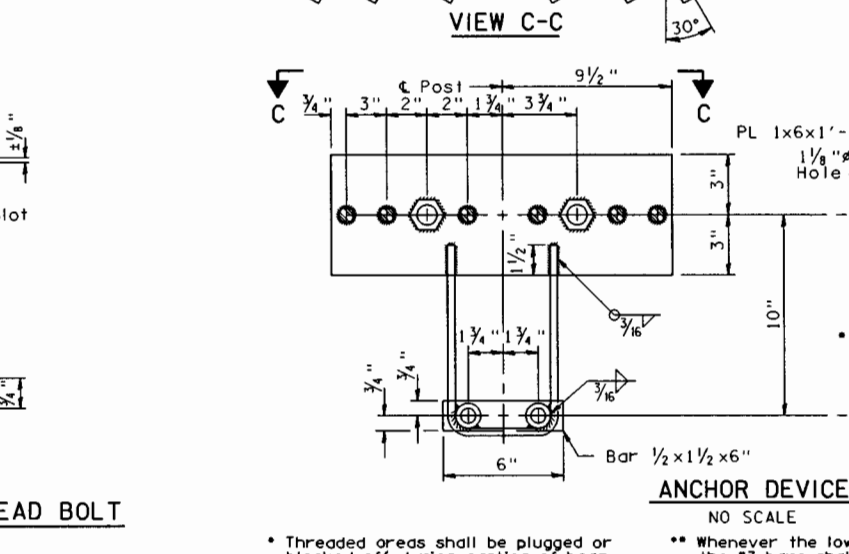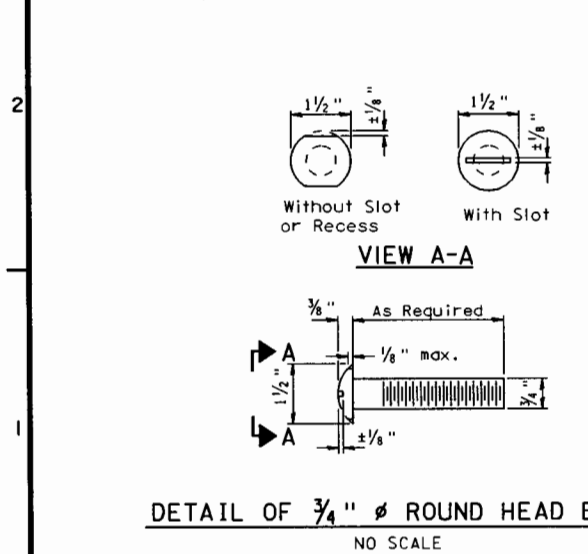

1. Base drawing copied from Illinois Department of Transportation, Standard Plans, Volume I: Precast Prestressed Concrete Deck Beam Bridges, 1 Nov 1995.
2. Hollow structural steel tubing shall conform to the requirements of ASTM designation A500 Grade B Structural Steel Tubing and shall meet the longitudinal CVN requirements of 15 ft-lbs at 0° F.
3. All other steel shapes and plates shall conform to the requirements of AASHTO M270 Grade 36 except posts and angles shall conform to AASHTO M270, Grade 50.
4. Bolts, cap screws, and nuts shall conform to the requirement of ASTM designation A307 except for high strength bolts, nuts and washers noted which shall conform to AASHTO M164.
5. All bolts, nuts, cap screws, washers and lock washers shall be galvanized in accordance with AASHTO M232.
6. All posts, railing, rail splices, anchor devices and angles shall be galvanized after shop fabrication in accordance with AASHTO M111 and ASTM A385. Galvanized rail shall not be painted.
7. All field drilled holes shall be coated with an approved zinc rich paint before erection.
8. The  $\frac{3}{4}$ " high strength bolts used to connect the 6 x 4 x  $\frac{3}{4}$ " angles to the post shall be tightened in accordance with Article 505.04(f)(3) of the Standard Specifications. The 1" high strength bolts connecting the angles to the concrete shall be tightened to a snug fit and given an additional  $\frac{1}{4}$  turn. The  $\frac{3}{8}$ " cap screws in bottom of posts shall be tightened to a snug fit only.
9. The  $\frac{1}{2}$ " x 6" x 7" plates that come in contact with concrete shall receive two coats of asphalt paint conforming to Section 1060.07 Type II or place  $\frac{1}{8}$ " fabric bearing pads between the plates and concrete.
10. The maximum allowable rail post spacing shall be 6'-3".
11. Weld end caps with  $\frac{1}{4}$ " continuous bead and dress smooth.

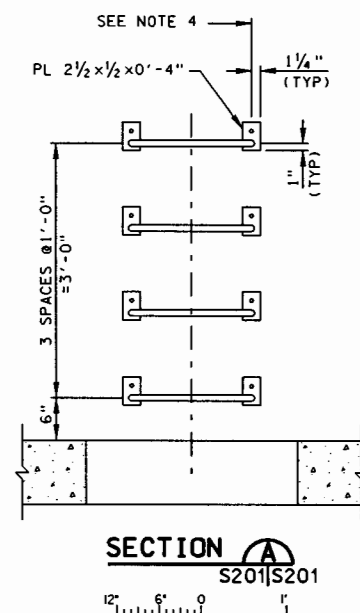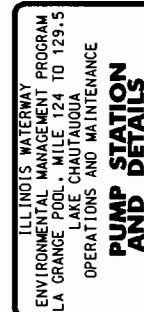

- NOTES:
1. ANCHOR BOLTS SHALL BE  $\frac{1}{2}$ " DIA. HAVE AT LEAST 5 INCH EMBEDMENT, 4000 POUND ULTIMATE PULLOUT AND 6000 POUND ULTIMATE SHEAR STRENGTH. ALL ANCHOR BOLTS AND FASTENERS SHALL BE GALVANIZED.
  2. WELD ALL PIPE JOINTS WITH CONTINUOUS BEAD, SIZE EQUAL TO PIPE WALL THICKNESS, AND DRESS SMOOTH.
  3. GALVANIZE HANDRAIL AFTER FABRICATION.
  4. CONTRACTOR SHALL VERIFY THAT THE WALL-MOUNTED HAND RUNGS WILL NOT INTERFERE WITH THE ACCESS COVER BELOW. IF NECESSARY, THE  $2\frac{3}{4}$ " RUNG DEPTH MAY BE REDUCED SLIGHTLY TO ENSURE CLEARANCE BETWEEN THE RUNGS AND ACCESS COVER.



439.0




**NOTES:**

1. EXISTING STOPLOG SLOTS SHALL BE REMOVED. REPLACE BOTTOM 15 FT. WITH NEW STOPLOG SLOT SHOWN. CUT 10 FT OF THE EXISTING STOPLOG AND PLACE AT TOP.
2. TOP OF NEW STOPLOG SLOT SHALL BE TAPERED TO MATCH EXISTING STOPLOG SLOT AS SHOWN IN STOPLOG SLOT JOINT SECTION.
3. FIELD ADJUST SPACING TO PROVIDE CLEARANCE BETWEEN NEW BOLTS AND EXISTING BOLTS 3" MIN. 6" MAX.
4. 2 STOPLOG SLOTS ARE REQUIRED IN EACH OF 3 GATEWELLS.
5. THE CONTRACTOR SHALL DEWATER THE GATEWELLS OR PERFORM UNDERWATER WORK. THE CONTRACTOR SHALL SUBMIT HIS PLAN TO ACCOMPLISH THE WORK.
6. THE CONTRACTOR MAY INSTALL THE UPPER LAKE SLOTS WHEN THE UPPER LAKE IS DEWATERED.
7. THE USFWS NORMALLY DEWATERS THE LOWER LAKE EACH YEAR DEPENDING ON RIVER LEVELS. THE USFWS DEWATERING OPERATION SHALL NOT BE INTERFERED WITH AND THE CONTRACTOR SHALL MEET ALL USFWS REQUIREMENTS. WRITTEN COORDINATION WITH USFWS WILL BE REQUIRED. ADDITIONAL CONTRACTOR DEWATERING IS ANTICIPATED TO LOWER WATER LEVELS BELOW THE SLOTS.
8. WATER LEVELS AT THE RIVER SIDE STOP LOG SLOTS ARE CONTROLLED BY WATER LEVELS IN THE RIVER NAVIGATION CHANNEL. THE CONTRACTOR MAY NOT BLOCK THE TRASH RACK; HOWEVER, THE TRASH RACK MAY BE TEMPORARILY REMOVED AND THE 5' x 5' BOX CULVERT OPENING MAY BE TEMPORARILY PLUGGED. THE DETAILS AND DESIGN OF THIS SYSTEM IS THE CONTRACTOR'S RESPONSIBILITY AND SHALL BE SUBMITTED TO THE CONTRACTING OFFICER FOR REVIEW AND APPROVAL.









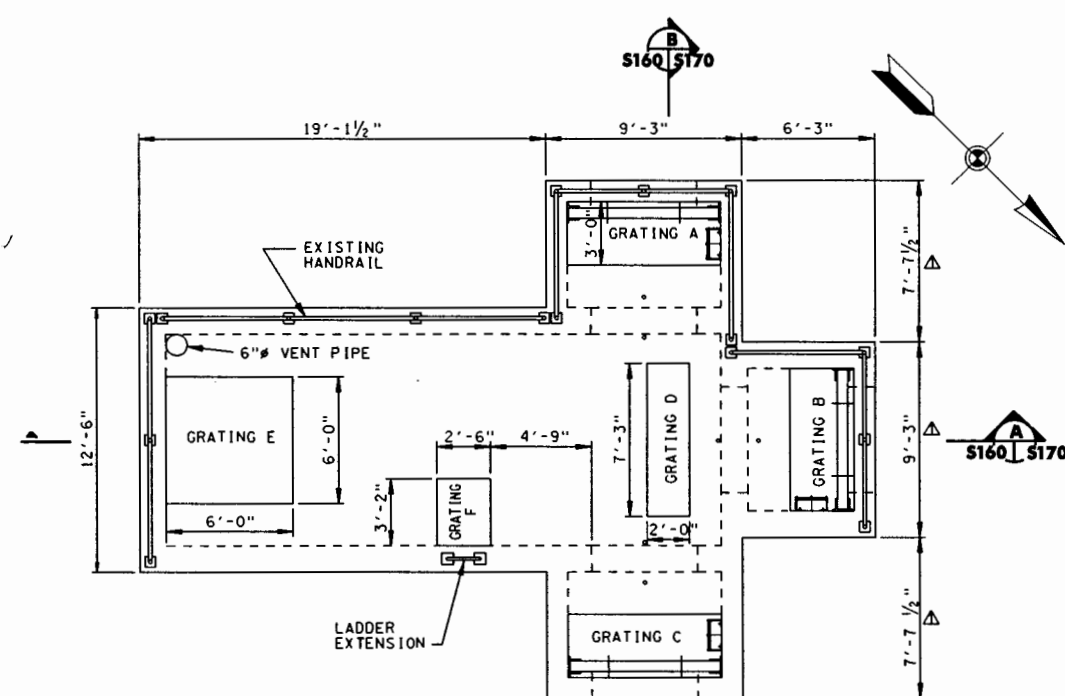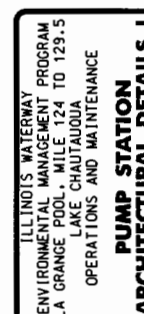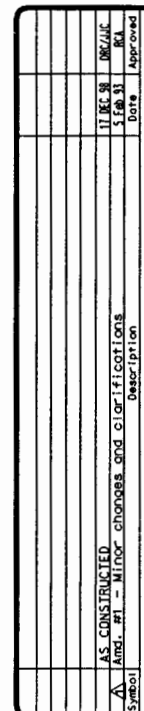

## PLAN

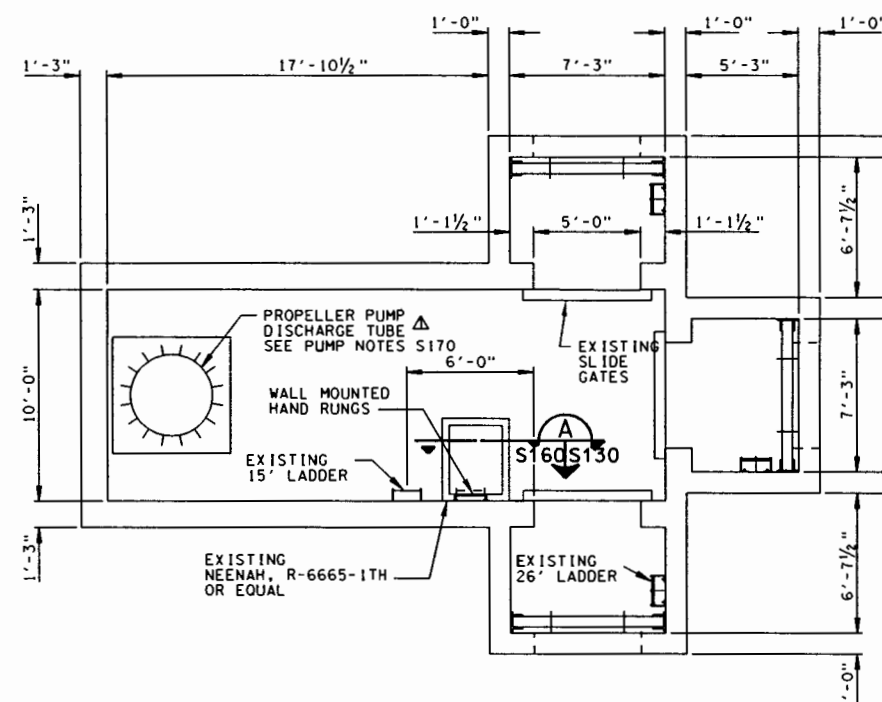

SECTION AT EL. 437.5

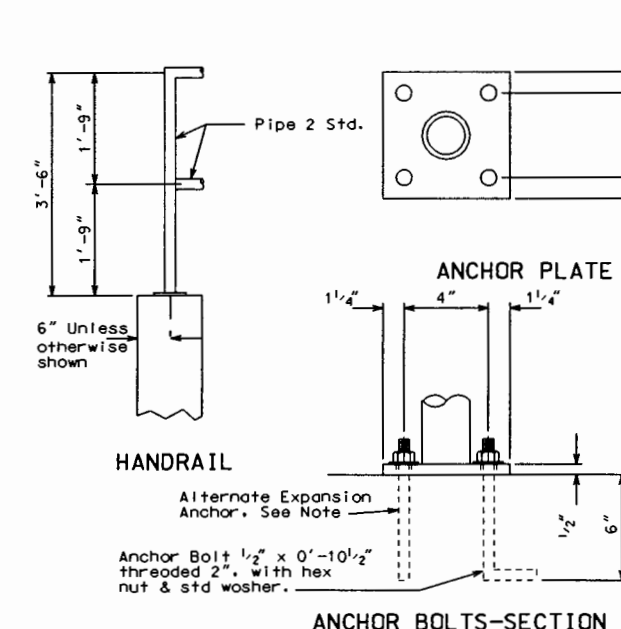


- NOTES:
1. Anchor bolts-either embedded bolts or expansion bolts may be used. Expansion bolts shall be 1/2" dia., have at least 5 inch embedment, 4000 lb. ultimate pullout and 6000 lb. ultimate shear. All anchor bolts and fasteners to be galvanized.
  2. Weld all pipe joints with continuous bead, size equal to pipe wall thickness, and dress smooth.
  3. Handrail to be galvanized after fabrication.


REFERENCE:  
1. For Ladder Details, see Sheet S-3.

| LOCATION   | A     | B     | NO. OF SECTIONS |
|------------|-------|-------|-----------------|
| Grating A  | 7'-3" | 3'-0" | 3               |
| Grating B  | 7'-3" | 3'-0" | 3               |
| Grating C  | 7'-3" | 3'-0" | 3               |
| Grating D  | 7'-3" | 2'-0" | 2               |
| Grating E* | 6'-0" | 6'-0" | 2               |
| Grating F  | 3'-2" | 2'-6" | 2               |

\*1/8" raised pattern floor plate to match and welded to grating. Notch corners for access to fasteners. Provide two handles for each grating.

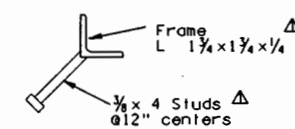


**STUD DETAIL**  
**NO SCALE**

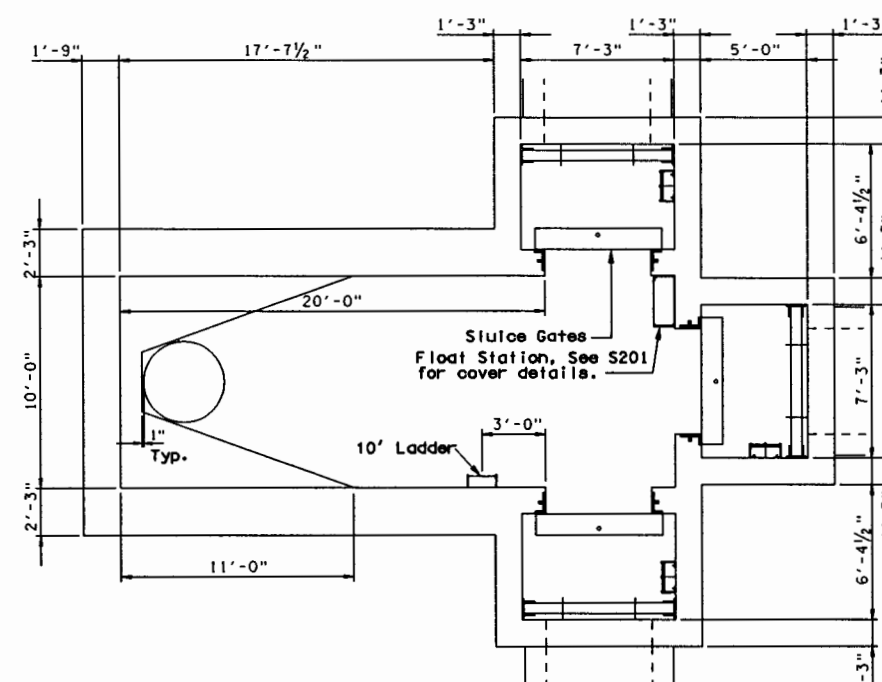


SECTION AT EL. 427

SCALE:  $\frac{1}{4}'' = 1'-0''$

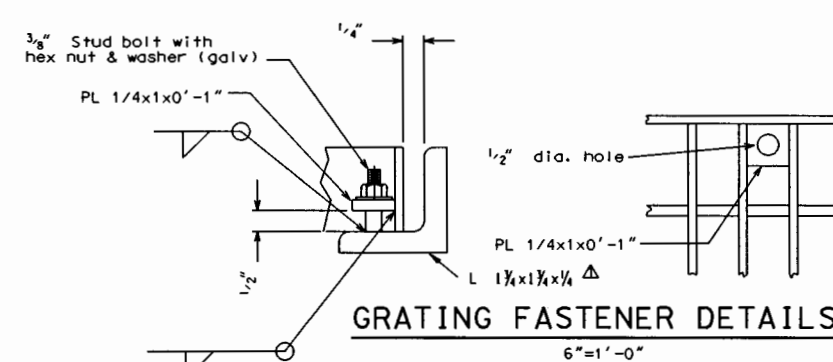


### GRATING FASTENER DETAILS

GRATING NOTES:  
Bond ends of bearing bars with bar  $1\frac{1}{2} \times 3/16$ .  
Bearing bars are  $1\frac{1}{2} \times \frac{3}{16}$  on  $1\frac{1}{16}$  centers.  
Cross bars are at 4".  
Provide fastener at each corner as shown.  
Grating is to be serrated type.  
In frame and grating are to be steel hot dip  
galvanized in accordance with ASTM A-123, after  
fabrication.  
Bearing bars to be in B direction.  
All gratings for an opening will be approx.  
the same size.

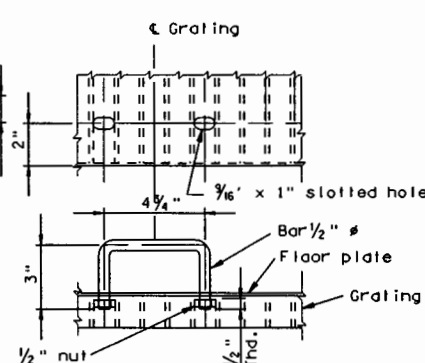

HANDLE DETAIL  
GRATING F

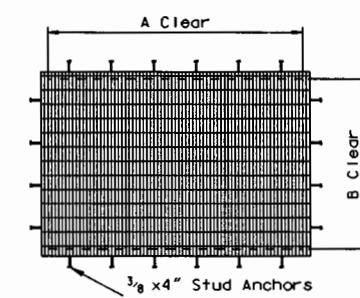

### GRATING AND FRAME DETAILS




| Symbol | Description            | Revisions |
|--------|------------------------|-----------|
| REVIS  | REVISED AS CONSTRUCTED |           |
| DATE   | APPROVED               |           |


|              |     |                       |                  |
|--------------|-----|-----------------------|------------------|
| Designed By: | MDW | Date:                 | MAR 1999         |
| Drawn By:    | JRK | Scale:                | AS SHOWN         |
| Checked By:  | TJW | Drawing Code:         | 1-L-1-3-1-1/67   |
| Reviewed By: | RCA | Specification Number: | DACW25-97-B-0032 |

ILLINOIS WATERWAY PROGRAM  
ENVIRONMENTAL MANAGEMENT  
LA GRANGE POOL, MILE 12.4 TO 129.5  
LAKE CHATAQUA  
OPERATIONS AND MAINTENANCE  
**PUMP STATION ARCHITECTURAL DETAILS II**


Sheet Reference Number:  
**S170**  
Sheet 43 of 84

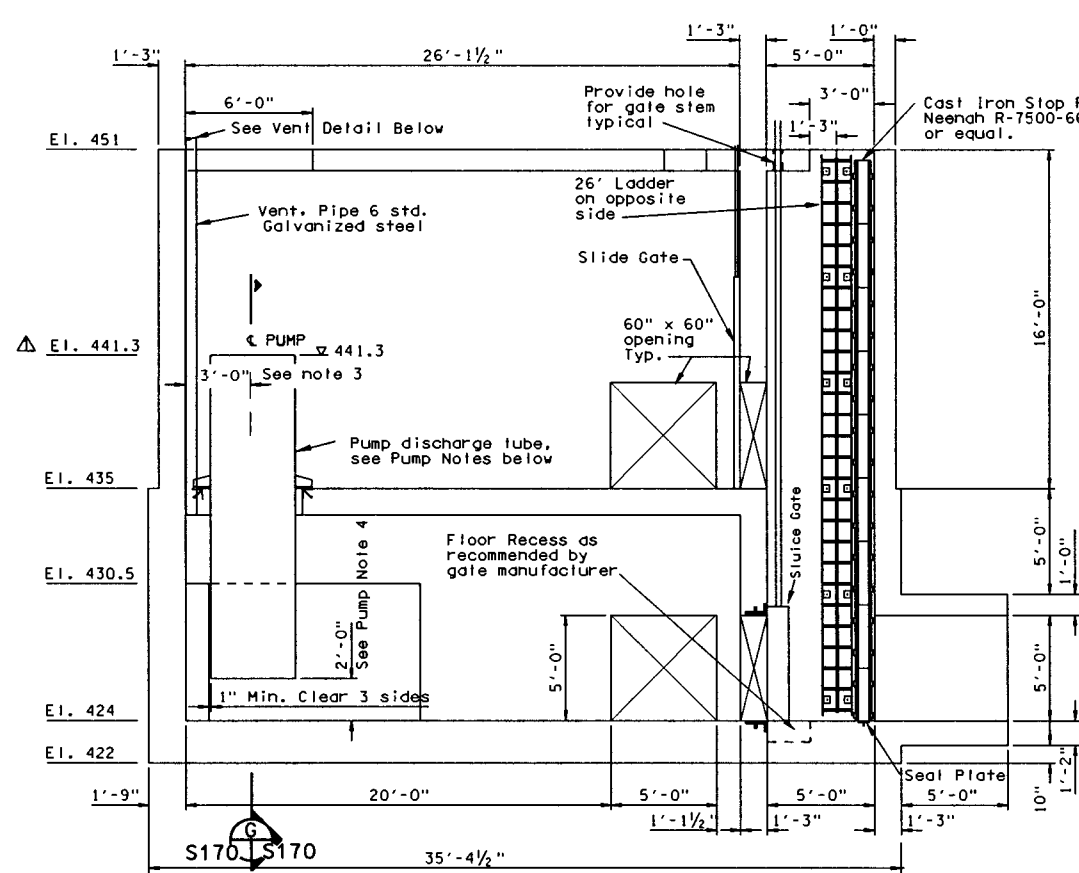

**SECTION A-A**  
S160 S170

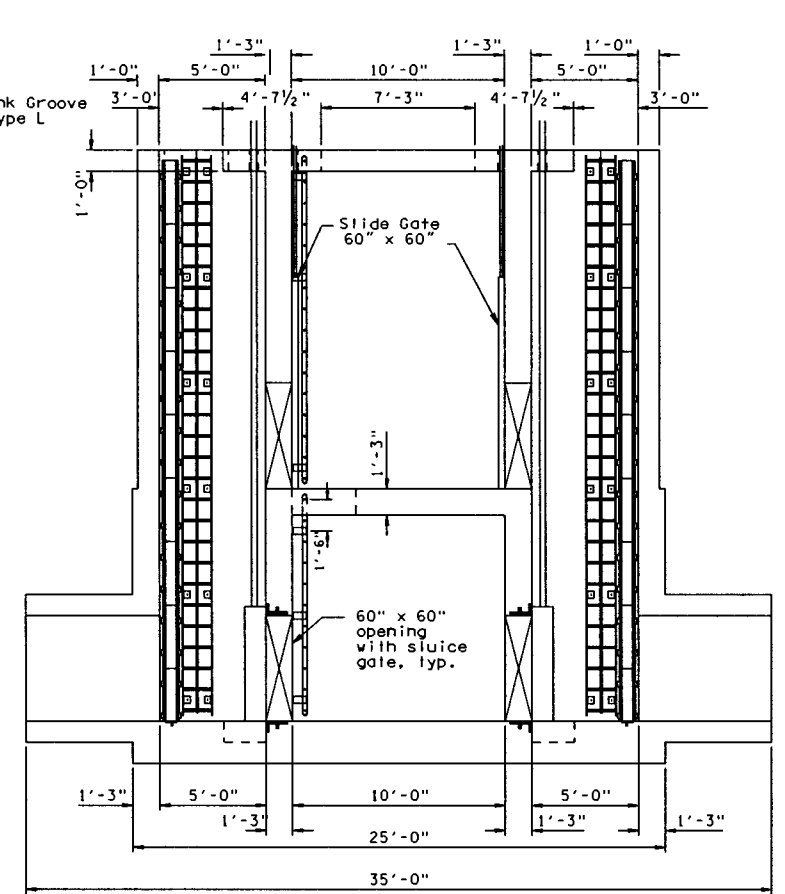

**SECTION B-B**  
S160 S170

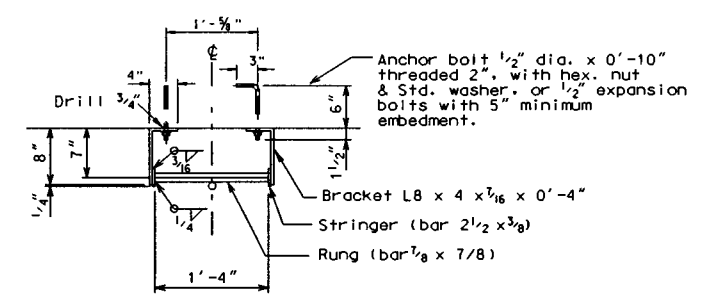


**LADDER DETAIL**

SCALE: 1" = 1'-0"  
12" 6" 0 1'


- SLUICE GATE NOTES:**
1. SEATING HEAD=25', UNSEATING HEAD=15'.
  2. ALL SLUICE GATES SHALL BE CAST IRON, FLATBACK, FLUSH BOTTOM, RISING STEM, WITH TOP AND SIDE WEDGES AND BRONZE LIFTING NUTS.
  3. ALL WALL THIMBLES SHALL BE "E" TYPE WITH SQUARE OPENINGS AND SQUARE FLANGES.
  4. PEDESTAL LIFTS SHALL BE CRANK OPERATED HAVING 25 POUND MAXIMUM CRANK PULL AND SHALL BE OF THE ENCLOSED TYPE.
  5. STEMS SHALL BE FABRICATED OF STAINLESS STEEL.
  6. PEDESTAL LIFTS SHALL HAVE GALVANIZED STEEL STEM COVERS.
  7. LOCATE PEDESTAL LIFTS AND ACCESSORIES FROM DIMENSIONS FURNISHED BY THE GATE MANUFACTURER.
  8. ALL ANCHOR BOLTS FOR GATES AND ACCESSORIES SHALL BE SUPPLIED BY GATE MANUFACTURER.
  9. PROVIDE STEM GUIDES AS REQUIRED.

- SLIDE GATE NOTES:**
1. SEATING HEAD =10', UNSEATING HEAD =12'.
  2. ALL SLIDE GATES SHALL BE FABRICATED FROM STEEL, EMBEDDED FRAME, FLATBACK, FLUSH BOTTOM, RISING STEM, NON SELF-CONTAINED.
  3. STEMS SHALL BE STAINLESS STEEL.
  4. PEDESTAL LIFTS SHALL HAVE GALVANIZED STEEL STEM COVERS.
  5. LOCATE PEDESTAL LIFTS AND ACCESSORIES FROM DIMENSIONS FURNISHED BY THE GATE MANUFACTURER.
  6. ALL ANCHOR BOLTS FOR GATES AND ACCESSORIES SHALL BE SUPPLIED BY GATE MANUFACTURER.
  7. PROVIDE STEM GUIDES AS REQUIRED.

- PUMP NOTES:**
1. SEE SPECIFICATIONS FOR PUMP REQUIREMENTS.
  2. DISCHARGE TUBE SUPPORT PLATE AND GUSSETS SHALL BE DETAILED AND FABRICATED BY PUMP MANUFACTURER.
  3. ADJUST LOCATION AND SIZE OF PUMP TUBE OPENING IN SLAB, IF NECESSARY TO FIT ACTUAL SELECTED PUMP.
  4. ADJUST DISCHARGE TUBE/SUMP FLOOR CLEARANCE AS RECOMMENDED BY PUMP MANUFACTURER.
  5. INSTALL SUPPORTS (NOT SHOWN) NEAR PUMP IMPELLER AND AT OTHER LOCATIONS DEEMED NECESSARY, AS DETAILED AND FABRICATED BY PUMP MANUFACTURER.
  6. MOTOR CABLE PENETRATIONS SHALL BE DETACHABLE FROM PIPING FOR EASE OF INSTALLATION AND MAINTENANCE.
  7. SEE ELECTRICAL SHEETS E-10 THROUGH E-40 FOR PUMP ELECTRICAL DETAILS.

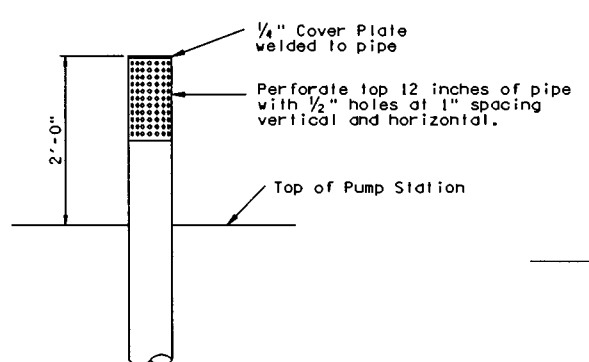

**VENT PIPE DETAIL**

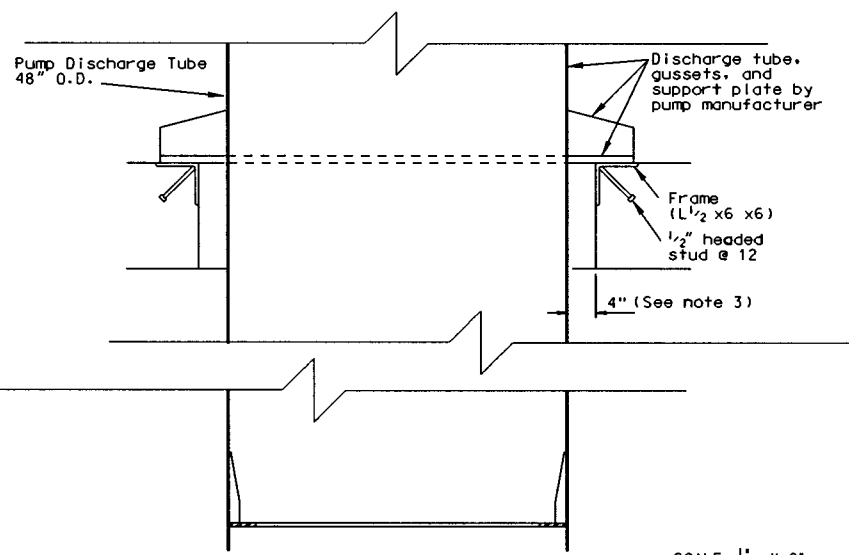

**SECTION C-C**  
S170 S170

SCALE: 1/4" = 1'-0"  
12" 6" 0 1'

**PUMP STATION LADDER TABLE**

| LOCATION   | LENGTH | QUANTITY | SAFETY DEVICE & EXTENSION |
|------------|--------|----------|---------------------------|
| GATEWELLS  | 26'    | 3        | YES                       |
| U PUMP BAY | 15'    | 1        | NO                        |
| L PUMP BAY | 10'    | 1        | NO                        |




| Symbol | Description | Revisions |
|--------|-------------|-----------|
| AS     | CONSTRUCTED |           |
| JJC    | DESIGNED    |           |
| JJC    | DRAWN       |           |
| JJC    | CHECKED     |           |
| JJC    | REVIEWED    |           |
| JJC    | APPROVED    |           |

|              |     |                  |                  |
|--------------|-----|------------------|------------------|
| DESIGNED BY: | DRC | DATE:            | MAR 1999         |
| DRAWN BY:    | JJC | SCALE:           | AS SHOWN         |
| CHECKED BY:  | JJC | DRAWING CODE:    | 1-L-1-3-1/67     |
| REVIEWED BY: | JJC | REVISION NUMBER: | DACW25-97-B-0032 |


ILLINOIS WATERWAY PROGRAM  
ENVIRONMENTAL MANAGEMENT  
LA GRANGE POOL, MILE 124 TO 129.5  
LAKE CHAUTAUQUA  
OPERATIONS AND MAINTENANCE

**PUMP STATION  
REINFORCING I**


Sheet  
Reference  
Number:  
**S180**  
Sheet 44 of 84

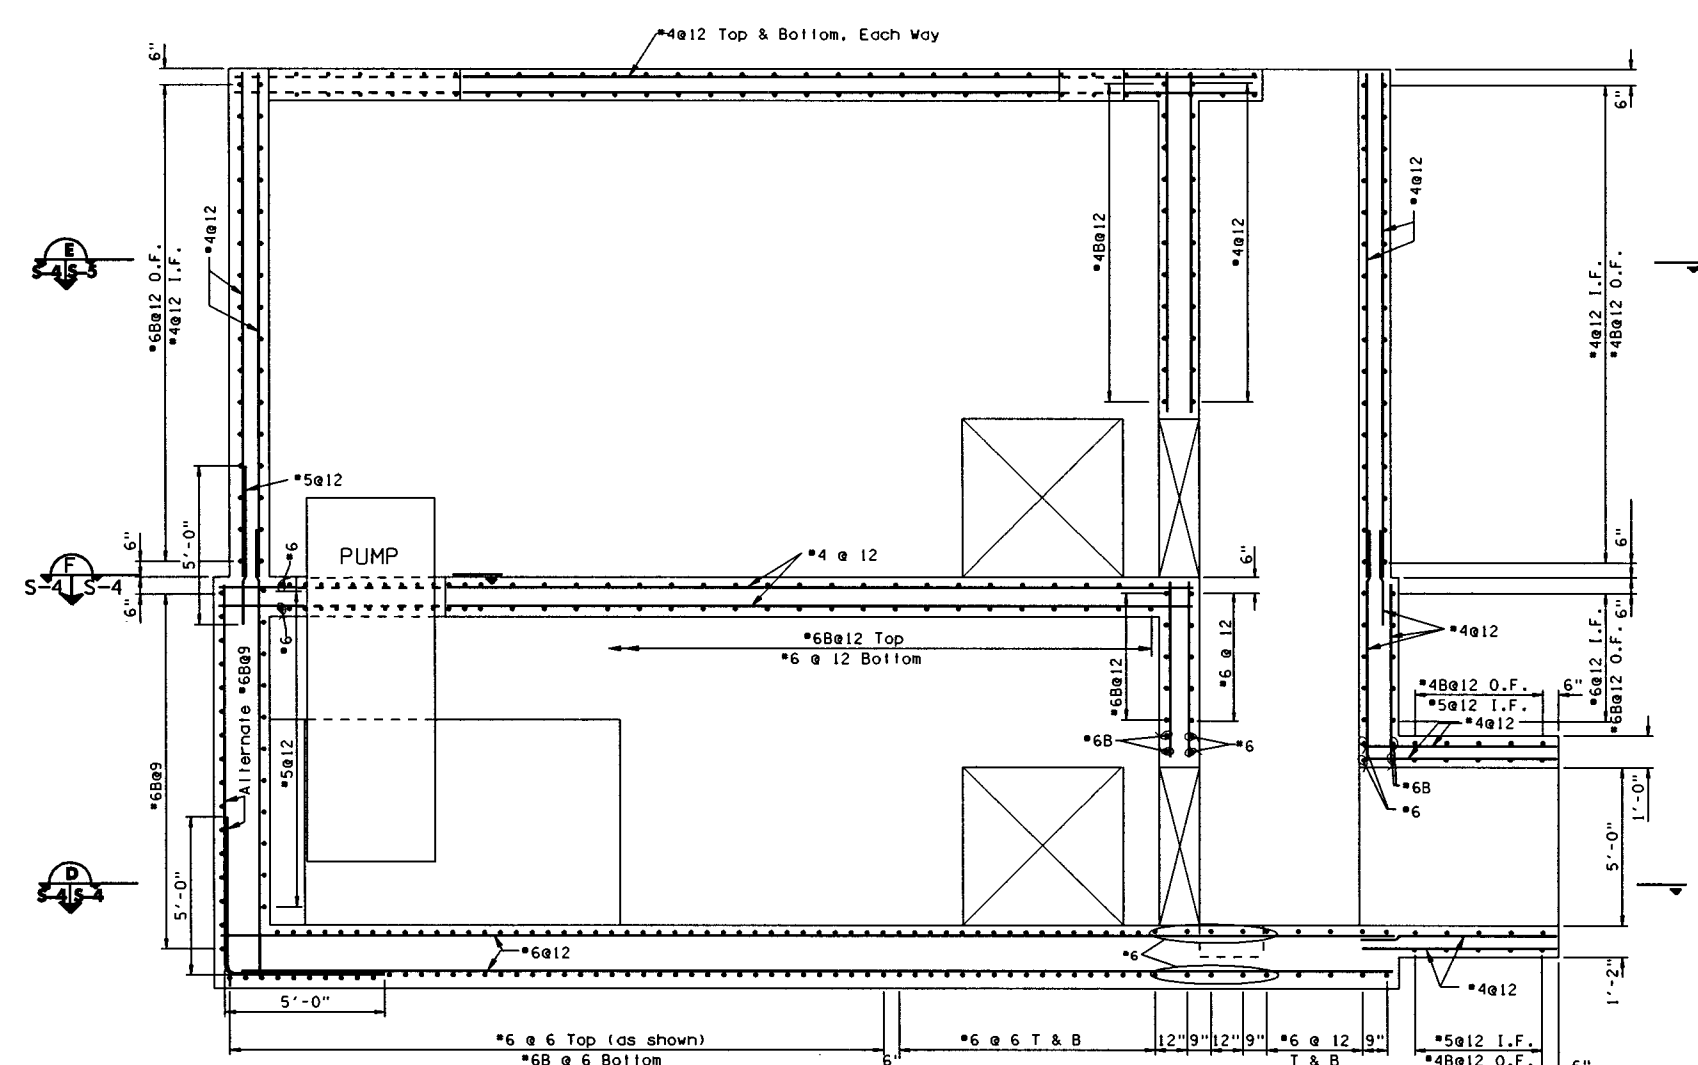

SECTION B  
S-3/S-4

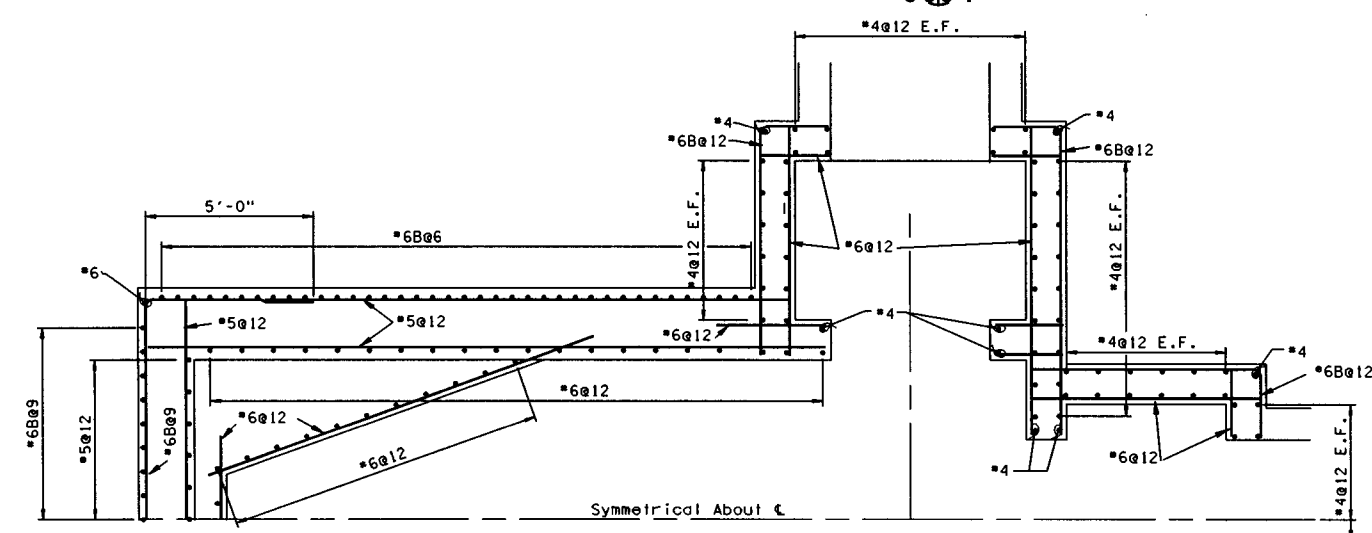


SECTION D  
S-4/S-4

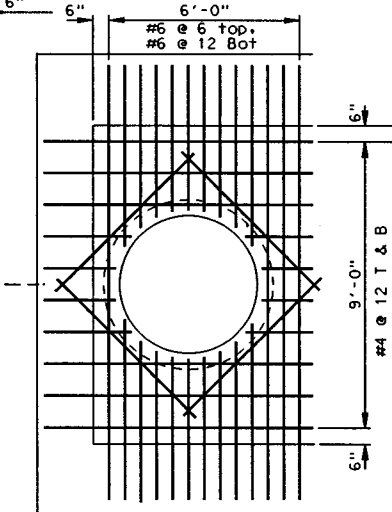

SECTION F  
S-4/S-4

SCALE: 3/8" = 1'-0"  
12" 0 2 4 6

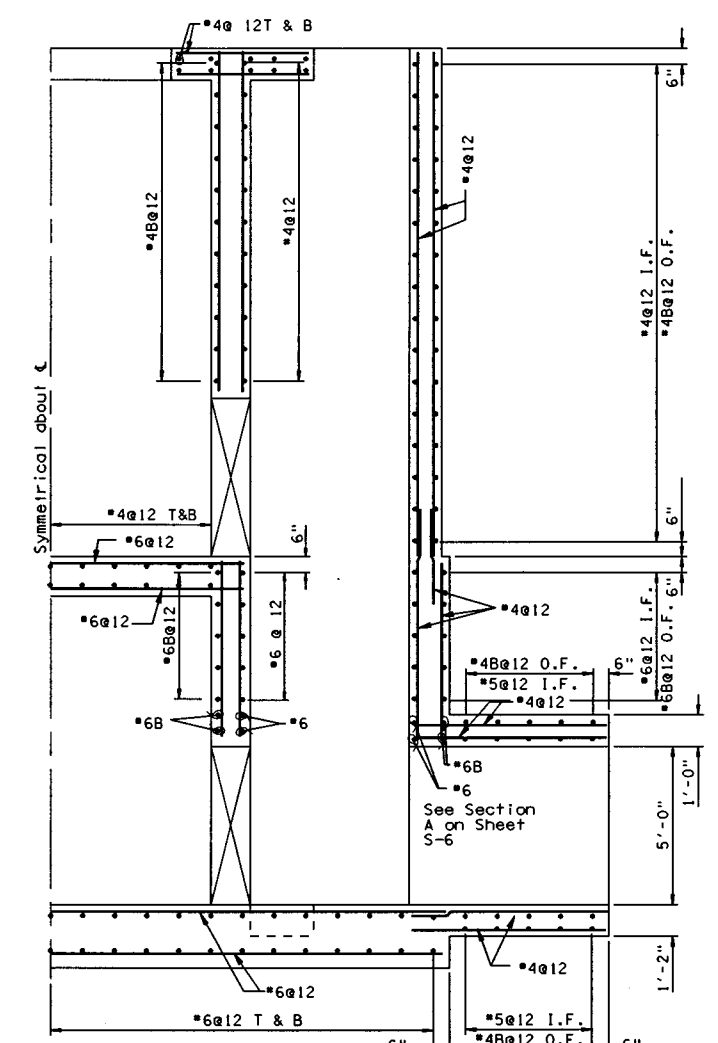

SECTION C  
S-5/S-4

REFERENCE:  
For ladders, stoplog slots and seal pilates  
see S-3.


Use this one: ep52a190.dgn

| Symbol         | Description | Revisions |
|----------------|-------------|-----------|
| AS CONSTRUCTED |             |           |
| DATE           | DATE        | DATE      |
| 11/06/99       | 11/06/99    | 11/06/99  |
| DRG/JUC        | DRG/JUC     | DRG/JUC   |


|              |              |                  |              |
|--------------|--------------|------------------|--------------|
| Designed By: | DRG          | Date:            | MAR 1999     |
| Drawn By:    | AS SHOWN     | Scale:           | AS SHOWN     |
| Checked By:  | 1-L-1-3-1/67 | Revision Number: | 1-L-1-3-1/67 |
| Reviewed By: | JUC          | Revision Number: | 1-L-1-3-1/67 |

ILLINOIS WATERWAY  
ENVIRONMENTAL MANAGEMENT PROGRAM  
LA GRANGE POOL, MILE 124 TO 129.5  
LAKE CHAUTAUQUA  
OPERATIONS AND MAINTENANCE  
**PUMP STATION  
BOX CULVERT & HEADWALL**


Sheet  
Reference  
Number:  
**S200**  
Sheet 46 of 84

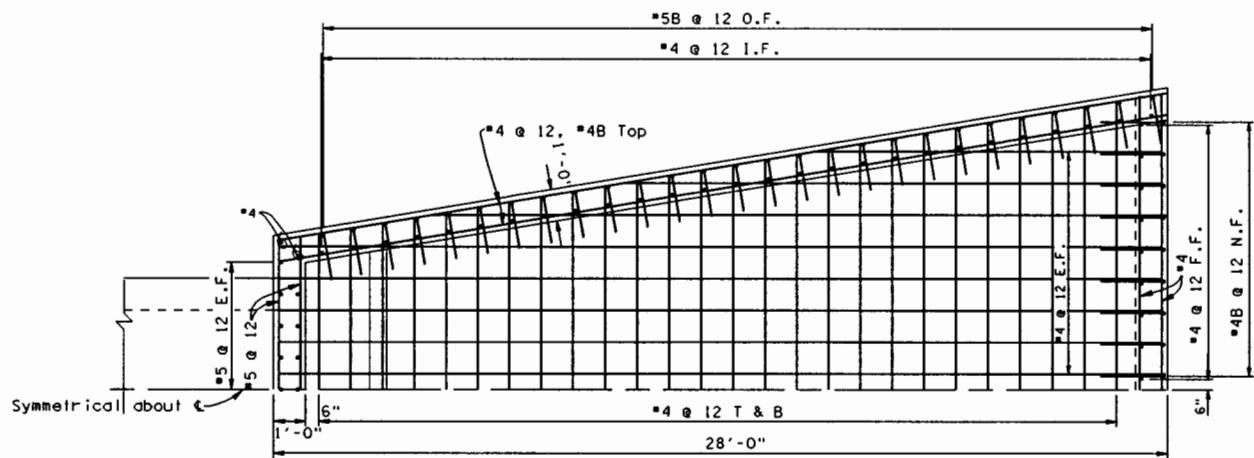


**PLAN**

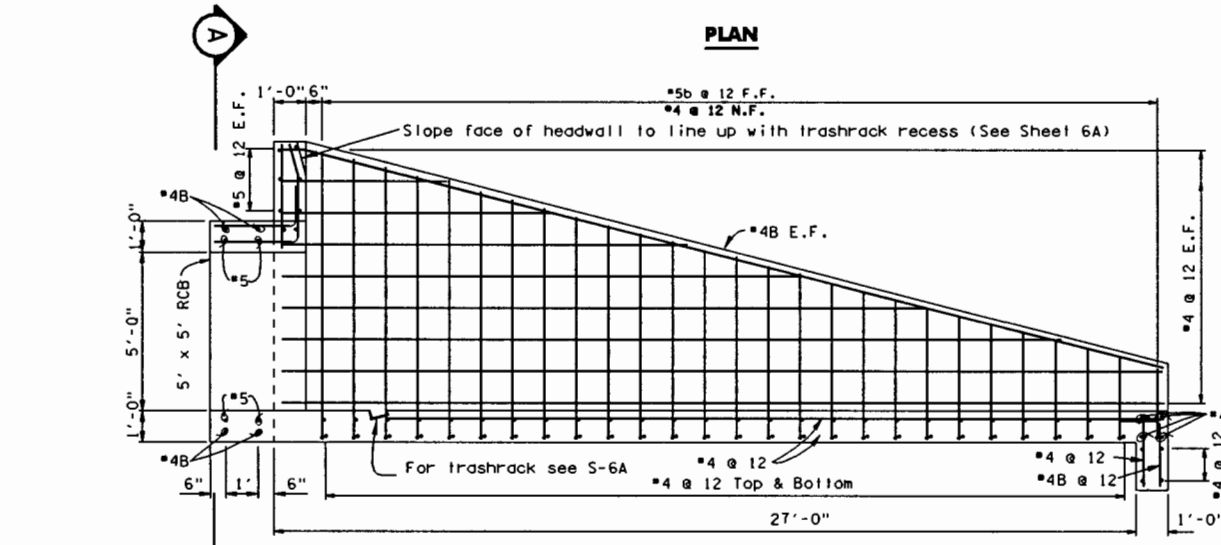


**SECTION**

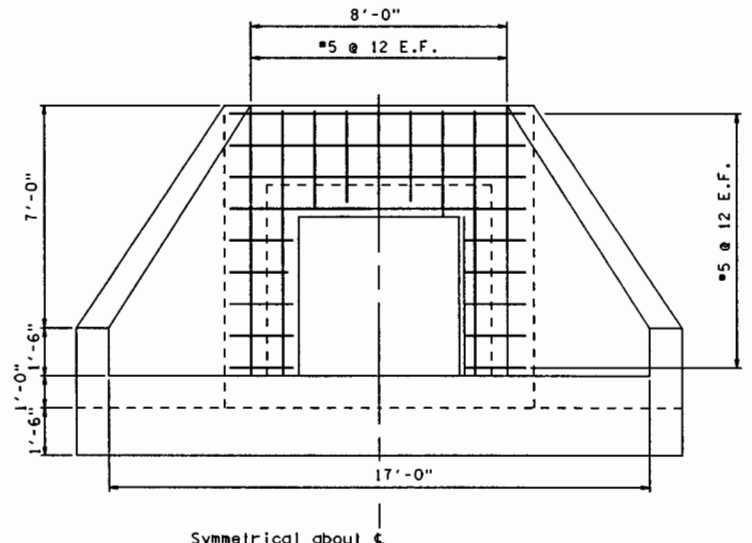


**ELEVATION**

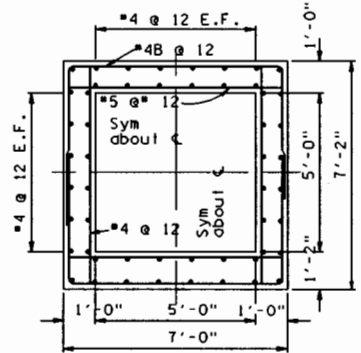


**SECTION A**

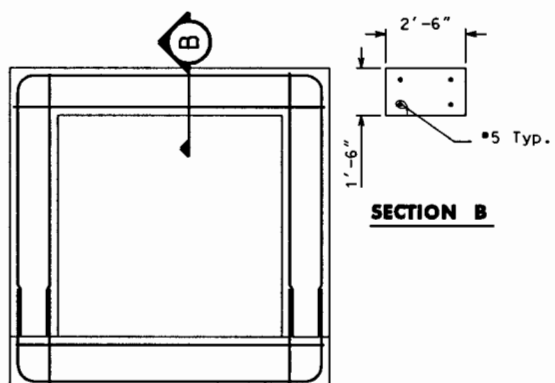

**SECTION B**

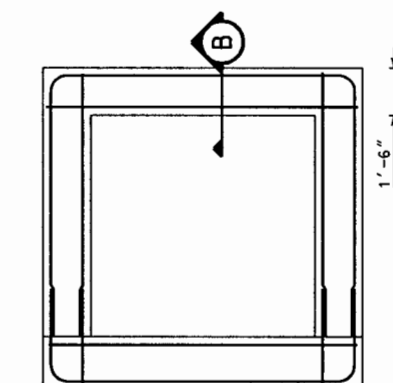


**ELEVATION-CONNECTING COLLAR**

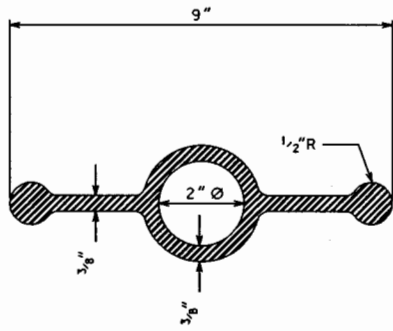


**WATERSTOP DETAIL**

PLACE ALL AROUND ALL PIPE JOINTS


Symmetrical about C

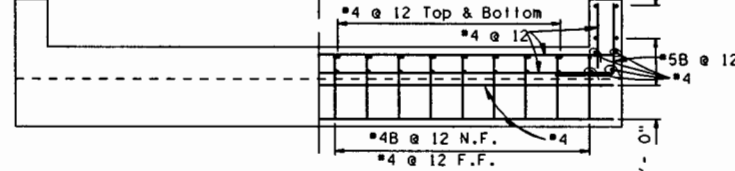


**END ELEVATION**

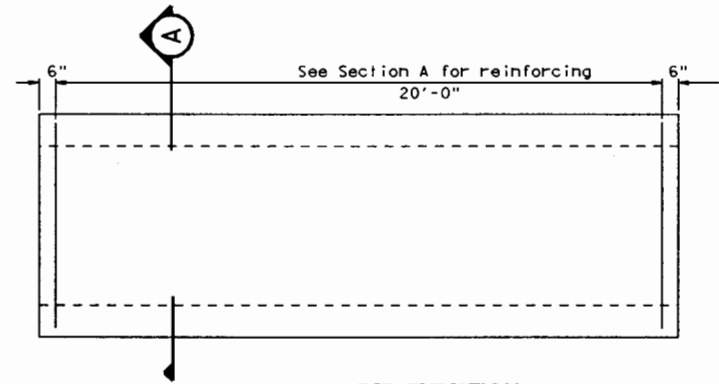

**RCB ELEVATION**

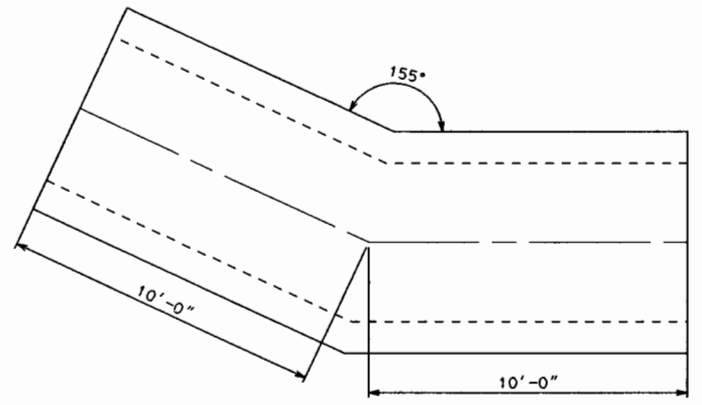


**CORNER MONOLITH 12**

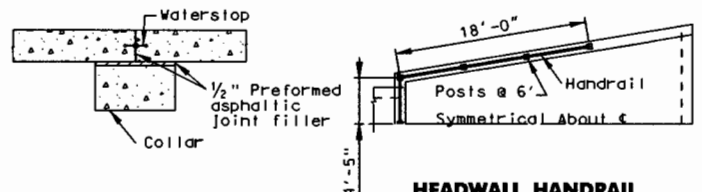

**HEADWALL HANDRAIL**


SCALE: 1/8" = 1'-0"

SCALE: 3/8" = 1'-0"

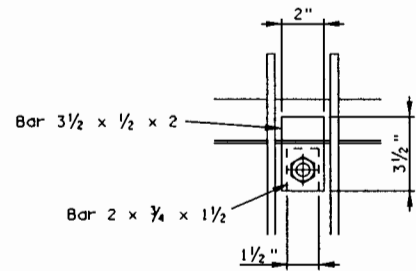


CLIP DETAIL

SCALE: 3" = 1'-0"

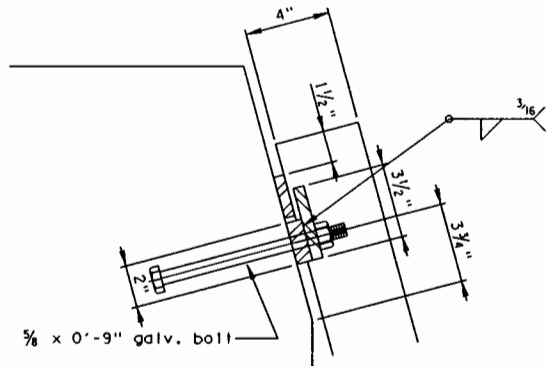


SECTION THRU CLIP

SCALE: 3" = 1'-0"

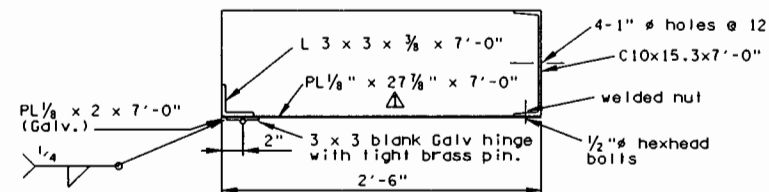

PLAN

SCALE: 1 1/2" = 1'-0"

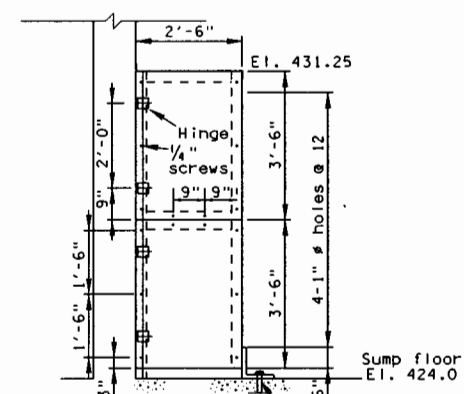


ELEVATION

SCALE: 1 1/2" = 1'-0"


FLOAT STATION COVER

Make 1 Galvanized

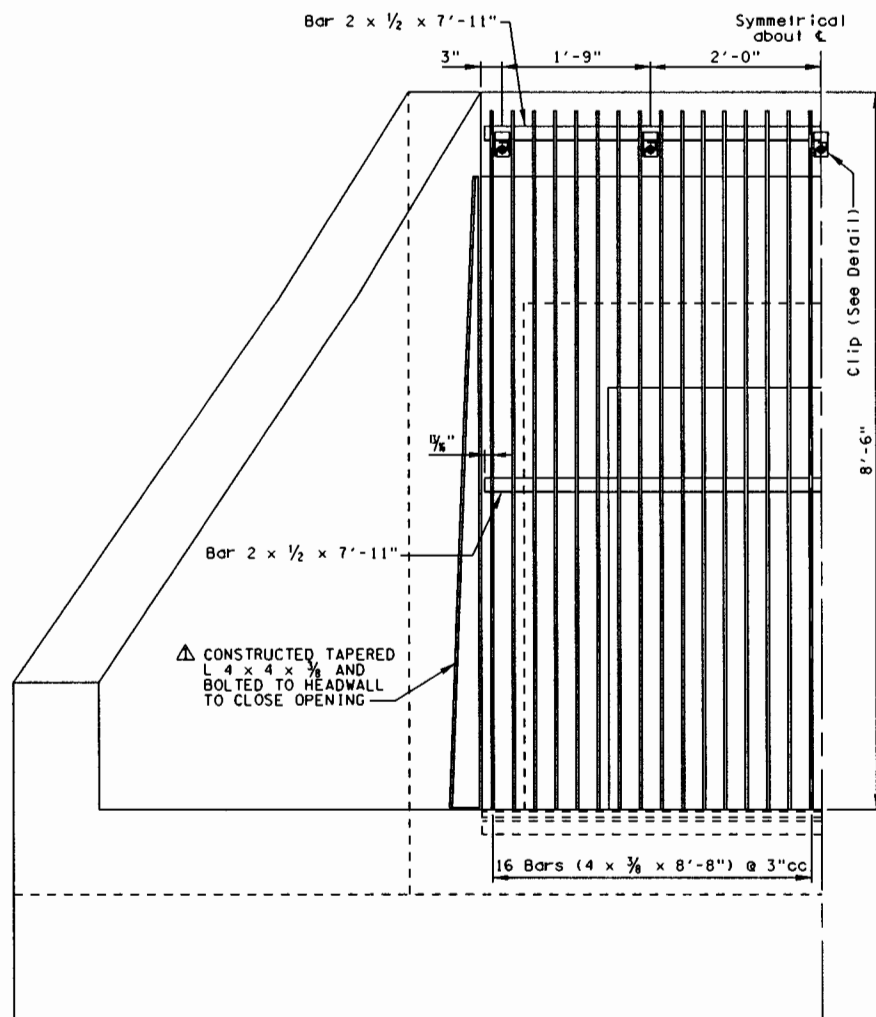


ELEVATION

SCALE: 1" = 1'-0"

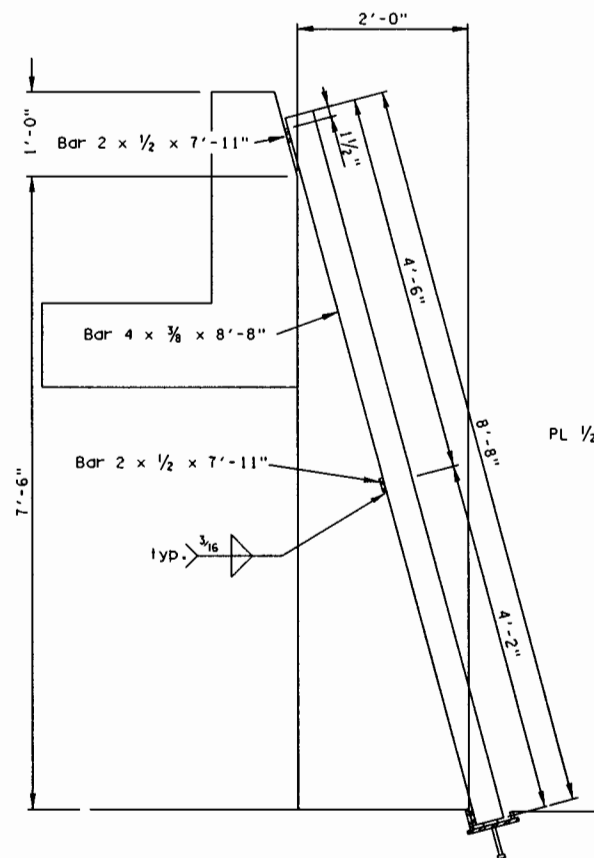

SECTION


SCALE: 1" = 1'-0"

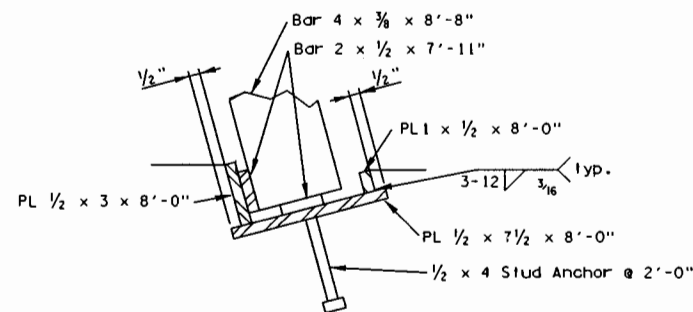

SHOE DETAIL

SCALE: 3" = 1'-0"

Note: Trashrack and embedded metals, and Float Station are to be galvanized after welding.

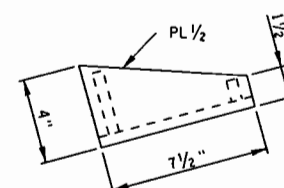

END PLATE DETAIL

SCALE: 3" = 1'-0"



| Symbol | Revised AS CONSTRUCTED | Description | Revisions |
|--------|------------------------|-------------|-----------|
| 1      | REVISED AS CONSTRUCTED |             |           |
| 2      |                        |             |           |
| 3      |                        |             |           |
| 4      |                        |             |           |
| 5      |                        |             |           |
| 6      |                        |             |           |

|                                                                            |                                                                                                  |                                     |
|----------------------------------------------------------------------------|--------------------------------------------------------------------------------------------------|-------------------------------------|
| U.S. ARMY ENGINEER DISTRICT<br>CORPS OF ENGINEERS<br>ROCK ISLAND, ILLINOIS | Designed By: MAR 1999<br>Scale: AS SHOWN<br>Drawn By: JPK<br>Checked By: TJW<br>Reviewed By: RCA | Calculation Number: 04CWS-97-8-0032 |
|----------------------------------------------------------------------------|--------------------------------------------------------------------------------------------------|-------------------------------------|

|                                                                                                                                             |                                  |
|---------------------------------------------------------------------------------------------------------------------------------------------|----------------------------------|
| ILLINOIS WATERWAY<br>ENVIRONMENTAL MANAGEMENT PROGRAM<br>LA GRANGE POOL, MILE 124 TO 129.5<br>LAKE CHAUTAUQUA<br>OPERATIONS AND MAINTENANCE | <b>PUMPSTATION<br/>TRASHRACK</b> |
|---------------------------------------------------------------------------------------------------------------------------------------------|----------------------------------|

|                                                                |
|----------------------------------------------------------------|
| Sheet<br>Reference<br>Number:<br><b>S210</b><br>Sheet 47 of 84 |
|----------------------------------------------------------------|

EXISTING PUMP STATION PLAN

EXISTING GATE PEDESTAL ANCHORAGE

NOTES:

1. THIS WORK INCLUDES: REMOVE 6 GATE PEDESTALS. REMOVE CEMENT GROUT. TEST PULL-OUT STRENGTH OF EACH ANCHOR ROD (6 GATE PEDESTALS, 4 RODS PER PEDESTAL). REPLACE RODS THAT FAIL TEST. REPLACE GROUT AND PEDESTALS.
2. 2 RODS AND THE GROUT ON A HEAVY DUTY SLUICE GATE PEDESTAL HAVE FAILED AND SHALL BE REPLACED. THE WORK ON THIS PEDESTAL SHALL BE COMPLETED WITHIN 90 DAYS OF THE NOTICE TO PROCEED.
3. GATES AND PEDESTALS ARE MANUFACTURED BY HYDROGATE. HYDROGATE SHOP DRAWINGS ARE AVAILABLE FOR REVIEW.

TYPICAL LIFT PEDESTAL ANCHOR BOLT LOCATION PLAN  
(3 - LOCATIONS THUS)

SECTION 

**REPAIRS TO GATE PEDESTAL ANCHORAGES**  
NO SCALE

[illegible]

|                                                                            |                                                                          |                                                                                                              |
|----------------------------------------------------------------------------|--------------------------------------------------------------------------|--------------------------------------------------------------------------------------------------------------|
| U.S. ARMY ENGINEER DISTRICT<br>COMPS OF ENGINEERS<br>ROCK ISLAND, ILLINOIS | Designed By: KEW<br>Drawn By: MRC<br>Checked By: DRC<br>Reviewed By: RAL | Date: 25 JUNE 2001<br>Scale: AS SHOWN<br>Project Code: 1-L-1-3-1/67<br>Solicitation Number: DACW25-01-B-0012 |
|----------------------------------------------------------------------------|--------------------------------------------------------------------------|--------------------------------------------------------------------------------------------------------------|

**PUMP STATION GATE  
PEDESTALS ANCHOR  
ROD REPAIR**

Sheet  
Reference  
Number:  
**S220**   
Sheet 48 of 84




| Symbol | Description            | Revisions |
|--------|------------------------|-----------|
| 1      | REVISED AS CONSTRUCTED |           |
| 2      | REVISED AS CONSTRUCTED |           |
| 3      | REVISED AS CONSTRUCTED |           |
| 4      | REVISED AS CONSTRUCTED |           |
| 5      | REVISED AS CONSTRUCTED |           |

|              |     |                      |                  |
|--------------|-----|----------------------|------------------|
| DESIGNED BY: | NEW | DATE:                | MAR 1999         |
| DRAWN BY:    | HOG | SCALE:               | AS SHOWN         |
| CHECKED BY:  | DRR | DRAWING CODE:        | 1-1-1-3-1-1/67   |
| REVIEWED BY: | DJH | SOILS REPORT NUMBER: | DACH25-97-B-0035 |

ILLINOIS WATERWAY  
ENVIRONMENTAL MANAGEMENT PROGRAM  
LA GRANDE POOL, MILE 124 TO 129.5  
LAKE CHATAUGUA  
OPERATIONS AND MAINTENANCE  
**ELEVATED CONTROL  
PLATFORM**

Sheet  
Reference  
Number:  
**S230**  
Sheet 49 of 84

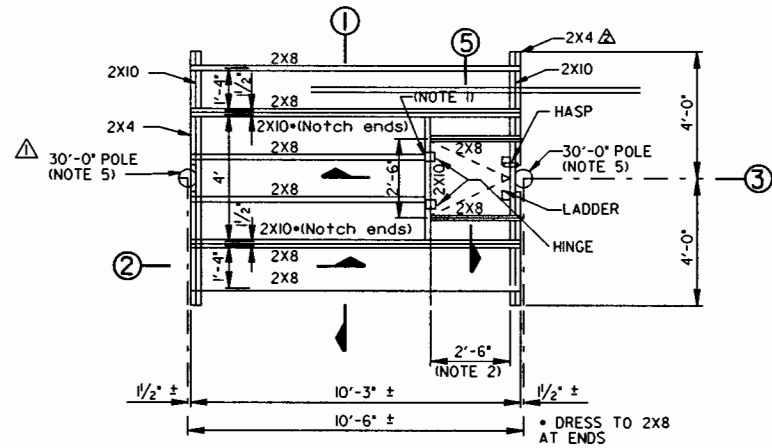


**FRAMING PLAN**

SCALE:  $\frac{1}{4}'' = 1'-0''$


**NOTES:**

1. JOIST HANGERS SHALL CARRY A MINIMUM OF 620#.
2. PROVIDE BRIDGING AT ENDS AND MID-SPAN OF JOISTS.
3. PROVIDE A 2" X 2" THICK WOOD HATCH COVER FLUSH WITH THE DECK.
4. PROVIDE HEAVY DUTY HINGES AND HASP FOR PADLOCK.
5. ALL BOLTS AND LAG SCREWS SHALL BE GALVANIZED, AND SHALL HAVE WASHERS AT HEAD AND NUT.
6. PROVIDE DOUGLAS FIR OR SOUTHERN PINE TREATED, CLASS 3 POLES. SET A MINIMUM OF 6'-0" INTO GROUND.

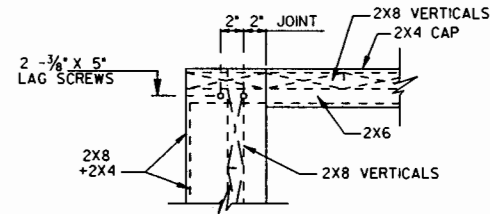


**CORNER DETAIL AT  
TOP OF RAIL**

SCALE:  $\frac{1}{2}'' = 1'-0''$

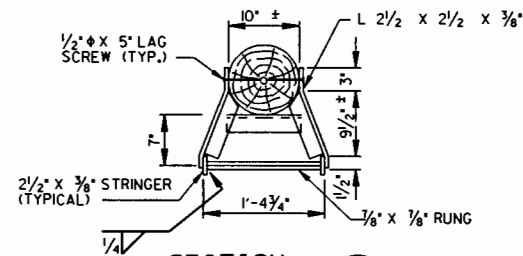


**SECTION 4**

SCALE:  $1'' = 1'-0''$

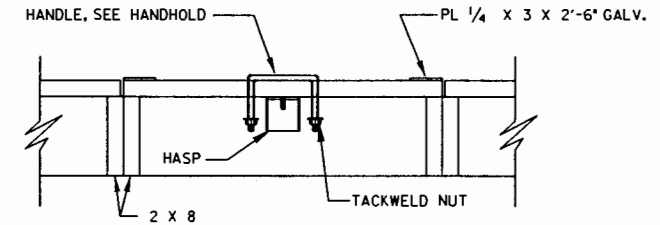


**SECTION 5**

SCALE:  $\frac{1}{2}'' = 1'-0''$

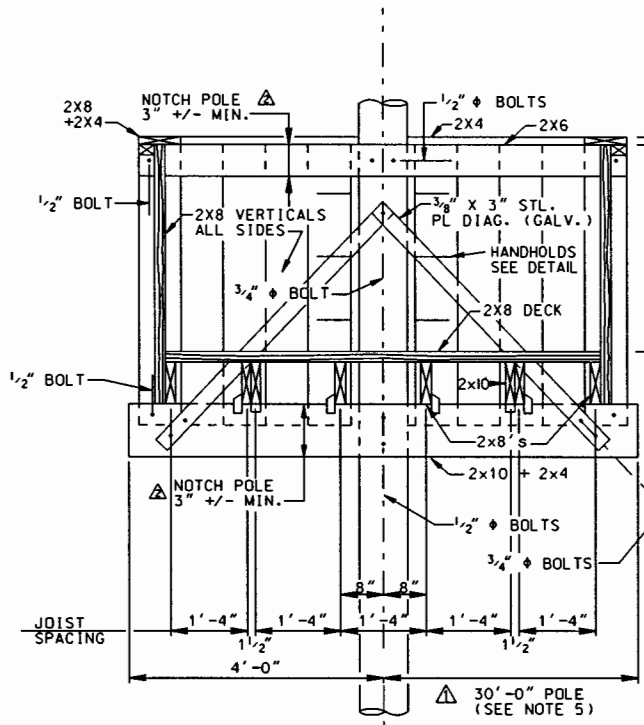


**SECTION 1**

SCALE:  $\frac{1}{4}'' = 1'-0''$

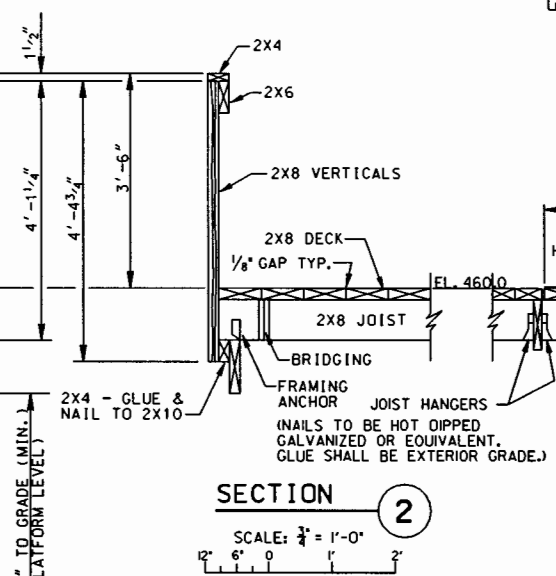

**SECTION 2**

SCALE:  $\frac{1}{4}'' = 1'-0''$

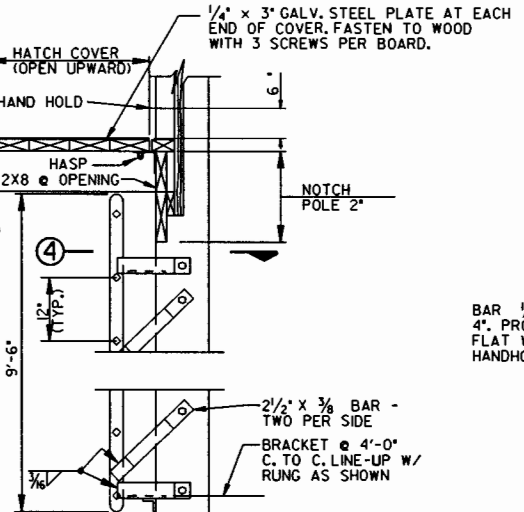

**SECTION 3**

SCALE:  $\frac{1}{4}'' = 1'-0''$

**NOTE:**

LADDER TO BE FABRICATED IN LENGTHS THAT WILL PERMIT GALVANIZING AFTER FABRICATION. SPLICES WILL BE FULL PENETRATION WELDS. GALVANIZING DESTROYED BY WELDING SHALL BE REPAIRED AS DESCRIBED IN SPECIFICATIONS.

**REFERENCES:**

1. SEE SHEET S150 FOR LOCATION OF ELEVATED CONTROL PLATFORM.

BAR  $\frac{1}{2}'' \times 18''$ , THREAD EACH 4". PROVIDE 4 HEX NUTS & FLAT WASHERS FOR EACH HANDHOLD

**HANDHOLD**







| Symbol | Description            | Revisions |
|--------|------------------------|-----------|
| △      | REVISED AS CONSTRUCTED |           |
| DATE   | DATE                   | DATE      |
| DATE   | DATE                   | DATE      |

|              |     |                      |                  |
|--------------|-----|----------------------|------------------|
| DESIGNED BY: | MJW | DATE:                | MAR 1999         |
| DRAWN BY:    | JRK | SCALE:               | AS SHOWN         |
| CHECKED BY:  | TJW | DRAWING CODE:        | 1-L-1-3-1/67     |
| REVIEWED BY: | RCA | SOLICITATION NUMBER: | DACW25-97-B-0032 |

ILLINOIS WATERWAY  
ENVIRONMENTAL MANAGEMENT PROGRAM  
LA GRANGE POOL, MILE 124 TO 129.5  
LAKE CHAUTAUQUA  
OPERATIONS AND MAINTENANCE

Sheet  
Reference  
Number:  
**S240**  
Sheet 50 of 84

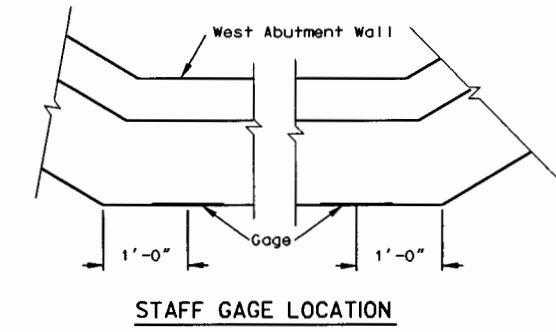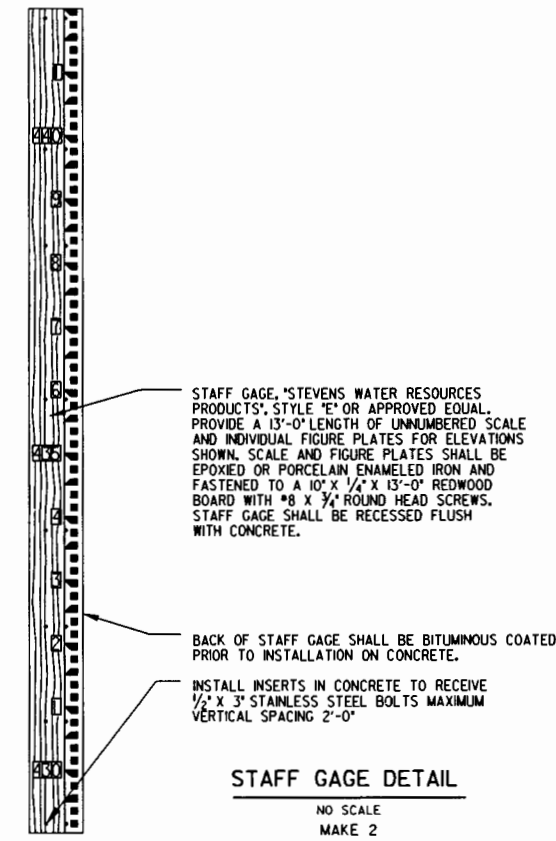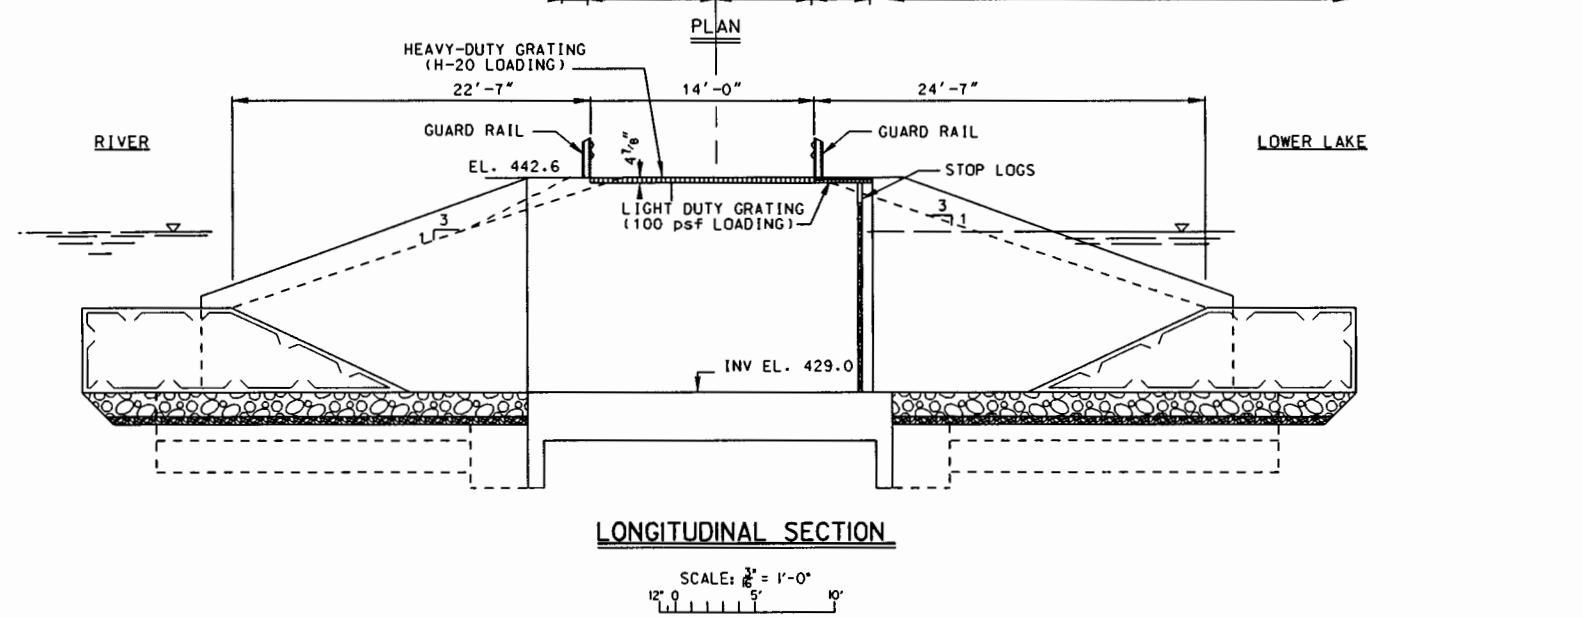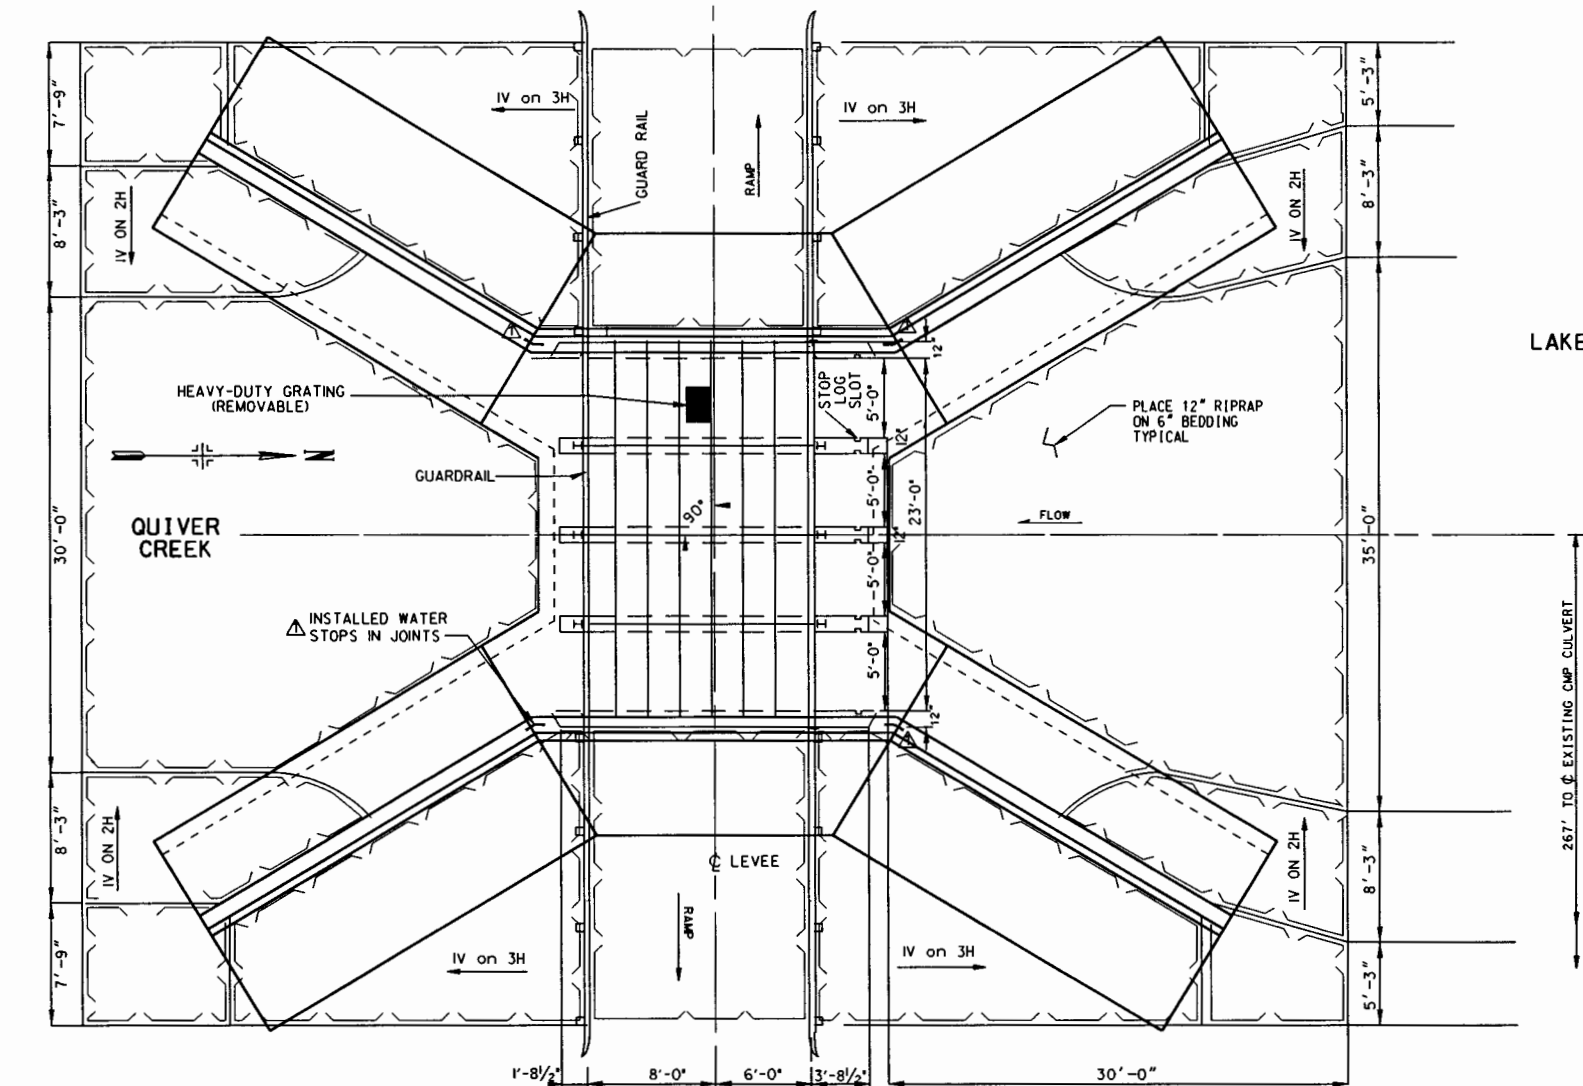




| Symbol | Description | Revisions |
|--------|-------------|-----------|
| 1      | AS SHOWN    |           |
| 2      | 1-1-3-1/67  |           |
| 3      | 1-1-3-1/67  |           |
|              |      |                       |                 |
|--------------|------|-----------------------|-----------------|
| Designed By: | MAJW | Date:                 | MAR 1999        |
| Drawn By:    | JRK  | Scale:                | AS SHOWN        |
| Checked By:  | TJW  | Drawing Code:         | 1-1-3-1/67      |
| Reviewed By: | RCA  | Specification Number: | DAC25-97-B-0032 |

ILLINOIS WATERWAY PROGRAM  
ENVIRONMENTAL MANAGEMENT  
LA GRANGE POND, MILE 124 TO 129.5  
CHRYSLER ENGINEERING  
OPERATIONS AND MAINTENANCE  
**STOPLOG STRUCTURE TRASHRACK**

Sheet  
Reference  
Number:  
**S260**  
Sheet 52 of 84

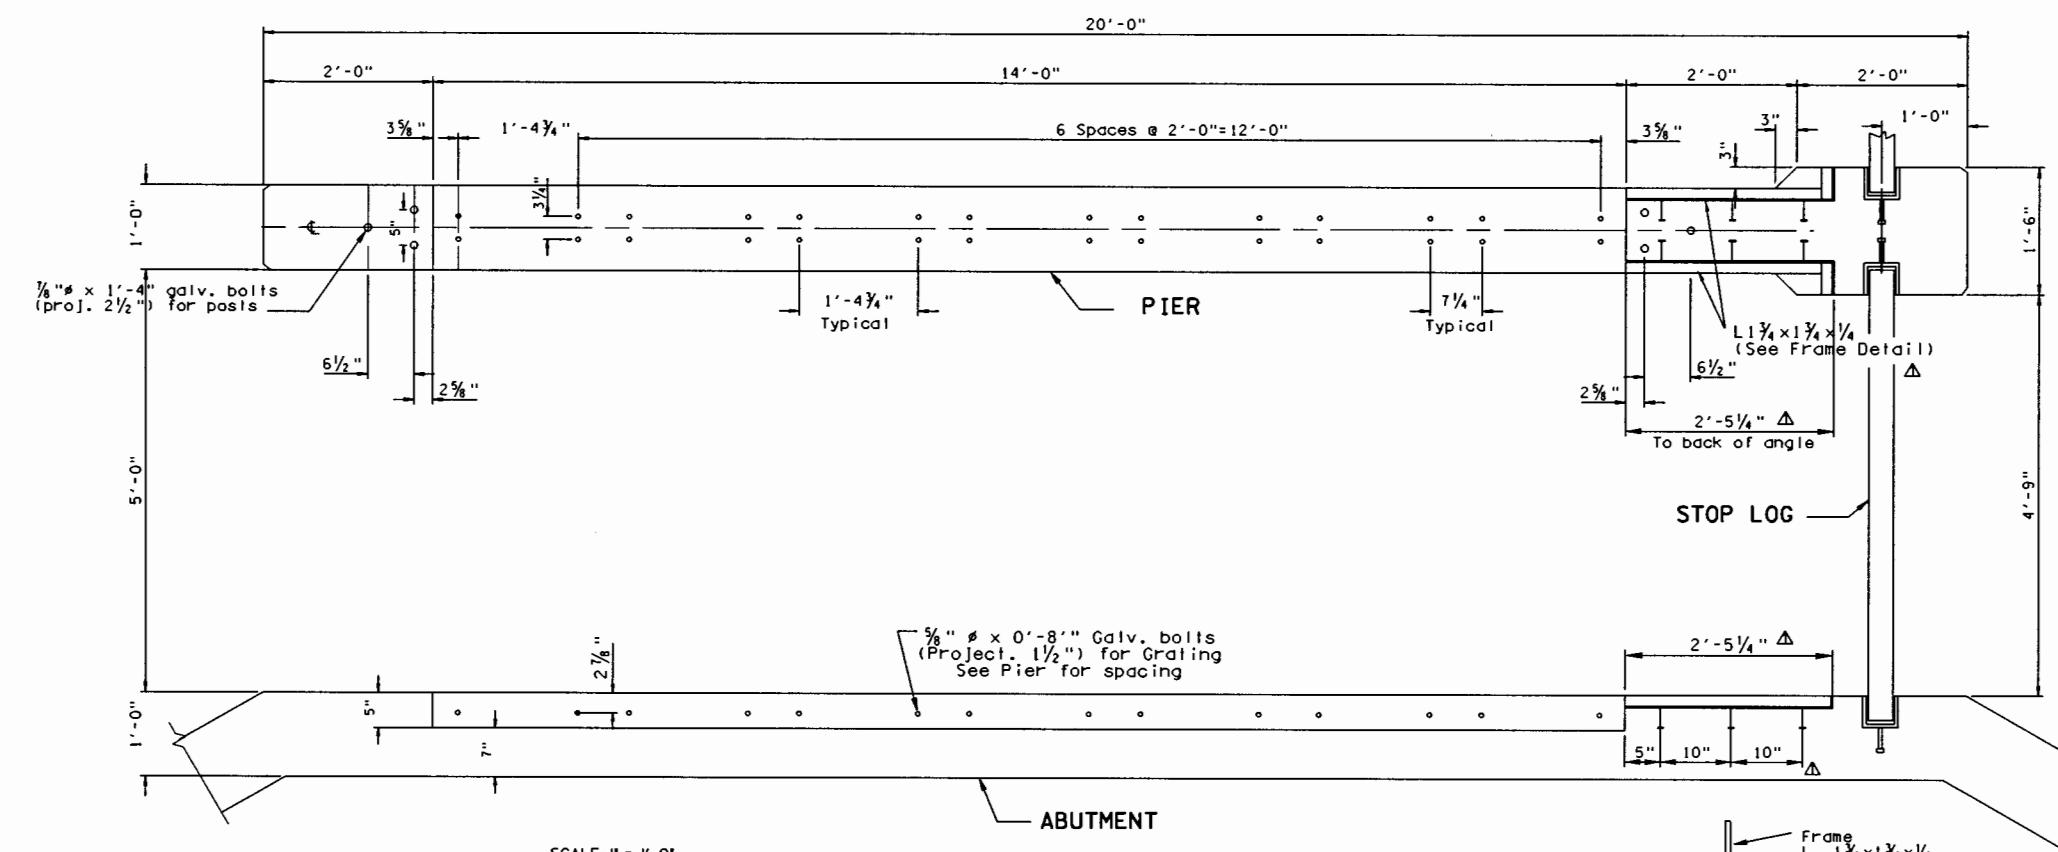

SCALE: 1" = 1'-0"

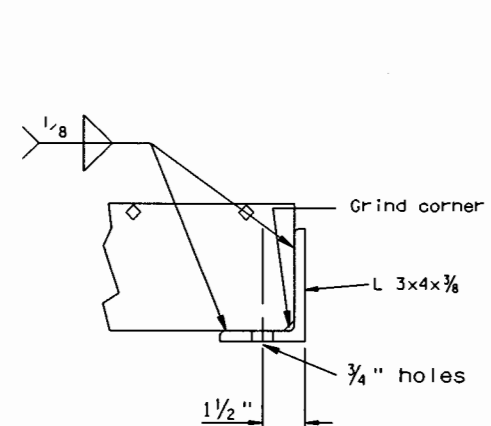

**BANDING DETAIL**


Clear span 5'-0"

Bearing bars 4 1/2" x 1/2" @ 2 3/8" c.c.

3/8" Twisted cross bars @ 4" c.c.

Banding bars on sides.

**HEAVY DUTY GRATING DETAILS**

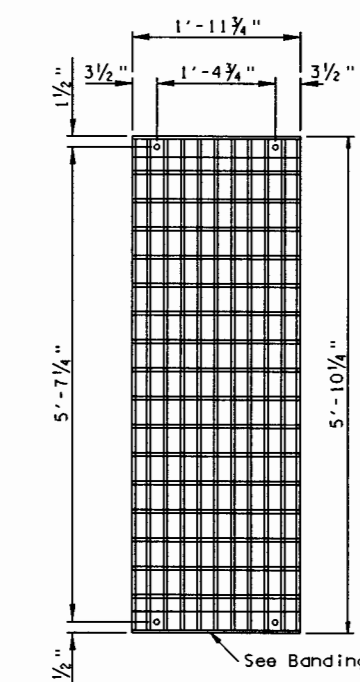


Δ Clear span 5'-0"

Bearing bars 1 1/2" x 3/16" @ 3/16" c.c.


1/4" Twisted cross bars @ 4" c.c.







(See Sheet S-2 for grating fastener details)

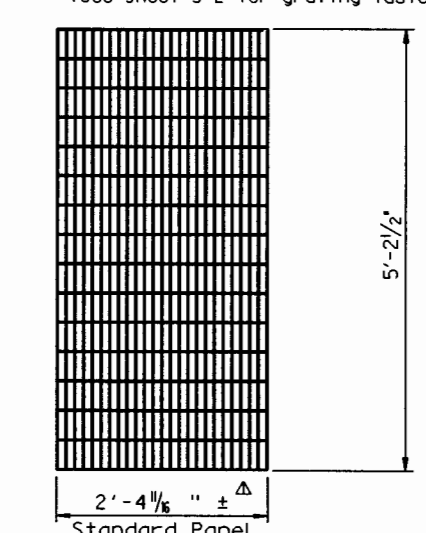

**LIGHT DUTY GRATING DETAILS**  
(ASTM A36) GALVANIZED

**STOPLOG KEEPERS**

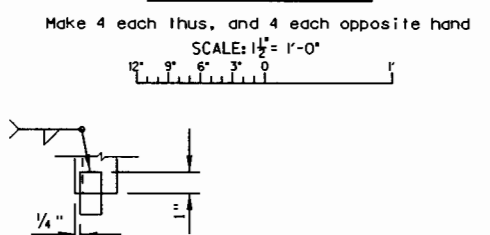

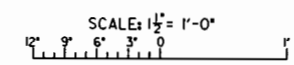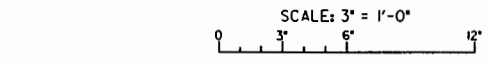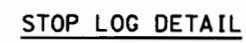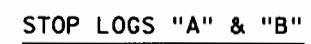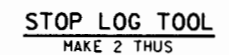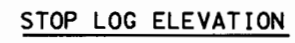

|                                                                                                                                                                                                                                                                                                   |                      |
|---------------------------------------------------------------------------------------------------------------------------------------------------------------------------------------------------------------------------------------------------------------------------------------------------|----------------------|
| <br><b>US Army Corps<br/>of Engineers</b><br><b>Rock Island<br/>District</b>                                                                                                                                   |                      |
| <p style="font-size: small; margin-top: 0;">DRAWING OF THE PROJECT OR PART THEREOF AS SHOWN ON THIS SHEET SHALL BE CONSIDERED A TRUE AND CORRECT REPRESENTATION OF THE PROJECT OR PART THEREOF AS AUTHORIZED BY THE DISTRICT ENGINEER.</p> <p style="margin-top: 10px;"><b>AS CONSTRUCTED</b></p> |                      |
|                                                                                                                                                                                                                                                                                                   | DATE: DEC 98 DRC/JJC |
|                                                                                                                                                                                                                                                                                                   | APPROVED:            |
|                                                                                                                                                                                                                                                                                                   | SIGNATURE:           |
|                                                                                                                                                                                                                                                                                                   | TITLE:               |
|                                                                                                                                                                                                                                                                                                   | REVISIONS:           |
|                                                                                                                                                                                                                                                                                                   | DESCRIPTION:         |
|                                                                                                                                                                                                                                                                                                   | SYMBOL:              |

|                         |                                               |
|-------------------------|-----------------------------------------------|
| <b>Designed By:</b> MLW | <b>Date:</b> MAR 1999                         |
| <b>Drawn By:</b> JRK    | <b>Scale:</b> AS SHOWN                        |
| <b>Checked By:</b> TJW  | <b>Drawing Code:</b> 1-L-1-3-1/67             |
| <b>Reviewed By:</b> RCA | <b>Specification Number:</b> DACW25-97-B-0032 |

|                                                                            |
|----------------------------------------------------------------------------|
| U.S. ARMY ENGINEER DISTRICT<br>CORPS OF ENGINEERS<br>ROCK ISLAND, ILLINOIS |
|----------------------------------------------------------------------------|

|                                                                                                                                              |
|----------------------------------------------------------------------------------------------------------------------------------------------|
| ILLINOIS WATERWAY<br>ENVIRONMENTAL MANAGEMENT PROGRAM<br>LA GRANGE POOL - MILE 124 TO 129+5<br>LAKE CHAUTAUQUA<br>OPERATIONS AND MAINTENANCE |
|----------------------------------------------------------------------------------------------------------------------------------------------|


## STOPLOG STRUCTURE STOPLOG DETAILS

Sheet Reference Number:  

### 5270

 Sheet 53 of 84

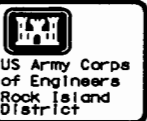


| Symbol   | Description            | Revisions |
|----------|------------------------|-----------|
| Δ        | REVISED AS CONSTRUCTED |           |
| DATE     | BY                     | APPROVED  |
| 11/13/99 | JRK                    | YLR       |


|                                                                            |                                                                          |                                                                                                          |
|----------------------------------------------------------------------------|--------------------------------------------------------------------------|----------------------------------------------------------------------------------------------------------|
| U.S. ARMY ENGINEER DISTRICT<br>CORPS OF ENGINEERS<br>ROCK ISLAND, ILLINOIS | Designed By: MJW<br>Drawn By: JRK<br>Checked By: JGB<br>Reviewed By: RCA | Date: MAR 1999<br>Scale: AS SHOWN<br>Drawing Code: 1-1-1-3-1/67<br>Solicitation Number: DACW25-97-B-0032 |
|----------------------------------------------------------------------------|--------------------------------------------------------------------------|----------------------------------------------------------------------------------------------------------|

ILLINOIS WATERWAY  
ENVIRONMENTAL MANAGEMENT PROGRAM  
LA GRANGE POOL, MILE 124 TO 129.5  
LAKE CHAUTAUQUA  
OPERATIONS AND MAINTENANCE  
**STOPLOG STRUCTURE  
REINFORCING DETAILS**


Sheet  
Reference  
Number:  
**S280**  
Sheet 54 of 84

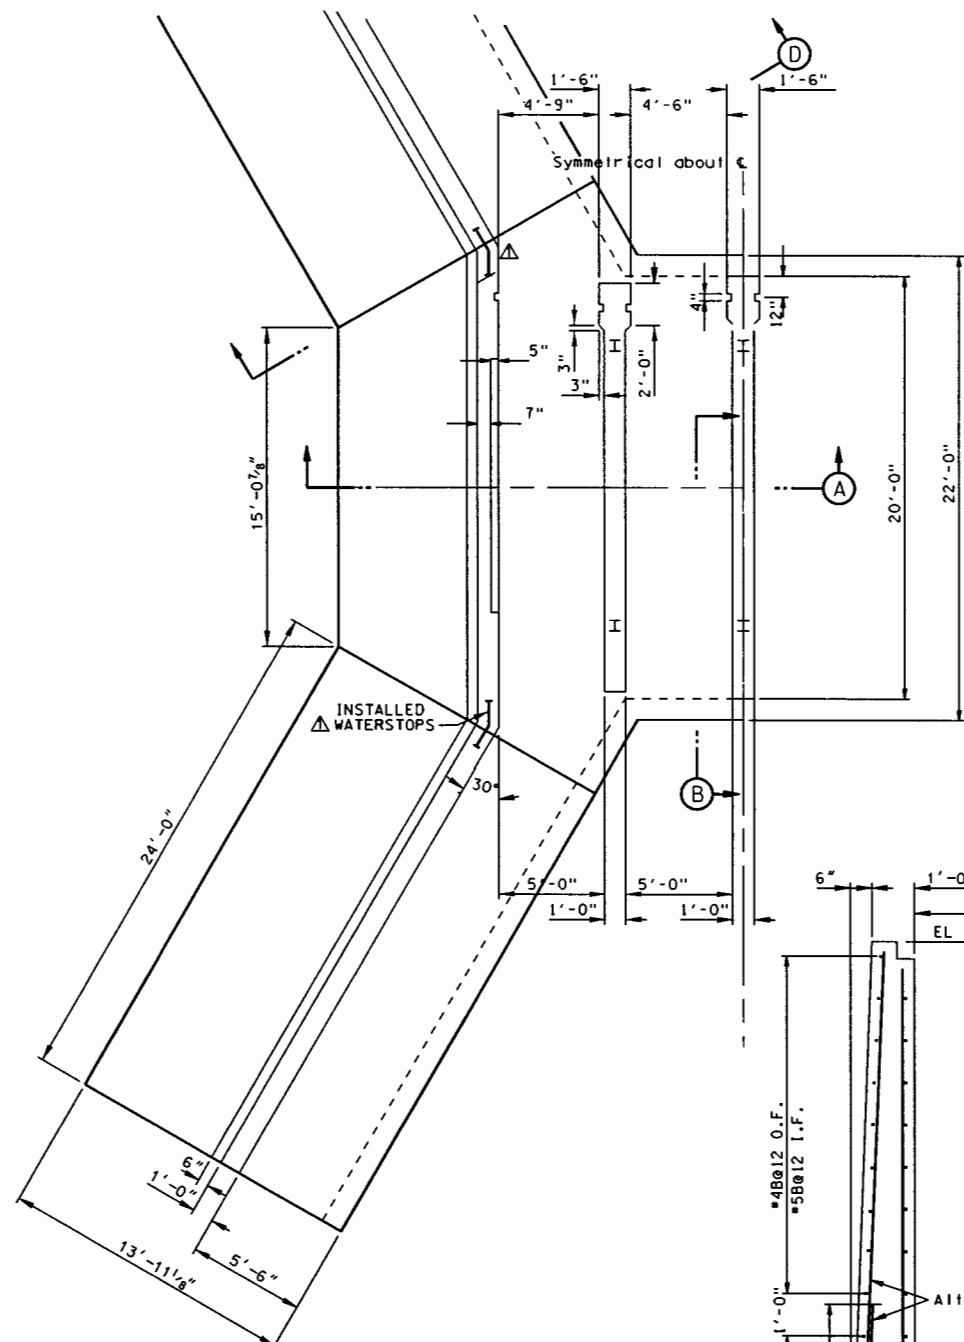


**PARTIAL PLAN**  
SCALE: 1/4" = 1'-0"  
1" 0 1 2 3 4 5'

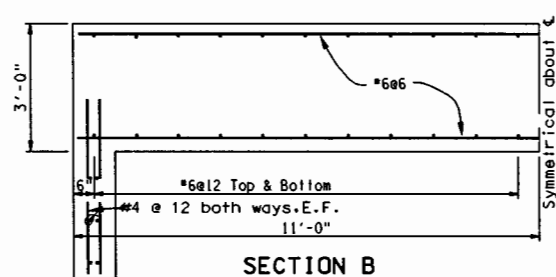


**SECTION B**

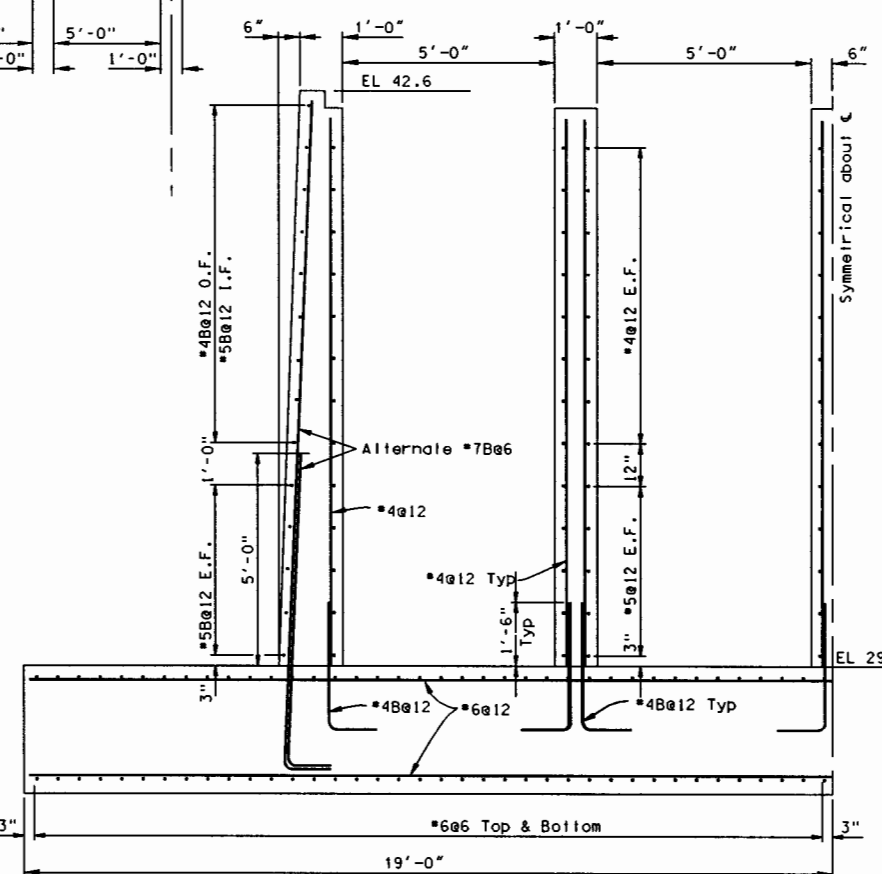

**SECTION A**







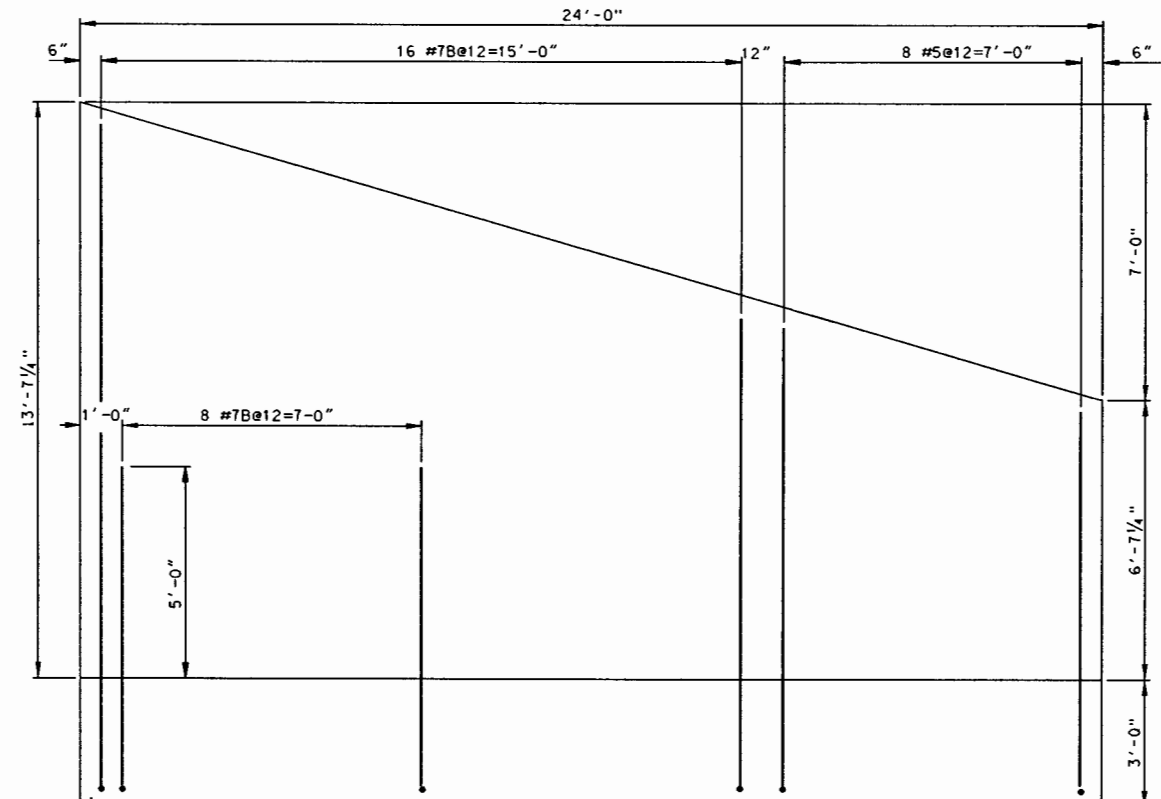


**ELEVATION - LANDSIDE REINFORCING**

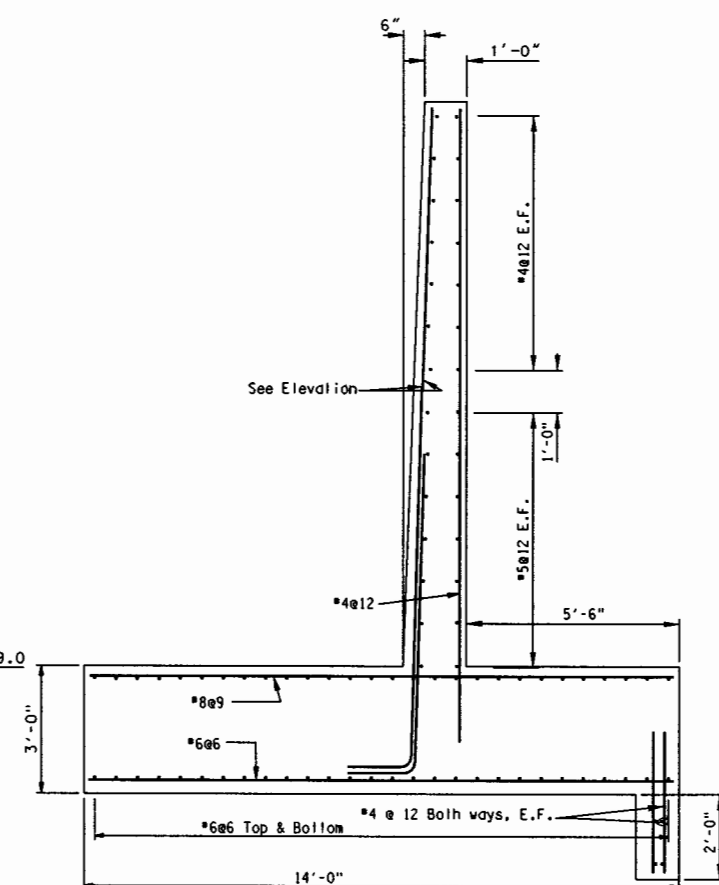

**SECTION D**

SCALE: 1/2" = 1'-0"  
1" 0 1 2 3 4'

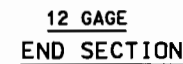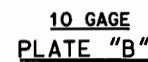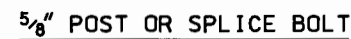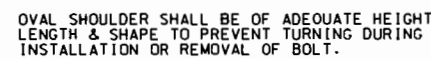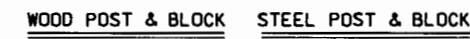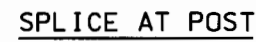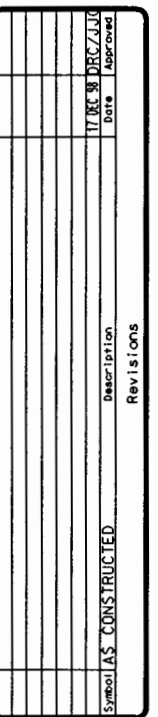

HOLE PUNCHING DETAILS  
FOR STEEL POSTS & BLOCKS





GUARD RAIL NOTES:

1. STEEL POSTS SHALL BE FABRICATED FROM MATERIAL MEETING THE REQUIREMENTS OF ASTM A36. THE SECTIONS SHALL BE GALVANIZED AFTER FABRICATION IN ACCORDANCE WITH THE REQUIREMENTS OF AASHTO M11.
2. WOOD POST AND BLOCKS SHALL BE DOUGLAS FIR "DENSE NO. 1" STRUCTURAL GRADE" CONFORMING TO THE REQUIREMENTS OF PARAGRAPH 131-bb OF THE STANDARD GRADING RULES FOR THE WEST COAST LUMBER, NO. 1, DEC 16, 1976, REVISED EDITION; OR SOUTHERN PINE "NO. 1, SR. GRADE" CONFORMING TO THE REQUIREMENTS OF PARAGRAPH 405 OF THE SOUTHERN PINE INSPECTION BUREAU GRADING RULES, 1977 EDITION.
3. WASHERS SHALL BE USED AT ALL POST BOLTS (BETWEEN BOLT HEAD AND BEAM). THEY SHALL BE RECTANGULAR IN SHAPE (3"x 1 3/4" x 3/16") MIN. AND FLAT, OR IF NECESSARY OF SUCH DESIGN TO FIT THE CONTOUR OF THE BEAM. WASHERS SHALL HAVE 11/16" x 1" HOLE.
4. ALL DIMENSIONS ARE SUBJECT TO MANUFACTURING TOLERANCES EXCEPT WHERE ALLOWABLE TOLERANCES ARE SHOWN.




MAKE 1 16'  
MAKE 1 24'

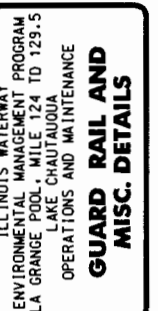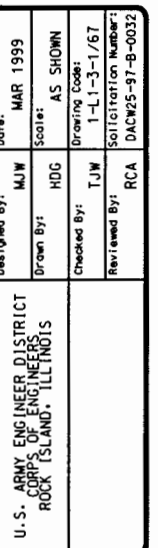


Sheet  
Reference  
Number:  
**S290**  
Sheet 55 of 84




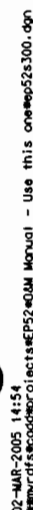



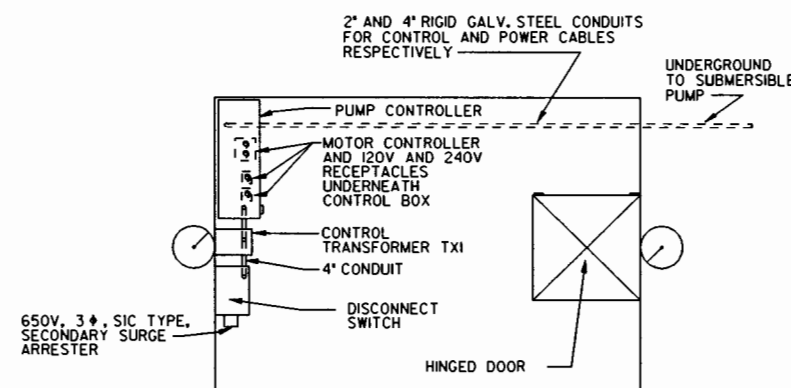

NOT TO SCALE

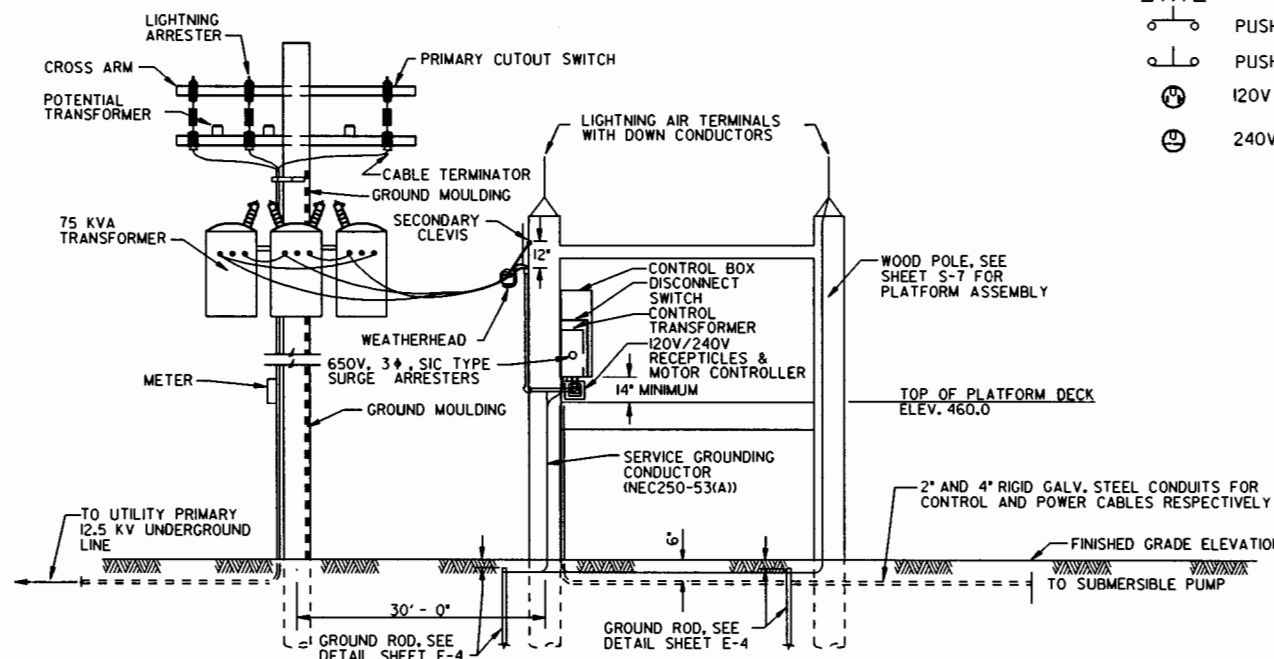

NOT TO SCALE

1. PRIMARY CABLE TO NEW UTILITY POLE
2. 3- 167 KVA TRANSFORMERS
3. CABLE TERMINATORS
4. LIGHTNING ARRESTERS
5. PRIMARY FUSED DISCONNECT SWITCHES
6. GROUND WIRE, GROUND ROD AND CONNECTION
7. STAND OFF BRACKET AND U-CLAMPS OR CROSS ARMS
8. METER AND METER SOCKET
9. SECONDARY WIRING TO SERVICE DISCONNECT SWITCH
10. CURRENT AND POTENTIAL TRANSFORMERS

|                                                                                       |                                                             |                                                                                     |                        |
|---------------------------------------------------------------------------------------|-------------------------------------------------------------|-------------------------------------------------------------------------------------|------------------------|
|    | OVER LOAD PROTECTION                                        |  | AUTO TRANSFORMER       |
|    | THERMAL PROTECTION                                          |  | CONTROL RELAY COIL     |
|    | MOTOR SEAL PROTECTION                                       |  | TIME DELAY RELAY COIL  |
|    | GROUND FAULT DETECTOR                                       |  | MOTOR STARTER COIL     |
|    | FLOAT SWITCH, CLOSE ON RISE                                 |  | GROUNDING CONNECTION   |
|    | PILOT LIGHT WITH INDICATED LENS<br>R=RED, GR=GREEN, A=AMBER |  | TIME DELAY DE-ENERGIZE |
|    | NORMALLY OPEN CONTACT                                       |  | FUSE                   |
|    | NORMALLY CLOSED CONTACT                                     |  | CIRCUIT BREAKER        |
|    | FUSIBLE DISCONNECT SWITCH                                   |                                                                                     |                        |
|    | RATED FUSE                                                  |                                                                                     |                        |
|   | THERMAL OVERLOAD                                            |                                                                                     |                        |
|  | CONTROL TRANSFORMER                                         |                                                                                     |                        |
|  | PUSHBUTTON NORMALLY OPEN, MOMENTARY TYPE                    |                                                                                     |                        |
|  | PUSHBUTTON NORMALLY CLOSED, MOMENTARY TYPE                  |                                                                                     |                        |
|  | 120V 20A DUPLEX GFCI RECEPTACLE                             |                                                                                     |                        |
|  | 240V 30A SIMPLEX RECEPTACLE                                 |                                                                                     |                        |

1. PUMP MANUFACTURER TO FURNISH PUMP CONTROLLER AND CABLES BETWEEN PUMP CONTROLLER AND PUMP MOTOR.
2. NO SPLICES SHALL BE MADE TO PUMP MANUFACTURER SUPPLIED POWER OR CONTROL CABLES.
3. UNDERGROUND CONDUITS SHALL BE WRAPPED WITH A PLASTIC TAPE OR FACTORY APPLIED PLASTIC RESIN TO PREVENT CORROSION.
4. FOR PLATFORM ASSEMBLY DETAIL, SEE SHEET S210.
5. THE CONTRACTOR SHALL COORDINATE WITH MENARD ELECTRIC COOPERATIVE AND IS RESPONSIBLE FOR PAYMENT TO MENARD ELECTRIC FOR FURNISHMENT OF MENARD ELECTRIC WORK. SUCH PAYMENT SHALL BE INCLUDED IN THE CONTRACTOR'S BID. SEE SPECIAL CLAUSE H-27, FOR MENARD ELECTRIC POINT OF CONTACT, P.O. BOX 279, 122 SOUTH SIXTH STREET, PETERSBURG, ILLINOIS 62675-0279, JOHN WHITEHURST (217/632-7746) OR (800/872-1203)
6. ALL SAFETY GROUNDING AND LIGHTNING GROUNDING SYSTEMS SHALL BE BONDED TOGETHER AT THE GROUND RODS ONLY.



US Army Corps  
of Engineers  
Rock Island  
District

[illegible]



|                                                       |                  |                                           |
|-------------------------------------------------------|------------------|-------------------------------------------|
| U.S. ARMY ENGINEER DISTRICT<br>ROCK ISLAND, ILL 61905 | Designed By: CJA | Date: MAR 1999                            |
|                                                       | Drawn By: HGC    | Scale: AS SHOWN                           |
|                                                       | Checked By: DMR  | Drawing Code: 1/67                        |
|                                                       | Reviewed By: DJH | SOI (1317) on Number:<br>DAC925-97-R-0032 |

**ILLINOIS WATERWAY  
ENVIRONMENTAL MANAGEMENT PROGRAM  
LA GRANGE POOL, MILE 124 TO 129.5  
LAKE CHAUTAUQUA  
OPERATIONS AND MAINTENANCE**

Sheet  
Reference  
Number:  
**E10**  
Sheet 57 of 84

12-MAR-2005 15:07



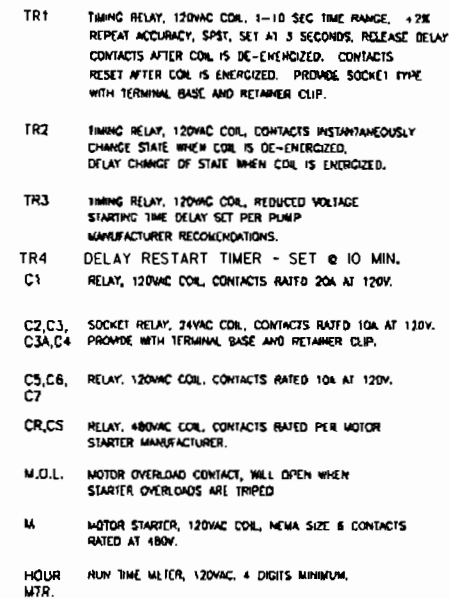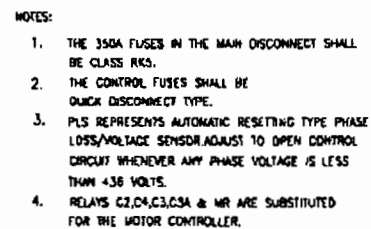

NOTES:

1. THE 350A FUSES IN THE MAIN DISCONNECT SHALL BE CLASS RK5.
2. THE CONTROL FUSES SHALL BE QUICK DISCONNECT TYPE.
3. PLS REPRESENTS AUTOMATIC RESETTING TYPE PHASE LOSS/VOLTAGE SENSORDIAGNOST TO OPEN CONTROL CIRCUIT WHENEVER ANY PHASE VOLTAGE IS LESS THAN 436 VOLTS.
4. RELAYS G2,G4,G3,G3A & NR ARE SUBSTITUTED FOR THE MOTOR CONTROLLER.

5. BLACK WIRES DENOTE 480 VOLT CIRCUIT.  
RED & WHITE WIRES DENOTE 120 VOLT CIRCUIT.  
PURPLE & YELLOW WIRES DENOTE 24 VOLT CIRCUIT
6. REASON FOR M.C.I. LOCATION IS M.C.I. IS ONLY  
RATED FOR 3 AMPS. C7 IS RATED AT HIGHER  
AMPERAGE (10 AMPS) TO ALLOW SHUTTING  
SYSTEM DOWN.
7. TWA DELAY RESTART

| Item | Revision        | By   | Date    |
|------|-----------------|------|---------|
| A    | M.O.L. Revision | S.A. | 5/28/57 |
| B    | Misc. Revisions | S.A. | 3/13/58 |
| C    | RESTART DELAY   | L.R. | 5/58    |
|      |                 |      |         |
|      |                 |      |         |
ARMY CORP OF ENG.  
LAKE CHAUTAUQUA

Specific: PUMP CONTROLLER  
ELEMENTARY DIAGRAM

| Des. Size | Plot Factor | Des. by      |
|-----------|-------------|--------------|
| Eng. :    | Date        | Cust. Eng. - |

Cust. Des. #

Vendor Des. #

E-2

E-2

[illegible]

|                                                                            |              |                       |                      |
|----------------------------------------------------------------------------|--------------|-----------------------|----------------------|
| U.S. ARMY ENGINEER DISTRICT<br>CORPS OF ENGINEERS<br>ROCK ISLAND, ILLINOIS | Designed By: | Dates:                | APR 2001             |
|                                                                            | Drawn By:    | Scale:                | AS SHOWN             |
|                                                                            | Checked By:  | Drawing Code:         | 1-1-3-1/67           |
|                                                                            | Reviewed By: | Soil Citation Number: | RAL DACW25-97-8-0032 |



ILLINOIS WATERWAY  
ENVIRONMENTAL MANAGEMENT PROGRAM  
A GRANGE POOL, MILE 124 TO 129.5  
LAKE CHAUTAUQUA  
OPERATIONS AND MAINTENANCE

**PUMP CONTROLLER  
ELEMENTARY DIAGRAM**

Sheet  
Reference  
Number:  
**E30**  
Sheet 59 of 84

22-MAR-2005 15:08



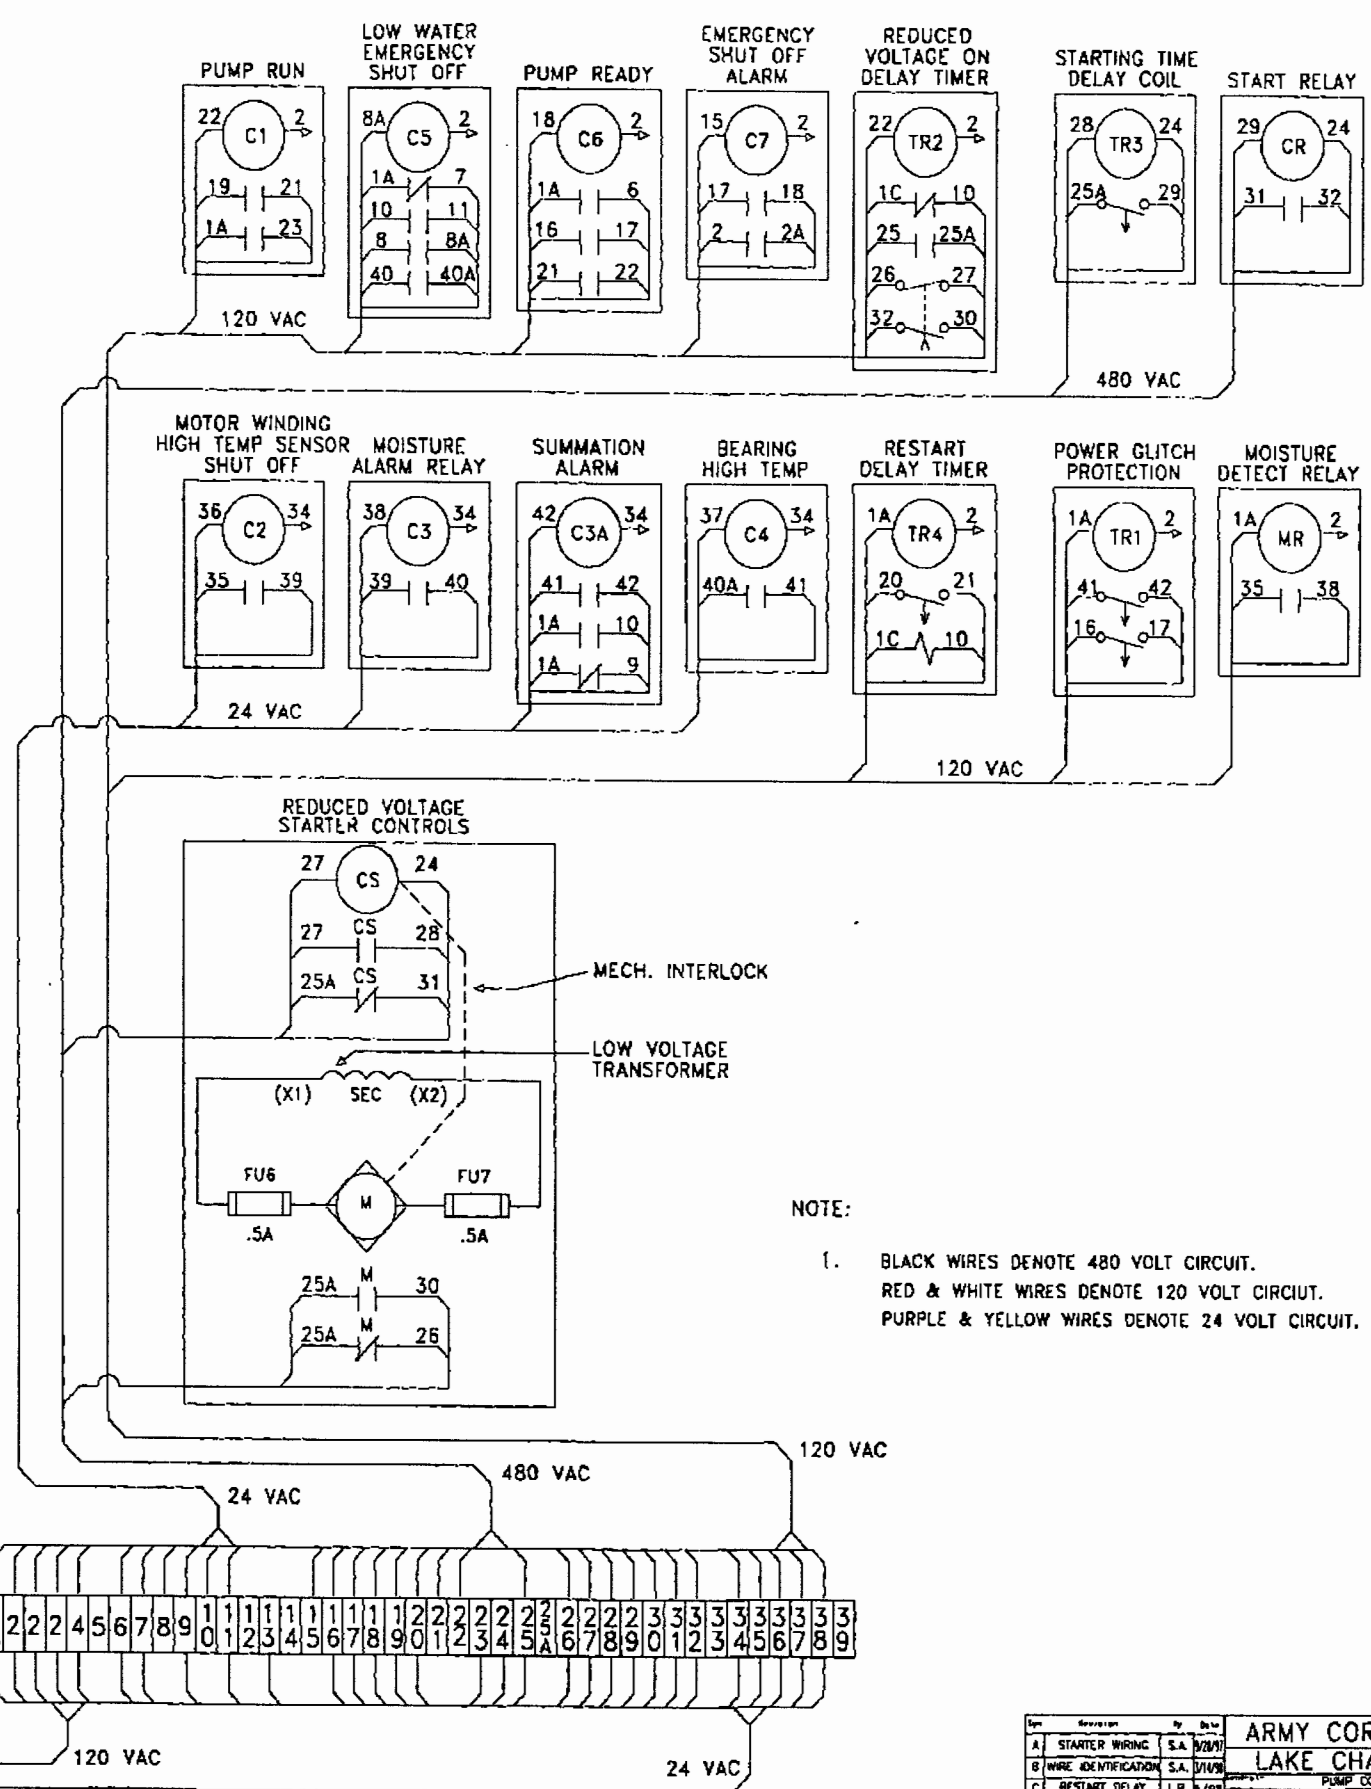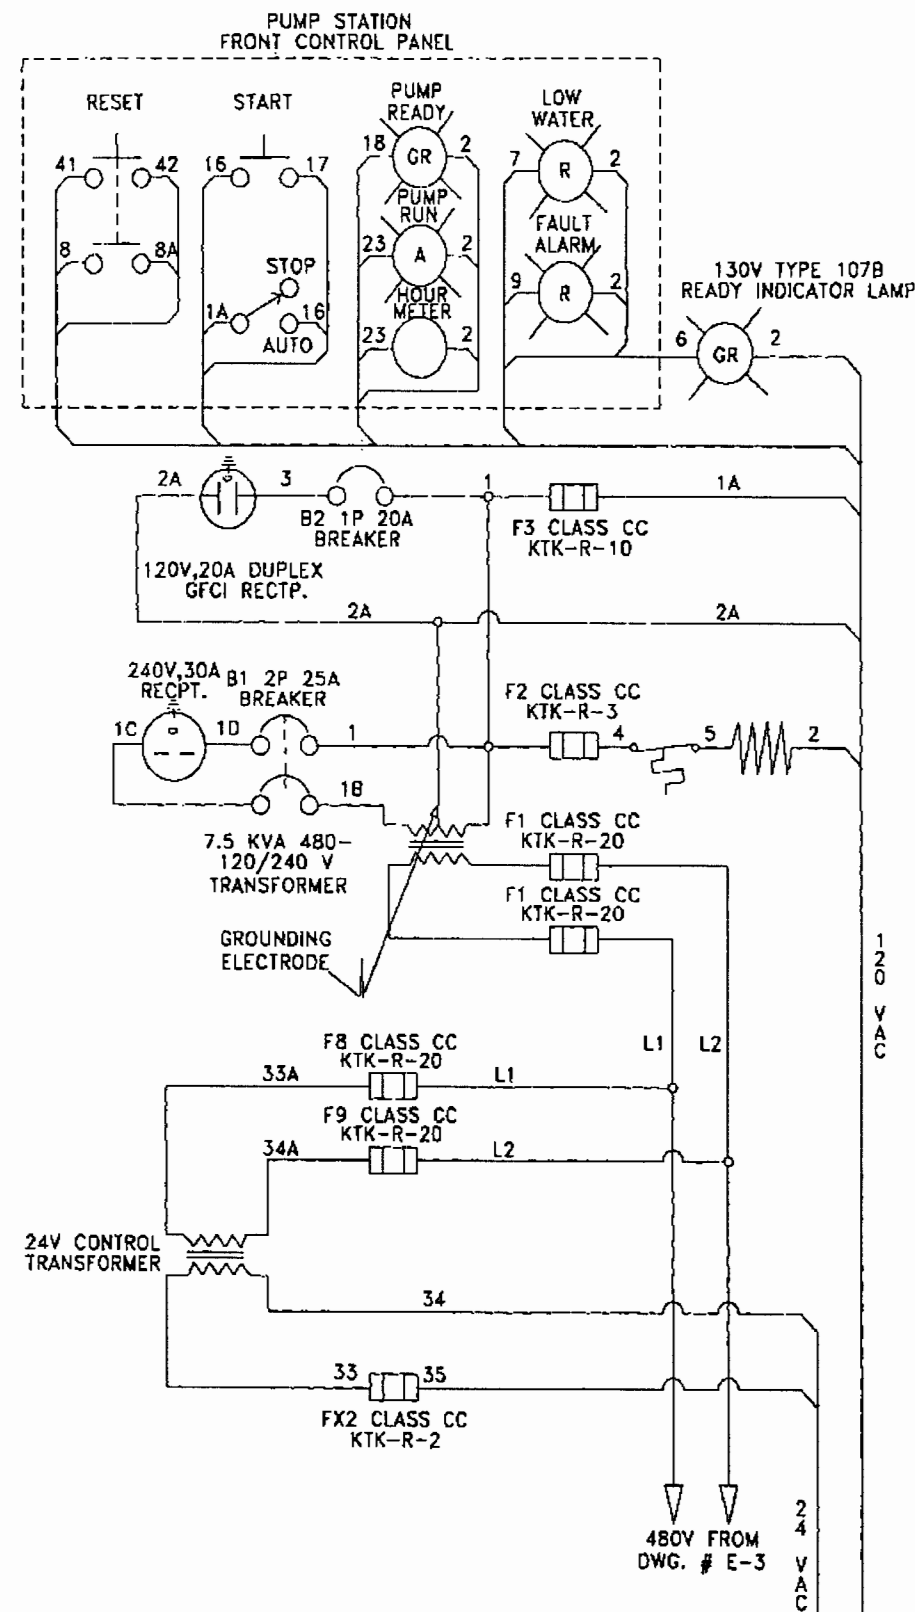

NOTE:  
1. BLACK WIRES DENOTE 480 VOLT CIRCUIT.  
RED & WHITE WIRES DENOTE 120 VOLT CIRCUIT.  
PURPLE & YELLOW WIRES DENOTE 24 VOLT CIRCUIT.

**Data Link Systems Inc.**  
AUTOMATION SYSTEMS  
P.O. Box 5586 Peoria, IL  
Ph. 313-77-0000 Zty 81001-5586

|                                                                                                                                             |               |                                   |                                  |
|---------------------------------------------------------------------------------------------------------------------------------------------|---------------|-----------------------------------|----------------------------------|
| U.S. ARMY ENGINEER DISTRICT<br>ROCK ISLAND, ILLINOIS                                                                                        |               | Date: APR 2001                    | Scale: AS SHOWN                  |
| Designed By: DWP                                                                                                                            | Drawn By: DRC | Checked By: 1-1-1-3-1-67          | Revision Number: DAC25-97-B-0032 |
| ILLINOIS WATERWAY PROGRAM<br>ENVIRONMENTAL MANAGEMENT<br>LA GRANGE POOL, MILE 124 TO 129.5<br>LAKE CHAUTAUQUA<br>OPERATIONS AND MAINTENANCE |               | PUMP CONTROLLER<br>WIRING DIAGRAM |                                  |
| Rev. 1                                                                                                                                      | Rev. 2        | Rev. 3                            | Rev. 4                           |
| Rev. 5                                                                                                                                      | Rev. 6        | Rev. 7                            | Rev. 8                           |
| Rev. 9                                                                                                                                      | Rev. 10       | Rev. 11                           | Rev. 12                          |
| Rev. 13                                                                                                                                     | Rev. 14       | Rev. 15                           | Rev. 16                          |
| Rev. 17                                                                                                                                     | Rev. 18       | Rev. 19                           | Rev. 20                          |
| Rev. 21                                                                                                                                     | Rev. 22       | Rev. 23                           | Rev. 24                          |
| Rev. 25                                                                                                                                     | Rev. 26       | Rev. 27                           | Rev. 28                          |
| Rev. 29                                                                                                                                     | Rev. 30       | Rev. 31                           | Rev. 32                          |
| Rev. 33                                                                                                                                     | Rev. 34       | Rev. 35                           | Rev. 36                          |
| Rev. 37                                                                                                                                     | Rev. 38       | Rev. 39                           | Rev. 40                          |
| Rev. 41                                                                                                                                     | Rev. 42       | Rev. 43                           | Rev. 44                          |
| Rev. 45                                                                                                                                     | Rev. 46       | Rev. 47                           | Rev. 48                          |
| Rev. 49                                                                                                                                     | Rev. 50       | Rev. 51                           | Rev. 52                          |
| Rev. 53                                                                                                                                     | Rev. 54       | Rev. 55                           | Rev. 56                          |
| Rev. 57                                                                                                                                     | Rev. 58       | Rev. 59                           | Rev. 60                          |
| Rev. 61                                                                                                                                     | Rev. 62       | Rev. 63                           | Rev. 64                          |
| Rev. 65                                                                                                                                     | Rev. 66       | Rev. 67                           | Rev. 68                          |
| Rev. 69                                                                                                                                     | Rev. 70       | Rev. 71                           | Rev. 72                          |
| Rev. 73                                                                                                                                     | Rev. 74       | Rev. 75                           | Rev. 76                          |
| Rev. 77                                                                                                                                     | Rev. 78       | Rev. 79                           | Rev. 80                          |
| Rev. 81                                                                                                                                     | Rev. 82       | Rev. 83                           | Rev. 84                          |
| Rev. 85                                                                                                                                     | Rev. 86       | Rev. 87                           | Rev. 88                          |
| Rev. 89                                                                                                                                     | Rev. 90       | Rev. 91                           | Rev. 92                          |
| Rev. 93                                                                                                                                     | Rev. 94       | Rev. 95                           | Rev. 96                          |
| Rev. 97                                                                                                                                     | Rev. 98       | Rev. 99                           | Rev. 100                         |

**U.S. ARMY ENGINEER DISTRICT**  
**ROCK ISLAND, ILLINOIS**

**ILLINOIS WATERWAY PROGRAM**  
**ENVIRONMENTAL MANAGEMENT**  
**LA GRANGE POOL, MILE 124 TO 129.5**  
**LAKE CHAUTAUQUA**  
**OPERATIONS AND MAINTENANCE**

**PUMP CONTROLLER**  
**WIRING DIAGRAM**

**Sheet Reference**  
**Number:**  
**E50**  
Sheet 61 of 84

| BILL OF MATERIAL |     |                 |                |                                                           |
|------------------|-----|-----------------|----------------|-----------------------------------------------------------|
| KEY ID           | QTY | CATALOG NUMBER  | DEV ID         | DESCRIPTION<br>MANUFACTURER                               |
| 1                | 1   | A-74H60DULP     |                | 2 DOOR NEMA 4<br>HOFFMAN                                  |
| 1.01             | 1   | A72P60          |                | MOUNTING PLATE<br>HOFFMAN                                 |
| 1.02             | 1   | A-201606FMLP    |                | NEMA 12 FLUSH MOUNT ENCLOSURE W/SWING OUT DOOR<br>HOFFMAN |
| 1.03             | 1   | A-DK20SS        | DRIP           | 20" NEMA 4 DRIP SHIELD<br>HOFFMAN                         |
| 1.04             | 1   | A-DK30SS        | DRIP           | 30" NEMA 4 DRIP SHIELD KIT<br>HOFFMAN                     |
| 1.05             | 1   | A-DK30SS        | DRIP           | 30" NEMA 4 DRIP SHIELD KIT<br>HOFFMAN                     |
| 2                | 1   | 779536-201      | ET METER       | ELAPSED TIME METER 120VAC 6-DIGIT<br>VEEGER-ROOT          |
| 3                | 1   | 8502-SG02V06    | CR             | SIZE 5 CONTACTOR<br>SQUARE D                              |
| 4                | 1   | 8502-SG02V06    | CS             | SIZE 5 CONTACTOR<br>SQUARE D                              |
| 5                | 1   | 8536-SH02V06    | M              | SIZE 6 STARTER<br>SQUARE D                                |
| 6                | 1   | 9001-SKR1GH5    | START          | GREEN PB<br>SQ D                                          |
| 7                | 1   | 9001-SKR1RH5    | LOW WTR        | RED NEMA 4 PILOT LIGHT 120VAC<br>SQ D                     |
| 8                | 1   | 9001-SKP1A31    | PUMP RUN       | AMBER PILOT LIGHT NEMA 4<br>SQ D                          |
| 9                | 1   | 9001-SKP1G31    | PUMP<br>READY  | GRN NEMA 4 PILOT LIGHT 120VAC<br>SQ D                     |
| 10               | 1   | 9001-SKP1R31    | RESET          | BLACK PB<br>SQ D                                          |
| 11               | 1   | 9001-SKP1R31    | FAULT<br>ALARM | RED NEMA 4 PILOT LIGHT 120VAC<br>SQ D                     |
| 12               | 1   | 9001-SKS11FBH1  | AUTO SW        | NEMA 4X 2-POS SEL SW WITH CONTACT BLOCK<br>SQ D           |
| 13               | 1   | AUTOTRANSFORMER | TRANS          | SIZE 6<br>SQUARE D                                        |
| 14               | 1   | WIRE-CHANNEL    |                | 3in wide X 22 7/16in long X 3in deep                      |
| 15               | 1   | WIRE-CHANNEL    |                | 3in wide X 24 1/16in long X 3in deep                      |
| 16               | 1   | WIRE-CHANNEL    |                | 3in wide X 23 9/16in long X 3in deep                      |
| 17               | 2   | WIRE-CHANNEL    |                | 3in wide X 22 13/16in long X 3in deep                     |
| 18               | 1   | 8501-NR51       |                | TIMING RELAY BASE<br>SQUARE D                             |
| 18.01            | 1   | 9050-JCK11-V20  | TR1            | 120 VOLT AC TIMING RELAY 0-TO SEC.<br>SQUARE D            |
| 19               | 1   | 8501-NR51       |                | TIMING RELAY BASE<br>SQUARE D                             |
| 19.01            | 1   | 9050-A012E      | TR2            | 120 VOLT AC TIMING RELAY 1 SEC. TO 3 MIN.<br>SQUARE D     |
| 20               | 1   | 8501-NR51       |                | TIMING RELAY BASE<br>SQUARE D                             |
| 20.01            | 1   | 9050-A010D      | TR3            | 440 VOLT AC TIMING RELAY 1 SEC. TO 3 MIN.<br>SQUARE D     |
| 20.02            | 3   | NH7             |                | TIMING RELAY BASE<br>SQUARE D                             |
| 21               | 1   | 8501-NR82       | C2             | KU RELAY BASE<br>SQUARE D                                 |
| 21.01            | 1   | KU12-V14        |                | 24 VOLT AC 10 AMP RELAY<br>SQUARE D                       |
| 22               | 1   | 8501-NR82       | C3             | KU RELAY BASE<br>SQUARE D                                 |
| 22.01            | 1   | KU12-V14        |                | 24 VOLT AC 10 AMP RELAY<br>SQUARE D                       |
| 23               | 1   | 8501-NR82       | C3A            | KU RELAY BASE<br>SQUARE D                                 |
| 23.01            | 1   | KU12-V14        |                | 24 VOLT AC 10 AMP RELAY<br>SQUARE D                       |
| 24               | 1   | 8501-NR82       | C4             | KU RELAY BASE<br>SQUARE D                                 |
| 24.01            | 1   | KU12-V14        |                | 24 VOLT AC 10 AMP RELAY<br>SQUARE D                       |
| 24.02            | 4   | NH2             |                | CLASS 8501 RETAINING STRAP<br>SQUARE D                    |
| 25               | 1   | 8501-X020-V02   | C5             | DPDT NEMA RELAY 120V AC<br>SQUARE D                       |

[illegible]

|                                                                                                                                                                              |  |
|------------------------------------------------------------------------------------------------------------------------------------------------------------------------------|--|
|  <b>US Army Corps of Engineers</b><br><b>Rock Island District</b>                         |  |
| <b>ILLINOIS WATERWAY</b><br><b>ENVIRONMENTAL MANAGEMENT PROGRAM</b><br><b>LA GRANGE ROAD MILE 24 TO 123.5</b><br><b>LAKE CHATAUGHUA</b><br><b>OPERATIONS AND MAINTENANCE</b> |  |
| <b>BILL OF MATERIAL</b>                                                                                                                                                      |  |
| Sheet Reference Number:<br><b>E60</b>                                                                                                                                        |  |
| Sheet 62 of 84                                                                                                                                                               |  |

 **Data Link Systems Inc.**  
Contractors / Engineers  
P.O. Box 5568 Peoria, IL  
Ph. 683-0886 Zip 61601-5568

| Item | Revision        | By     | Date    |
|------|-----------------|--------|---------|
| A    | MISC. REVISIONS | S.W.A. | 5/29/98 |
| B    | RESTART DELAY   | L.R.   | 5/98    |

Original: PUMP STATION CONTROL PANEL

Specific: PANEL LAYOUT DRAWINGS

Eng S. 20 D Plot Factor

Eng Date: 4-18-94

Cust Eng. Eng. 8


# ARMY CORP OF ENG.

## LAKE CHAUTAUQUA

Vendor Eng. 8

# E-5



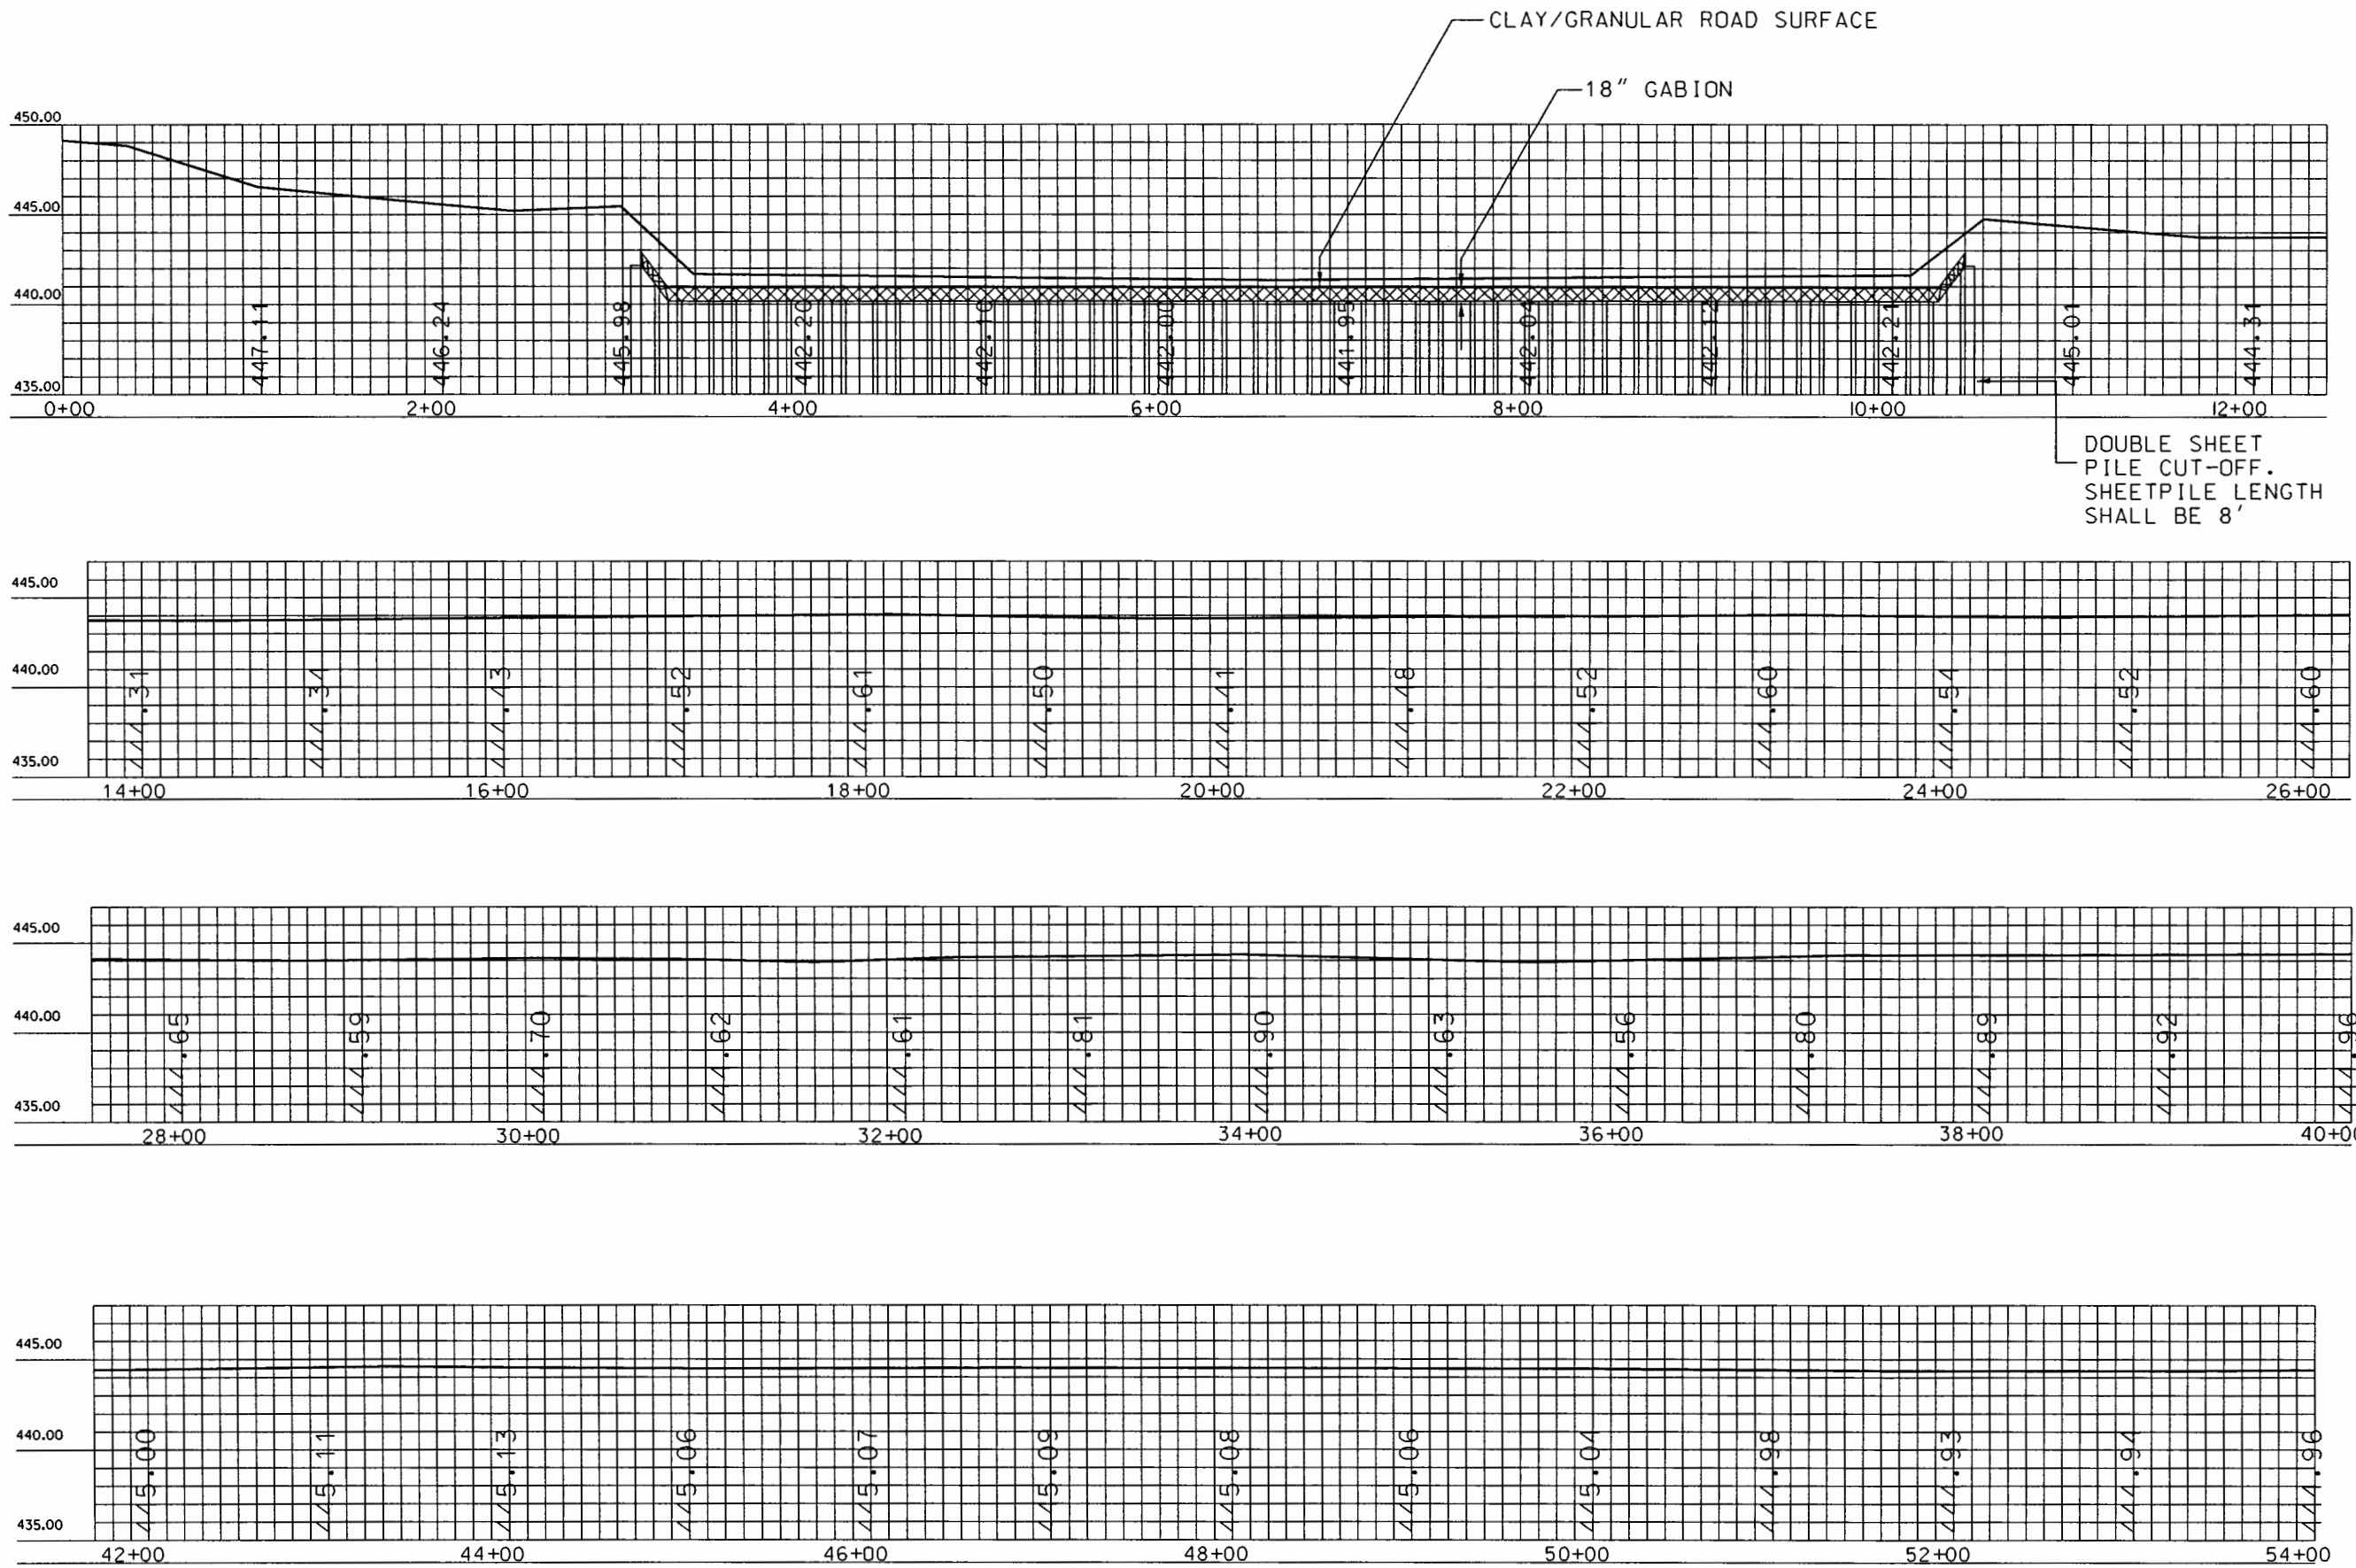

NOTE:  
USFWS CONSTRUCTED THE LOWER LAKE LEVEE IMPROVEMENT.  
USACE DEVELOPED AS-BUILTS FROM AUGUST 2000 GPS SURVEY.


| Symbol         | Description | Date | Revised |
|----------------|-------------|------|---------|
| AS CONSTRUCTED |             |      |         |

|                    |                                   |
|--------------------|-----------------------------------|
| Designed By: USFWS | Date: MAR 1999                    |
| Drawn By: DWP      | Scale: AS SHOWN                   |
| Checked By: DRC    | Drawing Code: 1-L-1-3-1/67        |
| Reviewed By: RAL   | Revision Number: DACW25-97-B-0032 |

ILLINOIS WATERWAY  
ENVIRONMENTAL MANAGEMENT PROGRAM  
LA GRANGE LAKE, CHANDLER MAINTENANCE  
OPERATIONS AND MAINTENANCE  
**LOWER LAKE  
LEVEE PROFILES**  
**0+00 F - 54+00 F**

Sheet  
Reference  
Number:  
**F180**  
Sheet 63 of 84



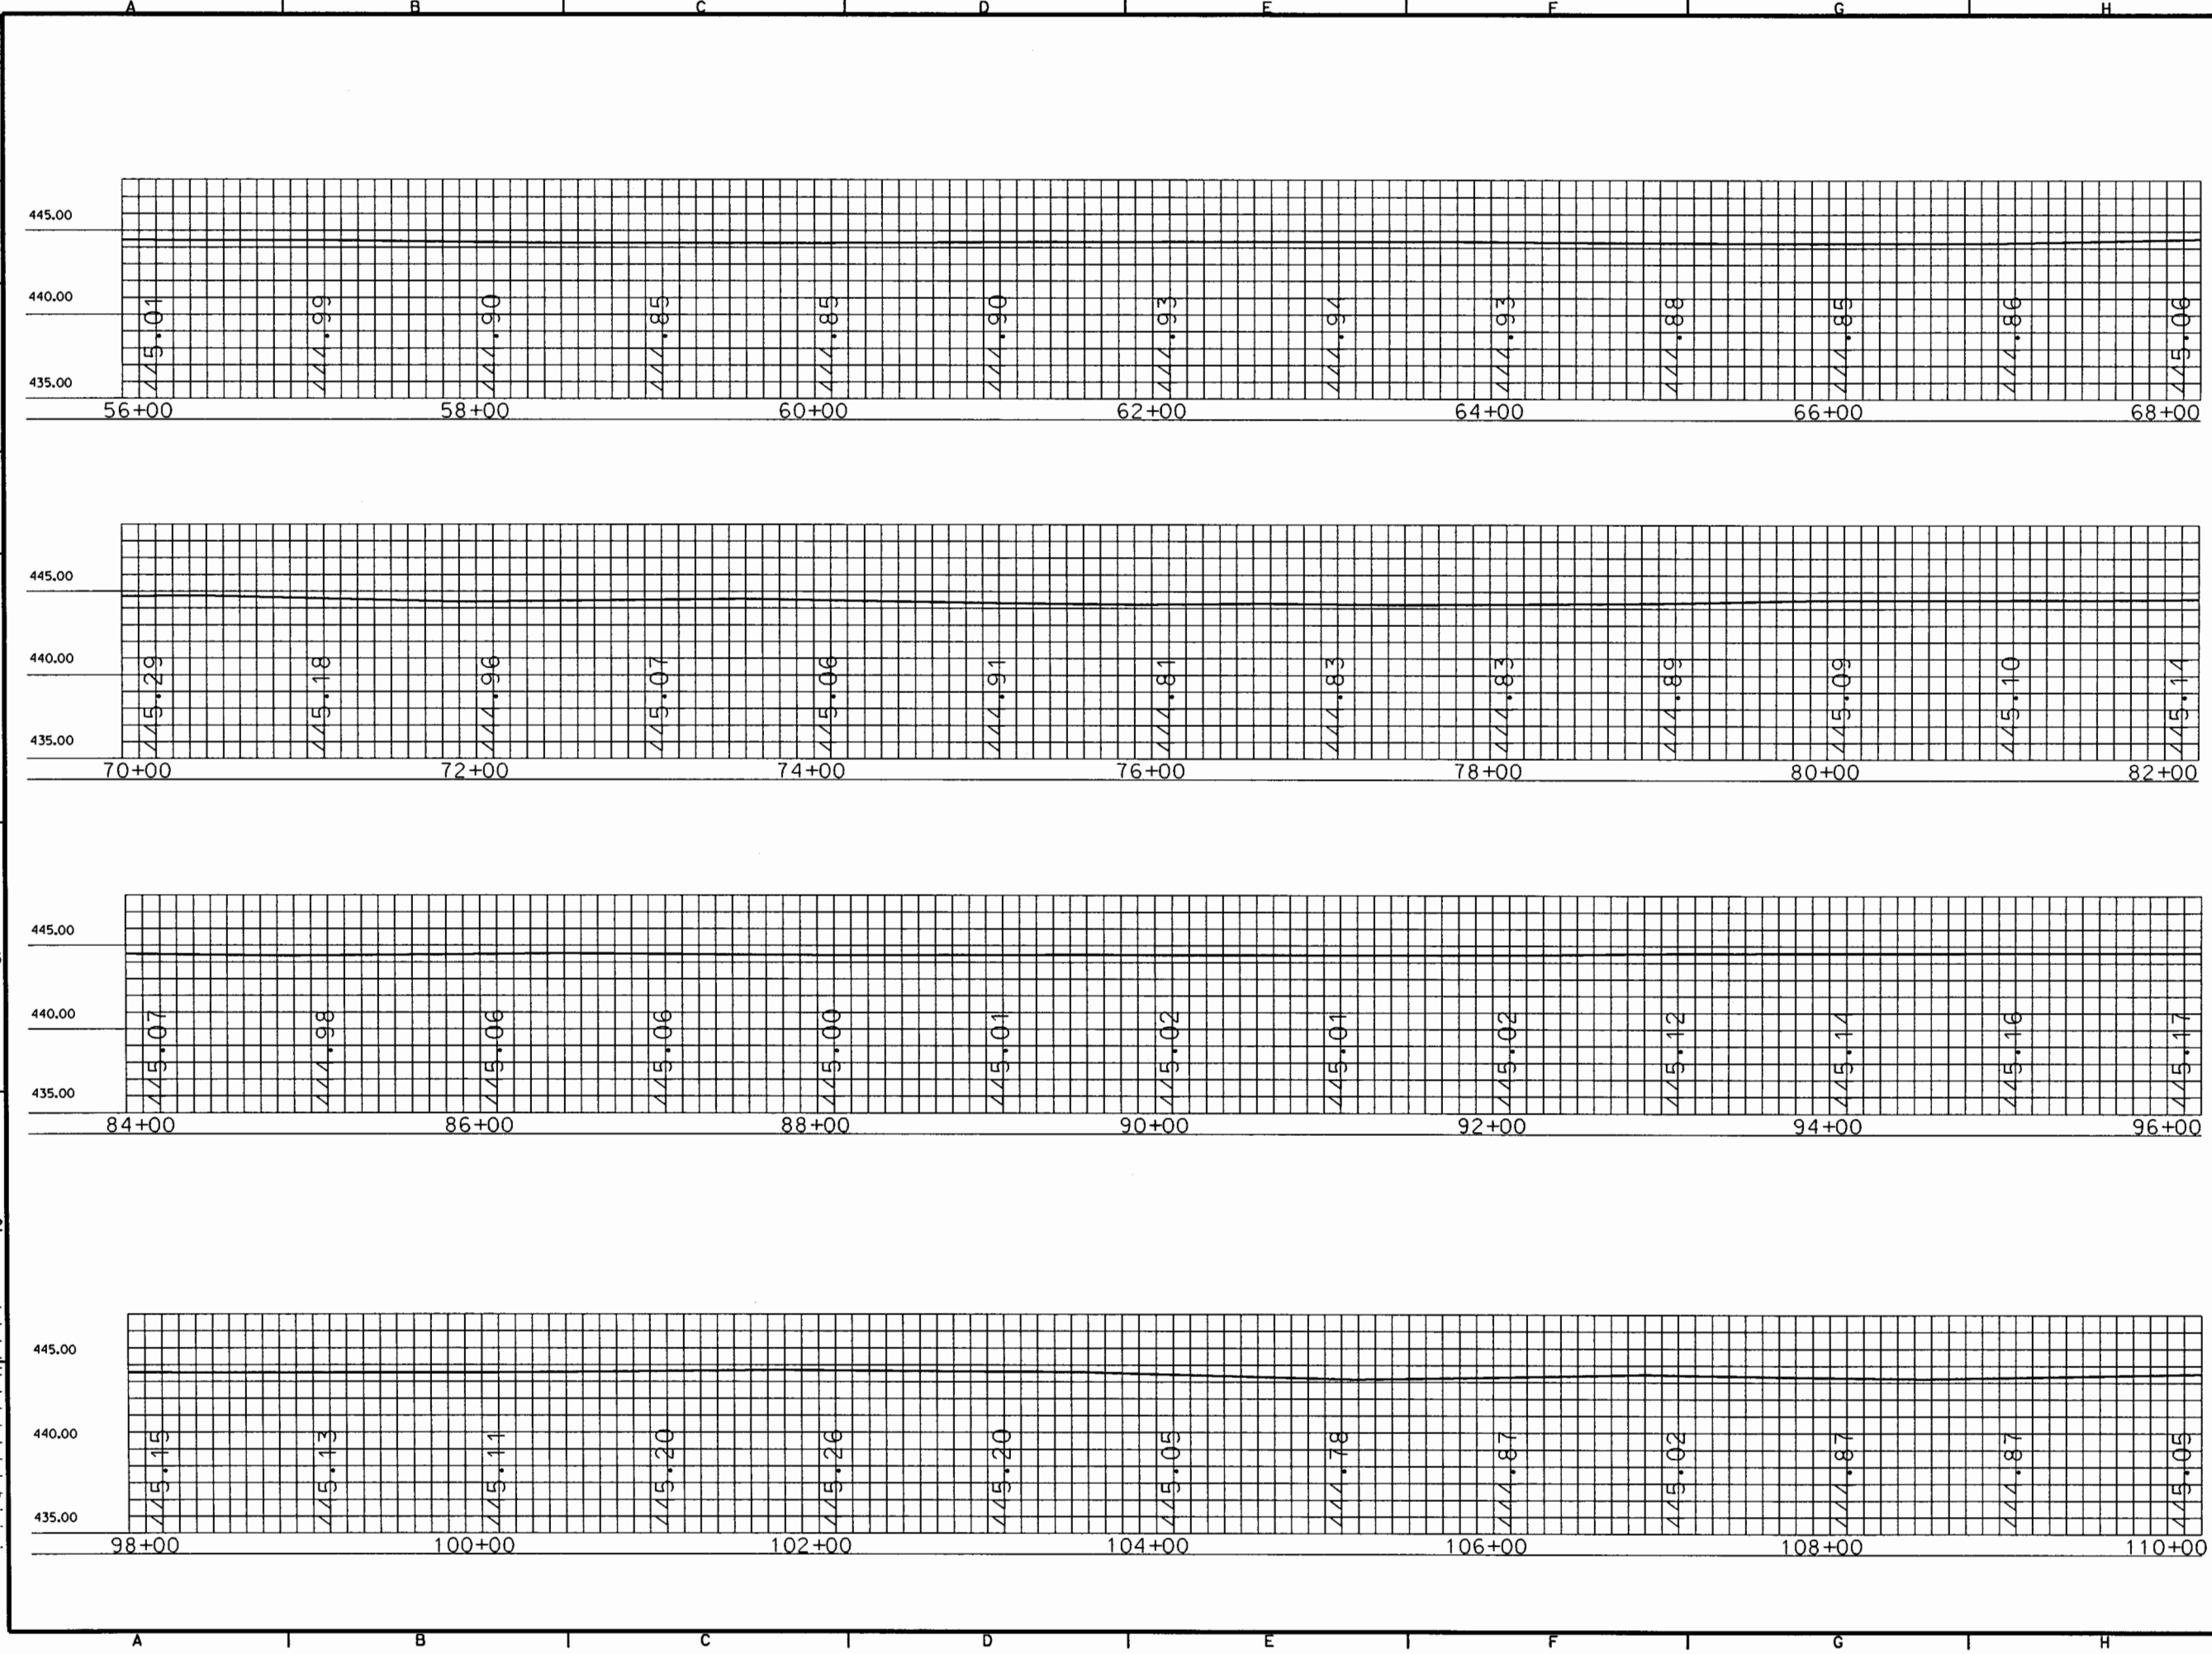

| Symbol         | Description | Date | Approved |
|----------------|-------------|------|----------|
| AS CONSTRUCTED |             |      |          |


|                    |                                              |
|--------------------|----------------------------------------------|
| Designed By: USFWS | Date: MAR 1999                               |
| Drawn By: DWP      | Scale: AS SHOWN                              |
| Checked By: DRC    | Drawing Code: 1-L1-3-1/67                    |
| Reviewed By: RAL   | Soil Classification Number: DACK25-97-B-0032 |

ILLINOIS WATERWAY  
ENVIRONMENTAL MANAGEMENT PROGRAM  
LA GRANGE POOL, MILE 124 TO 129.5  
OPERATIONS AND MAINTENANCE  
LOWER LAKE  
56+00 F - 110+00 F

Sheet  
Reference  
Number:  
**F190**  
Sheet 64 of 84





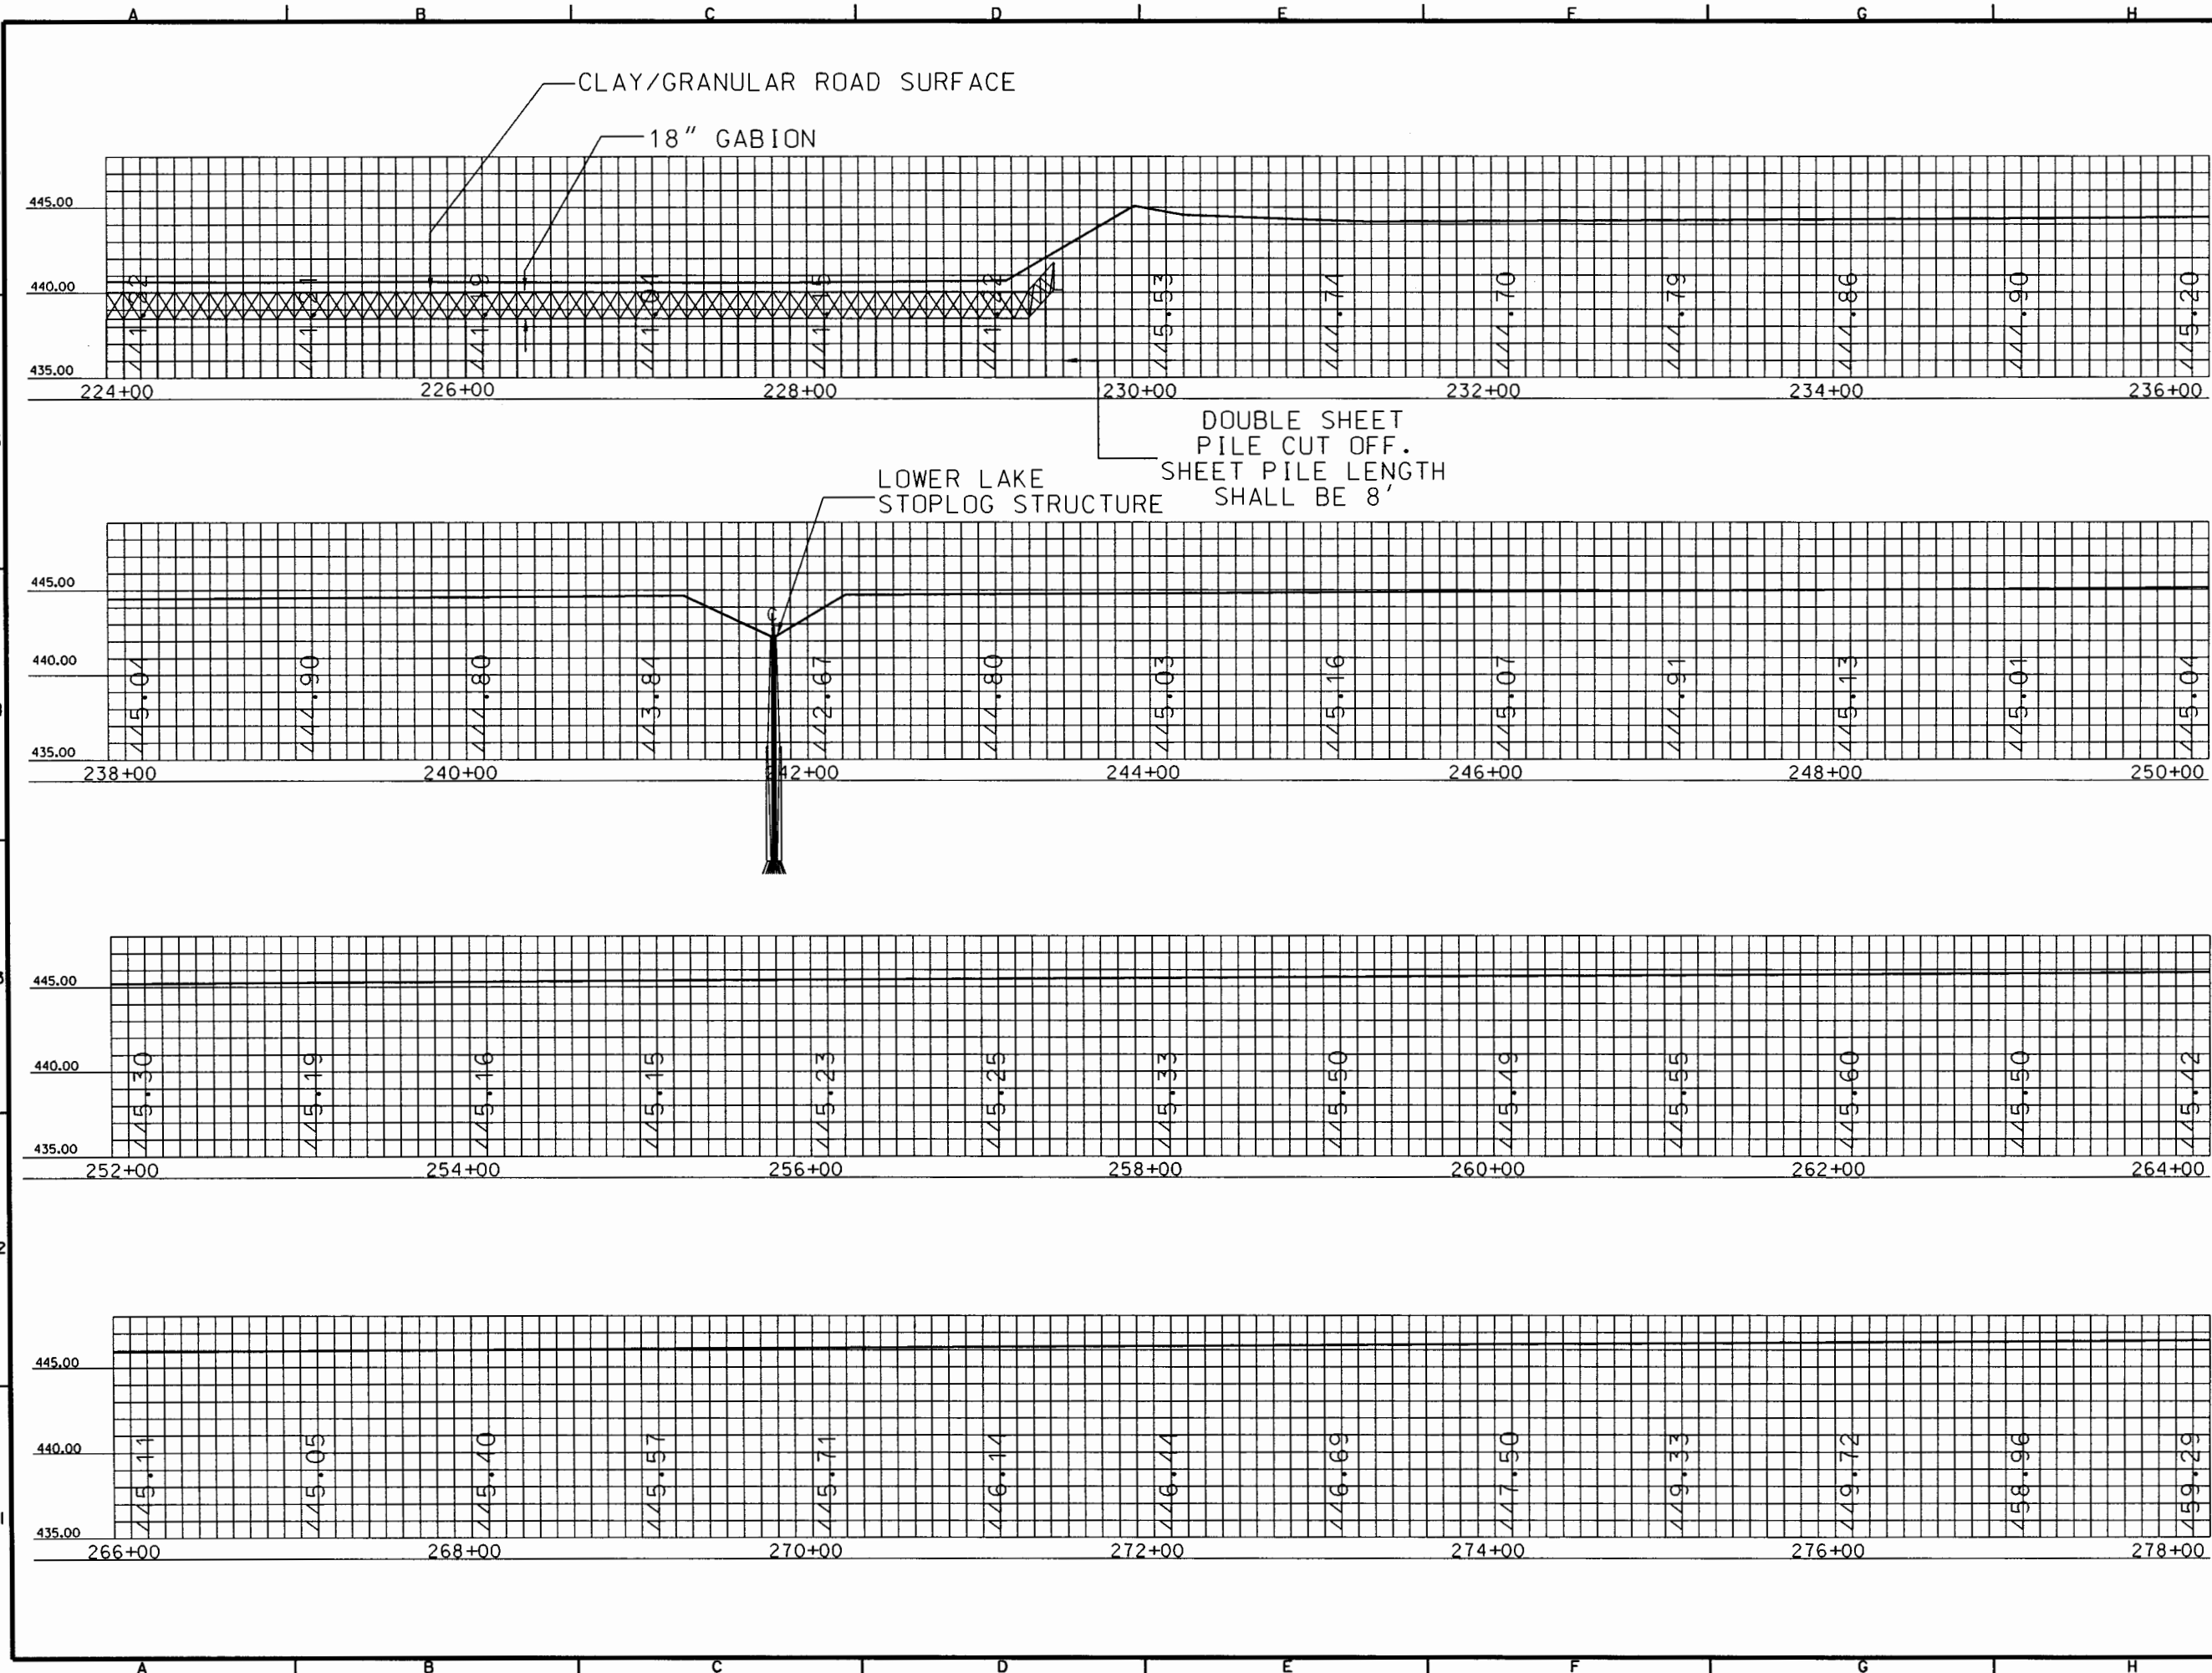




| Symbol         | Description | Date | Approved |
|----------------|-------------|------|----------|
| AS CONSTRUCTED |             |      |          |

|              |       |                      |                  |
|--------------|-------|----------------------|------------------|
| Designed By: | USFWS | Date:                | MAR 1999         |
| Drawn By:    | DWP   | Scale:               | AS SHOWN         |
| Checked By:  | DRC   | Drawing Code:        | 1-1-1-3-1/67     |
| Reviewed By: | RAL   | Solicitation Number: | DACW25-97-B-0032 |

ILLINOIS WATERWAY  
ENVIRONMENTAL MANAGEMENT PROGRAM  
LA ORANGE POOL, MILE 124 TO 129.5  
LAKE CHATAUGUA  
OPERATIONS AND MAINTENANCE  
**LOWER LAKE  
LEVEE PROFILES**  
**224+00 F - 278+00 F**

Sheet  
Reference  
Number:  
**F220**  
Sheet 67 of 84



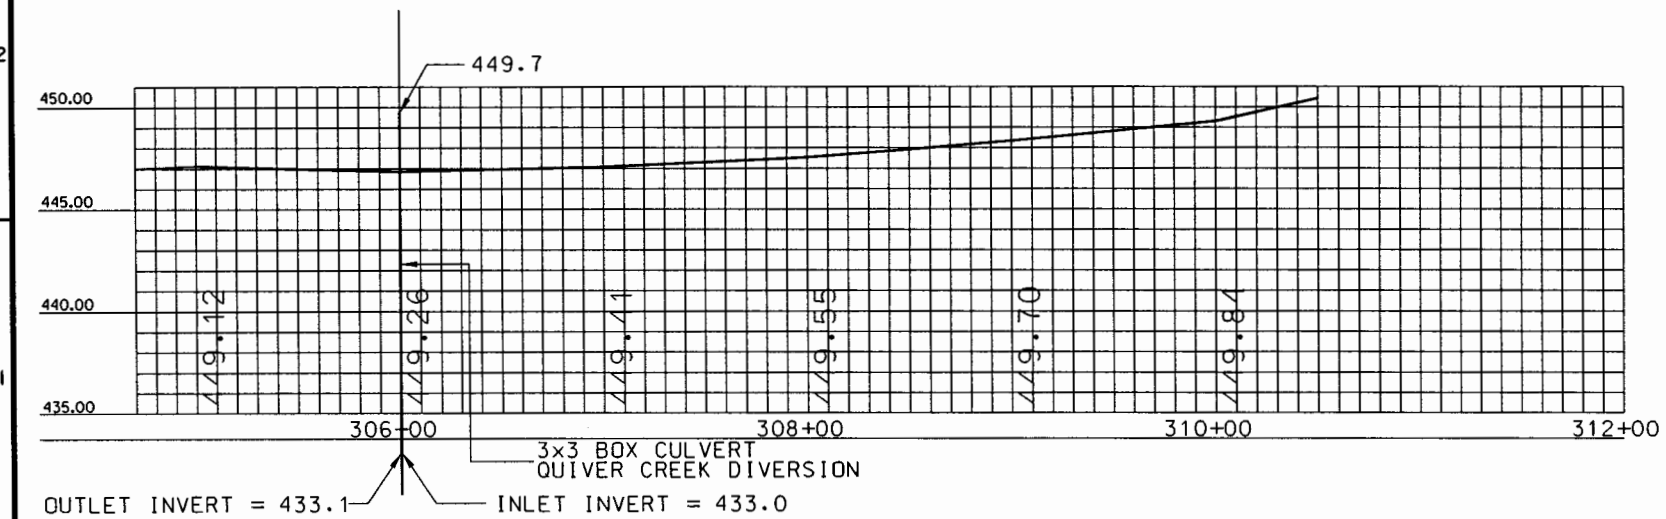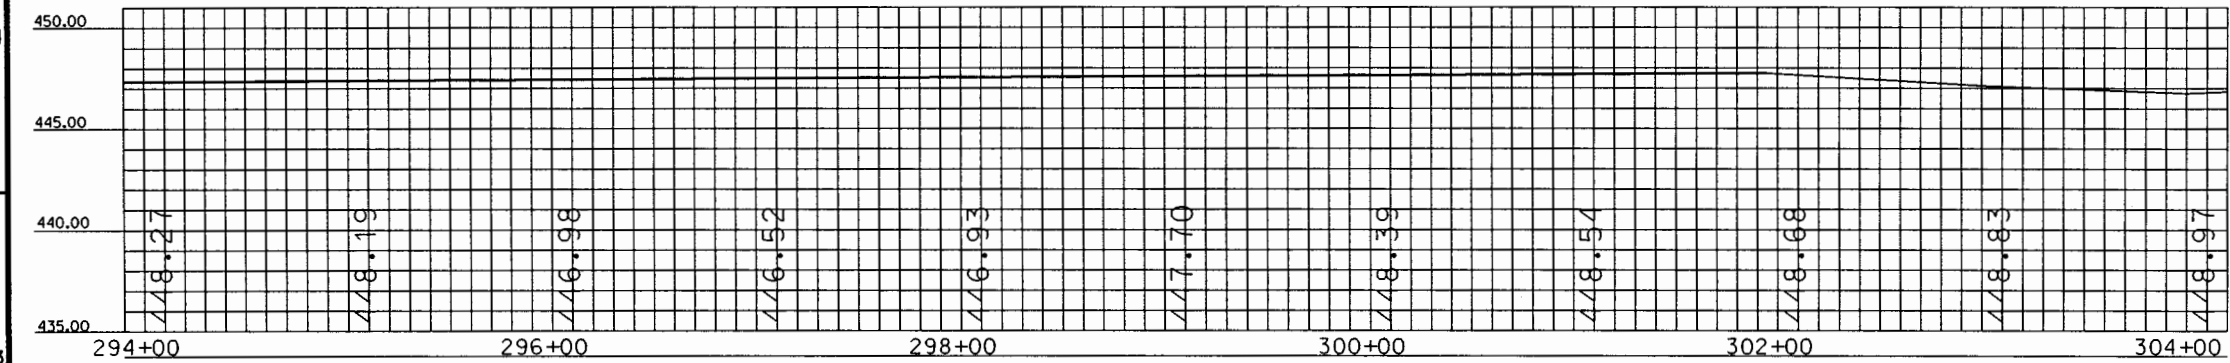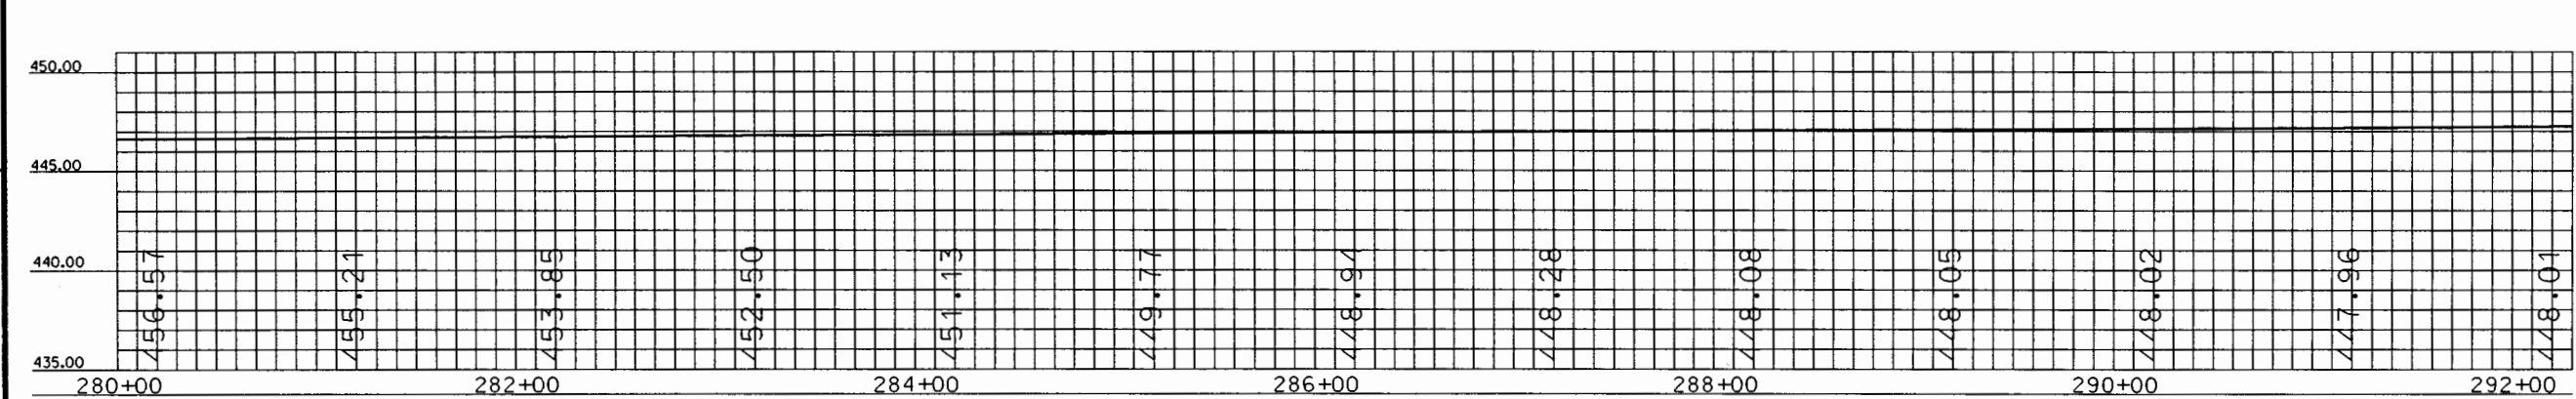

| Symbol | Description | Revisions | Date | Approved |
|--------|-------------|-----------|------|----------|
| AS     | CONSTRUCTED |           |      |          |

|                                                                            |                                                                            |                                                                                                       |
|----------------------------------------------------------------------------|----------------------------------------------------------------------------|-------------------------------------------------------------------------------------------------------|
| U.S. ARMY ENGINEER DISTRICT<br>CORPS OF ENGINEERS<br>ROCK ISLAND, ILLINOIS | Designed By: USFWS<br>Drawn By: DWP<br>Checked By: DRC<br>Reviewed By: RAL | Date: MAR 1999<br>Scale: AS SHOWN<br>Drawing Code: 1-L-3-1/67<br>Calculation Number: DACW25-97-B-0032 |
|----------------------------------------------------------------------------|----------------------------------------------------------------------------|-------------------------------------------------------------------------------------------------------|

ILLINOIS WATERWAY  
ENVIRONMENTAL MANAGEMENT PROGRAM  
LA GRANGE POOL, MILE 124 TO 129.5  
LAKE CHAUTAUQUA  
OPERATIONS AND MAINTENANCE  
**LOWER LAKE  
LEVEE PROFILES**  
**280+00 F - 312+00 F**


Sheet  
Reference  
Number:  
**F230**  
Sheet 68 of 84









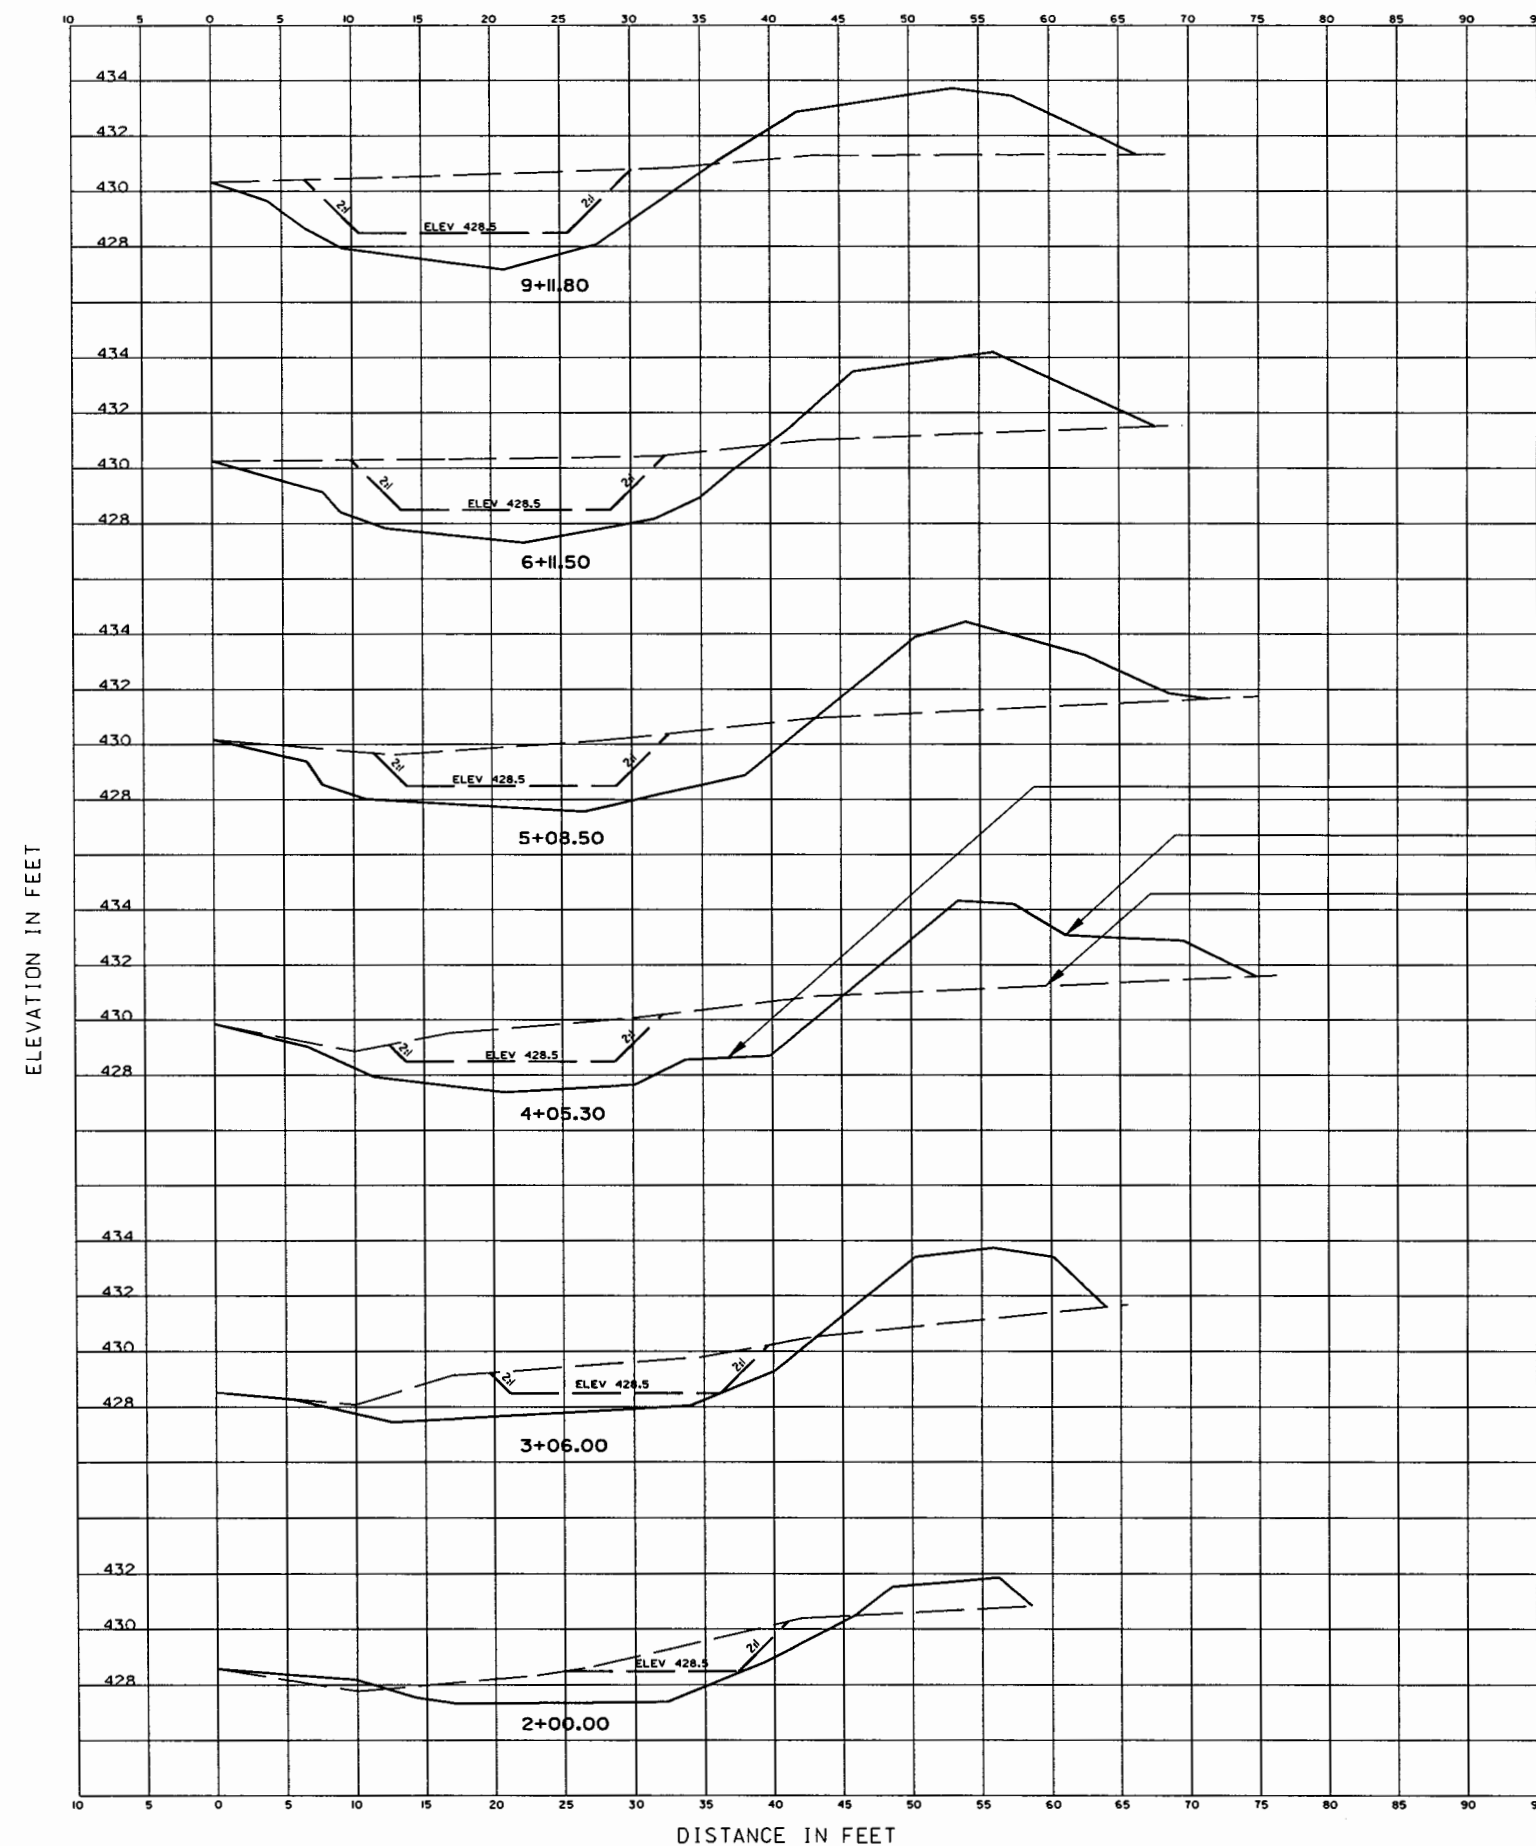

## — EXCAVATION

— SPOIL BERM - STONE FORDS ARE  
NOT SHOWN

— EXISTING LAKEBED SURFACE


AS BUILT CROSS SECTIONS PROVIDED BY:  
RJS CONSTRUCTORS  
J. RAMPELBERG  
11/24/03

[illegible]

|                                                                      |              |     |                      |                  |
|----------------------------------------------------------------------|--------------|-----|----------------------|------------------|
| U.S. ARMY ENGINEERING<br>CORPS OF ENGINEERS<br>ROCK ISLAND, ILLINOIS | Designed By: | DRC | Date:                | MAR 2001         |
|                                                                      | Drawn By:    | DWP | Scale:               | AS SHOWN         |
|                                                                      | Checked By:  | KNM | Project Code:        | 1-L1-3-1/67      |
|                                                                      | Reviewed By: |     | Solicitation Number: | DACW5-01-86-0012 |


**ILLINOIS WATERWAY  
ENVIRONMENTAL MANAGEMENT PROGRAM  
LA GRANGE POOL MILE 124 TO 129.5  
LAKE CHAUTAUQUA  
OPERATIONS AND MAINTENANCE**

Sheet  
Reference  
Number:  
**F270**  
Sheet 72 of 84

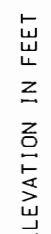

— EXISTING LAKEBED SURFACE

AS BUILT CROSS SECTIONS PROVIDED BY:  
RJS CONSTRUCTORS  
J. RAMPELBERG  
11/24/03

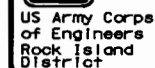
[illegible]

|                                                                            |              |     |                      |              |
|----------------------------------------------------------------------------|--------------|-----|----------------------|--------------|
| U.S. ARMY ENGINEER DISTRICT<br>CORPS OF ENGINEERS<br>ROCK ISLAND, ILLINOIS | Designed By: | DRC | Date:                | MAR 2001     |
|                                                                            | Drawn By:    | DWP | Scale:               | AS SHOWN     |
|                                                                            | Checked By:  | KNM | Project Code:        | 1-L1-3-1/67  |
|                                                                            | Reviewed By: | DRC | Solicitation Number: | DWPM-21-0002 |

**ILLINOIS WATERWAY  
ENVIRONMENTAL MANAGEMENT  
PROGRAM  
LA GRANGE POOL, MILE 124 TO 129.5  
LAKE CHAUTAUQUA  
OPERATIONS AND MAINTENANCE**

Sheet  
Reference  
Number:  
**F280**  
Sheet 72 of 84

02-MAR-2005 15:14  
\\mrdfsec02\proj\ecise\p52\03M Manual - Use this one\p52\230.dgn

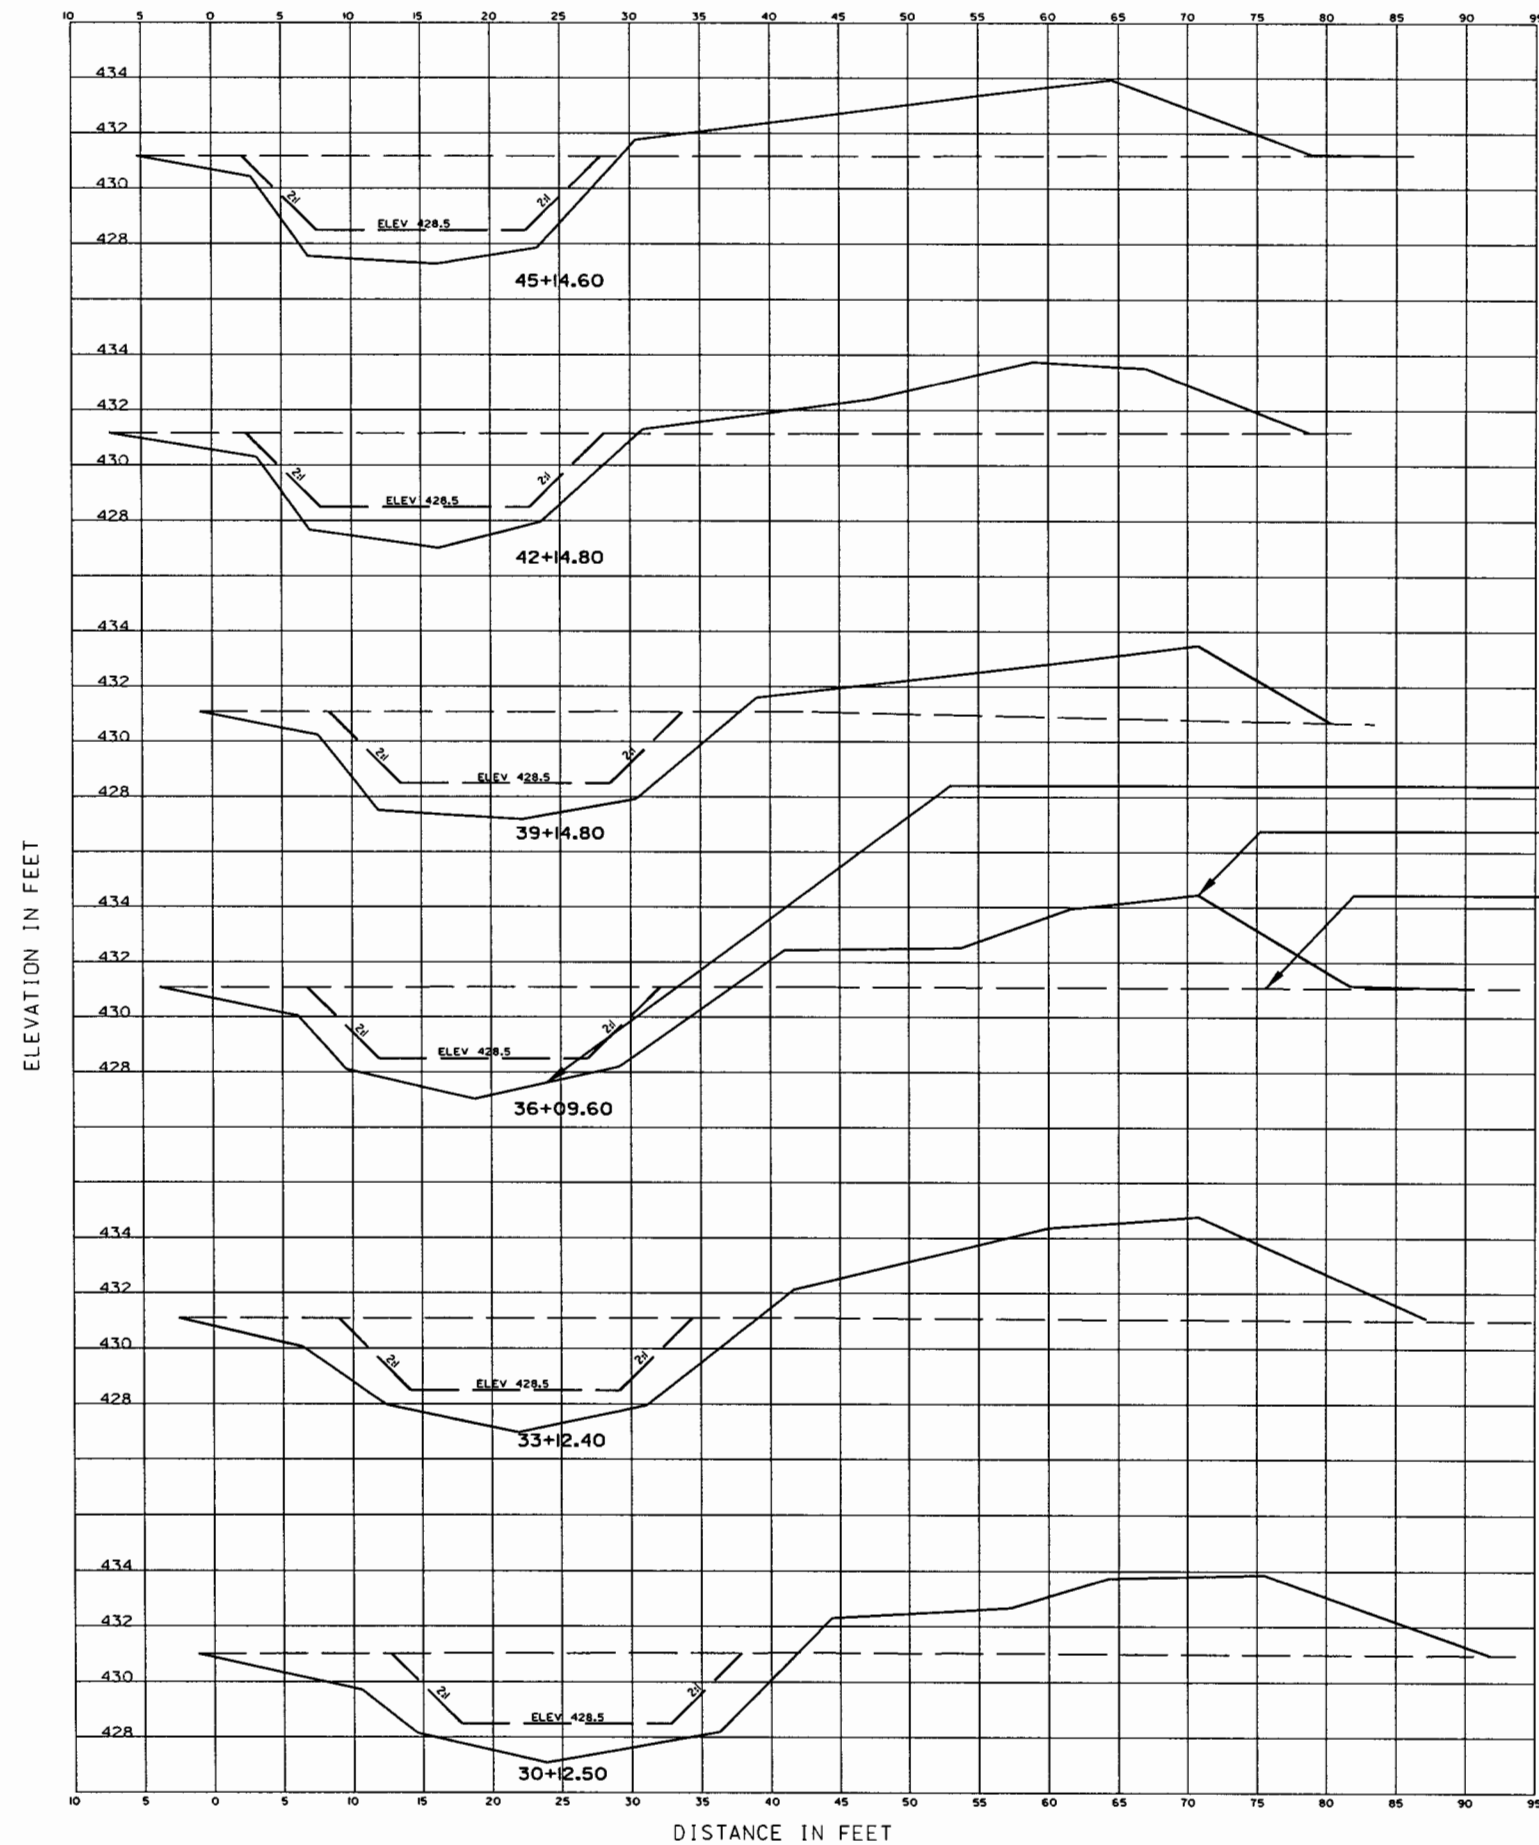

EXCAVATION  
SPOIL BERM - STONE FORDS ARE NOT SHOWN  
EXISTING LAKEBED SURFACE

AS BUILT CROSS SECTIONS PROVIDED BY:  
RJS CONSTRUCTORS  
J. RAMPENBERG  
11/24/03




| Symbol    | Description | Revisions |
|-----------|-------------|-----------|
| AS BUILT  |             |           |
| 18 MAR 04 |             | Approved  |
| Date      |             |           |

|                                                                            |          |           |          |               |              |                      |                  |
|----------------------------------------------------------------------------|----------|-----------|----------|---------------|--------------|----------------------|------------------|
| Designed By:                                                               | DRC      | Drawn By: | DWP      | Checked By:   | KNM          | Reviewed By:         | DRC              |
| Date:                                                                      | MAR 2001 | Series:   | AS SHOWN | Project Code: | 1-L-1-3-1/67 | Solicitation Number: | DACW25-01-B-0012 |
| U.S. ARMY ENGINEER DISTRICT<br>CORPS OF ENGINEERS<br>ROCK ISLAND, ILLINOIS |          |           |          |               |              |                      |                  |

ILLINOIS WATERWAY PROGRAM  
ENVIRONMENTAL MANAGEMENT TO T25.5  
LA GRANGE, ILL. CHAULTAQUA  
OPERATIONS AND MAINTENANCE  
**LOWER LAKE  
DEWATERING CHANNEL  
CROSS SECTIONS III**

Sheet  
Reference  
Number:  
**F290**  
Sheet 74 of 84

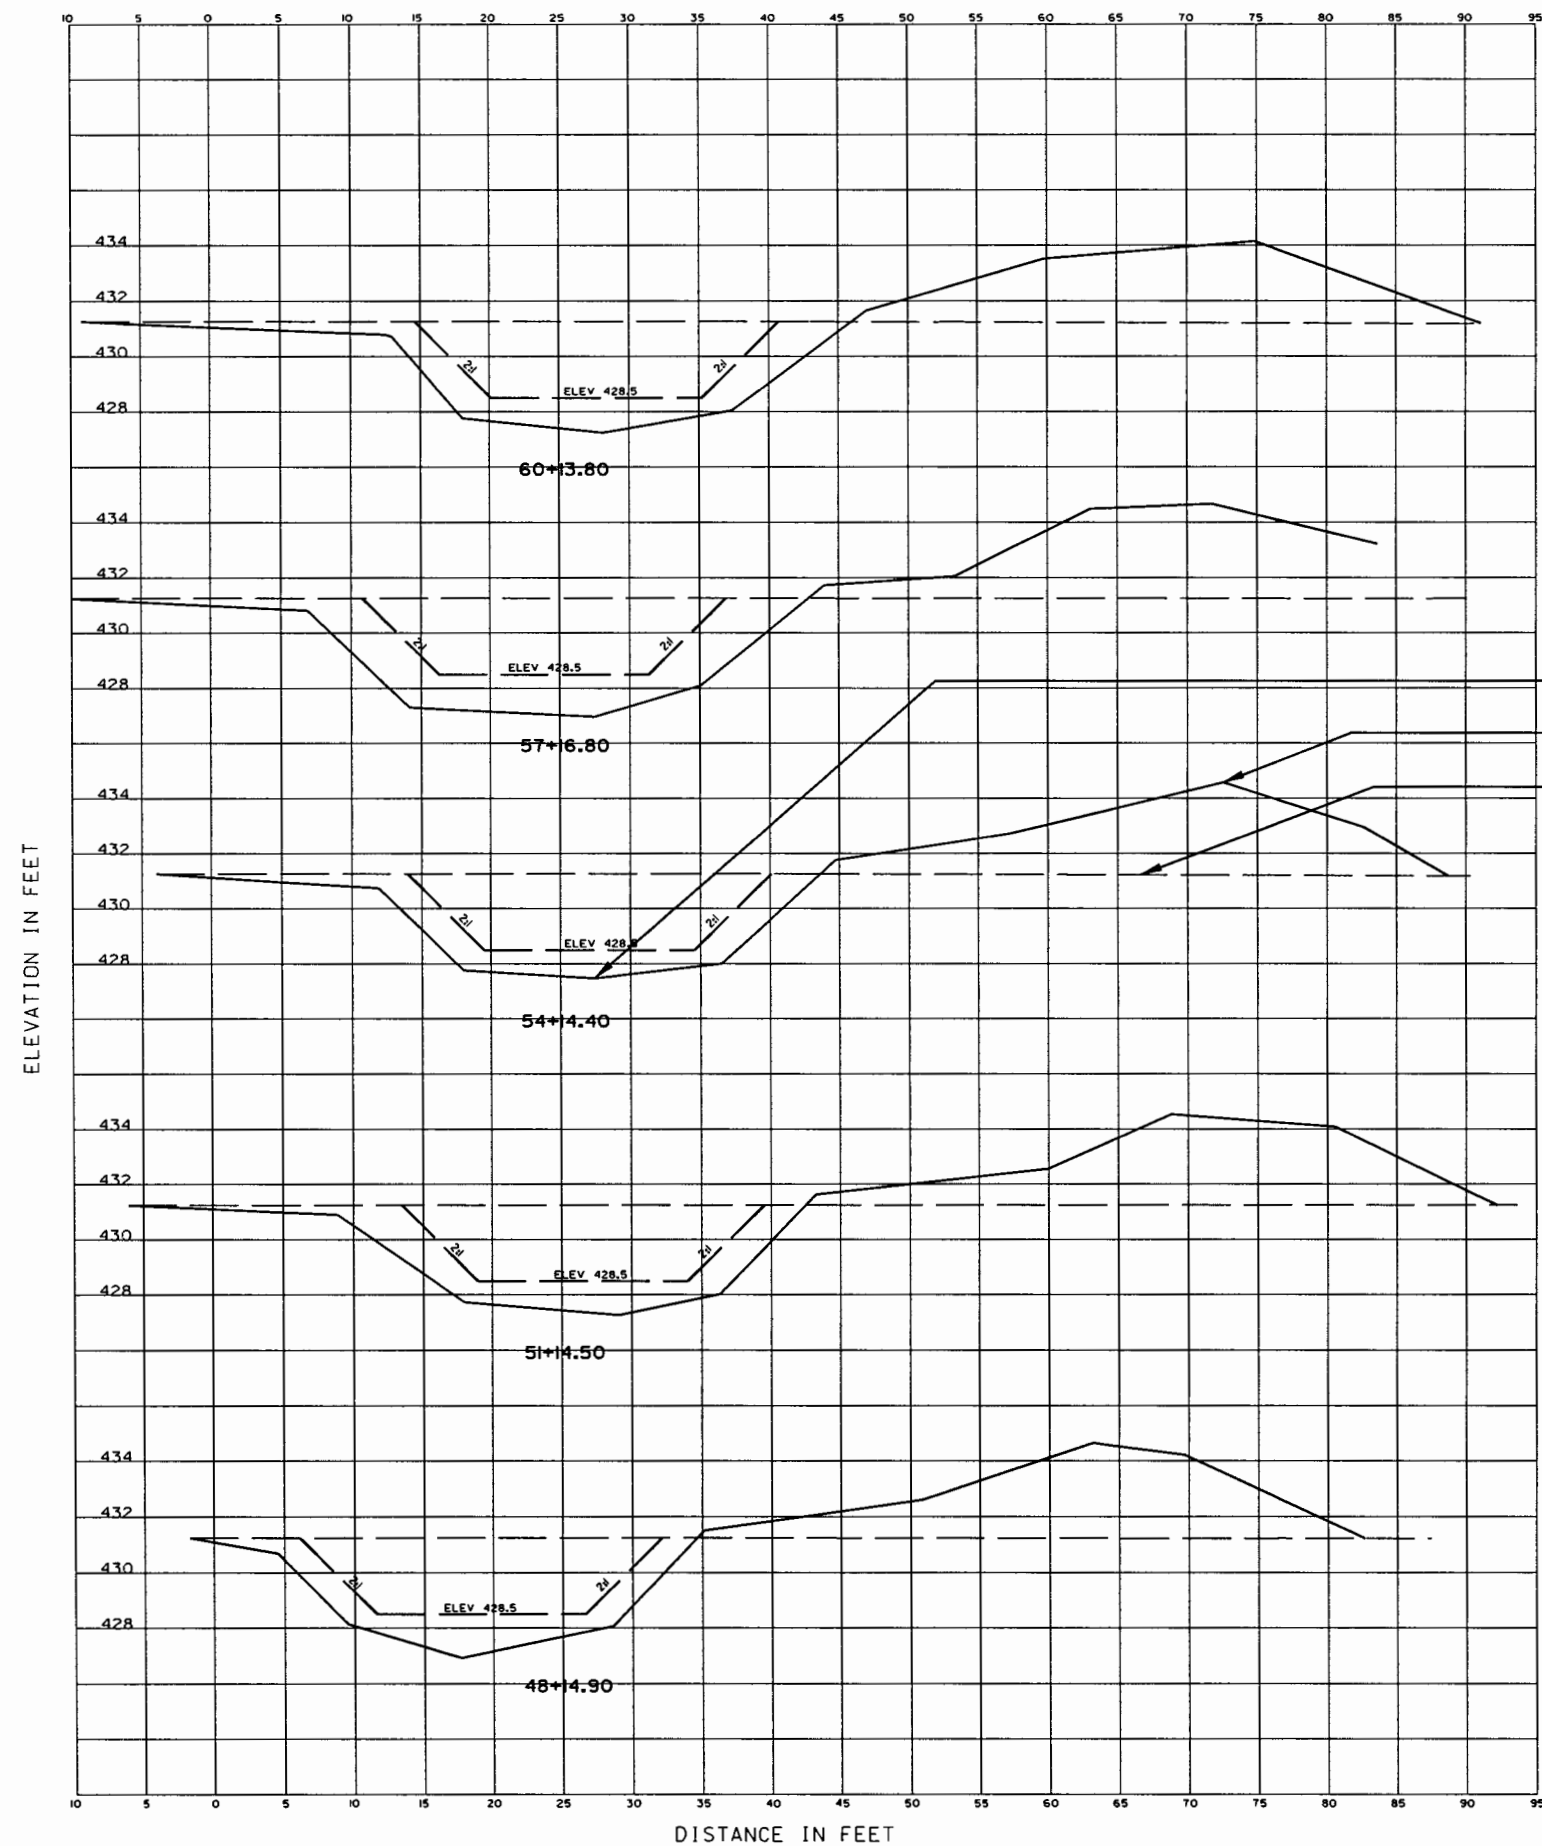

EXCAVATION  
 SPOIL BERM - STONE FORDS ARE NOT SHOWN  
 EXISTING LAKEBED SURFACE

AS BUILT CROSS SECTIONS PROVIDED BY:  
 RJS CONSTRUCTORS  
 J. RAMPENBERG  
 11/24/03




| Symbol    | Description | Revisions |
|-----------|-------------|-----------|
| AS BUILT  |             |           |
| 11 MAR 04 |             |           |
| Date      |             |           |
| Approved  |             |           |

|                                                      |                  |                                  |
|------------------------------------------------------|------------------|----------------------------------|
| U.S. ARMY ENGINEER DISTRICT<br>ROCK ISLAND, ILLINOIS | Designed By: DRC | Date: MAR 2001                   |
|                                                      | Drawn By: DWP    | Scale: AS SHOWN                  |
|                                                      | Checked By: KNM  | Project Code: 1-L-1-3-1/67       |
|                                                      | Reviewed By: DRC | Revision Number: DAC25-01-B-0012 |

ILLINOIS WATERWAY PROGRAM  
 ENVIRONMENTAL MANAGEMENT  
 LA GRANGE POOL - MILE 124 TO 129.5  
 CHAULTAUGUI  
 OPERATIONS AND MAINTENANCE  
**LOWER LAKE  
 DEWATERING CHANNEL  
 CROSS SECTIONS IV**

Sheet  
 Reference  
 Number:  
**F300**  
 Sheet 75 of 84

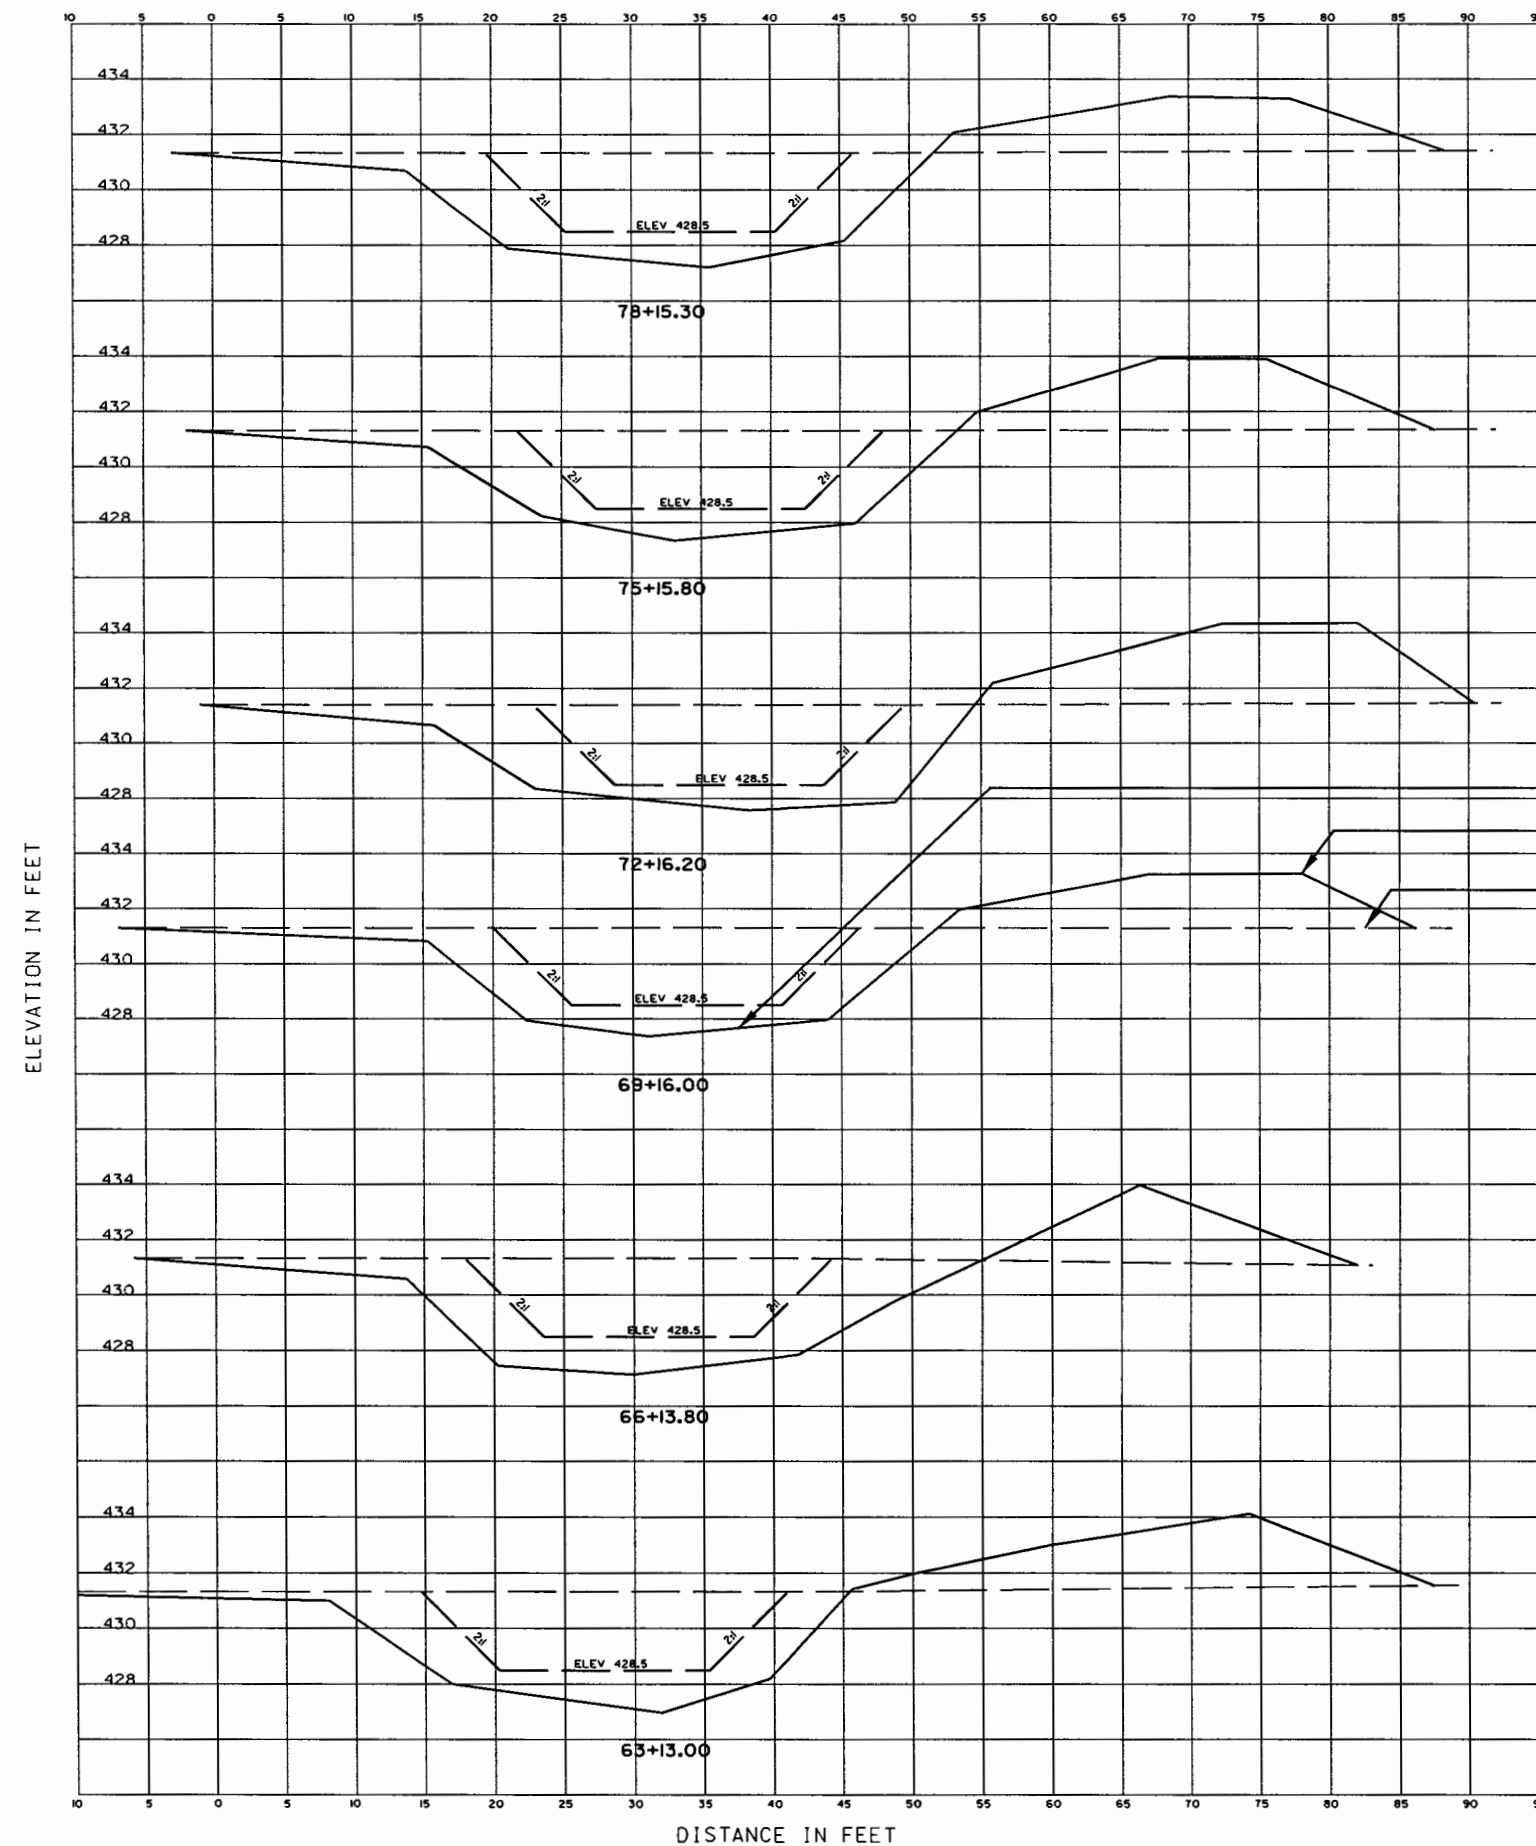

## EXCAVATION

— SPOIL BERM - STONE FORDS ARE NOT SHOWN

— EXISTING LAKEBED SURFACE

AS BUILT CROSS SECTIONS PROVIDED BY:  
RJS CONSTRUCTORS  
J. RAMPENBERG  
11/24/03


[illegible]

|                                                                            |                  |                                       |
|----------------------------------------------------------------------------|------------------|---------------------------------------|
| U.S. ARMY ENGINEER DISTRICT<br>CORPS OF ENGINEERS<br>ROCK ISLAND, ILLINOIS | Designed By: DRC | Date: MAR 2001                        |
|                                                                            | Brown By: DWP    | Score: AS SHOWN                       |
|                                                                            | Checked By: KMM  | Project Code: 1-L-1-3-1/67            |
|                                                                            | Reviewed By: DRC | Solicitation Number: DACW25-01-B-0012 |

**ILLINOIS WATERWAY  
ENVIRONMENTAL MANAGEMENT PROGRAM  
LA GRANGE POOL, MILE 124 TO 129.5  
LAKE CHAUTAUQUA  
OPERATIONS AND MAINTENANCE**

Sheet  
Reference  
Number:  
**F310**  
Sheet 76 of 84



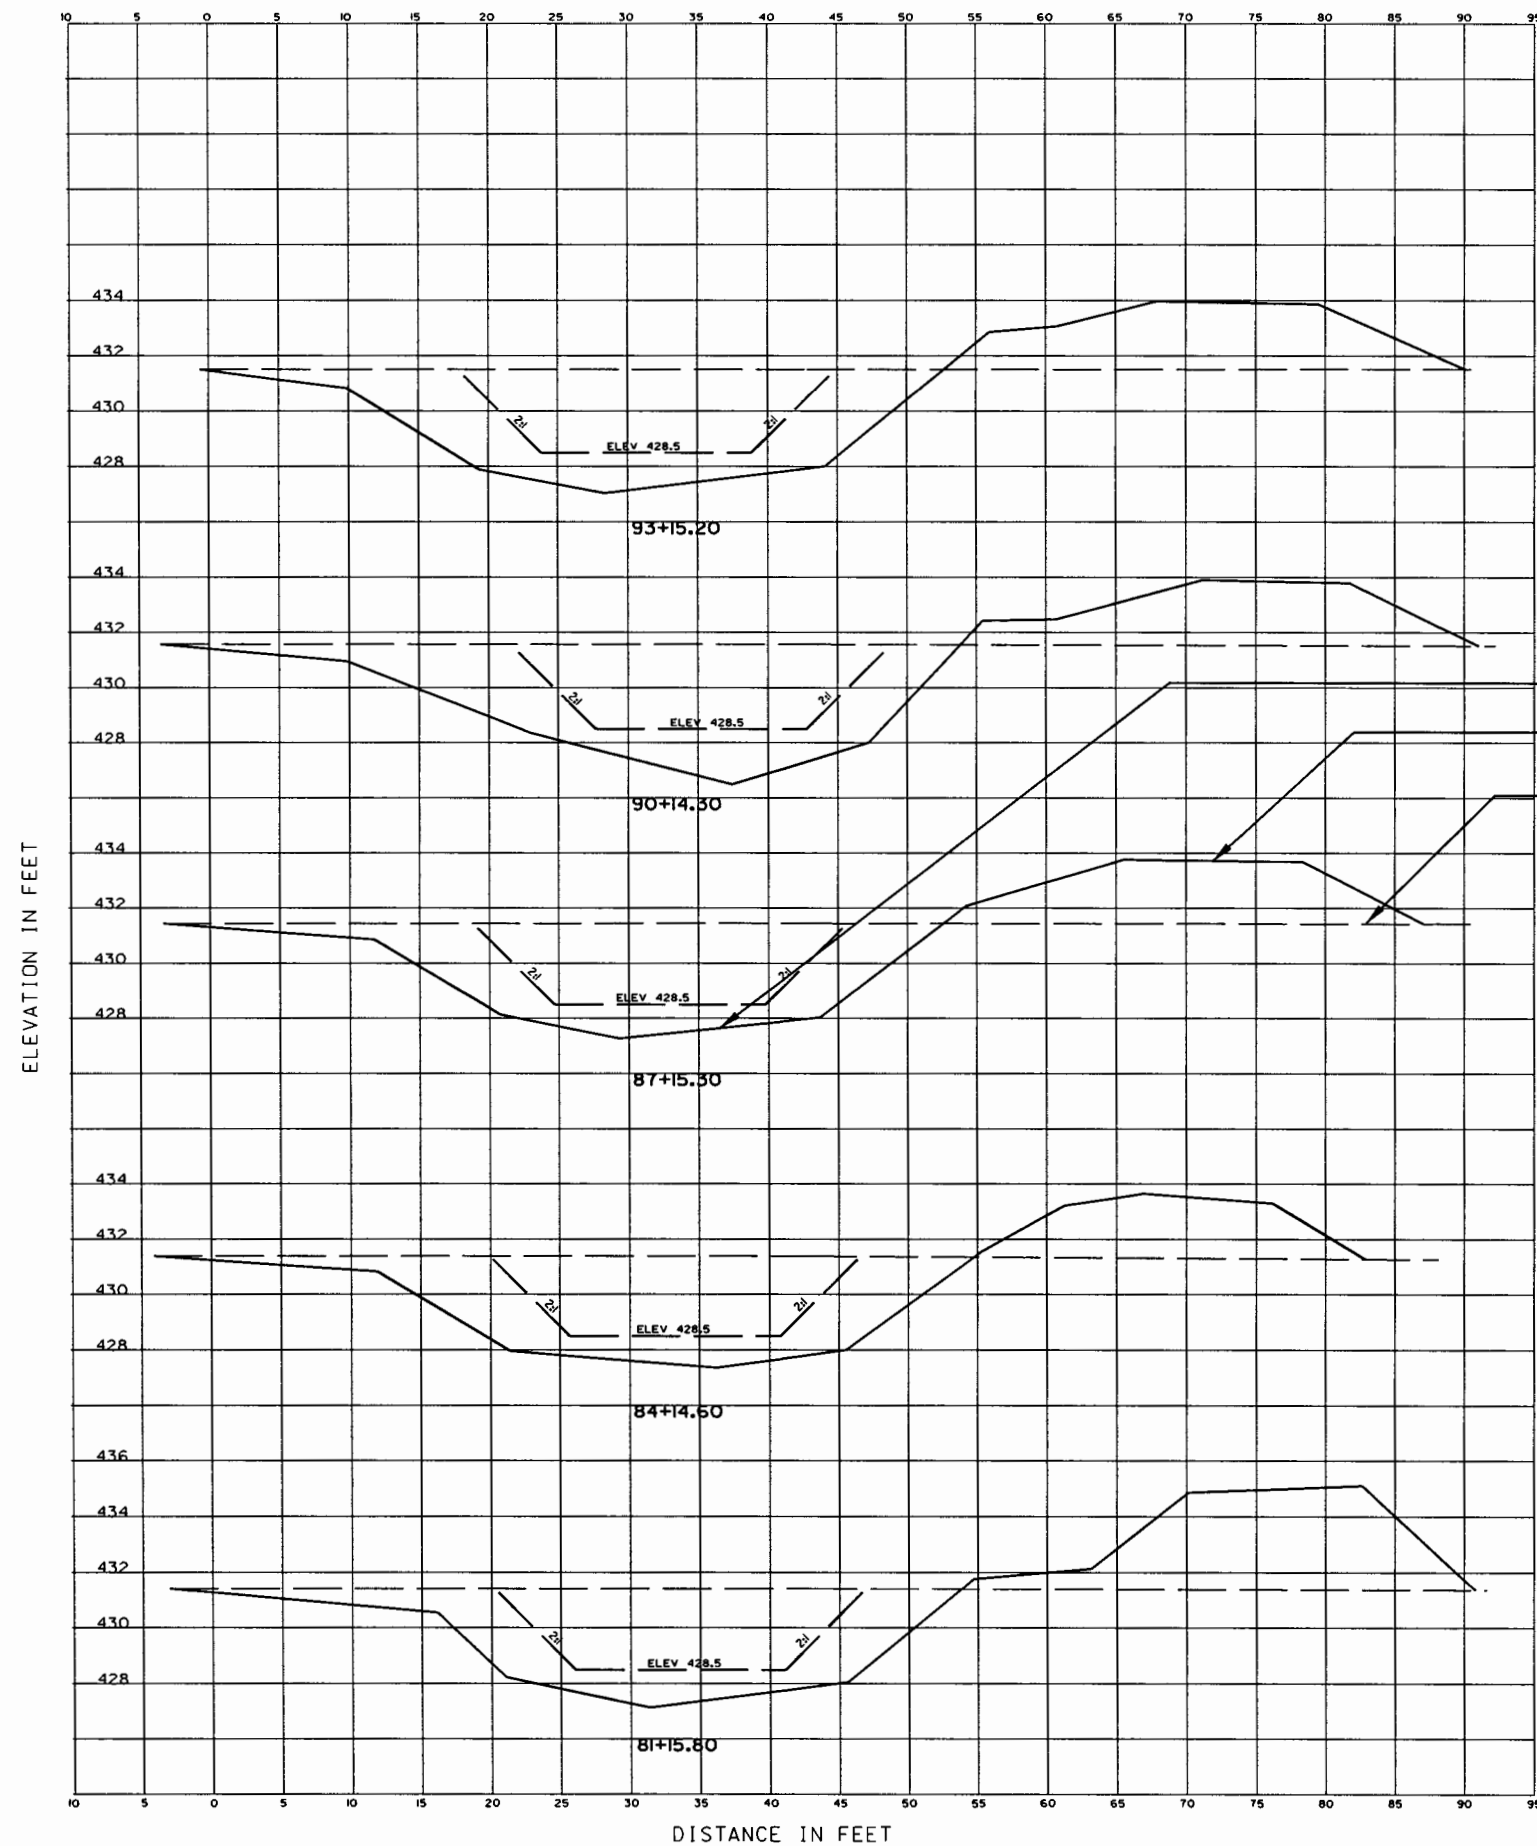

EXCAVATION  
SPOIL BERM - STONE FORDS ARE NOT SHOWN  
EXISTING LAKEBED SURFACE

AS BUILT CROSS SECTIONS PROVIDED BY:  
RJS CONSTRUCTORS  
J. RAMPENBERG  
11/24/03



| Symbol    | Description | Revisions |
|-----------|-------------|-----------|
| AS BUILT  |             |           |
| 18 MAR 04 | Date        | Approved  |


|                                                                            |                                                                          |                                                                                                          |
|----------------------------------------------------------------------------|--------------------------------------------------------------------------|----------------------------------------------------------------------------------------------------------|
| U.S. ARMY ENGINEER DISTRICT<br>CORPS OF ENGINEERS<br>ROCK ISLAND, ILLINOIS | Designed By: DRC<br>Drawn By: DWP<br>Checked By: KMM<br>Reviewed By: DRC | Date: MAR 2001<br>Scale: AS SHOWN<br>Project Code: 1-L-1-3-1/67<br>Solicitation Number: DACW25-01-B-0012 |
|----------------------------------------------------------------------------|--------------------------------------------------------------------------|----------------------------------------------------------------------------------------------------------|

ILLINOIS WATERWAY PROGRAM  
ENVIRONMENTAL PROGRAM  
LA GRANGE, ILL. MILE 124 TO 129.5  
LAKE CHATAIGNA  
OPERATIONS AND MAINTENANCE  
**LOWER LAKE  
DEWATERING CHANNEL  
CROSS SECTIONS VI**

Sheet  
Reference  
Number:  
**F320**  
Sheet 77 of 84



02-MAR-2005 15:22  
\\mrvfisc\codeproj\projects\EP52\QDM Manual - Use this one\ep52\303.dgn

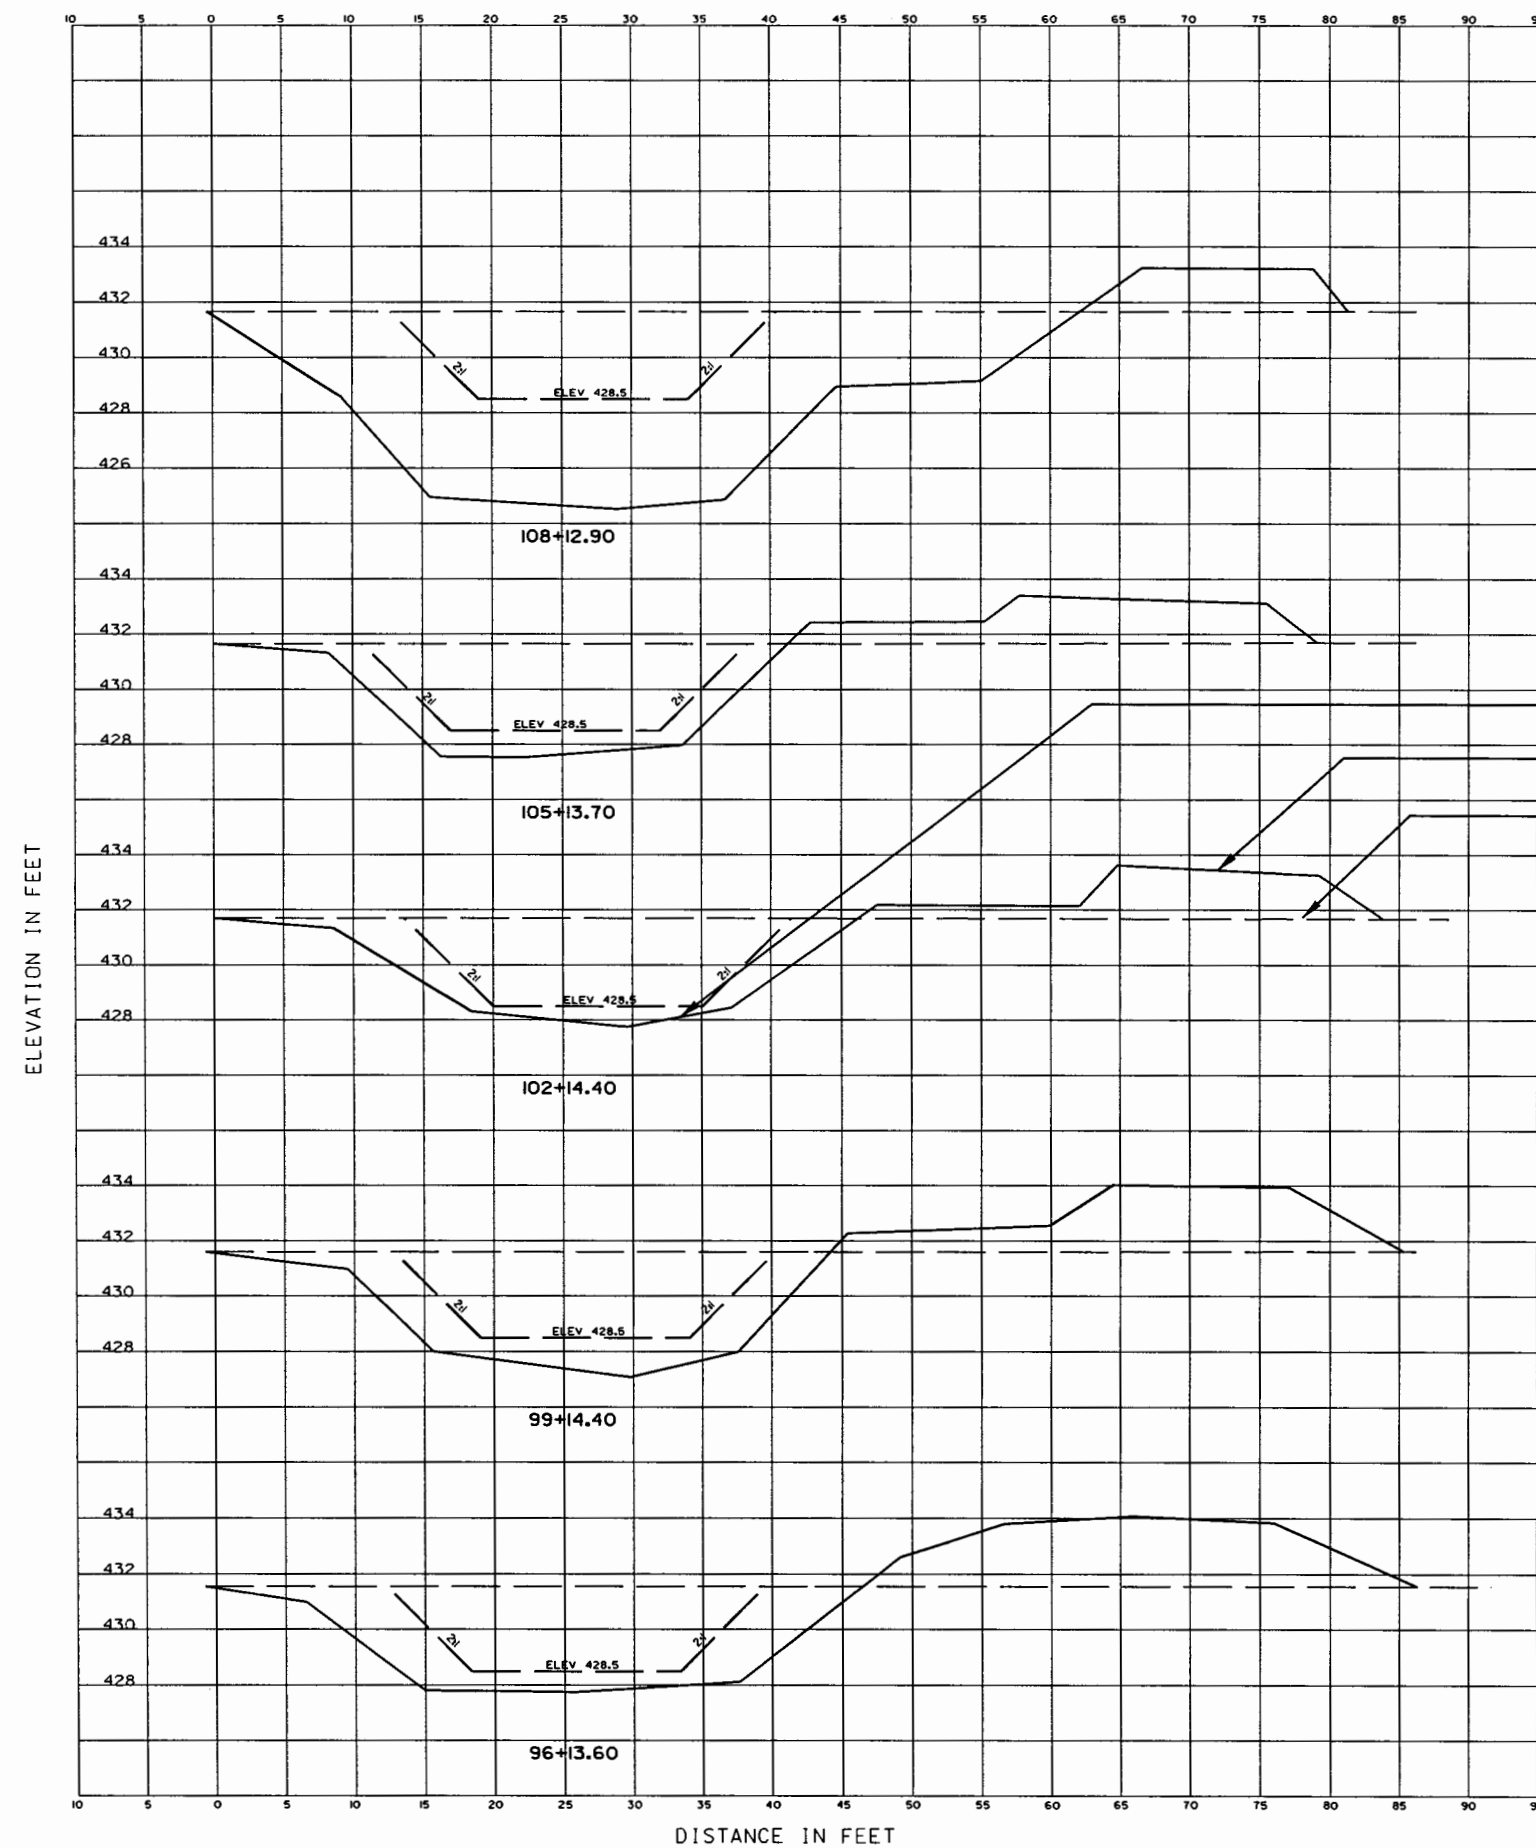

EXCAVATION  
SPOIL BERM - STONE FORDS ARE NOT SHOWN  
EXISTING LAKEBED SURFACE

AS BUILT CROSS SECTIONS PROVIDED BY:  
RJS CONSTRUCTORS  
J. RAMPENBERG  
11/24/03




| Symbol   | Description | Revisions |
|----------|-------------|-----------|
| AS BUILT |             |           |
| IF BUILT |             |           |
| DATE     |             |           |

|                                                                            |                                       |
|----------------------------------------------------------------------------|---------------------------------------|
| Designed By: DRC                                                           | Date: MAR 2001                        |
| Drawn By: DWP                                                              | Scale: AS SHOWN                       |
| Checked By: KNM                                                            | Project Code: 1-L-1-3-1/67            |
| Reviewed By: DRC                                                           | Solicitation Number: DACW25-01-B-0012 |
| U.S. ARMY ENGINEER DISTRICT<br>CORPS OF ENGINEERS<br>ROCK ISLAND, ILLINOIS |                                       |

ILLINOIS WATERWAY PROGRAM  
ENVIRONMENTAL MANAGEMENT  
LA GRANGE POOL AND MILE 124 TO 129.5  
OPERATIONS AND MAINTENANCE  
**LOWER LAKE  
DEWATERING CHANNEL  
CROSS SECTIONS VII**

Sheet  
Reference  
Number:  
**F330**  
Sheet 78 of 84

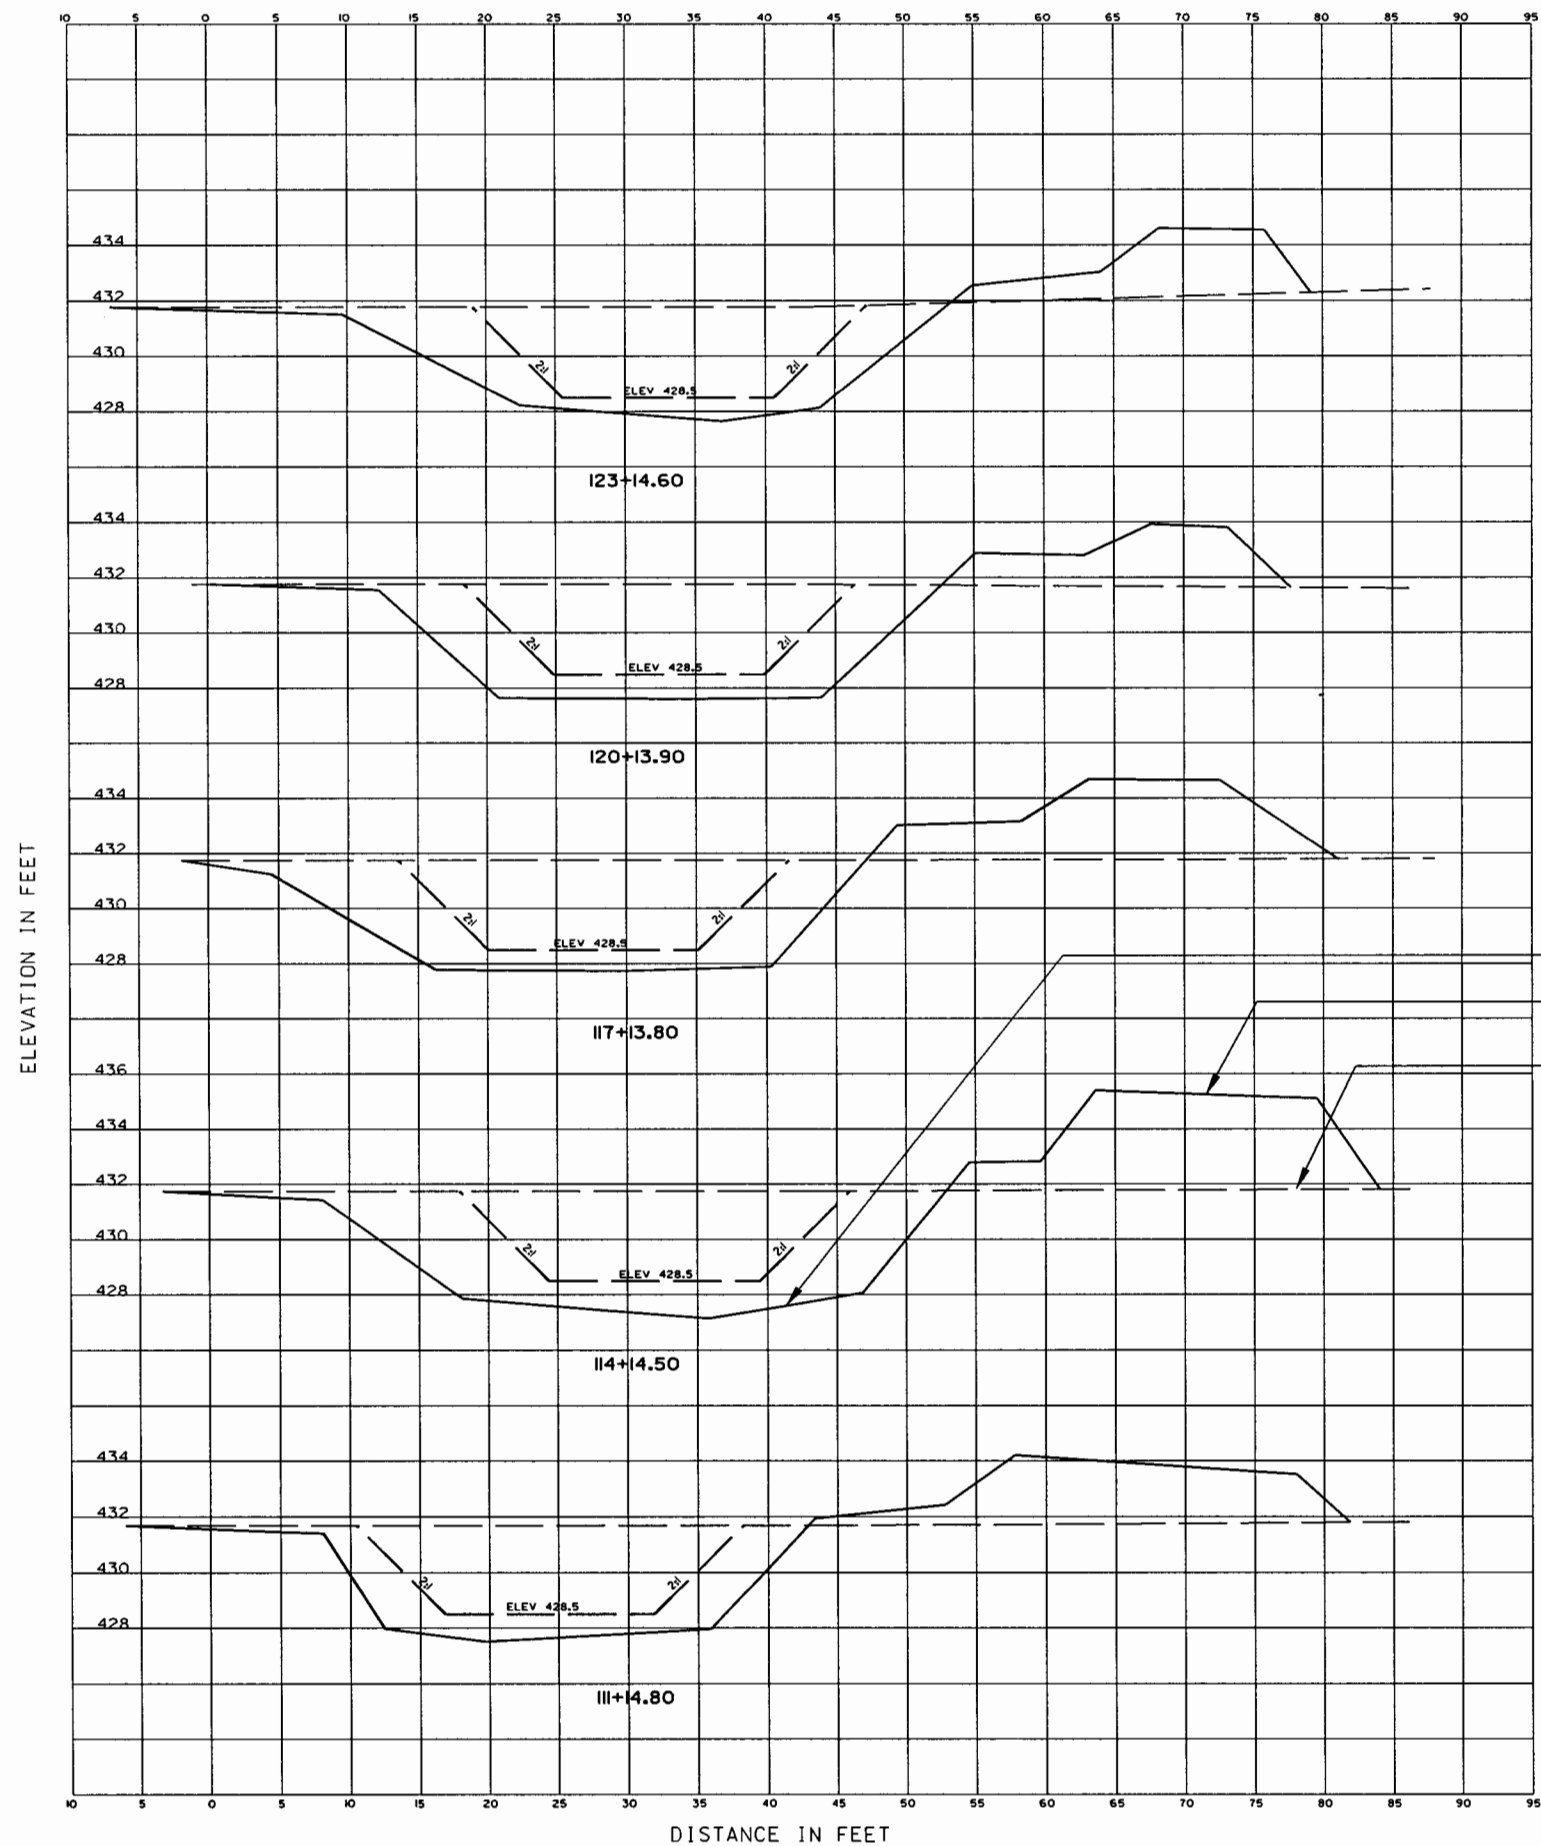

EXCAVATION  
SPOIL BERM - STONE FORDS ARE NOT SHOWN  
EXISTING LAKEBED SURFACE

AS BUILT CROSS SECTIONS PROVIDED BY:  
RJS CONSTRUCTORS  
J. RAMPENBERG  
11/24/03




| Symbol    | Description | Revisions |
|-----------|-------------|-----------|
| AS BUILT  |             |           |
| 18 MAR 04 |             |           |
| Date      |             |           |
| Approved  |             |           |

|                                                                                |                                                                          |                                                                                                          |
|--------------------------------------------------------------------------------|--------------------------------------------------------------------------|----------------------------------------------------------------------------------------------------------|
| U.S. ARMY ENGINEER DISTRICT<br>CHATTANOOGA, TENNESSEE<br>ROCK ISLAND, ILLINOIS | Designed By: DRC<br>Drawn By: DWP<br>Checked By: KMM<br>Reviewed By: DRC | Date: MAR 2001<br>Scale: AS SHOWN<br>Project Code: 1-L1-3-1/67<br>Soil Citation Number: DACW25-01-B-0012 |
|--------------------------------------------------------------------------------|--------------------------------------------------------------------------|----------------------------------------------------------------------------------------------------------|

ILLINOIS WATERWAY PROGRAM  
ENVIRONMENTAL IMPACT STATEMENT  
LA GRANGE POOL, MILE 124 TO 129.5  
CHATTANOOGA LAKE CHATTANOOGA  
OPERATIONS AND MAINTENANCE  
**LOWER LAKE  
DEWATERING CHANNEL  
CROSS SECTIONS VIII**

Sheet  
Reference  
Number:  
**F340**  
Sheet 79 of 84

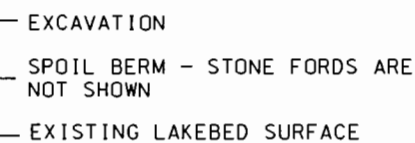


AS BUILT CROSS SECTIONS PROVIDED BY:  
RJS CONSTRUCTORS  
J. RAMPENBERG  
11/24/03

[illegible]

|                                                                        |                  |                                       |
|------------------------------------------------------------------------|------------------|---------------------------------------|
| U.S. ARMY ENGINEER DISTRICT<br>CORPS ENGINEER<br>ROCK ISLAND, ILLINOIS | Designed By: DRC | Date: MAR 2001                        |
|                                                                        | Brown By: DWP    | Scale: AS SHOWN                       |
|                                                                        | Checked By: KJM  | Project Code: 1-L1-3-1/67             |
|                                                                        | Reviewed By: DRC | Solicitation Number: DACW50-01-9-0013 |

**ILLINOIS WATERWAY  
ENVIRONMENTAL MANAGEMENT PROGRAM  
LA GRANGE POOL MILE 124 TO 129.5  
LAKE CHALAUQUA  
OPERATIONS AND MAINTENANCE**

Sheet  
Reference  
Number:  
**F350**  
Sheet 80 of 84

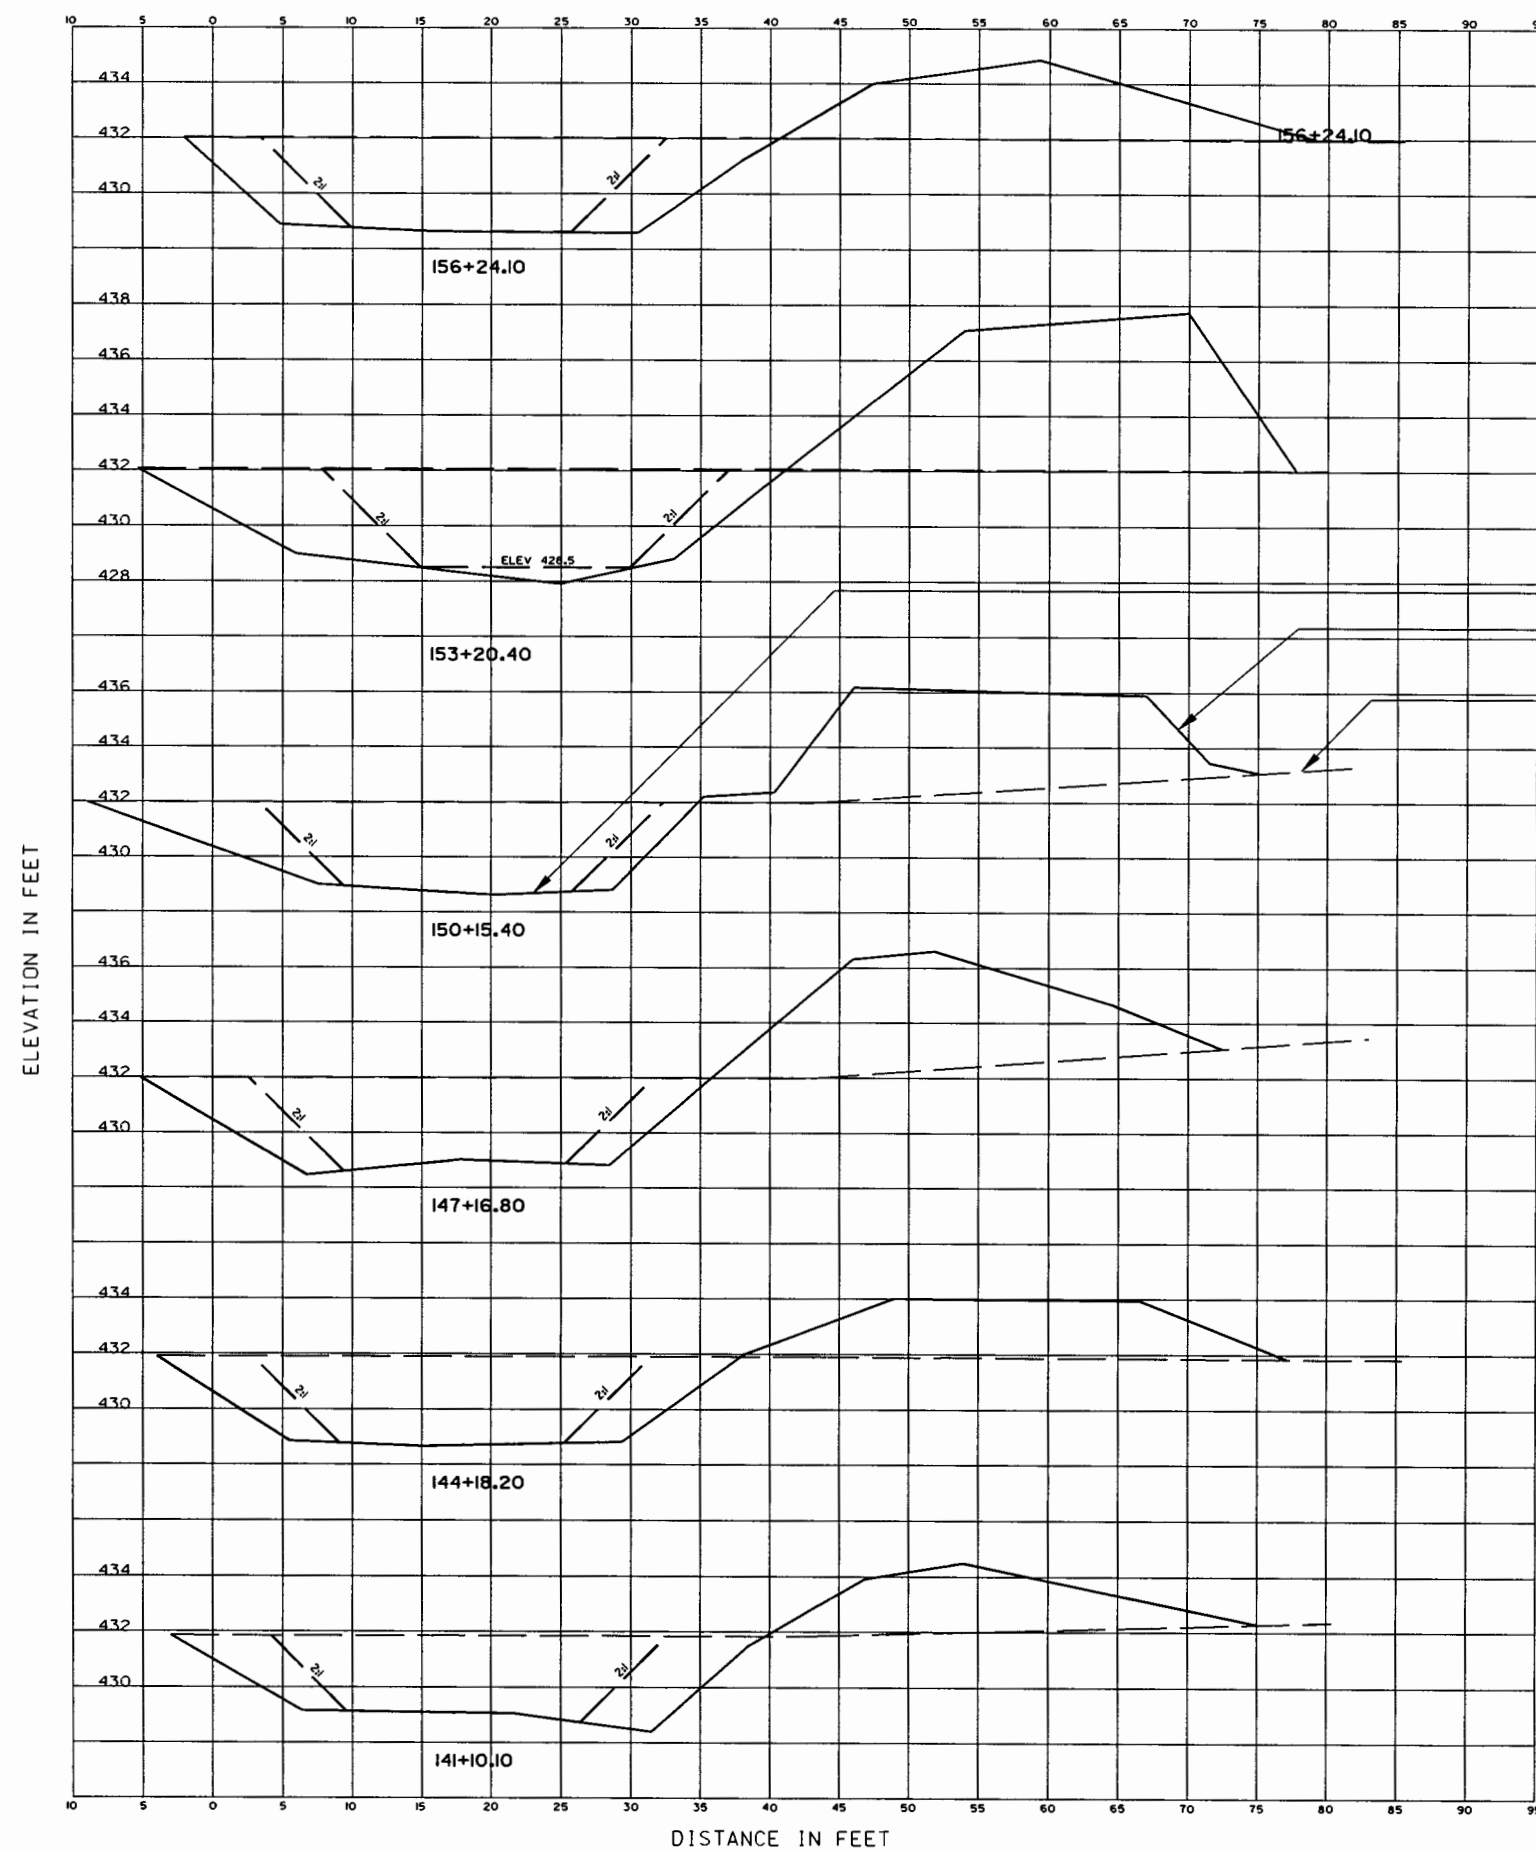

- EXCAVATION
- SPOIL BERM - STONE FORDS ARE NOT SHOWN
- EXISTING LAKEBED SURFACE

AS BUILT CROSS SECTIONS PROVIDED BY:  
RJS CONSTRUCTORS  
J. RAMPELBERG  
11/24/03


[illegible]

|                                                                            |                  |                                       |
|----------------------------------------------------------------------------|------------------|---------------------------------------|
| U.S. ARMY ENGINEER DISTRICT<br>CORPS OF ENGINEERS<br>ROCK ISLAND, ILLINOIS | Designed By: DRC | Dates: MAR 2001                       |
|                                                                            | Drawn By: DWP    | Scale: AS SHOWN                       |
|                                                                            | Checked By: KNM  | Project Code: 1-L-1-3-1/67            |
|                                                                            | Reviewed By: DRC | Solicitation Number: DACW25-01-B-0012 |

**ILLINOIS WATERWAY  
ENVIRONMENTAL MANAGEMENT PROGRAM  
LA GRANGE POOL, MILE 124 TO 129.5  
LAKE CHAUTAUQUA  
OPERATIONS AND MAINTENANCE**

Sheet  
Reference  
Number:  
**F360**  
Sheet 81 of 84

02-MAR-2005 15:24  
\*mvdscaddprojectseps2.mxd Manual - Use this onsep21307.dgn

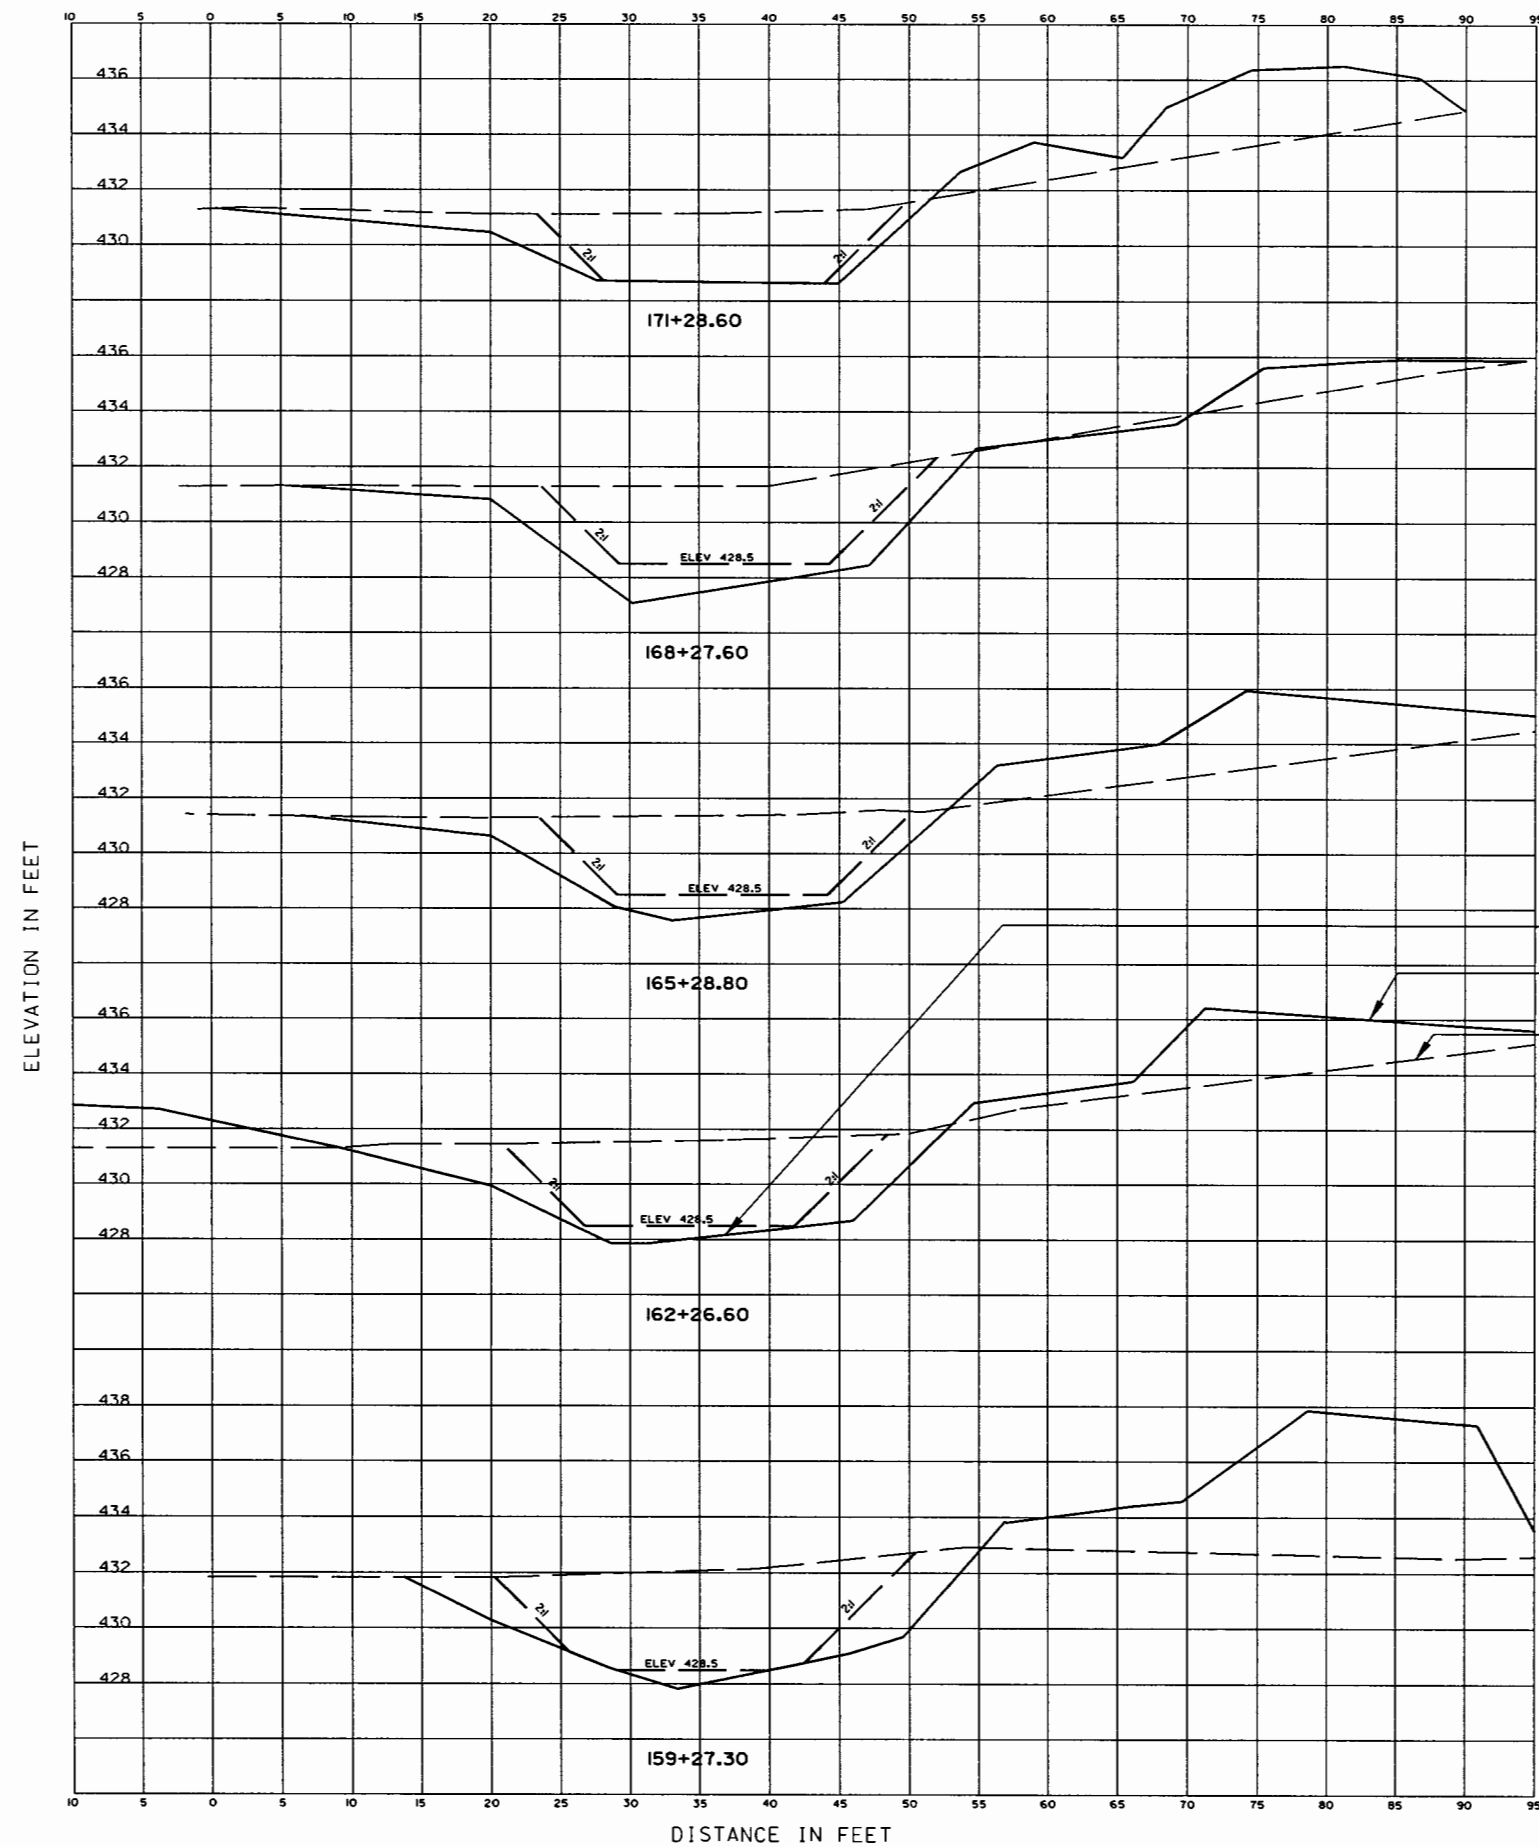


| Symbol    | Description | Revisions |
|-----------|-------------|-----------|
| AS BUILT  |             |           |
| 18 MAR 04 |             | Approved  |
| 18 MAR 04 |             | Approved  |

|                                                      |                  |                                       |
|------------------------------------------------------|------------------|---------------------------------------|
| U.S. ARMY ENGINEER DISTRICT<br>ROCK ISLAND, ILLINOIS | Designed By: DRC | Date: MAR 2001                        |
|                                                      | Drawn By: DWP    | Scale: AS SHOWN                       |
|                                                      | Checked By: KHM  | Project Code: 1-L-3-1/67              |
|                                                      | Reviewed By: DRC | Solicitation Number: DACW25-01-R-0012 |

ILLINOIS WATERWAY  
ENVIRONMENTAL MANAGEMENT TO 123.5  
LA GRANGE, ILLINOIS  
OPERATIONS AND MAINTENANCE  
**LOWER LAKE  
DEWATERING CHANNEL  
CROSS SECTIONS XI**

Sheet  
Reference  
Number:  
**F370**  
Sheet 82 of 84

02-MAR-2005 15:24  
\\mfrd8c000\projects\PE2\QDM Manual - Use this one\PE2\QDM.dgn

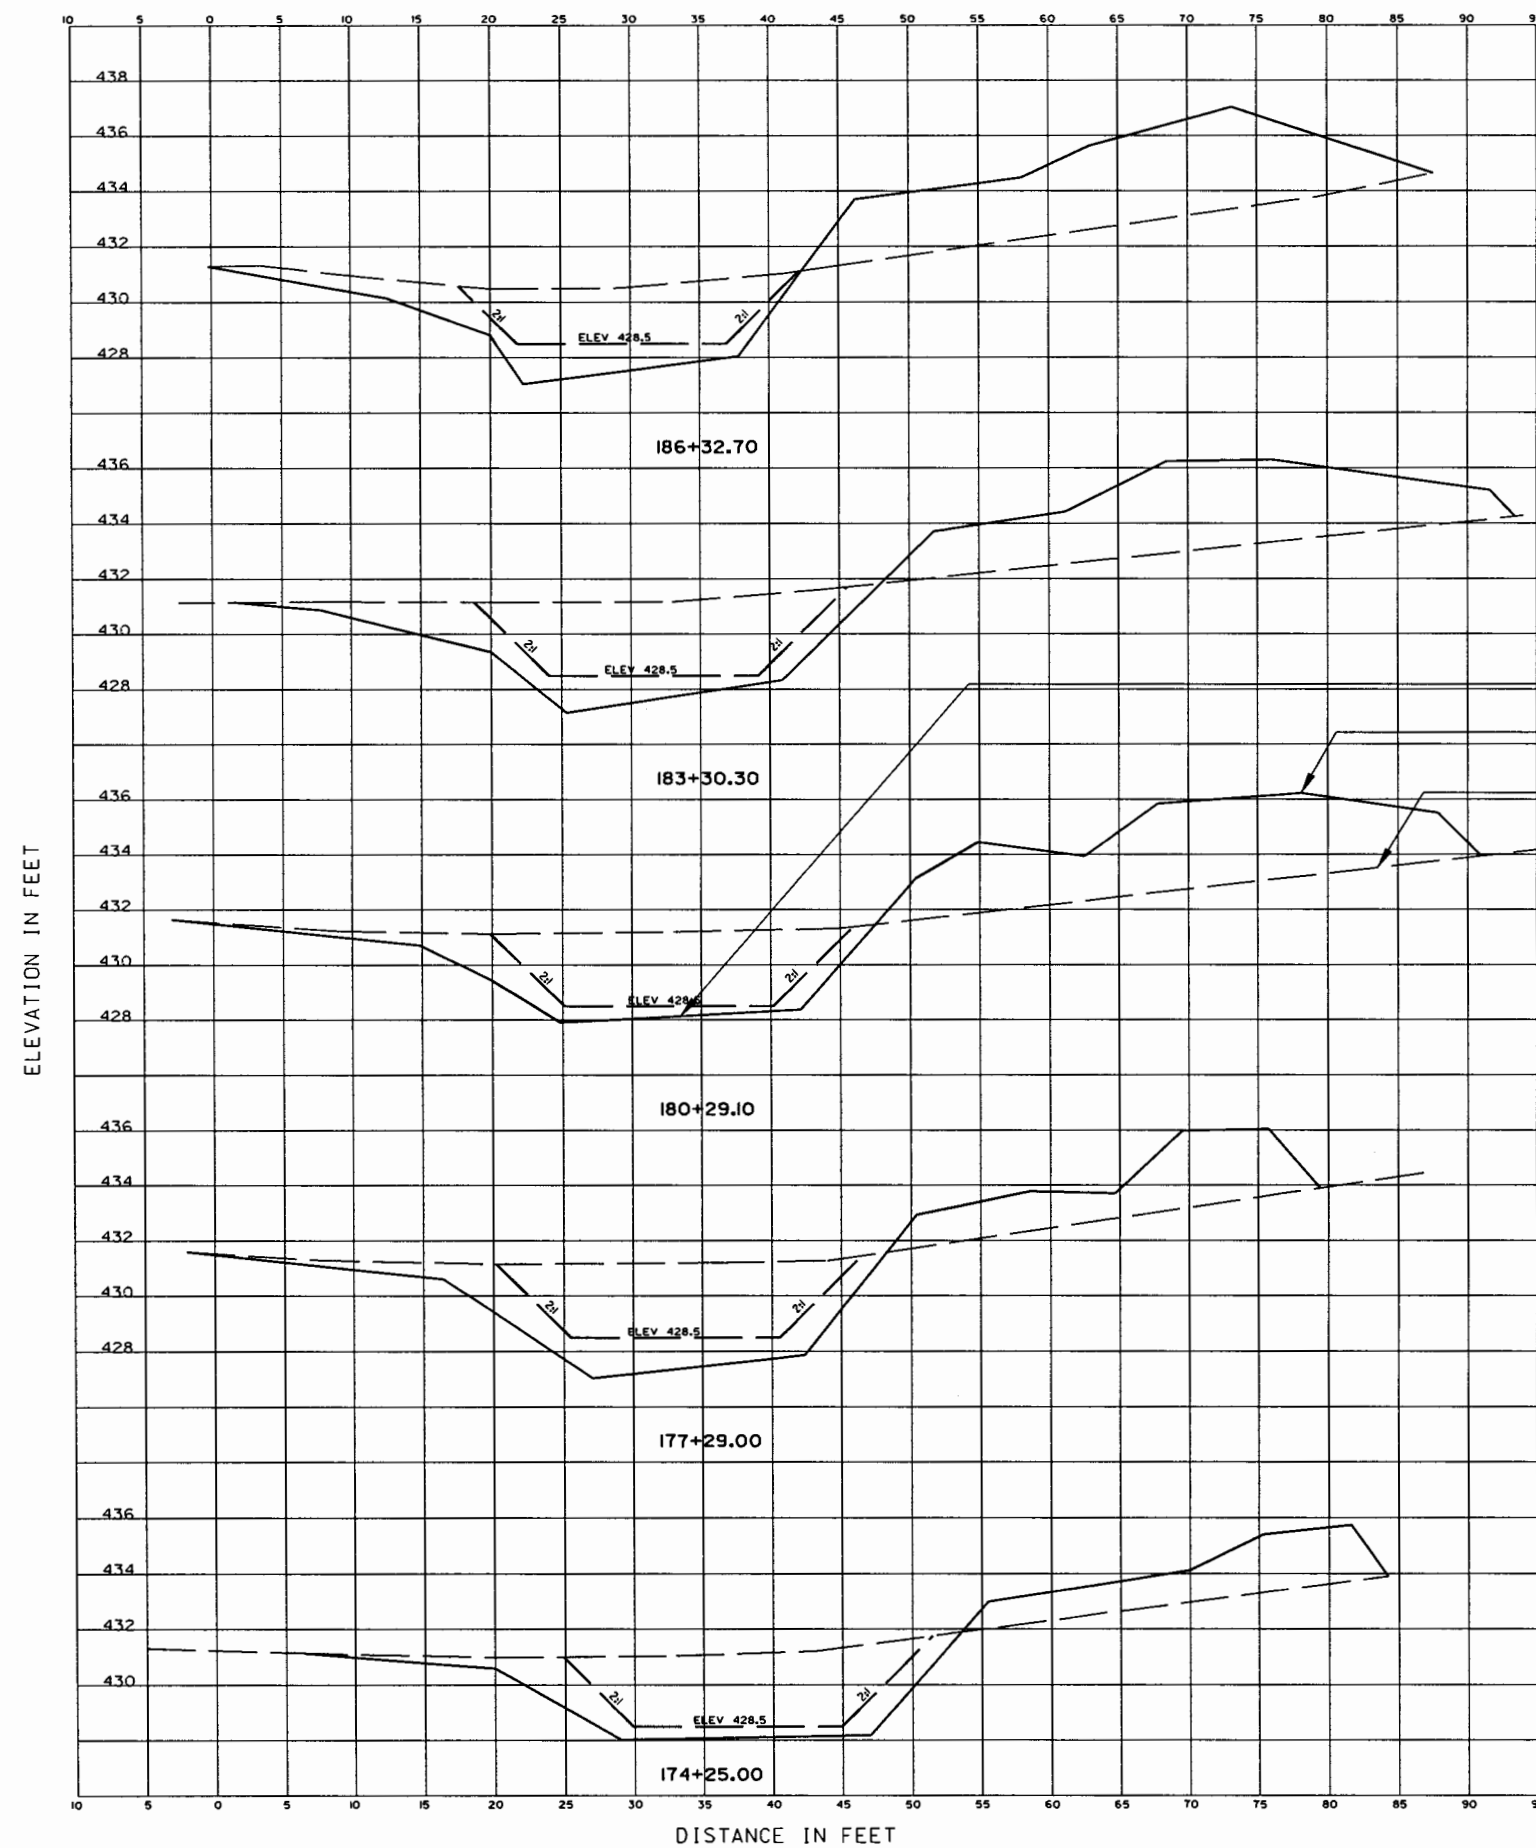

EXCAVATION  
SPOIL BERM - STONE FORDS ARE NOT SHOWN  
EXISTING LAKEBED SURFACE

AS BUILT CROSS SECTIONS PROVIDED BY:  
RJS CONSTRUCTORS  
J. RAMPENBERG  
11/24/03



| Symbol    | Description | Revisions |
|-----------|-------------|-----------|
| AS BUILT  |             |           |
| 11 MAR 04 |             |           |
| Date      |             |           |
| Approved  |             |           |

|                                                                            |                                       |
|----------------------------------------------------------------------------|---------------------------------------|
| Designed By: DRC                                                           | Date: MAR 2001                        |
| Drawn By: DWP                                                              | Scale: AS SHOWN                       |
| Checked By: KNM                                                            | Project Code: 1-L1-3-1/67             |
| Reviewed By: DRC                                                           | Solicitation Number: DACW25-01-B-0012 |
| U.S. ARMY ENGINEER DISTRICT<br>CORPS OF ENGINEERS<br>ROCK ISLAND, ILLINOIS |                                       |


ILLINOIS WATERWAY  
MANAGEMENT PROGRAM  
LA GRANDE POOL, MILE 124 TO 129.5  
OPERATIONS AND MAINTENANCE  
**LOWER LAKE  
DEWATERING CHANNEL  
CROSS SECTIONS XII**

Sheet  
Reference  
Number:  
**F380**  
Sheet 83 of 84



02-MAR-2005 15:25  
amwdfacddrprojectsEP5200M Manual - Use this oneamp2109.dgn

EXCAVATION  
SPOIL BERM - STONE FORDS ARE  
NOT SHOWN  
EXISTING LAKEBED SURFACE

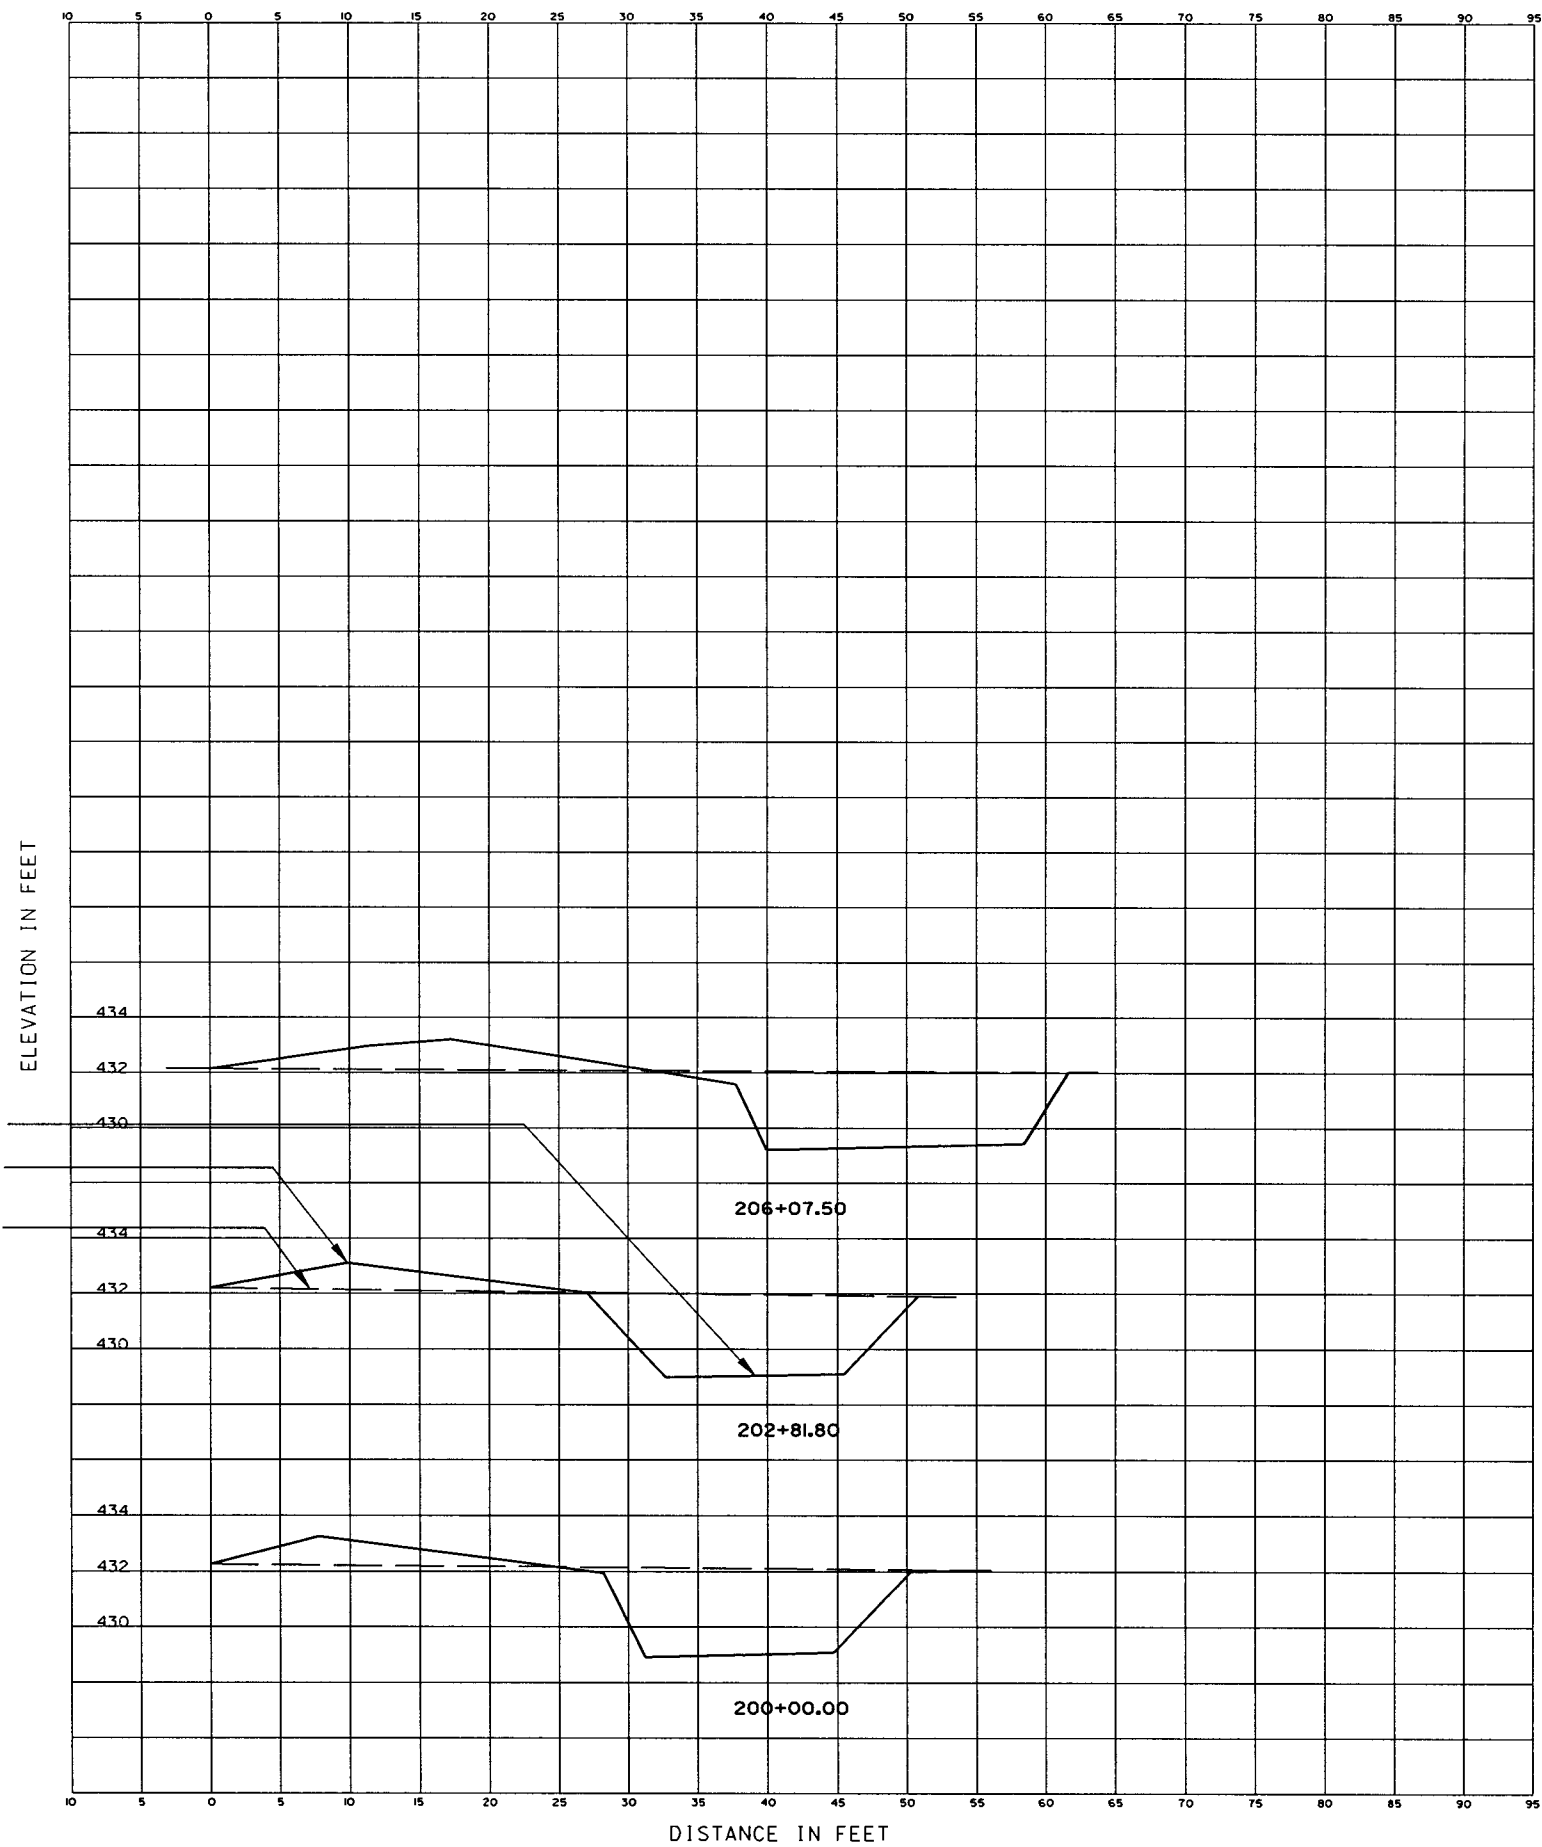

AS BUILT CROSS SECTIONS PROVIDED BY:  
RJS CONSTRUCTORS  
J. RAMPENBERG  
11/24/03



| Symbol   | Description | Revisions |
|----------|-------------|-----------|
| AS BUILT |             |           |

|              |     |                      |                  |
|--------------|-----|----------------------|------------------|
| Designed By: | DRC | Date:                | MAR 2001         |
| Drawn By:    | DWP | Scale:               | AS SHOWN         |
| Checked By:  | KNN | Project Code:        | 1-L1-3-1/67      |
| Reviewed By: | DRC | Solicitation Number: | DACW25-01-B-0012 |

ILLINOIS WATERWAY PROGRAM  
ENVIRONMENTAL MANAGEMENT TO 125.5  
LA GRANGE, ILLINOIS  
OPERATIONS AND MAINTENANCE  
**LOWER LAKE  
DEWATERING CHANNEL  
CROSS SECTIONS XIII**

Sheet  
Reference  
Number:  
**F390**  
Sheet 84 of 84