

1. ALL ELEVATIONS ARE REFERENCED TO MEAN SEAL LEVEL 1912 (MSL 1912).
2. THE MAJORITY OF SUNFISH LAKE IS A STUMP FIELD. DUE CONSIDERATION MUST BE GIVEN TO THE DIFFICULTIES OF NAVIGATING AND DREDGING IN SUCH CONDITIONS.
3. WATER DEPTHS IN THE SUNFISH LAKE PROJECT AREA VARY FROM 0 - 2.5 METERS. AT FLAT POOL ELEVATION. THE AVERAGE DEPTH IS APPROXIMATELY 1 METER. FLOATING PLANT ACCESS TO THE PROJECT AREA MAY REQUIRE DREDGING.
4. SURVEY DATUM: ILLINOIS WEST NAD 83, METERS.
5. MUD LAKE SURVEYING BENCHMARKS SHOWN ON SHEET X4.

1. THE ESTIMATED CAPACITY OF THE CDF, ALLOWING FOR 1.6 METERS OF FREEBOARD, IS APPROXIMATELY 100,000 CUBIC METERS. THE ESTIMATED QUANTITY OF MATERIAL TO BE EXCAVATED FROM ALIGNMENTS D-M IS APPROXIMATELY 80,000 CUBIC METERS. THE CONTRACTOR'S CHANNEL EXCAVATION PLAN MUST ADDRESS HOW EFFLUENT WATER QUALITY STANDARDS WILL BE MET, GIVING CONSIDERATION TO THE CAPACITY OF THE DISPOSAL FACILITY AND THE AMOUNT OF MATERIAL TO BE DREDGED. IF NECESSARY, THE PLAN MAY INCLUDE, BUT NOT BE LIMITED TO: ALTERNATING PERIODS OF DREDGING AND DEWATERING; ADDITION OF CHEMICAL FLOCCULANTS; BUCKET/AUGER DREDGING; AND/OR DE-WATERING OF SEDIMENTS.
2. THE CONTRACTOR MUST MAINTAIN AT LEAST 1 METER OF FREEBOARD ABOVE THE WATER SURFACE IN THE CDF AT ALL TIMES, UNLESS OTHERWISE DIRECTED BY THE CONTRACTING OFFICER.

THE GOALS OF THE POOL 11 ISLANDS HABITAT REHABILITATION AND ENHANCEMENT PROJECT (HREP) ARE TO:

1. RESTORE BACKWATER HABITAT BY REDUCING SEDIMENTATION, AND PROVIDING PROTECTION AGAINST WIND-INDUCED WAVE FORCES THAT CAUSE SEDIMENT RESUSPENSION.
2. CREATE DEEP WATER AQUATIC HABITAT.

THE OBJECTIVES OF THE PROJECT ARE TO:

1. CONSTRUCT A 1568-METER EMBANKMENT TO DEFLECT RIVER FLOWS AWAY FROM THE SUNFISH LAKE AREA BREAK UP WIND-INDUCED WAVES.
2. CONSTRUCT A 10-HECTARE SYSTEM OF DEEP-WATER CHANNELS FOR FISH HABITAT.

THE OBJECTIVES OF THE PROJECT ARE TO:

1. CONSTRUCT A 2965-METER EMBANKMENT TO DEFLECT RIVER FLOWS AWAY FROM THE MUD LAKE AREA BREAK UP WIND-INDUCED WAVES.
2. CONSTRUCT A 8.8-HECTARE SYSTEM OF DEEP-WATER CHANNELS FOR FISH HABITAT.

INDICATES SECTION OR ELEVATION
SECTION OR ELEVATION IDENTIFICATION
 IF DRAWN ON SAME SHEET

INDICATES SECTION
SECTION IDENTIFICATION

INDICATES DETAIL
DETAIL IDENTIFICATION
 IF DRAWN ON SAME SHEET

SHEET REFERENCE NUMBER FROM WHICH SECTION IS TAKEN

SHEET REFERENCE NUMBER FROM WHICH SECTION IS DRAWN

SHEET REFERENCE NUMBER FROM WHICH DETAIL IS TAKEN

SHEET REFERENCE NUMBER FROM WHICH DETAIL IS DRAWN



US Army Corps
of Engineers
Rock Island
District


[illegible]

U. S. ARMY ENGINEER DISTRICT CORPS OF ENGINEERS ROCK ISLAND, ILLINOIS	Designated By: RTN Drawn By: SDB Checked By: MJA Reviewed By: DJH	Dates: 21 SEP. 2002 Status: AS SHOWN Drawing Code: EP66 Solicitation Number: DACW25-02-R-0008
---	--	--

POOL 11 ISLANDS
HABITAT REHABILITATION
& ENHANCEMENT PROJECT
STAGE 1 - SUNFISH LAKE

**INDEX OF DRAWINGS
& PROJECT DESCRIPTION**



Sheet
Reference
Number:
X2
Sheet ² of 25

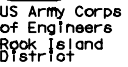[illegible]

U. S. ARMY ENGINEER DISTRICT CORPS OF ENGINEERS ROCK ISLAND, ILLINOIS	Drawn By: SDB/TPD	Scale: AS SHOWN	16 SEP. 2001
	Checked By:	Drawing Code:	
	Reviewed By:	KGB	
		Satiation Number:	
		DJH	

**LOCATION PLAN
AND VICINITY MAP**

PLATE 1
PLATE 2

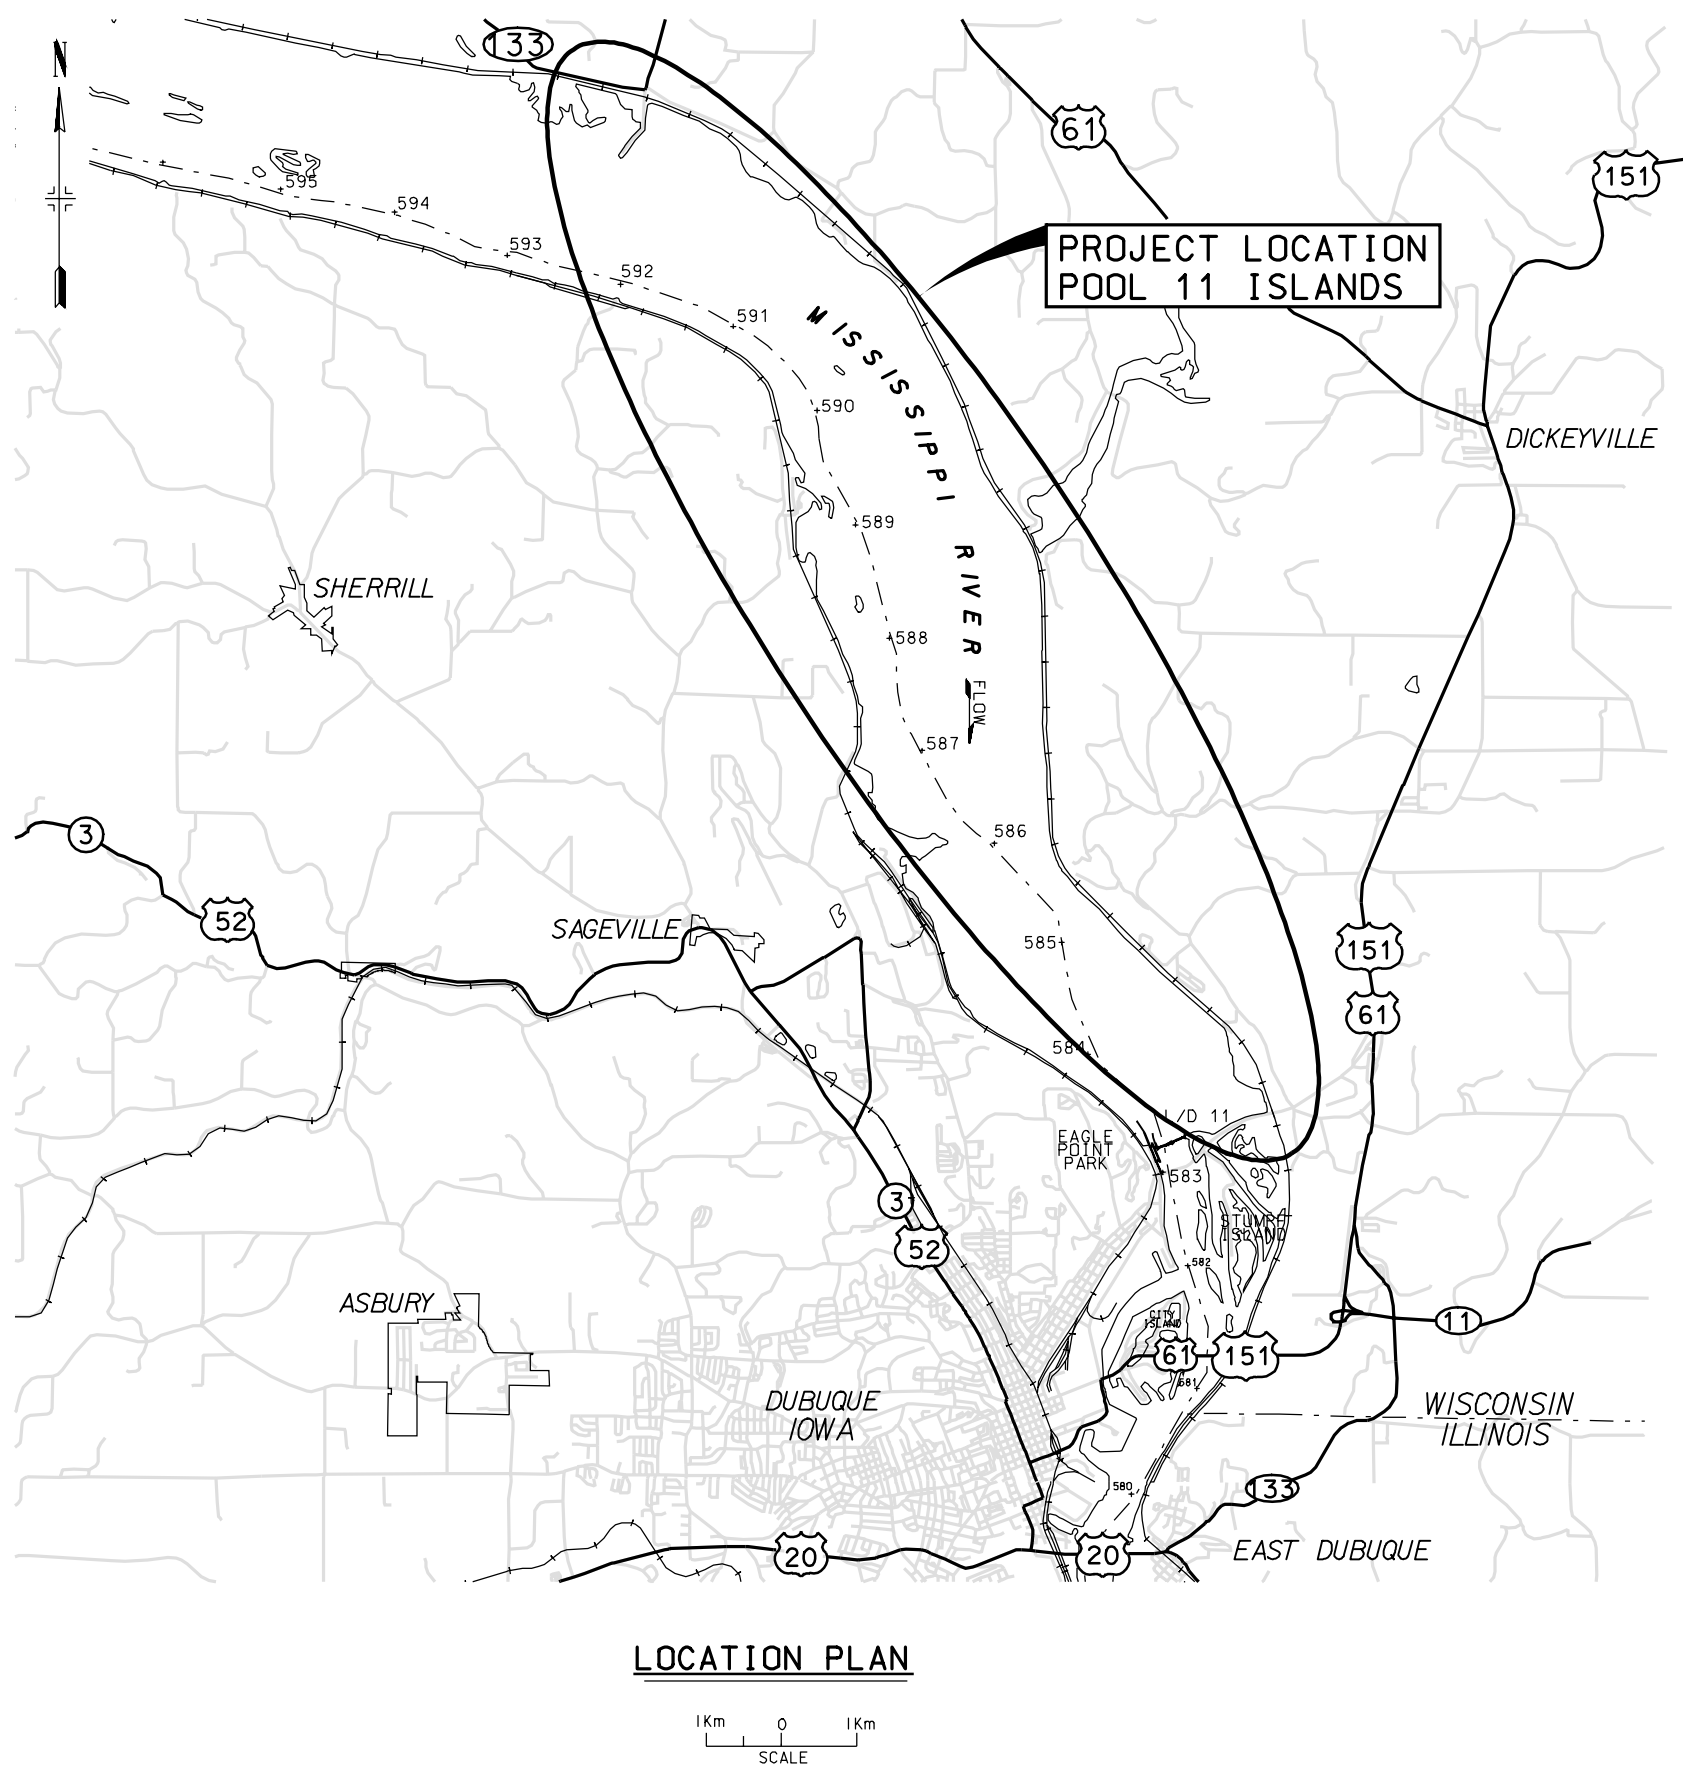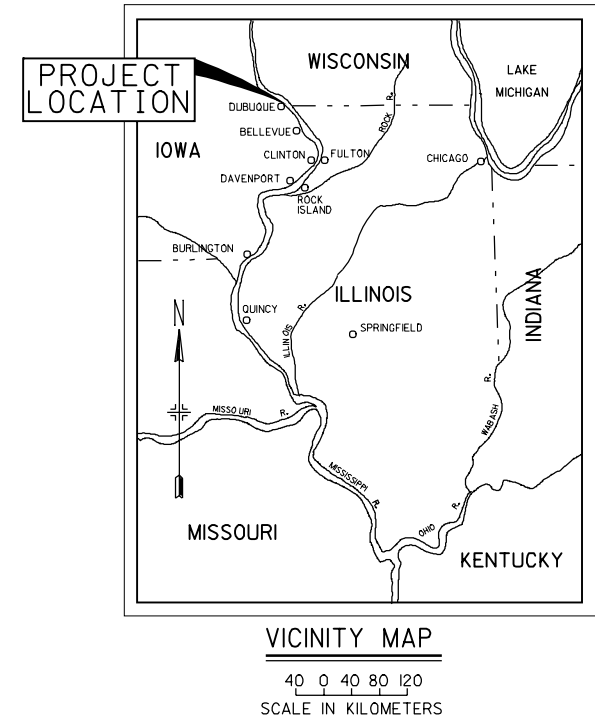


ALL DISTANCES, MEASUREMENTS AND ELEVATIONS SHOWN ARE IN METERS UNLESS NOTED OTHERWISE.

CONSTRUCTION FEATURES

THE FOLLOWING PROVIDES A BRIEF DESCRIPTION OF THE MAJOR PROJECT FEATURES. IT IS NOT NECESSARILY A CONSTRUCTION SEQUENCE.

FEATURE: DEFLECTION EMBANKMENT


(ALIGNMENT A) CONSTRUCT DEFLECTION EMBANKMENT USING ADJACENT BORROW FROM RIVER BED.

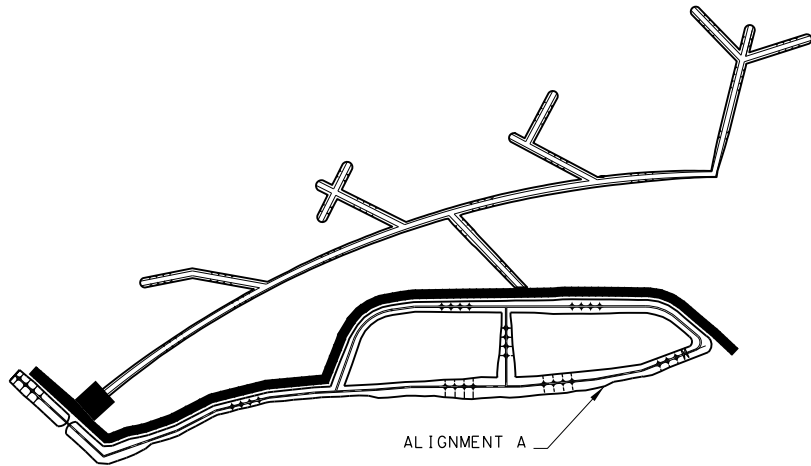

BORINGS INDICATE THE RIVERBED CONSISTS PRIMARILY CLAYS. THE COMPOSITION OF THE MATERIAL REQUIRES THAT EXCAVATION AND PLACEMENT BE ACCOMPLISHED MECHANICALLY, USING A 3 CUBIC METER BUCKET (MINIMUM), TO MAINTAIN IN-SITU SOIL STRENGTH.

FEATURE: CONFINED DISPOSAL FACILITY


(ALIGNMENTS B & C) CONSTRUCT A TWO- CELL CONFINED DISPOSAL FACILITY (CDF) USING ADJACENT BORROW FROM THE RIVERBED.

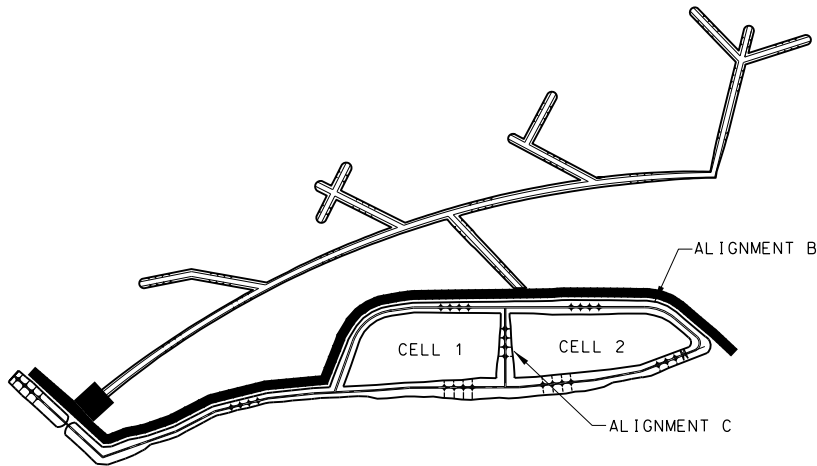

EMBANKMENT FOR THE CDF MUST ALSO BE PLACED MECHANICALLY USING A 3 CUBIC METER BUCKET (MINIMUM).

FEATURE: DEEP WATER FISH HABITAT


CONSTRUCT A SYSTEM OF DEEP-WATER CHANNELS FOR FISH HABITAT.

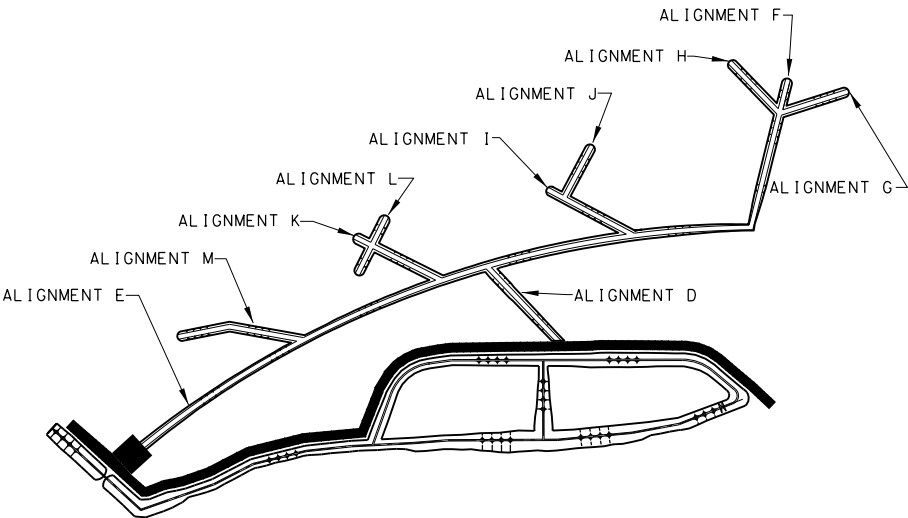

THE EXCAVATED CHANNEL RESULTING FROM EMBANKMENT BORROW OPERATIONS (ALIGNMENTS A & B) WILL PROVIDE APPROXIMATELY 3.8 HECTARES OF FISH HABITAT. THE REMAINING 6.2 HECTARES OF FISH HABITAT CHANNELS (ALIGNMENTS D-M) MAY BE EXCAVATED BY HYDRAULIC PIPELINE DREDGE, BUCKET/AUGER DREDGE, CLAMSHELL DREDGE, OR OTHER SUITABLE MEANS ACCEPTABLE TO THE GOVERNMENT. ALL EXCAVATED MATERIAL FROM CHANNELS D-M MUST BE PLACED IN THE CDF. SEE GENERAL NOTES FOR INFORMATION REGARDING CAPACITY OF CDF ON SHEET X2.


FEATURE: FLOW INLET AND SEDIMENT TRAP

CONSTRUCT A FLOW INLET IN THE DEFLECTION EMBANKMENT TO ALLOW NOMINAL FLOW THROUGH THE NEWLY EXCAVATED CHANNELS. PLACE RIPRAP TO PROTECT THE INLET FROM EROSION. FLOW INLET DETAILS MAY BE FOUND ON SHEET C19. DIRECTLY DOWNSTREAM OF THE FLOW INLET, EXCAVATE A SEDIMENT TRAP. SEDIMENT TRAP DETAILS MAY BE FOUND ON SHEET C19.

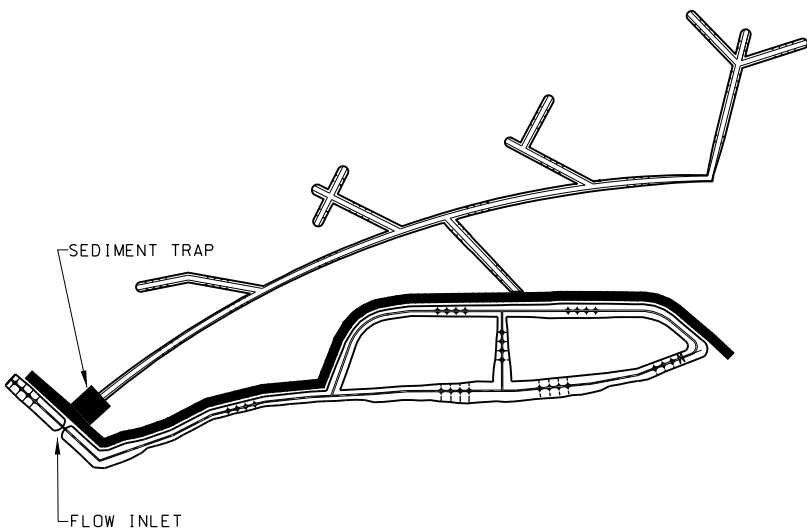

FEATURE: RIPRAP BERM

CONSTRUCT A ROCK BERM ALONG THE UPSTREAM TOE OF THE NEW EMBANKMENT, FROM STA 0+00 TO STA 3+50.

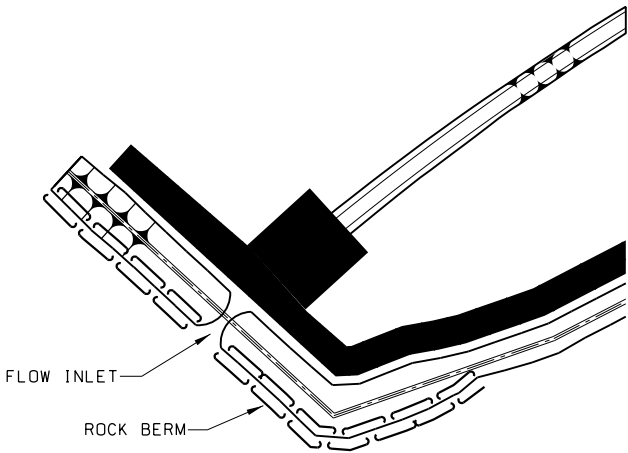


Symbol	Description	Revisions
AS CONSTRUCTED		
27 JUL 04 JRP/REH	Date	Approved

U.S. ARMY ENGINEER DISTRICT CORPS OF ENGINEERS ROCK ISLAND, ILLINOIS	Designed By: RTN Drawn By: SDB Checked By: MJA Reviewed By: DJH	Date: 21 SEP 2002 Scale: AS SHOWN Drawing Code: EP66 Solicitation Number: DACW25-02-R-0008
--	--	---

POOL 11 ISLANDS HABITAT REHABILITATION & ENHANCEMENT PROJECT STAGE 1 - SUNFISH LAKE	CONSTRUCTION FEATURES
--	--------------------------

Sheet Reference Number: X4 Sheet 4 of 25

ALL DISTANCES, MEASUREMENTS AND ELEVATIONS SHOWN ARE IN METERS UNLESS NOTED OTHERWISE.

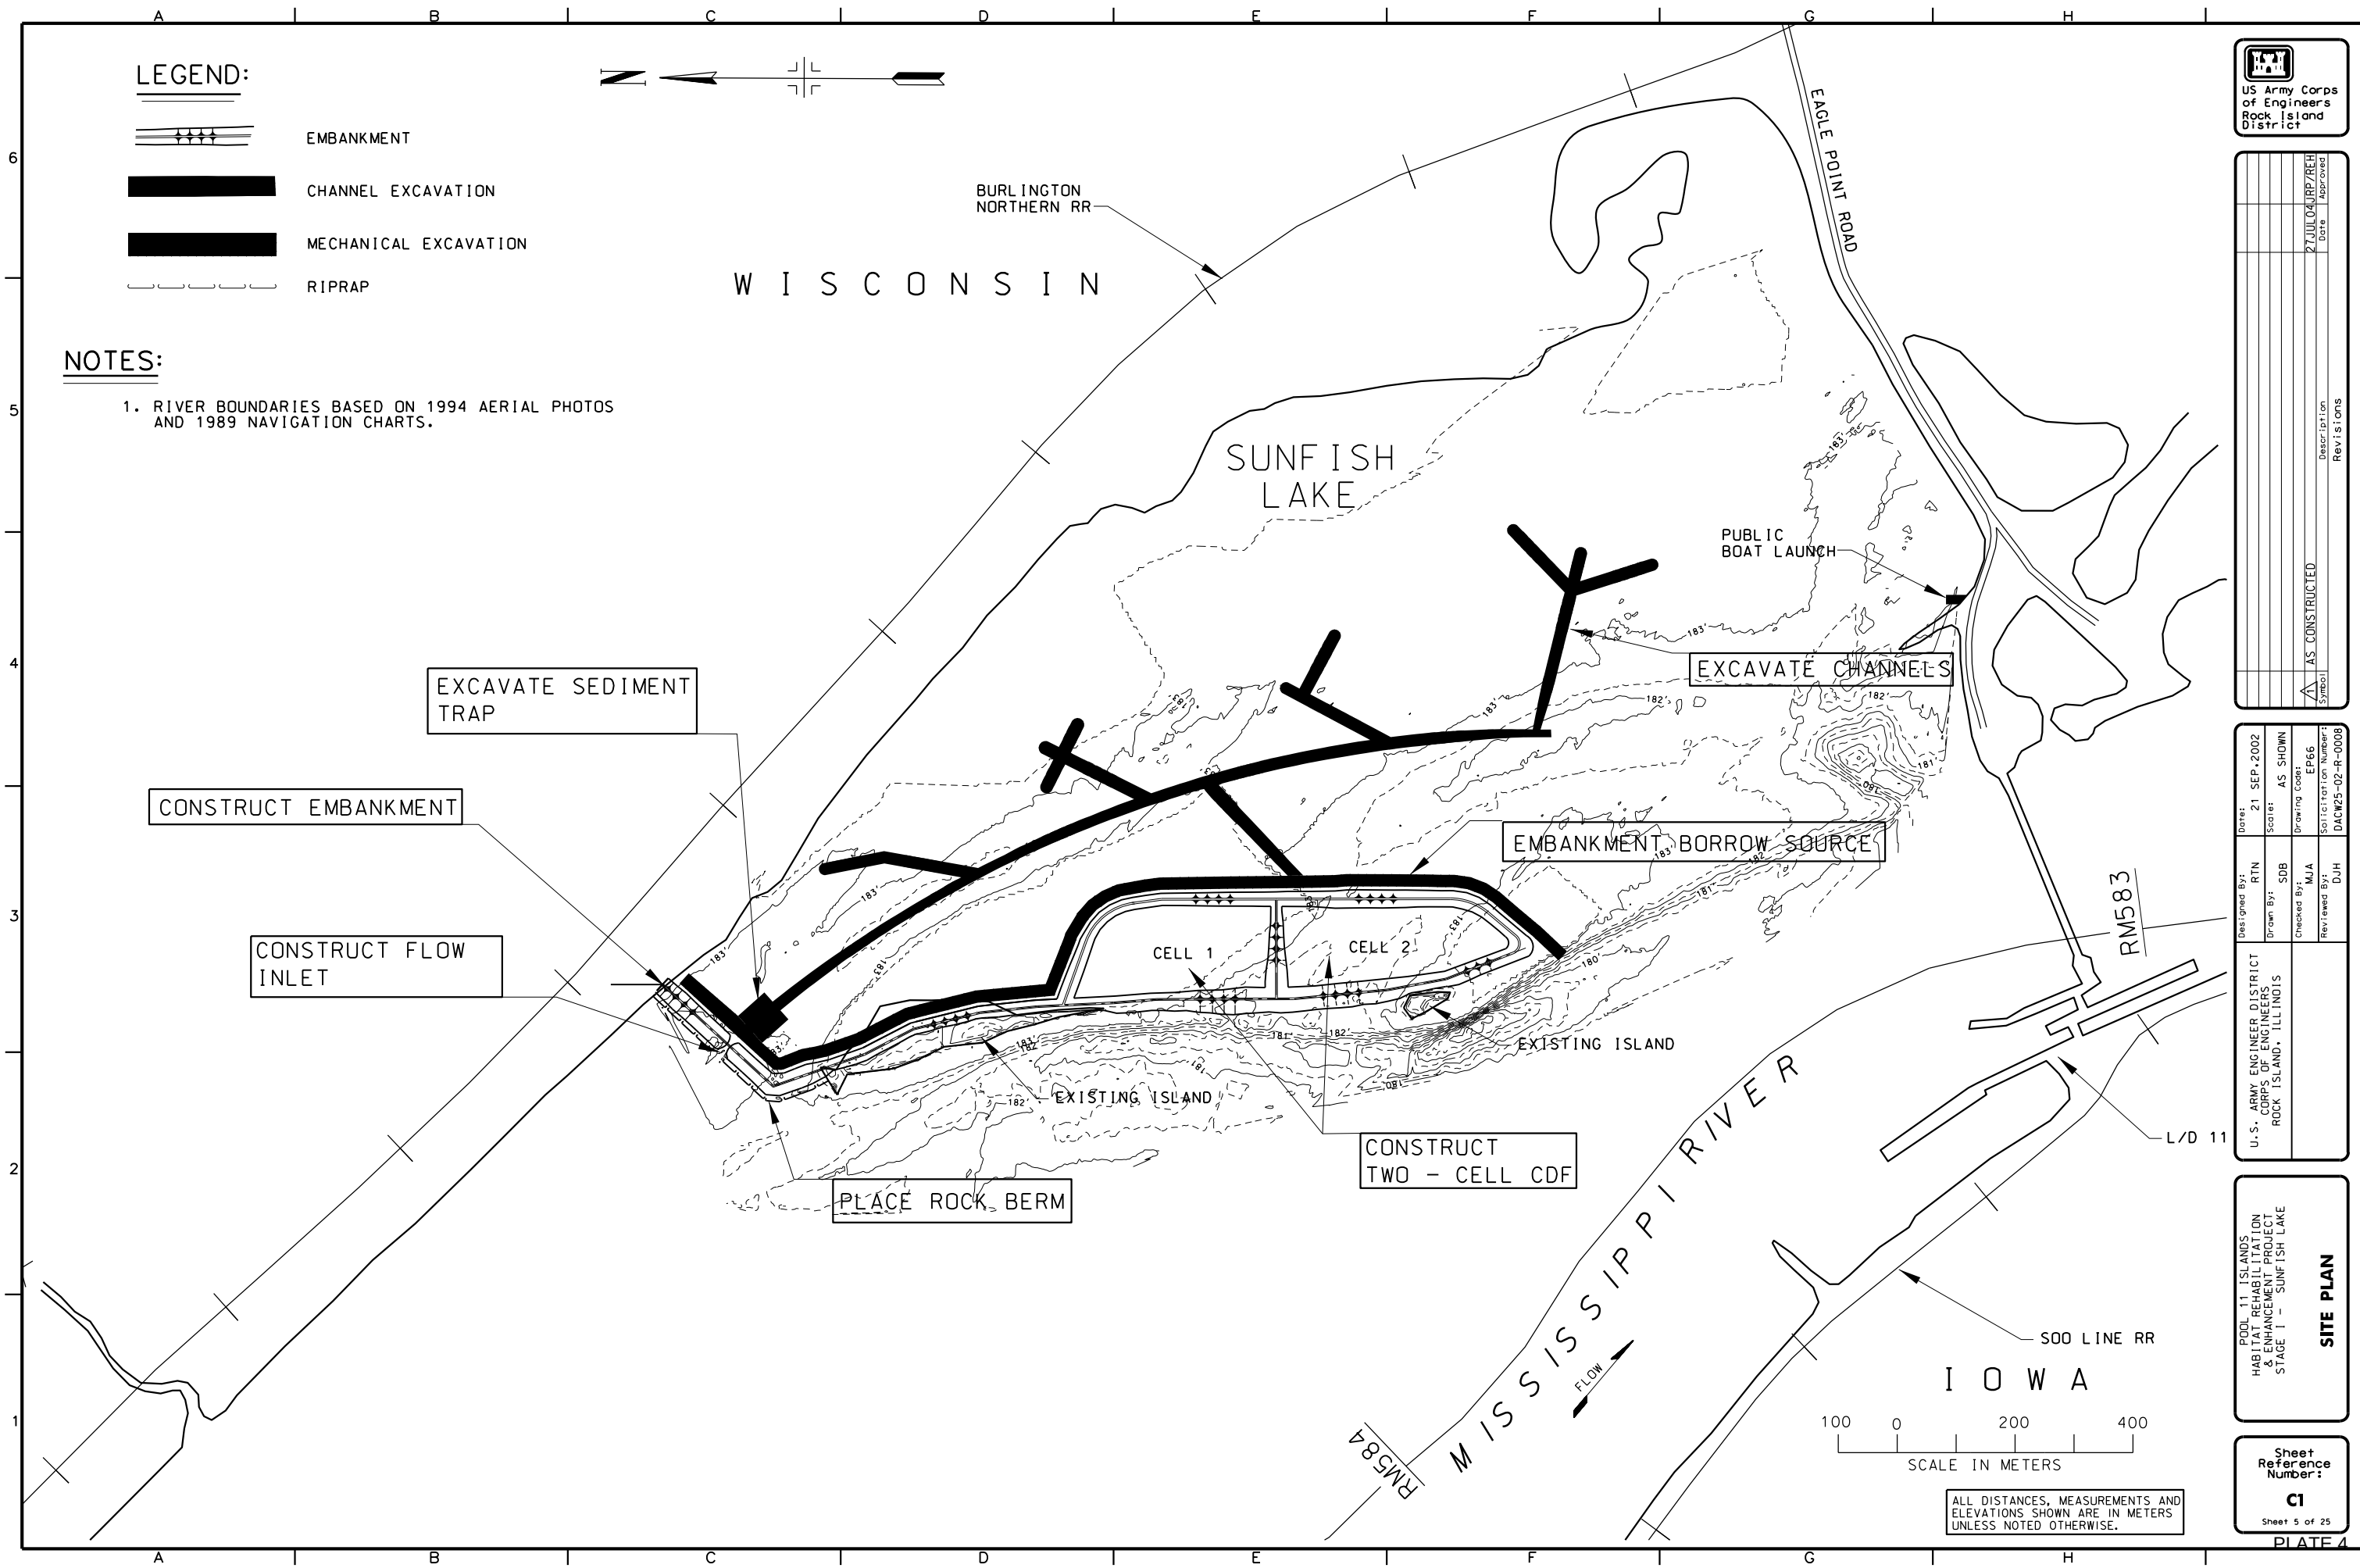

LEGEND:

- EMBANKMENT
- CHANNEL EXCAVATION
- MECHANICAL EXCAVATION
- RIPRAP

NOTES:

1. RIVER BOUNDARIES BASED ON 1994 AERIAL PHOTOS AND 1989 NAVIGATION CHARTS.



Symbol	Description	Revisions
AS CONSTRUCTED		
27 JUL 04 JRP/REH	Date	Approved

U.S. ARMY ENGINEER DISTRICT CORPUS ENGINEERS ROCK ISLAND, ILLINOIS	Designed By: RTN Drawn By: SDB Checked By: MJA Reviewed By: DJH	Date: 21 SEP 2002 Scale: AS SHOWN Drawing Code: EP66 Solicitation Number: DACW25-02-R-0008
--	--	---


POOL 11 ISLANDS
HABITAT REHABILITATION
& ENHANCEMENT PROJECT
STAGE 1 - SUNFISH LAKE

SITE PLAN

Sheet
Reference
Number:
C1
Sheet 5 of 25


PLATE 4

ALL DISTANCES, MEASUREMENTS AND ELEVATIONS SHOWN ARE IN METERS UNLESS NOTED OTHERWISE.

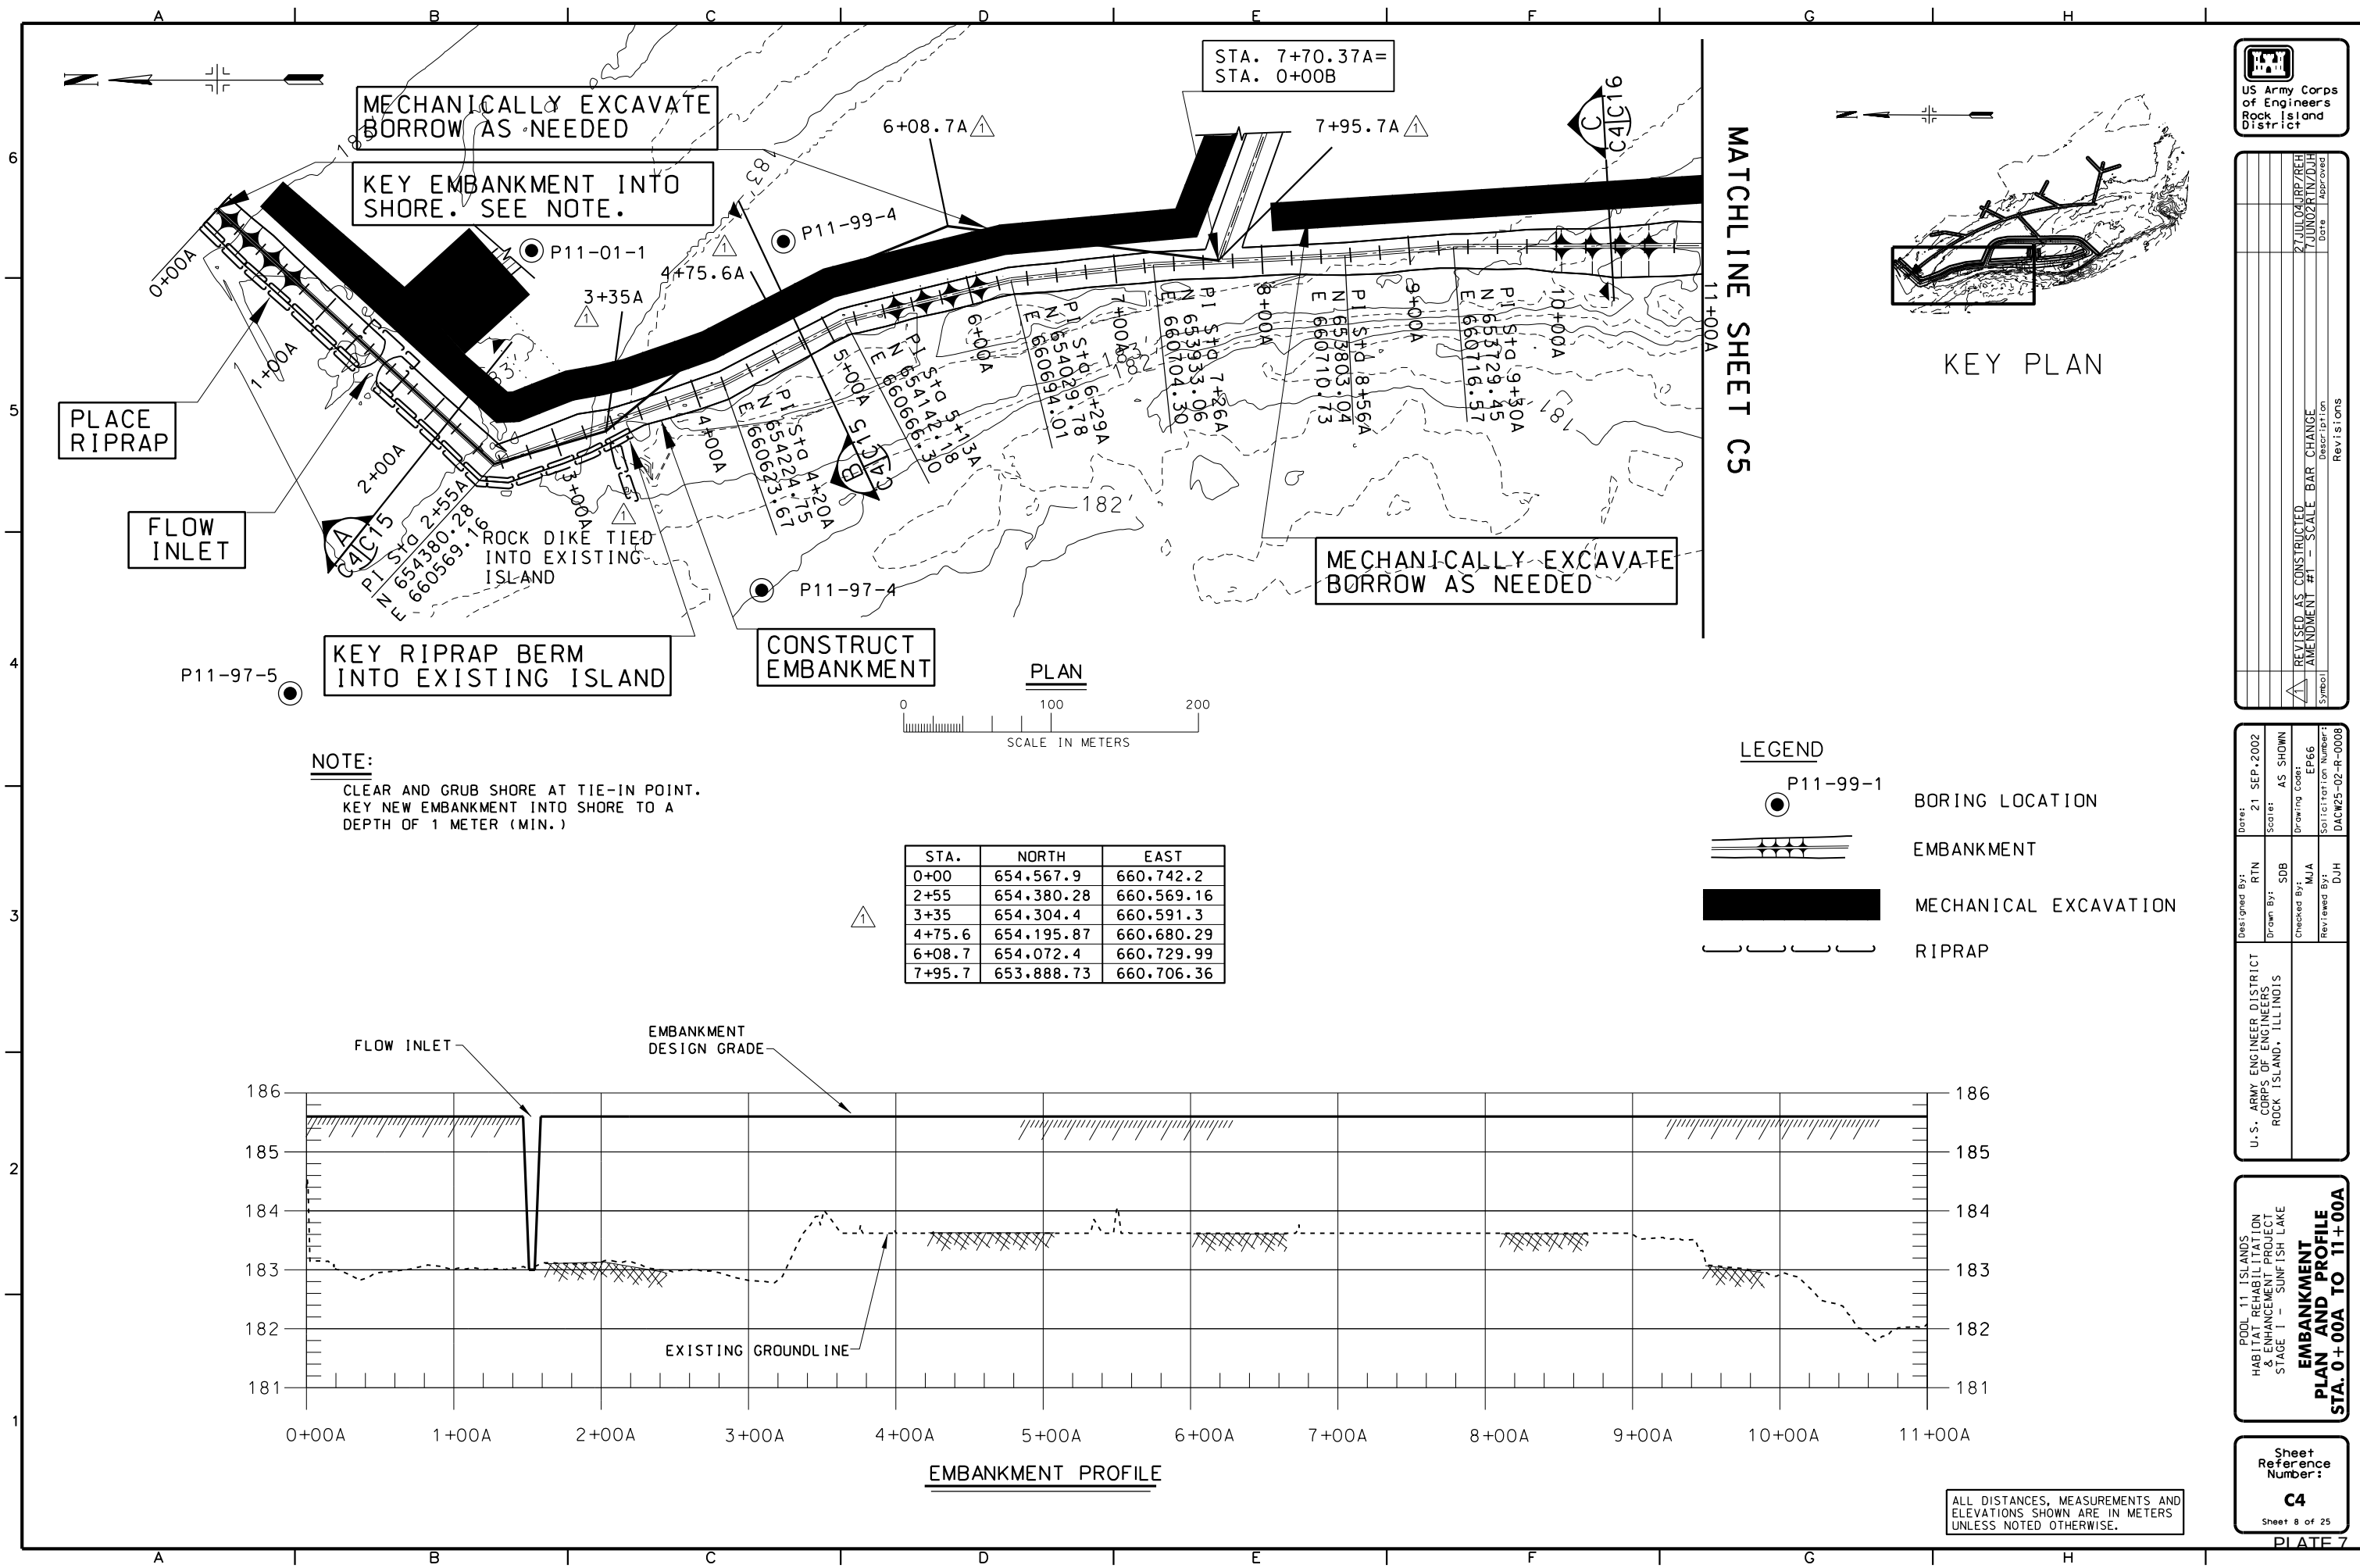


NOTE:
CLEAR AND GRUB SHORE AT TIE-IN POINT.
KEY NEW EMBANKMENT INTO SHORE TO A
DEPTH OF 1 METER (MIN.)

STA.	NORTH	EAST
0+00	654,567.9	660,742.2
2+55	654,380.28	660,569.16
3+35	654,304.4	660,591.3
4+75.6	654,195.87	660,680.29
6+08.7	654,072.4	660,729.99
7+95.7	653,888.73	660,706.36

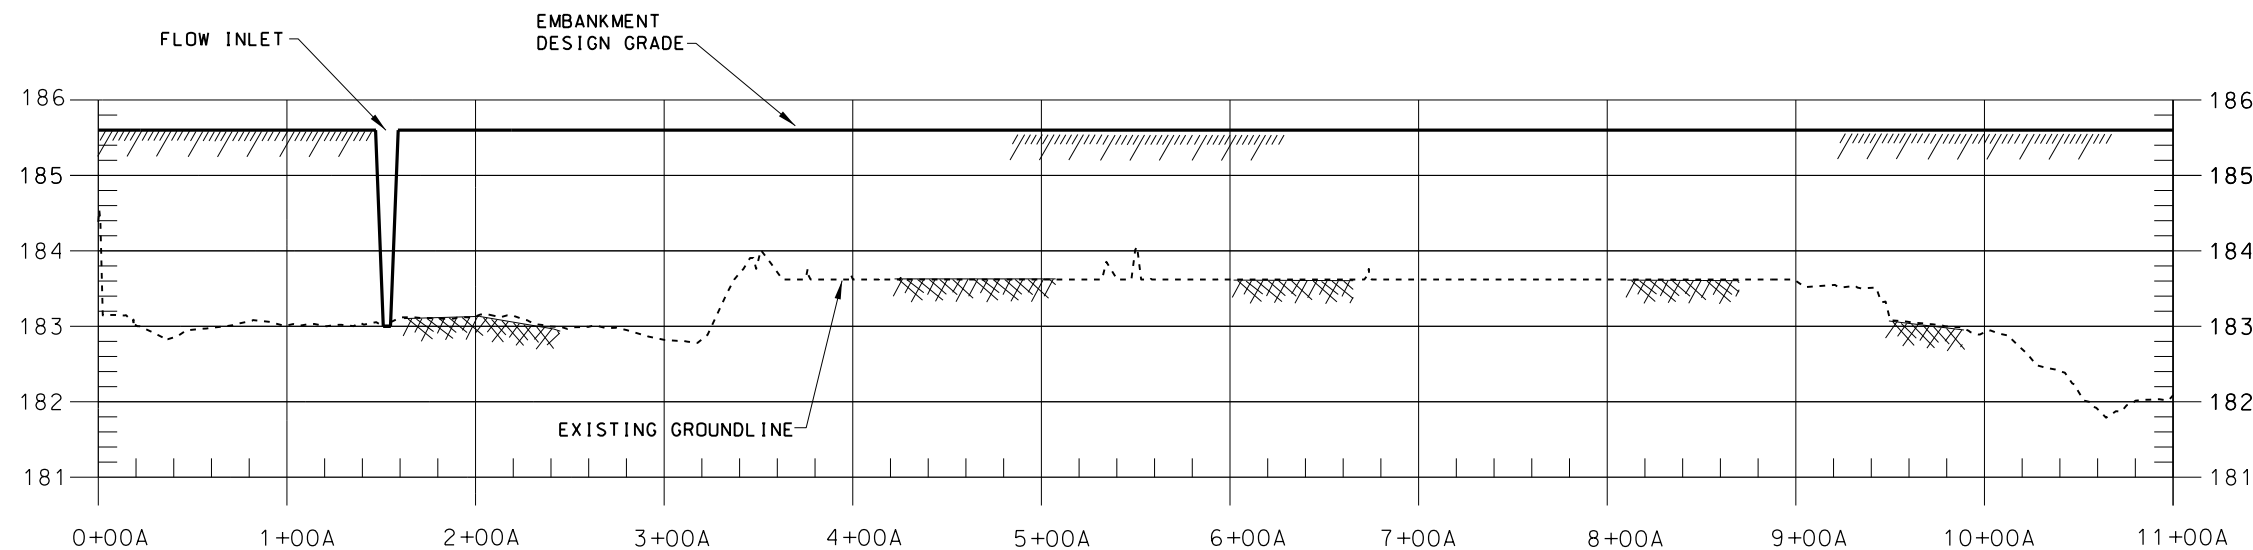

- LEGEND**
- P11-99-1 BORING LOCATION
 - EMBANKMENT
 - MECHANICAL EXCAVATION
 - RIPRAP

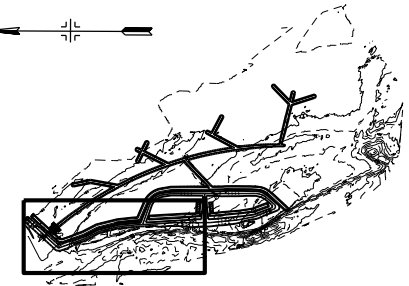

DESIGNED BY: RTN	DATE: 21 SEP 2002
DRAWN BY: SDB	SCALE: AS SHOWN
CHECKED BY: MJA	DRAWING CODE: EP66
REVIEWED BY: DUH	SOLICITATION NUMBER: DACW25-02-R-0008

POOL 11 ISLANDS
HABITAT REHABILITATION
& ENHANCEMENT PROJECT
STAGE 1 - SUNFISH LAKE

**EMBANKMENT
PLAN AND PROFILE
STA. 0+00A TO 11+00A**

Sheet
Reference
Number:
C4


Sheet 8 of 25

PLATE 7



ALL DISTANCES, MEASUREMENTS AND
ELEVATIONS SHOWN ARE IN METERS
UNLESS NOTED OTHERWISE.

22Apr03 15:00 TSep06 04.dgn

MATCHLINE SHEET C4

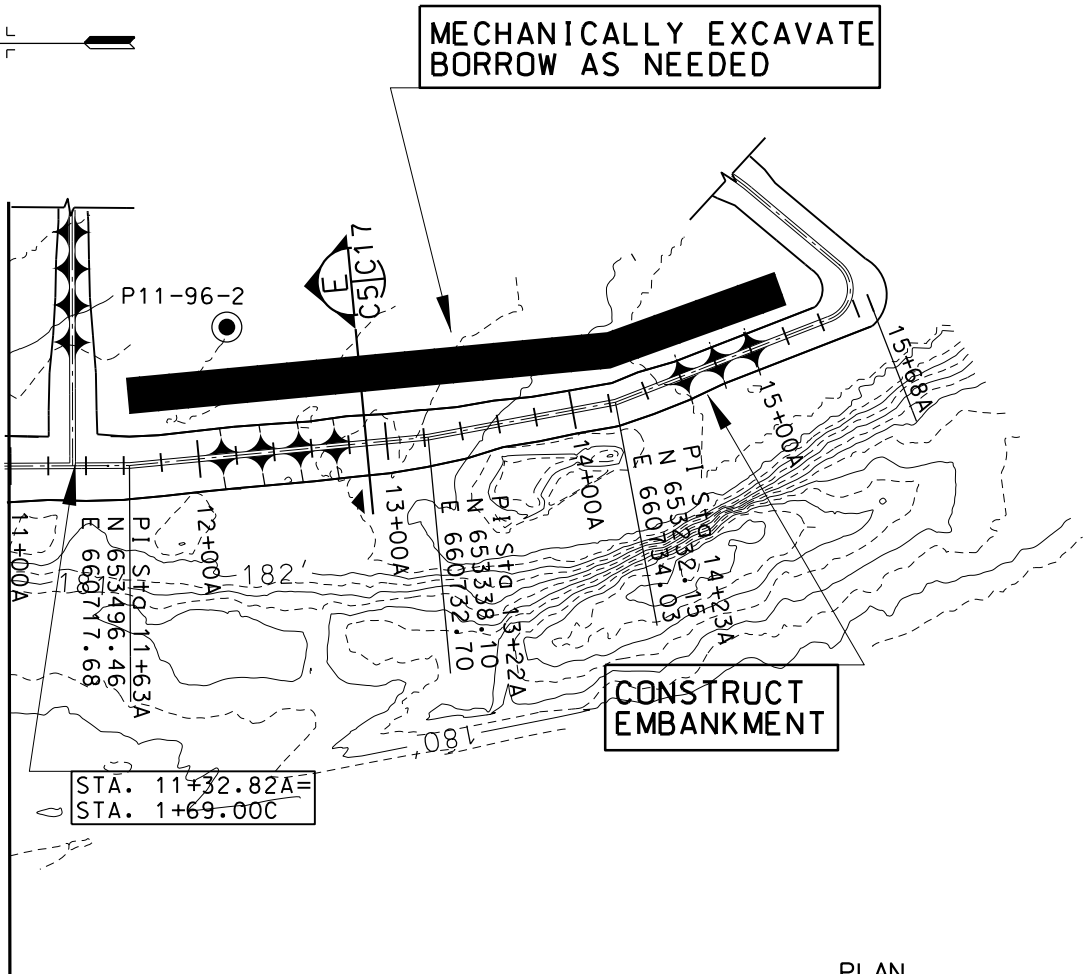


PLAN

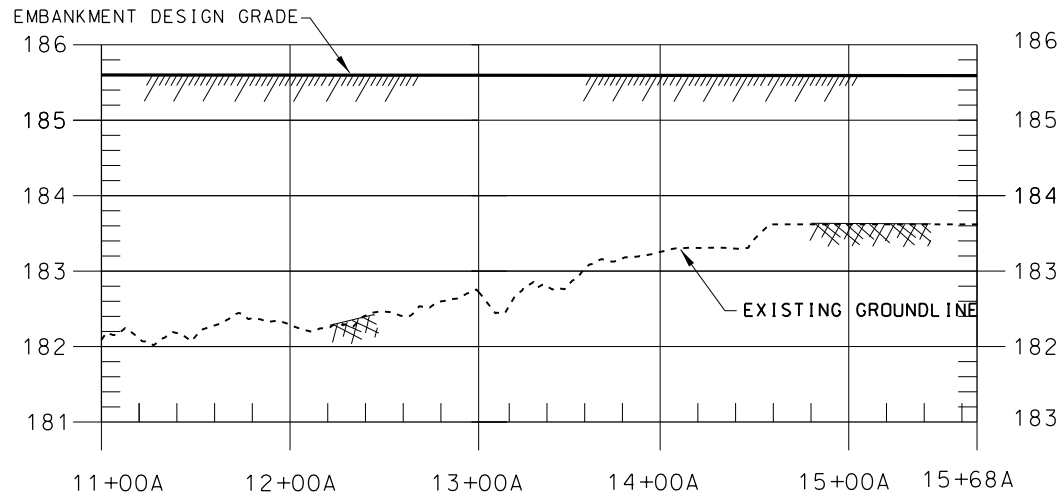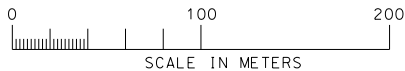

EMBANKMENT PROFILE

LEGEND

- P11-99-1 BORING LOCATION
- EMBANKMENT
- MECHANICAL EXCAVATION

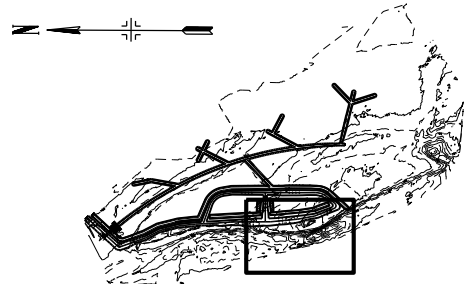

KEY PLAN




Symbol	Description	Revisions
AS	AS - CONSTRUCTED	
AMENDMENT #1	SCALE BAR CHANGE	
27JUL04JRP/ZRH	Date	Approved
7JUN02RIN/DJH	Date	Approved

U.S. ARMY ENGINEER DISTRICT CORPS OF ENGINEERS ROCK ISLAND, ILLINOIS	Designed By: RTN Drawn By: SDB Checked By: MJA Reviewed By: DJH	Date: 21 SEP 2002 Scale: AS SHOWN Drawing Code: EP66 Solicitation Number: DACW25-02-R-0008
--	--	---

POOL 11 ISLANDS
HABITAT REHABILITATION
& ENHANCEMENT PROJECT
STAGE 1 - SUNFISH LAKE
**EMBANKMENT
PLAN AND PROFILE
STA. 11+00A TO 15+68A**

Sheet
Reference
Number:
C5
Sheet 9 of 25

ALL DISTANCES, MEASUREMENTS AND
ELEVATIONS SHOWN ARE IN METERS
UNLESS NOTED OTHERWISE.

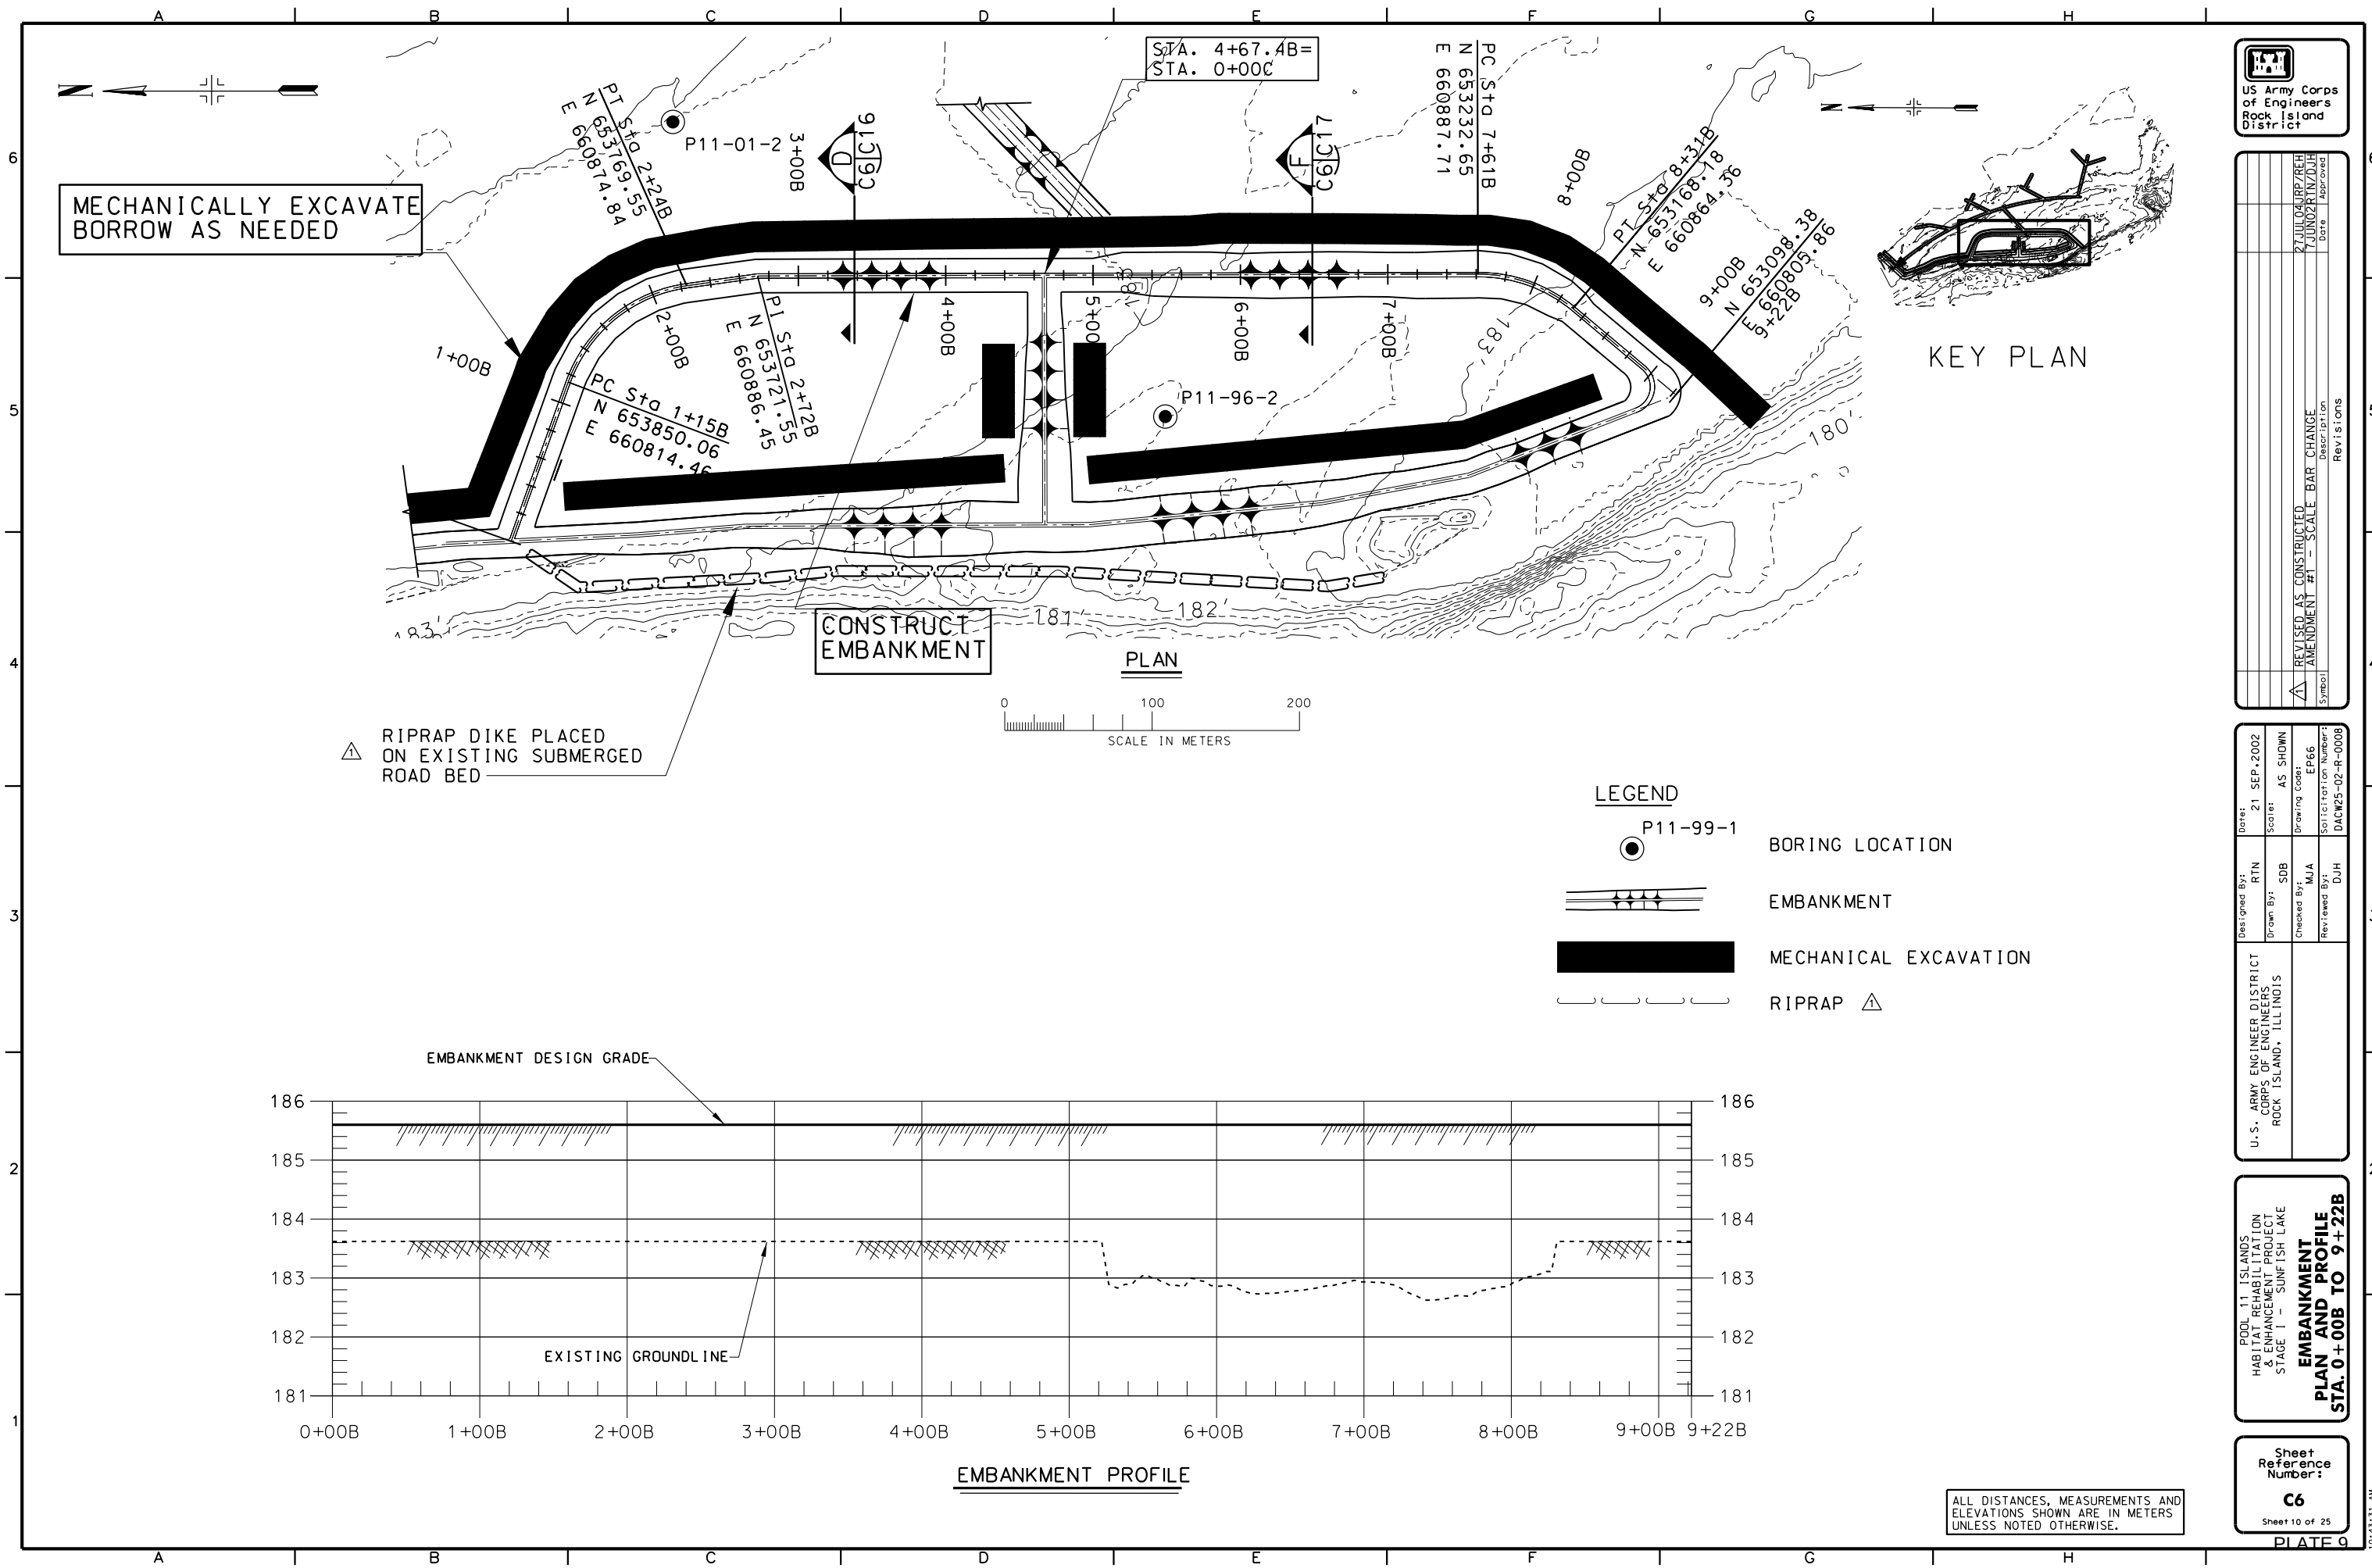

US Army Corps
of Engineers
Rock Island
District




Symbol	Description	Revisions
△	REVISED AS CONSTRUCTED	
	AMENDMENT #1 - SCALE BAR CHANGE	
	27JUL04JRP/ZRH	Approved
	7JUN02RIN/DJH	Date

U.S. ARMY ENGINEER DISTRICT CORPS OF ENGINEERS ROCK ISLAND, ILLINOIS	Designed By: RTN Drawn By: SDB Checked By: MJA Reviewed By: DJH	Date: 21 SEP. 2002 Scale: AS SHOWN Drawing Code: EP66 Solicitation Number: DACW25-02-R-0008
--	--	--

POOL 11 ISLANDS
HABITAT REHABILITATION
& ENHANCEMENT PROJECT
STAGE 1 - SUNFISH LAKE
**EMBANKMENT
PLAN AND PROFILE
STA. 0+00B TO 9+22B**

Sheet
Reference
Number:
C6
Sheet 10 of 25


ALL DISTANCES, MEASUREMENTS AND
ELEVATIONS SHOWN ARE IN METERS
UNLESS NOTED OTHERWISE.

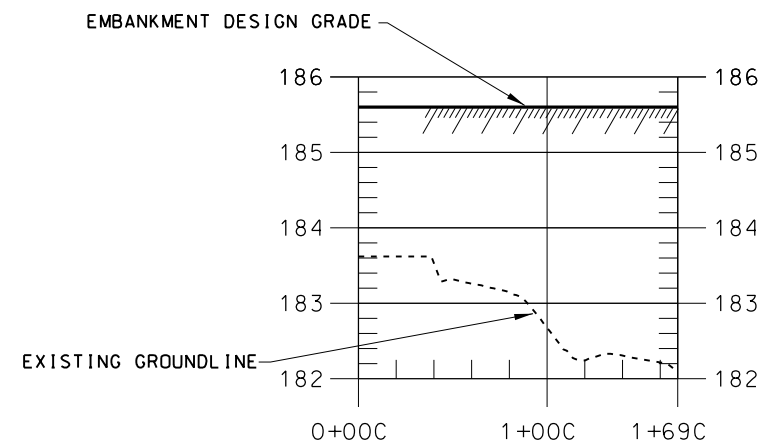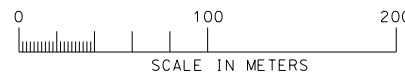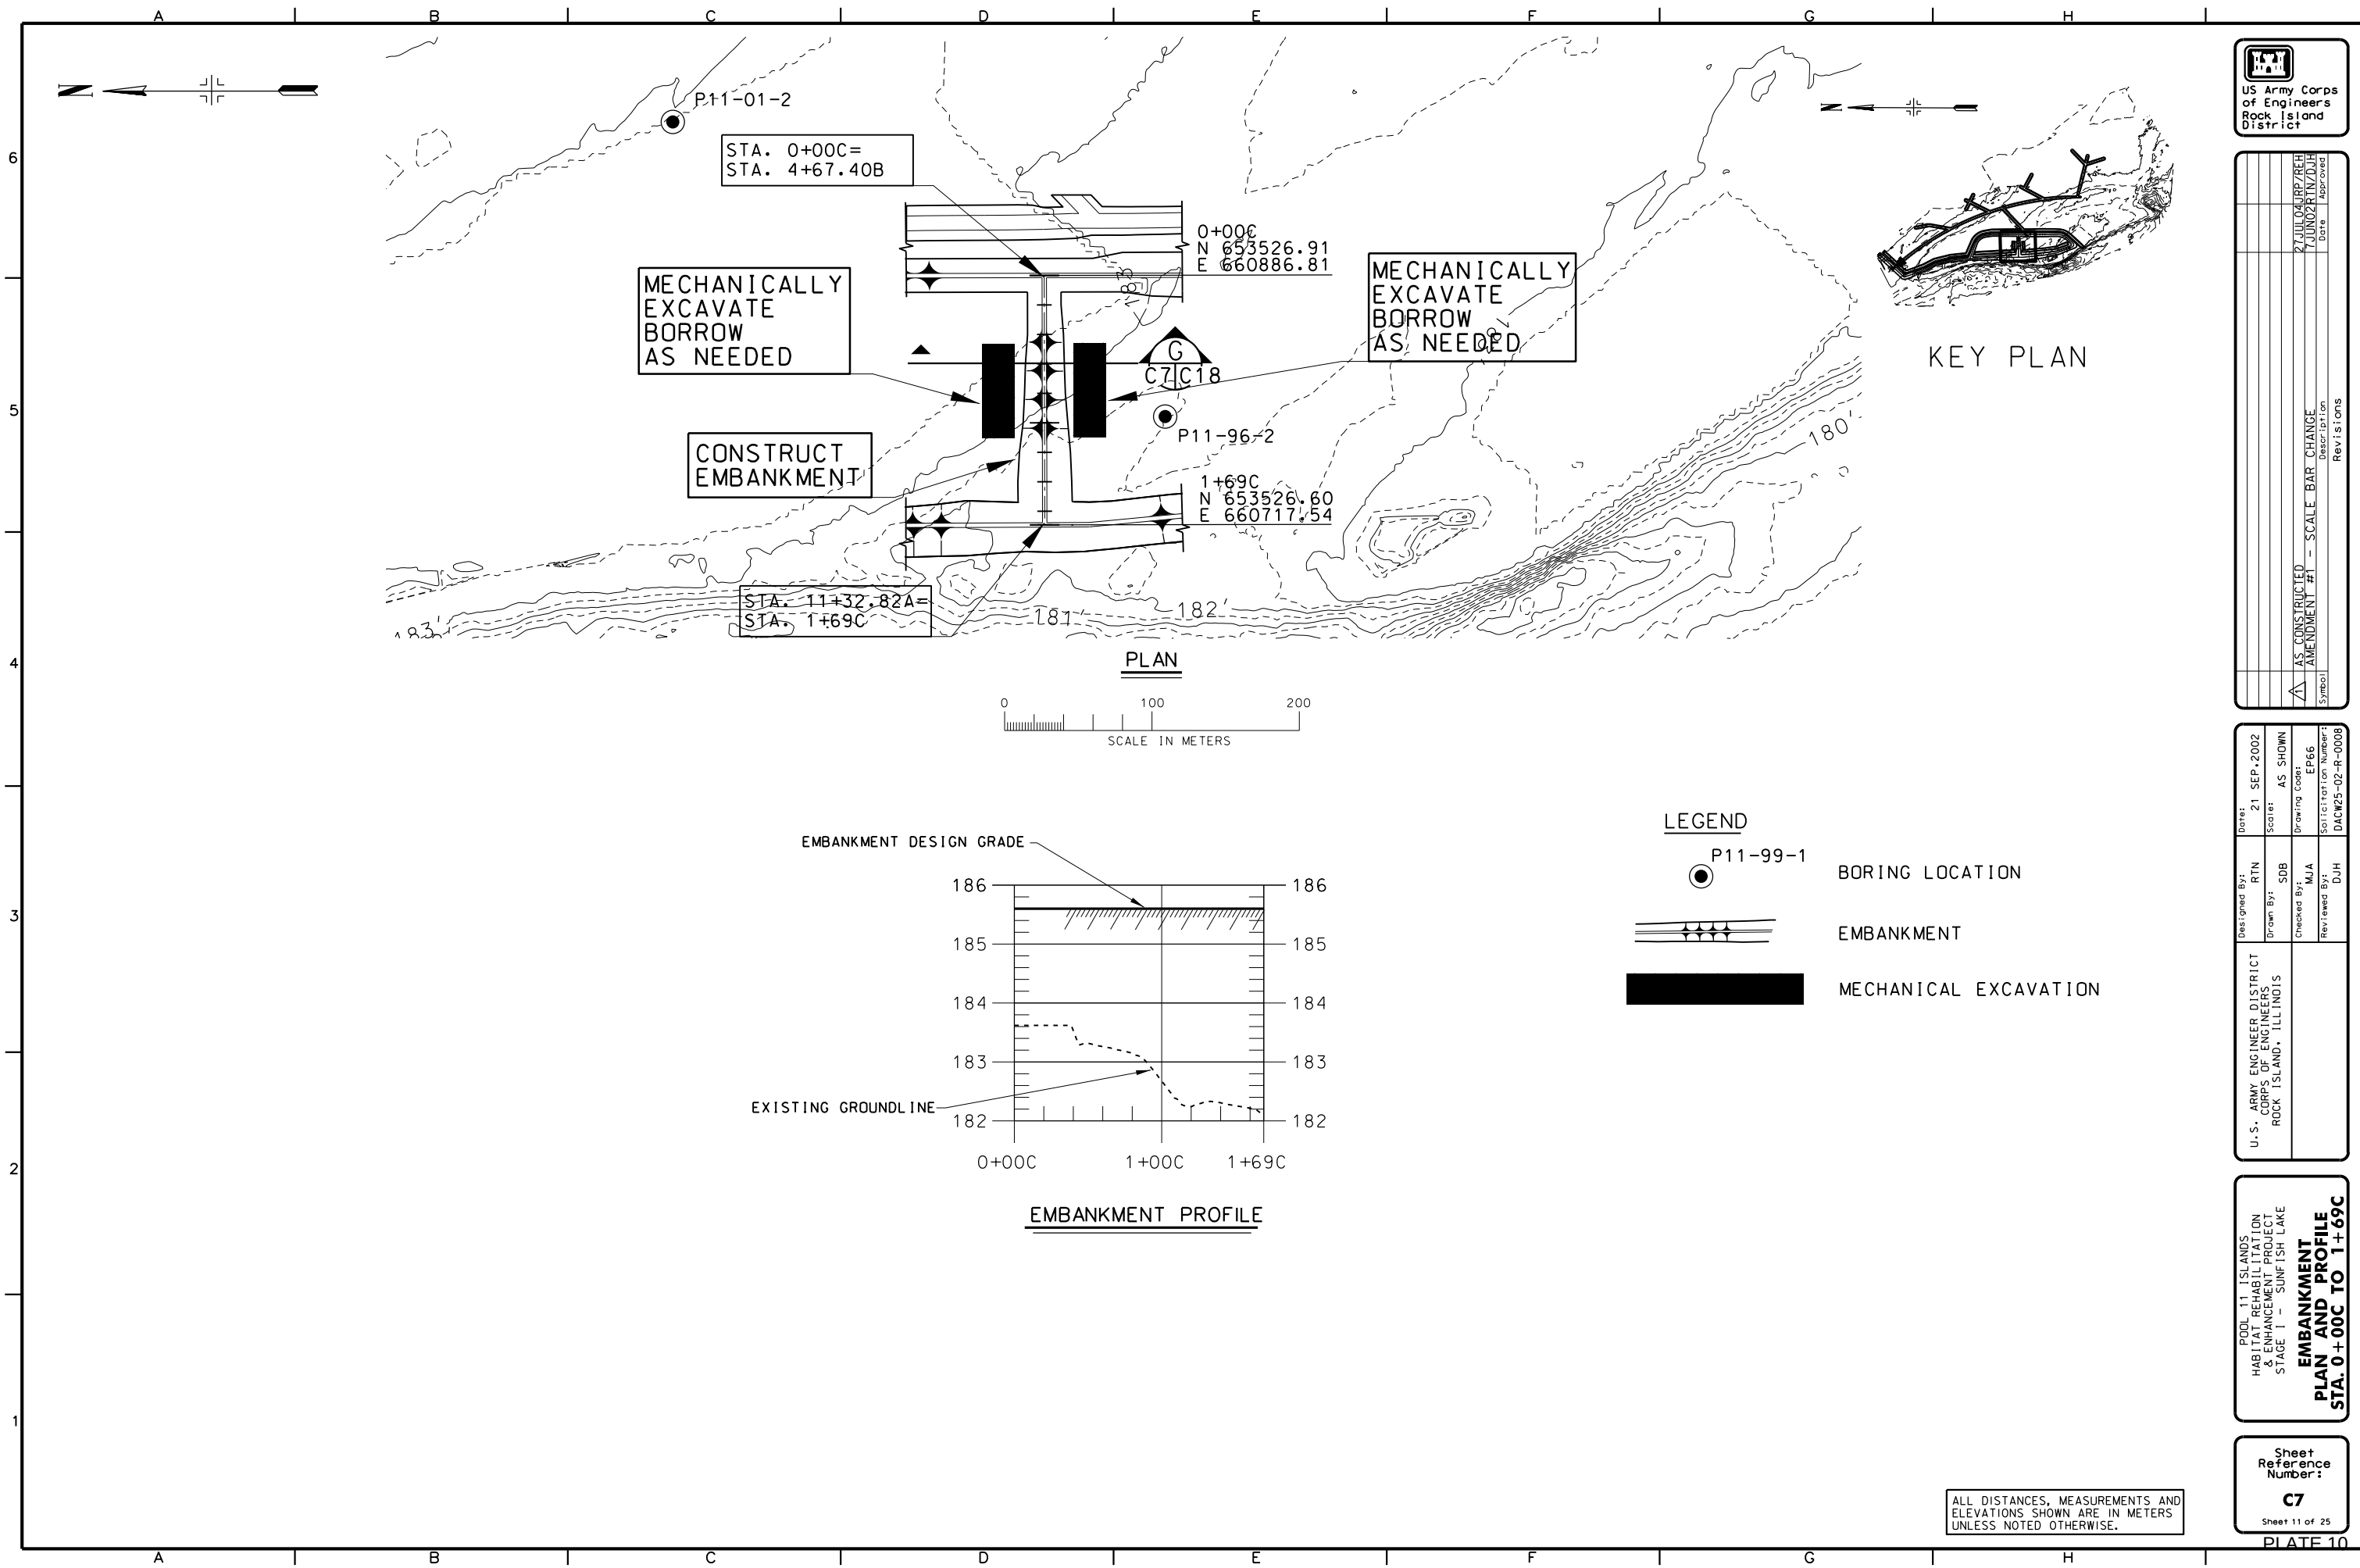

EMANKMENT PROFILE

LEGEND

- P11-99-1 BORING LOCATION
- EMBANKMENT
- MECHANICAL EXCAVATION

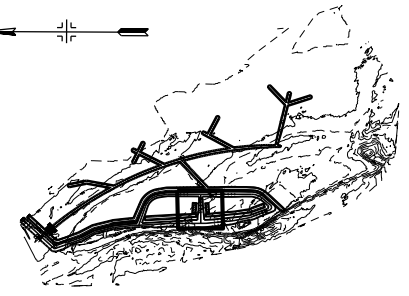

KEY PLAN






Symbol	Description	Revisions
AS CONSTRUCTED	AMENDMENT #1 - SCALE BAR CHANGE	
27JUL04JRP/ZRH	Date	Approved
7JUN02RIN/DJH	Date	Approved

Designed By: RTN	Date: 21 SEP 2002
Drawn By: SDB	Scale: AS SHOWN
Checked By: MJA	Drawing Code: EP66
Reviewed By: DJH	Solicitation Number: DACW25-02-R-0008

POOL 11 ISLANDS
HABITAT REHABILITATION
& ENHANCEMENT PROJECT
STAGE 1 - SUNFISH LAKE
**EMANKMENT
PLAN AND PROFILE
STA. 0+00C TO 1+69C**

Sheet
Reference
Number:
C7
Sheet 11 of 25

ALL DISTANCES, MEASUREMENTS AND
ELEVATIONS SHOWN ARE IN METERS
UNLESS NOTED OTHERWISE.

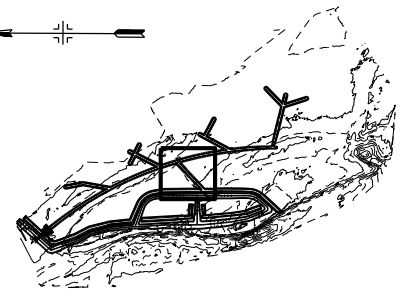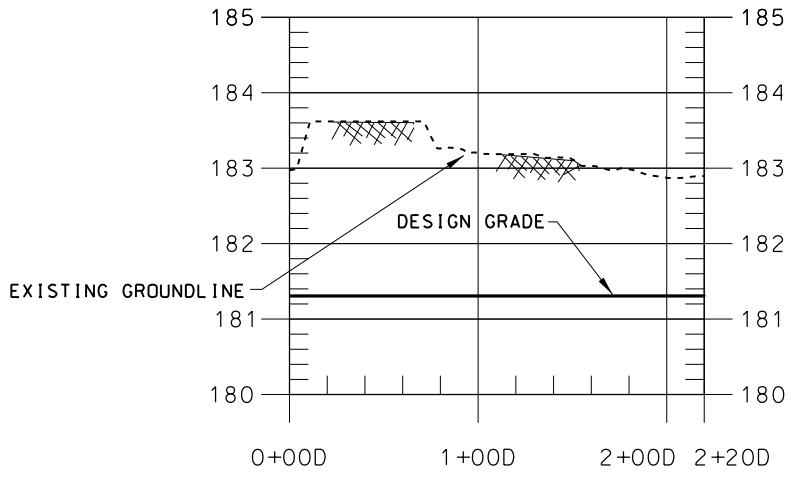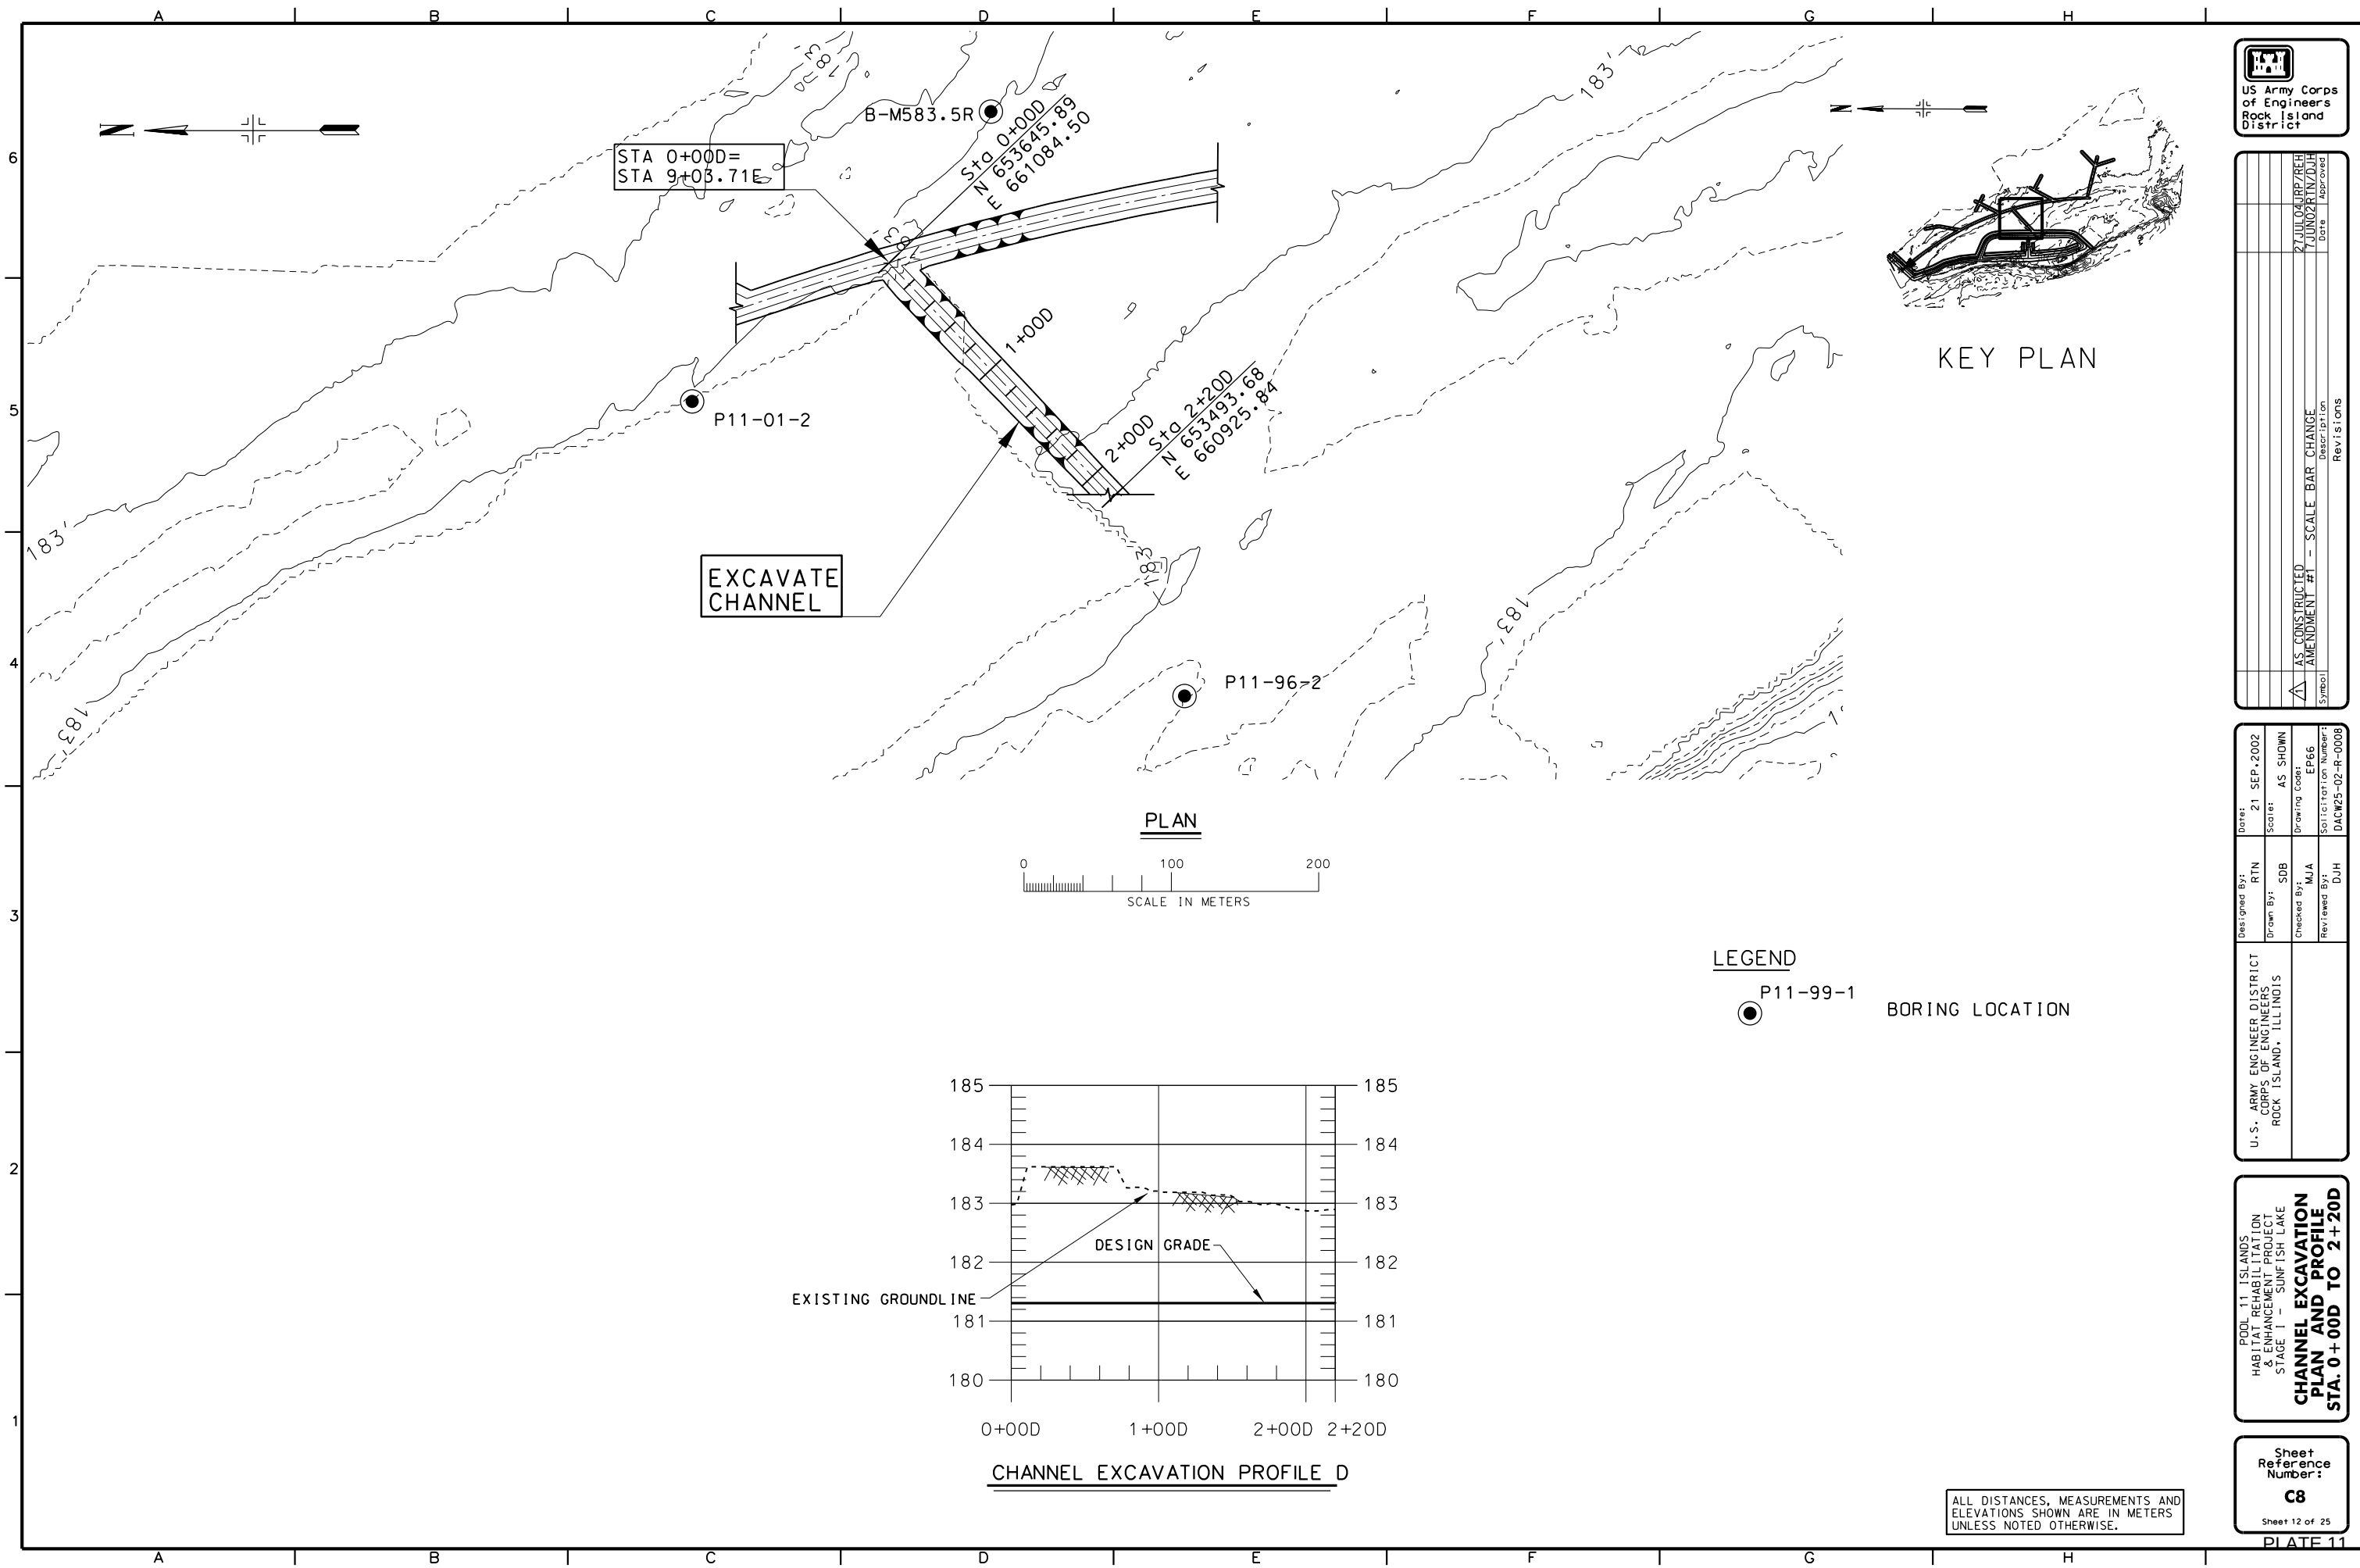

KEY PLAN

LEGEND

P11-99-1 BORING LOCATION






Symbol	Description	Revisions
AS	AS CONSTRUCTED	
AMENDMENT #1	SCALE BAR CHANGE	
27JUL04JRP/ZRH	Date	Approved
7JUN02RIN/DJH	Date	Approved

U.S. ARMY ENGINEER DISTRICT CORPS OF ENGINEERS ROCK ISLAND DISTRICT	Designed By: RTN Drawn By: SDB Checked By: MJA Reviewed By: DJH	Date: 21 SEP 2002 Scale: AS SHOWN Drawing Code: EP66 Solicitation Number: DACW25-02-R-0008
---	--	---

POOL 11 ISLANDS
HABITAT REHABILITATION
& ENHANCEMENT PROJECT
STAGE 1 - SUNFISH LAKE
CHANNEL EXCAVATION
PLAN AND PROFILE
STA. 0+000 TO 2+200

Sheet
Reference
Number:
C8
Sheet 12 of 25

ALL DISTANCES, MEASUREMENTS AND
ELEVATIONS SHOWN ARE IN METERS
UNLESS NOTED OTHERWISE.

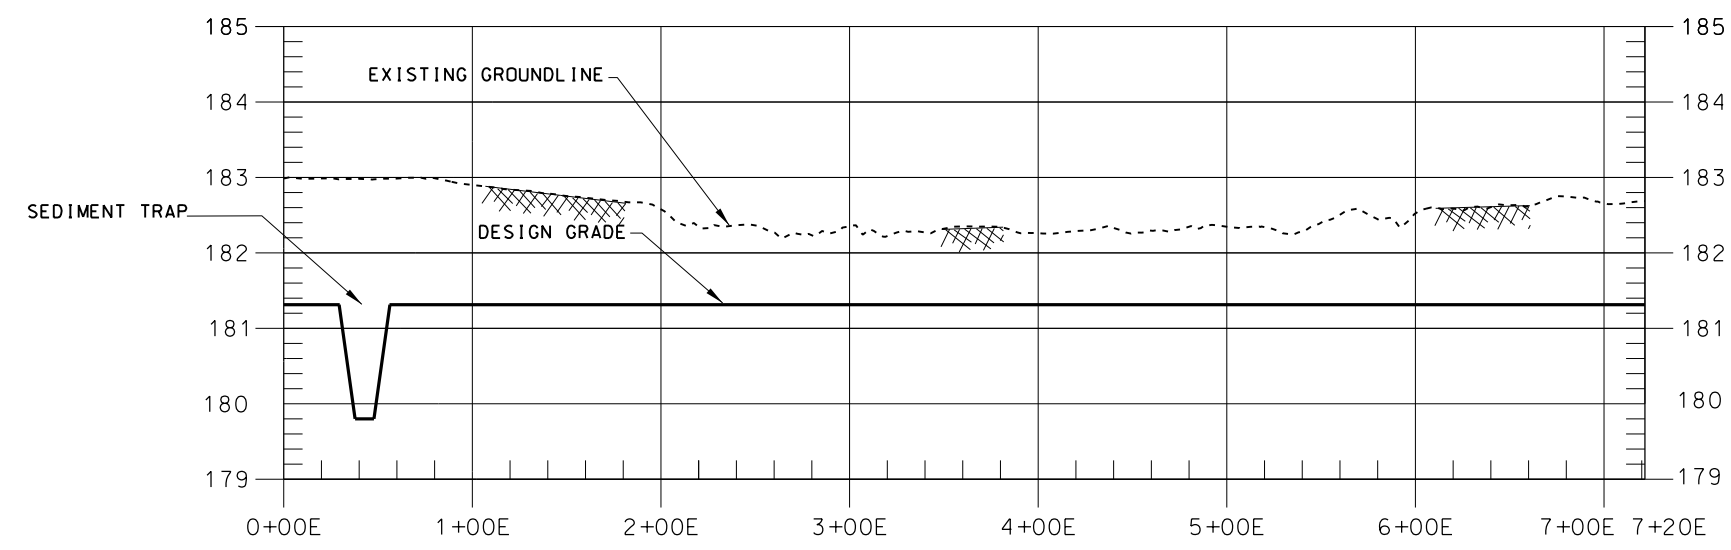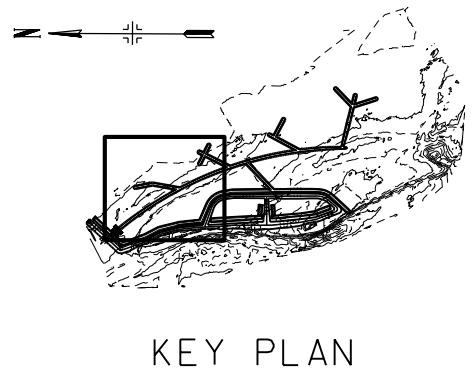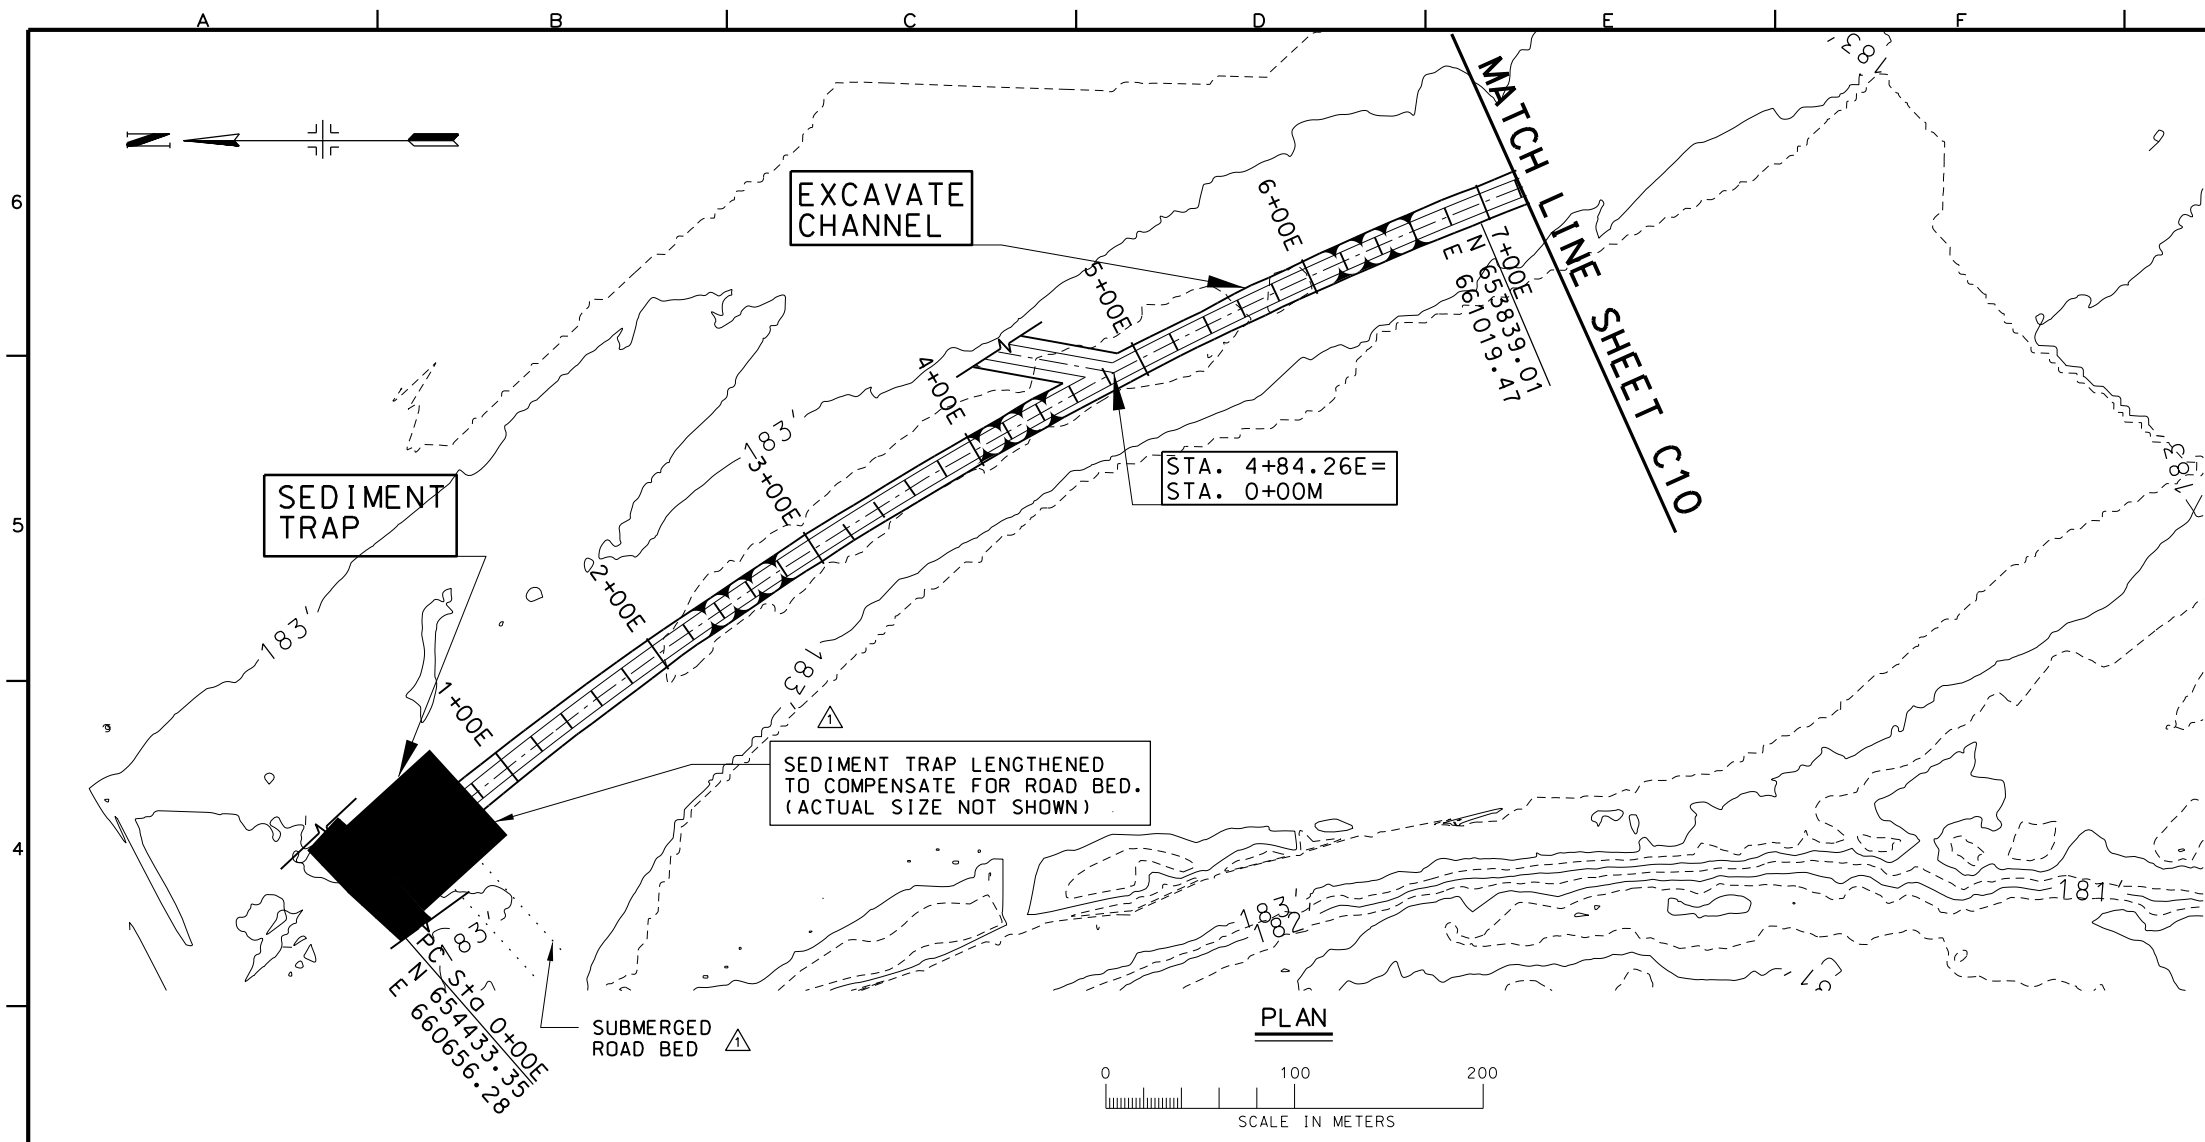

CHANNEL EXCAVATION PROFILE E

ALL DISTANCES, MEASUREMENTS AND ELEVATIONS SHOWN ARE IN METERS UNLESS NOTED OTHERWISE.





Symbol	Description	Revisions
Δ	REVISED AS CONSTRUCTED	
	AMENDMENT #1 - SCALE BAR CHANGE	
	27 JUL 04 JRP/REH	Approved
	7 JUN 02 RTN/DJH	Date


Designed By:	RTN	Date:	21 SEP 2002
Drawn By:	SDB	Scale:	AS SHOWN
Checked By:	MJA	Drawing Code:	EP66
Reviewed By:	DJH	Solicitation Number:	DACW25-02-R-0008

POOL 11 ISLANDS
HABITAT REHABILITATION
& ENHANCEMENT PROJECT
STAGE 1 - SUNFISH LAKE
**CHANNEL EXCAVATION
PLAN AND PROFILE
STA. 0+00E TO 7+20E**

Sheet
Reference
Number:
C9
Sheet 13 of 25

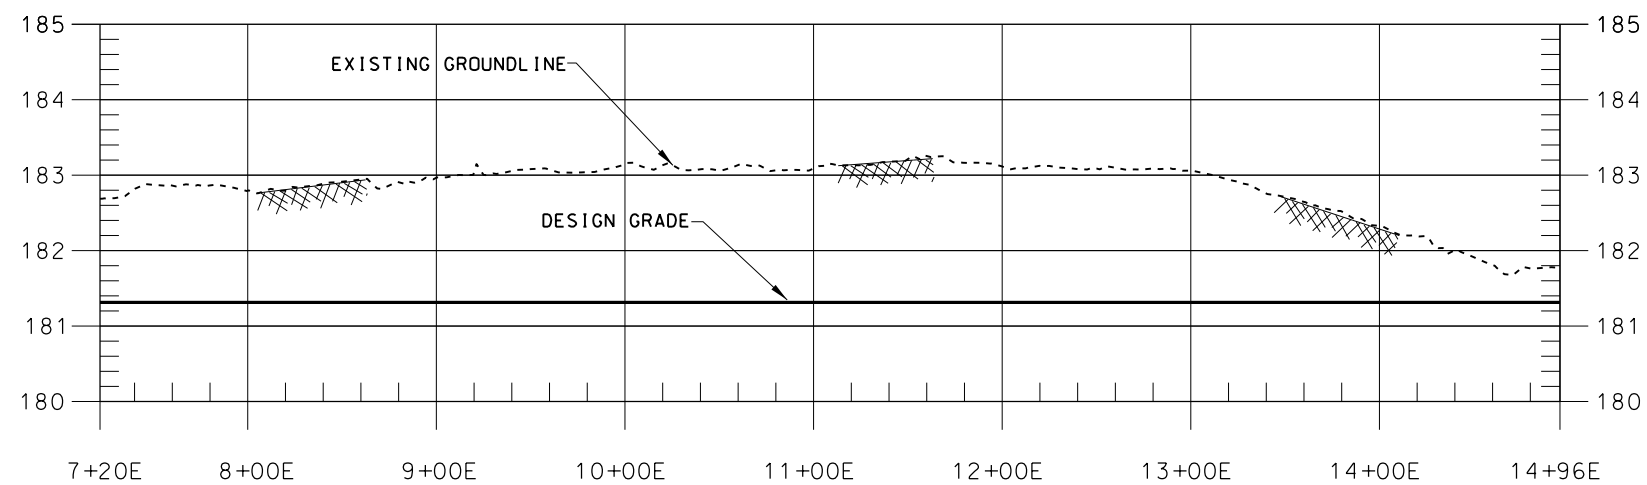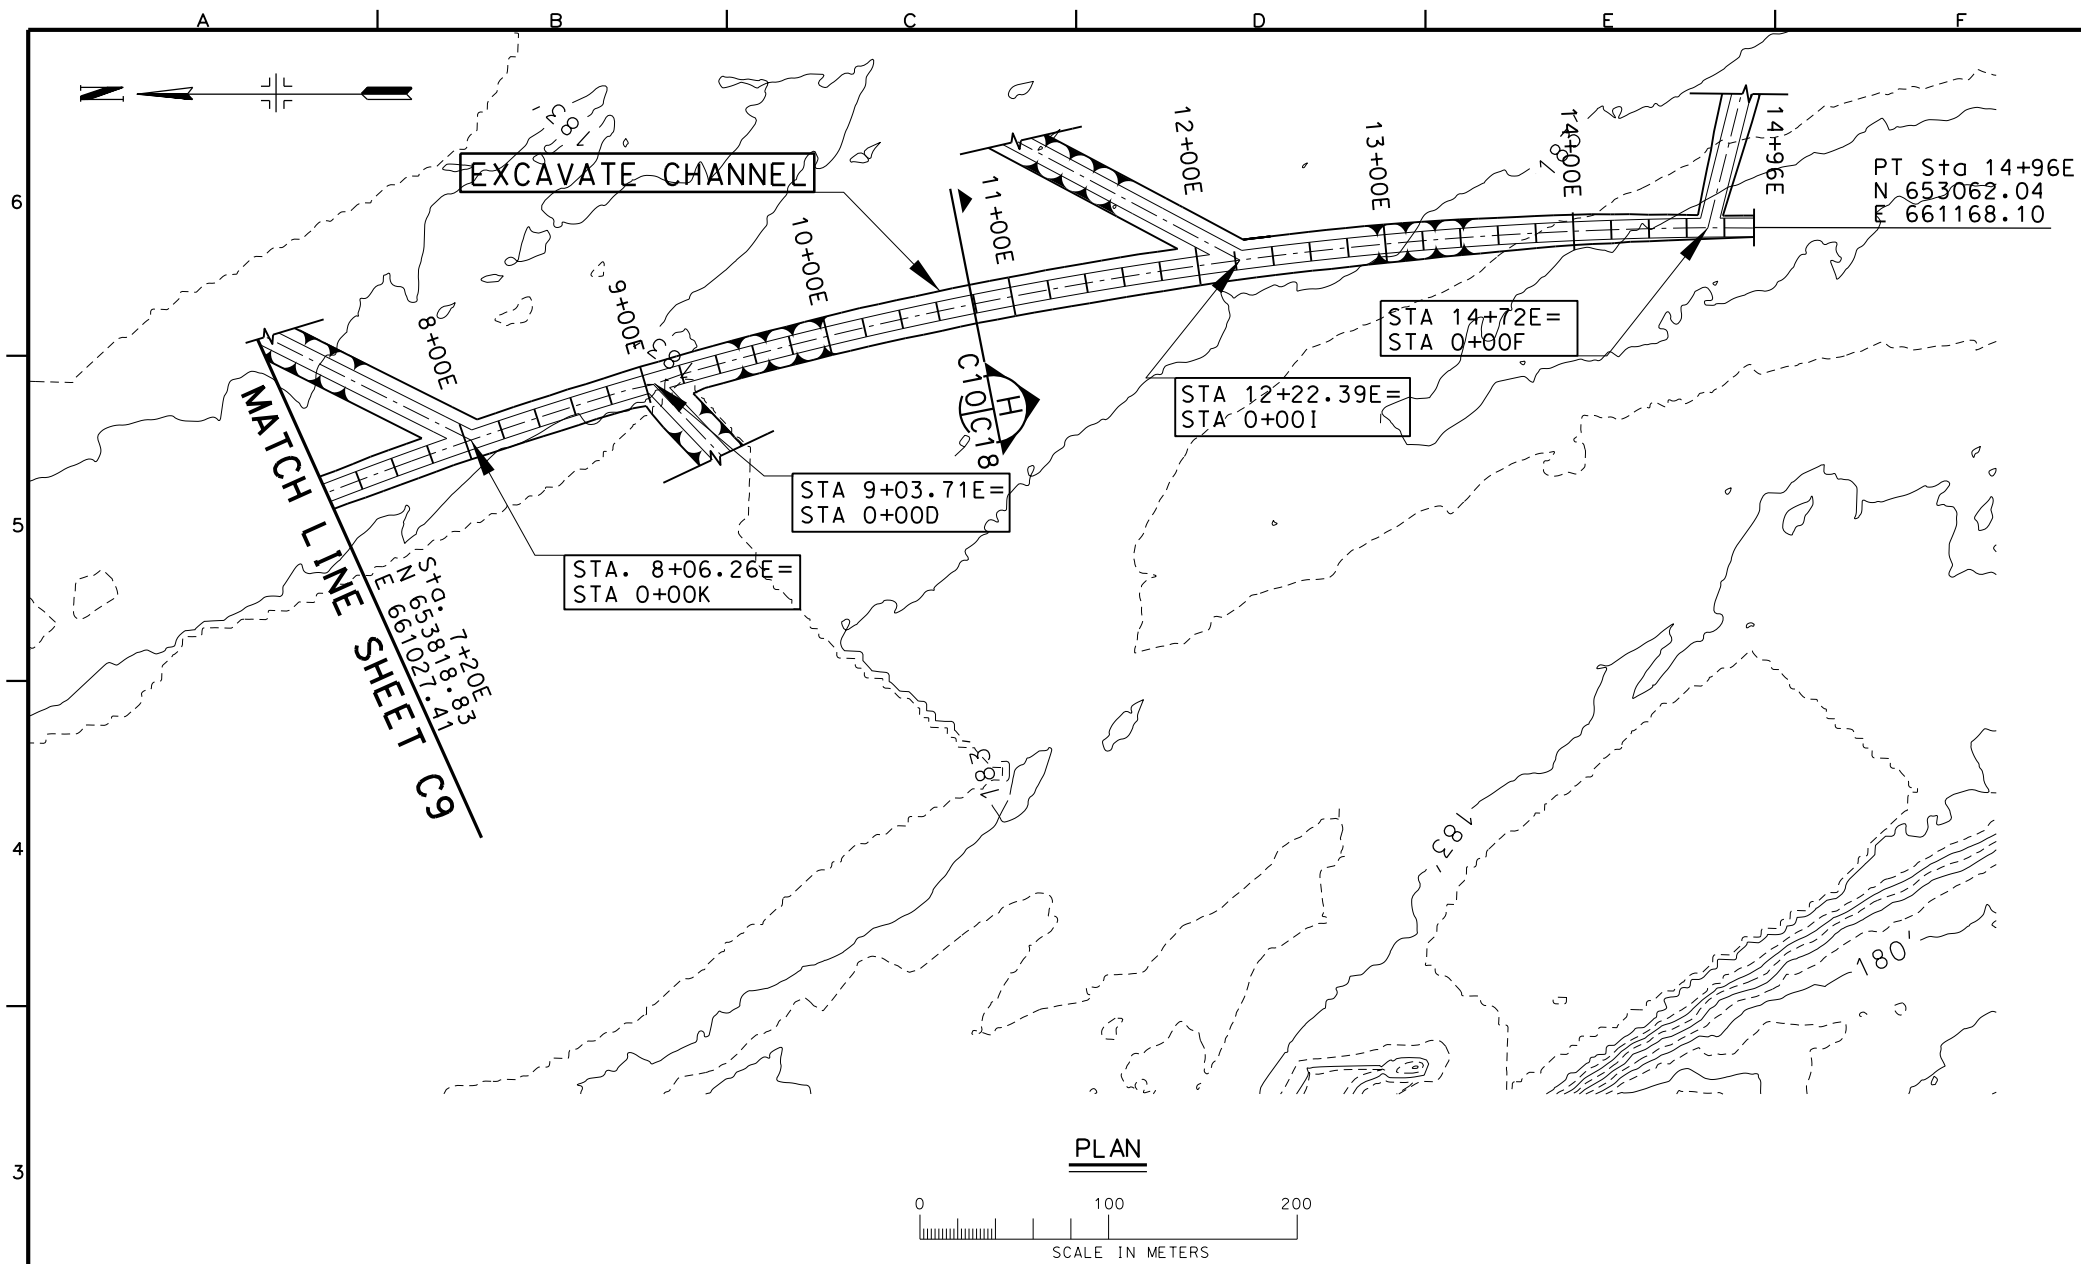

ALL DISTANCES, MEASUREMENTS AND
ELEVATIONS SHOWN ARE IN METERS
UNLESS NOTED OTHERWISE.



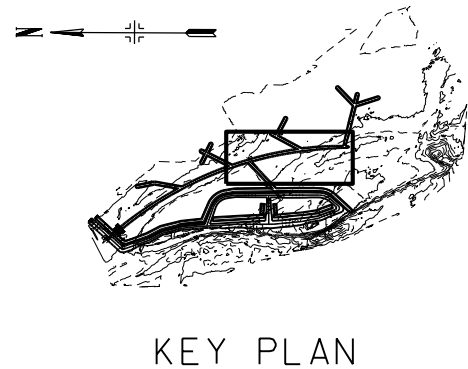


Symbol	Description	Revisions
AS	AS CONSTRUCTED	
AMENDMENT #1	SCALE BAR CHANGE	
27JUL04JRP/ZRH	Date	Approved
7JUN02RIN/DJH	Date	Approved


Designed By:	RTN	Date:	21 SEP 2002
Drawn By:	SDB	Scale:	AS SHOWN
Checked By:	MJA	Drawing Code:	EP66
Reviewed By:	DJH	Solicitation Number:	DACW25-02-R-0008

POOL 11 ISLANDS
HABITAT REHABILITATION
& ENHANCEMENT PROJECT
STAGE 1 - SUNFISH LAKE
**CHANNEL EXCAVATION
PLAN AND PROFILE
STA. 7+20E TO 14+96E**

Sheet
Reference
Number:
C10
Sheet 14 of 25

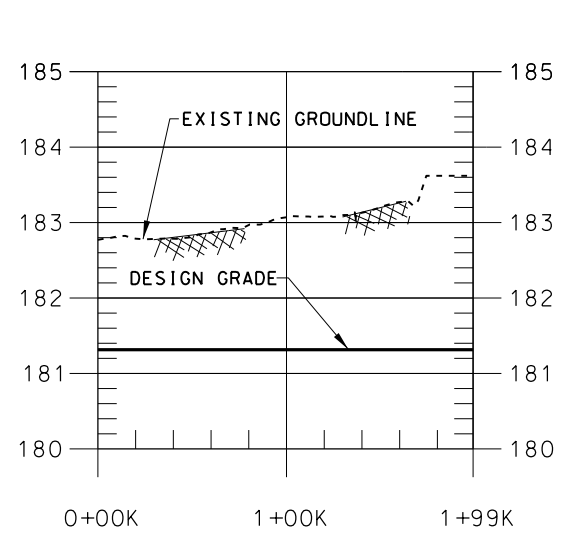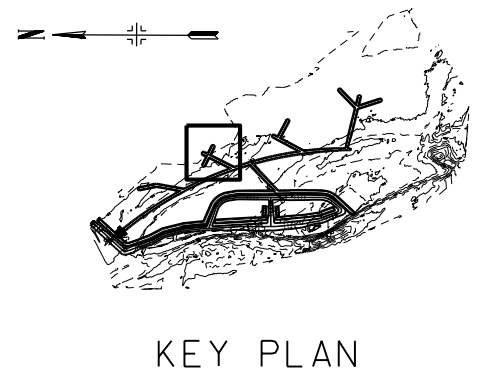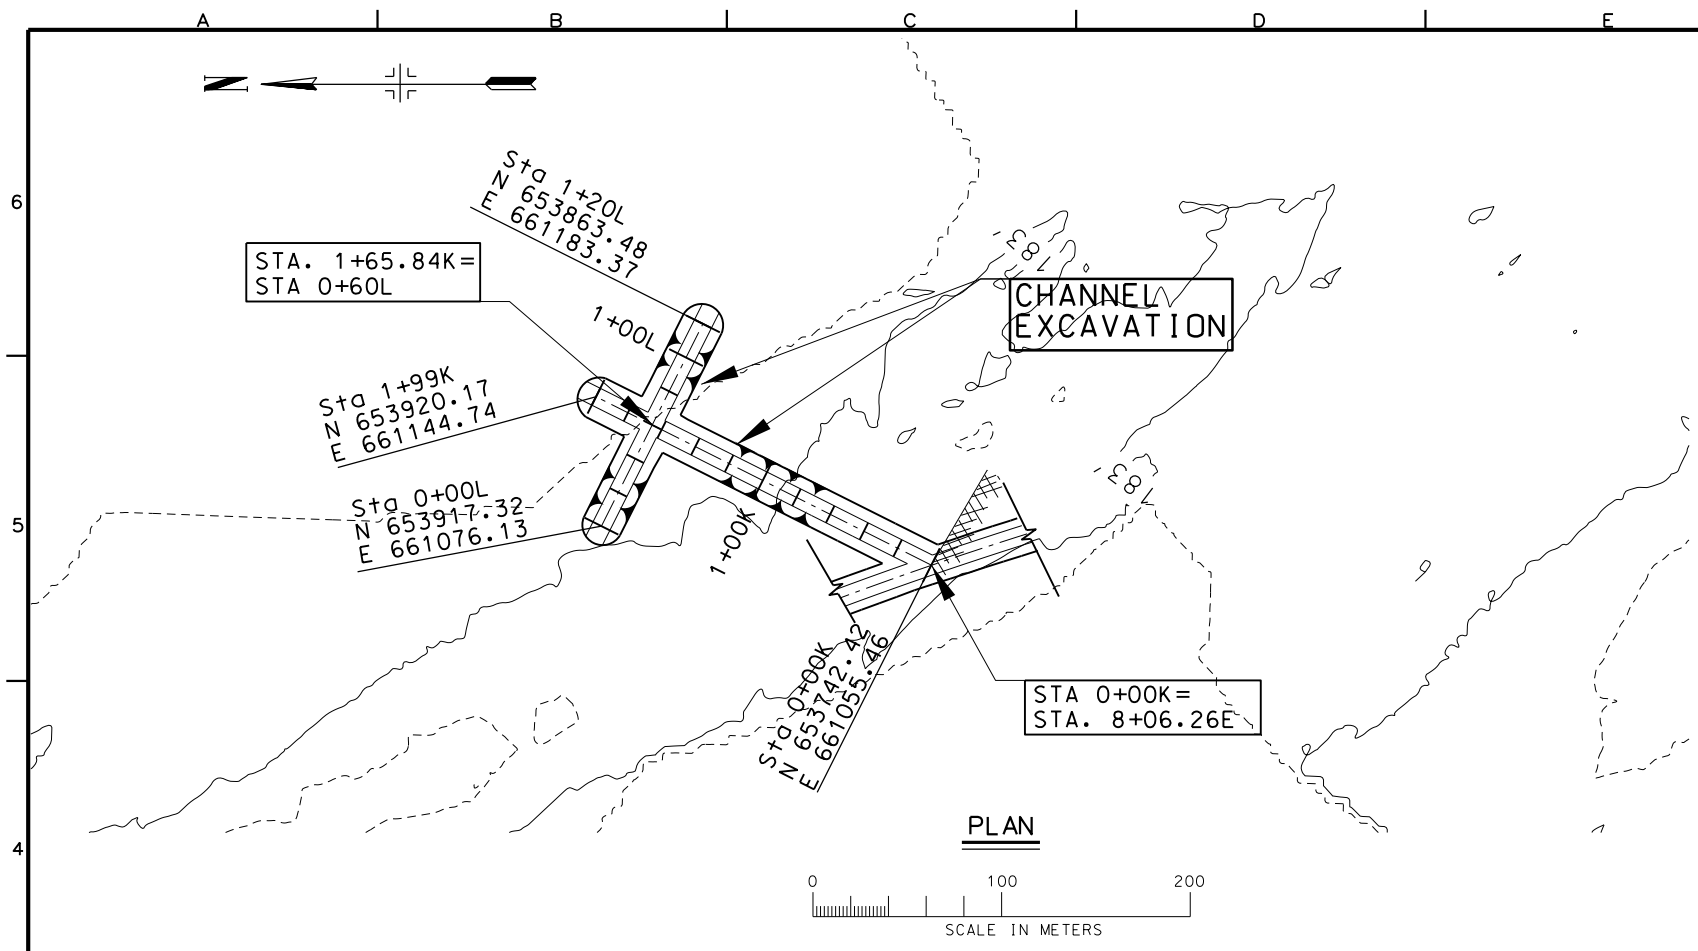

CHANNEL EXCAVATION PROFILE K

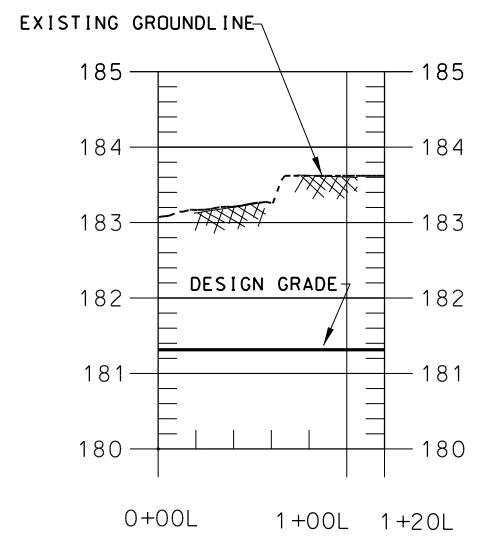

CHANNEL EXCAVATION PROFILE L

ALL DISTANCES, MEASUREMENTS AND ELEVATIONS SHOWN ARE IN METERS UNLESS NOTED OTHERWISE.



Symbol	Description	Date	Approved
AS - CONSTRUCTED	AS - CONSTRUCTED	27JUL04JRP/REH	
AMENDMENT #1	AMENDMENT #1	7JUN02RIN/DJH	
SCALE	SCALE		
BAR CHANGE	BAR CHANGE		

Designed By:	RTN	Date:	21 SEP.2002
Drawn By:	SDB	Scale:	AS SHOWN
Checked By:	MJA	Drawing Code:	EP66
Reviewed By:	DJH	Solicitation Number:	DACW25-02-R-0008

POOL 11 ISLANDS
HABITAT REHABILITATION
& ENHANCEMENT PROJECT
STAGE 1 - SUNFISH LAKE
**CHANNEL EXCAVATION
PLAN AND PROFILES**
K/L


Sheet
Reference
Number:
C13
Sheet 17 of 25
PLATE 16

Revisions	Symbol	Description	Date	Approved
1	AS CONSTRUCTED		27 JUL 04 JRP/REH	

Designed By:	RTN	Date:	21 SEP 2002
Drawn By:	SDB	Scale:	AS SHOWN
Checked By:	MJA	Drawing Code:	EP66
Reviewed By:	DJH	Soil Citation Number:	DACW25-02-R-0008


POOL 11 ISLANDS HABITAT REHABILITATION & ENHANCEMENT PROJECT STAGE 1 - SUNFISH LAKE	TYPICAL SECTIONS I
--	--------------------

Sheet Reference Number: C15 Sheet 19 of 25

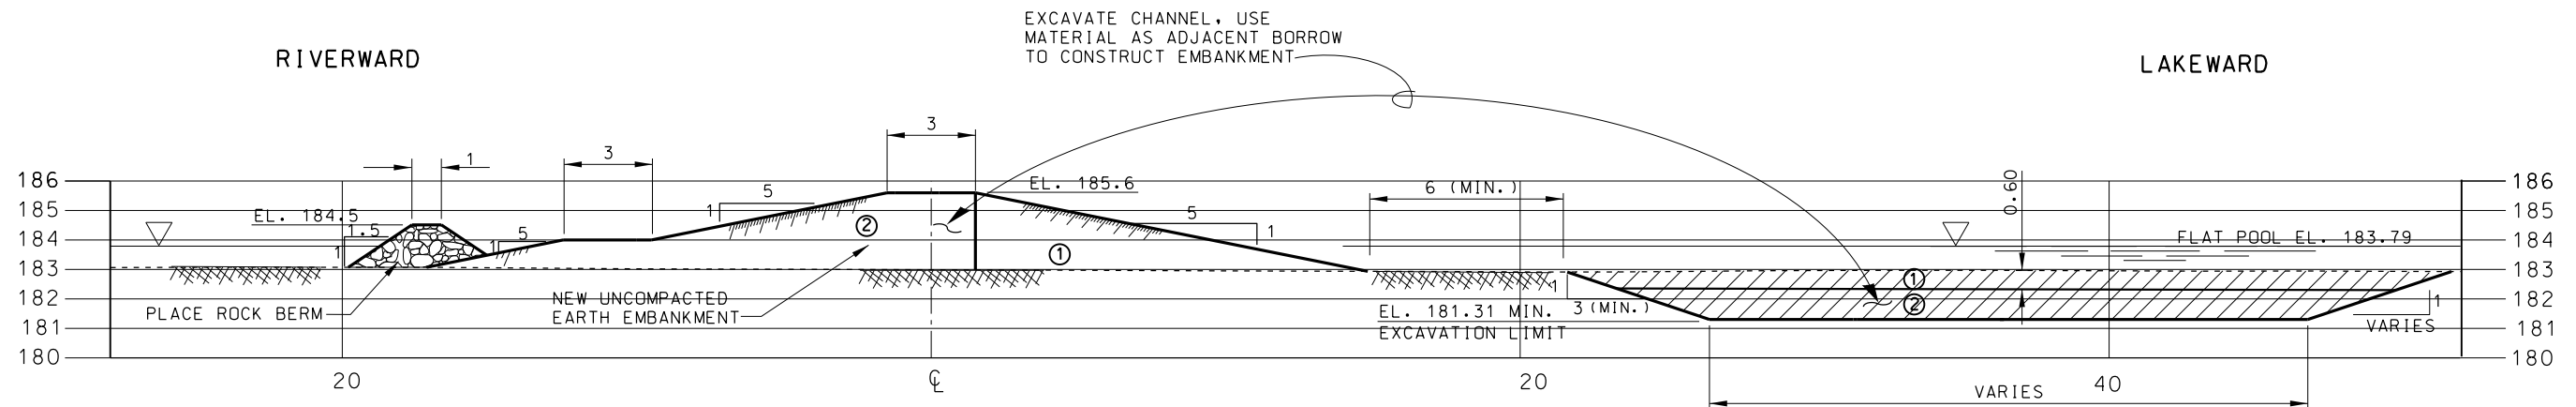

A
C4/C15 TYPICAL SECTION EMBANKMENT AND EXCAVATION
NO SCALE
STA. 0+00A TO 3+50A

- LEGEND**
- ① UPPER SEDIMENT
 - ② LOWER SEDIMENT
 - EXCAVATION

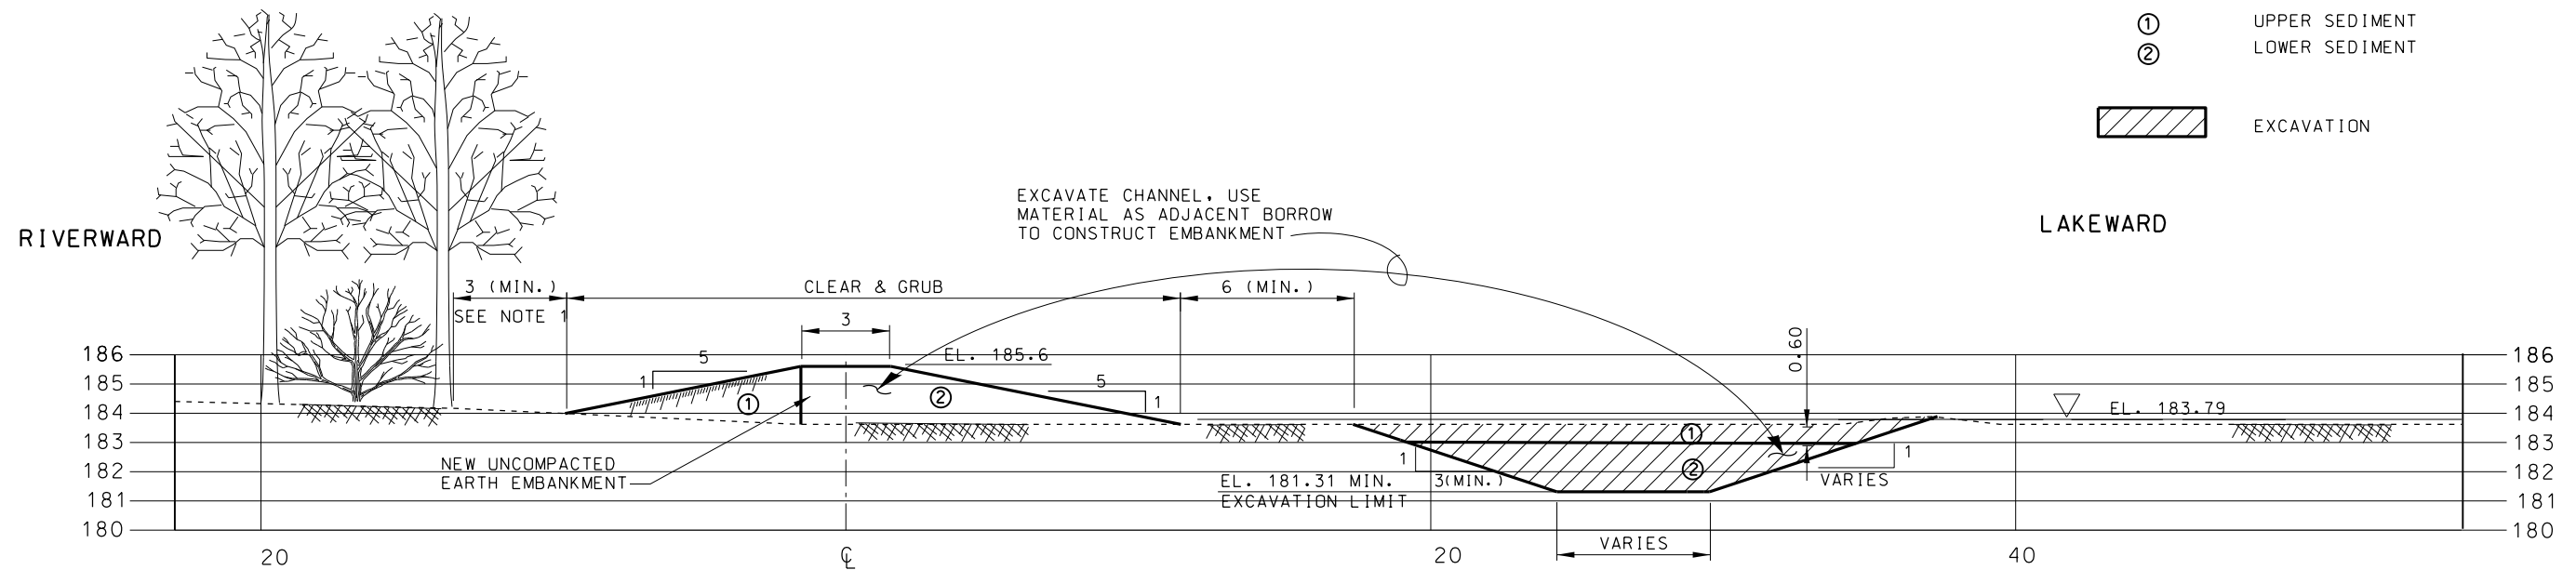

B
C4/C15 TYPICAL SECTION EMBANKMENT EXCAVATION
NO SCALE
ADJACENT TO EXISTING ISLAND

- NOTES:**
- EMBANKMENT CENTERLINE MAY BE ADJUSTED AS NECESSARY TO MAINTAIN MINIMUM DISTANCE FROM TREE LINE. NO DAMAGE MAY BE CAUSED TO ANY TREE LARGER THAN 10 CENTIMETER DIAMETER.

ALL DISTANCES, MEASUREMENTS AND ELEVATIONS SHOWN ARE IN METERS UNLESS NOTED OTHERWISE.

Revisions	Description	Date	Approved
1	AS CONSTRUCTED	27 JUL 04	JRP/REH


Designed By:	RTN	Date:	21 SEP 2002
Drawn By:	SDB	Scale:	AS SHOWN
Checked By:	MJA	Drawing Code:	EP66
Reviewed By:	DJH	Soil Citation Number:	DACW25-02-R-0008

POOL 11 ISLANDS
HABITAT REHABILITATION
& ENHANCEMENT PROJECT
STAGE 1 - SUNFISH LAKE

Sheet
Reference
Number:
C16
Sheet 20 of 25

RIVERWARD

CDF

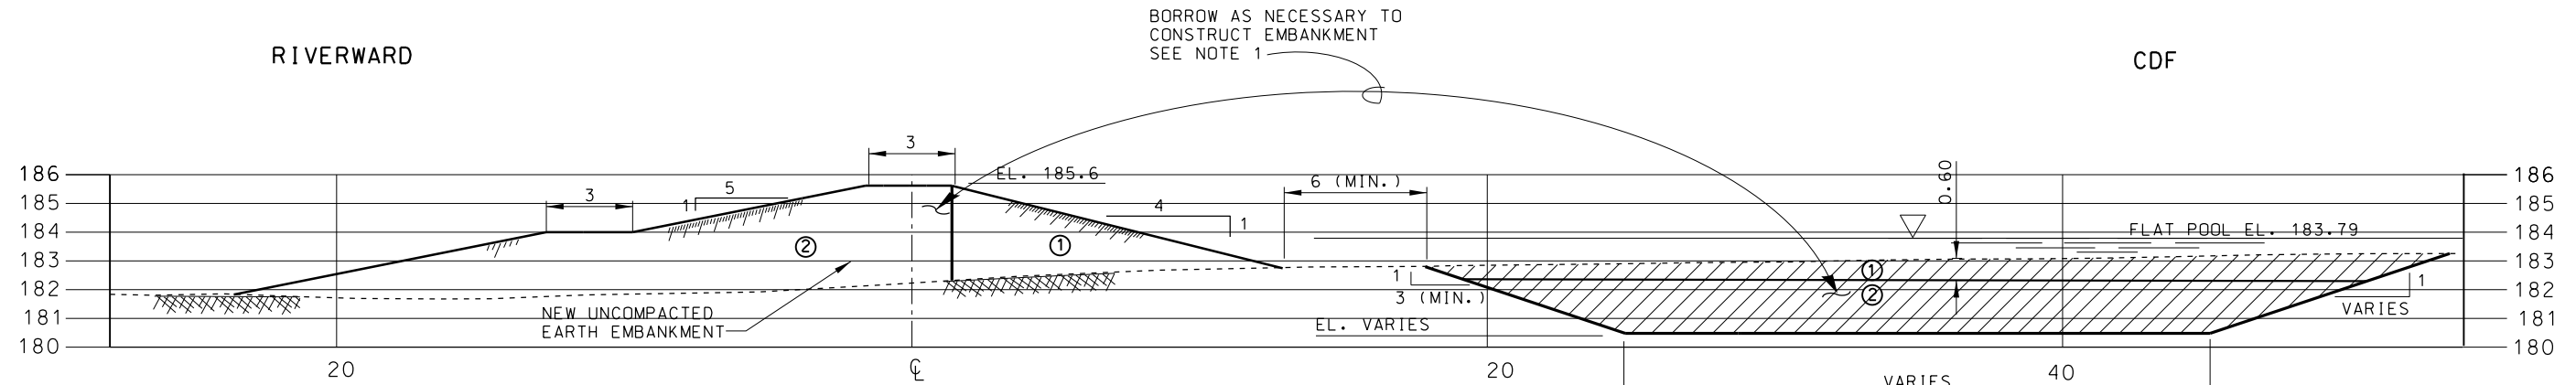


C
C4/C16
TYPICAL SECTION EMBANKMENT AND BORROW
NO SCALE
CDF CELL 1

LEGEND

- ① UPPER SEDIMENT
- ② LOWER SEDIMENT
- EXCAVATION

CDF

LAKEWARD

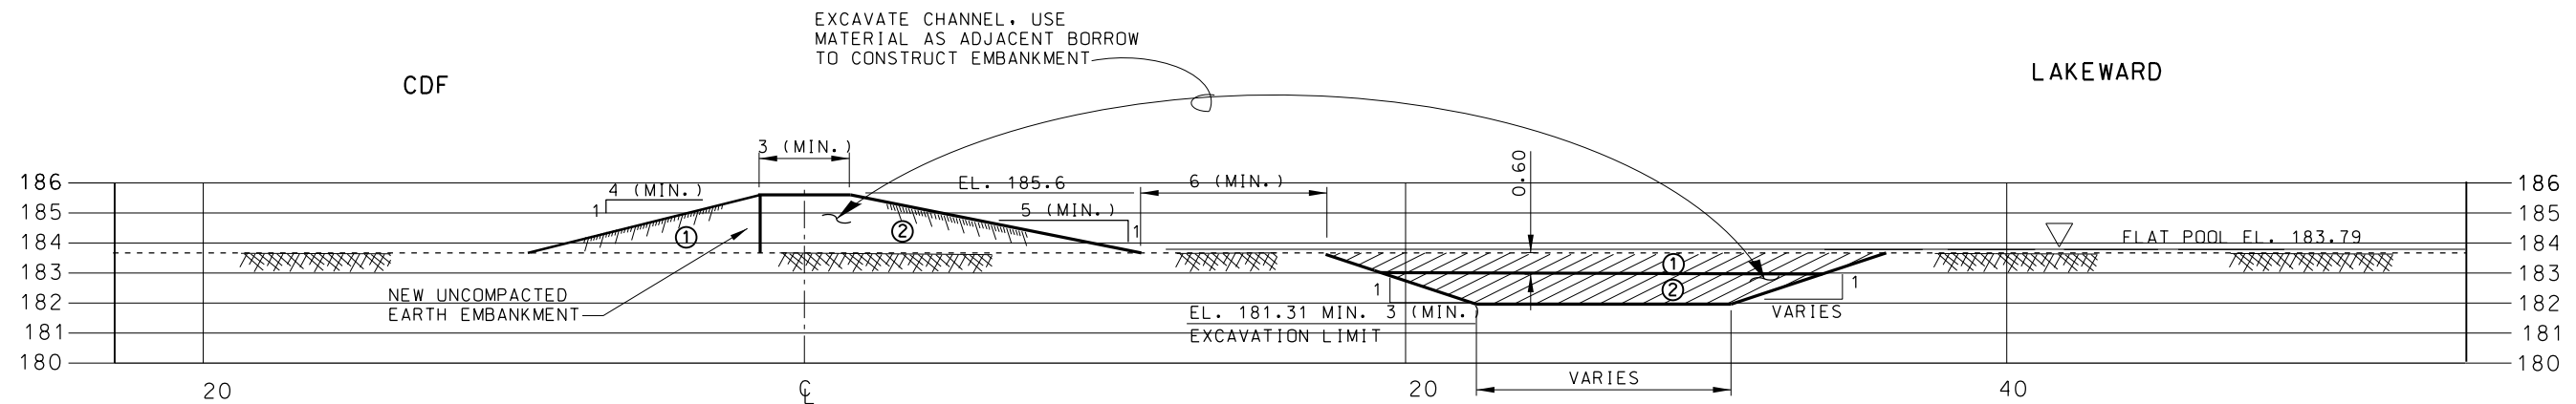

D
C6/C16
TYPICAL SECTION EMBANKMENT AND EXCAVATION
NO SCALE
CDF CELL 1


ALL DISTANCES, MEASUREMENTS AND
ELEVATIONS SHOWN ARE IN METERS
UNLESS NOTED OTHERWISE.

Revisions	Description	Date	Approved
AS CONSTRUCTED		27 JUL 04 JRP/REH	

Designed By:	RTN	Date:	21 SEP 2002
Drawn By:	SDB	Scale:	AS SHOWN
Checked By:	MJA	Drawing Code:	EP66
Reviewed By:	DJH	Soil Citation Number:	DACW25-02-R-0008

POOL 11 ISLANDS
HABITAT REHABILITATION
& ENHANCEMENT PROJECT
STAGE 1 - SUNFISH LAKE


Sheet
Reference
Number:
C17
Sheet 21 of 25

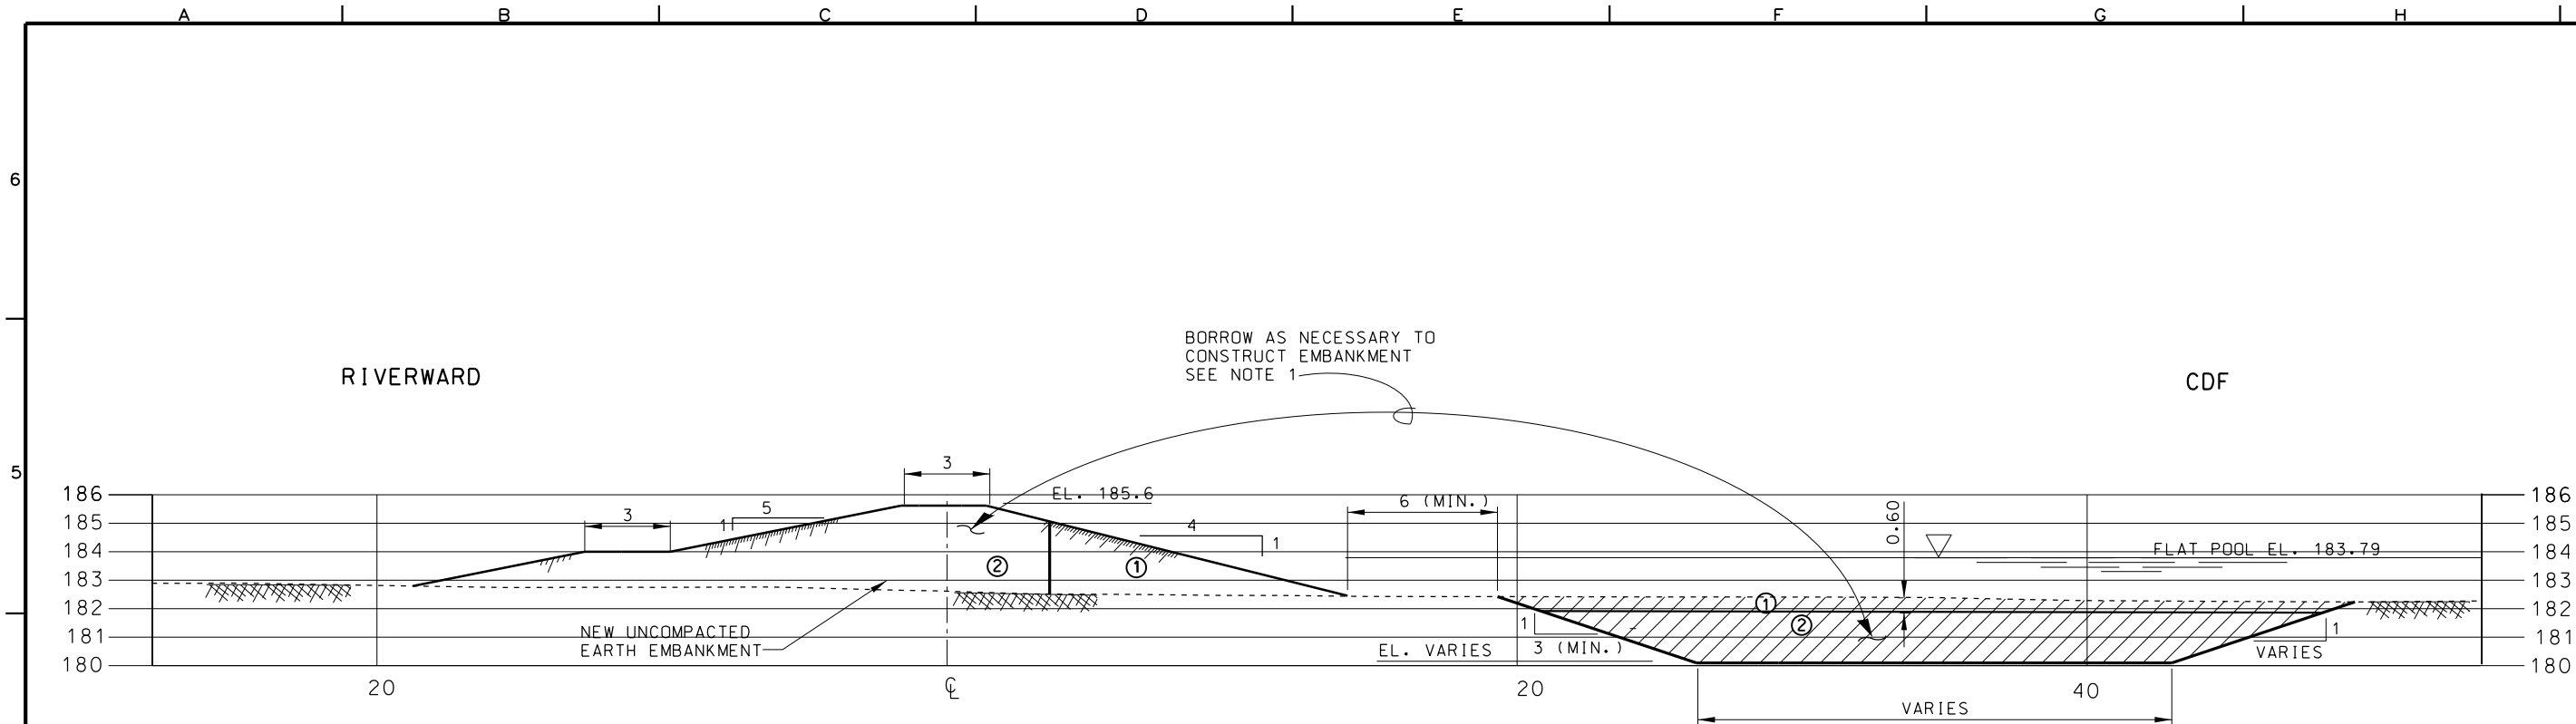

E
C5/C17
TYPICAL SECTION EMBANKMENT AND BORROW
NO SCALE
CDF CELL 2

LEGEND

- ① UPPER SEDIMENT
- ② LOWER SEDIMENT
- EXCAVATION

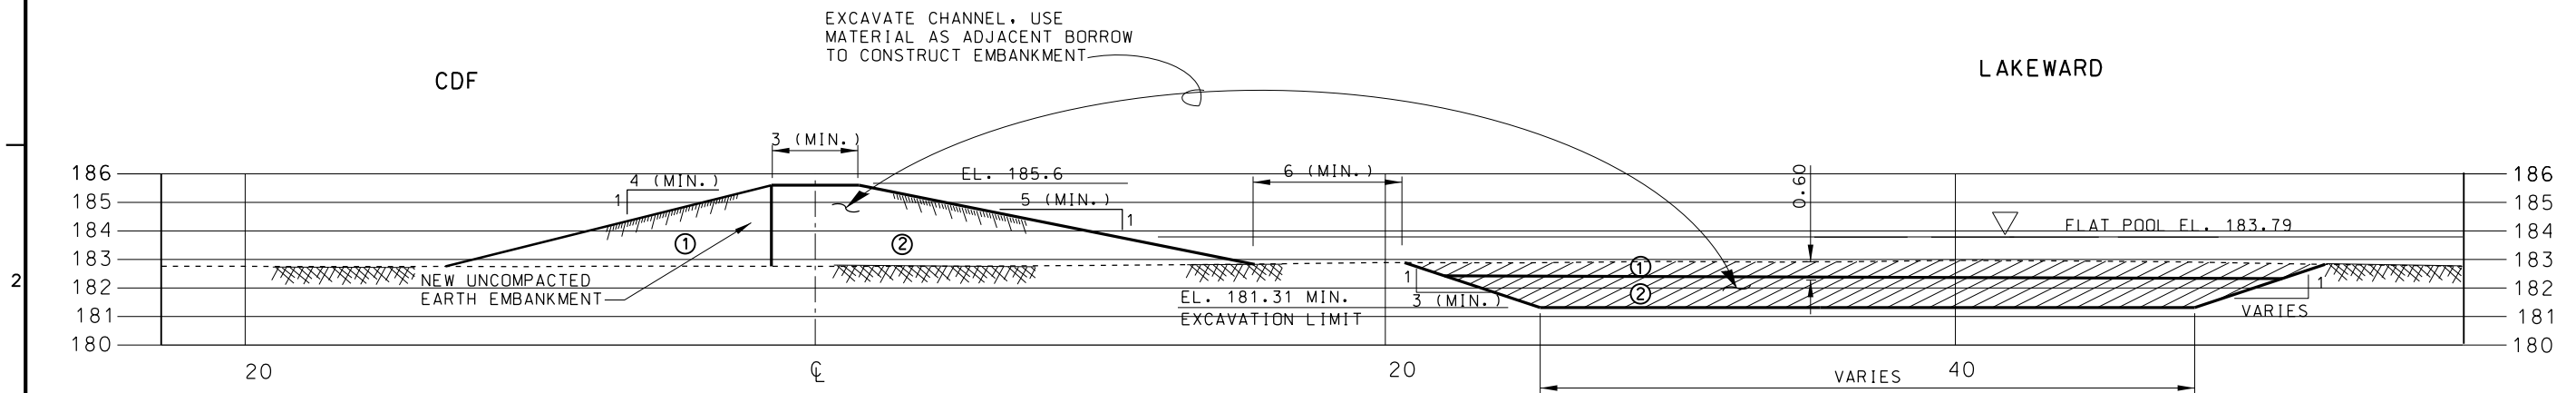

F
C6/C17
TYPICAL SECTION EMBANKMENT AND EXCAVATION
NO SCALE
CDF CELL 2

ALL DISTANCES, MEASUREMENTS AND
ELEVATIONS SHOWN ARE IN METERS
UNLESS NOTED OTHERWISE.


Symbol	Description	Revisions
△	REVISED AS CONSTRUCTED	
MOD.	- EXCAVATION CHANNEL CHANGE	
27JUL04JRP/REH	Date	Approved

U.S. ARMY ENGINEER DISTRICT CORPS OF ENGINEERS ROCK ISLAND, ILLINOIS	Designed By: RTN Drawn By: SDB Checked By: MJA Reviewed By: DJH	Date: 21 SEP. 2002 Scale: AS SHOWN Drawing Code: EP66 Solicitation Number: DACW25-02-R-0008
--	--	--

POOL 11 ISLANDS
HABITAT REHABILITATION
& ENHANCEMENT PROJECT
STAGE 1 - SUNFISH LAKE

TYPICAL SECTIONS IV


Sheet
Reference
Number:
C18
Sheet 22 of 25

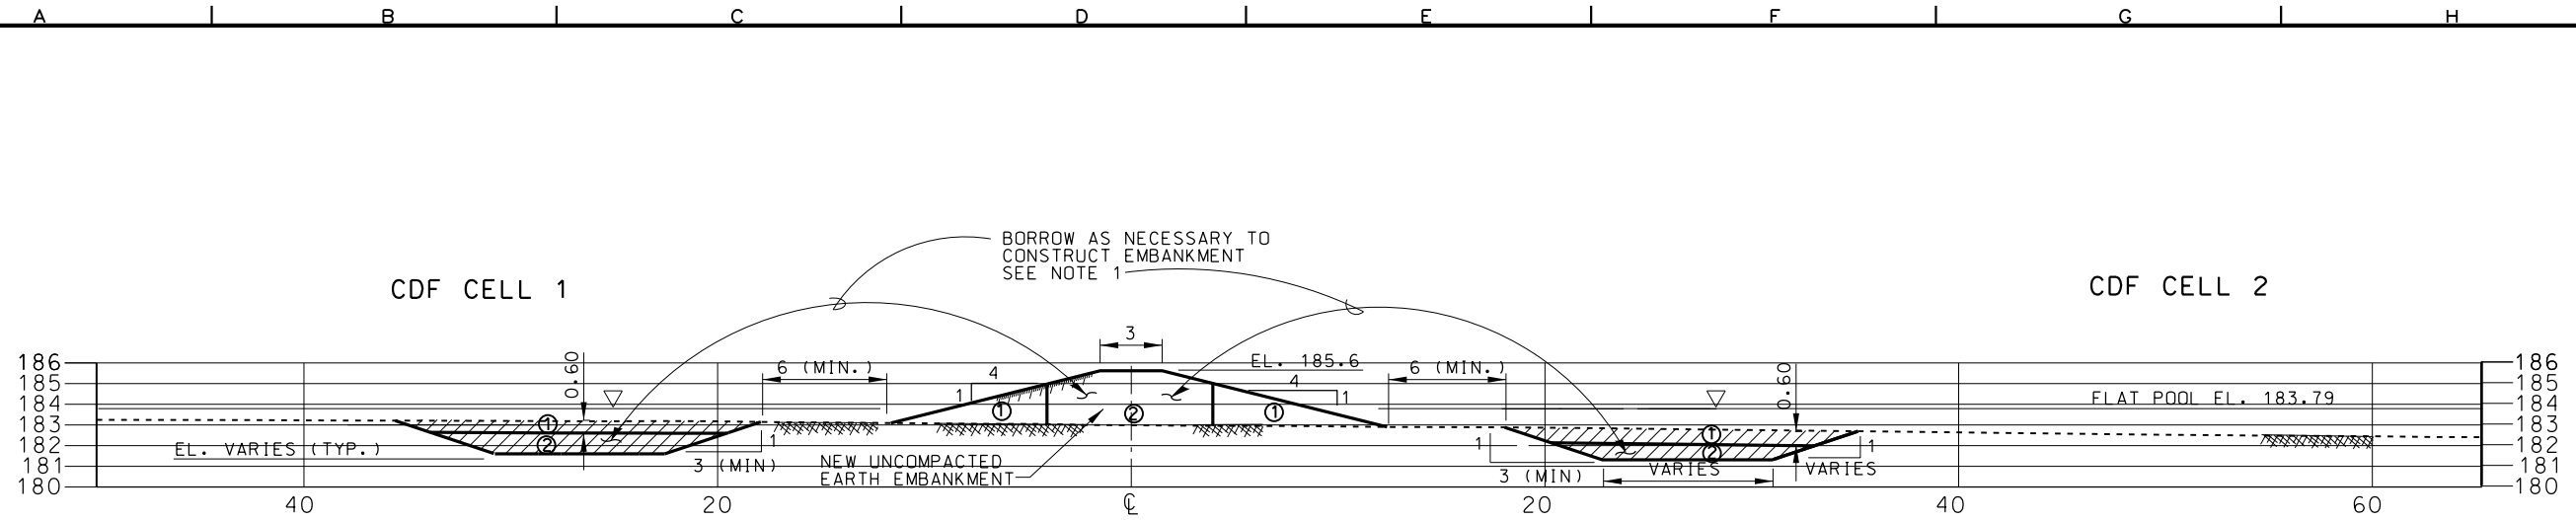

G
C7/C18 NO SCALE
TYPICAL SECTION EMBANKMENT AND BORROW
BETWEEN CDF CELLS

LEGEND


- ① UPPER SEDIMENT
- ② LOWER SEDIMENT
- EXCAVATION

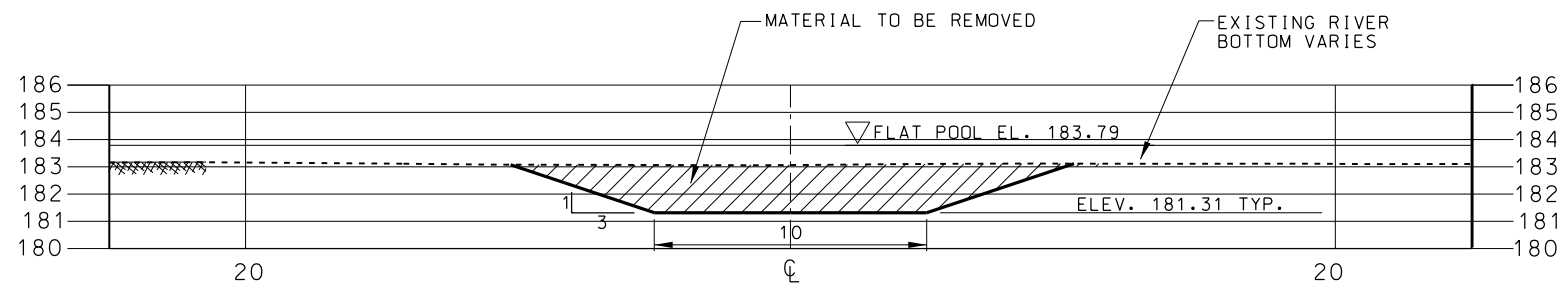



H
C9/C18 NO SCALE
CHANNEL EXCAVATION TYPICAL SECTION

NOTE:
SECTION H WAS MODIFIED PER VALUE ENGINEERING PROPOSAL,
CONTRACT MODIFICATION #A0005 DATED AUGUST 8, 2003.

ALL DISTANCES, MEASUREMENTS AND
ELEVATIONS SHOWN ARE IN METERS
UNLESS NOTED OTHERWISE.

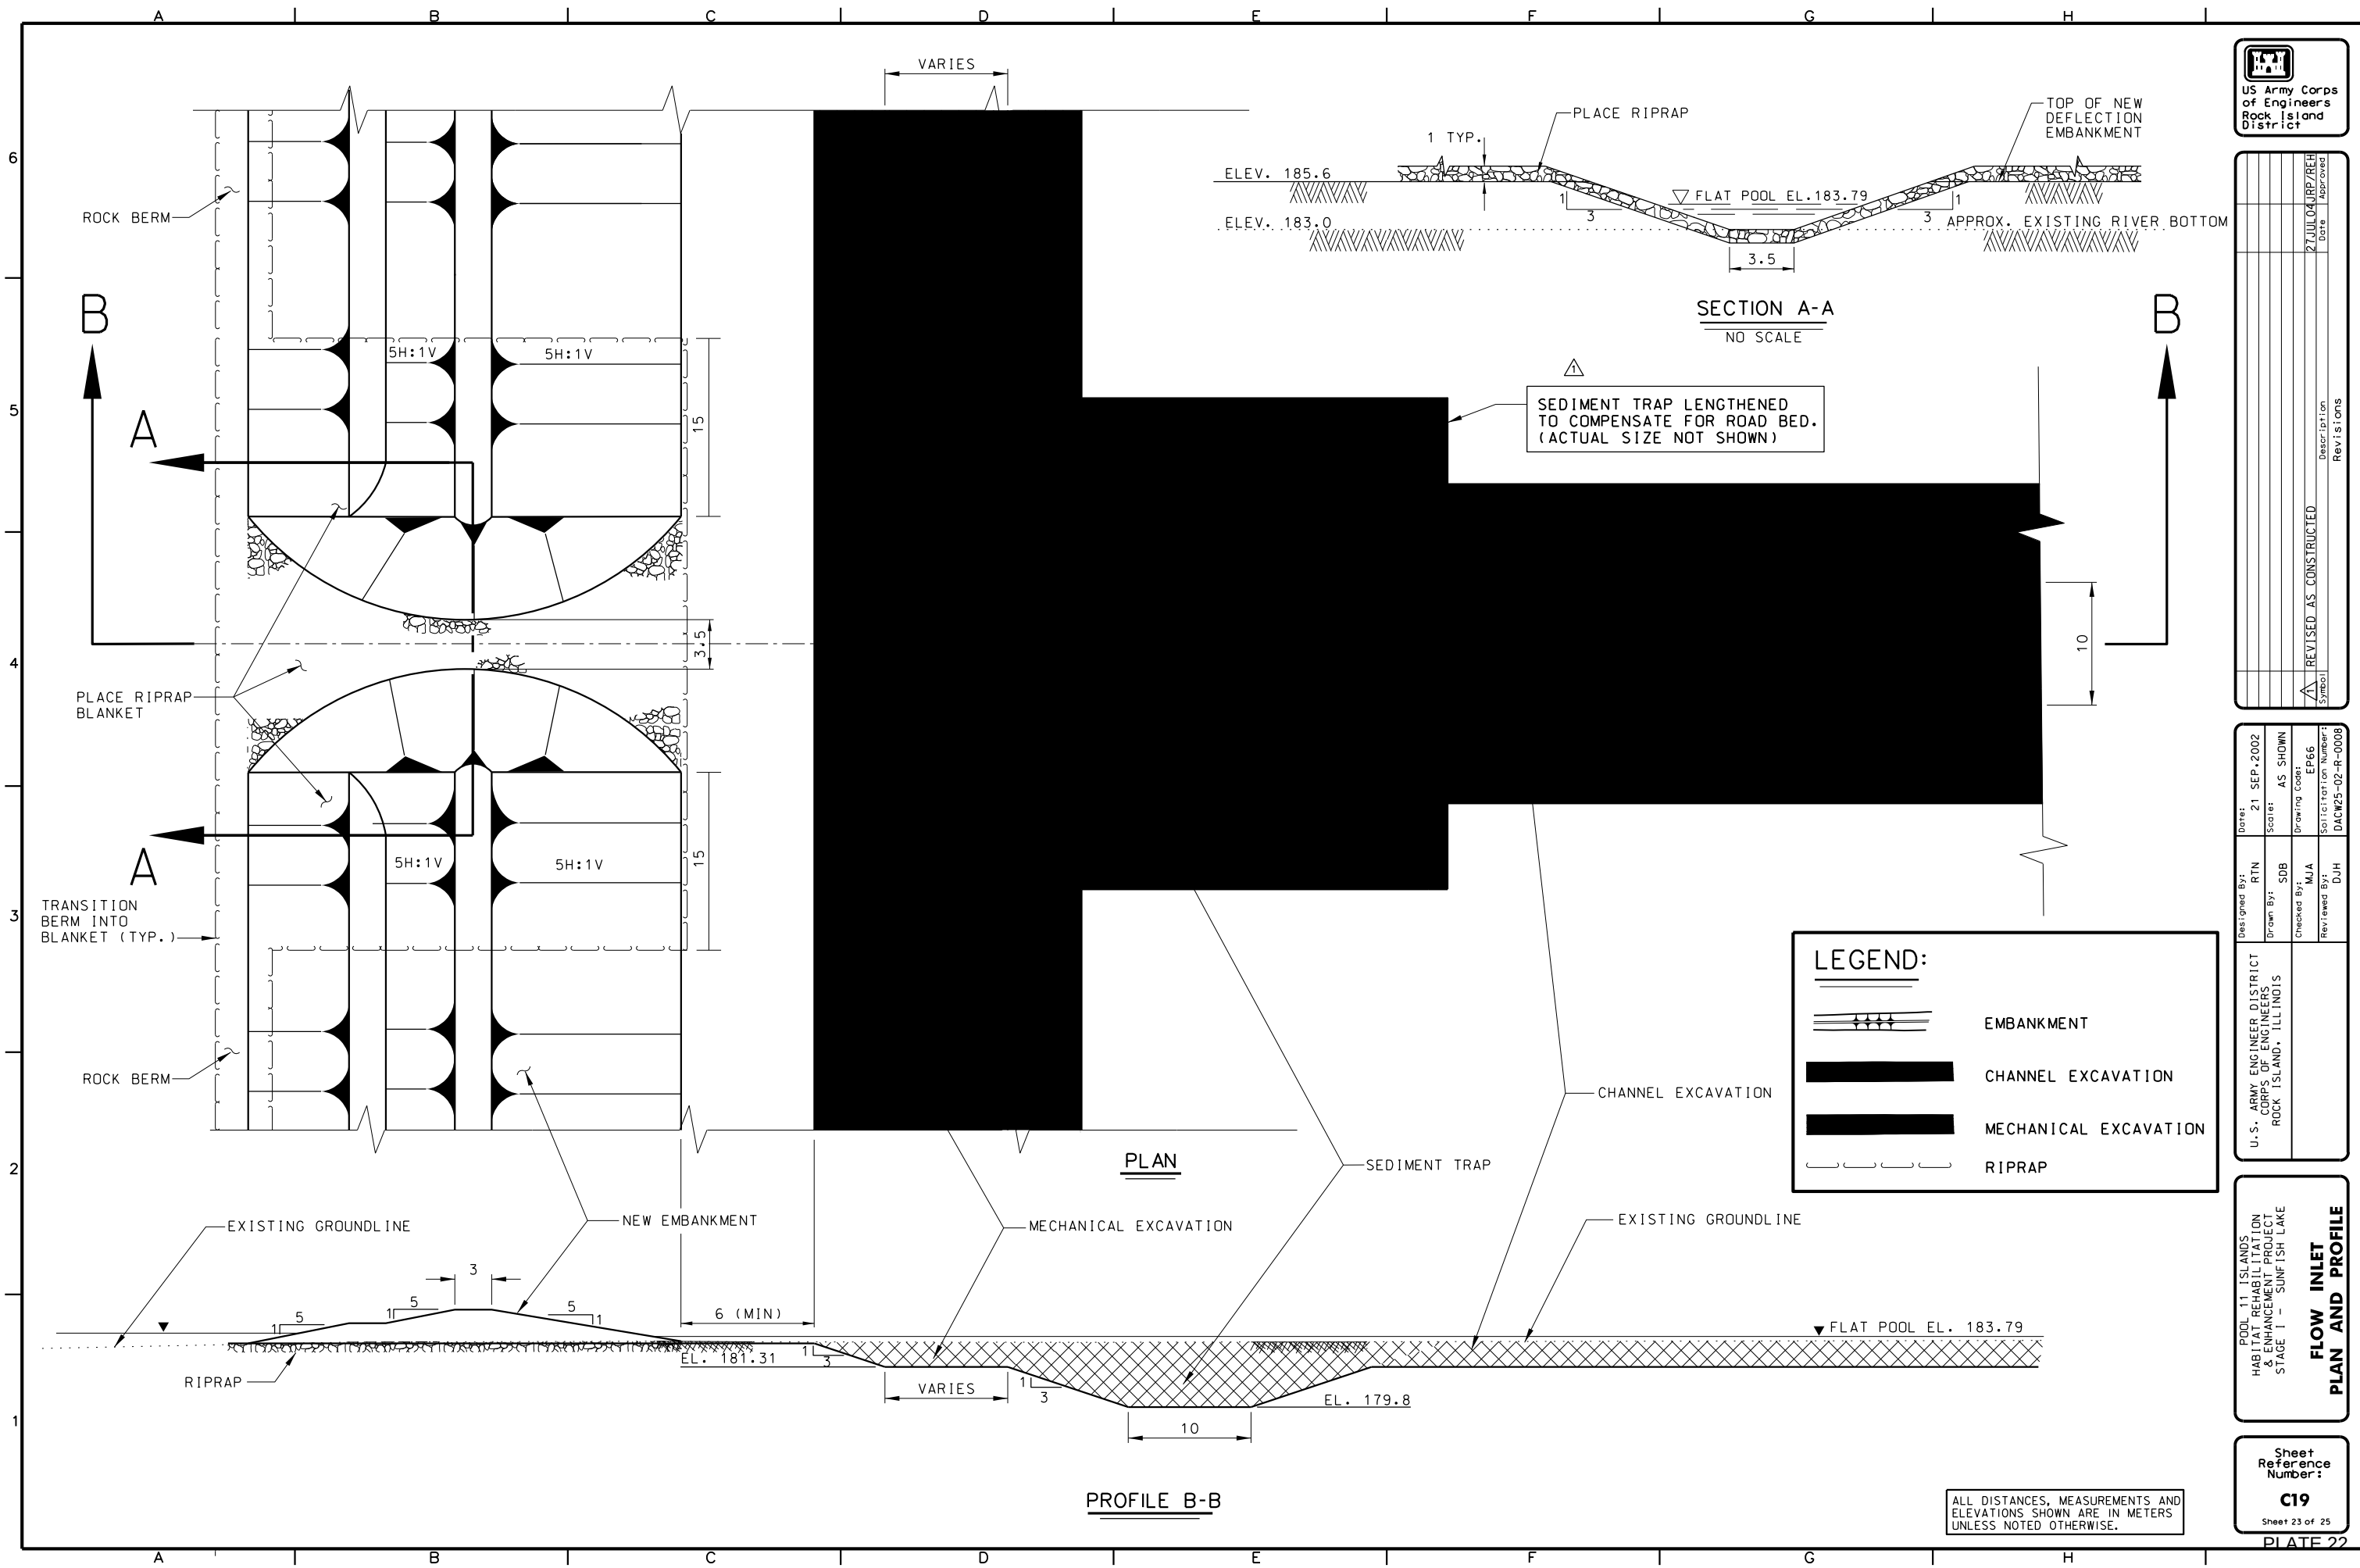

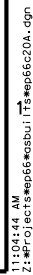

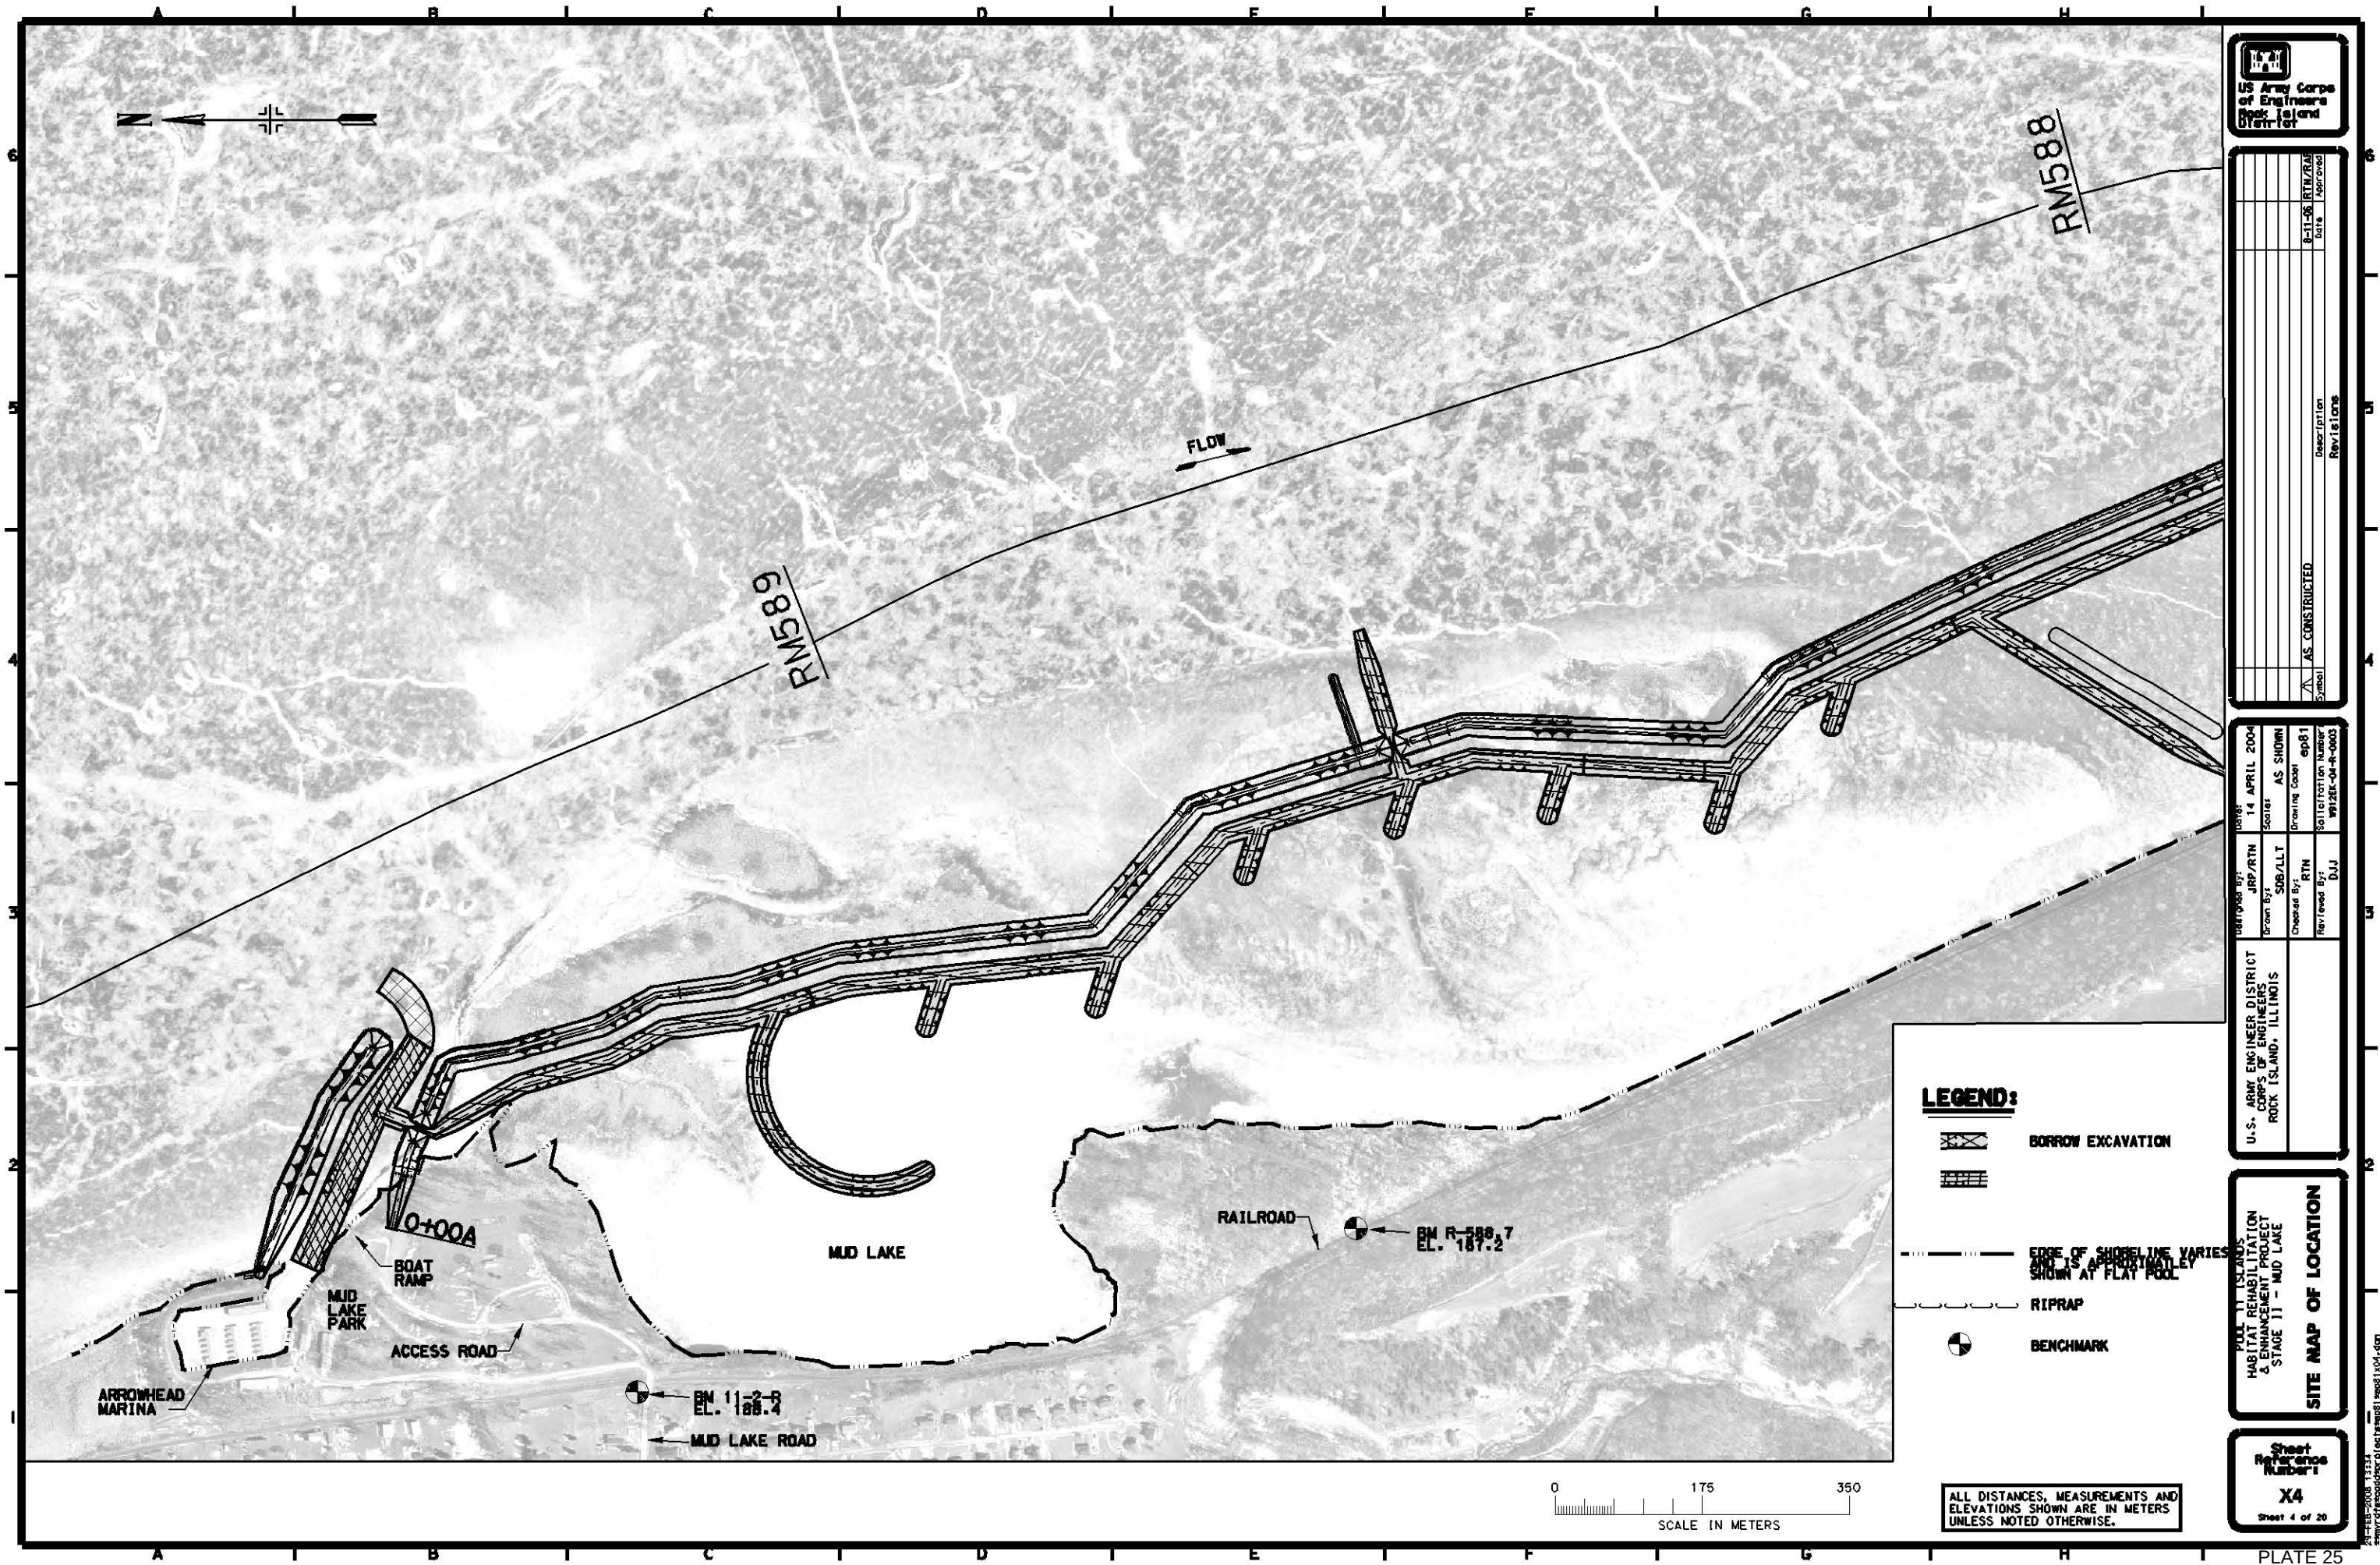

LEGEND:

- BORROW EXCAVATION
- RIPRAP
- EDGE OF SHORELINE VARIES AND IS APPROXIMATELY SHOWN AT FLAT POOL
- BENCHMARK

ALL DISTANCES, MEASUREMENTS AND ELEVATIONS SHOWN ARE IN METERS UNLESS NOTED OTHERWISE.

US Army Corps of Engineers
District 11
Rock Island, IL

Revision	Date	Description
1	8-11-06	RTN/RAE
2		Approved
3		
4		
U.S. ARMY ENGINEER DISTRICT CORPS OF ENGINEERS ROCK ISLAND, ILLINOIS	DATE: 14 APRIL 2004	BY: JRP/RTN	AS SHOWN	ep8.1
	Drawn By: SDB/LLT	Checkered By: RTN	Drawing Code: ep8.1	
	Reviewed By: DJJ	Revision Number: 001		

SITE MAP OF LOCATION

POOL 11 ISLANDS
HABITAT REHABILITATION
& ENHANCEMENT PROJECT
STAGE 11 - MUD LAKE

Sheet Reference

X4


Sheet 4 of 20

CONSTRUCTION FEATURES


THE FOLLOWING PROVIDES A BRIEF DESCRIPTION OF THE MAJOR PROJECT FEATURES. IT IS NOT NECESSARILY A CONSTRUCTION SEQUENCE.




FEATURE: DEFLECTION EMBANKMENT A
CONSTRUCT DEFLECTION EMBANKMENT USING ADJACENT BORROW FROM RIVER BED.

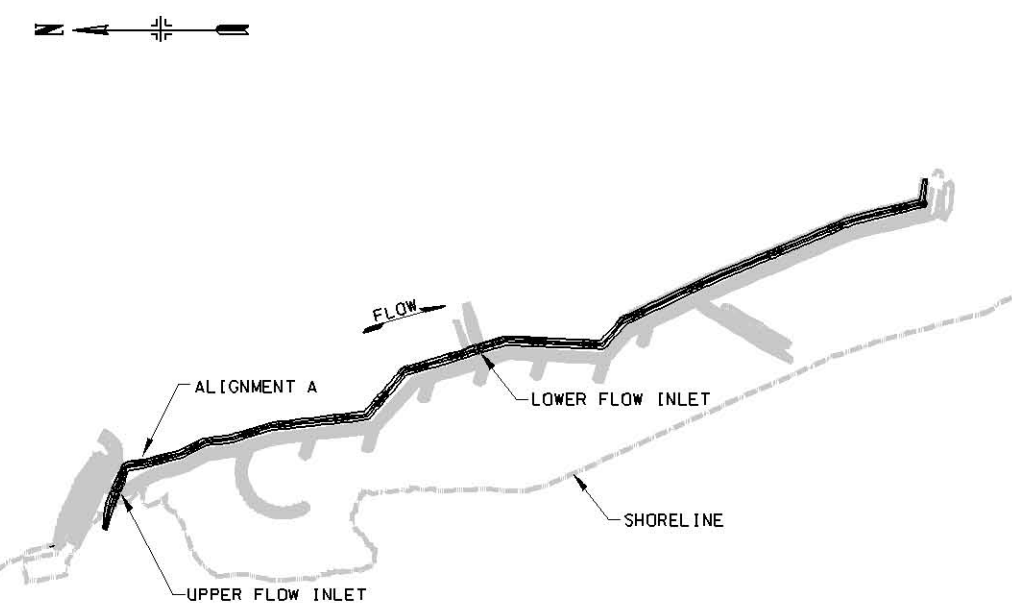

FEATURE: DEFLECTION EMBANKMENT B

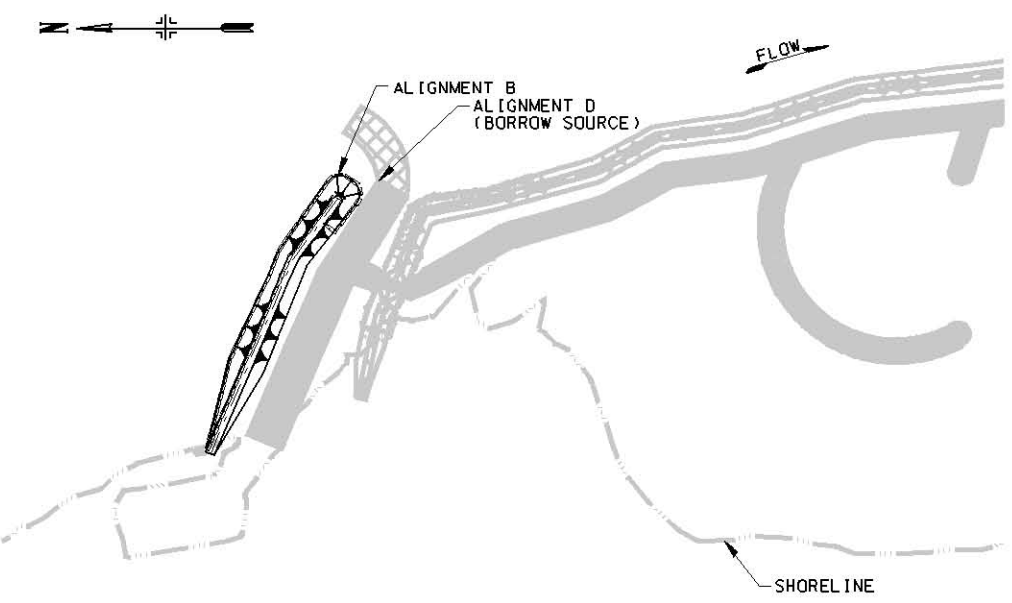


FEATURE: DEEP WATER FISH HABITAT
(ALIGNMENTS C, E-M) CONSTRUCT A SYSTEM OF DEEP-WATER CHANNELS FOR FISH HABITAT.

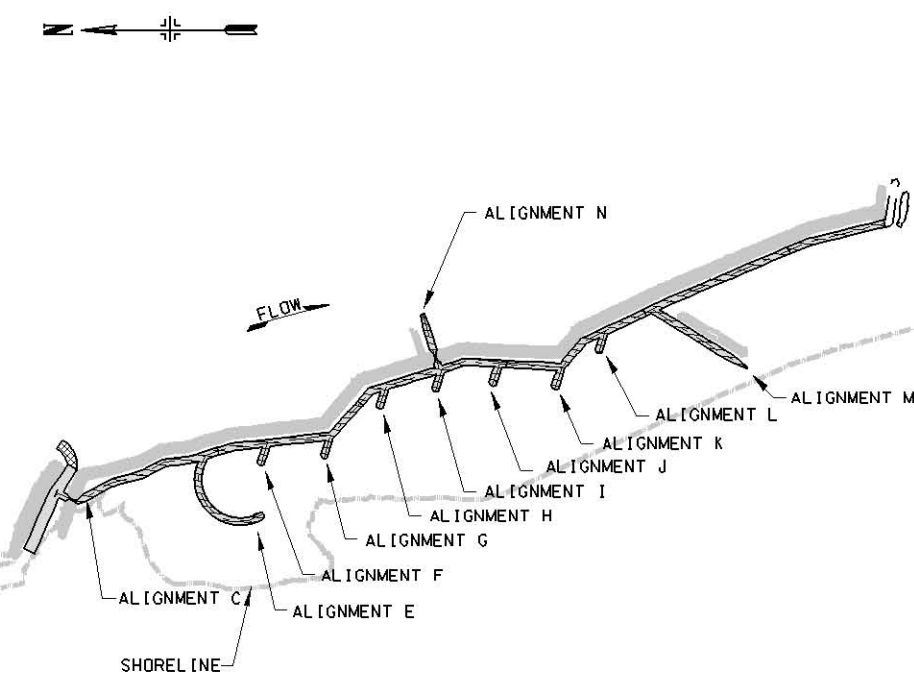


THE EXCAVATED CHANNELS WILL PROVIDE APPROXIMATELY 8.8 HECTARES OF FISH HABITAT, AS WELL AS A MATERIAL SOURCE FOR CONSTRUCTION OF EMBANKMENT (ALIGNMENT A).

FEATURE: UPPER FLOW INLET
CONSTRUCT A FLOW INLET IN THE DEFLECTION EMBANKMENT TO ALLOW NOMINAL FLOW THROUGH THE NEWLY EXCAVATED CHANNELS. PLACE RIPRAP TO PROTECT THE INLET FROM EROSION. FLOW INLET DETAILS MAY BE FOUND ON SHEET C13.

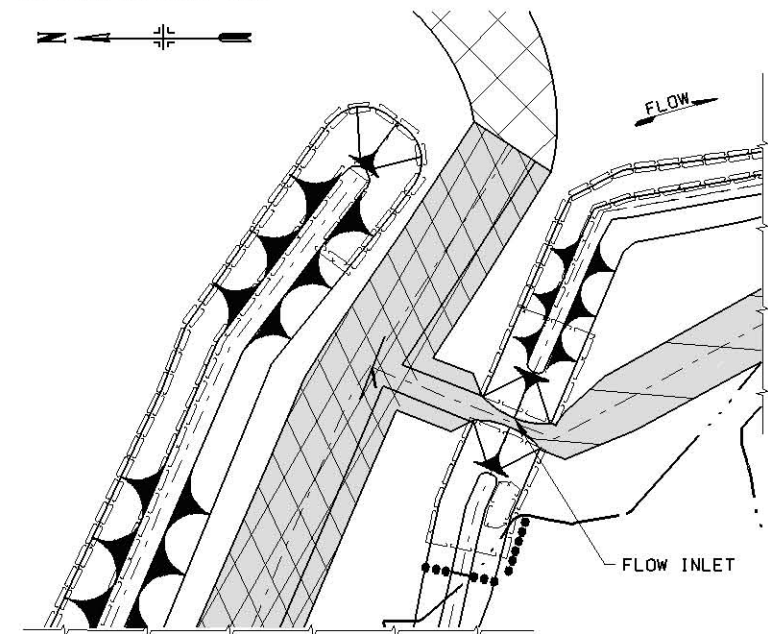

FEATURE: LOWER FLOW INLET
CONSTRUCT A FLOW INLET IN THE DEFLECTION EMBANKMENT TO ALLOW NOMINAL FLOW THROUGH THE NEWLY EXCAVATED CHANNELS. PLACE RIPRAP TO PROTECT THE INLET FROM EROSION. FLOW INLET DETAILS MAY BE FOUND ON SHEET C13.

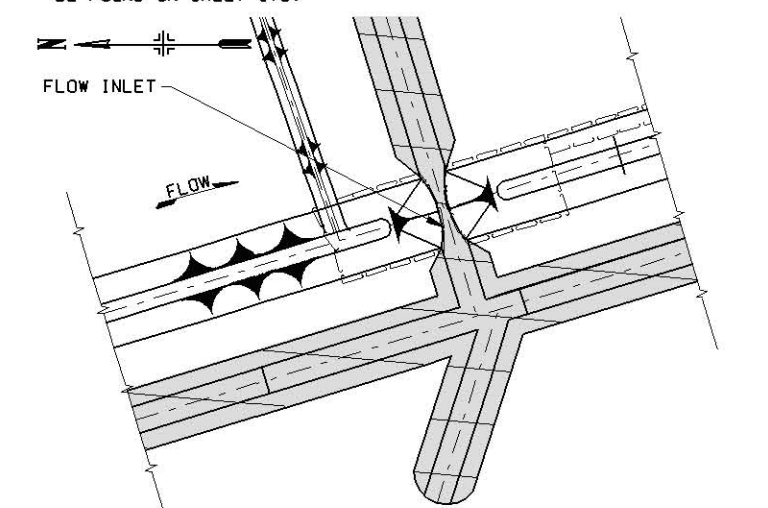


ALL DISTANCES, MEASUREMENTS AND ELEVATIONS SHOWN ARE IN METERS UNLESS NOTED OTHERWISE.

Revision	Date	By	Check	Appr
1	8-11-06	RTN	RTN	RTN
2				
3				
4				
5				
6				

U.S. ARMY ENGINEER DISTRICT CORPS OF ENGINEERS ROCK ISLAND, ILLINOIS	Designed By: JRP/RTN Drawn By: SDB/LLT Checked By: RTN Reviewed By: DJJ	Date: 14 APRIL 2004 Scale: AS SHOWN Drawing Code: ep81 Revision Number: W812EK-04-R-0003
--	--	---

POOL 11 ISLANDS
HABITAT REHABILITATION
& ENHANCEMENT PROJECT
STAGE 11 - MUD LAKE
CONSTRUCTION FEATURES

Sheet
Reference
Number:
X5
Sheet 5 of 20

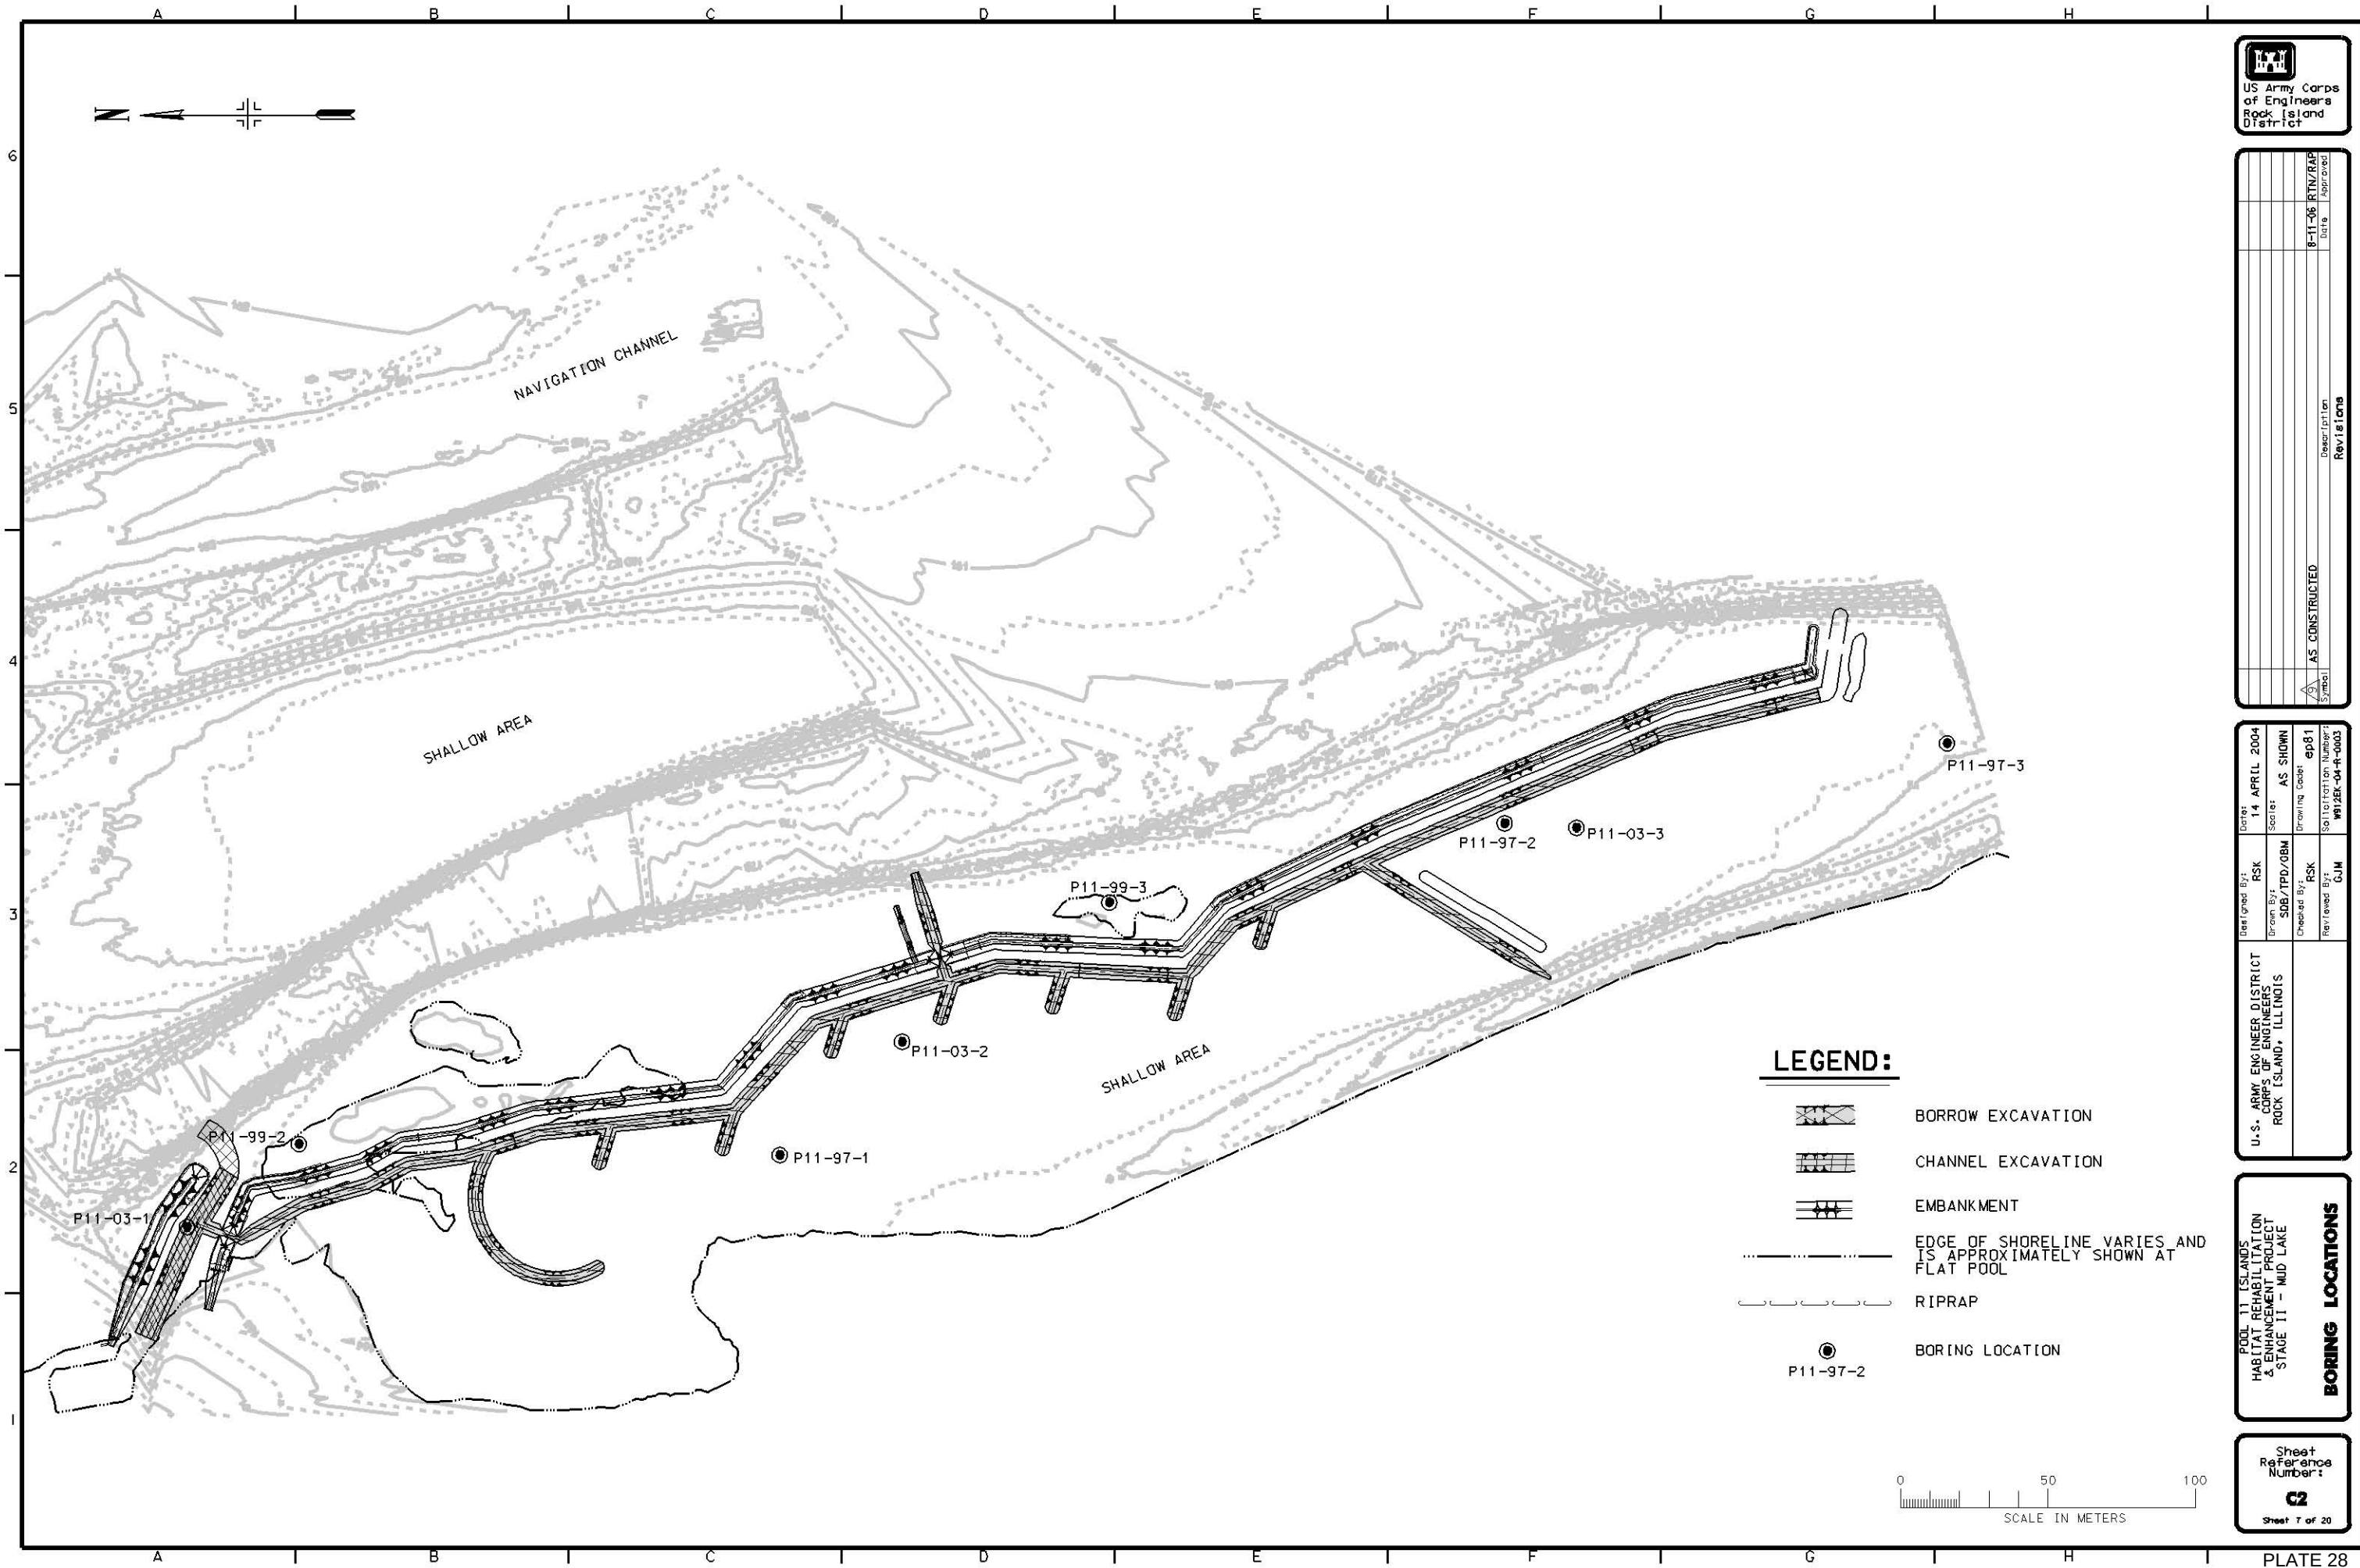

US Army Corps
of Engineers
Rock Island
District


Symbol	Description	Revision
AS CONSTRUCTED	AS CONSTRUCTED	8-11-06 RTN/RAP
		Date
		Approved


U.S. ARMY ENGINEER DISTRICT CORPS OF ENGINEERS ROCK ISLAND, ILLINOIS	Designed By: RSK Drawn By: SDB/TPD/OBM Checked By: RSK Reviewed By: GJM	Date: 14 APRIL 2004 Scale: AS SHOWN Drawing Code: ep81 Revision Number: W912EX-04-R-0003
--	--	---


POOL 11 ISLANDS
HABITAT REHABILITATION
& ENHANCEMENT PROJECT
STAGE 11 - MUD LAKE



BORING LOCATIONS

Sheet
Reference
Number:
62
Sheet 7 of 20

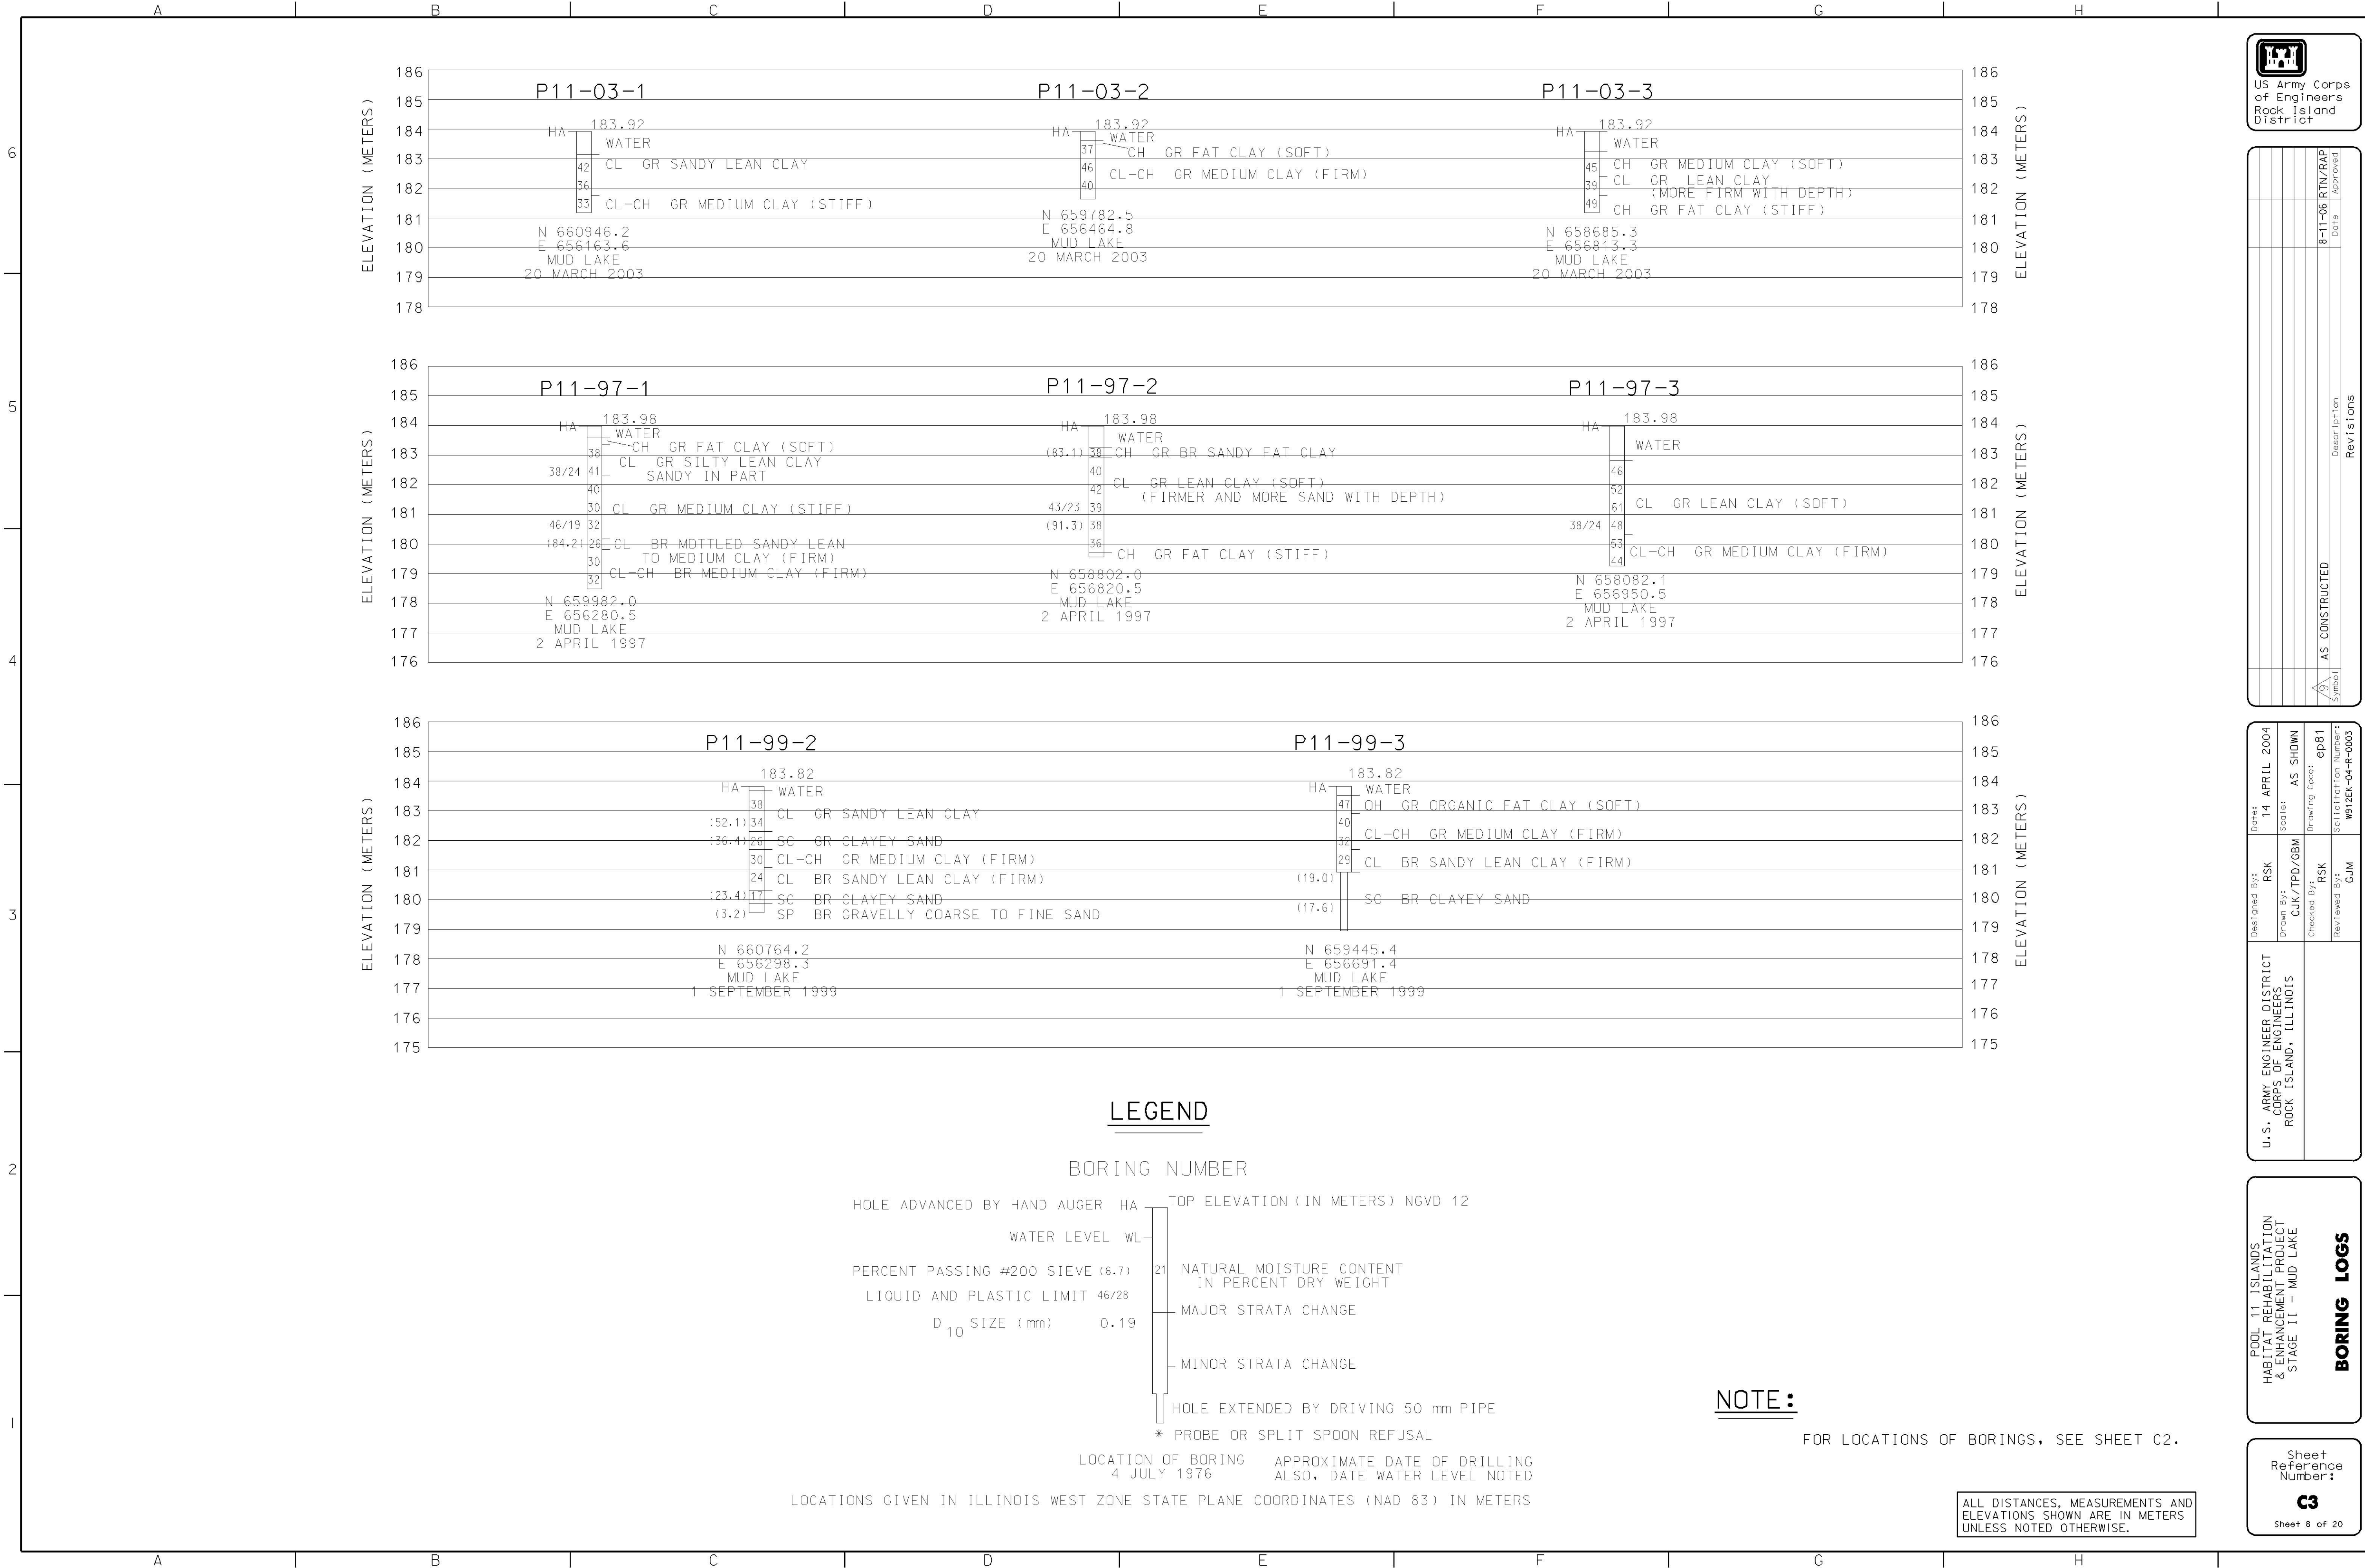


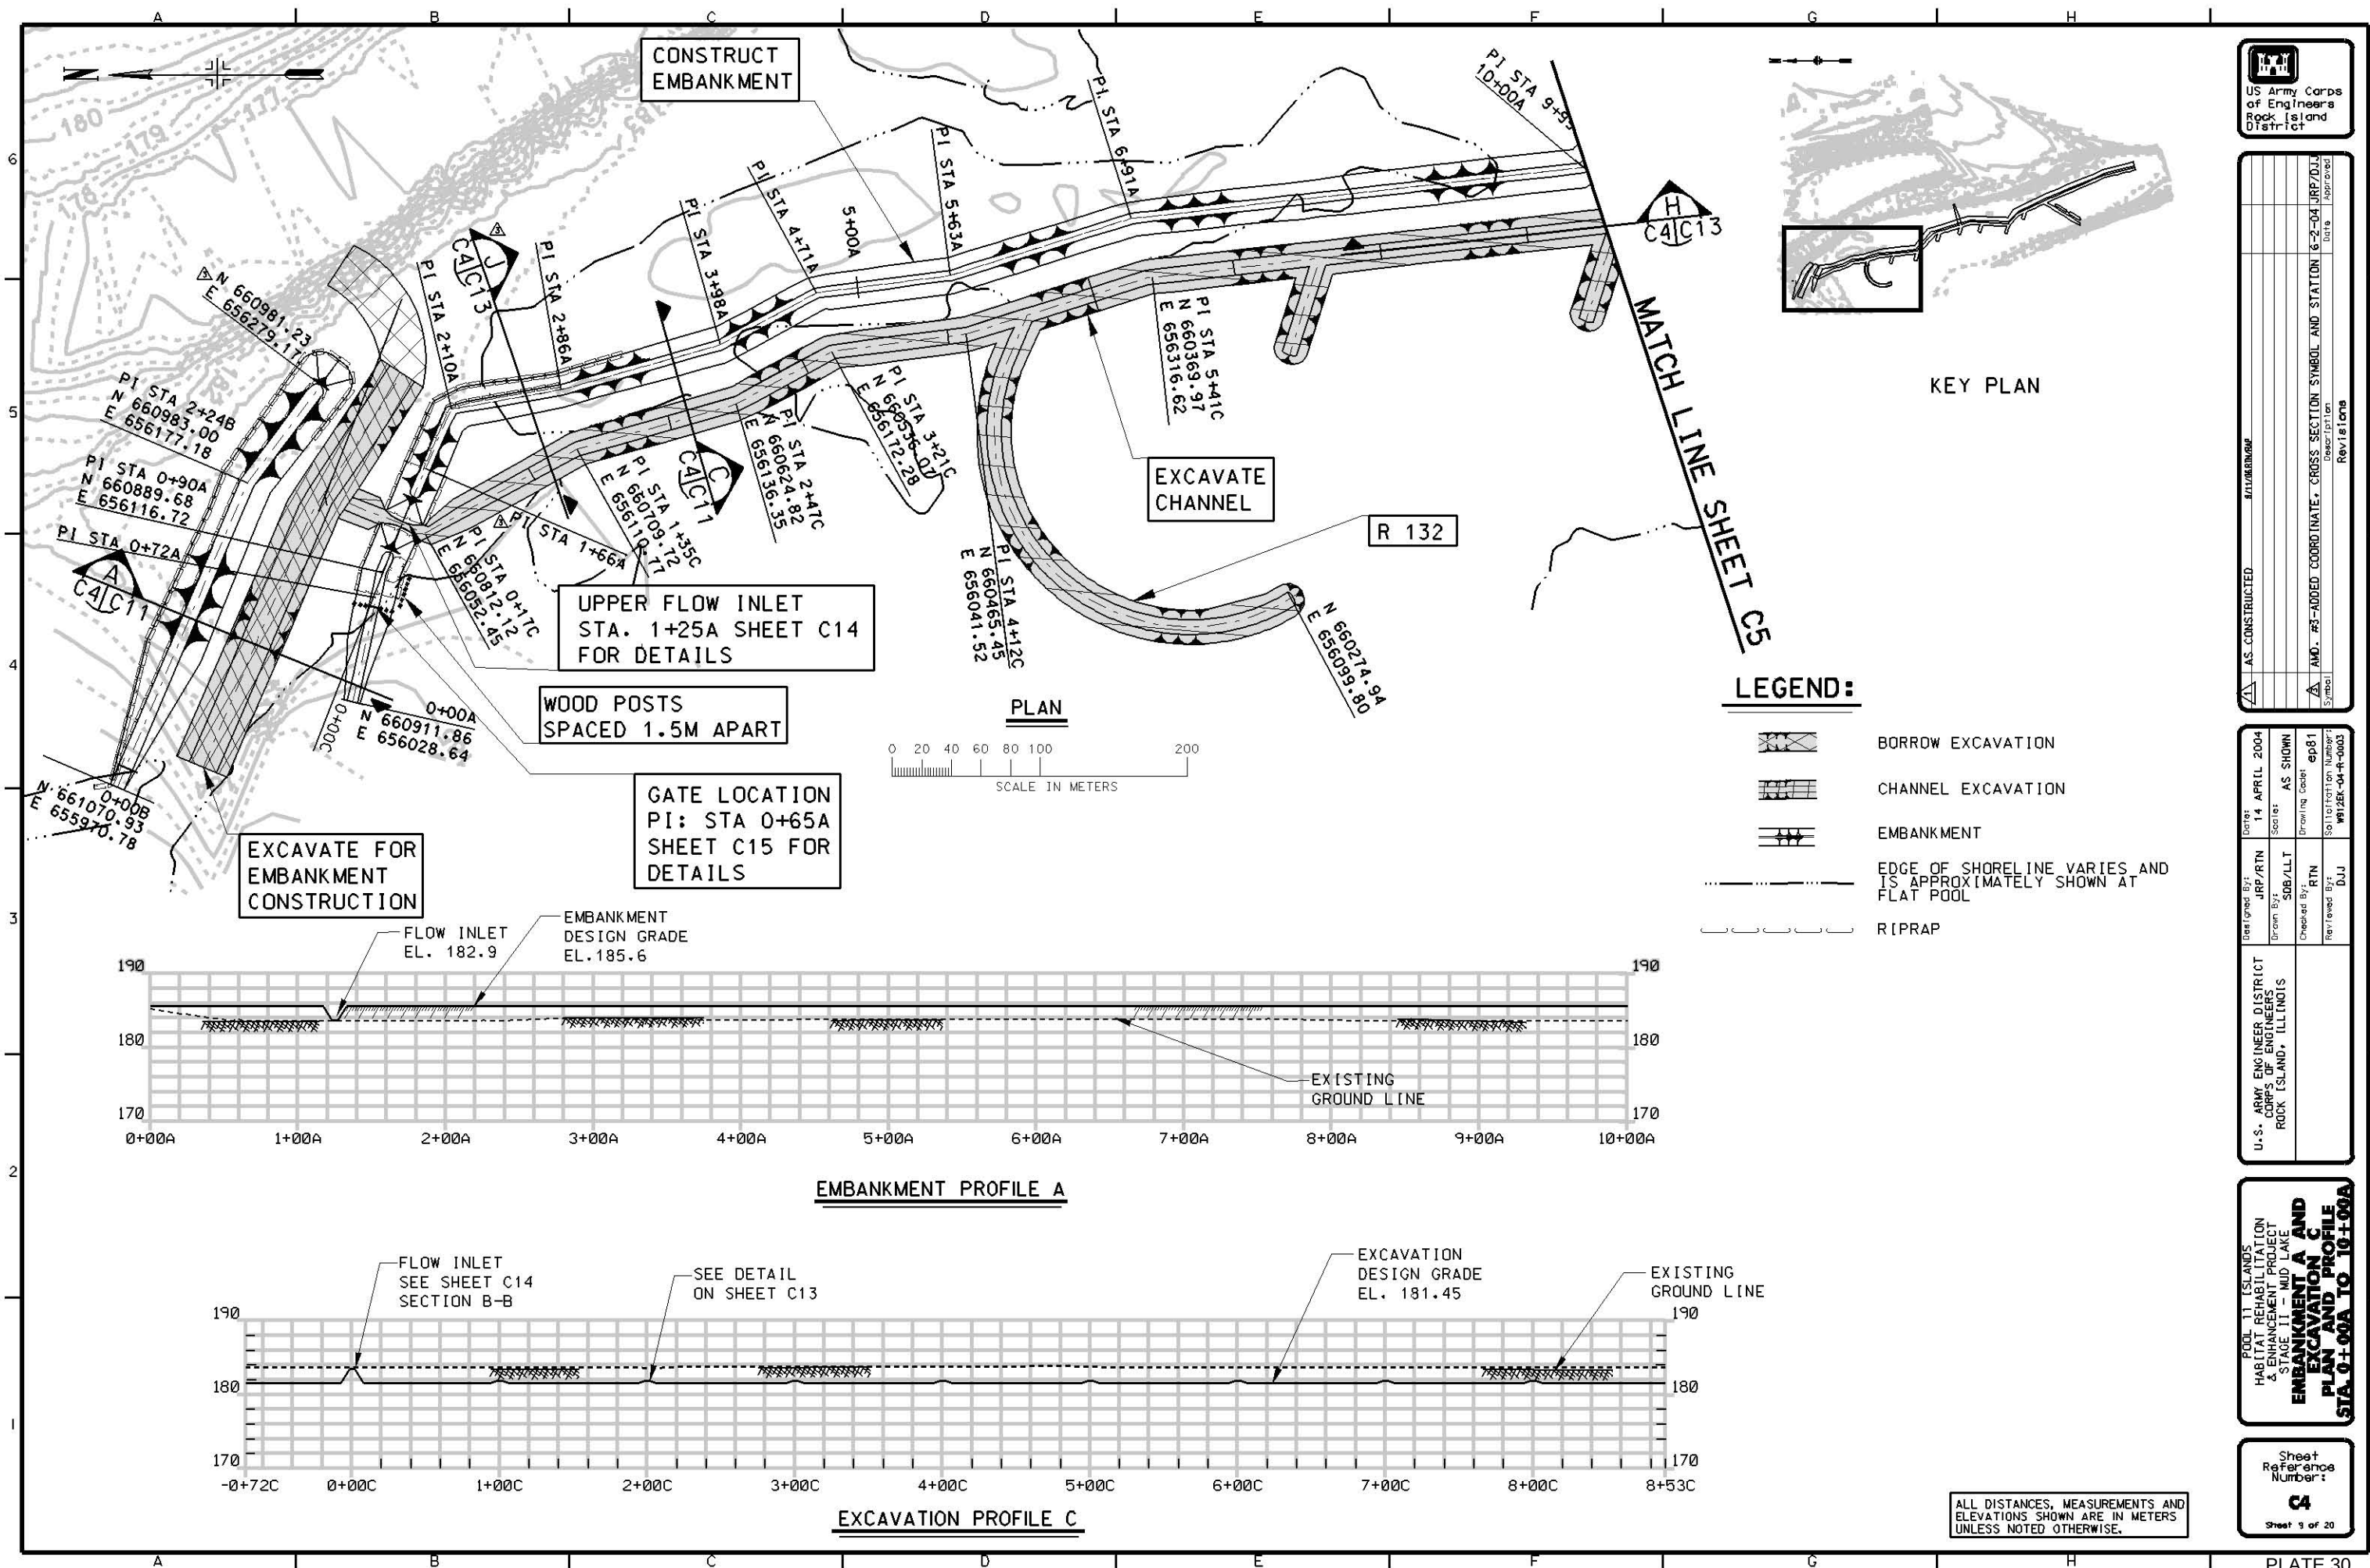

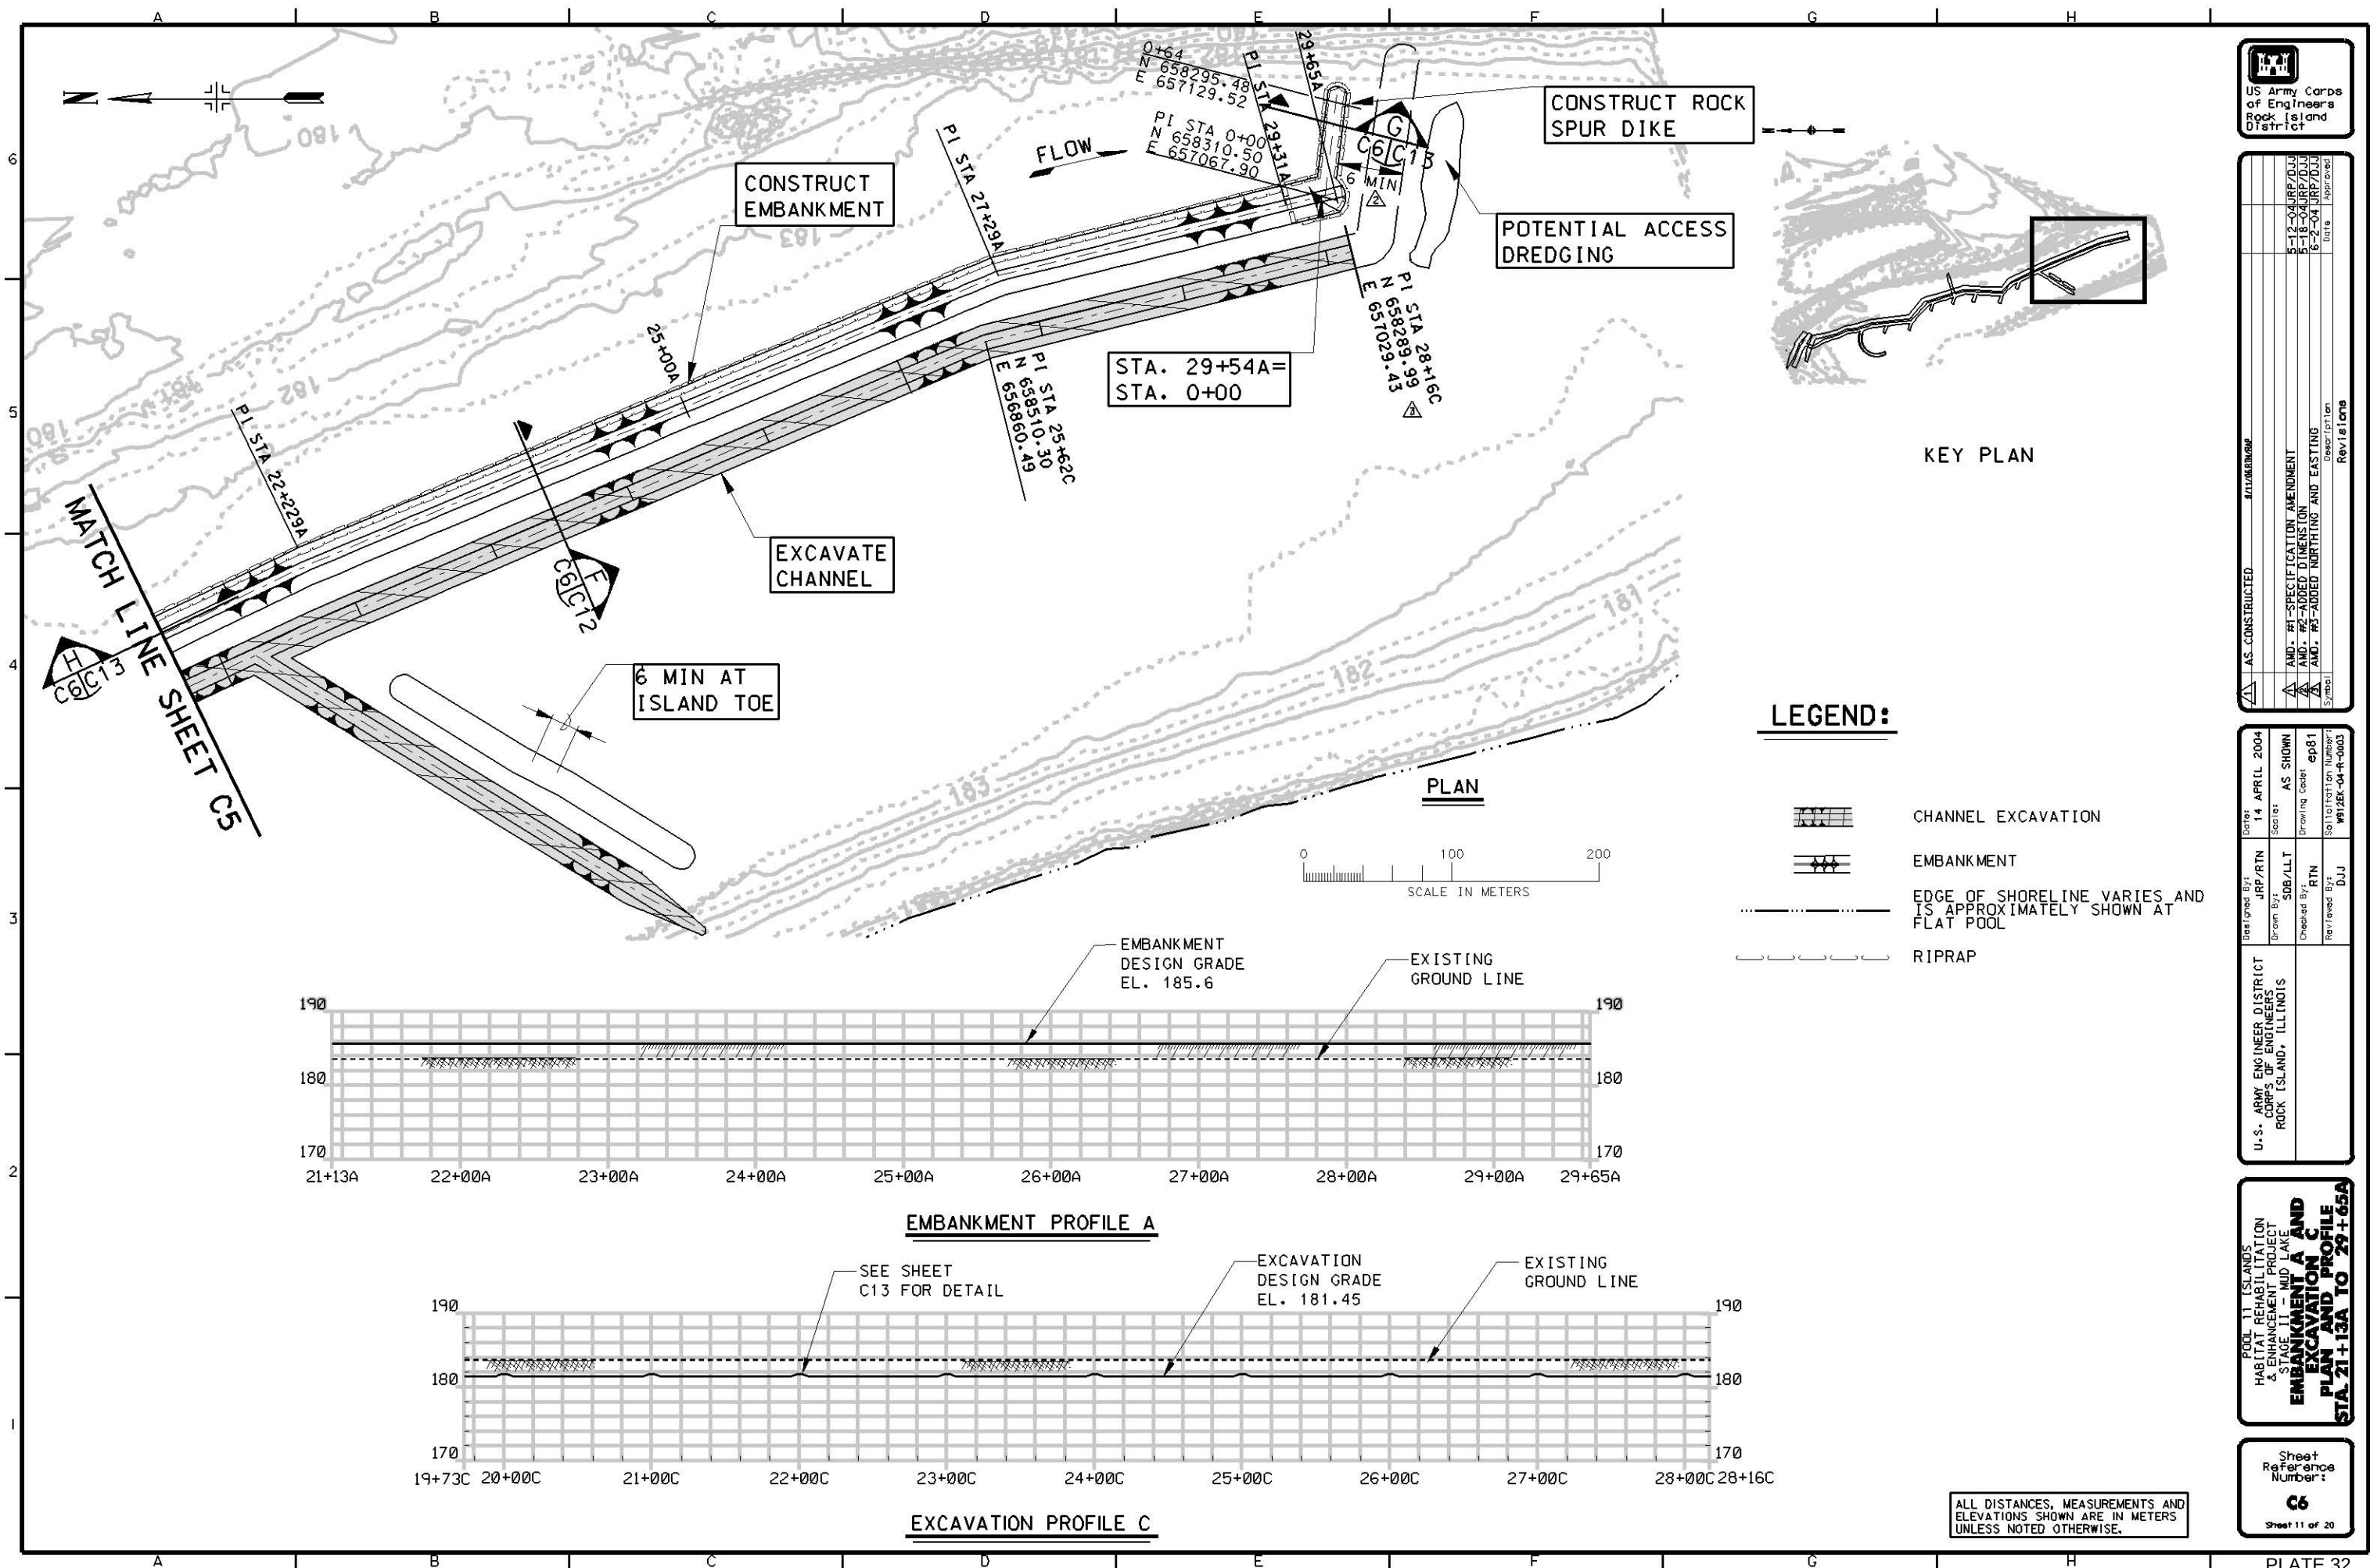

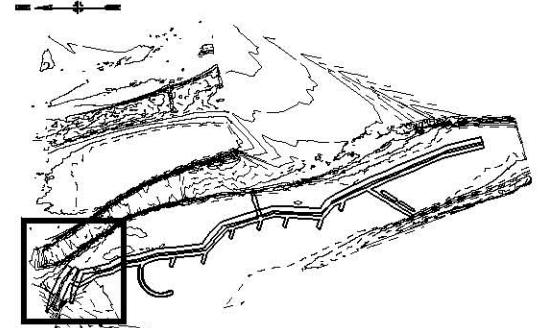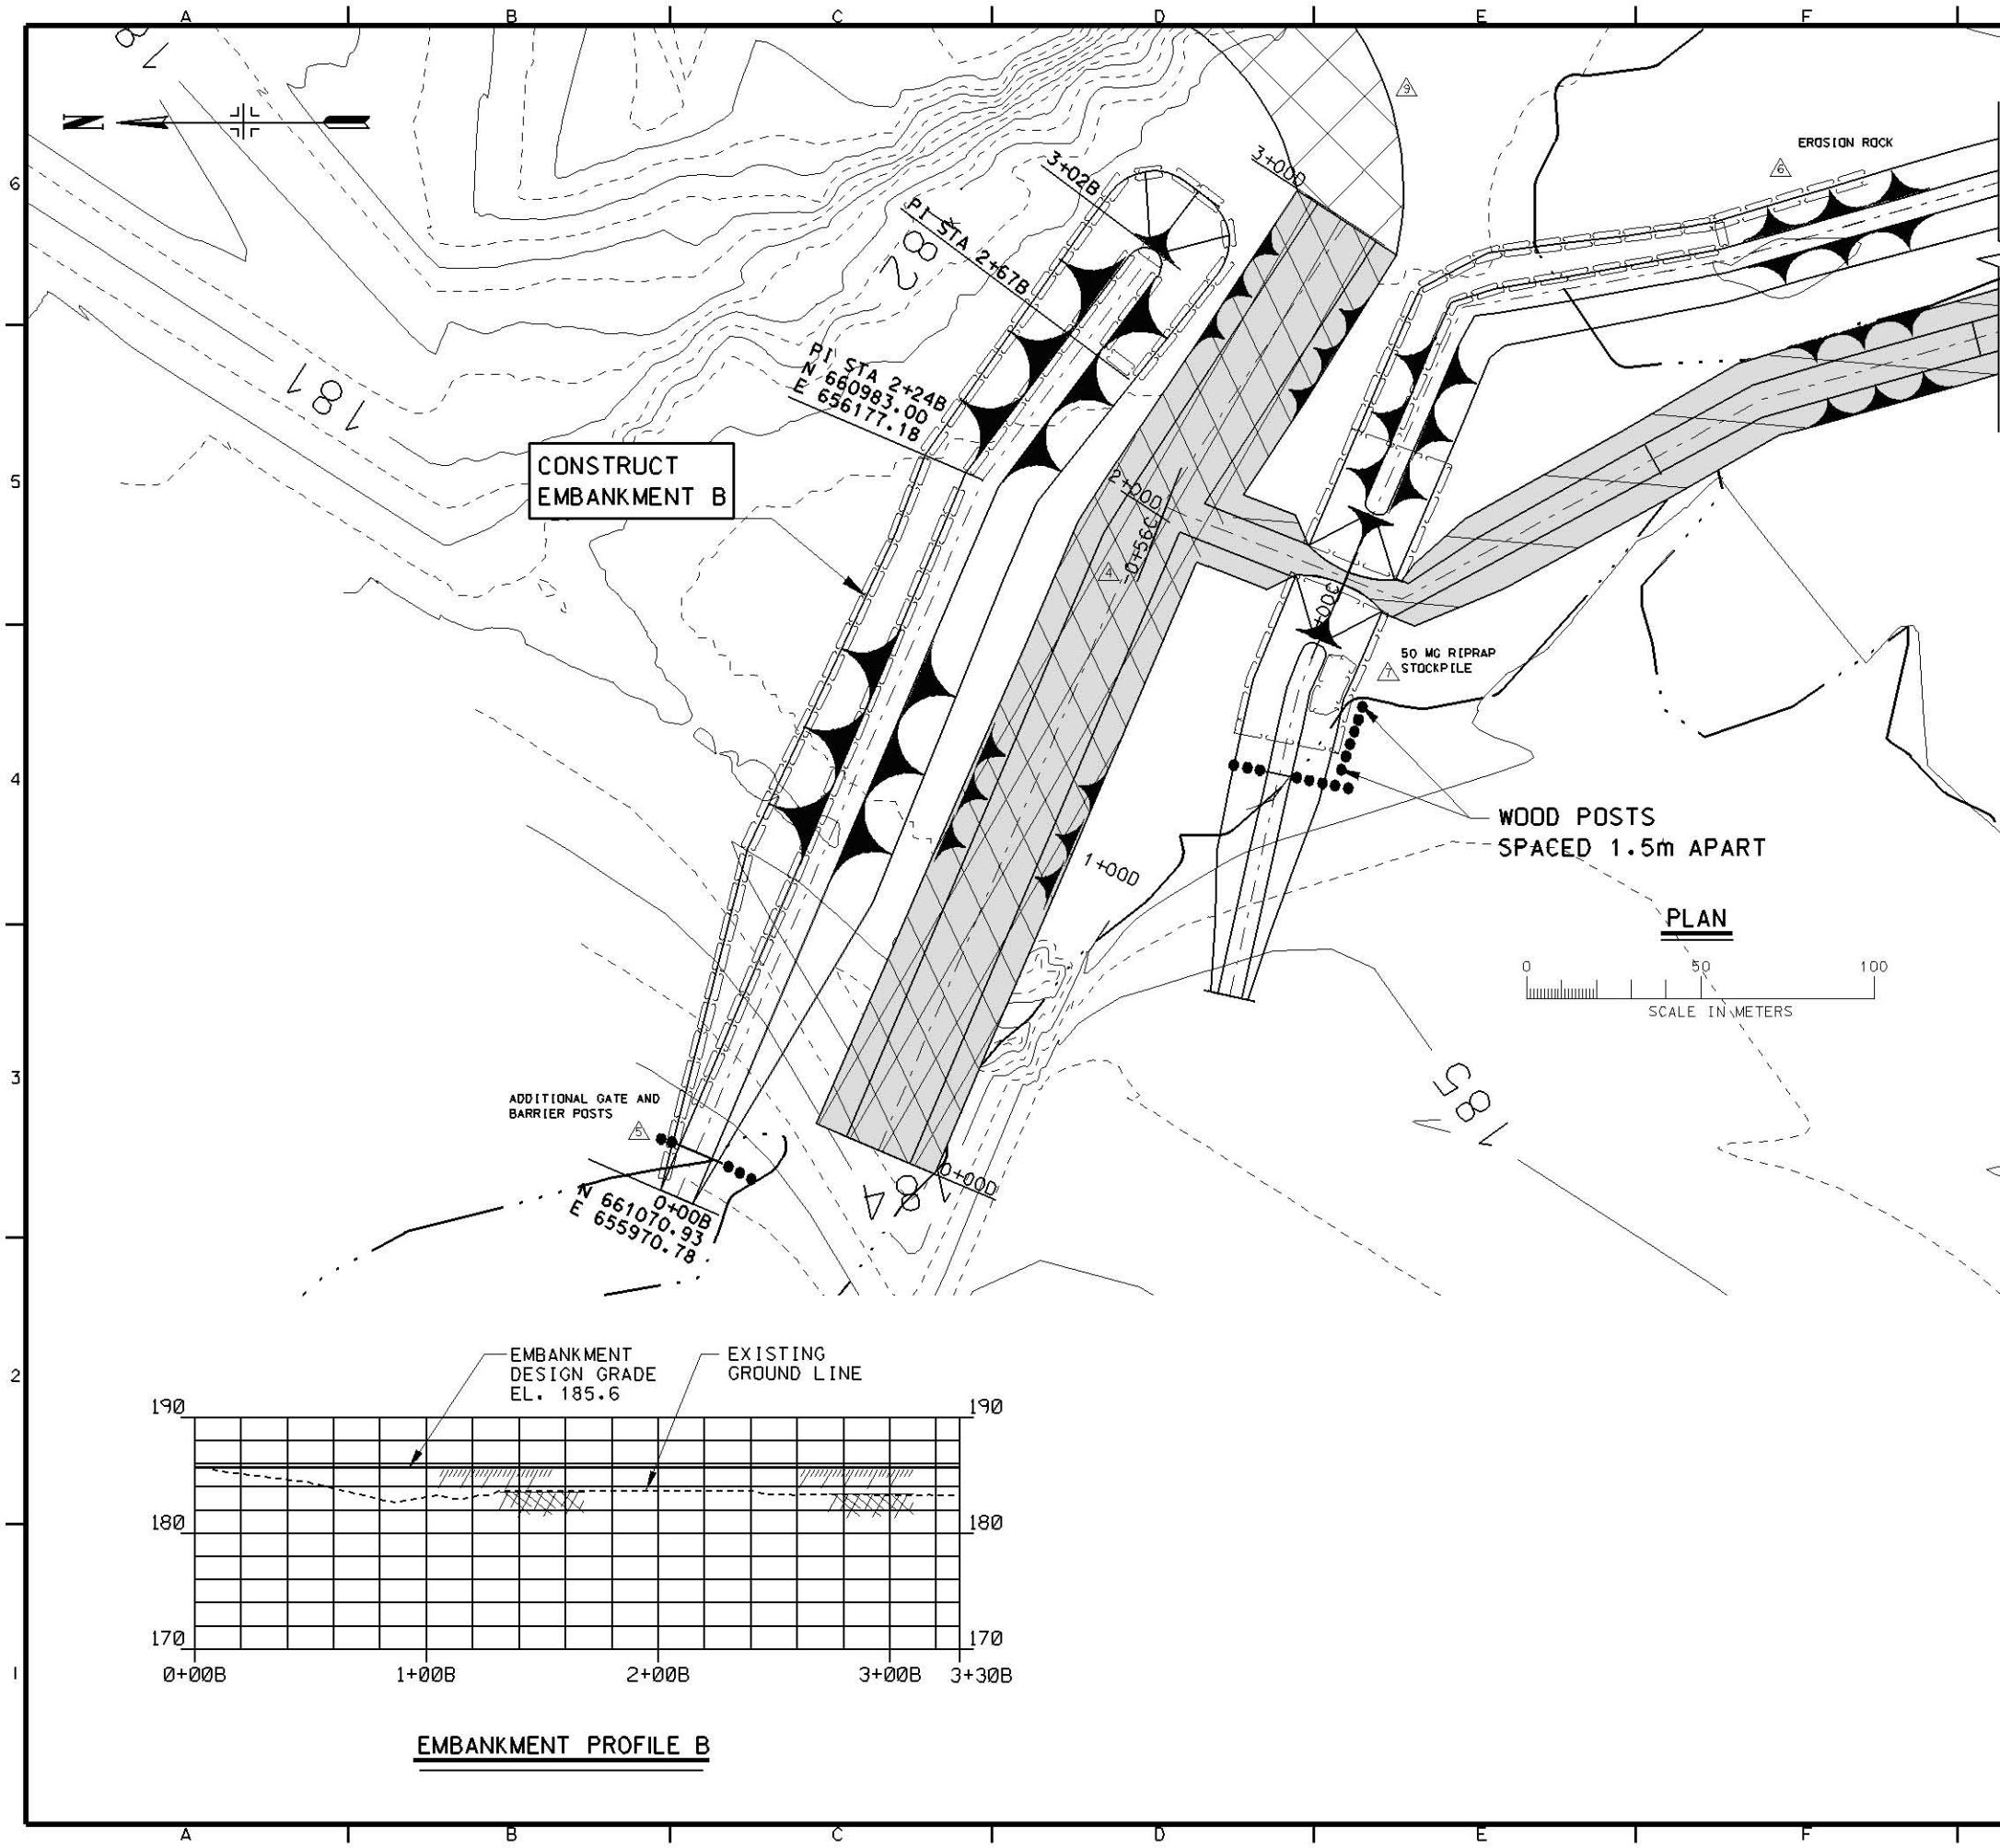

KEY PLAN

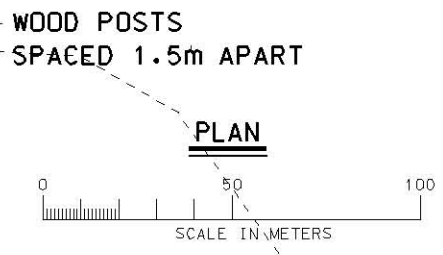


PLAN

LEGEND:

- BORROW EXCAVATION
- CHANNEL EXCAVATION
- EMBANKMENT
- EDGE OF SHORELINE VARIES AND IS APPROXIMATELY SHOWN AT FLAT POOL
- RIPRAP

NOTES:

INTERSECTION OF ALIGNMENT C AT -0.72C WITH ALIGNMENT D AT 2+00D SHALL BE CONTERMINOUS.

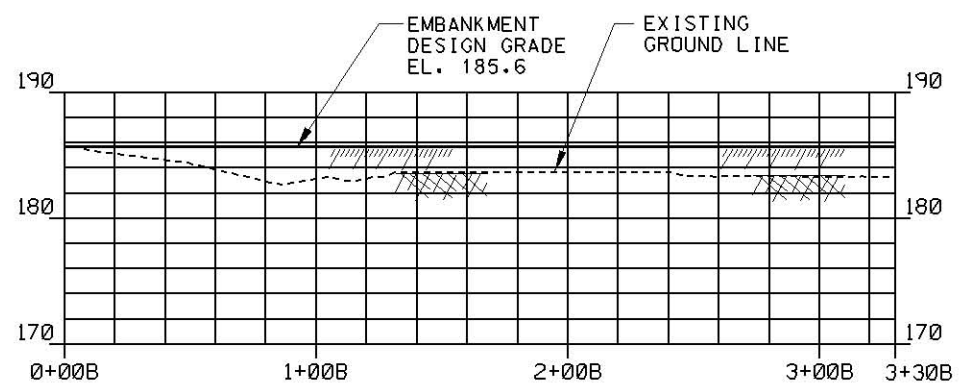

EMBANKMENT PROFILE B



REVISED AS	DATE	BY	DESCRIPTION
REVISED AS	11-05	RTN	RTN
MOD. # 1	11-05	RTN	MOD. # 1 - ADDITIONAL GATE AND POSTS
MOD. # 2	11-05	RTN	MOD. # 2 - STATION DISTANCE CHANGE
MOD. # 3	11-05	RTN	MOD. # 3 - STATION DISTANCE CHANGE
MOD. # 4	11-05	RTN	MOD. # 4 - STATION DISTANCE CHANGE
MOD. # 5	11-05	RTN	MOD. # 5 - STATION DISTANCE CHANGE
MOD. # 6	11-05	RTN	MOD. # 6 - STATION DISTANCE CHANGE
MOD. # 7	11-05	RTN	MOD. # 7 - STATION DISTANCE CHANGE
MOD. # 8	11-05	RTN	MOD. # 8 - STATION DISTANCE CHANGE
MOD. # 9	11-05	RTN	MOD. # 9 - STATION DISTANCE CHANGE
MOD. # 10	11-05	RTN	MOD. # 10 - STATION DISTANCE CHANGE
MOD. # 11	11-05	RTN	MOD. # 11 - STATION DISTANCE CHANGE
MOD. # 12	11-05	RTN	MOD. # 12 - STATION DISTANCE CHANGE
MOD. # 13	11-05	RTN	MOD. # 13 - STATION DISTANCE CHANGE
MOD. # 14	11-05	RTN	MOD. # 14 - STATION DISTANCE CHANGE
MOD. # 15	11-05	RTN	MOD. # 15 - STATION DISTANCE CHANGE
MOD. # 16	11-05	RTN	MOD. # 16 - STATION DISTANCE CHANGE
MOD. # 17	11-05	RTN	MOD. # 17 - STATION DISTANCE CHANGE
MOD. # 18	11-05	RTN	MOD. # 18 - STATION DISTANCE CHANGE
MOD. # 19	11-05	RTN	MOD. # 19 - STATION DISTANCE CHANGE
MOD. # 20	11-05	RTN	MOD. # 20 - STATION DISTANCE CHANGE

U.S. ARMY ENGINEER DISTRICT CORPS OF ENGINEERS ROCK ISLAND, ILLINOIS	Designed By: JRP/RTN Drawn By: SDB/LLT Checked By: RTN Reviewed By: DJJ	Date: 14 APRIL 2004 Scale: AS SHOWN Drawing Code: ep81 Revision Number: 0003
--	--	---

POOL 11 ISLANDS
HABITAT REHABILITATION
& ENHANCEMENT PROJECT
STAGE II - MUD LAKE
**EMBANKMENT B AND
EXCAVATION D
PLAN AND PROFILE**

Sheet
Reference
Number:
C7
Sheet 12 of 20


ALL DISTANCES, MEASUREMENTS AND ELEVATIONS SHOWN ARE IN METERS UNLESS NOTED OTHERWISE.

Revision	Date	By	App'd
1	8-11-06	RTN/RAP	
2			
3			
Date:	14 APRIL 2004
Designed By:	JRP/RTN
Drawn By:	SDB/LLT
Checked By:	RTN
Reviewed By:	DJJ
Scale:	AS SHOWN
Drawing Code:	ep81
Specification Number:	W12EX-04-R-0003

U.S. ARMY ENGINEER DISTRICT
CORPS OF ENGINEERS
ROCK ISLAND, ILLINOIS



Sheet
Reference
Number:
CB
Sheet 13 of 20

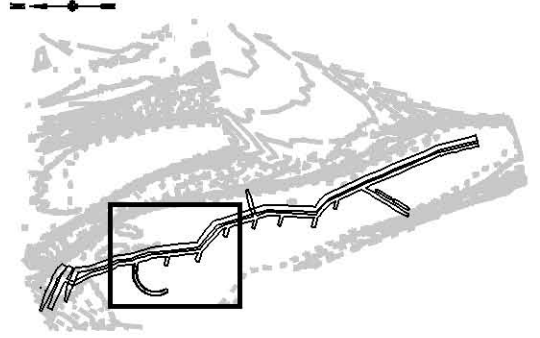


KEY PLAN

LEGEND:


- CHANNEL EXCAVATION
- EMBANKMENT
- EDGE OF SHORELINE VARIES AND IS APPROXIMATELY SHOWN AT FLAT POOL

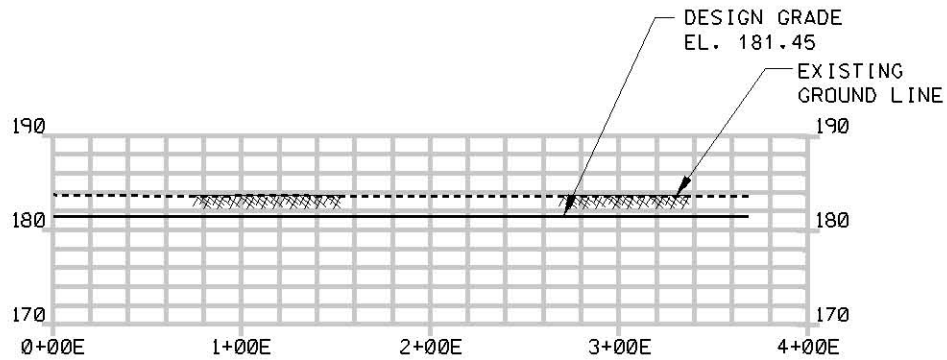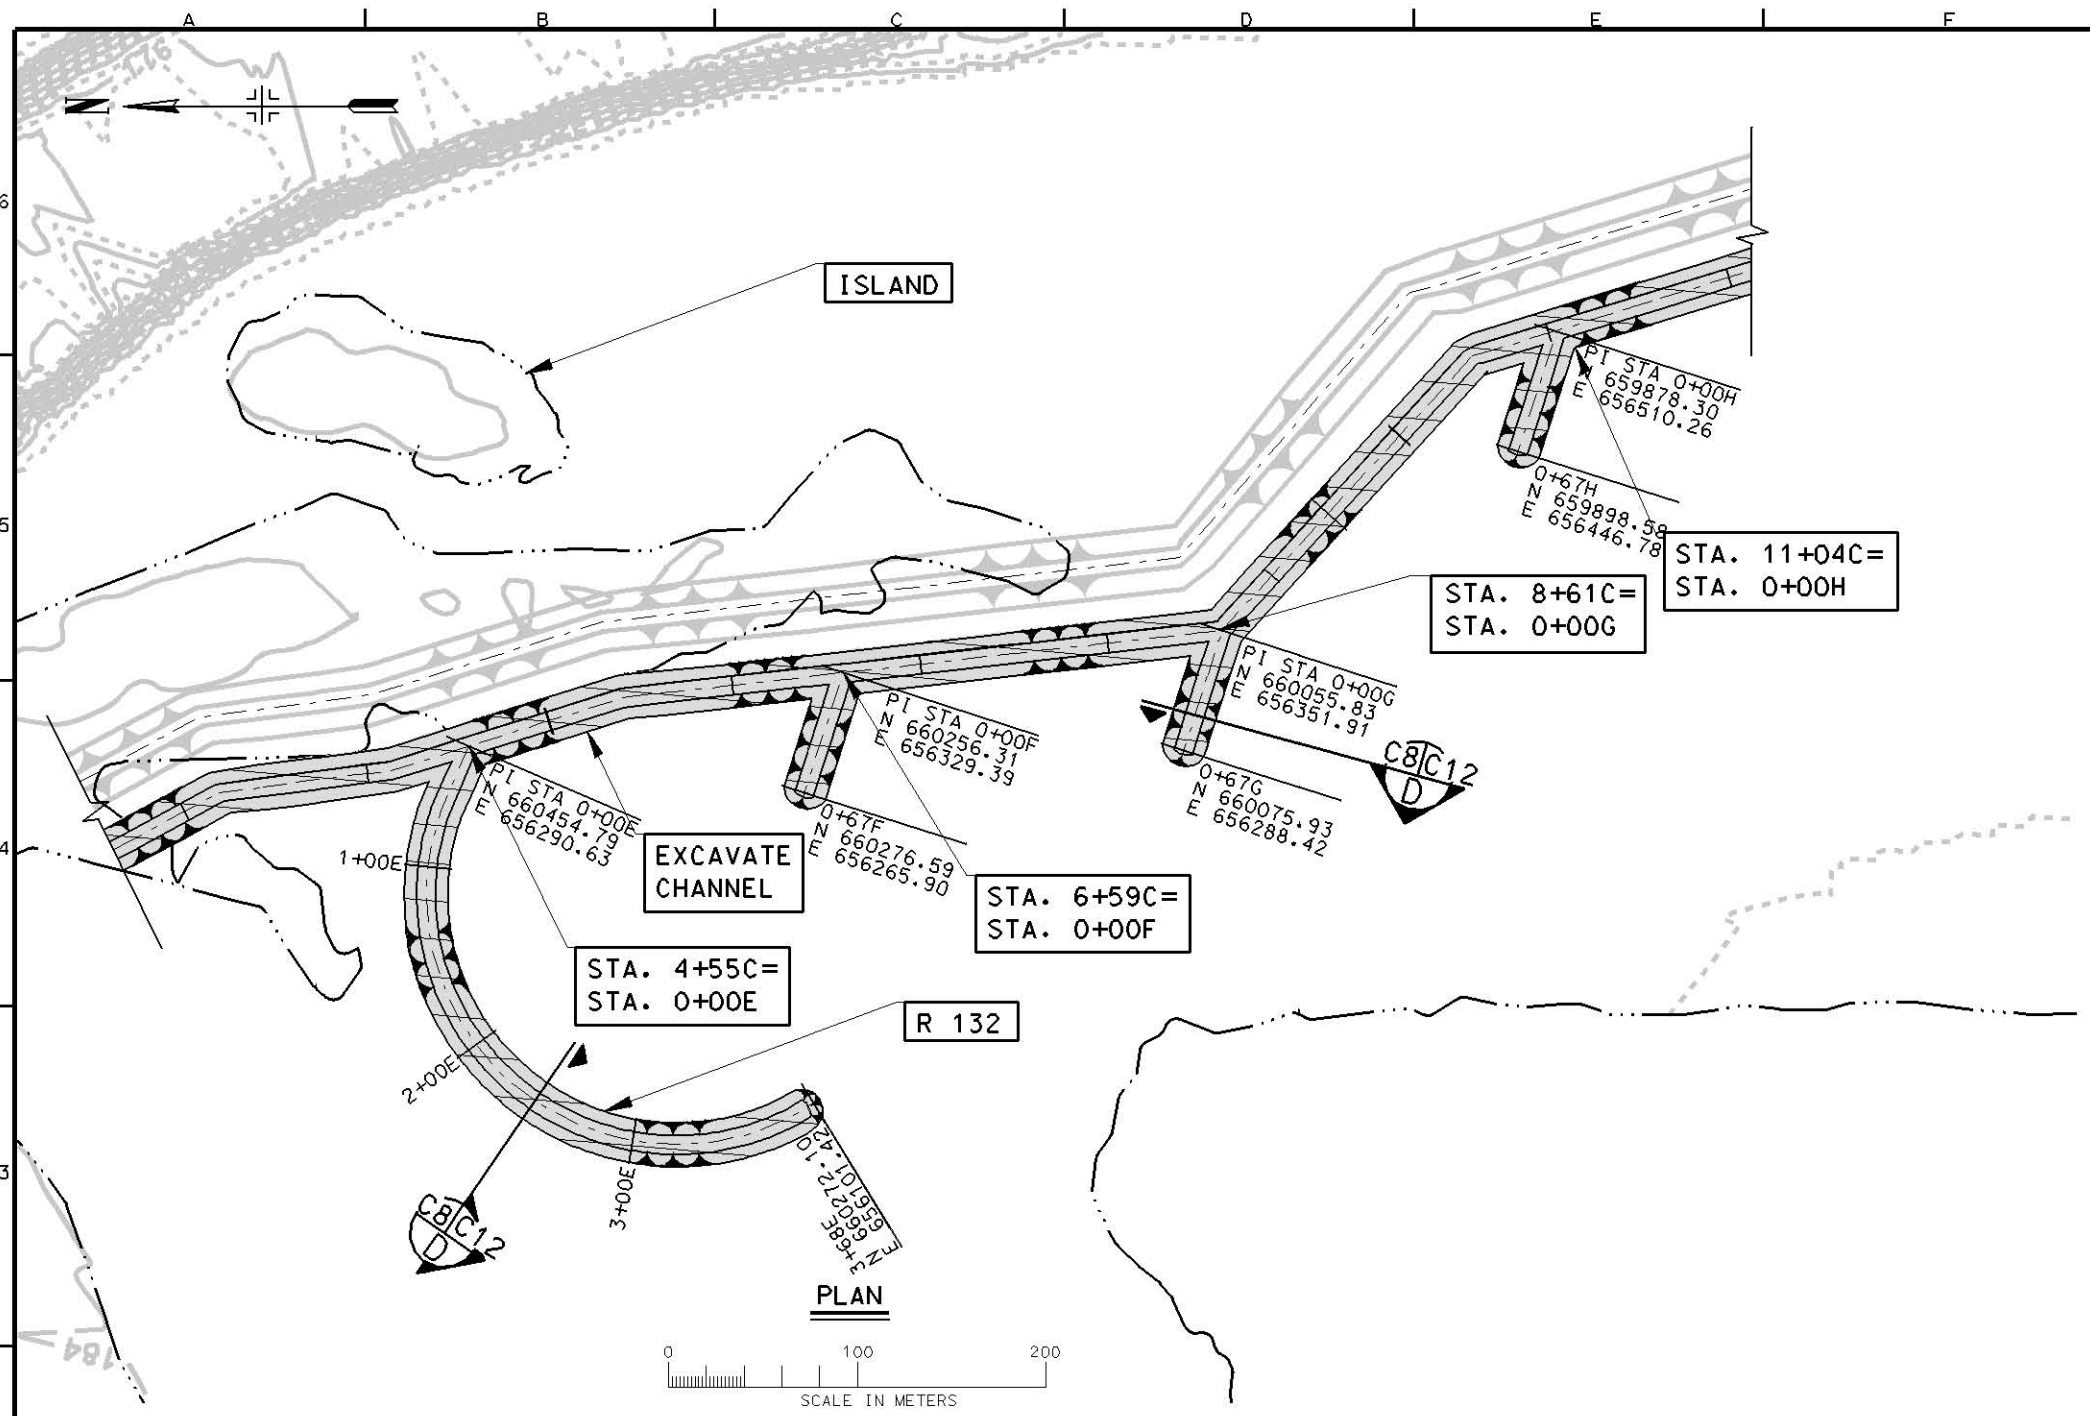


CHANNEL EXCAVATION PROFILE E

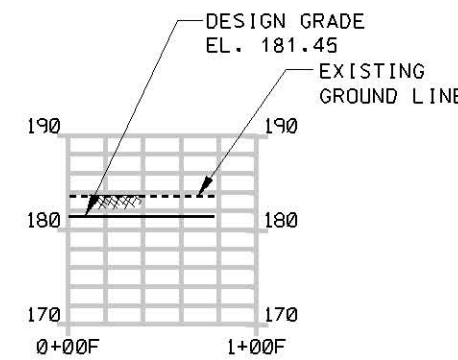

CHANNEL EXCAVATION PROFILE F


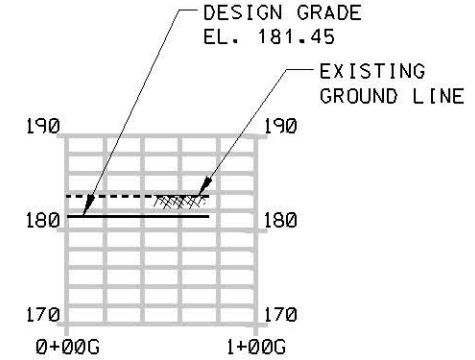


CHANNEL EXCAVATION PROFILE G

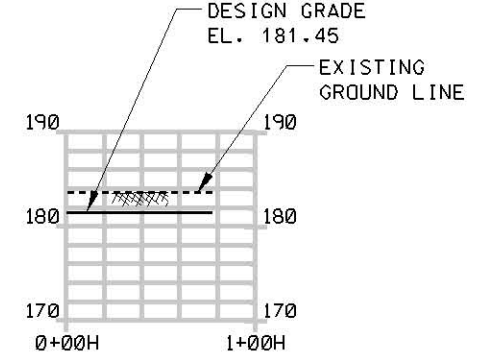


CHANNEL EXCAVATION PROFILE H

ALL DISTANCES, MEASUREMENTS AND ELEVATIONS SHOWN ARE IN METERS UNLESS NOTED OTHERWISE.

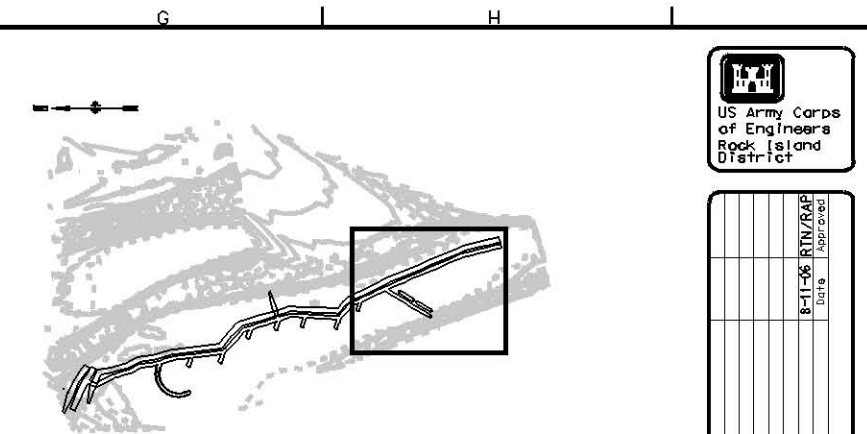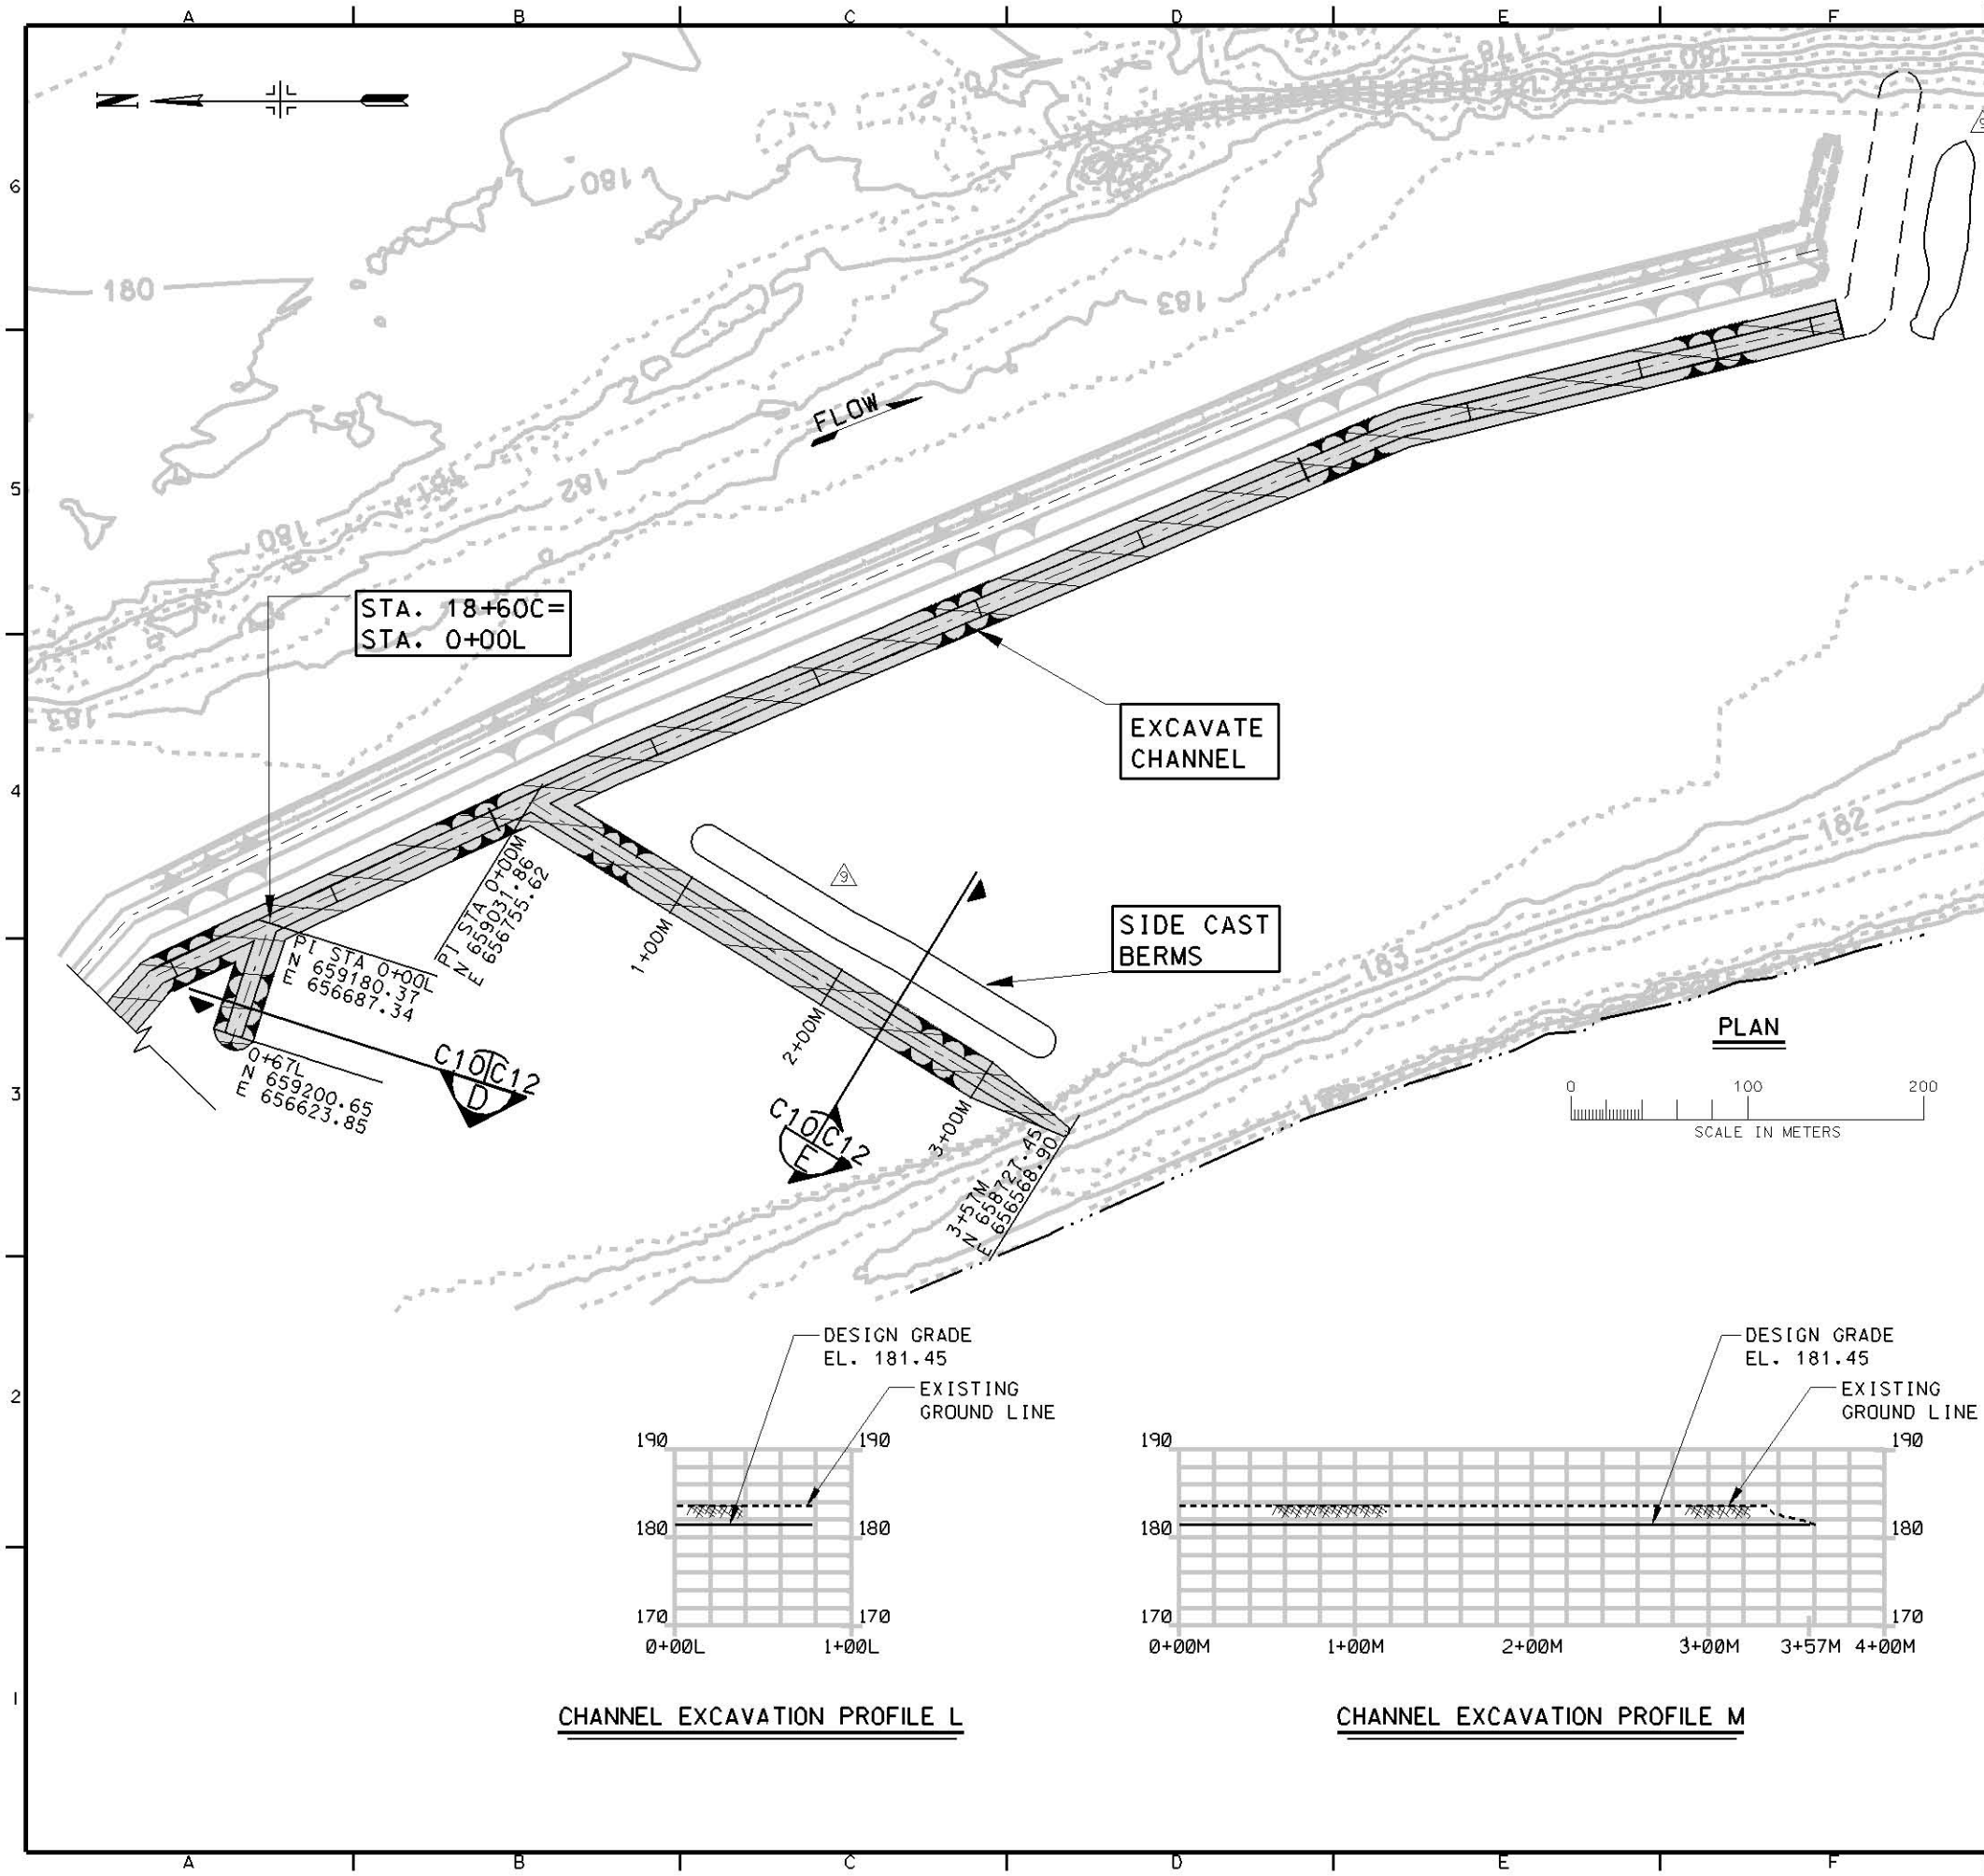


KEY PLAN

PLAN

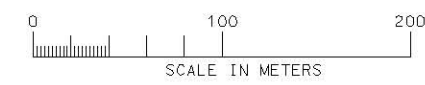


LEGEND:

- CHANNEL EXCAVATION
- EMBANKMENT
- EDGE OF SHORELINE VARIES AND IS APPROXIMATELY SHOWN AT FLAT POOL
- RIPRAP

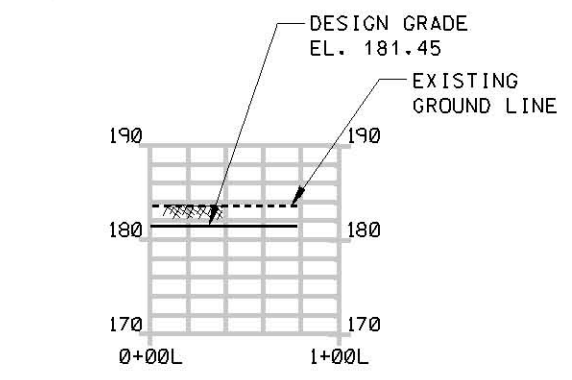

CHANNEL EXCAVATION PROFILE L

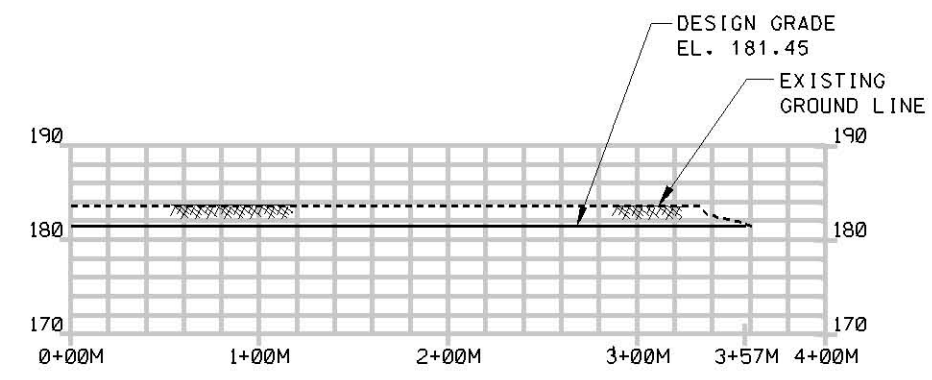

CHANNEL EXCAVATION PROFILE M

ALL DISTANCES, MEASUREMENTS AND ELEVATIONS SHOWN ARE IN METERS UNLESS NOTED OTHERWISE.



Symbol	Description	Revisions
REVISED AS CONSTRUCTED		
8-11-06 RTN/RAP	Date	Approved

U.S. ARMY ENGINEER DISTRICT CORPS OF ENGINEERS ROCK ISLAND, ILLINOIS	Designed By: JRP/RTN Drawn By: SDB/LLT Checked By: RTN Reviewed By: DJJ	Date: 14 APRIL 2004 Scale: AS SHOWN Drawing Code: ep81 Revision Number: W12EK-04-R-0003
--	--	--

POOL 11 ISLANDS
HABITAT REHABILITATION
& ENHANCEMENT PROJECT
STAGE 11 - MUD LAKE
**CHANNEL EXCAVATION
PLAN AND PROFILE
L & M**

Sheet
Reference
Number:
C10
Sheet 15 of 20


8-11-06	RTN/RAP	Approved
Date	Symbol	Revisions
AS CONSTRUCTED		

Date:	14 APRIL 2004
Designed By:	JRP/RTN
Drawn By:	SDB/LLT
Checked By:	RTN
Reviewed By:	DJJ
Scale:	AS SHOWN
Drawing Code:	ep81
Specification Number:	W12EX-04-R-003


U.S. ARMY ENGINEER DISTRICT
CORPS OF ENGINEERS
ROCK ISLAND, ILLINOIS

POL 11 ISLANDS
HABITAT REHABILITATION
& ENHANCEMENT PROJECT
STAGE II - MUD LAKE
TYPICAL SECTIONS
A, B AND C


Sheet
Reference
Number:
C11
Sheet 16 of 20

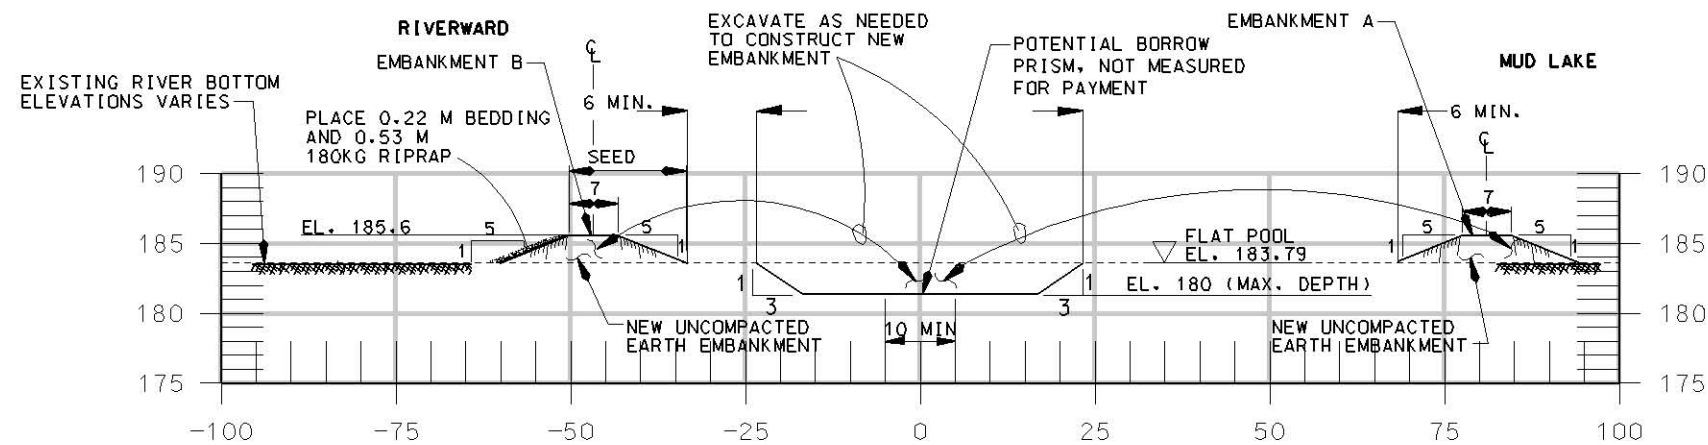

A
C4/C11
TYPICAL SECTION - EMBANKMENT AND BORROW SOURCE
NO SCALE

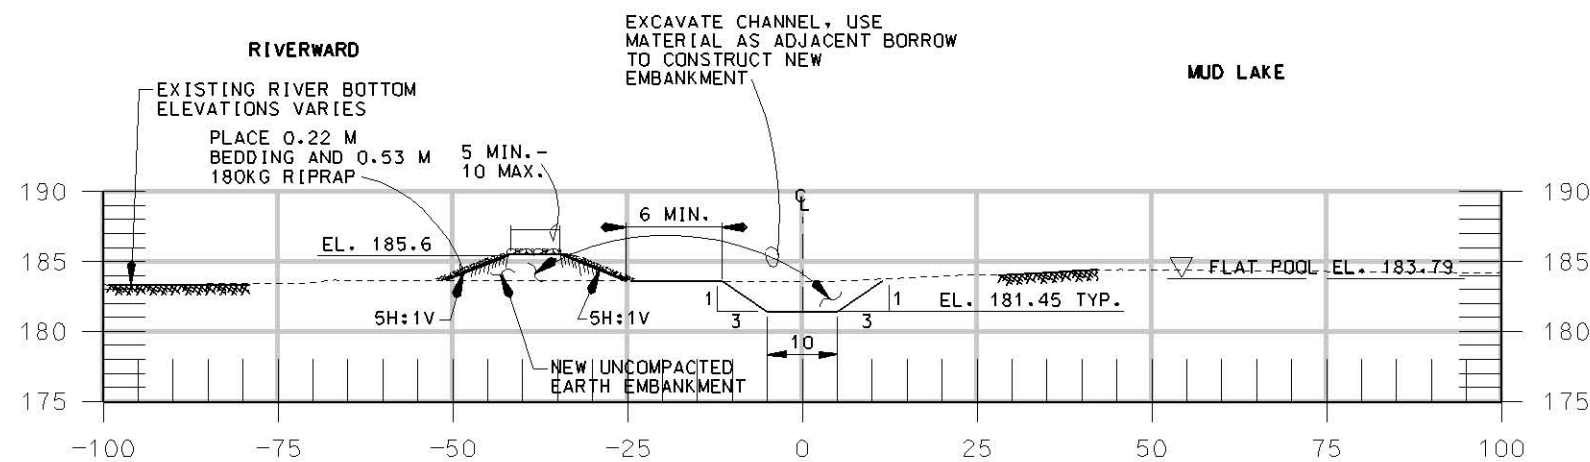

B
C5/C11
TYPICAL SECTION - RIPRAP EMBANKMENT WITH EXCAVATED CHANNEL
STA 13+86A TO STA 14+09A
STA 14+53A TO STA 14+76A
NO SCALE



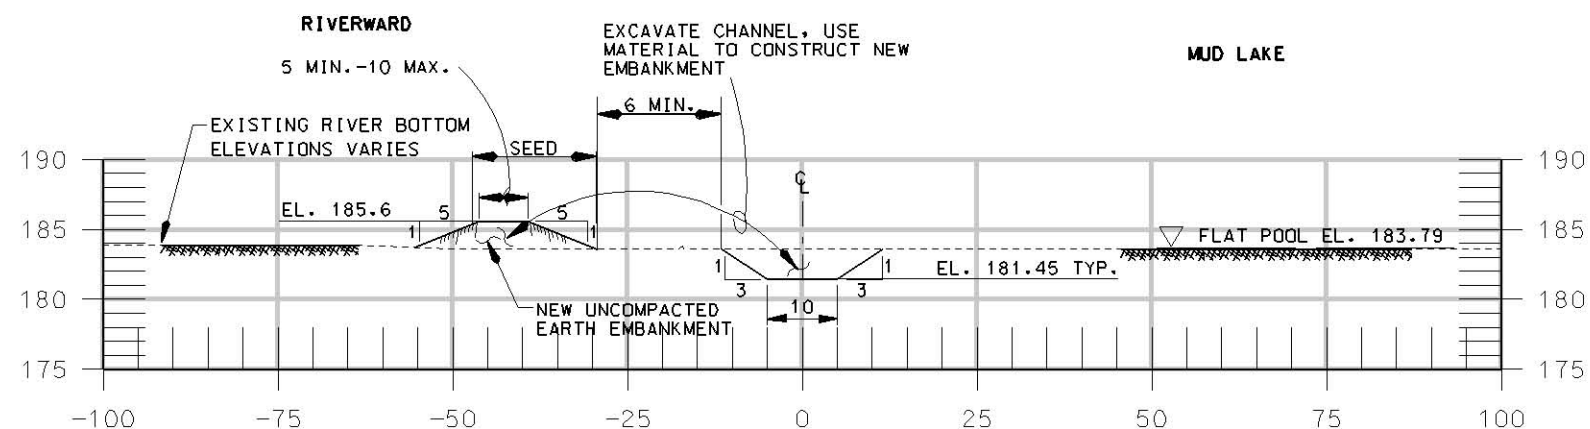


C
C4.C5/C11
TYPICAL SECTION - EMBANKMENT WITH EXCAVATED CHANNEL
STA 2+86A TO STA 11+65A
STA 12+05A TO STA 13+86A
STA 16+10A TO STA 19+10A
NO SCALE

NOTES:

1. ALL SLOPES ON EMBANKMENTS SHALL BE 5 (MIN.) :1.
2. SEEDING SHALL EXTEND TO BOUNDARY OF RIPRAP OR NORMAL WATERLINE.
3. ABOVE ELEVATION 183.79 M, 0.53 M RIPRAP SHALL BE PLACED ON 0.22 M BEDDING STONE.
4. BELOW ELEVATION 183.79 M, 0.65 M RIPRAP SHALL BE PLACED ON 0.35 M BEDDING STONE.

ALL DISTANCES, MEASUREMENTS AND
ELEVATIONS SHOWN ARE IN METERS
UNLESS NOTED OTHERWISE.

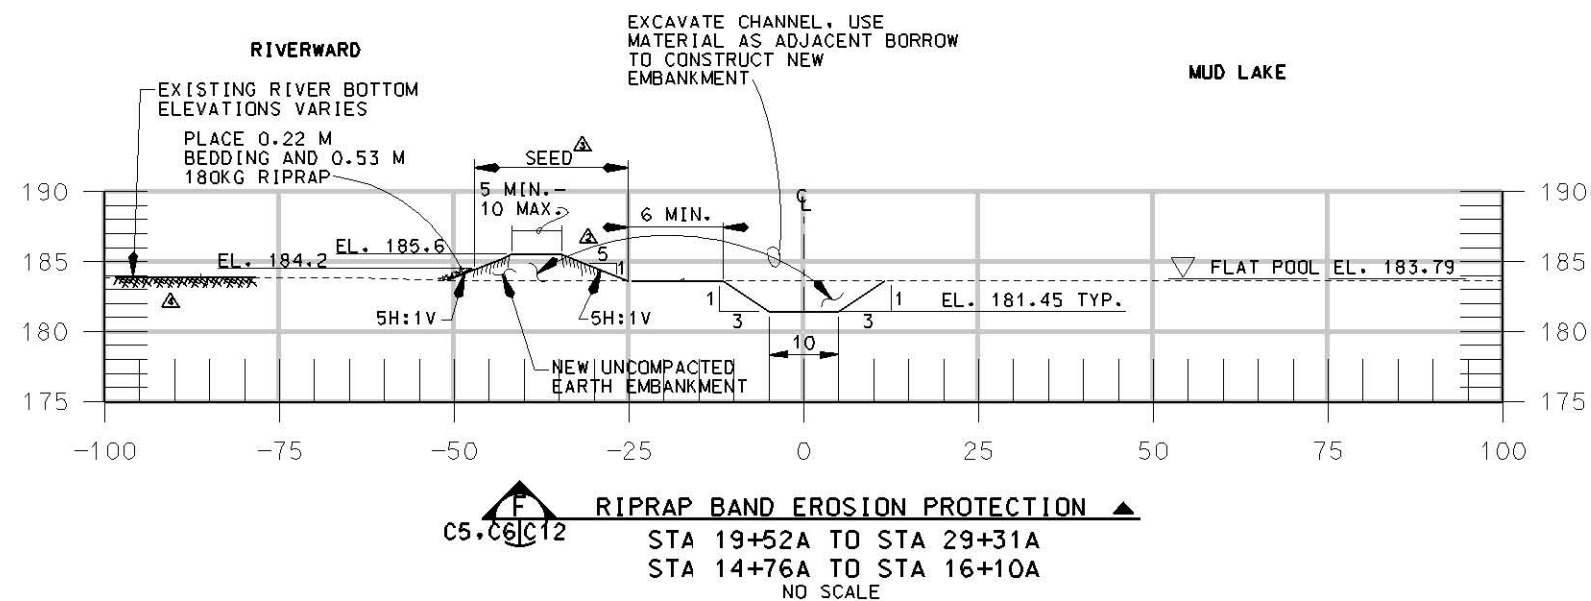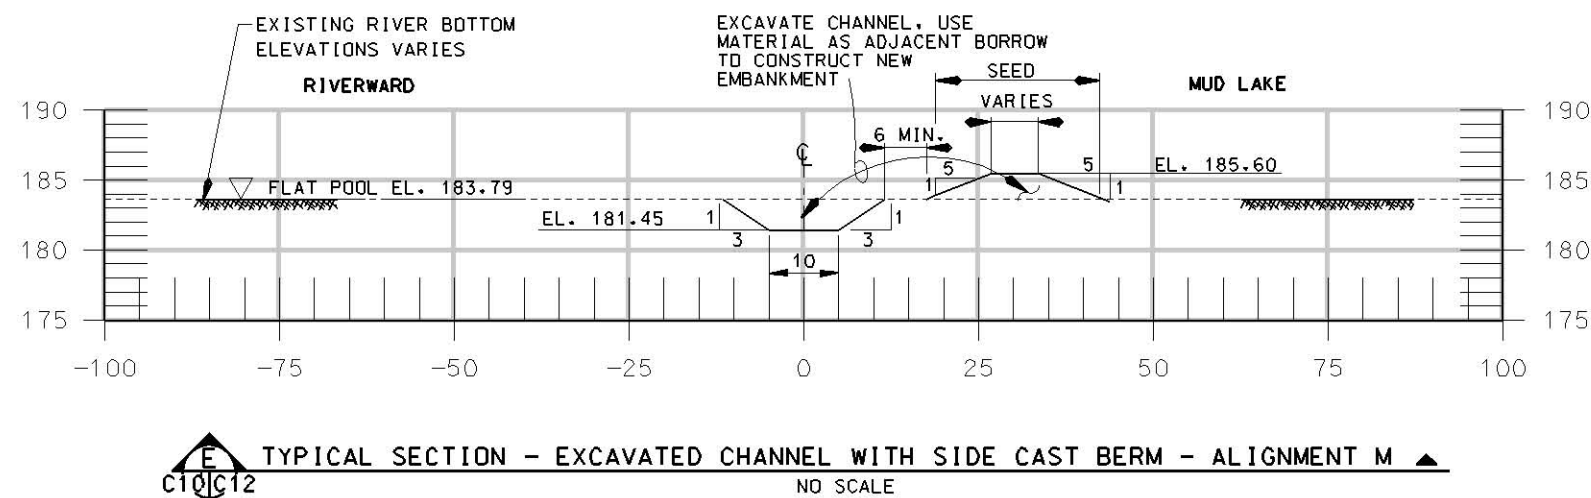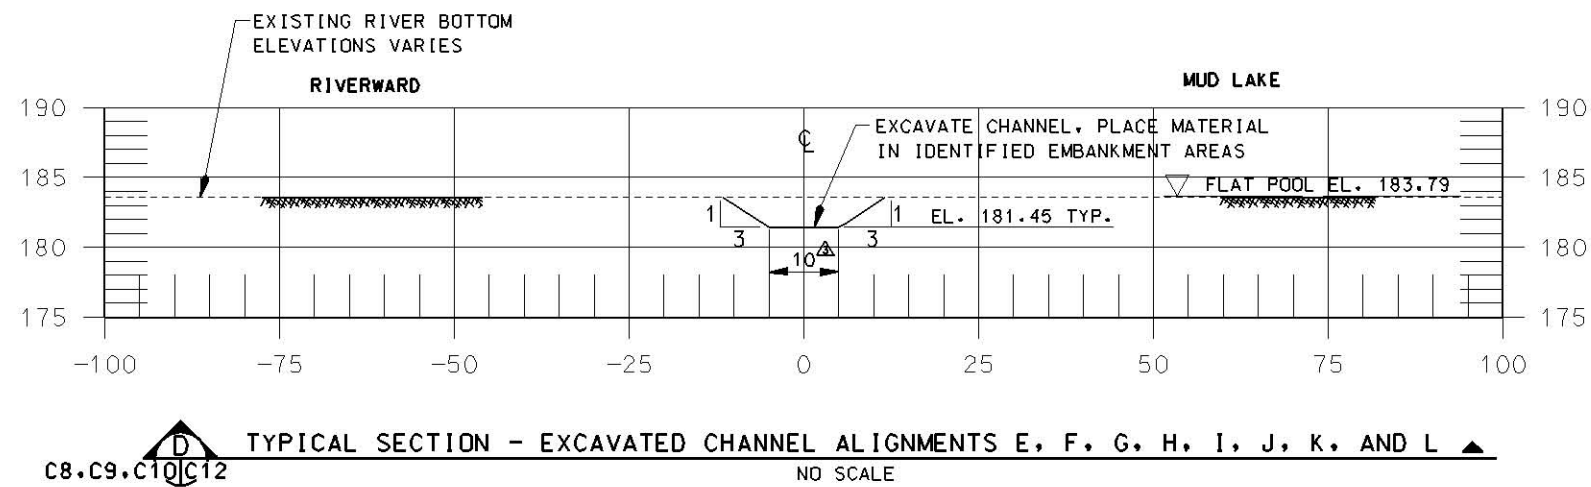

NOTES:

- ALL SLOPES ON EMBANKMENTS SHALL BE 5 (MIN.) :1.
- SEEDING SHALL EXTEND TO BOUNDARY OF RIPRAP OR NORMAL WATERLINE.
- ABOVE ELEVATION 183.79 M, 0.53 M RIPRAP SHALL BE PLACED ON 0.22 M BEDDING STONE.
- BELOW ELEVATION 183.79 M, 0.65 M RIPRAP SHALL BE PLACED ON 0.35 M BEDDING STONE.

ALL DISTANCES, MEASUREMENTS AND ELEVATIONS SHOWN ARE IN METERS UNLESS NOTED OTHERWISE.

Symbol	Description	Revisions
AS CONSTRUCTED	AS SHOWN	ep81
AND #1-SPECIFICATION AMENDMENT	AS SHOWN	ep81
AND #2-SLOPE LABEL CORRECTION	AS SHOWN	ep81
AND #3-DIMENSION AND SEEDING CORRECTION	AS SHOWN	ep81
AND #4-MINER REVISION	AS SHOWN	ep81

U.S. ARMY ENGINEER DISTRICT CORPS OF ENGINEERS ROCK ISLAND, ILLINOIS	Designed By: JRP/RTN	Drawn By: SDB/LLT	Checked By: RTN	Reviewed By: DJJ	Date: 14 APRIL 2004	Scale: AS SHOWN	Drawing Code: ep81	Revision Number: W812EX-04-R-0003
--	----------------------	-------------------	-----------------	------------------	---------------------	-----------------	--------------------	-----------------------------------

POOL 11 ISLANDS
HABITAT REHABILITATION
& ENHANCEMENT PROJECT
STAGE 11 - MUD LAKE
TYPICAL SECTIONS
D, E AND F


Sheet
Reference
Number:
C12
Sheet 17 of 20

Symbol	Description	Revisions
AS	AS CONSTRUCTED	
8-11-06	RTN/RAP	8-11-06
6-2-04	JRP/DJJ	6-2-04
	Approved	


Date:	14 APRIL 2004
Designed By:	JRP/RTN
Drawn By:	SDB/LLT
Checked By:	RTN
Reviewed By:	DJJ
Scale:	AS SHOWN
Drawing Code:	ep81
Specification Number:	WS12EK-04-R-0003

POOL 11 ISLANDS
HABITAT REHABILITATION
& ENHANCEMENT PROJECT
STAGE II - MUD LAKE
MUD LAKE
TYPICAL SECTIONS
G, H, I AND J


Sheet
Reference
Number:
C13
Sheet 18 of 20

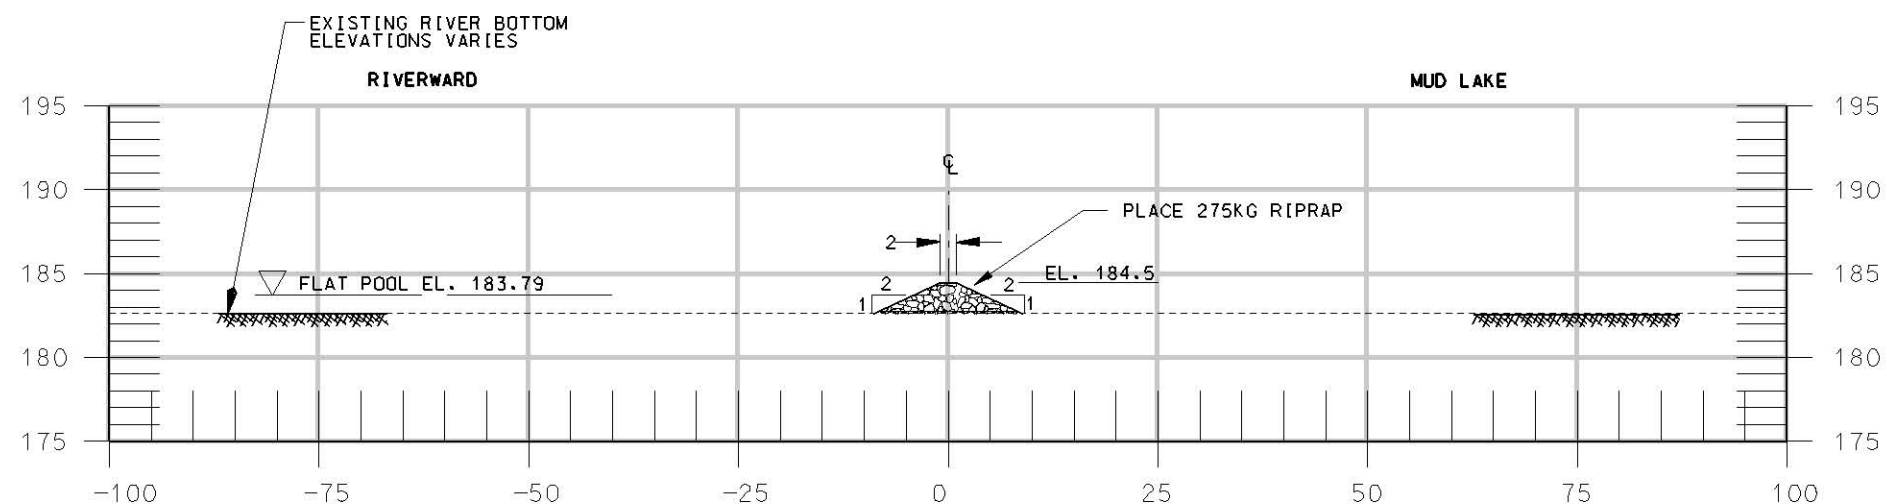


G
C6/C13 **ROCK SPUR DIKE SECTION**
NO SCALE

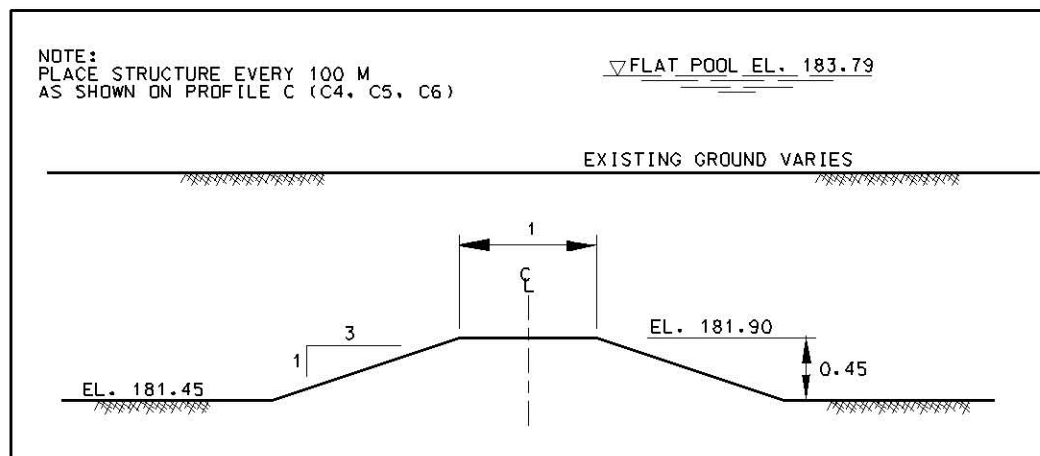

H
C4, C5, C6/C13 **TYPICAL SECTION - DEPTH DIVERSITY STRUCTURE**
NO SCALE

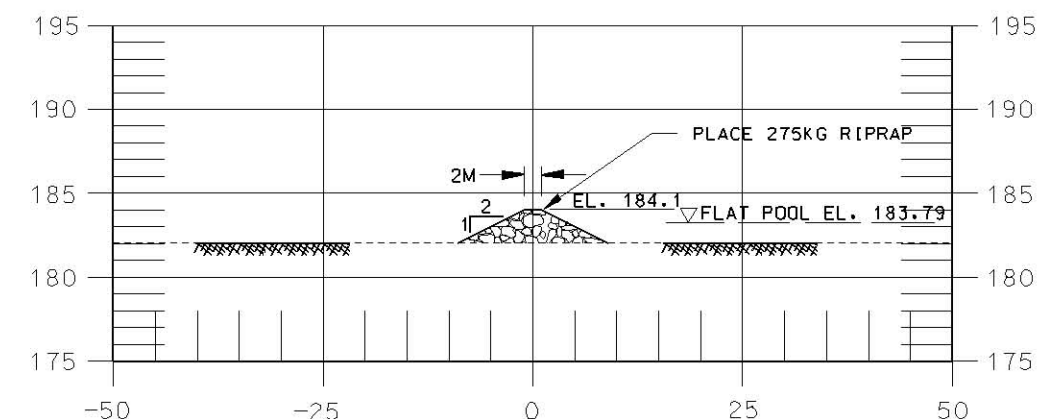

I
C5/C13 **TYPICAL SECTION - RIPRAP EMBANKMENT**
NO SCALE

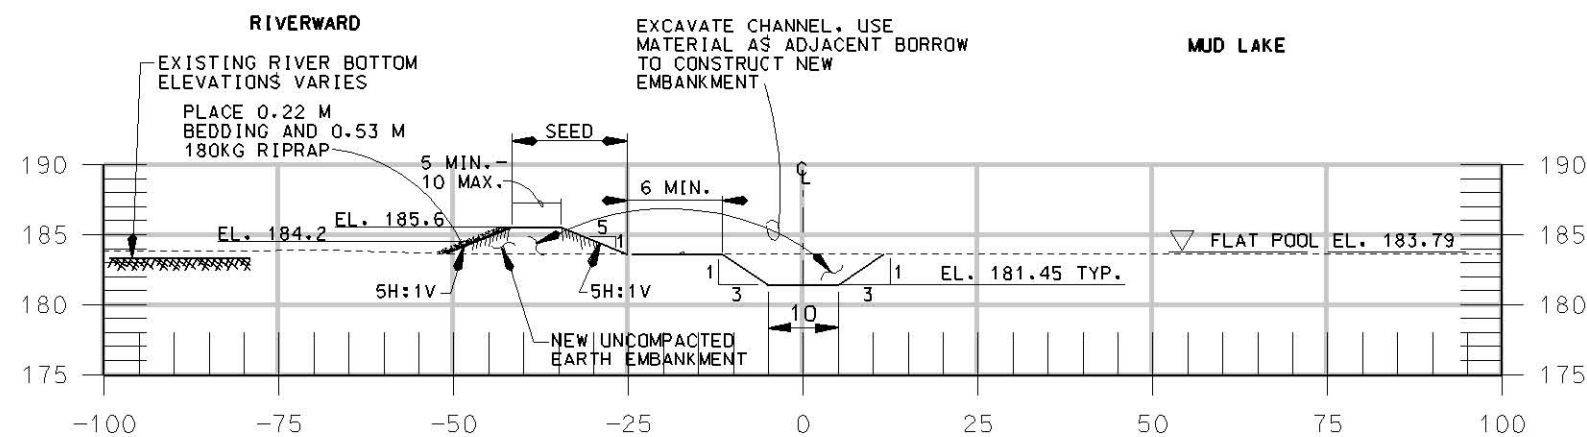

J
C4, C5/C13 **TYPICAL SECTION-RIPRAP EMBANKMENT**
NO SCALE

NOTES:

- ALL SLOPES ON EMBANKMENTS SHALL BE 5 (MIN.) :1.
- SEEDING SHALL EXTEND TO BOUNDARY OF RIPRAP OR NORMAL WATERLINE.
- ABOVE ELEVATION 183.79 M, 0.53 M RIPRAP SHALL BE PLACED ON 0.22 M BEDDING STONE.
- BELOW ELEVATION 183.79 M, 0.65 M RIPRAP SHALL BE PLACED ON 0.35 M BEDDING STONE.



ALL DISTANCES, MEASUREMENTS AND
ELEVATIONS SHOWN ARE IN METERS
UNLESS NOTED OTHERWISE.

8-11-06 RTN/RAP	Approved	Revisions
5-2-06 RTN/RAP	Date	
5-24-06 RTN/RAP	Date	
AS CONSTRUCTED	Description	
MOD#8 - ADDITIONAL RIPRAP		
MOD#7 - RIPRAP STOCKPILE		
Symbol		


Date: 14 APRIL 2004	AS SHOWN	ep81
Designed By: JRP/RTN	Drawing Code:	W12EK-04-R-0003
Drawn By: SDB/LIT	RTN	
Checked By: RTN	Reviewed By: DJJ	
U.S. ARMY ENGINEER DISTRICT CORPS OF ENGINEERS ROCK ISLAND, ILLINOIS		

POOL 11 ISLANDS
HABITAT REHABILITATION
& ENHANCEMENT PROJECT
STAGE 11 - MUD LAKE
TYPICAL FLOW INLET DETAILS

Sheet
Reference
Number:
C14
Sheet 19 of 20

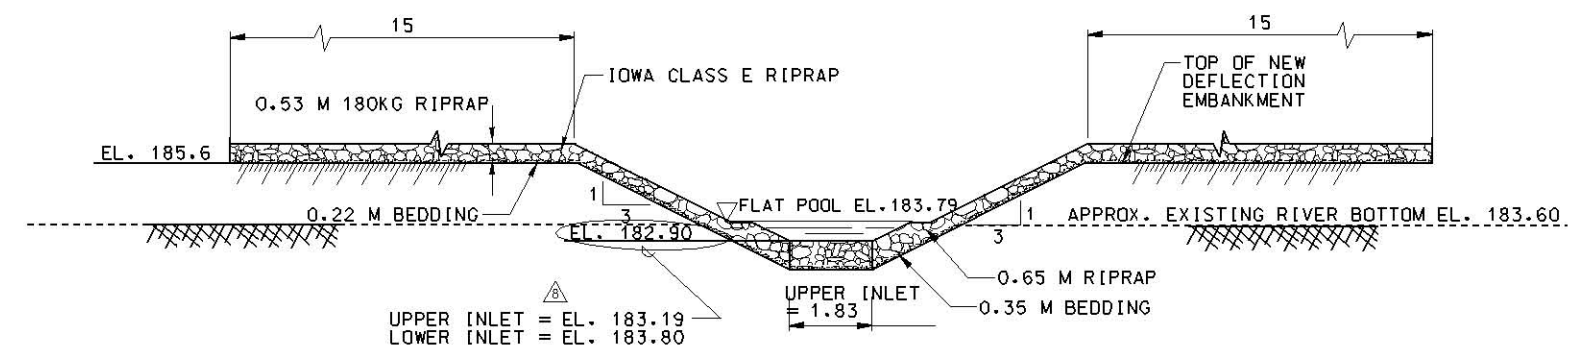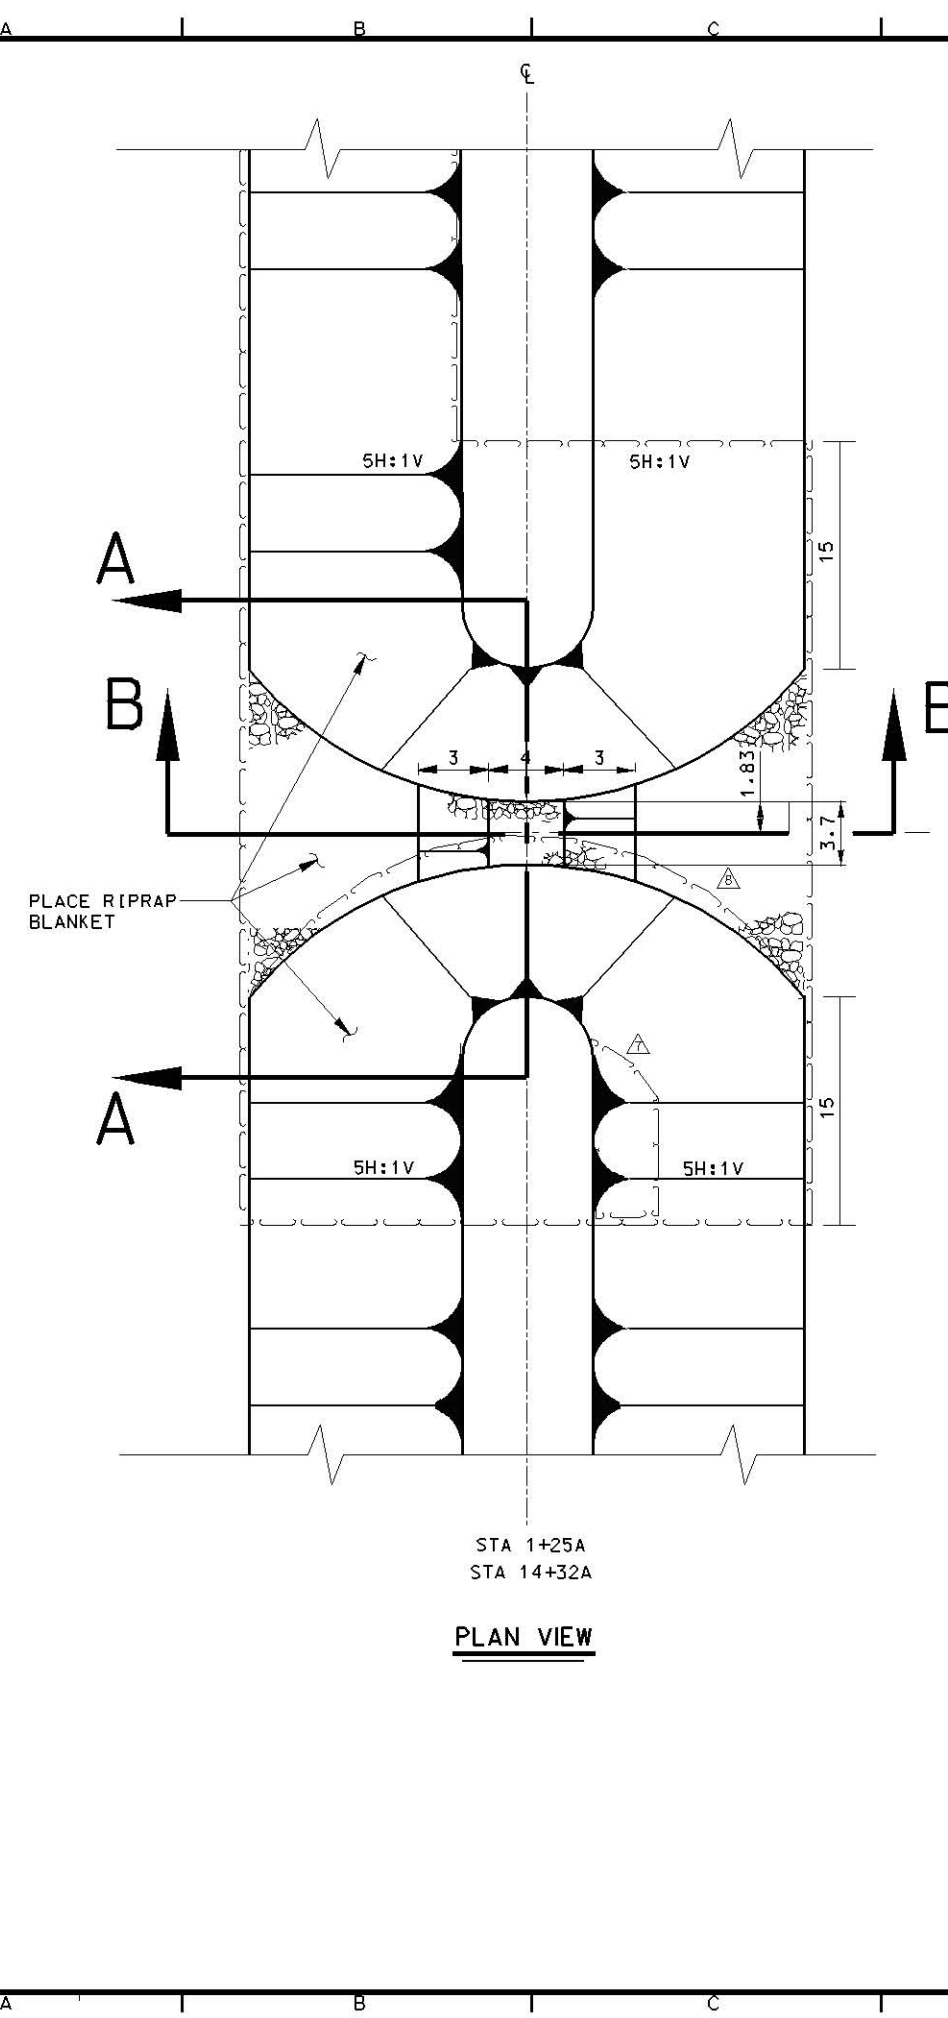

SECTION A-A FLOW INLET SECTION
NO SCALE


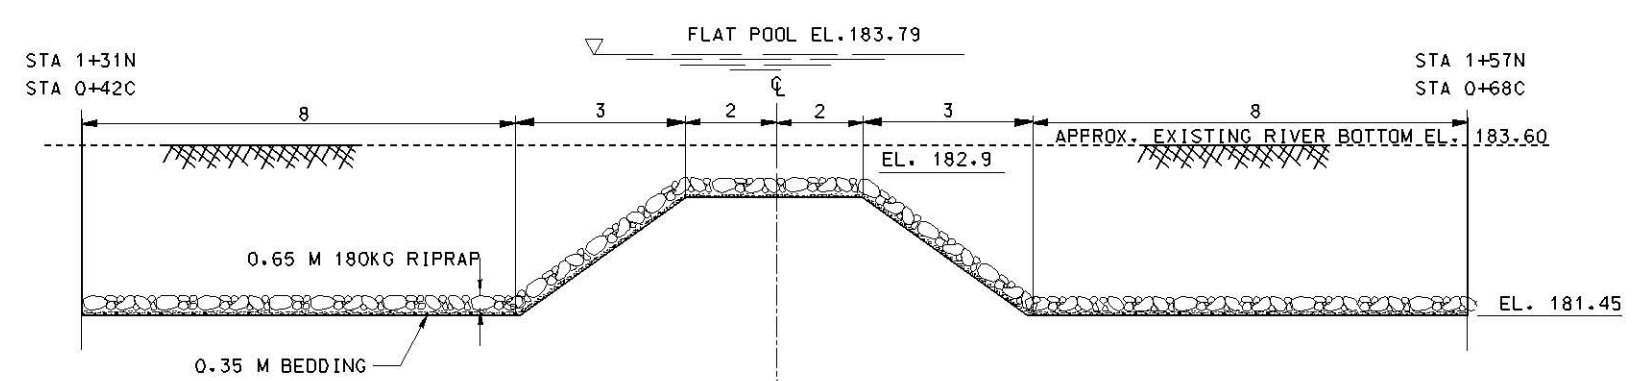


SECTION B-B FLOW INLET SECTION
NO SCALE

NOTES:

1. ABOVE ELEVATION 183.79 M, 0.53 M RIPRAP SHALL BE PLACED ON 0.22 M BEDDING STONE.
2. BELOW ELEVATION 183.79 M, 0.65 M RIPRAP SHALL BE PLACED ON 0.35 M BEDDING STONE.

ALL DISTANCES, MEASUREMENTS AND ELEVATIONS SHOWN ARE IN METERS UNLESS NOTED OTHERWISE.

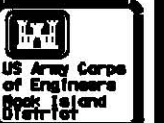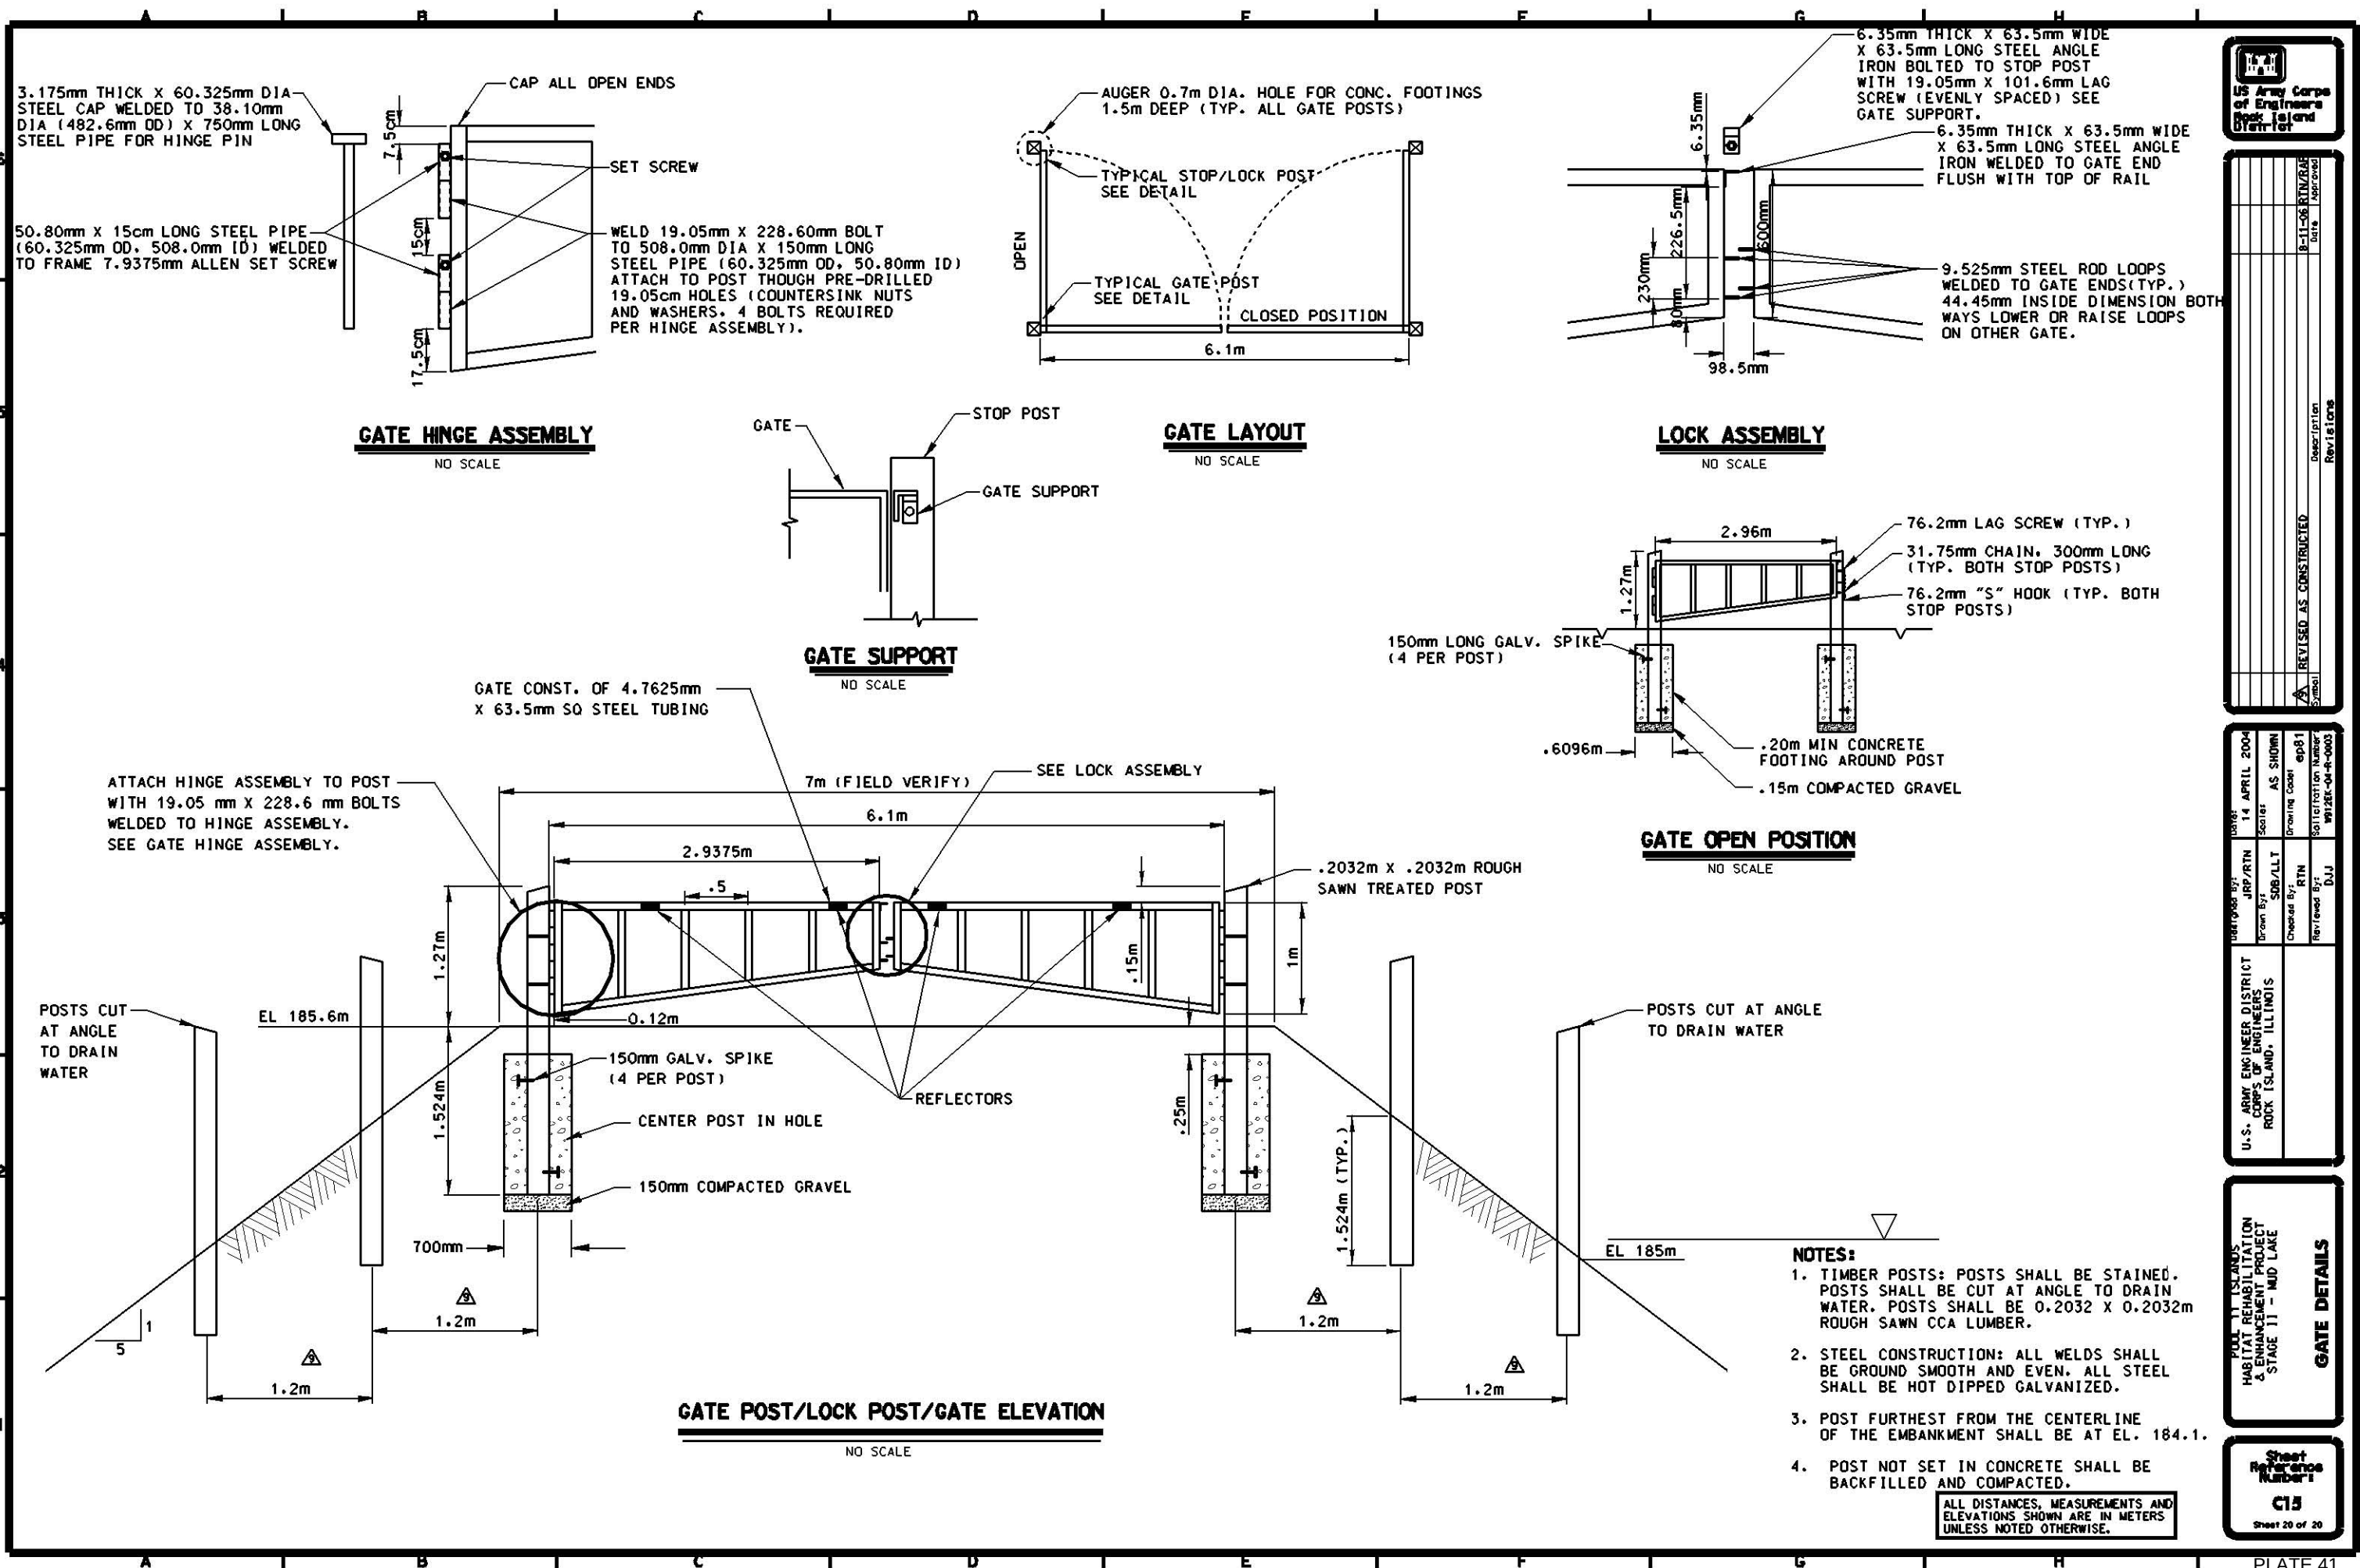


Revisions	Description	Date
1	REVISED AS CONSTRUCTED	8-11-06 RTN/RAE

U.S. ARMY ENGINEER DISTRICT CORPS OF ENGINEERS ROCK ISLAND, ILLINOIS	Drawn By: JRP/RTN SDB/LLT Checked By: RTN Reviewed By: DJJ	14 APRIL 2004 AS SHOWN Drawing Code: ep81 Specification Number: W122K-04-R-0003
--	---	--

POOL 11 ISLANDS HABITAT REHABILITATION & ENHANCEMENT PROJECT STAGE 11 - MID LAKE	GATE DETAILS
---	---------------------

Sheet Reference Number C15 Sheet 20 of 20
--

- WATER QUALITY: E. DUBUQUE IL 1979, 1980-1982
GRANT RIVER REC AREA
ISLAND 212
GRANT RIVER MOUTH (FECC)
- POOL 11 AQUATIC VEGETATION TREND ANALYSIS
8/1991
- WATERFOWL INDEX COUNTS 588-1993
1986-1988, 1990 (WDNR)
- MUSSEL SURVEY RM. 583-615 (WDNR)
- GRANT RIVER BASELINE AHAG
- GRANT RIVER BASELINE AHAG

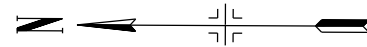
[illegible]



U.S. ARMY CORPS OF ENGINEERS, TRIC ROCK ISLAND, ILL 619015	Drawn By: BLL/SDB/TPD Scale: AS SHOWN Checked By: KGB Reviewed By: DJH	RTN 16 SEP. 2001 Drawing Code: Solicitation Number:
---	---	--

**POST - CONSTRUCTION
MONITORING PLAN**





LATE 17

LATE 42

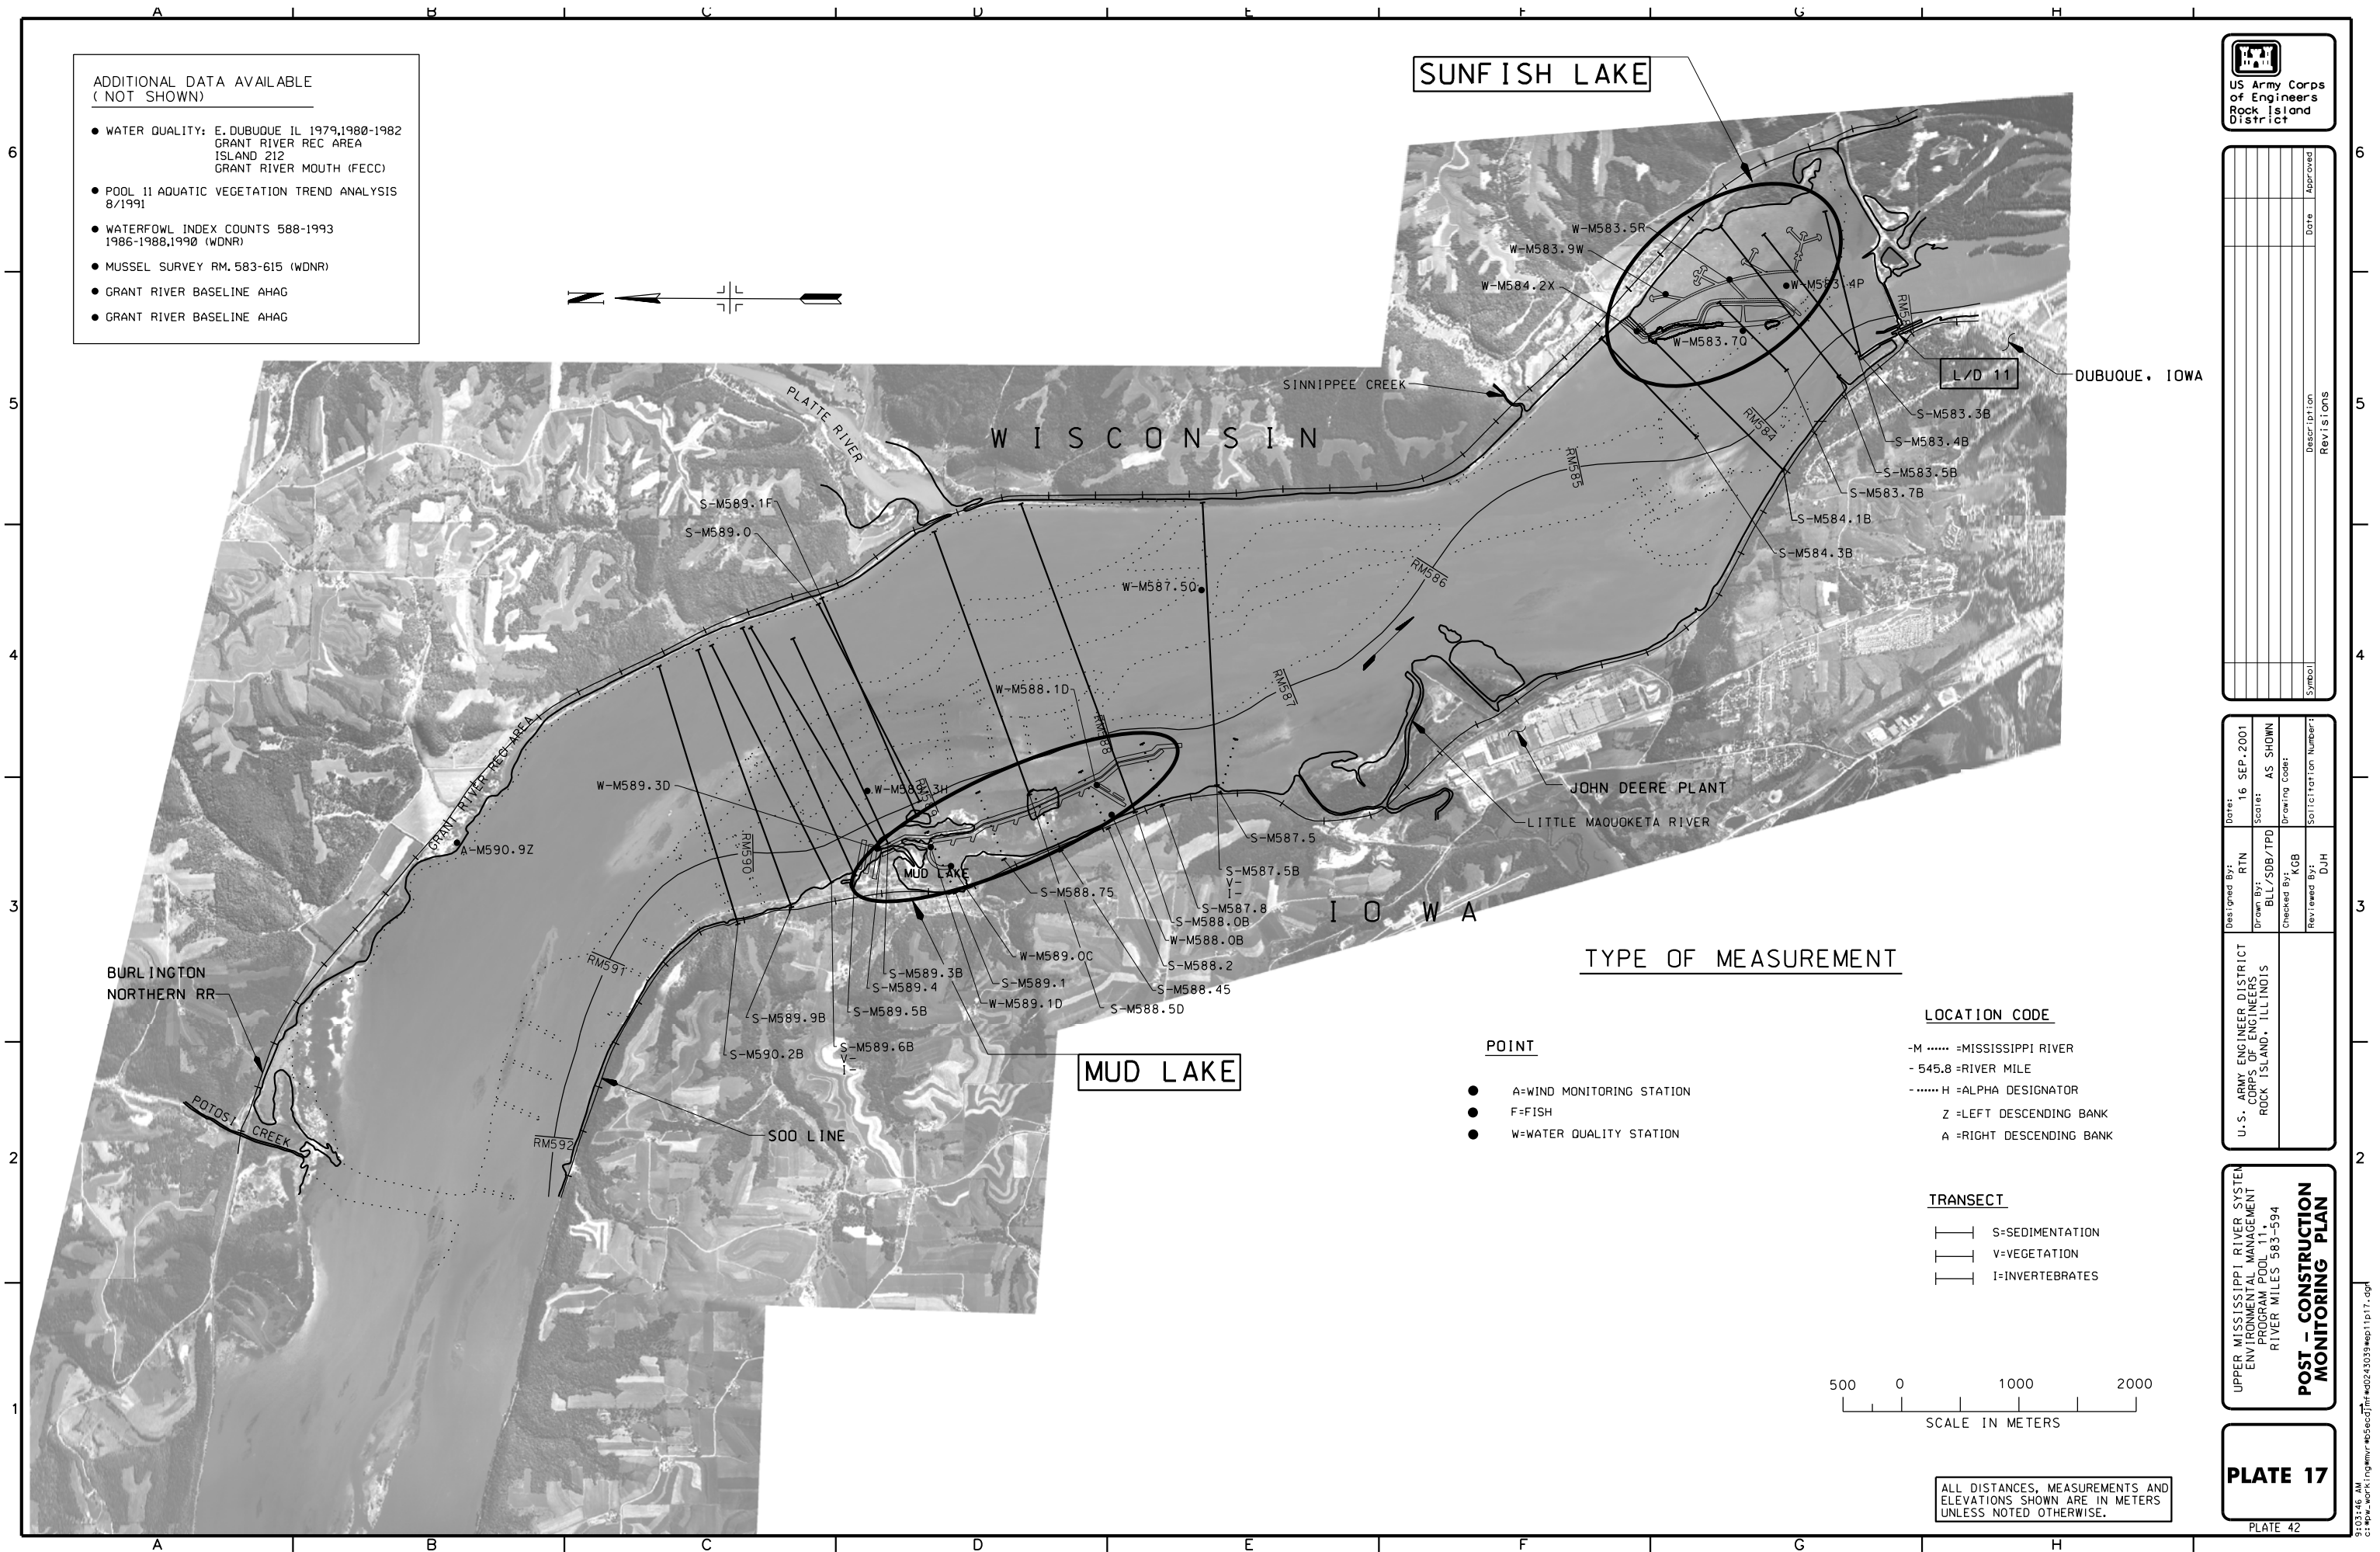

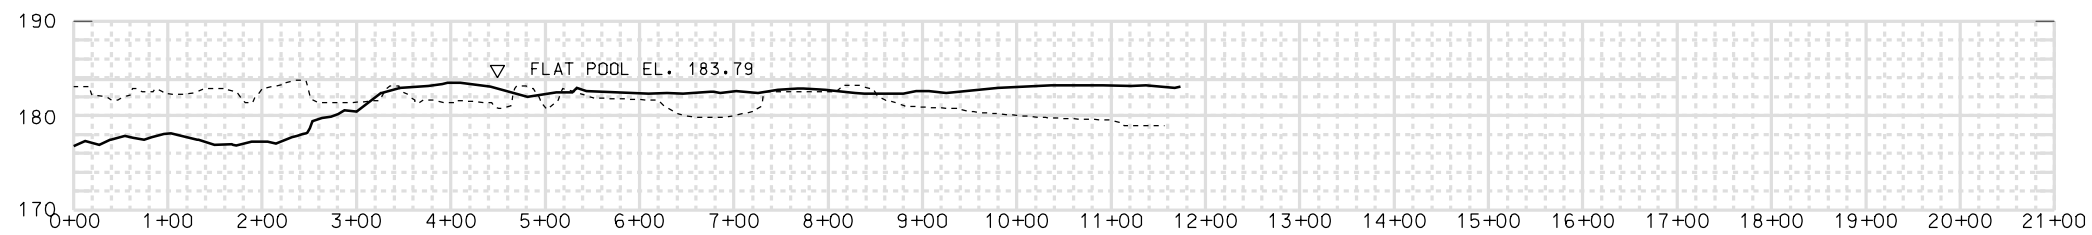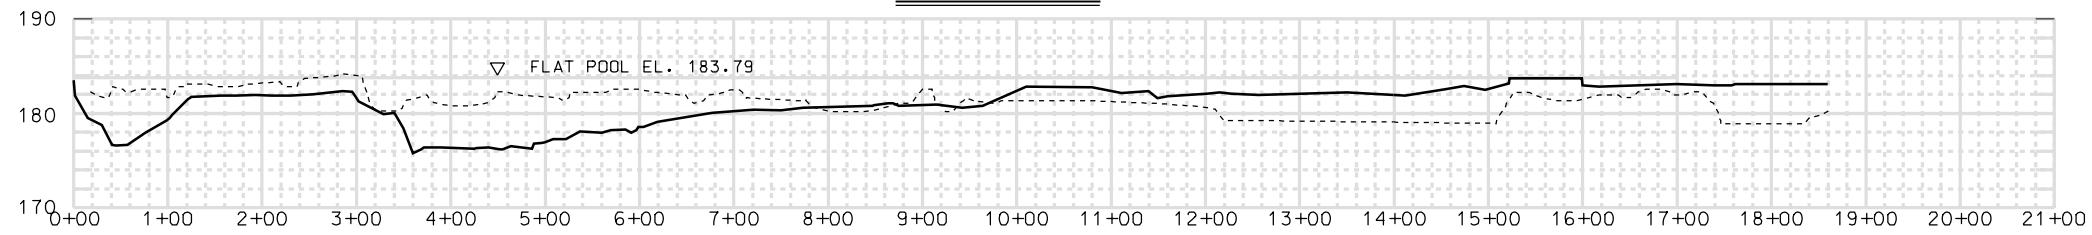S-M 584.3

S-M 584.1

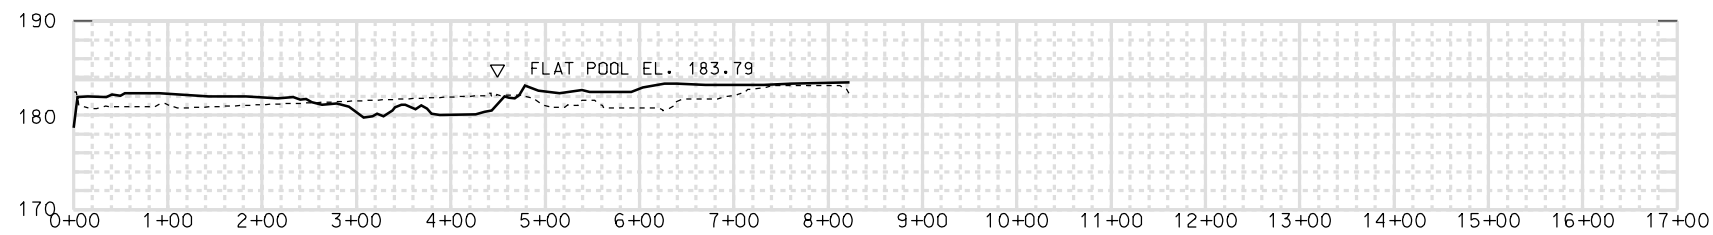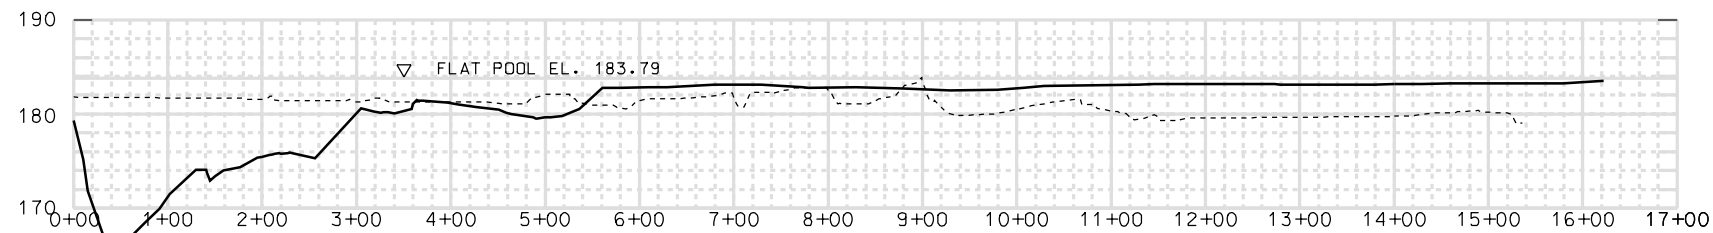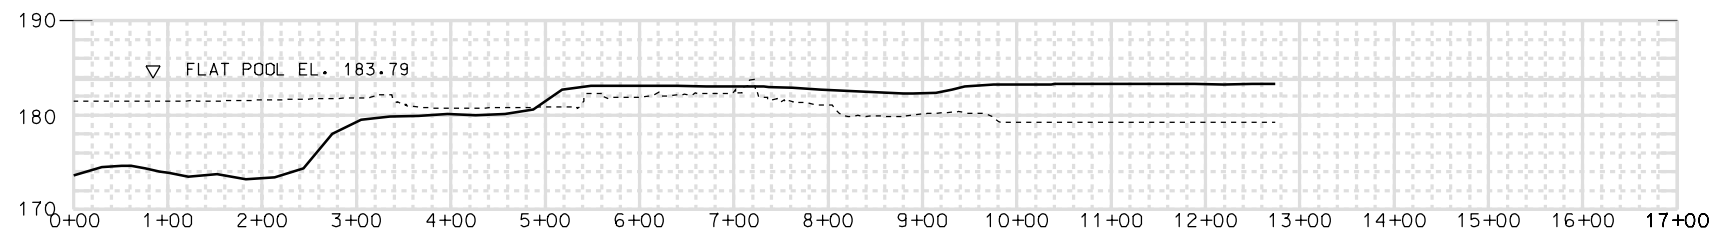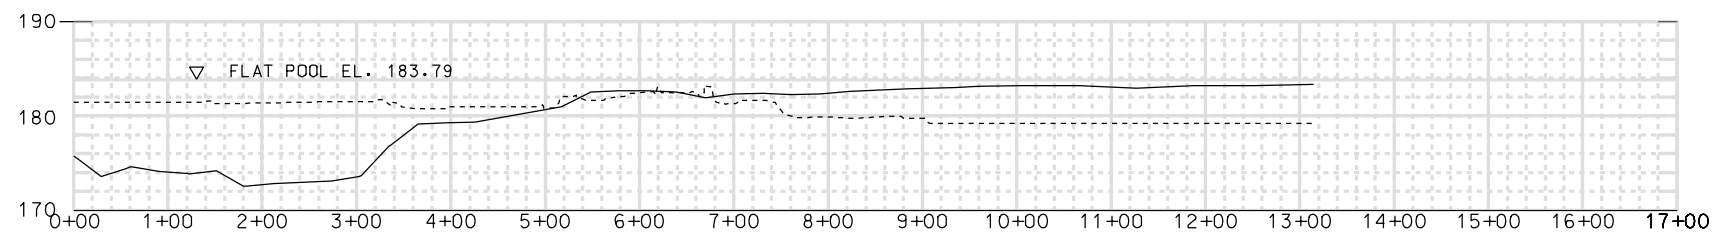S-M 583.7S-M 583.5S-M 583.4

S-M 583.3

IOWA

WISCONSIN

[illegible]

U.S. ARMY ENGINEER DISTRICT CORPS OF ENGINEERS ROCK ISLAND, ILLINOIS	Designed by: RTN	Date: 16 SEP. 2001
	Drawn by: SOB/TPD	Scale: AS SHOWN
	Checked by: KJGB	Drawing Code:
	Reviewed by: DUH	SDI Traction Number:

UPPER MISSISSIPPI RIVER SYSTEM
ENVIRONMENTAL MANAGEMENT
PROGRAM POOL 11.
RIVER MILES 583-594

**SUNFISH LAKE
TRANSECTS**






PLATE 18
PLATE 43

LEGEND

————— GENERATED FROM 1990's DATA
----- GENERATED FROM 1938 DATA

----- GENERATED FROM 1938 DATA

ALL DISTANCES, MEASUREMENTS AND ELEVATIONS SHOWN ARE IN METERS UNLESS NOTED OTHERWISE.

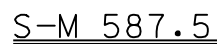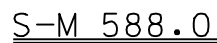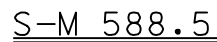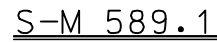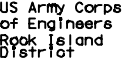

IOWA

————— GENERATED FROM 1990'S DATA

ALL DISTANCES, MEASUREMENTS AND ELEVATIONS SHOWN ARE IN METERS UNLESS NOTED OTHERWISE.







[illegible]

U.S. ARMY ENGINEER DISTRICT CORPS OF ENGINEERS ROCK ISLAND, ILLINOIS	Designed By: RTN	16 SEP. 2001
	Drawn By: SDB/TPD	Social: AS SHOWN
	Checked By: KGB	Drawing Code:
	Reviewed By: J.H	Scale/Title/Number:

UPPER MISSISSIPPI RIVER SYSTEM
ENVIRONMENTAL MANAGEMENT
PROGRAM POOL 11.
RIVER MILES 583-594

PLATE 19
PLATE 44

12-OCT-2001 06:52
a: *projects*ep11*ep11p19.dgn

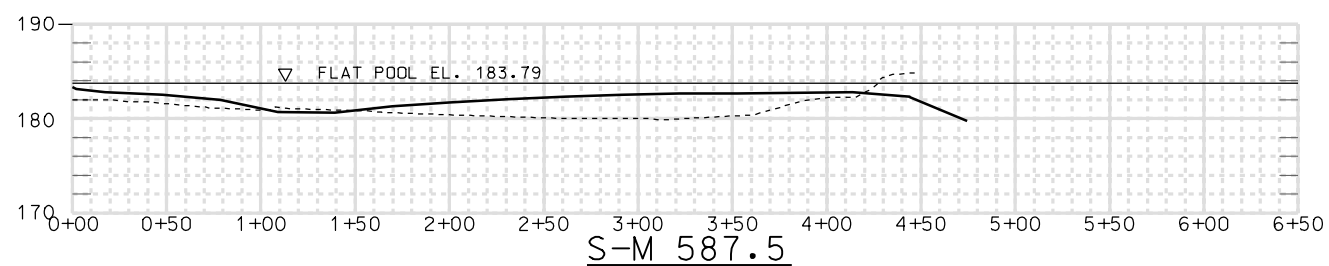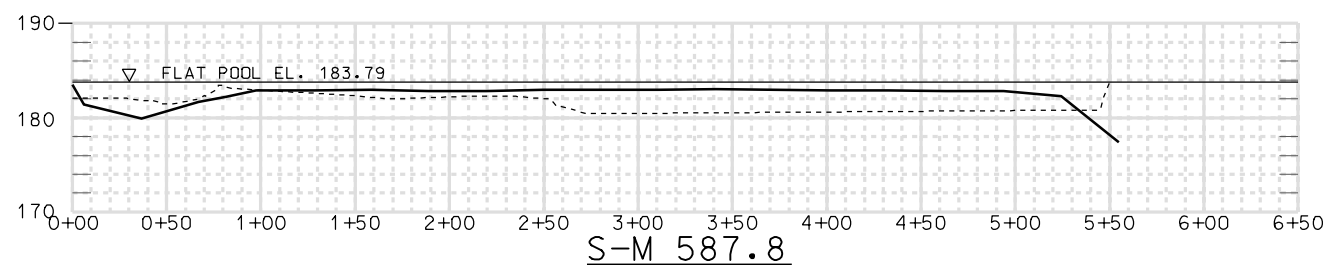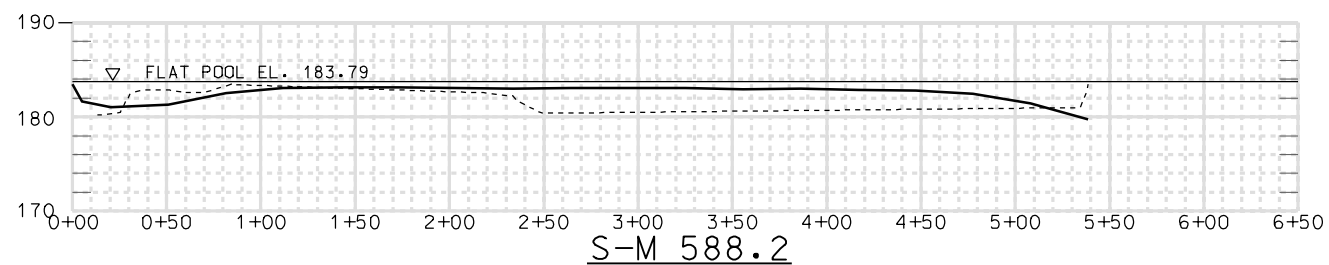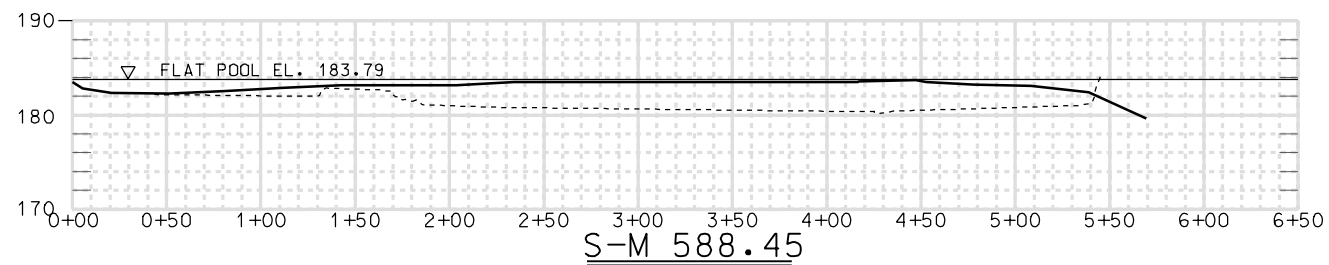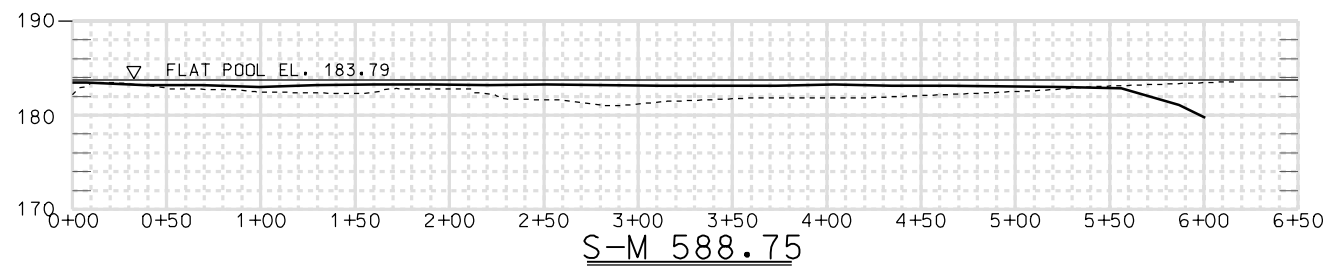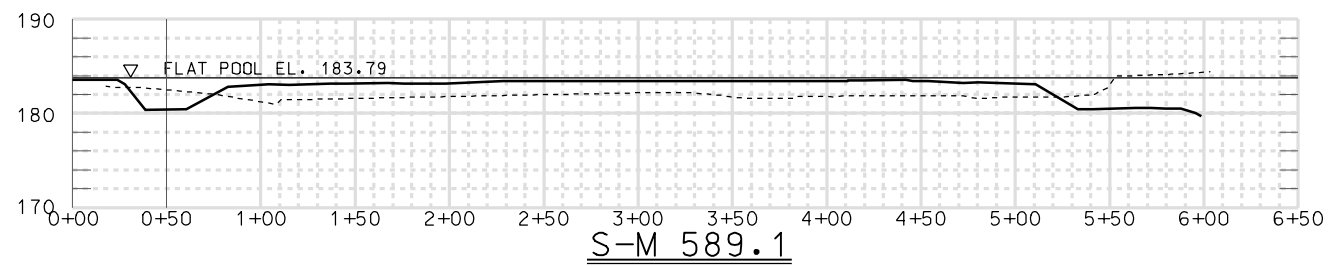

IOWA

WISCONSIN

[illegible]

U.S. ARMY ENGINEER DISTRICT CORPS OF ENGINEERS ROCK ISLAND, ILLINOIS	Drawn By: RTN	Issue Date: 16 SEP. 2001
	TPD/SDB	Scale: AS SHOWN
	Checked By: KIM	Drawing Code:
	Reviewed By: DJH	Substitution Number:

UPPER MISSISSIPPI RIVER SYSTEM
ENVIRONMENTAL MANAGEMENT
PROGRAM POOL 11.
RIVER MILES 583-594

MUD LAKE TRANSECTS

PLATE 20
PLATE 45

LEGEND

— GENERATED FROM 1997 DATA

----- GENERATED FROM 1938 DATA

ALL DISTANCES, MEASUREMENTS AND ELEVATIONS SHOWN ARE IN METERS UNLESS NOTED OTHERWISE.