




8-11-06	RTN/RAP	Approved
Date	Symbol	Revisions
AS CONSTRUCTED		

Designed By:	RSN	Date:	21 SEP 2002
Drawn By:	SDB	Scale:	AS SHOWN
Checked By:	MEH	Drawing Code:	EP66
Reviewed By:	BAH	Solicitation Number:	DACW25-02-R-0008

U.S. ARMY ENGINEER DISTRICT
CORPS OF ENGINEERS
ROCK ISLAND, ILLINOIS

Sheet
Reference
Number:
PLATE 37




POOL 11 ISLANDS
HABITAT REHABILITATION
& ENHANCEMENT PROJECT
SUNFISH LAKE AND MUD LAKE
MUD LAKE
TYPICAL SECTIONS
A, B AND C

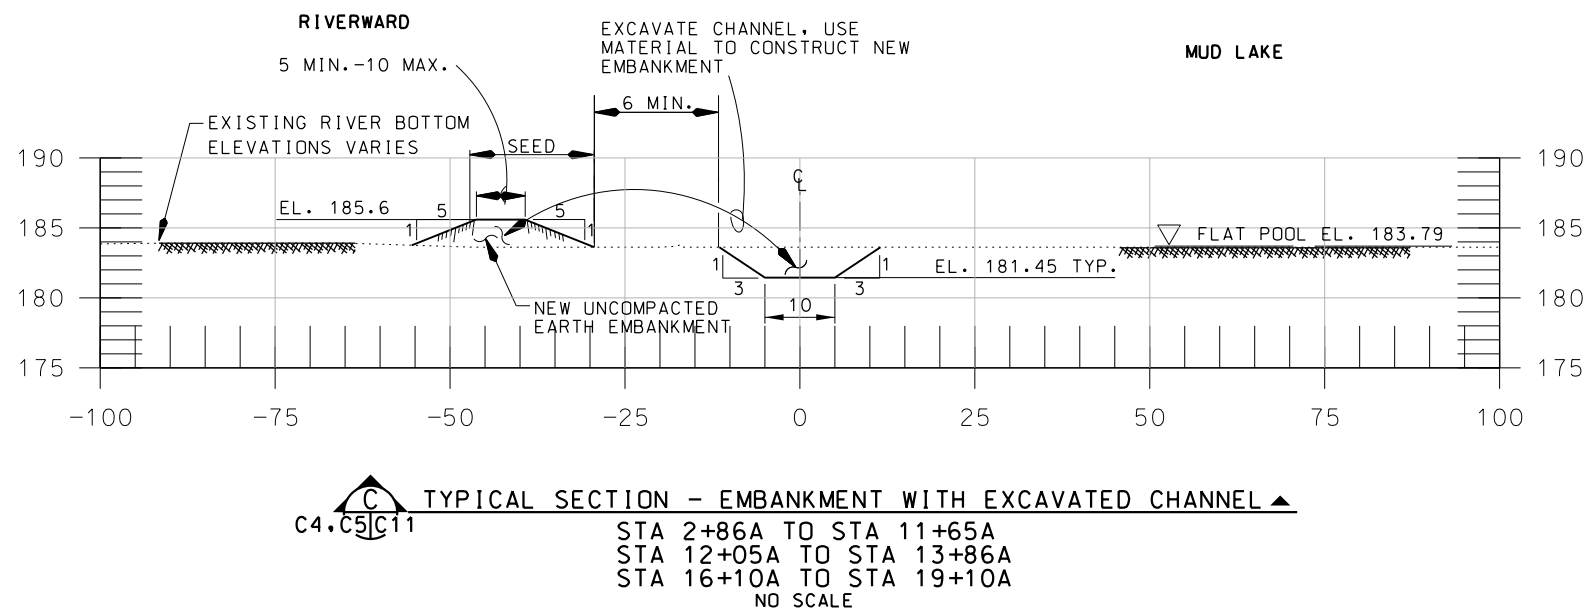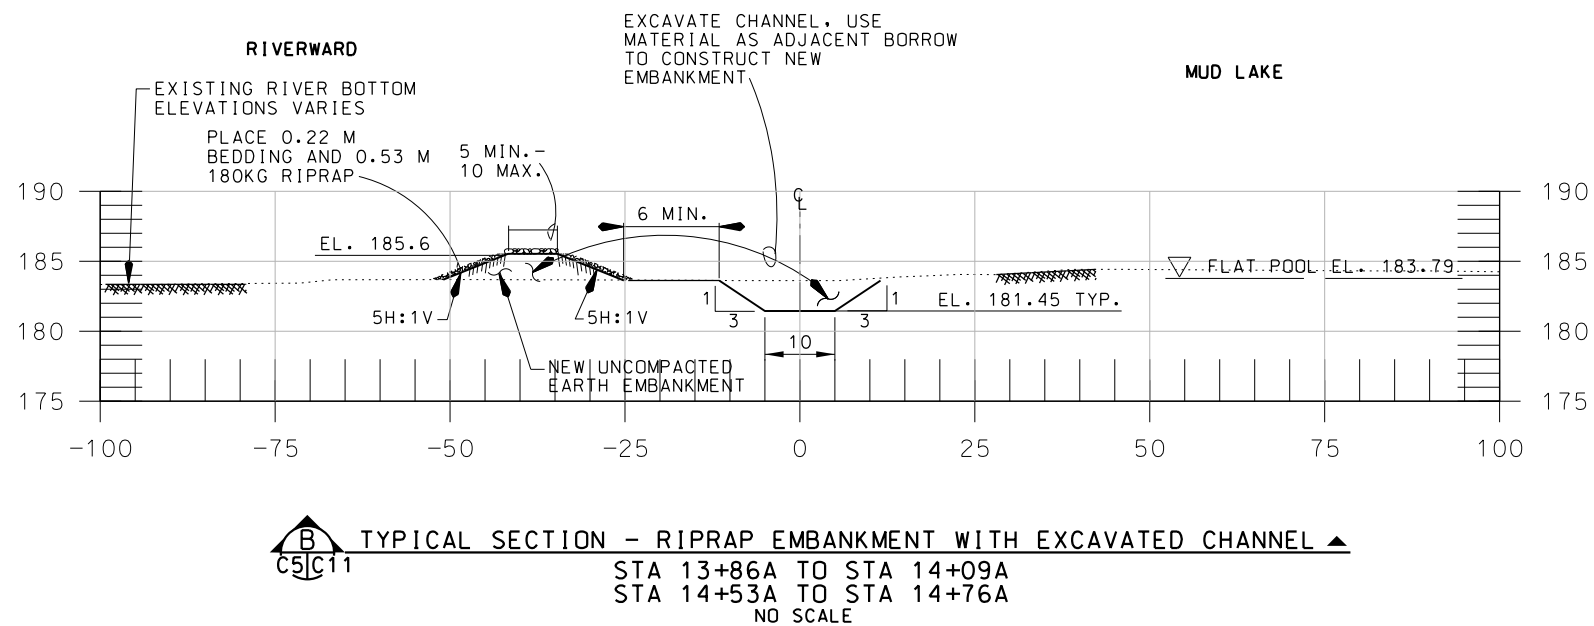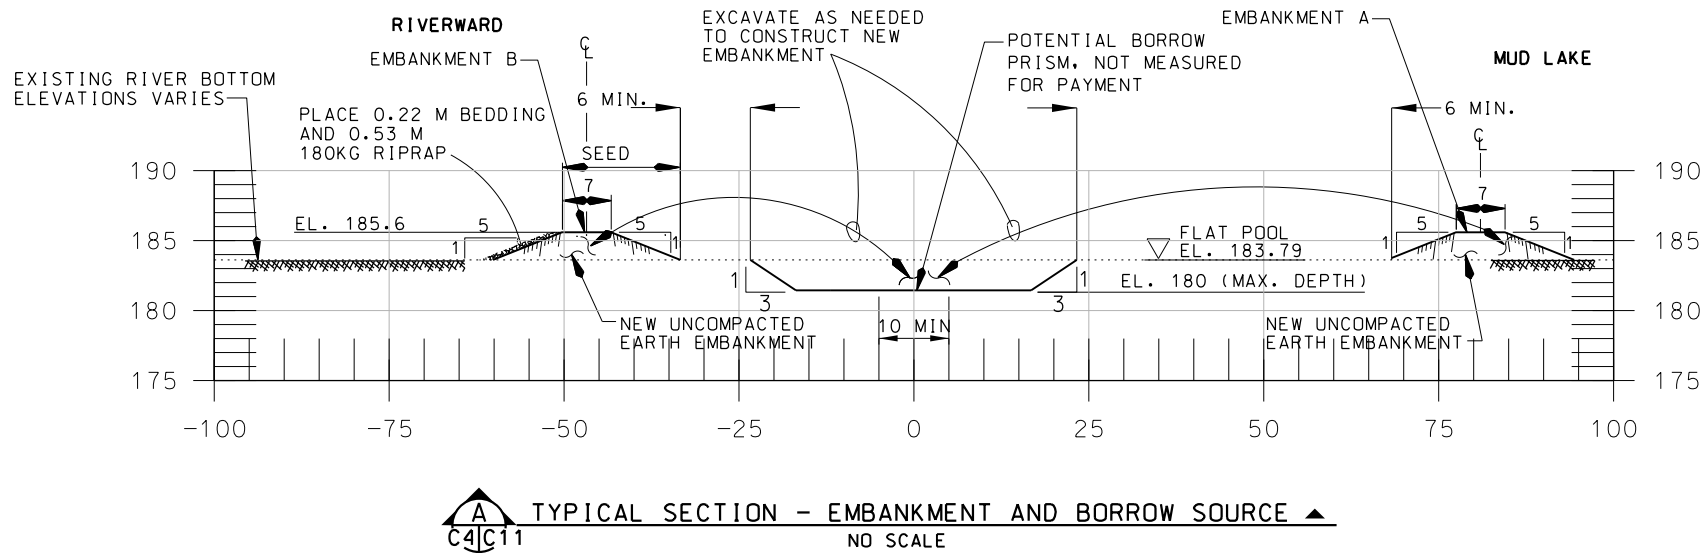

NOTES:

1. ALL SLOPES ON EMBANKMENTS SHALL BE 5 (MIN.) :1.
2. SEEDING SHALL EXTEND TO BOUNDARY OF RIPRAP OR NORMAL WATERLINE.
3. ABOVE ELEVATION 183.79 M, 0.53 M RIPRAP SHALL BE PLACED ON 0.22 M BEDDING STONE.
4. BELOW ELEVATION 183.79 M, 0.65 M RIPRAP SHALL BE PLACED ON 0.35 M BEDDING STONE.

ALL DISTANCES, MEASUREMENTS AND
ELEVATIONS SHOWN ARE IN METERS
UNLESS NOTED OTHERWISE.

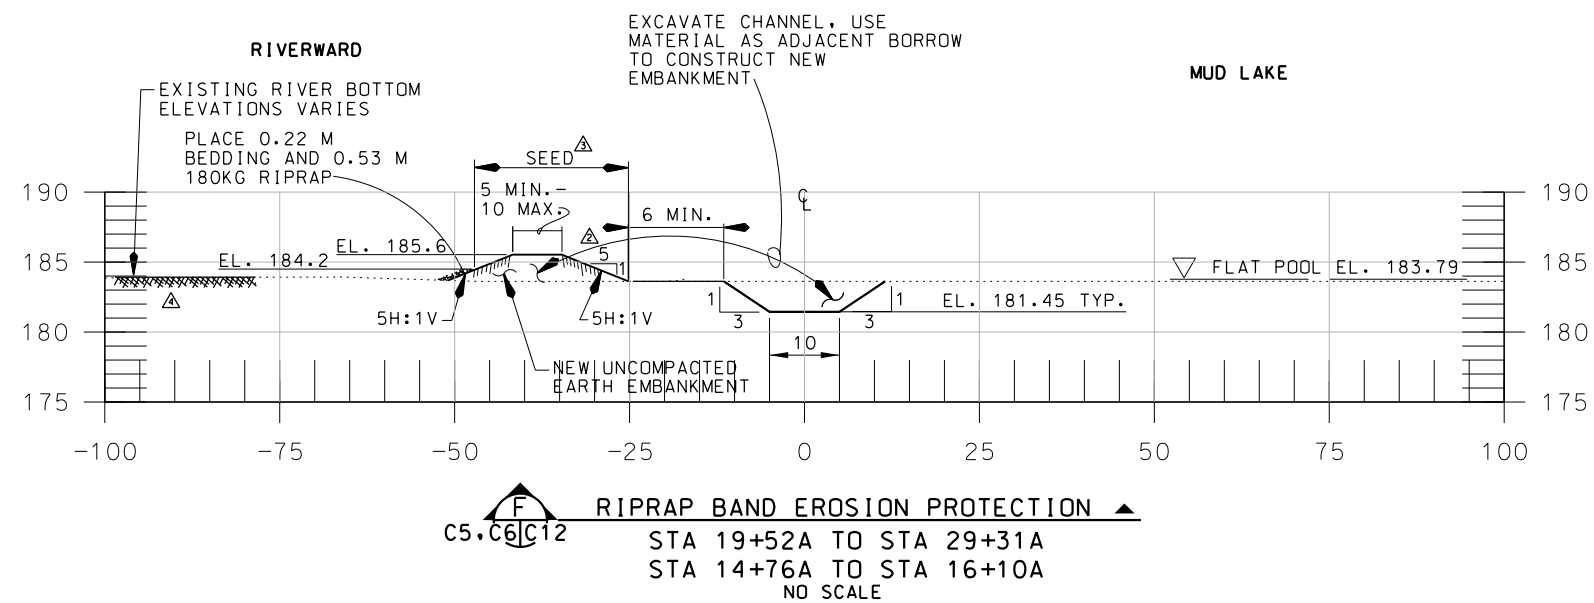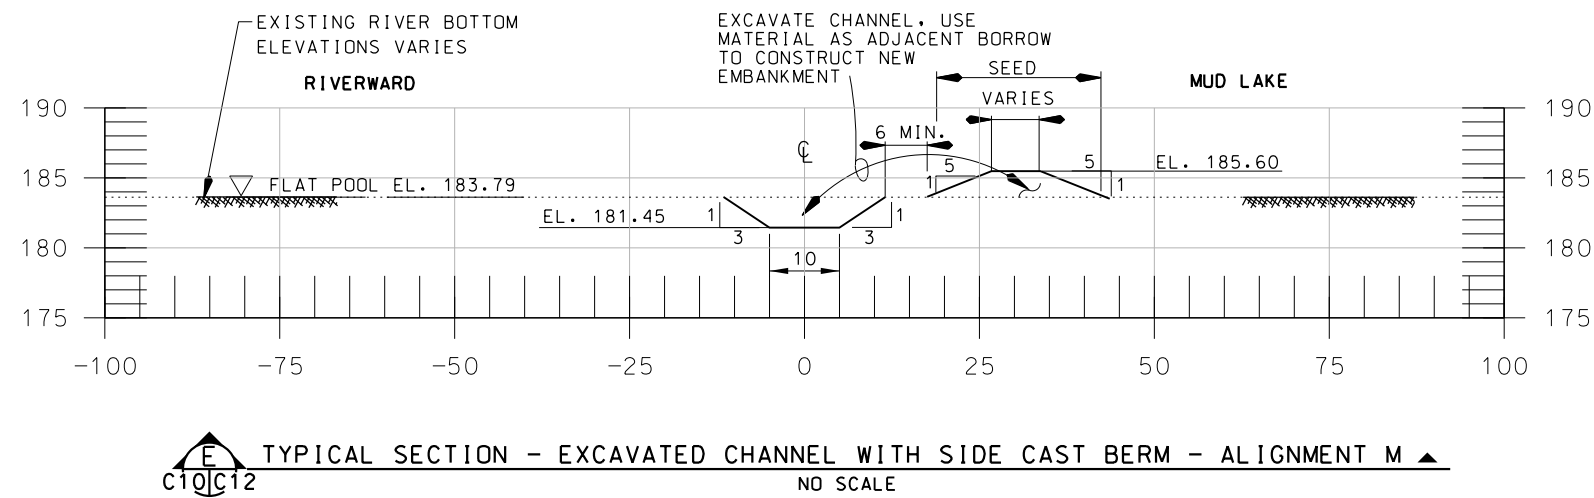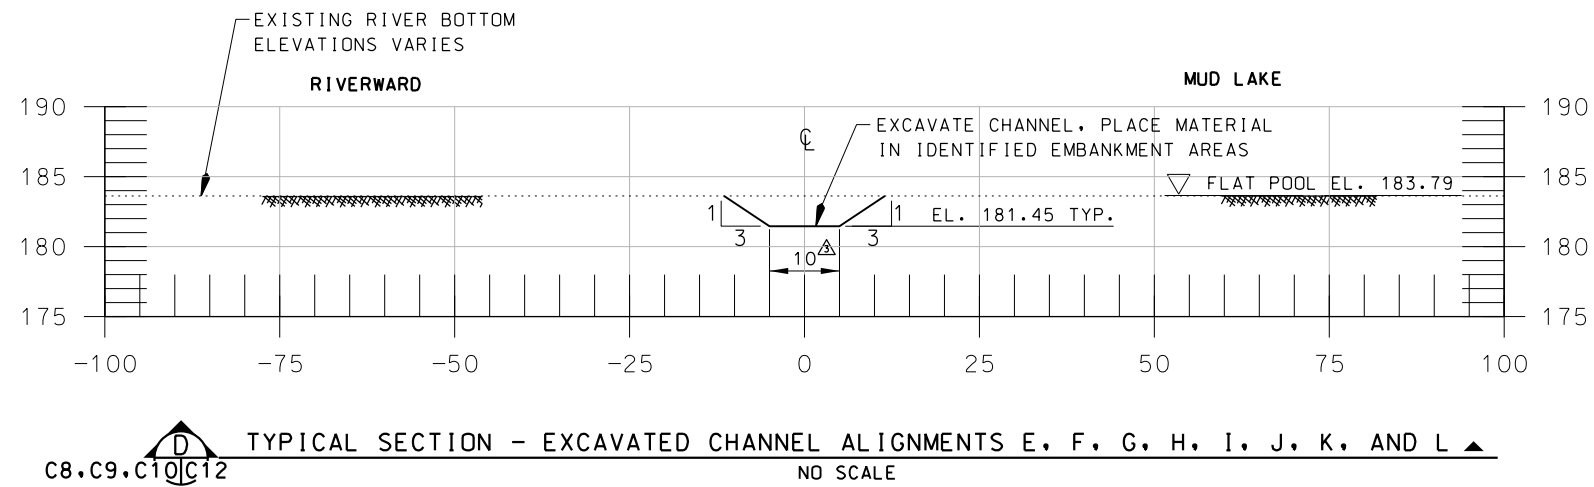

NOTES:

1. ALL SLOPES ON EMBANKMENTS SHALL BE 5 (MIN.) :1.
2. SEEDING SHALL EXTEND TO BOUNDARY OF RIPRAP OR NORMAL WATERLINE.
3. ABOVE ELEVATION 183.79 M, 0.53 M RIPRAP SHALL BE PLACED ON 0.22 M BEDDING STONE.
4. BELOW ELEVATION 183.79 M, 0.65 M RIPRAP SHALL BE PLACED ON 0.35 M BEDDING STONE.


ALL DISTANCES, MEASUREMENTS AND ELEVATIONS SHOWN ARE IN METERS UNLESS NOTED OTHERWISE.

U.S. ARMY ENGINEER DISTRICT CORPS OF ENGINEERS ROCK ISLAND, ILLINOIS	Designed By:	R5N	Date:	21 SEP 2002
	Drawn By:	SDB	Scale:	AS SHOWN
	Checked By:	MEH	Drawing Code:	EP66
	Reviewed By:	BAH	Solicitation Number:	DACW25-02-R-0008

POOL 11 ISLANDS
HABITAT REHABILITATION
& ENHANCEMENT PROJECT
SUNFISH LAKE AND MUD LAKE
MUD LAKE
TYPICAL SECTIONS
D, E AND F


Sheet
Reference
Number:
PLATE 38

A B C D E F G H

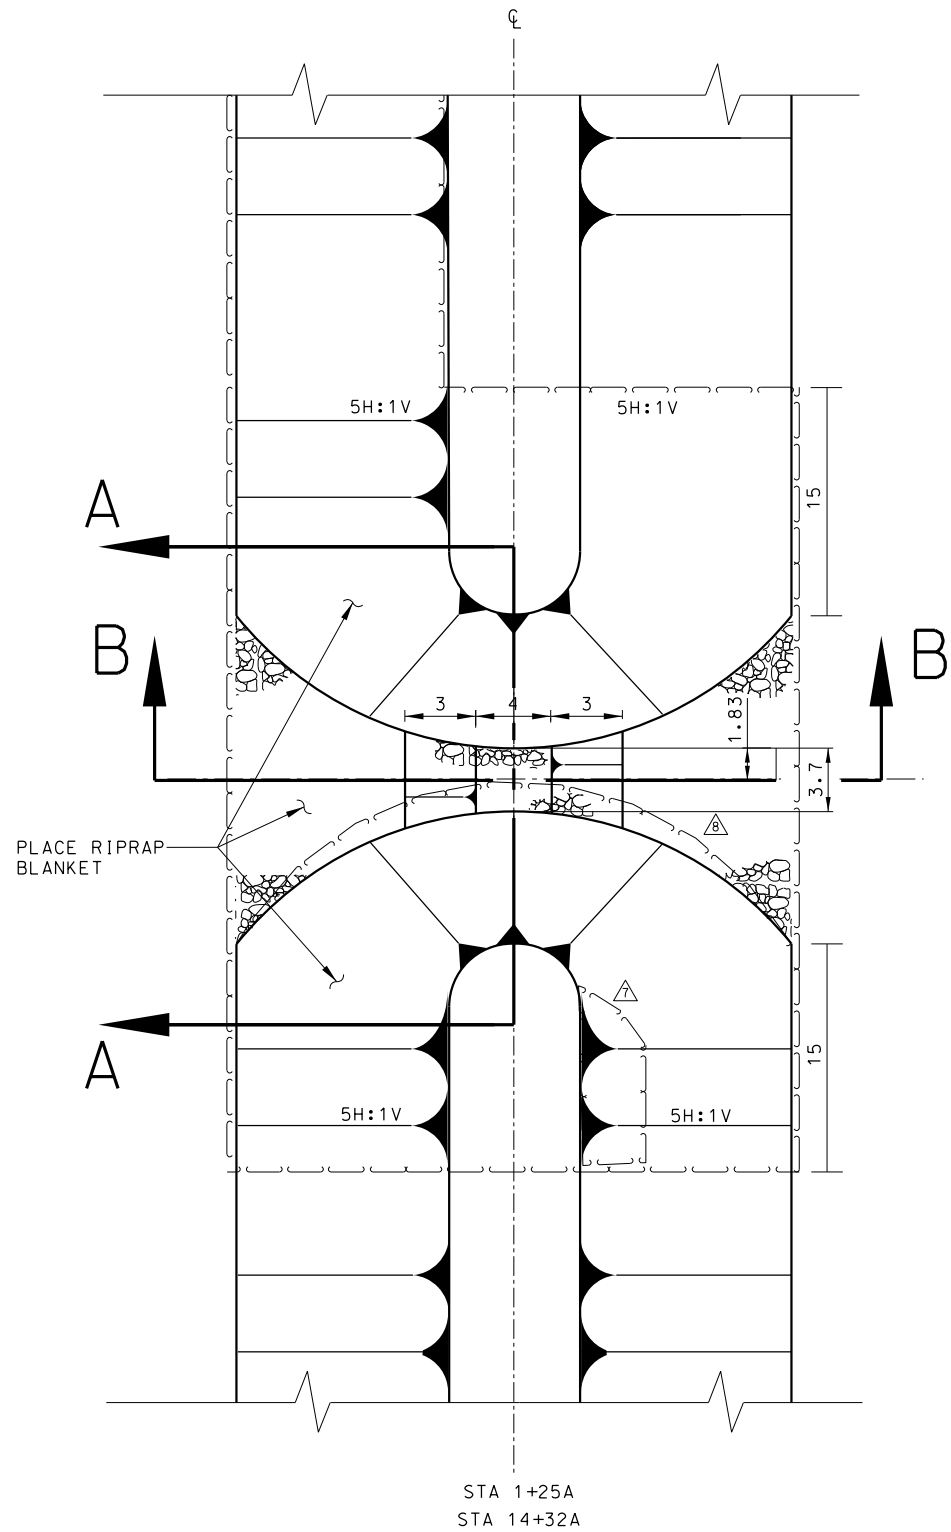


STA 1+25A
STA 14+32A

PLAN VIEW

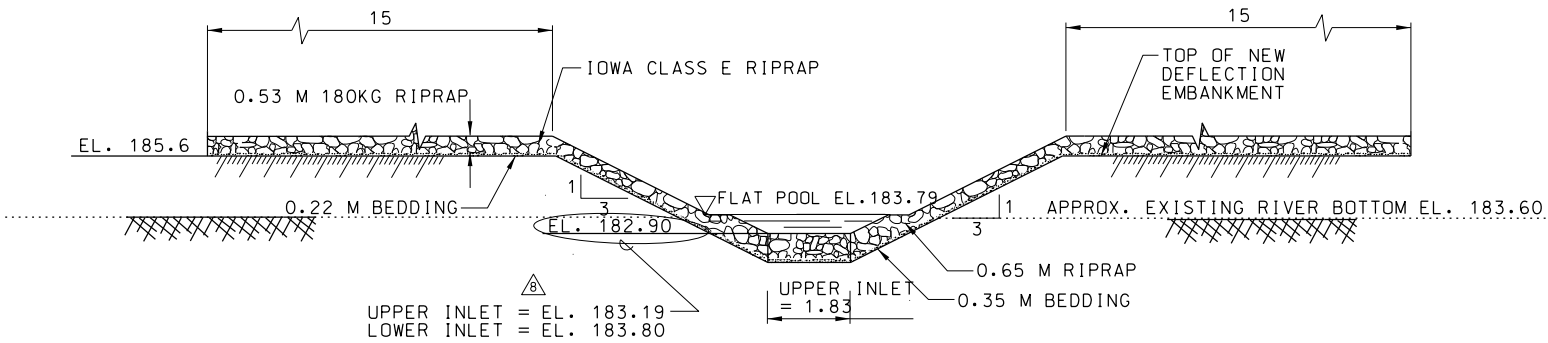

SECTION A-A FLOW INLET SECTION

NO SCALE

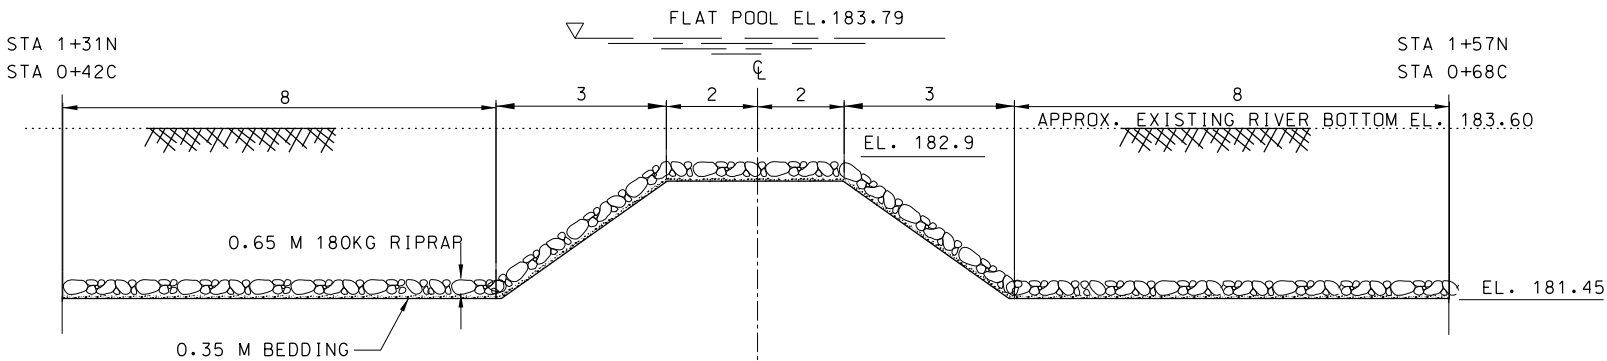

SECTION B-B FLOW INLET SECTION

NO SCALE

NOTES:

1. ABOVE ELEVATION 183.79 M. 0.53 M RIPRAP SHALL BE PLACED ON 0.22 M BEDDING STONE.
2. BELOW ELEVATION 183.79 M. 0.65 M RIPRAP SHALL BE PLACED ON 0.35 M BEDDING STONE.

ALL DISTANCES, MEASUREMENTS AND ELEVATIONS SHOWN ARE IN METERS UNLESS NOTED OTHERWISE.




Symbol	Description	Revisions
AS CONSTRUCTED	AS SHOWN	AS SHOWN
MOD#66 - ADDITIONAL RIPRAP	MOD#66 - ADDITIONAL RIPRAP	MOD#66 - ADDITIONAL RIPRAP
MOD#7 - RIPRAP STOCKPILE	MOD#7 - RIPRAP STOCKPILE	MOD#7 - RIPRAP STOCKPILE
8-11-06 RTN/RAP	8-11-06 RTN/RAP	8-11-06 RTN/RAP
5-2-06 RTN/RAP	5-2-06 RTN/RAP	5-2-06 RTN/RAP
5-24-06 RTN/RAP	5-24-06 RTN/RAP	5-24-06 RTN/RAP
Date	Date	Date
Approved	Approved	Approved

U.S. ARMY ENGINEER DISTRICT CORPS OF ENGINEERS ROCK ISLAND, ILLINOIS	Designed By: RTN Drawn By: SDB Checked By: MJA Reviewed By: DUH	Date: 21 SEP 2002 Scale: AS SHOWN Drawing Code: EP66 Solicitation Number: DACW25-02-R-0008
--	--	---

POOL 11 ISLANDS
HABITAT REHABILITATION
& ENHANCEMENT PROJECT
SUNFISH LAKE AND MUD LAKE
TYPICAL FLOW
INLET DETAILS

Sheet
Reference
Number:
PLATE 40

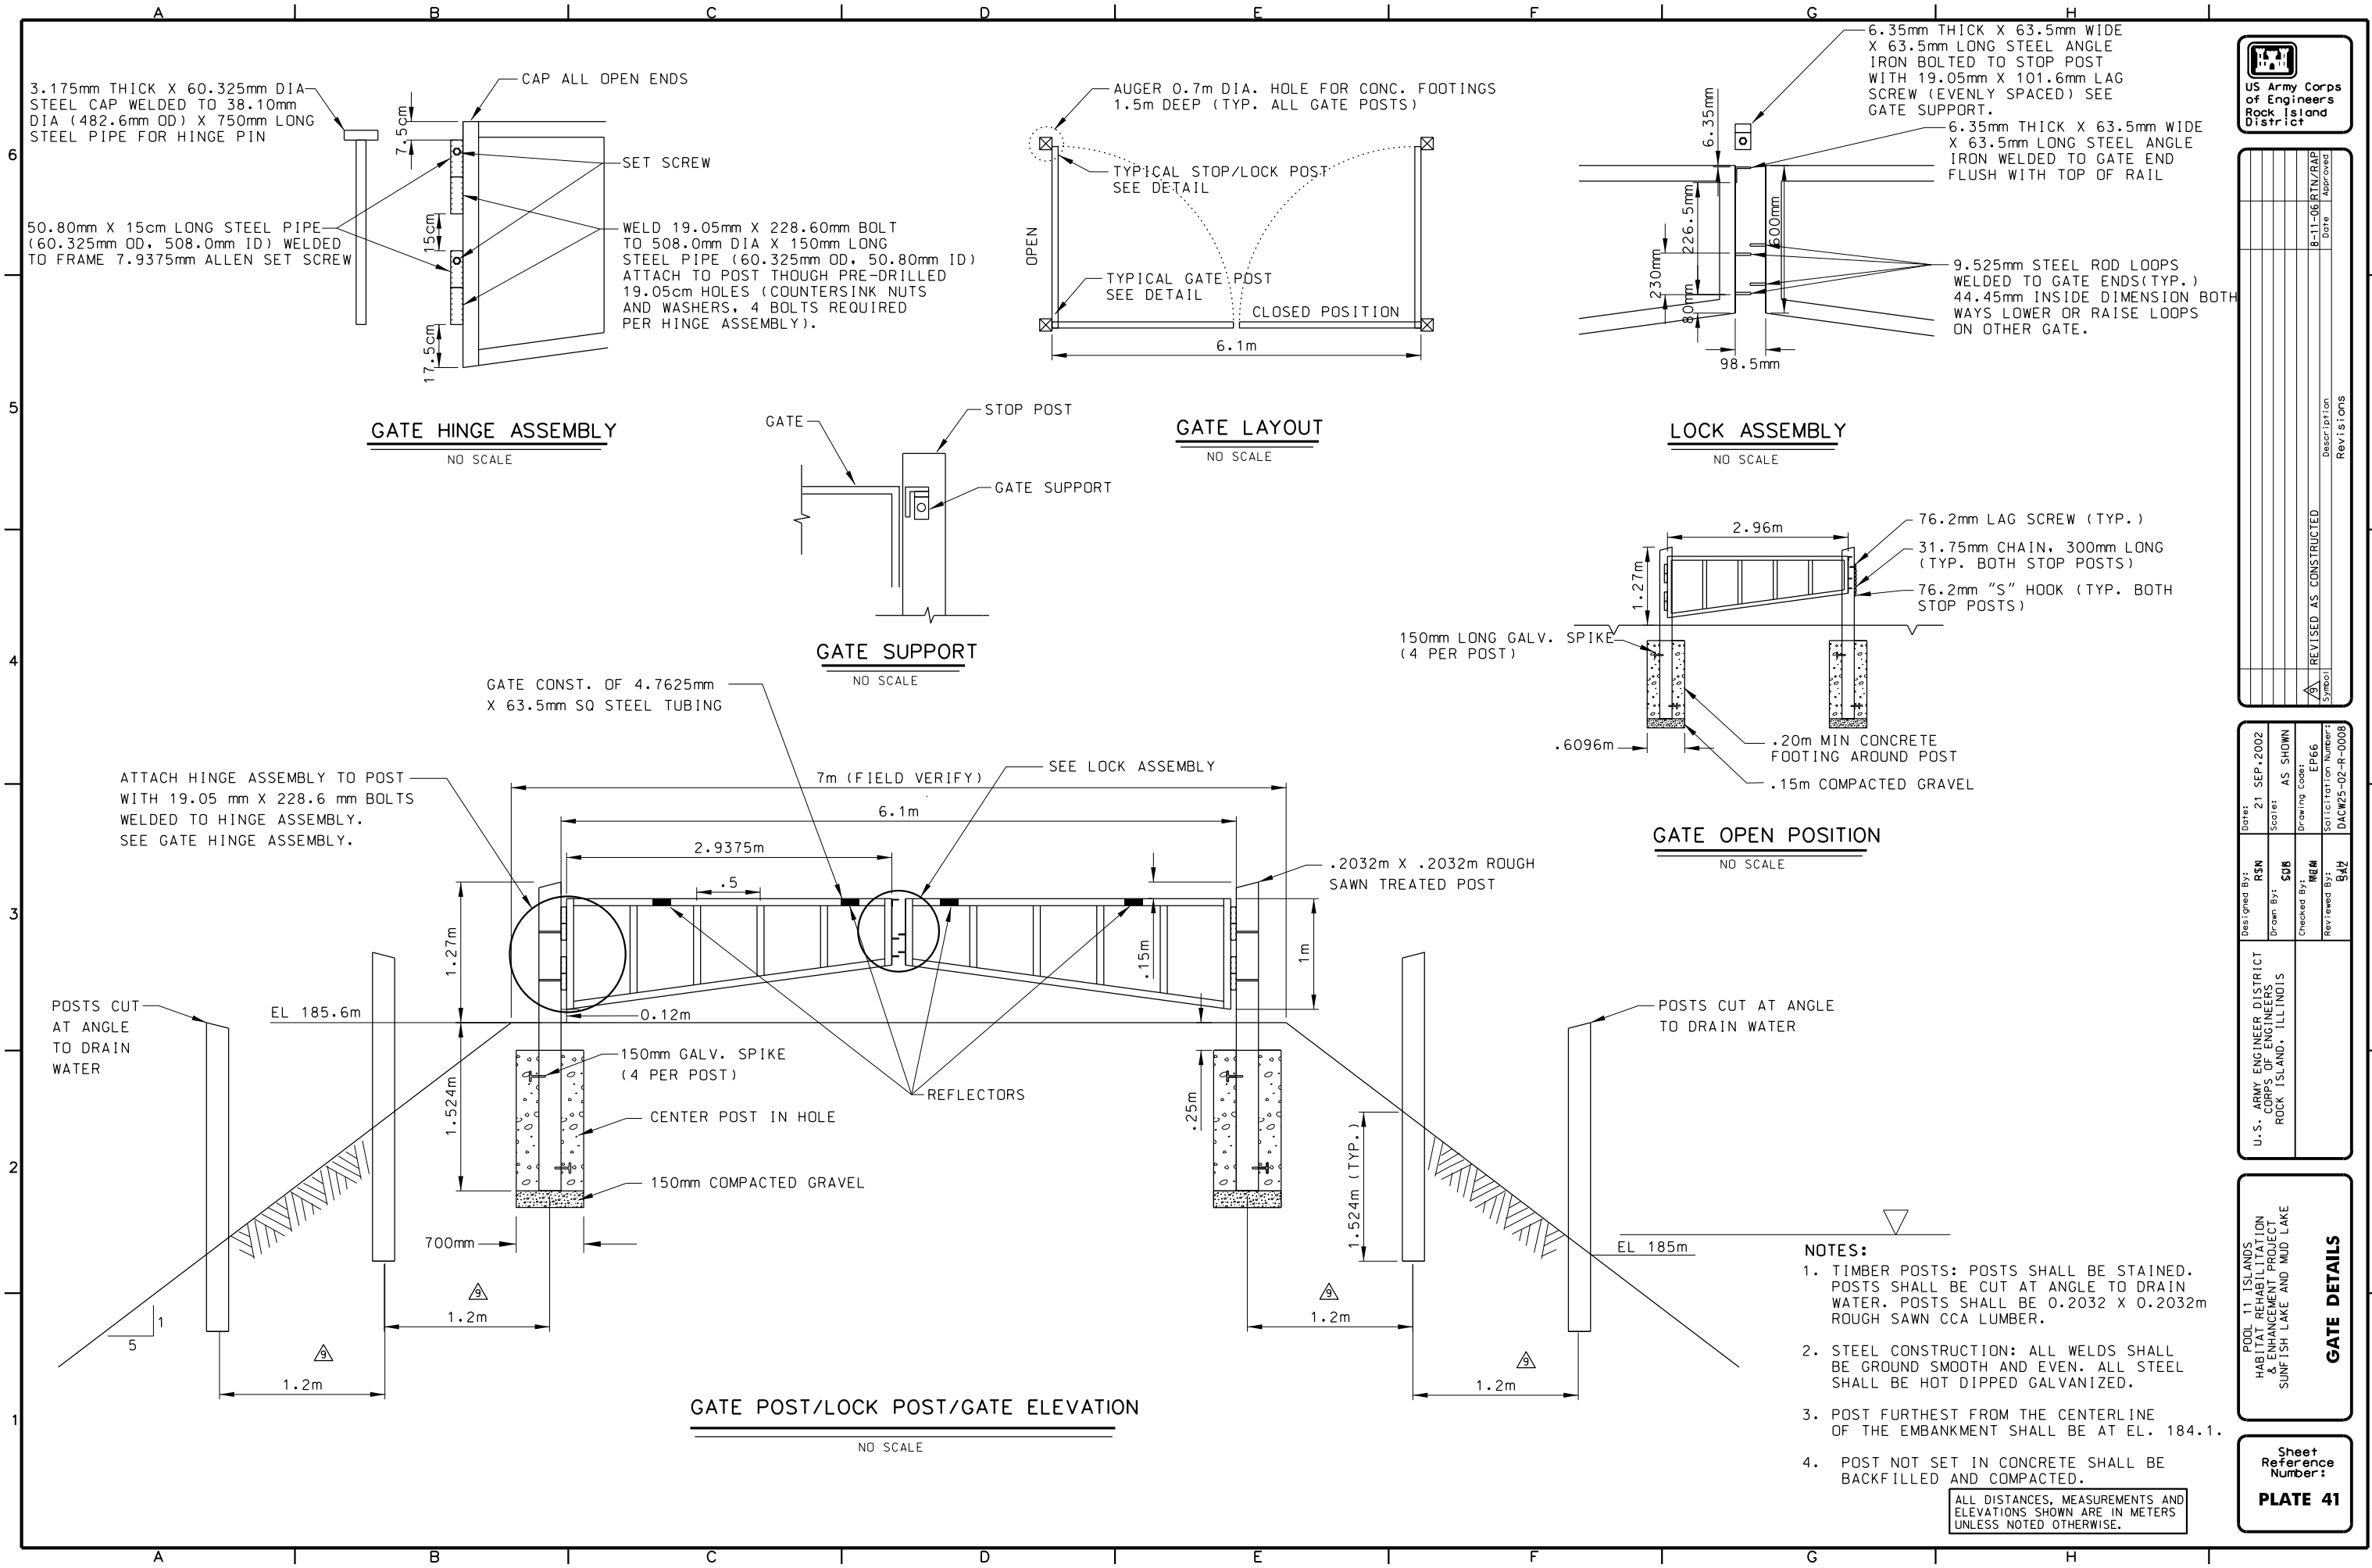





Symbol	Revised As Constructed	Date	Approved
A	REVISED AS CONSTRUCTED	8-11-06 RTN/RAP	

U.S. ARMY ENGINEER DISTRICT CORPS OF ENGINEERS ROCK ISLAND, ILLINOIS	Designed By: RSN Drawn By: SDB Checked By: MIM Reviewed By: BAH	Date: 21 SEP 2002 Scale: AS SHOWN Drawing Code: EP66 Solicitation Number: DACW25-02-R-0008
--	--	---

POOL 11 ISLANDS
HABITAT REHABILITATION
& ENHANCEMENT PROJECT
SUNFISH LAKE AND MUD LAKE

GATE DETAILS

Sheet
Reference
Number:
PLATE 41

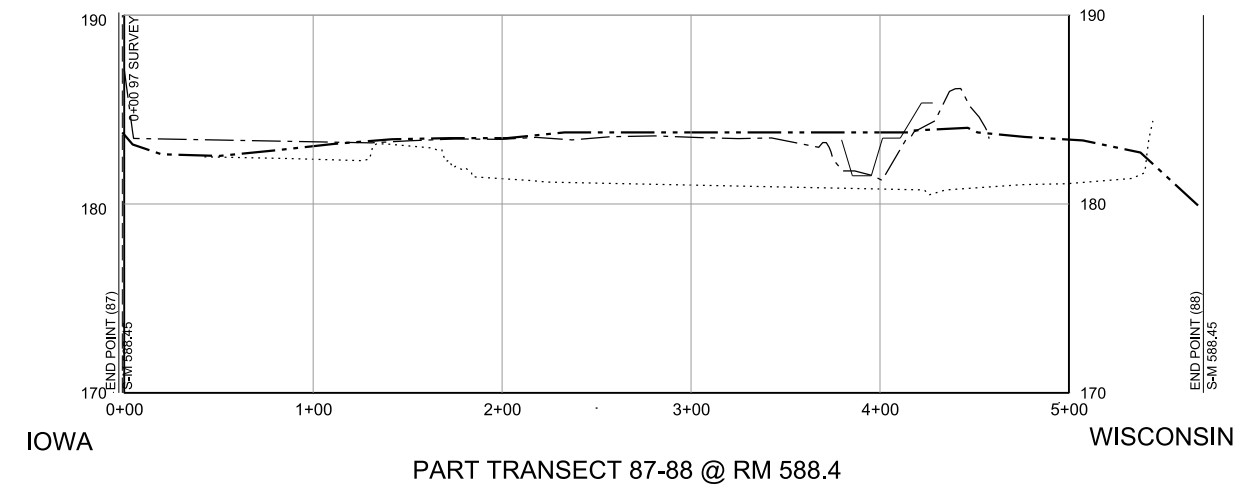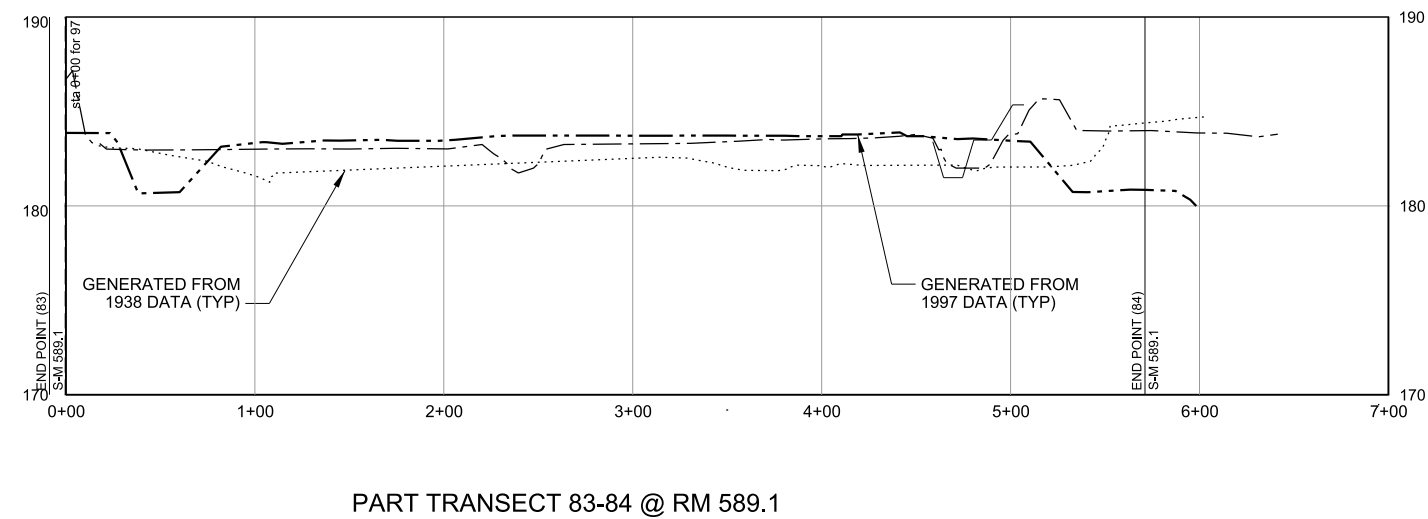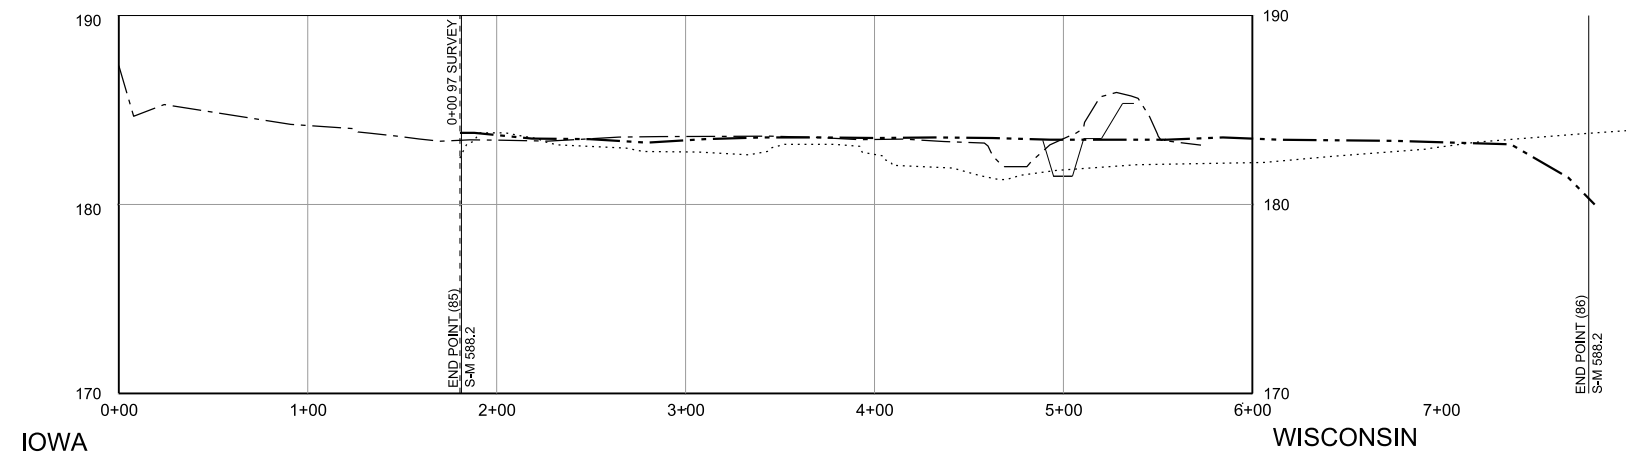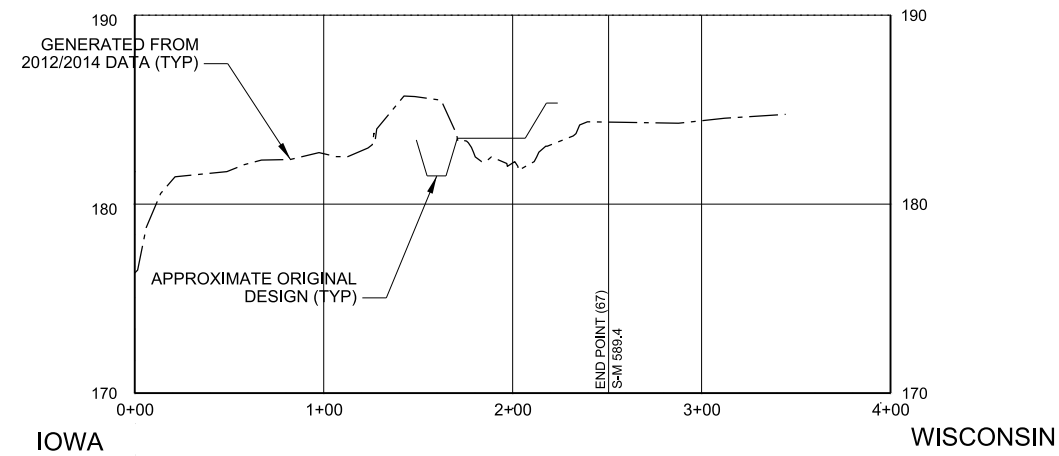

_____ APPROXIMATE ORIGINAL DESIGN
 - . - . - . GENERATED FROM 2012/2014 DATA
 — .. — — — — GENERATED FROM 1997 DATA
 - - - - - - - - - - GENERATED FROM 1938 DATA





[illegible]

| | | |
|---|---------------|-------------------|
| U.S. ARMY CORPS OF ENGINEERS
ROCK ISLAND DISTRICT
ROCK ISLAND, ILLINOIS | DESIGNED BY: | DATE: |
| | OWN BY: | SOLICITATION NO.: |
| | U.I.H. | CONTRACT NO.: |
| | SUBMITTED BY: | PROJECT CODE: |
| | H.I.A. | PER |
| | PLOT SCALE: | PILOT DATE: |
| | AS SHOWN | |
| | SIZE: | FILE NAME: |
| | ANSI D | PER C-301 xxx.dgn |

MISSISSIPPI RIVER
POOL 11 ISLAND
DUBUQUE CO. IAGRANT CO. WI
POOL 11 ISLAND PERFORMANCE EVALUATION REPORT

MUD LAKE TRANSECTS

PLATE 09

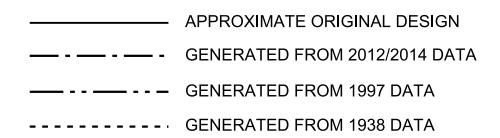
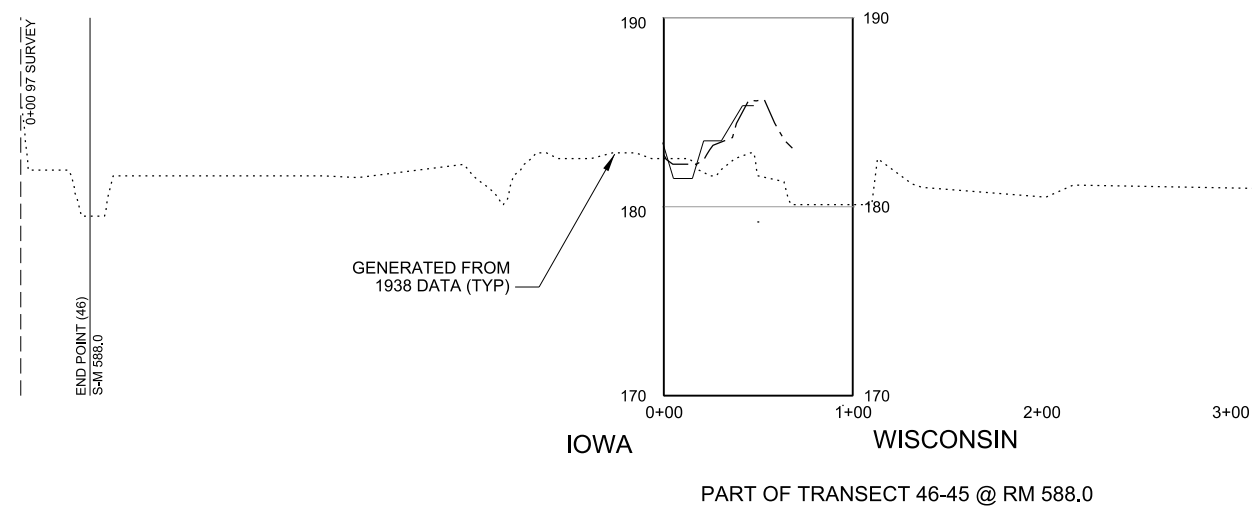
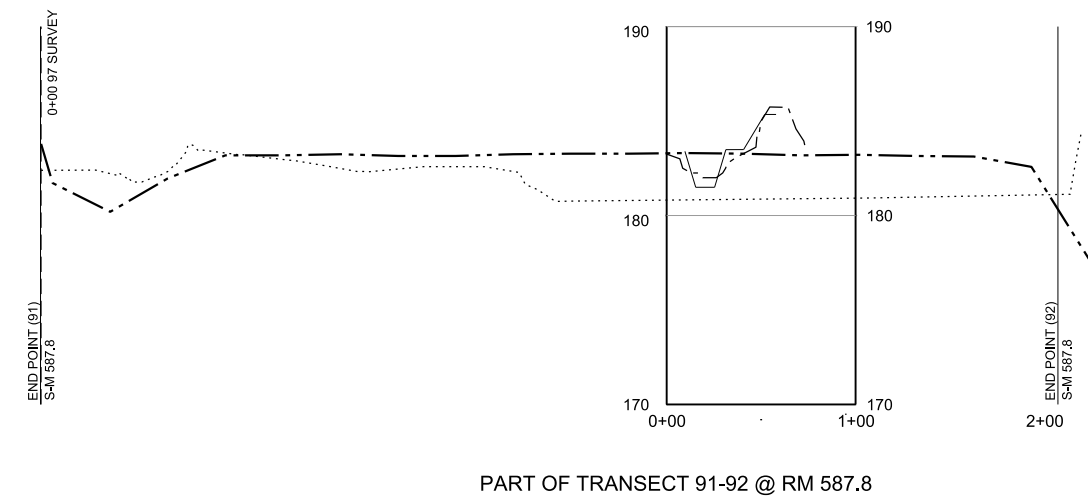
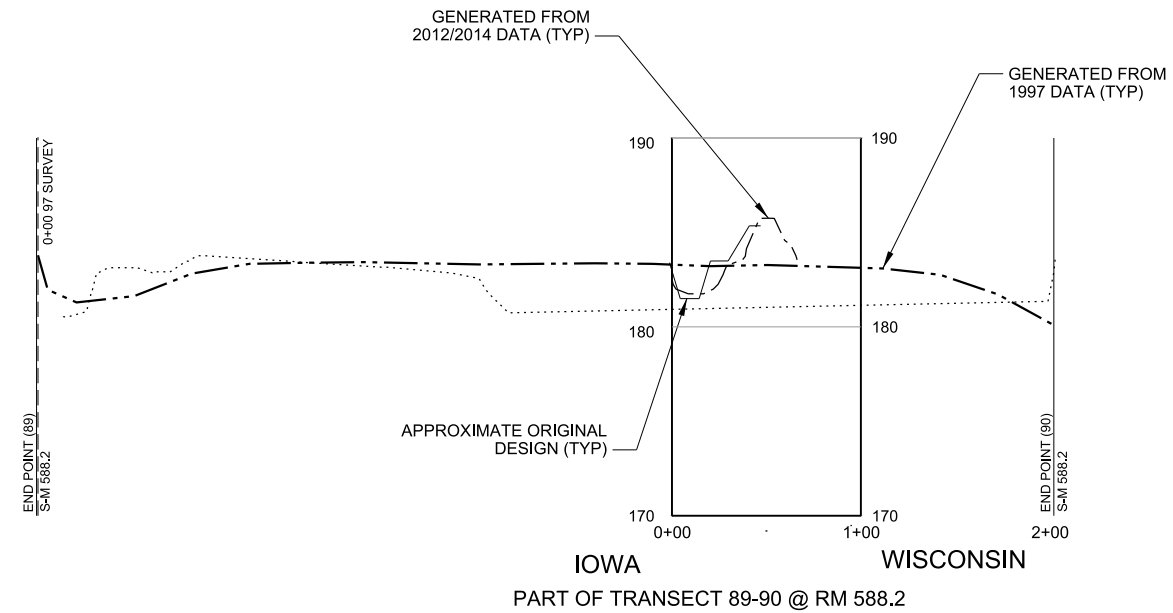
[illegible]

| | | | | |
|---|------|-----------------|------------------|----------------------|
| ROCK ISLAND DISTRICT
ROCK ISLAND, ILLINOIS | ADP1 | DIVN BY:
LLH | CHK BY: | SOLICITATION NO.: |
| | | SUBMITTED BY: | | CONTRACT NO.: |
| | HLA | | | PROJECT CODE:
PER |
| | | AS SHOWN | FILE NAME: | |
| | | ANSI D | SIZE: | |
| | | | PER_C-3020xx.dgn | |

PLATE 10

Sheet
ID
C-302

PLATE 45

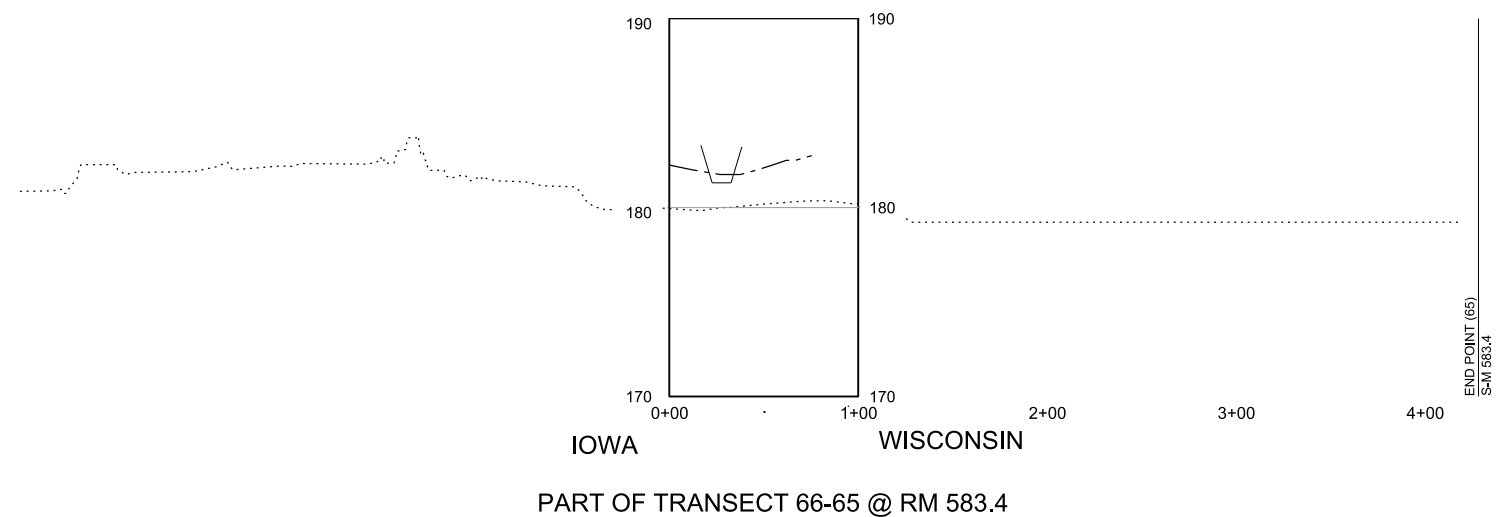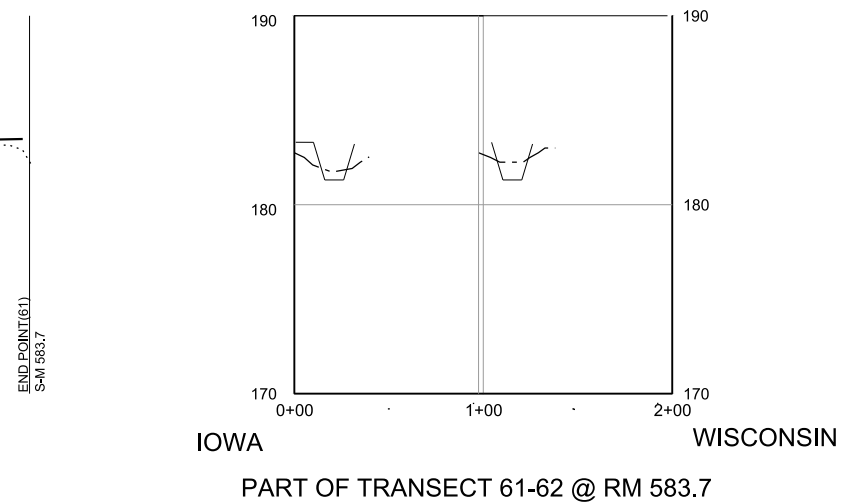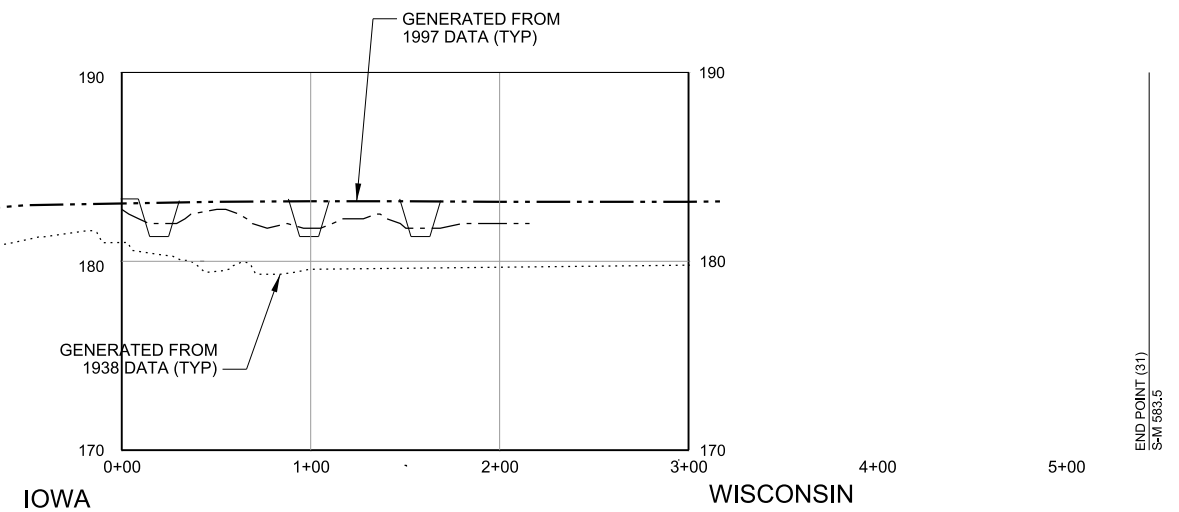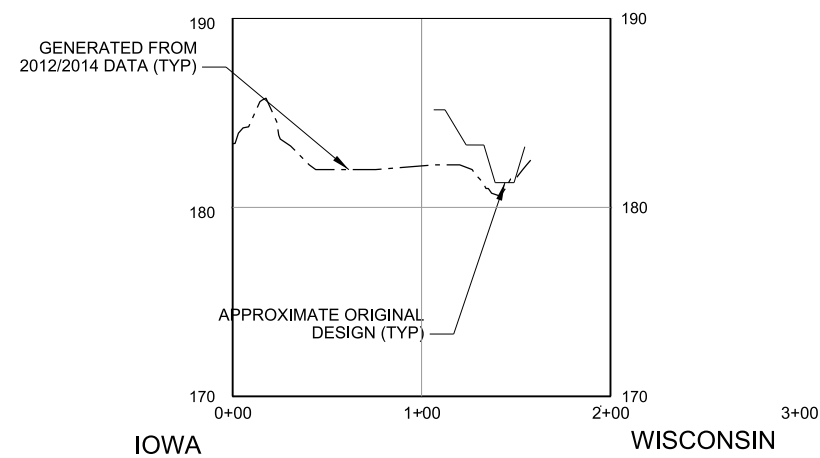

_____ APPROXIMATE ORIGINAL DESIGN
 - . - . - . GENERATED FROM 2012/2014 DATA
 — .. — — — — GENERATED FROM 1997 DATA
 - - - - - - - - - - GENERATED FROM 1938 DATA

[illegible]

| | | | | |
|------|---|----------------------------|------------|----------------------|
| ADP1 | ROCK ISLAND DISTRICT
ROCK ISLAND, ILLINOIS | DIVN BY:
LLH | CKD BY: | SOLICITATION NO.: |
| HLA | | SUBMITTED BY: | | CONTRACT NO.: |
| | | PLOT SCALE:
AS SHOWN | PLOT DATE: | PROJECT CODE:
PER |
| | | SIZE: | FILE NAME: | |
| | | ANSI D
PER_C-303xxx.dgn | | |

POOL 11 ISLAND
DUBUQUE CO, IA/GRANT CO, WI
POOL 11 ISLAND PERFORMANCE EVALUATION REPORT

1171

Sheet
ID
303

PLATE 46