

**MISSISSIPPI RIVER**

**RICE LAKE STATE FISH  
AND WILDLIFE AREA**

**FULTON COUNTY, ILLINOIS**

**U.S. ARMY CORPS OF ENGINEERS  
UPPER MISSISSIPPI RIVER RESTORATION  
HABITAT REHABILITATION AND ENHANCEMENT PROJECT**

---

**OPERATION AND MAINTENANCE  
MANUAL**

---

**SEPTEMBER 2021**



**US Army Corps  
of Engineers®**  
Rock Island District

**RICE LAKE STATE FISH AND WILDLIFE AREA  
UPPER MISSISSIPPI RIVER RESTORATION  
HABITAT REHABILITATION AND ENHANCEMENT PROJECT  
FULTON COUNTY, ILLINOIS**

**SEPTEMBER 2021**

**PREFACE**

This Operation and Maintenance (O&M) manual is for the Rice Lake State Fish and Wildlife Area (SFWA) Upper Mississippi River Restoration (UMRR) Habitat Rehabilitation and Enhancement Project (HREP) located on the LaGrange Pool, Illinois Waterway, River Miles (RM) 132.0 through 138.0 in Fulton County, Illinois. This project was federally constructed and is thus considered a Federal project. This O&M manual has been compiled by the Rock Island District, U.S. Army Corps of Engineers (USACE), to assist local officials in complying with the requirements for operating and maintaining the project.

The O&M manual provides essential operation and maintenance instructions and references to be used by personnel knowledgeable of the project. Inspection of the completed Project is detailed in Section 9, *Maintenance and Inspections*. Inspection guidance for the Illinois Department of Natural Resources (ILDNR) and follow-up corrective action reporting is also provided. Additionally, the O&M manual serves as a reference document containing descriptions of the features involved in the original construction of the project, the construction history, post-construction modifications, a copy of the Project Partnership Agreement (PPA) between the ILDNR and the USACE, and a listing of project points of contact.

Included within this O&M manual are copies of as-built drawings, equipment data to include O&M guidance, and other references related to the Rice Lake SFWA UMRR HREP (Project).

The O&M manual should be periodically updated by the ILDNR to incorporate best professional practices. The O&M manual will only be updated by the USACE following Federal action at the Project. All points of contact, websites and supplier information should be checked and verified on a yearly basis by the ILDNR. Physical modifications and any operational changes impacting the Project must be approved and documented by USACE. A copy of the Project inspections should also be attached to the O&M manual.



**OPERATION AND MAINTENANCE MANUAL**  
**RICE LAKE STATE FISH AND WILDLIFE AREA**  
**UPPER MISSISSIPPI RIVER RESTORATION**  
**HABITAT REHABILITATION AND ENHANCEMENT PROJECT**  
**FULTON COUNTY, ILLINOIS**

**SEPTEMBER 2021**

<b>PREFACE.....</b>	<b>I</b>
<b>1. GENERAL .....</b>	<b>1</b>
1.1. Introduction and Purpose .....	1
1.2. Project Function .....	2
1.3. Project Description .....	2
<b>2. AUTHORIZATION .....</b>	<b>3</b>
<b>3. LOCATION .....</b>	<b>4</b>
<b>4. PERTINENT INFORMATION.....</b>	<b>4</b>
4.1 Hydrology .....	4
4.2. Climate .....	4
<b>5. CONSTRUCTION HISTORY .....</b>	<b>6</b>
5.1. Project Features .....	6
5.2. Project Right of Way Drawings .....	8
5.3. Project Construction .....	8
5.4. Construction Modifications .....	11
5.5. Construction As-Built Drawings .....	12
5.6. Post-Construction Modifications .....	12
5.7. Project Encroachments and Modifications .....	13
<b>6. PROJECT PERFORMANCE .....</b>	<b>13</b>
6.1. Performance Monitoring and Assessment .....	13
6.2. Post-Construction Monitoring .....	13
<b>7. PROJECT PARTNERSHIP AGREEMENT .....</b>	<b>17</b>
<b>8. OPERATION.....</b>	<b>17</b>
8.1. General .....	17
8.2. Overflow Spillway .....	17
8.3. Outlet Structure .....	18
8.4. Pump Station and Control Building .....	18
8.5. Water Control Structures .....	19
<b>9. MAINTENANCE AND INSPECTIONS .....</b>	<b>19</b>
9.1. Maintenance.....	19
9.2. Inspections.....	23

<b>10. REPAIR, REPLACEMENT AND REHABILITATION .....</b>	<b>24</b>
10.1 Repair .....	24
10.2. Replacement.....	24
10.3. Rehabilitation .....	24
<b>11. CONTACT INFORMATION .....</b>	<b>24</b>
11.1 Chain of Command .....	24
11.2. State Personnel.....	24
11.3. Federal Personnel .....	24

## **TABLES**

Table 1.1	Summary of Planning and Construction Activities .....	2
Table 1.2	Project Goals, Objectives and Features .....	2
Table 5.1	Summary of Project Features.....	6
Table 5.2	Actual Construction Costs .....	9
Table 6.1	Estimated Post-Construction Monitoring Costs.....	14
Table 6.2	Monitoring and Performance Evaluation Matrix .....	14
Table 6.3	Monitoring and Data Collection Summary .....	15
Table 6.4	Post-Construction Evaluation Plan .....	16
Table 8.1	Annual Management Plan .....	17
Table 9.1	Estimated Annual Operation & Maintenance Costs .....	19
Table 9.2	Inspection Timeline .....	24

## **FIGURES**

Figure 1.1	Rice Lake HREP Overview Map.....	3
Figure 4.1	New LaGrange L&D Flows: 1990-2015 .....	5

## **APPENDICES**

Appendix A	As-Built Drawings and Cross Sections
Appendix B	Project Partnership Agreement and Right of Way Drawings
Appendix C	Project References and Regulations
Appendix D	Site Manager's Project Inspection and Monitoring Results
Appendix E	Project Photographs
Appendix F	Pump Station Submersible Pumps
Appendix G	Pump Station Butterfly Valves
Appendix H	Pump Station Control Building Motor Control Center
Appendix I	Pump Station Control Building Light Fixtures
Appendix J	Outlet Structure Stop Log and Slide Gates
Appendix K	Distribution List

**OPERATION AND MAINTENANCE MANUAL**  
**RICE LAKE STATE FISH AND WILDLIFE AREA**  
**UPPER MISSISSIPPI RIVER RESTORATION**  
**HABITAT REHABILITATION AND ENHANCEMENT PROJECT**  
**FULTON COUNTY, ILLINOIS**

**SEPTEMBER 2021**

## **1. GENERAL**

**1.1. Introduction and Purpose.** The Rice Lake State Fish and Wildlife Area (SFWA) Upper Mississippi River Restoration (UMRR) Habitat Rehabilitation and Enhancement Project (HREP) was completed under the supervision of the Rock Island District, U.S. Army Corps of Engineers (USACE). Copies of the drawings and references pertaining to this project are included in this manual.

This Operation and Maintenance (O&M) manual describes the operation, maintenance and upkeep responsibilities for the Rice Lake SFWA UMRR HREP (Project) that is required by USACE to receive Federal assistance under the UMRR Program. The instructions are consistent with the general procedures presented in the Definite Project Report (DPR) dated March 2011.

This manual serves to furnish the Illinois Department of Natural Resources (ILDNR) officials with information and guidance to assist in the orderly and efficient use of the constructed features to meet project goals and objectives. Likewise, adequate maintenance of habitat rehabilitation and enhancement projects is required to ensure serviceability of project features. The intent of the maintenance instructions is to present preventative maintenance information consisting of systematic inspections and subsequent corrective actions, which should ensure long-term use. A timely preventative maintenance program reduces and prevents major damage to constructed features. The ILDNR shall maintain the Project in an acceptable condition as defined in this O&M manual. This manual was written for personnel familiar with the Project and does not contain detailed information which is common to site personnel or which is presented in other existing manuals or regulations. This manual provides the general standards of maintenance and establishes an initial frequency of maintenance inspections that should ensure satisfactory Project performance. This manual is the latest in a series of O&M guidance specifically designed to assist in the operation and maintenance of the Project. This document supersedes and incorporates previous Project specific O&M manuals. Although this document is intended to call out the most salient issues, additional guidance for proper operation and maintenance is present in USACE guidance and policy documents. The Code of Federal Regulations specifying O&M requirements is attached in Appendix C. Additionally, the USACE provides clarification of proper operation and maintenance of Project features that may require efforts that are additional to those stated in this document. The USACE encourages an active dialogue between the USACE and the ILDNR to indicate USACE policy clarifications that may have O&M implications for the Project. Table 1.1 gives a brief history of the planning, engineering, design and construction activities of the Project.

**Table 1.1. Summary of Planning and Construction Activities**

Project Phase	Purpose	Project Milestone	Date Completed
Pre-Project	Identify and define problems and establish need of project	Original Fact Sheet	October 1987
Planning, Engineering and Design	Quantify project objectives, perform preliminary design, satisfy NEPA <sup>1</sup> and permit requirements, develop performance evaluation plan, obtain project approval for construction	DPR Public & Agency Review	January 2010
		Final DPR with EA <sup>2</sup>	March 2011
		DPR MVD Approval	April 2011
		Obtain 401/404 Permits	July 2011
		Project Partnership Agreement	July 2011
Construction	Finalize plans and specifications, obtain O&M agreement, advertise and award construction contracts, construct project	Final Plans & Specs & Advertise Contract	July 2011
		Bid Opening	August 2011
		Award Contract & Notice to Proceed	September 2011
		Construction Complete	June 2015

<sup>1</sup> National Environmental Policy Act<sup>2</sup> Environmental Assessment

**1.2. Project Function.** The Project is classified as a HREP that was federally constructed and is federally maintained. It was designed to restore wetland and aquatic habitat by increasing the areal coverage of annual emergent and moist soil vegetation, decreasing summer water levels to promote moist soil vegetation growth, and increasing connectivity between Big/Goose Lakes and the Illinois River during summer draw downs. Table 1.2 summarizes the goals, objectives, and features of the Project.

**Table 1.2. Project Goals, Objectives and Features**

Goals	Objectives	Project Features
Restore Wetland Habitat	Increase the areal coverage as measured in acres of annual emergent and moist soil vegetation in Big and Goose Lakes during the summer growing season	Construct overflow spillway across Goose Lake and repair natural spillway
	Decrease summer water levels to below EL 440 feet in Big Lake, Goose Lake and Rice Lake to promote moist soil vegetation growth during the summer growing season	Construct pump station and control building with discharge channel and water control structures
Restore Aquatic Habitat	Increase connectivity between Big/Goose Lakes and the Illinois River during summer drawdowns to reduce fish mortality and avian botulism	Construct fish egress or outlet structure between Goose Lake and the Illinois River

**1.3. Project Description.** This section describes the Project, as it exists at the time of the O&M manual's printing. The Project features consist of repairing the natural spillway, constructing an overflow spillway, a spillway access road, outlet structure, discharge channel, pump station, control building, 24-inch water control structures, and 48-inch water control structures. These features are shown generically in pump station, control building in Figure 1.1



and more specifically in the plates found in Appendix A, *As-Built Drawings and Cross Sections*. See Section 5, *Construction History*, for a discussion on the construction history of the Project including post-flood rehabilitation.

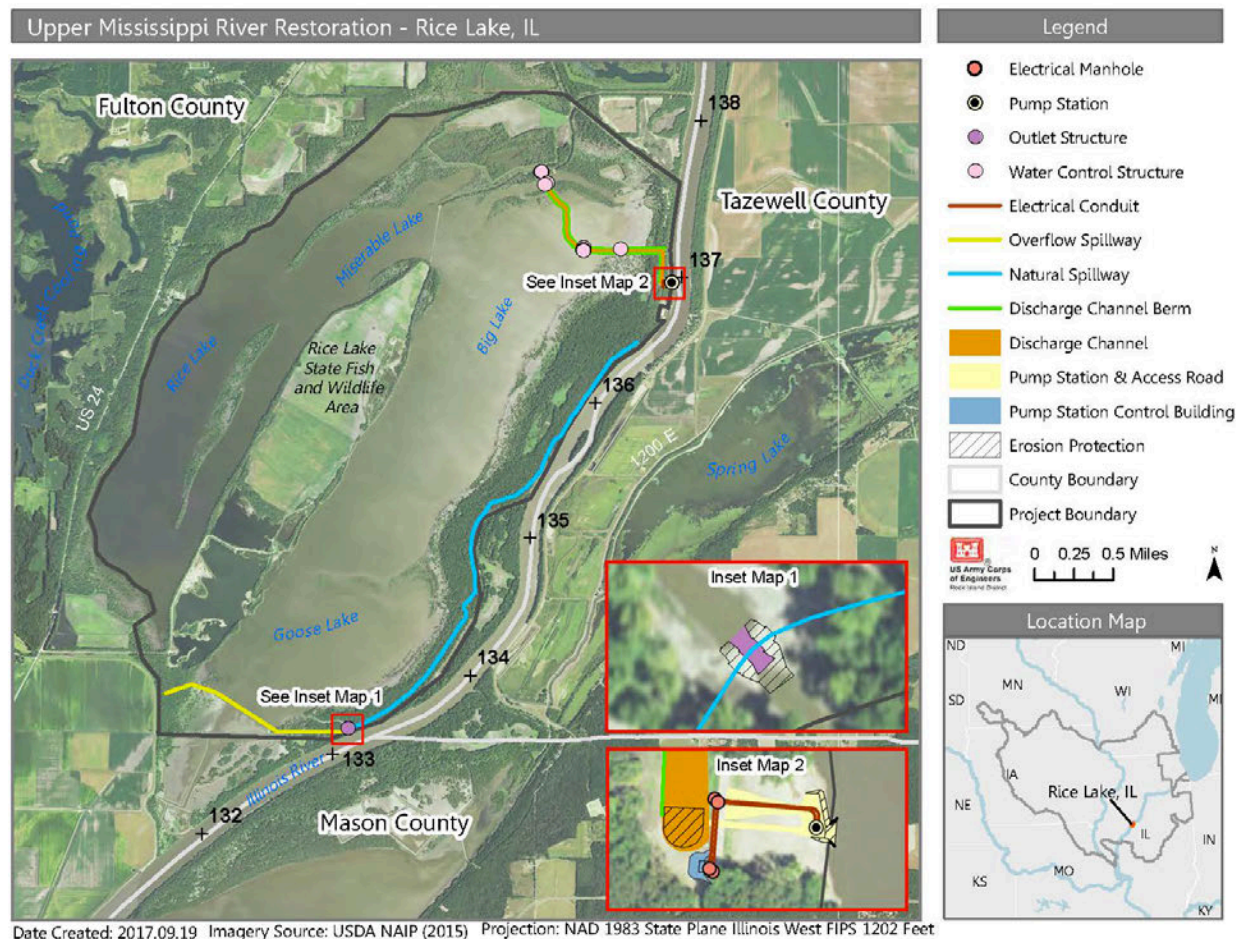


Figure 1.1. Rice Lake HREP Overview Map

## 2. AUTHORIZATION

This O&M manual serves to meet the Department of the Army's requirements under the 1985 Supplemental Appropriations Act (Public Law 99-88), Section 1103 of the Water Resources Development Act (WRDA) of 1986 (Public Law 99-662), Section 405 of WRDA 1990 (Public Law 101-640), Section 107 of WRDA 1992 (Public Law 102-580), and Section 509 of WRDA 1999 (Public Law 106-53). The USACE funded and constructed the Project under these authorizations.

As set forth in the Project Partnership Agreement (PPA), included in Appendix B, *Project Partnership Agreement and Right of Way Drawings*, the ILDNR has agreed to maintain and operate, at no cost to the USACE, the Project including all the repaired or restored Project features in accordance with Section 107(b) of the WRDA of 1992, Public Law 102-580.

### 3. LOCATION

The Project is located on the Rice Lake SFWA on the right descending bank of the Illinois Waterway's LaGrange Pool, approximately 4 miles downstream of Banner, Illinois, between River Miles (RM) 132.0 and 138.0. It is located in Fulton County, Illinois, approximately 24 miles southwest of Peoria, Illinois. The IL DNR manages the Rice Lake SFWA to provide quality nesting and mid-migration habitat for migratory and resident waterfowl. The Project area is comprised of several backwater lakes, wet floodplain forests, and floodplain agricultural fields. The agricultural fields are located on a large tract of floodplain (Duck Island) that separates the two largest lakes, Rice Lake and Big Lake. Sheet G-002 provides vicinity and general location maps for the Rice Lake SFWA.

### 4. PERTINENT INFORMATION

**4.1. Hydrology.** The LaGrange Lock and Dam provides navigable channel depths by maintaining a water surface elevation of 429.2 feet (flat pool) or higher. The water levels are highly variable. The Project features are adjacent to the Illinois River 9-foot channel but are not contiguous, so navigation is unaffected. Historical flow data for the LaGrange Pool is provided in Figure 4.1. The maximum, minimum, and average daily flows are shown for the 25 year time period of 1990 to 2015.


Information from river gages can provide an indication of river levels and potential flooding at the Project. The Illinois River gage near Havana, Illinois is 12.4 miles downstream of the Project. Pertinent information for this gage is summarized below. Additional information can be obtained from the following website:

<https://rivergages.mvr.usace.army.mil/WaterControl/new/layout.cfm>. First select "Rock Island District" from the "Water Levels By" drop down menu; then select "Illinois River Basin" from the "Rock Island District Basins" drop down menu; then select "Illinois River near Havana, IL" from the list. The gages are listed from upstream to downstream.

<u>Illinois River near Havana, IL (HAV12)</u>	<u>Historical Top 5 Crests</u>
❖ Gage Zero: 424.4 feet NGVD29	1. 27.78 feet on 04/25/2013
❖ Flat Pool: 4.8 feet or 429.2 feet NGVD29	2. 27.24 feet on 07/01/2015
❖ Flood Stage: 14.0 feet or 438.4 feet NGVD29	3. 27.10 feet on 05/26/1943
❖ River Mile: 119.6	4. 26.80 feet on 01/04/2016
❖ Location: Mason County, Havana, IL on the left bank 100 feet downstream of the U.S. Highway 136 bridge	5. 26.73 feet on 05/26/2020

It should be noted that the Illinois River gages are referenced to National Geodetic Vertical Datum (NGVD) 1929 datum. The Project datum is North American Vertical Datum (NAVD) 1988. Each of these datums is slightly different from the other, varying by a few tenths of a foot in elevation. The National Oceanic Atmospheric Administration (NOAA) provides an online conversion tool between 1929 and 1988 datum at the following location:  
<http://www.ngs.noaa.gov/TOOLS/Vertcon/vertcon.html>

**4.2. Climate.** The average annual daily minimum temperature was 42 degrees Fahrenheit (F), while the average annual daily maximum temperature was 64 degrees F. However, the temperatures in central Illinois can fluctuate over an extreme range. Average monthly temperatures range from a maximum of 89.2 degrees F in July to a minimum of 17.5 degrees F in January. The precipitation is moderate, with an average annual value of 34.0 inches. The average annual snowfall is 21.4 inches

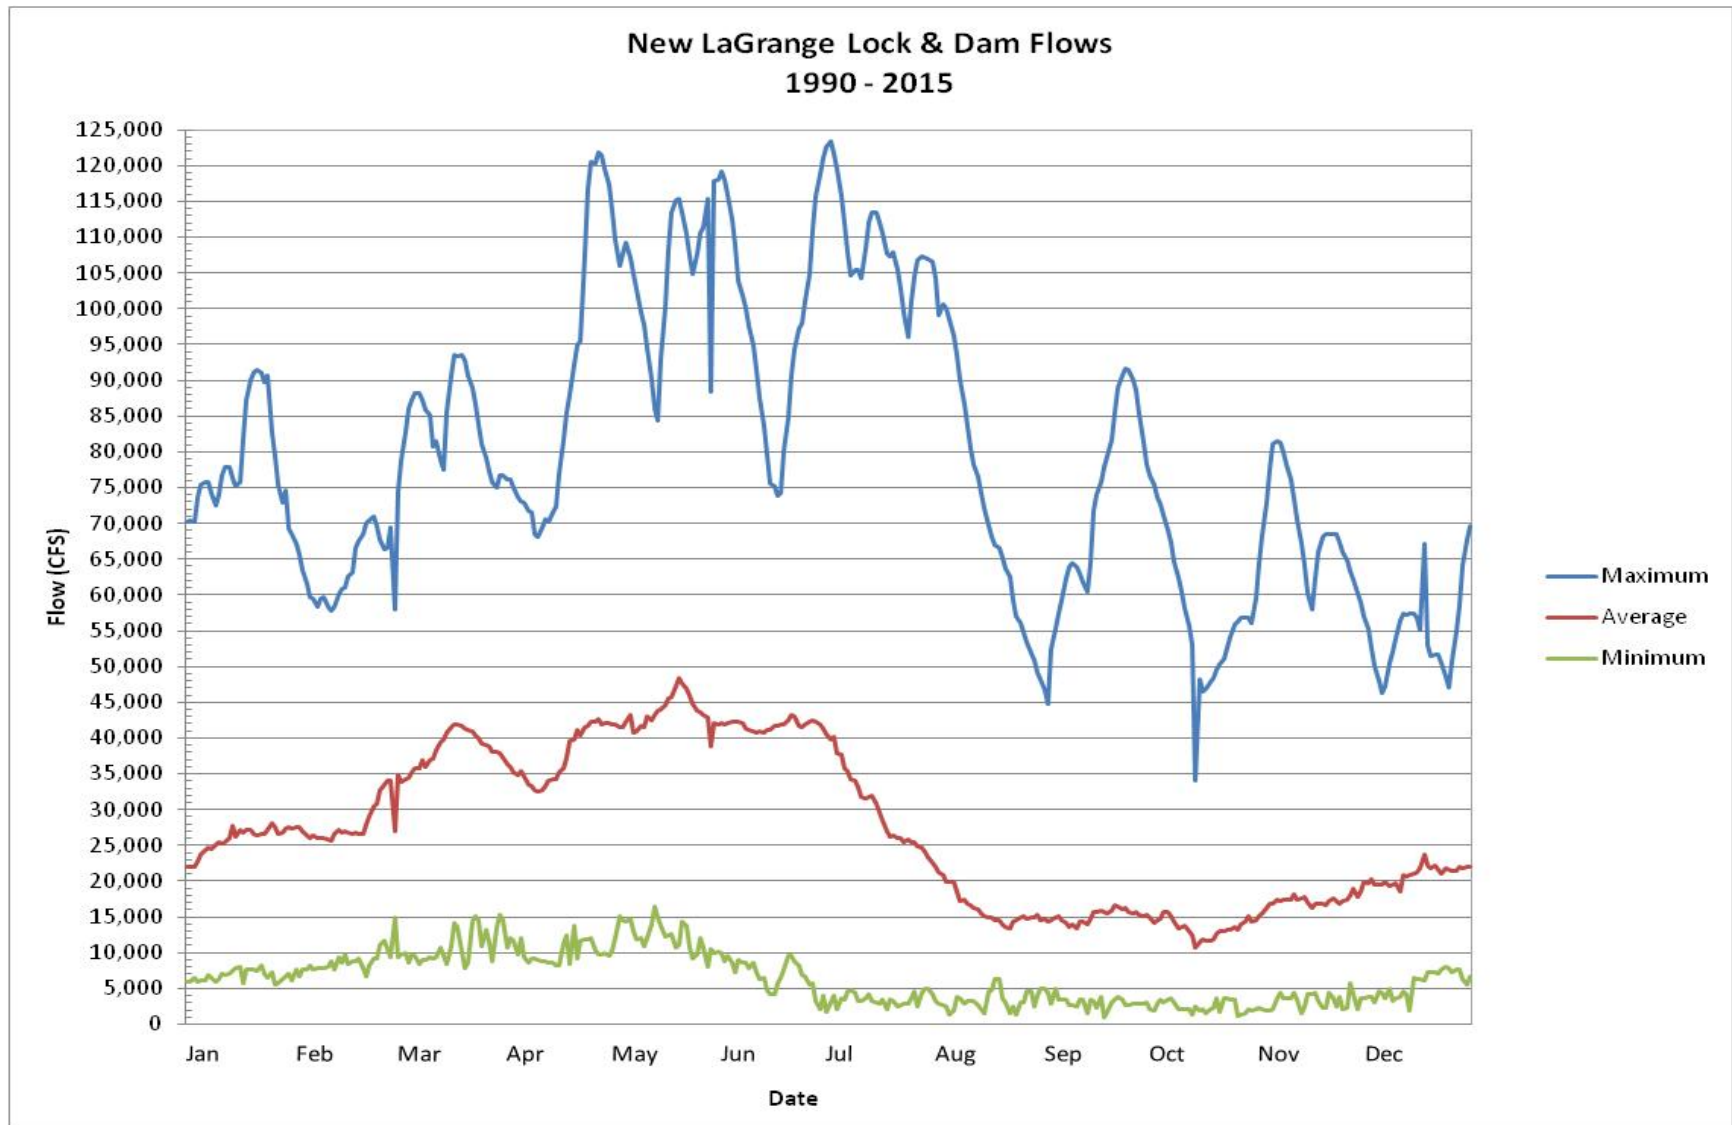

**Figure 4.1. New LaGrange L&D Flows: 1990 – 2015**



## 5. CONSTRUCTION HISTORY

**5.1. Project Features.** USACE designed and constructed the Project in coordination with the ILDNR. Several features were utilized in the Project to meet the objectives and goals. The Project features consist of repairing the natural spillway, constructing an overflow spillway, a spillway access road, outlet structure, discharge channel, pump station, control building, 24-inch water control structures, and 48-inch water control structures. These features are summarized in Table 5.1 and described in more detail below. Appendix E includes Project feature photos.

**Table 5.1. Summary of Project Features**

Feature	Measurement	Unit
<b>Overflow Spillway</b>		
Length	6,524	Feet
Top Elevation	440.0	Feet NAVD88
Top Width	10	Feet
Side Slopes	4:1	H:V
Embankment, Wet Material	19,610	Cubic Yards
Embankment, Dry Material	10,800	Cubic Yards
<b>Natural Spillway</b>		
Length	17,558	Feet
<b>Outlet Structure</b>		
Top Elevation	440	Feet NAVD88
Sill Elevation	431.5	Feet NAVD88
4'-6" Stoplog Bays	2	Each
5' x 5' Slide Gate Bay	1	Each
<b>Pump Station</b>		
Pumps	3	Each
Manufacturer	Sulzer ABS	
Type	Submersible Propeller	
Model Number	VUP 1001 M2200/12-92.60	
Flow	44,400	GPM
Top Elevation	440.0	Feet NAVD88
Riverside Sill Elevation	420.5	Feet NAVD88
Landside Sill Elevation	432.0	Feet NAVD88
6' x 12' Box Culvert Length	262	Feet
Jersey Barriers	110	Feet
<b>Discharge Structure</b>		
Sill Elevation	431.7	Feet NAVD88
24" Riprap (RR-5)	835	Tons
<b>Discharge Channel</b>		
Length	6,893	Feet
Berm Top Elevation	441.0	Feet NAVD88
Channel Bottom Elevation	430.0	Feet NAVD88
Channel Bottom Width	30	Feet
Side Slopes	3:1	H:V
Excavation	91,362	Cubic Yards
<b>Water Control Structures</b>		
48" Diameter CMP Stoplog Structures	6	Each
24" Diameter CMP Stoplog Structures	4	Each
<b>Erosion Protection</b>		
18" Riprap (RR-4)	696	Tons
6" to 9" Bedding Stone (RR-1)	547	Tons
9" Granular Surfacing	1,028	Tons



**a. Overflow Spillway.** An overflow spillway was constructed from Station 0+00 to Station 65+24 at the downstream end of the Project on the south end of Goose and Beebe Lakes to provide controlled overtopping of the embankment system. The spillway from Station 0+00 to 18+00 and from Station 40+00 to 65+24 was constructed with “dry” material from excavation of the discharge channel. The spillway from 18+00 to 40+00 was constructed with “wet” material from the bottom of Goose Lake. Refer to the overflow spillway plans and profiles on sheets C-102 to C-104 and typical sections on C-301.

**b. Natural Spillway.** A natural ridge at higher ground exists adjacent to the Project along the Illinois River. It was determined during design that this ridge was at a sufficient elevation to act as a natural spillway, except at three locations. These areas, totaling approximately 700 feet, were repaired or elevated during construction. See sheets C-113 to C-115. One repair area also included removing an existing 36” CMP stoplog structure. The natural spillway begins where the overflow spillway ends at Station 65+24 and extends upstream to Station 240+82, reference sheets C-104 to C-111.

**c. Spillway Access Road.** A spillway access road was constructed on the south end of the quarry pit and Beebe Lake. It allows access from the existing access road to the overflow spillway, refer to sheet C-101 for approximate location and sheet C-332 for typical section.

**d. Outlet Structure.** An outlet structure was constructed just beyond where the overflow spillway transitions to the natural spillway at approximate Station 66+50. See sheet C-112. The outlet structure consists of two stoplog bays and one slide gate bay which allow for manipulating and maintaining water levels within the Project. Two existing 36” CMP stoplog structures were also removed at this location prior to construction of the outlet structure.

**e. Pump Station.** A pump station was constructed at the upstream end of the Project between the Illinois River and Banner Dyke Road. See sheet C-121 for location and sheets S-101 and S-301 for details. The pump station allows for pumping water from the Illinois River into the discharge channel which flows into the Rice Lake SFWA. The pump station, in combination with the water control structures allow for control of the water into the Rice Lake SFWA.

**f. Control Building.** A control building for the pump station was constructed on the west side of Banner Dyke Road, south of the discharge structure. The control building is a masonry structure on a concrete foundation with a slab top elevation of 457.5 feet, which equates roughly to the 0.2 percent chance or 500-year flood event. The control building houses the pump station controls. Refer to sheet C-121 for location and sheets S-107 and S-203 for details.

**g. Discharge Channel.** A discharge channel approximately 6,893 feet in length was excavated beginning at the discharge structure on the west side of Banner Dyke Road, north of the control building. Water is piped from the pump station to the discharge structure through a concrete box culvert. The bottom elevation of the discharge channel is 430.0 feet. The bottom width is 30 feet with side slopes at 3H:1V. The discharge channel runs northward approximately 1,075 feet and then turns westward. It runs westward approximately 2,925 feet and then turns northward. The channel runs northward for approximately 1,360 feet and then turns north-northwestward. The channel runs approximately 1,533 feet north-northwestward and then connects to the existing channel which leads into the Rice Lake SFWA. Plans and profiles of the discharge channel can be found on sheets C-122 to C-124. Material excavated from the discharge channel was used to construct the overflow spillway.

**h. 24-Inch Water Control Structures.** Four (4) 24" water control structures were constructed for the Project. They are located along the discharge channel, one each at Stations 25+00 and 37+60, and two at Station 64+80. See sheets C-125 to C-127. All four structures consist of 24" diameter CMP with a prefabricated inline water control riser with stoplogs.

**i. 48 Inch-Water Control Structures.** Six (6) 48" water control structures were constructed for the Project. They are located along the discharge channel, three each at Station 37+60 and three each at Station 69+00, reference sheets C-126 and C-128. All six structures consist of 48" diameter CMP with a 54" diameter CMP riser with stoplogs.

**5.2. Project Right of Way Drawings.** The Project is cost-shared with the ILDNR, as the non-Federal Sponsor. All of the Project lands are owned in Fee Simple Title and managed by the ILDNR. The real estate interests acquired for the Project consist of approximately 4,029 acres in Fee Simple Title. Right of way (ROW) drawings for the Project were developed during design phase and are provided in Appendix B.

**5.3. Project Construction.** Construction contract information is listed below. An overall breakdown of construction costs is provided in Table 5.2.

Contract Name:	Rice Lake Habitat Rehab & Enhancement, Stage I
Contract Number:	W912EK-11-C0090
Contractor:	SAF, INC. 130 E Voris St, Ste A Akron, OH 44311
Date Awarded:	September 2011
Date Completed:	June 2015
Contract Cost:	\$9,308,026.32

**Table 5.2. Actual Construction Costs**

Item No.	Supplies/Services	Qty	Unit	Unit Price	Amount
0001	Mobilization and Demobilization	1	LS	XXX	\$93,293.00
0002	Temporary Field Office	1	LS	XXX	\$67,400.00
0003	Telephone Bills for Temporary Field Office				
0003AA	First 1,000.00 Dollars	373	DL	\$15.00	\$5,594.19
0003AB	Over 1,000.00 Dollars	0	DL	\$14.00	\$0.00
0004	Clearing, Grubbing, and Stripping	1	LS	XXX	\$104,781.00
0005	Demolition of Existing Water Control Structures	1	LS	XXX	\$22,348.00
0006	Dredging/Excavating Pump Station Intake	1	LS	XXX	\$86,444.00
0007	Electrical Service	1	LS	XXX	\$261,484.00
0008	Pump Station and Control Building Electrical Work	1	LS	XXX	\$372,739.00
0009	Pump Station and Wing Walls				
0009AA	Concrete Mud Slab and Bedding	1	LS	XXX	\$10,843.00
0009AB	Reinforced Concrete	1	LS	XXX	\$1,310,216.00
0009AC	Submersible Pumps, Discharge Tubes &	1	LS	XXX	\$1,060,787.25
0009AD	Miscellaneous Metal Fabrications	1	LS	XXX	\$180,445.00
0009AE	Steel H-Piles	1	LS	XXX	\$265,834.95
0010	Pump Station Control Building				
0010AA	Reinforced Concrete	1	LS	XXX	\$68,975.00
0010AB	Masonry	1	LS	XXX	\$23,120.00
0010AC	Roof Assembly	1	LS	XXX	\$29,995.00
0010AD	Steel Door, Stairs, and Handrail	1	LS	XXX	\$53,218.00
0010AE	Control Building Mechanical	1	LS	XXX	\$173,321.00
0011	Precast Concrete Box Culvert	224	LF	\$3683.00	\$824,992.00
0012	Pump Station Discharge Structure	1	LS	XXX	\$71,596.00
0013	Discharge Channel Excavation				
0013AA	First 75,000 Cubic Yards	75,000	CY	\$13.37	\$1,002,750.00
0013AB	Over 75,000 Cubic Yards	16,362	CY	\$16.11	\$263,587.47
0014	24-Inch Diameter Water Control Structure	4	EA	\$28,073.25	\$112,293.00
0015	48-Inch Diameter Water Control Structure	6	EA	\$63,449.00	\$380,694.00
0016	Spillway Embankment, Wet Material Placement				
0016AA	First 16,000 Cubic Yards	18,500	CY	\$18.82	\$348,170.00
0016AB	Over 16,000 Cubic Yards	1,110	CY	\$88.23	\$97,935.30
0017	Spillway Embankment, Dry Material Placement				
0017AA	First 16,000 Cubic Yards	10,800	CY	\$20.50	\$221,400.00
0017AB	Over 16,000 Cubic Yards	0	CY	\$23.67	\$0.00

**Table 5.2. Actual Construction Costs**

Item No.	Supplies/Services	Qty	Unit	Unit Price	Amount
0018	Outlet Structure				
0018AA	Reinforced Concrete	1	LS	XXX	\$193,173.00
0018AB	Grating	1	LS	XXX	\$23,722.00
0018AC	Handrails	1	LS	XXX	\$20,246.00
0018AD	Aluminum Stoplogs	1	LS	XXX	\$17,185.00
0018AE	Aluminum Slide Gate	1	LS	XXX	\$10,247.00
0019	Granular Surfacing				
0019AA	First 900 Tons	900	TN	\$21.91	\$19,719.00
0019AB	Over 900 Tons	128	TN	\$21.92	\$2,812.12
0020	Pump Station Access Road Swing Gate	1	LS	XXX	\$8,873.00
0021	Stone Protection – Bedding Stone				
0021AA	First 500 Tons	500	TN	\$61.02	\$30,510.00
0021AB	Over 500 Tons	47	TN	\$61.02	\$2,867.94
0022	Stone Protection - Riprap (RR-4)				
0022AA	First 600 Tons	600	TN	\$76.65	\$45,990.00
0022AB	Over 600 Tons	96	TN	\$383.25	\$36,792.00
0023	Stone Protection - Riprap (RR-5)				
0023AA	First 700 Tons	700	TN	\$79.66	\$55,762.00
0023AB	Over 700 Tons	135	TN	\$76.65	\$10,324.75
0024	Concrete Jersey Barriers				
0024AA	First 110 Linear Feet	110	LF	\$92.10	\$10,131.00
0024AB	Over 110 Linear Feet	0	LF	\$70.25	\$0.00
0025	Seeding	1	LS	XXX	\$85,157.60
0026	Outlet Structure Mud Slab	1	LS	XXX	\$21,750.00
0027	Special Joint Sealant	1	LS	XXX	\$10,229.15
0028	Modify Pump Station Discharge Chamber Hatches	1	LS	XXX	\$37,651.53
0031	Degrade Overflow Spillway Wet Material	1	LS	XXX	\$80,000.00
0032	Remove Pump Station Debris	1	LS	XXX	\$33,000.00
0033	Repair Outlet Structure	1	LS	XXX	\$160,848.71
0034	Repair Spillway & Berms	1	LS	XXX	\$426,230.74
0035	Repair Water Control Structures	1	LS	XXX	\$163,296.75
0037	Closeout	1	LS	XXX	\$287,250.87
<b>TOTAL CONSTRUCTION COST</b>					<b>\$9,308,026.32</b>

LS = Lump Sum

TN = Tons

EA = Each

DI = U.S. Dollars

CY = Cubic Yards

LF = Linear Feet



**5.4 Construction Modifications.** The Project construction contract had multiple modifications. Ten of the modifications required technical changes to the contract and are described below.

**a. Special Joint Sealant.** A special joint sealant was added to provide watertight seals at the precast box culvert sections, the annular space between the steel discharge pipes, and the top slab of the pump station. The design basis was SikaSwell® S-2 manufactured by Sika Corporation.

**b. Outlet Structure Mud Slab.** A 12-inch mud slab was incorporated to provide an adequate foundation for the outlet structure due to unsuitable materials that were encountered during excavation. See sheet S-309.

**c. Adjust Limit of Wet & Dry Spillway.** The limit of overflow spillway construction using wet material and using dry material was adjusted from Station 23+00 to Station 18+00 per request by the Contractor. See sheet C-102. Quantities for these bid items were adjusted accordingly.

**d. Modify Pump Station Discharge Chamber Hatches.** The three gate hatches on the discharge chamber side of the pump station were raised to prevent potential reverse flow through the discharge chamber side of the pump station during pumping operations when the water level in the discharge channel is elevated. See sheet S-301. Access equipment and safety features were also installed. The openings in the top slab of the pump station for the discharge piping on the discharge chamber side were also modified from oblong to circular. These changes were necessary to provide watertight seals. Reference sheet S-101.

**e. Stoplog Security Device.** A stoplog security device for the two stoplog bays was installed to prevent theft and unauthorized use of the stoplogs at the outlet structure. See sheet S-108.

**f. Repair Spillway and Berms.** A record flood in spring 2013 caused damage to the Project and it was necessary to repair the overflow spillway embankment (dry material placement) and discharge channel berms to pre-flood conditions. Approximately 4,400 feet of overflow spillway embankment and approximately 9,000 feet of discharge channel berms were repaired to include surface preparation, material placement, regrading/reshaping, seeding and surveying.

**g. Repair Outlet Structure.** A record flood in spring 2013 caused damage to the Project and repairs were required to provide a functional outlet structure. The outlet structure was modified to incorporate rock installation adjacent to the top of the structure. See sheets C-112 and C-201.

**h. Remove Pump Station Debris.** Debris that accumulated at the bottom of the pump station during the spring flood event of 2013 was removed and disposed offsite.

**i. Degrade Overflow Spillway Wet Material.** Approximately 2,200 feet of overflow spillway was degraded to a top elevation of 440.0 feet so this feature would function as hydraulically designed.

**j. Repair Water Control Structures.** A record flood in spring 2013 and ice in winter 2014 caused damage to the Project and repairs were required to provide functional water control structures. Two of the 24-inch CMP stoplog structures were reinstalled and the risers

lowered. See sheets C-125 and C-126. The six 48 -inch CMP gate structures were converted to stoplog structures. See sheet S-520.

**5.5. Construction As-Built Drawings.** The construction drawings, included in Appendix A, depict as-built or as-repaired Project features.

**5.6. Post-Construction Modifications.** The Project sustained another record flood in summer 2015. Each pump's electrical power and control cable end connections were inundated during this high water event rendering the pumps inoperable. As a result, a service contract (W912EK-16-C-0023) was awarded to the pump supplier to repair all three 48" submersible pumps. The pumps were disassembled and evaluated to identify all damaged or failed pump components requiring replacement or repair. The pumps were then repaired, reassembled and tested on site after reinstallation.

In addition to the pump repairs, a modified design was developed to elevate the junction boxes that house each pump's electrical power and control cable end connections. The existing 6.35" x 8" aluminum I-beams installed during construction to support the junction boxes were replaced with 15" x 30" steel I-beams (W30x173). The bottom of the junction boxes was raised from approximate EL 447.0 to EL 458.8. Reference sheets S-512, E-106, E-301, E-302 and E-503 in Appendix A for additional details. The reinstallation of the pumps and installation of the elevation junction boxes was performed by USACE personnel from the Operations Division, Maintenance Branch in the Mississippi River Project Office. This work was complete in early September 2017.

In late September 2017, the ILDNR Site Manager began running the pumps to raise the interior water elevations. After approximately 60 hours of operation, pump #2 shut down and became inoperable. As a result, a service contract (W912EK-18-P-0046) was awarded to the pump supplier to repair pump #2. The pump was disassembled and evaluated to identify all damaged or failed pump components requiring replacement or repair. The pump was then repaired, reassembled and tested on site after reinstallation. This work was complete in June 2018. See Appendix F for contract reports.

In September 2018, the non-Federal Sponsor notified the Government that Pump #2 became inoperable a third time. The other two pumps became inoperable the following week. The authorized pump supplier/manufacturer performed a service call in October 2018. See Appendix F for field service report. As a result, a service contract (W912EK-19-P-0071) was awarded to Quality Flow Systems, Inc. All three pumps were disassembled and evaluated to identify all damaged or failed pump components requiring replacement or repair. In addition, a complete electrical damage and functional operation inspection and assessment of the pump station motor control center (MCC) was performed and recommendations for repair were provided. The pumps were then repaired, reassembled and tested on site after reinstallation. Motor control center repairs were completed during pump reinstallation but prior to testing and included the following: verification of the service entrance ground / neutral bonding and correction of any deficiencies, fastening of the earth ground at the MCC ground bus bar in the bottom of the MCC structure, repair of the severed ground conductor outside of the control building, installation of new cable grips and three-pole electrical termination blocks in the upper junction boxes at the pump station for each pump, replacement of the water level transducers and suspension kits in the pump station, replacement of all three surge protector device arrestors for Phase A, B and C in the MCC, and replacement of the pump instrumentation multiconductor cables from the MCC in the control building to the upper junction boxes at the pump station for each pump. This work

was substantially complete in April 2021, however a mod was awarded in July 2021 to replace the Pump #1 display panel. Refer to Appendices F and H for contract reports.

In conjunction with the pump repairs, a service contract (W912EK-21-P-0028) was awarded to Hoerr Construction, Inc. in March 2021 to remove the sediment from the pump station bays using a vac truck just prior to the reinstallation of the pumps.

**5.7. Project Encroachments and Modifications.** 33 USC 408 (Section 408) provides authority solely to the Secretary of the Army for modifications or alterations to USACE projects. According to Army policy, there is very limited delegated authority to District Commanders to approve minor, low impact modifications to projects operated and maintained by sponsors. Approval from the Rock Island District Engineer is required prior to any minor improvement or change in any feature of the Project. In addition, no encroachment shall be made on Project rights-of-way without prior determination that the proposed work will not adversely affect the Project. Before starting work on any such improvements, changes, or encroachments, ILDNR officials shall submit for consideration and approval a complete set of the proposed plans to the USACE, Rock Island District, ATTN: CEMVR-EC-DN. Following review of the proposed plans, the USACE shall notify the ILDNR by letter of the findings and if approval is granted. If approval is granted, and after the work is completed, the ILDNR will update the O&M manual to reflect the modification to the Project and provide a copy to the USACE. Additionally, the sponsor shall furnish the USACE drawings, which show the new "as-built" condition.

## **6. PROJECT PERFORMANCE**

**6.1. Performance Monitoring and Assessment.** The purpose of this section is to summarize monitoring and data collection aspects of the Project. Table 6.1 outlines the estimated annual post-construction costs for performance monitoring and assessment. ILDNR and USACE shall conduct the fish net sampling and moist soil vegetation mapping at the intervals specified. The estimated cost for collecting these data every 5 years was interpolated into an annual cost as shown in Table 6.1.

Table 6.2 presents the Monitoring and Performance Evaluation Matrix which highlights the main project phases, the types of activities involved for each phase, and their purposes. For each activity, it is defined who is the responsible agency, who is the implementing agency, what is the funding source, and any implementation instructions, if applicable.

Table 6.3 illustrates the Monitoring and Data Collection Summary, which outlines what is monitored, how it will be accomplished, who will collect the data, and at what intervals. For purposes of this manual, USACE and the ILDNR Site Manager are responsible for the engineering and natural resources data in the post-construction phase column.

**6.2. Post-Construction Monitoring.** Table 6.4 presents the Post-Construction Evaluation Plan. Monitoring includes both quantitative and qualitative data from federal and state agencies, research organizations, and the Site Manager. The monitoring parameters were developed to measure the effectiveness of the stated goals and objectives. Monitoring data, including annual field observations by the Site Manager, are used to evaluate the performance of the Project. The Site Manager should refer to Section 9, *Maintenance and Inspections*, and the inspection checklist in Appendix D for a more complete description of the requested field observations.

**Table 6.1. Estimated Post-Construction Monitoring Costs**

Description	Unit Cost	Frequency	Total Cost
Fish Net Sampling	\$800	Years 1 thru 2	\$1,600
Moist Soil Vegetation Mapping	\$5,000	Years 1 thru 5	\$25,000
<b>TOTAL ESTIMATED MONITORING COST</b>			<b>\$26,600</b>

**Table 6.2. Monitoring and Performance Evaluation Matrix**

Project Phase	Type of Activity	Purpose	Responsible Agency	Implementing Agency	Funding Source	Implementation Instructions
Pre-Project	Pre-Project Monitoring	Identify and define problems at HREP site; establish need of proposed project features	Sponsor	Sponsor	Sponsor	N/A
	Baseline Monitoring	Establish baseline for performance evaluation	USACE	USACE / Sponsor	HREP / Sponsor	See Table 6.3
Design	Data Collection for Design	Include quantification of project objectives; design of project; and development of performance evaluation plan	USACE	USACE	HREP	See Table 6.3
Construction	Construction Monitoring	Assess construction impacts; assure permit conditions are met	USACE	USACE	HREP	See State Section 401 Stipulations
Post-Construction	Performance Evaluation Monitoring	Determine success of project as related to objectives	USACE / Sponsor	USACE / Sponsor	HREP / Sponsor	See Tables 6.3 and 6.4



**Table 6.3. Monitoring and Data Collection Summary**

	WATER QUALITY DATA						ENGINEERING DATA			NATURAL RESOURCE			Sampling Agency	Remarks
	Pre-Project Phase		Design Phase		Post-Construction Phase		Pre-Project Phase	Design Phase	Post-Const. Phase	Pre-Project Phase	Design Phase	Post-Const. Phase		
Type Measurement	Apr-Sep	Oct-Mar	Apr-Sep	Oct-Mar	Apr-Sep	Oct-Mar								
<b>POINT MEASUREMENTS</b>														
Column Settling Stations														
Column Settling Analysis								1					USACE	
<b>Boring Stations <sup>1</sup></b>														
Geotechnical Borings								1					USACE	
<b>Fish Station <sup>2</sup></b>														
Net Sampling										1		Y1-2	ILDNR	
<b>AREA MEASUREMENTS</b>														
<b>Mapping</b>														
Moist Soil Vegetation										1		Y1-5	USACE	

**LEGEND**

M = Monthly

Yn = Year-n Interval where n = the number of years after construction completion that the data is collected

<sup>1</sup> Boring Stations - See B sheets in as-built drawings in Appendix A for locations and logs

<sup>2</sup> Fish Station - See sheet C-101 in as-built drawings in Appendix A for location of outlet structure

**Table 6.4. Post-Construction Evaluation Plan**

Goal	Objective	Enhancement Feature	Unit	Year 0 Without Project	Year 1 With Project	Year 25 With Project	Target Year 50 With Project	Feature Measurement See Table 6.2	Annual Field Observations by Site Manager
<b>Restore Wetland Habitat</b>	<p>Increase the areal coverage as measured in acres of annual emergent and moist soil vegetation in Big and Goose Lakes during the summer growing season</p> <p>Protect the interior (Big Lake, Goose Lake and Rice Lake) from river levels below EL 440 during the summer growing season (July to September) to promote moist soil vegetation growth</p>	<p>Construct overflow spillway across Goose Lake and repair natural spillway</p> <p>Construct pump station and control building with discharge channel and water control structures</p>	Number of summer seasons with river levels below EL 440 to total years in operation (%)	10	40	40	40	Seasonal inundation and moist soil vegetation measurements by analysis of aerial photography / GIS mapping and ground observations	Record observations for both drawdown and flooding; inspect and record discharge channel and water control structures condition
<b>Restore Aquatic Habitat</b>	Increase connectivity between Big and Goose Lakes and the Illinois River during summer drawdowns to reduce fish mortality and avian botulism	Construct fish egress or outlet structure between Goose Lake and the Illinois River	Number of structures accessible to fish during lowering of interior water levels	0	1	1	1	Fish net sampling on riverside of outlet structure	Record observations on fish kills and avian botulism cases



## 7. PROJECT PARTNERSHIP AGREEMENT

The ILDNR and the USACE, Rock Island District Engineer entered into a PPA on 27 June 2011, as required by the UMRR Program. Upon execution of the PPA, lands acquired for Project purposes were eligible for credit against the non-Federal Sponsor's 35 percent requirement. Lands already owned as part of a previous Federal Project were not considered for credit.

As set forth in the PPA with the ILDNR, the ILDNR has agreed to "...operate, maintain, repair, rehabilitate, and replace the entire *Project* or *functional portion of the Project*, at no cost to the Government." A copy of the PPA is included as Appendix B of the O&M manual.

## 8. OPERATION

**8.1. General.** This section presents management instructions for the major project features that were designed and constructed to minimize O&M requirements. A formal Annual Management Plan has been developed for the Project. This plan was developed by the USACE, in coordination with the ILDNR, as shown in Table 8.1. The ILDNR is responsible for the operation and maintenance of all Project features in accordance with the PPA and the environmental management regulations contained in Section 107(b) of WRDA 1992. See Appendix C. The ILDNR shall be responsible for developing and sustaining a program that will operate and maintain the Project and its features. The USACE is responsible for administration of the UMRR Program in accordance with current laws and USACE policies.

**Table 8.1. Annual Management Plan**

Month	Action	Purpose
Jun to Jul	Dewater area by gravity through outlet structure	Expose mudflats to encourage production of moist-soil vegetation
Jul to Sept	Maintain lower water levels to maximum extent possible	Maintain mudflats to continue production of moist-soil vegetation
Sept to Oct	Gradually increase water levels through pump station and water control structures	Provide access to food plants for migratory waterfowl
Oct to Jun	Maintain higher water levels to maximum extent possible	Maintain winter furbearer habitat

Project features shall be continuously operated and maintained to obtain maximum benefits. No encroachment or trespass that will adversely affect the efficient operation or maintenance of the project shall be permitted upon the constructed features. No improvement shall be passed over, under, or through the constructed features, nor shall any excavation or construction be permitted within these features without prior approval by the USACE. Such improvements or alterations, which are desirable and permissible, shall be constructed in accordance with standard engineering practice. Advice regarding the effect of proposed improvements or alterations on the functioning of the project and information concerning methods of construction acceptable under standard engineering practice shall be obtained from the Rock Island District Engineer or, if otherwise obtained, shall be submitted for approval. As-built drawings or prints showing improvements or alterations as finally constructed shall be furnished to the Rock Island District Engineer or Authorized Representative after completion of such work.

**8.2 Overflow Spillway.** Specific operation requirements will be performed as determined by the ILDNR Site Manager. The top elevation of the overflow spillway needs to be maintained At EL 440 feet NAVD88 to ensure this feature operates as designed. During operational inundation periods, the overflow spillway shall be inspected to verify the following:

- 1) No indications of slides or sloughs are developing;
- 2) No wave wash or scouring action is occurring;
- 3) No high reaches exist above design grade to delay filling of the interior;
- 4) No low reaches exist below design grade that may be overtopped prematurely; and
- 5) No other conditions exist which might endanger the overflow spillway.

Steps shall be taken to control any condition that endangers the overflow spillway and to repair the damaged section.

**8.3. Outlet Structure.** Specific operation requirements will be performed as determined by the ILDNR Site Manager in accordance with the manufacturer's operation procedures provided in Appendix J. Water levels in the lakes and management units can be manipulated through the use of the stoplogs in the outlet structure. When the water levels of the Illinois River are expected to rise with heavy sediment loads during dewatering operations, the outlet structure shall be closed to prevent sediment from entering the Project. The outlet structure shall remain closed until the heavy sediment floodwaters recede or overtopping of the overflow spillway is forecasted. To prevent overtopping damage to the outlet structure, all stoplogs shall be removed and stored when the water levels of the Illinois River rise and overtopping of the overflow spillway is predicted. Overtopping of the overflow spillway occurs at EL 440 feet NAVD88. This elevation correlates to an approximate river stage of 15.6 at the Havana, IL gage. The stoplogs shall remain out until the water levels recede and the Project is back in operation.

**8.4. Pump Station and Control Building.** Specific operation requirements will be performed as determined by the ILDNR Site Manager. During the fall season, the pump station will be used to raise the water levels of the lakes and moist soil units. The capacity of all three pumps is approximately 133,200 GPM @ 15 feet total dynamic head. The Project interior is estimated to raise approximately 2 feet in 15 days at this capacity. Prior to activating the pumps, the siphon break or butterfly valves on the pump station discharge piping shall be opened. See vent detail on sheet M-102 in Appendix A for location and Appendix G for operation instructions. Each pump must then be activated manually. After pump start up and once all air has been vented from the discharge piping, the butterfly valves should be closed for operation. This reduces energy consumption of the pumps. The siphon break vent valves must be reopened upon pump shutdown to break siphon and prevent continuous flow through the discharge piping and pumps. Never operate or restart the pumps while in a siphon flow condition. Each pump must also be deactivated manually once the desired interior water elevations are achieved. Pumping to maintain interior elevations will also be by manual activation and deactivation. During operation, the pump monitoring and status unit in the MCC enclosure inside the control building shall be monitored to ensure the pumps are functioning properly. The following allowable starting frequency is based on motor power ratings as identified by the pump manufacturer. The maximum pump starts per hour is 10 at an interval of 6 minutes.

It is recommended the ILDNR Site Manager maintain a pump logbook for historical recordkeeping at the pump station. The following data is recommended for inclusion in the logbook; the date, pump hours, pump motor amperage, pump motor voltage, water level of the river, and significant pump station activities or alarms. See Appendix F for pump station log template. Technical information pertaining to the pumps is referenced in the Sulzer ABS Submersible Propeller Pump VUP Installation and Operating Instructions provided in Appendix F. The local authorized service center for ABS Sulzer pumps is Flow-Technics Inc. in Frankfort, IL and may be contacted at office number (815)277-2600. Appendix H includes System schematics and drawings for the MCC. Turning off the main circuit breaker in the control building to minimize energy usage is not recommended because this will disconnect power to



everything including the MCC enclosure compartment heaters, which are required to control condensation, and the building's exterior and interior light fixtures. It is recommended the ILDNR Site Manager operate the unit heater as needed to maintain the equipment inside the control building in good condition especially if there are beginning indicators of corrosion, damage or other deterioration due to excessive cold temperatures or moisture condensation. The following recommended interior temperatures are based on product ratings as identified by the equipment manufacturers. The minimum operating temperature for proper function of equipment inside the control building is 32 degrees Fahrenheit (32°F), while the minimum storage temperature is -4 degrees Fahrenheit (-4°F).

**8.5. Water Control Structures.** Specific operation requirements will be performed as determined by the ILDNR Site Manager. Water levels in the lakes and management units can be manipulated through the use of stoplogs in the water control structures. The stoplogs can be used to direct the flow of water from the discharge channel to the desired area during pumping. To prevent overtopping damage to the berms, all stoplogs shall be removed and stored when the water levels of the Illinois River rise and overtopping of the overflow spillway is predicted. Overtopping of the overflow spillway occurs at EL 440 feet NAVD88. This elevation correlates to an approximate river stage of 15.6 at the Havana, IL gage. The stoplogs shall remain out until the water levels recede and the Project is back in operation.

## 9. MAINTENANCE AND INSPECTIONS

**9.1. Maintenance.** An active preventative maintenance program reduces damage to existing Project features by taking early corrective action. Additional costs associated with repair and rehabilitation are also avoided. An effective preventative maintenance program requires regular, thorough inspections. Routine inspections can aid ILDNR officials in discovering deficiencies within the Project. They can also provide ILDNR officials with baseline condition data. This data is necessary for considering repair options for major damage within the Project. Steps will be taken by the ILDNR Site Manager to correct conditions disclosed by Project inspections. Regular maintenance repair measures will be accomplished during the appropriate season as scheduled by the ILDNR Site Manager to ensure structure serviceability. Table 9.1 includes estimated operation and maintenance costs for the Project. The maintenance items were developed during the feasibility phase, agreed to by the ILDNR and documented in the DPR. Quantities for maintenance dredging and riprap assume that approximately ten percent of the total construction volume would be excavated or replaced at years 40 or 30, respectively. The need for dredging will be evaluated after completion of the bathymetric surveys and documented in the Performance Evaluation Reports.

**Table 9.1. Estimated Annual Operation and Maintenance Costs**

Item	Qty	Unit	Unit Price	Total Cost
<b>Operation</b>				
Pump Operation	350	Hours	\$40	\$14,000
Project Inspection	40	Hours	\$50	\$2,000
<b>Maintenance</b>				
MCC Maintenance	40	Hours	\$100	\$4,000
Mowing, Spillway & Berms	80	Hours	\$50	\$4,000
Granular Surfacing	20	TN	\$25	\$500
Riprap	30	TN	\$80	\$2,400
Debris Removal (channel/structures)	100	Hours	\$50	\$5,000
<b>TOTAL ESTIMATED ANNUAL O&amp;M COST</b>				<b>\$31,900</b>

**9.1.1. Overflow/Natural Spillways and Discharge Channel Berms.** The ILDNR Site Manager shall provide at all times such maintenance as may be necessary to ensure the serviceability of the spillways and berms in time of inundation. Measures shall be taken such as mowing, burning, and herbicide application to promote the growth of sod, control burrowing animals, provide routine mowing to extend 15 feet horizontally from the toe of the spillway/berm where applicable, remove wild growth and drift deposits, and repair damage caused by erosion or other forces. Any major repairs shall be coordinated with USACE. Project inspections shall be made by the ILDNR Site Manager to ensure that the above maintenance measures are being effectively carried out and to verify the following:

- 1) Settlement, slough, or loss of section;
- 2) Wave wash and scouring;
- 3) Overtopping erosion;
- 4) Inadequate vegetative cover (too much or too little);
- 5) Unauthorized grazing or traffic;
- 6) Encroachments;
- 7) Unfavorable tree/shrub growth; and
- 8) Seepage distress.

Such inspections shall be made prior to the beginning of an inundation period, immediately following major high water periods, and otherwise at intervals necessary to insure the best care of the spillway or once per year. Steps shall be taken to correct conditions disclosed by such inspections. Regular maintenance repair measures shall be accomplished during the appropriate season as scheduled by the ILDNR Site Manager. All routine maintenance and corrective actions completed shall be documented in the inspection report found in Appendix D.

**9.1.2. Spillway Access Road.** The ILDNR Site Manager shall conduct annual observations of the spillway access road. The road shall be maintained to the design cross section and be free of ruts. Any significant displacement of the granular surfacing should also be noted and repaired as necessary.

**9.1.3. Outlet Structure.** The outlet structure shall be inspected annually and immediately following a high water event to determine whether seepage is taking place along the lines of its contact with the embankment. Corrective action shall be taken upon discovery of any adverse conditions at the structure. Project inspections of the outlet structure shall be made by the ILDNR Site Manager to verify the following:

- 1) Slide gate and stop logs are in good operating condition;
- 2) Riprap is clear of unwanted woody vegetation;
- 3) No displacement of riprap has occurred;
- 4) Inlet and outlet channels are open;
- 5) Care is being exercised to prevent the accumulation of trash and debris; and
- 6) Erosion is not occurring adjacent to the structure that may endanger its function.

Steps shall be taken to repair damage, replace missing or broken parts, or remedy adverse conditions disclosed by such inspections.

**9.1.4. Discharge Channel.** The ILDNR Site Manager shall perform annual observations of the excavated channel. If debris such as fallen trees blocks portions of the channel, the debris could cause the water velocity to slow down and drop sediment.

The debris should be removed if potential sedimentation could occur as a result. The ILDNR Site Manager shall also conduct periodic inspections and report any significant sedimentation. Areas that appear to be filling in with sediment should be identified for closer monitoring and identified for maintenance dredging. Steps should be taken to remedy adverse conditions.

**9.1.5. Discharge Structure.** The ILDNR Site Manager shall conduct annual observations of the riprap at the discharge structure to observe unwanted tree growth. Keep the riprap clear of woody vegetation. Annual observation of any significant riprap displacement should also be noted and repaired as necessary.

**9.1.6. Pump Station.** The pump station and all associated items shall be properly maintained to not adversely impact the Project. Specific pump maintenance should be performed as determined by the ILDNR Site Manager in accordance with the pump manufacturer's O&M manual. See Appendix F. Before commencing any maintenance work, the pump should be completely disconnected from the mains by qualified personnel, properly locked out and tagged out, and care should be taken that it cannot be inadvertently switched back on.

The ILDNR Site Manager shall perform inspections of the pump station as necessary, but at a minimum, no less than once per year. Ideally, routine inspections will occur prior to pump operation in the fall. Steps shall be taken to correct conditions disclosed by such inspections. In addition, the ILDNR Site Manager may request the USACE to perform a periodic pump station inspection. Project inspections shall be made by the ILDNR Site Manager to ensure that the above maintenance measures are being effectively carried out and to check the following:

**1) Structure:** Visually inspect all structural surfaces to discover any adverse conditions such as cracks or excessive corrosion. Conditions that may affect the integrity of the structure shall be corrected as soon as practicable.

**2) Electrical:** Inspect the pump's electrical power and control cables in the manholes and at the pump station for evidence of damage or deterioration. The lower junction boxes and the elevated junction boxes at the pump station to include the electrical cables and connections will be examined closely and their overall condition assessed. Any damage to the conduits, evidence of leakage in the electrical junction box enclosures, or deterioration of electrical terminations or power blocks shall be repaired as needed. The lower junction boxes may endure flood water which can deposit silt inside the enclosures. Dried silt that may be existing in the bottom of the lower junction boxes should be removed and if the enclosures were flooded then each enclosure drain should also be cleaned so they allow drainage and breathing as intended.

**3) Pump:** The pump shall be observed for indications of improper operation or damage. Avoid operation of pump during sump cavitation or ice conditions. The lifting tools to include chains and shackles should be visually checked in regular intervals, approximately every 3 months, for wear and corrosion. These parts should be replaced if required. The pump manufacturer recommends that the pumps be run for a maximum of 1 minute every 3 months in order to check both its functioning and availability. However, it is further recommended that the pumps be operated throughout the year at least once per week for 30 minutes each when ice conditions do not persist to minimize the amount of sediment accumulation in the pump chambers. When river elevations are above the top slab of the pump station, only operate one pump at a time and monitor for erosion of surrounding soils along the box culvert alignment.

**4) Bulkhead:** The bulkhead shall be properly secured on site or stored off site to prevent vandalism or loss during high water events. The bulkhead shall be installed in the proper slot prior to removing a pump for repair or maintenance.

**5) Trash Rack:** The ILDNR Site Manager shall periodically check for trash accumulation at rack and clear as necessary. If operating conditions or observations indicate an issue is developing and as operating conditions will permit, inspections shall be routinely performed to investigate general condition. It is recommend that the trash rack be cleared of floating and sunken debris routinely during pump operation and annually for regular scheduled maintenance.

**6) Sump:** The ILDNR Site Manager shall periodically check the sump for proper water depth and sedimentation, especially prior to extended operation. Accumulated sediments in the sump may cause cavitation and interfere with the proper operation of the pump. It is recommended that the pumps be operated periodically throughout the year, at least once per month when ice conditions do not persist, to minimize sediment accumulation in the sump.

**9.1.7. Control Building.** Inspect the MCC for evidence of insects, corrosion, or other deterioration. Inspect the pump's electrical power and control cables inside and under the control building for evidence of damage or deterioration. Any damage to the conduits or deterioration of electrical terminations or power blocks shall be repaired as needed. All electrical lighting and associated wiring shall be examined closely and their overall condition assessed. Any corroded, loose, or broken contacts shall be cleaned, tightened and repaired as needed. Information on the light fixtures and ballasts is provided in Appendix I. Inspection and maintain the building ventilation system to include the exhaust fan. Clean intake screens of dust and cottonwood fluff. Inspect and maintain the electric unit heaters. Once a year inspect the control panel wiring to make certain insulation is intact and all connections are tight. Inspect all heater and relay contacts. If the contacts appear badly pitted or burned, replace the contactor/relay. Clean the unit heater casing, fan and motor once a year. A dirty motor will tend to run hot and eventually will be damaged internally. Any rust spots on the casing should be cleaned and repainted.

**9.1.8. Water Control Structures.** The water control structures shall be inspected annually and immediately following a high water event to determine whether seepage is taking place along the lines of its contact with the embankment. Corrective action shall be taken upon discovery of any adverse conditions at the structures. The ILDNR Site Manager shall inspect place along the lines of its contact with the embankment. Corrective action shall be taken upon discovery of any adverse conditions at the structures. The ILDNR Site Manager shall inspect the water control structures to verify the following:

- 1) Stoplog channels are clear of debris and the stoplogs are present;
- 2) Inlet and outlet channels are open;
- 3) Care is being exercised to prevent the accumulation of trash and debris; and
- 4) Erosion is not occurring adjacent to the structure that may endanger its function.

Steps shall be taken to repair damage, replace missing or broken parts, or remedy adverse conditions disclosed by such inspections.

**9.1.9. Miscellaneous Features.** Any other feature not discussed in this O&M manual but nevertheless constructed as a part of the Project, or which function as a part of or affect the efficient functioning of the Project, shall be routinely inspected by the ILDNR Site Manager and



appropriate maintenance measures taken. Features with damaged or unserviceable parts shall be repaired or replaced without delay.

**9.2. Inspections.** An active maintenance program is based on inspections and subsequent servicing, adjustment, or repair. An effective maintenance program ensures Project serviceability by timely and thorough inspections, thereby avoiding or reducing maintenance costs. Also, by documenting the condition of the Project, a baseline for consideration of rehabilitation can be established for Project damage resulting from a major storm or flood event. The two types of inspections for the Project are: (1) routine inspections by the ILDNR Site Manager and (2) joint inspections by the ILDNR Site Manager and the USACE. A blank inspection form is shown in Appendix D. Should any improvements or modifications be made to the Project, additional instructions may become necessary for proper operation and maintenance.

**9.2.1. Routine Inspections.** Routine inspections of the Project shall be performed by the ILDNR Site Manager or an appropriate representative for the purpose of noting deficiencies and initiating corrective actions. This inspection will be performed at periods not exceeding 12 months and will follow inspection guidance presented in subsequent sections of this manual. It is suggested that the inspection be conducted late summer or early fall, which would be representative of post-flood season conditions but prior to pumping operations. Additional routine inspections should occur as necessary when determined by the ILDNR Site Manager. A Project inspection checklist has been developed and is presented in Appendix D. The ILDNR Site Manager shall furnish a copy of the completed checklist to the USACE, Rock Island District, ATTN: UMRR MVR Project Manager, CEMVR-PM-M, Clock Tower Building, P.O. Box 2004, Rock Island, Illinois 61204-2004, immediately following each routine inspection.

**9.2.2. Joint Inspections.** Joint inspections of the Project should be performed periodically by the ILDNR Site Manager and the USACE. The purpose of this inspection is to monitor performance and to assure that adequate maintenance is being performed as presented in the DPR and this manual. The District Engineer or authorized representative shall have the right to enter all portions of the Project upon coordination with the ILDNR Site Manager for this purpose. After a joint inspection, the USACE shall provide the ILDNR with a copy of the performance evaluation report.

**a. Post-Flood Inspections.** If a major storm or flood event is forecasted, it is recommended that the ILDNR Site Manager take photographs of the pre-flood condition of major Project features. The ILDNR Site Manager shall request a joint inspection with the USACE immediately following a specific storm or flood event which causes damage exceeding the annual O&M as specified in the DPR and this manual. It is recommended to notify the project cooperators as well. The routine inspections by the ILDNR Site Manager and the joint inspection results will be the basis for determining maintenance responsibility and potential rehabilitation by the USACE. Along with the request for a joint inspection, the ILDNR shall compile and provide a post-flood report. The report shall outline a complete history of the flood event to include the following:

- 1) Date damages incurred;
- 2) Description of damages sustained;
- 3) Photographs of damages sustained and pre-flood condition (if available);
- 4) A daily tabulation of river stages throughout the event from the nearest river gage;
- 5) Date of last inspection and a copy of the completed inspection checklist; and
- 6) Any other useful information.

**9.2.3. Inspection Timeline.** Table 9.2 presents a general guideline of the Project's proposed inspection schedules. The actual schedule will vary due to unforeseen conflicts, individual schedule constraints, and weather.

**Table 9.2. Inspection Timeline**

<b>Timeframe</b>	<b>Action</b>
Late summer/early fall	ILDNR performs routine inspection prior to pump operation
Late fall /early winter	ILDNR submits inspection results. See template in Appendix D
After major flood events	USACE and ILDNR conducts post-flood inspection

## **10. REPAIR, REPLACEMENT AND REHABILITATION**

Repair, Replacement and Rehabilitation actions are to conform to the Project as-builts, reference Appendix A, unless otherwise approved by the USACE and shall be performed in accordance with the project PPA. Deficient or deferred Project maintenance items, obvious when the damage occurs, must be accomplished by or at the expense of ILDNR.

**10.1. Repair.** Repairs are those activities of a routine nature that maintain the Project in good condition after it has been damaged by a natural or manmade cause.

**10.2. Replacement.** Replacement covers features that no longer operate or function as designed and must be replaced.

**10.3. Rehabilitation.** Rehabilitation refers to those activities of a more significant nature to restore the Project to good condition after it has been damaged. The options of rehabilitation or abandonment of the Project may be considered at such time that damage exceeds O&M requirements. Any decision would be carried forth only upon written mutual agreement of the ILDNR and the USACE.

## **11. CONTACT INFORMATION**

**11.1. Chain of Command.** The main point of contact for the Project is the ILDNR Site Manager, Scott Schlueter. Additional key personnel in the ILDNR that are listed as points of contact are the Civil Engineer, Arthur Neal and the HREP Coordinator, Lawrence Patterson. The chain of command for the USACE starts with the Project Engineer, who will be on site with the ILDNR after a flood event. This person will pass information along to the UMRR MVR Project Manager. Contact information is available in Sections 11.2 and 11.3.

**11.2. State Personnel.** The Project is managed by the ILDNR. It is located in the Rice Lake SFWA which has its administration buildings located onsite at address below. The ILDNR is required to provide the USACE with a current listing of ILDNR officials. It is the ILDNR's responsibility to maintain and update this list accordingly. The following is contact information for key State personnel as of September 2021.

**Illinois Department of Natural Resources, Rice Lake State Fish & Wildlife Area**

19721 N US 24

Canton, IL 61520

<http://dnr.state.il.us/Lands/Landmgt/PARKS/R1/Rice.htm>

Scott Schlueter, Site Manager



**Illinois Department of Natural Resources**

One Natural Resources Way

Springfield, IL 62702-1271

<https://www.dnr.illinois.gov/Pages/default.aspx>

Arthur Neal, Civil Engineer

(217) 785-4847  
[REDACTED]

Chad Craycraft, Federal Programs Coordination Manager

(217) 782-9211  
[REDACTED]

**11.3. Federal Personnel.** The following is a list of Federal personnel as of September 2021.

**US Army Corps of Engineers, Rock Island District**

Clock Tower Building, PO Box 2004

Rock Island IL 61204-2004

<http://www.mvr.usace.army.mil>

Marshall Plumley, UMRR Regional Program Manager

[REDACTED]

Julie Millhollin, UMRR MVR Project Manager

[REDACTED]

Rachel Fellman, Project Engineer

[REDACTED]

**National Weather Service – Forecast Office Lincoln, IL**

1362 IL-10

Lincoln, IL 62656

River Forecasts: (217) 732-3089

<http://www.weather.gov/ilx/>

**OPERATION AND MAINTENANCE MANUAL**  
**RICE LAKE STATE FISH AND WILDLIFE AREA**  
**UPPER MISSISSIPPI RIVER RESTORATION**  
**HABITAT REHABILITATION AND ENHANCEMENT PROJECT**  
**FULTON COUNTY, ILLINOIS**

**SEPTEMBER 2021**

**APPENDIX A**  
**AS-BUILT DRAWINGS AND CROSS SECTIONS**

## **APPENDIX A**

### **AS-BUILT DRAWINGS AND CROSS SECTIONS**

#### **TABLE OF CONTENTS**

1. Construction Stage I As-Built Drawings with Post-Construction Junction Boxes .....	A-1
2. Construction Stage I Overflow Spillway Final Cross Sections .....	A-117
3. Construction Stage I Discharge Channel Final Cross Sections .....	A-127





ILLINOIS WATERWAY  
LAGRANGE POOL  
FULTON COUNTY, IL  
RICE LAKE HABITAT REHAB & ENHANCEMENT  
STAGE I

Solicitation: W912EK-11-R-0029

Contract: W912EK-11-C-0090

June 2011

THIS PROJECT WAS DESIGNED BY THE ROCK ISLAND DISTRICT CORPS OF ENGINEERS. THE INITIALS OR SIGNATURES AND REGISTRATION DESIGNATIONS OF INDIVIDUALS APPEAR ON THESE PROJECT DOCUMENTS WITHIN THE SCOPE OF THEIR EMPLOYMENT AS REQUIRED BY ER 1110-1-8152. SIGNATURES INDICATE OFFICIAL RECOMMENDATION OF ALL DRAWINGS IN THIS SET.

APPROVED BY: [Signature] 5 JUL 2011  
DISTRICT COMMANDER DATE

APPROVAL RECOMMENDED BY:

[Signature] 1 July 2011  
CHIEF, DESIGN BRANCH DATE

[Signature] P.E. 5 JUL 2011  
CHIEF, HYDROLOGY & HYDRAULICS BRANCH DATE

[Signature] P.E. 5 July 2011  
CHIEF, GEOTECHNICAL BRANCH DATE

[Signature] 5 JUL 2011  
CHIEF, TECHNICAL SERVICES BRANCH DATE

[Signature] P.E. 5 JUL 2011  
CHIEF, ENGINEERING & CONSTRUCTION DIVISION DATE

[illegible]





D

C

B

A

INDEX					
Sheet ID	TITLE OF DRAWING		Sheet ID	TITLE OF DRAWING	
GENERAL			STRUCTURAL		
G-001	COVER SHEET		S-201	PUMP STATION WING WALL ELEVATIONS	
G-002	LOCATION PLAN, VICINITY MAP AND LEGEND		S-202	DISCHARGE STRUCTURE AND CULVERT ELEVATION	
G-003	INDEX, ABBREVIATIONS, GENERAL NOTES AND SCOPE OF WORK		S-203	CONTROL BUILDING ELEVATIONS AND SECTION	
	SURVEY		S-204	OUTLET STRUCTURE END ELEVATIONS	
V-101	SURVEY CONTROL DIAGRAM				
V-102	PUMP STATION LAYOUT		S-301	PUMP STATION SECTIONS	
	GEOTECHNICAL		S-302	PUMP STATION REINFORCEMENT	
B-101	BORING LOCATIONS		S-303	PUMP STATION REINFORCEMENT IN WALLS	
			S-304	PUMP STATION REINFORCEMENT IN BEAMS	
B-301	BORING LOGS I		S-305	PUMP STATION WING WALL REINFORCEMENT	
B-302	BORING LOGS II		S-306	DISCHARGE STRUCTURE REINFORCEMENT	
B-303	BORING LOGS III		S-307	CULVERT REINFORCEMENT	
B-304	BORING LOGS IV		S-308	CONTROL BUILDING ROOF FRAMING	
	CIVIL		S-309	OUTLET STRUCTURE SECTIONS	
C-101	OVERALL SITE PLAN		S-310	OUTLET STRUCTURE CONCRETE REINFORCEMENT DETAILS SHEET 1 OF 2	
C-102	OVERFLOW SPILLWAY PLAN AND PROFILE STA. 0+00 TO 25+00		S-311	OUTLET STRUCTURE CONCRETE REINFORCEMENT DETAILS SHEET 2 OF 2	
C-103	OVERFLOW SPILLWAY PLAN AND PROFILE STA. 25+00 TO 50+00				
C-104	OVERFLOW AND NATURAL SPILLWAY PLAN AND PROFILE STA. 50+00 TO 75+00		S-501	PUMP STATION TRASH RACK DETAILS SHEET 1 OF 2	
C-105	NATURAL SPILLWAY PLAN AND PROFILE STA. 75+00 TO 100+00		S-502	PUMP STATION TRASH RACK DETAILS SHEET 2 OF 2	
C-106	NATURAL SPILLWAY PLAN AND PROFILE STA. 100+00 TO 125+00		S-503	BULKHEAD	
C-107	NATURAL SPILLWAY PLAN AND PROFILE STA. 125+00 TO 150+00		S-504	PUMP STATION BULKHEAD OPENINGS	
C-108	NATURAL SPILLWAY PLAN AND PROFILE STA. 150+00 TO 175+00		S-505	PUMP STATION GRATED HATCH OPENINGS	
C-109	NATURAL SPILLWAY PLAN AND PROFILE STA. 175+00 TO 200+00		S-506	CONTROL BUILDING FOUNDATION REINFORCEMENT & PILE CONNECTION DETAILS	
C-110	NATURAL SPILLWAY PLAN AND PROFILE STA. 200+00 TO 225+00		S-507	PUMP STATION HANDRAIL DETAILS	
C-111	NATURAL SPILLWAY PLAN AND PROFILE STA. 225+00 TO 240+82		S-508	PUMP STATION SIPHON OPENING DETAILS	
C-112	OUTLET STRUCTURE SITE PLAN		S-509	CONTROL BUILDING DETAILS SHEET 1 OF 2	
C-113	NATURAL SPILLWAY REPAIR AREA 1 SITE PLAN		S-510	CONTROL BUILDING DETAILS SHEET 2 OF 2	
C-114	NATURAL SPILLWAY REPAIR AREA 2 SITE PLAN		S-511	OUTLET STRUCTURE HANDRAIL DETAIL	
C-115	NATURAL SPILLWAY REPAIR AREA 3 SITE PLAN		S-512	PUMP STATION NEW JUNCTION BOX DETAILS	
			S-519	SLIDE GATE TO STOPLOG CONVERSION DETAILS	
C-120	PUMP STATION GENERAL PLAN		S-520	WATER CONTROL STRUCTURES DETAILS SHEET 1 OF 2	
C-121	PUMP STATION SITE PLAN		S-521	WATER CONTROL STRUCTURES DETAILS SHEET 2 OF 2	
C-122	DISCHARGE CHANNEL PLAN AND PROFILE STA. 0+00 TO 20+00			MECHANICAL	
C-123	DISCHARGE CHANNEL PLAN AND PROFILE STA. 20+00 TO 45+00		M-101	PUMP STATION SECTIONAL PLAN	
C-124	DISCHARGE CHANNEL PLAN AND PROFILE STA. 45+00 TO 69+64		M-102	PUMP STATION TOP PLAN	
C-125	WATER CONTROL STRUCTURE PLAN AND SECTION STA. 25+00				
C-126	WATER CONTROL STRUCTURES PLAN AND SECTION STA. 37+60		M-201	PUMP STATION SECTION	
C-127	WATER CONTROL STRUCTURES PLAN AND SECTION STA. 64+80				
C-128	WATER CONTROL STRUCTURES PLAN AND SECTION STA. 69+00		M-501	PUMP STATION DETAILS	
			M-502	CONTROL BUILDING DETAILS	
C-201	OUTLET STRUCTURE SITE PROFILE			ELECTRICAL	
			E-001	ELECTRICAL SYMBOLS AND ABBREVIATIONS	
C-220	PUMP STATION PROFILE				
C-221	PUMP STATION ACCESS ROAD PROFILE AND GATE DETAILS		E-101	ELECTRICAL SITE PLAN	
			E-102	PUMP STATION ELECTRICAL PLAN	
C-301	OVERFLOW AND NATURAL SPILLWAY TYPICAL SECTIONS		E-103	CONTROL BUILDING POWER AND LIGHTING PLANS	
C-302	OVERFLOW SPILLWAY SECTIONS		E-104	CONTROL BUILDING GROUNDING AND LIGHTNING PROTECTION PLAN	
C-303	NATURAL SPILLWAY SECTIONS		E-105	CONTROL BUILDING INSTRUMENTATION PLAN	
C-304	NATURAL SPILLWAY SECTIONS		E-106	PUMP STATION NEW JUNCTION BOX PLAN	
C-320	PUMP STATION TYPICAL SECTIONS		E-301	PUMP STATION NEW JUNCTION BOX ELEVATION	
C-321	PUMP STATION CROSS SECTIONS SHEET 1 OF 4		E-302	PUMP STATION NEW JUNCTION BOX ELEVATION	
C-322	PUMP STATION CROSS SECTIONS SHEET 2 OF 4				
C-323	PUMP STATION CROSS SECTIONS SHEET 3 OF 4		E-501	MANHOLE DETAILS	
C-324	PUMP STATION CROSS SECTIONS SHEET 4 OF 4		E-502	DUCT BANK AND MISCELLANEOUS ELECTRICAL DETAILS	
C-325	DISCHARGE CHANNEL TYPICAL SECTIONS		E-503	PUMP STATION NEW JUNCTION BOX DETAILS	
C-326	DISCHARGE CHANNEL CROSS SECTIONS SHEET 1 OF 6				
C-327	DISCHARGE CHANNEL CROSS SECTIONS SHEET 2 OF 6		E-601	SINGLE-LINE DIAGRAM	
C-328	DISCHARGE CHANNEL CROSS SECTIONS SHEET 3 OF 6		E-602	ELECTRICAL SCHEDULES	
C-329	DISCHARGE CHANNEL CROSS SECTIONS SHEET 4 OF 6		E-603	ELEMENTARY WIRING DIAGRAMS	
C-330	DISCHARGE CHANNEL CROSS SECTIONS SHEET 5 OF 6				
C-331	DISCHARGE CHANNEL CROSS SECTIONS SHEET 6 OF 6		ABBREVIATIONS:		
C-332	DISCHARGE CHANNEL RIPRAP AND SPILLWAY ACCESS ROAD TYPICAL SECTIONS		APPROX	APPROXIMATE	HSS HOLLOW STEEL SECTION
			ANSI	AMERICAN NATIONAL STANDARDS INSTITUTE	GALV GALVANIZED
			ASTM	AMERICAN SOCIETY FOR TESTING & MATERIALS	GR GRADE
C-420	PUMP STATION INTAKE BASIN SITE PLAN		BOT	BOTTOM	HOR HORIZONTAL
	STRUCTURAL		C/C	CENTER TO CENTER	IN INCH
S-001	PUMP STATION GENERAL NOTES		C/L	CENTERLINE	LONG LONGITUDINAL
			CJ	CONSTRUCTION JOINT	MFG MANUFACTURER
S-101	PUMP STATION PLANS		CLR	CLEAR	MAX MAXIMUM
S-102	PUMP STATION AND WING WALL PILE LAYOUT PLAN		CMU	CONCRETE MASONRY UNIT	MIN MINIMUM
S-103	PUMP STATION REINFORCEMENT IN TOP DECK		CONC	CONCRETE	NPS NOMINAL PIPE SIZE
S-103A	PUMP STATION SURGE BASIN WALLS REINFORCEMENT		DET	DETAILS	OC ON CENTER
S-104	PUMP STATION REINFORCEMENT IN WALLS AND BASE SLAB		DIA	DIAMETER	OPP OPPOSITE
S-105	PUMP STATION REINFORCEMENT IN WING WALLS AND BASE SLAB		DWG	DRAWING	PL PLATE
S-106	DISCHARGE STRUCTURE AND CULVERT PLAN		EA	EACH	PSI POUNDS PER SQUARE INCH
S-107	CONTROL BUILDING PLAN		EF	EACH FACE	PVC POINT OF VERTICAL CURVATURE
S-108	OUTLET STRUCTURE PLAN		EL	ELEVATION	PVI POINT OF VERTICAL INTERSECTION
S-109	OUTLET STRUCTURE CONCRETE REINFORCEMENT PLAN		ELEV	ELEVATION	PVT POINT OF VERTICAL TANGENCY
			EOP	END OF PIPE	R RADIUS
			EQ	EQUAL	REINF REINFORCEMENT
			EW	EACH WAY	REQ REQUIRED
			FB	FRAME BEAM	SEC SECTION

INDEX AND GENERAL NOTES

GENERAL NOTES

1. THE PROJECT IS LOCATED AT RICE LAKE STATE FISH AND WILDLIFE AREA, LOCATED IN FULTON COUNTY. THE PROPERTY IS OWNED BY THE ILLINOIS DNR. THE BANNER DYKE ROAD IS MAINTAINED BY BANNER TOWNSHIP.
2. THE CONTRACTOR SHALL STAGE AND STORE EQUIPMENT WITHIN THE STAGING AREAS AS SHOWN ON SHEET C-101 AND C-120 OR OTHERWISE DIRECTED BY THE CONTRACTING OFFICER.
3. THE PUBLIC WILL HAVE ACCESS TO THE BANNER DYKE ROAD, BOAT RAMP, AND PUBLIC PARKING AREAS AT THE UPSTREAM END DURING THE CONSTRUCTION OF THIS PROJECT.
  - a. THE CONTRACTOR SHALL SECURE WITH PORTABLE CHAIN LINK FENCING ANY EQUIPMENT OR SUPPLIES STORED IN THE PUBLIC ACCESS STAGING AREAS.
  - b. THE CONTRACTOR SHALL COORDINATE WITH THE CONTRACTING OFFICER FOR MAINTAINED PUBLIC ACCESS AREAS AND REQUIREMENTS.
4. THE CONTRACTOR SHALL BE RESPONSIBLE FOR LOCATING UTILITIES ON SITE PRIOR TO BEGINNING THE WORK AND SHALL BE RESPONSIBLE FOR REPAIRING ANY UTILITIES DAMAGED DURING CONSTRUCTION. UTILITY LOCATIONS SHOWN ARE APPROXIMATE.
5. THE CONTRACTOR MUST MAINTAIN ONE LANE OF TRAFFIC AT ALL TIMES ALONG THE BANNER DYKE ROAD.
  - a. THE CONTRACTOR SHALL INSTALL TEMPORARY TRAFFIC BARRICADES AND SIGNAGE FOR ANY LANE CLOSURES DURING NON-WORKING CONTRACTOR HOURS. LANE CLOSURES WILL NOT BE ALLOWED OVER THE WEEKENDS.
  - b. FLAGGERS WITH APPROPRIATE BARRICADES AND SIGNAGE MAY BE UTILIZED DURING CONTRACTOR WORKING HOURS.
  - c. PROPER TRAFFIC CONTROL SHALL BE PROVIDED BY CONTRACTOR IN ACCORDANCE WITH EM 385-1-1.
6. THE CONTRACTOR SHALL BE RESPONSIBLE FOR REPAIR/REPLACEMENT OF ANY ROADWAYS DAMAGED DUE TO CONSTRUCTION ACTIVITY.
7. ALL EXISTING DIMENSIONS SHOWN ON THESE PLANS SHALL BE FIELD-VERIFIED BY THE CONTRACTOR AND APPROVED BY THE CONTRACTING OFFICER.
8. CONTRACTOR SHALL COORDINATE, DETERMINE AND BE RESPONSIBLE FOR ADHERENCE TO AND COMPLIANCE WITH ALL NATIONAL, STATE, AND LOCAL CONSTRUCTION AND INSTALLATION CODES FOR THE PROJECT.
9. REFER TO SPECIFICATION SECTION 00 73 05 "ADDITIONAL PHYSICAL DATA CLAUSE INFORMATION" FOR HYDRAULIC DATA. LOCAL FLAT POOL IS EL. 429 NGVD 29. NAVD 88 EQUALS NGVD 29 LESS 0.34 FEET.
10. SURVEY:
  - a. COORDINATES ARE IN STATE PLANE NAD83, ILLINOIS WEST, US SURVEY FEET. VERTICAL DATUM IS IN NAVD 88 FEET, GEOID 09.
11. CONTRACTOR SHALL INSTALL AND MAINTAIN SILT FENCES WHERE REQUIRED.

SCOPE OF WORK  
THE SCOPE OF WORK FOR THIS PROJECT GENERALLY CONSISTS OF BUT SHALL NOT BE LIMITED TO THE FOLLOWING:

1. PUMP STATION:
  - a. THE CONTRACTOR SHALL VERIFY THE LOCATION OF EXISTING 24" WATER MAIN PRIOR TO CONSTRUCTION.
  - b. CONSTRUCT NEW CONCRETE CULVERT BETWEEN PUMP STATION AND DISCHARGE STRUCTURE.
  - c. CONSTRUCT NEW DISCHARGE STRUCTURE.
  - d. CONSTRUCT NEW PUMP STATION AND WING WALLS ON PILES WITH 3 SUBMERSIBLE PUMPS.
  - e. CONSTRUCT NEW PUMP STATION CONTROL BUILDING WITH MOTOR CONTROL CENTER.
  - f. PLACE ADDITIONAL EMBANKMENT FILL ON THE WEST SIDE OF THE BANNER DYKE ROAD FOR PUMP STATION CONTROL BUILDING PARKING.
  - g. COORDINATE WITH THE UTILITY FOR INSTALLATION OF UTILITY TRANSFORMER, METER, CONDUITS, AND UTILITY CONNECTIONS.
  - h. CONSTRUCT A NEW GRANULAR ACCESS ROAD OFF THE BANNER DYKE ROAD WITH SWING GATE.
  - i. PLACE RIPRAP WHERE SHOWN.
  - j. INSTALL JERSEY BARRIERS ALONG PUMP STATION PARKING AREA.
  - k. THE CONTRACTOR SHALL GRADE AND SEED ALL DISTURBED OR NEWLY CONSTRUCTED AREAS.
2. DISCHARGE CHANNEL:
  - a. CONSTRUCT DISCHARGE CHANNEL FROM PUMP STATION DISCHARGE STRUCTURE TO EXISTING CHANNEL ALONG BANNER DYKE ROAD AND EXISTING BERM.
  - b. CONSTRUCT FOUR 24" AND SIX 48" WATER CONTROL STRUCTURES.
3. OVERFLOW SPILLWAY
  - a. THE CONTRACTOR SHALL CONSTRUCT THE PORTION OF THE OVERFLOW SPILLWAY THAT IS LOCATED ACROSS GOOSE LAKE WITH MATERIAL EXCAVATED FROM WITHIN GOOSE LAKE ADJACENT TO THE SPILLWAY ALIGNMENT.
  - b. THE REMAINDER OF THE OVERFLOW SPILLWAY SHALL BE CONSTRUCTED WITH MATERIAL EXCAVATED FROM THE DISCHARGE CHANNEL.
4. NATURAL SPILLWAY
  - a. CONSTRUCT NEW OUTLET STRUCTURE AND REGRADE CHANNEL.
  - b. REPAIR NATURAL SPILLWAY AT THREE LOCATIONS TO FILL IN LOW AREAS.
  - c. REMOVE THREE EXISTING STOPLOG STRUCTURES.




DATE	APPROVED	REVISION	DESCRIPTION
8/17/2011	RCF	1	AND 0001 REVISION NOTE
8/06/2014	RCF	2	MOD EAOIT ADD SHEET
			AS-BUILT AS OF 29 SEPTEMBER 2017

DATE: 26-10-2020	DESIGNED BY: RCF	OWN BY: C24	FILE NAME: EP102-0003.dgn
SOLICITATION NO.: 1002	CONTRACT NO.: 1002	PROJECT CODE: EP102	
U.S. ARMY CORPS OF ENGINEERS	ROCK ISLAND DISTRICT	ILLINOIS	

ILLINOIS WATERWAY  
LAKE HARBOR REPAIR & ENHANCEMENT  
STAGE I  
RICE LAKE HARBOR REPAIR & ENHANCEMENT  
INDEX, ABBREVIATIONS, GENERAL NOTES AND SCOPE OF WORK

Sheet ID  
G-003



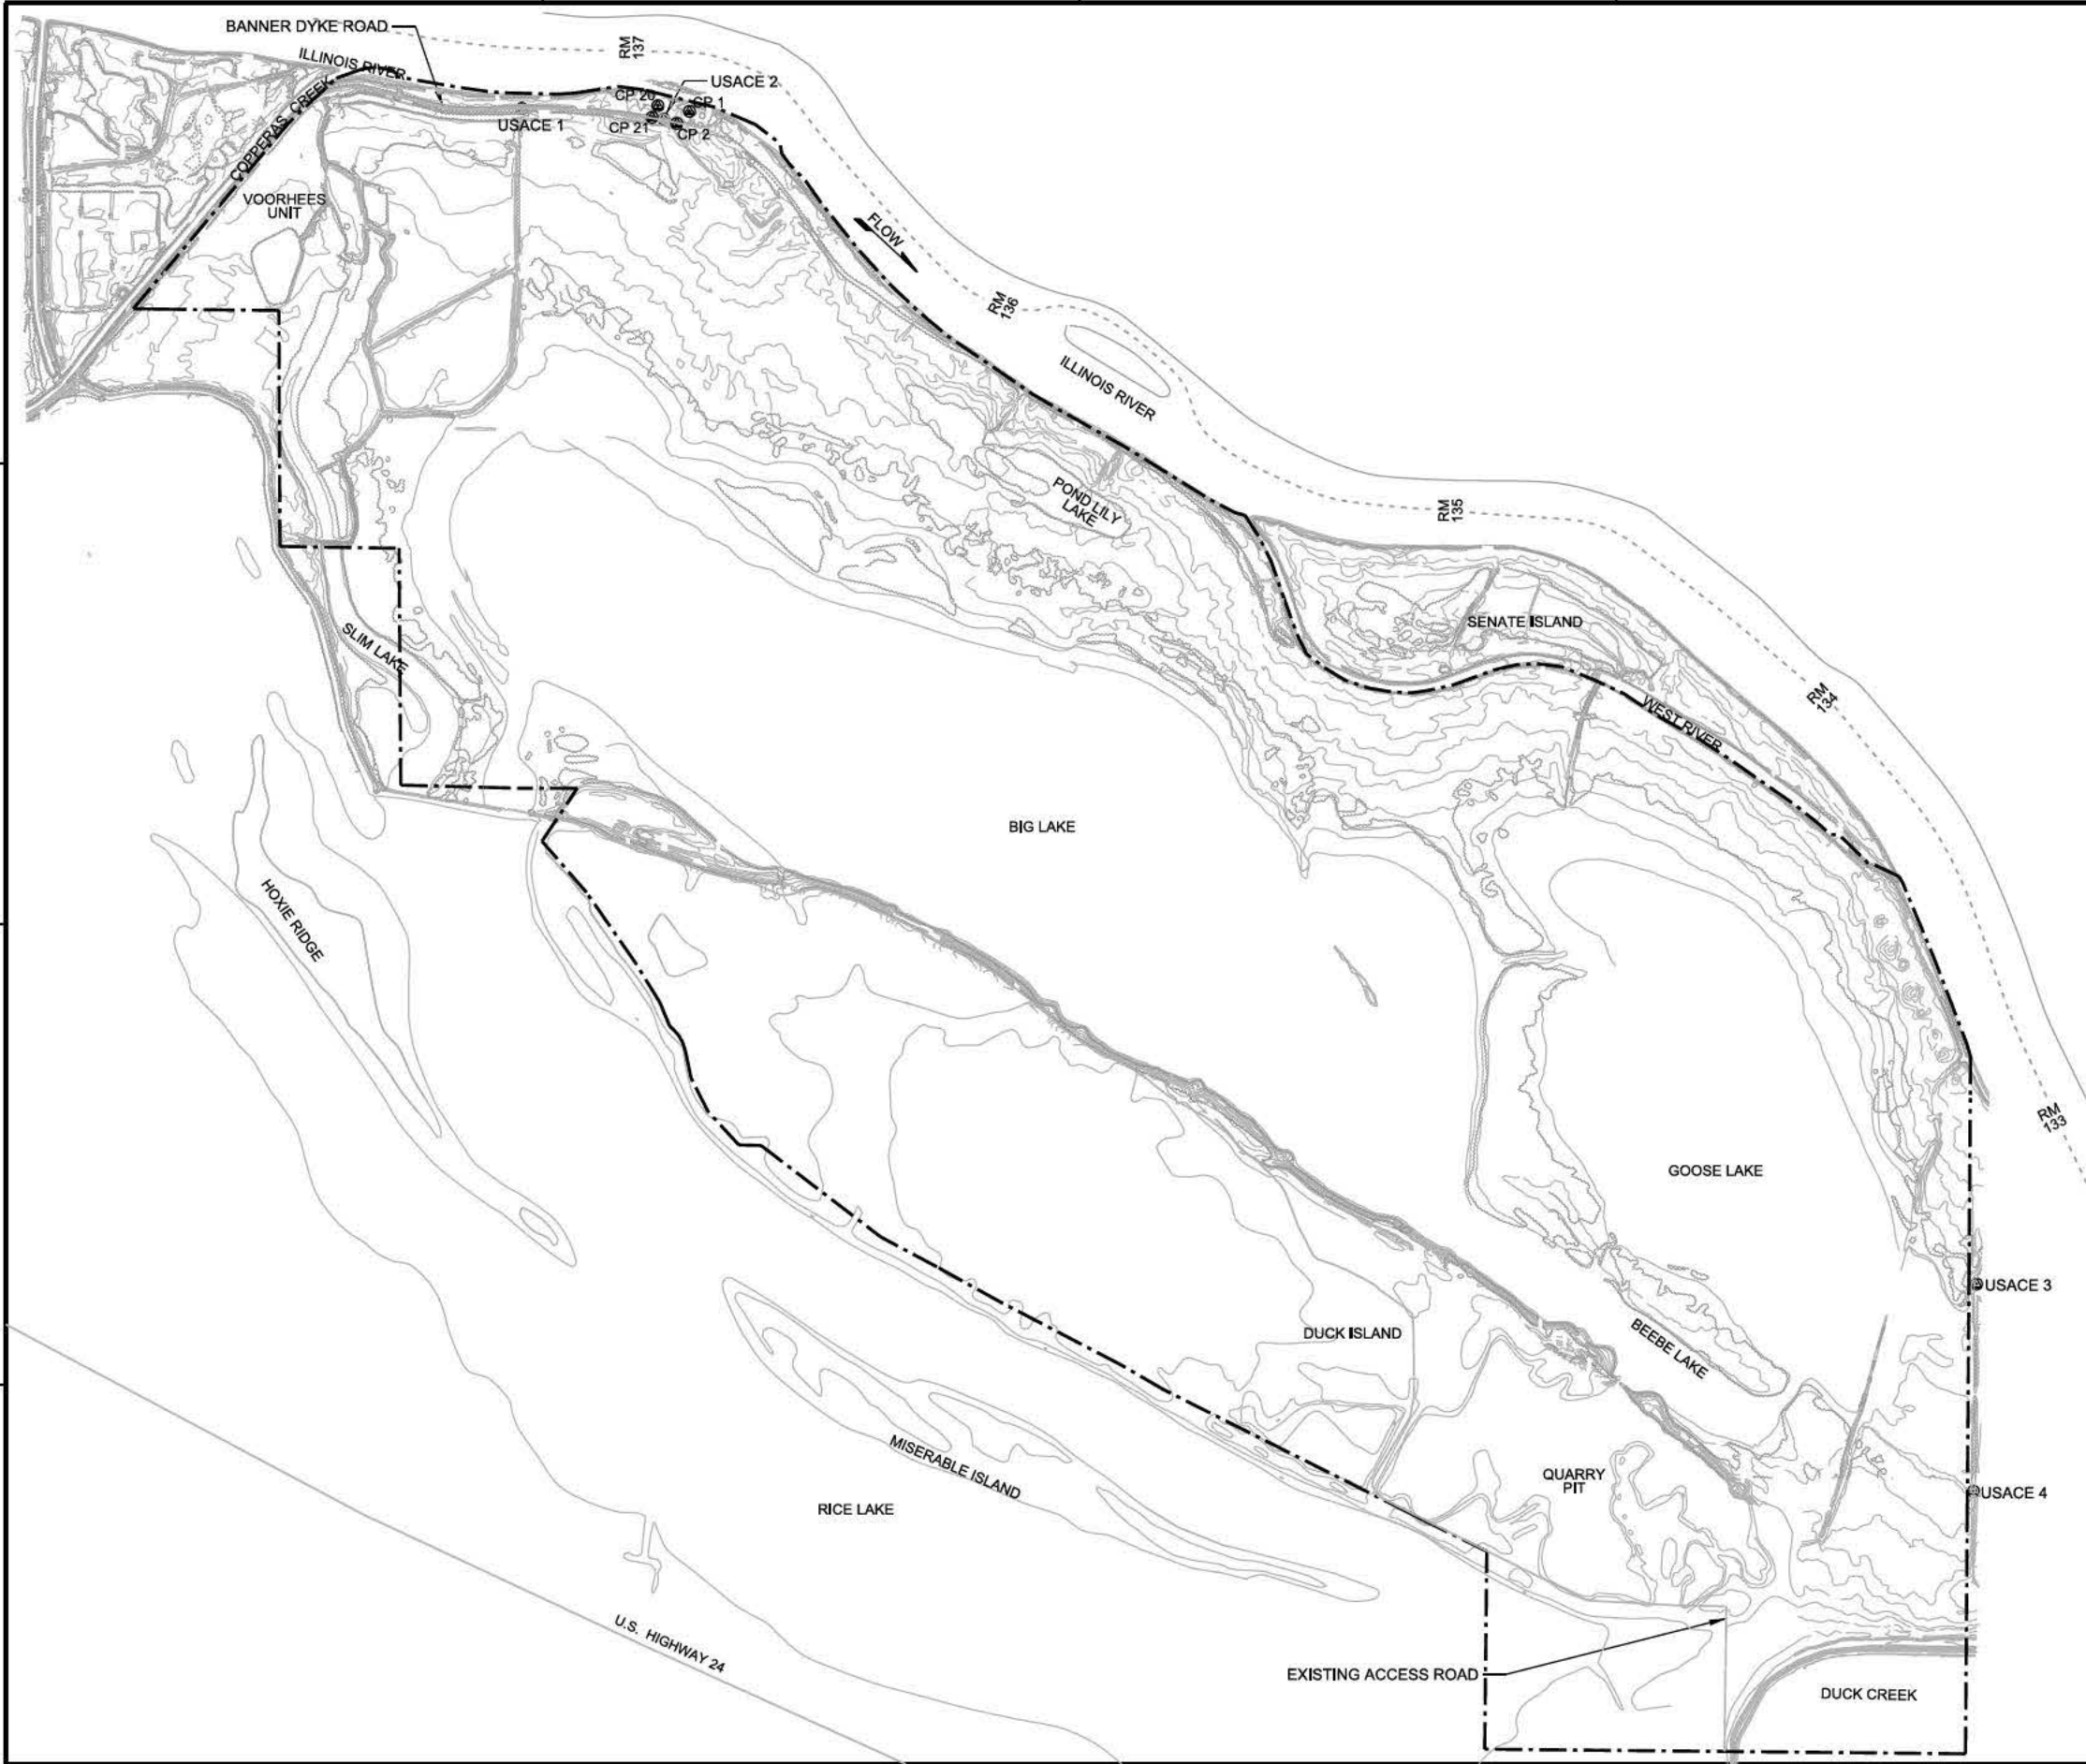

SITE CONTROL POINTS - GRID COORDINATES				
NAME	NORTHING	EASTING	ELEVATION	DESCRIPTION
CP 1	1387111.6790	2373762.7310	446.37	IRON ROD
CP 2	1387252.1940	2373627.4360	451.85	IRON ROD
CP 20	1387462.6475	2373825.4299	444.18	IRON ROD
CP 21	1387527.2129	2373695.3674	451.56	LANDSCAPE NAIL
USACE 1	1388977.082	2373798.561	450.76	MONUMENT
USACE 2	1387399.247	2373682.175	451.47	MONUMENT
USACE 3	1372787.020	2360714.173	441.12	MONUMENT
USACE 4	1372821.220	2358408.814	440.70	MONUMENT



DATE	DESCRIPTION
AS-BUILT AS OF 29 SEPTEMBER 2017	

U.S. ARMY CORPS OF ENGINEERS	DESIGNED BY:	DATE:
ROCK ISLAND DISTRICT	OWN BY:	20170920
ROCK ISLAND, ILLINOIS	CHD BY:	SOLICITATION NO.:
	SUBMITTED BY:	CONTRACT NO.:
	AS SHOWN	PROJECT CODE:
	FILE NAME:	EP102
	ANALYST:	EP102A101.dgn

ILLINOIS WATERWAY  
LAGRANGE POOL  
FLINTCROFT DAM  
RICE LAKE HABITAT REHAB & ENHANCEMENT  
STAGE I  
SURVEY CONTROL  
DIAGRAM

Sheet  
ID  
V-101

AS-BUILT  
A-4


 SURVEY CONTROL DIAGRAM

0 1000' 2000'  
SCALE: 1"=1000'



c:\pwworking\mvt5\calh\id0153722\EP102\1-102.dgn  
8/28/2018 3:08:49 PM  
BEDDLIN

A  
B  
C  
D

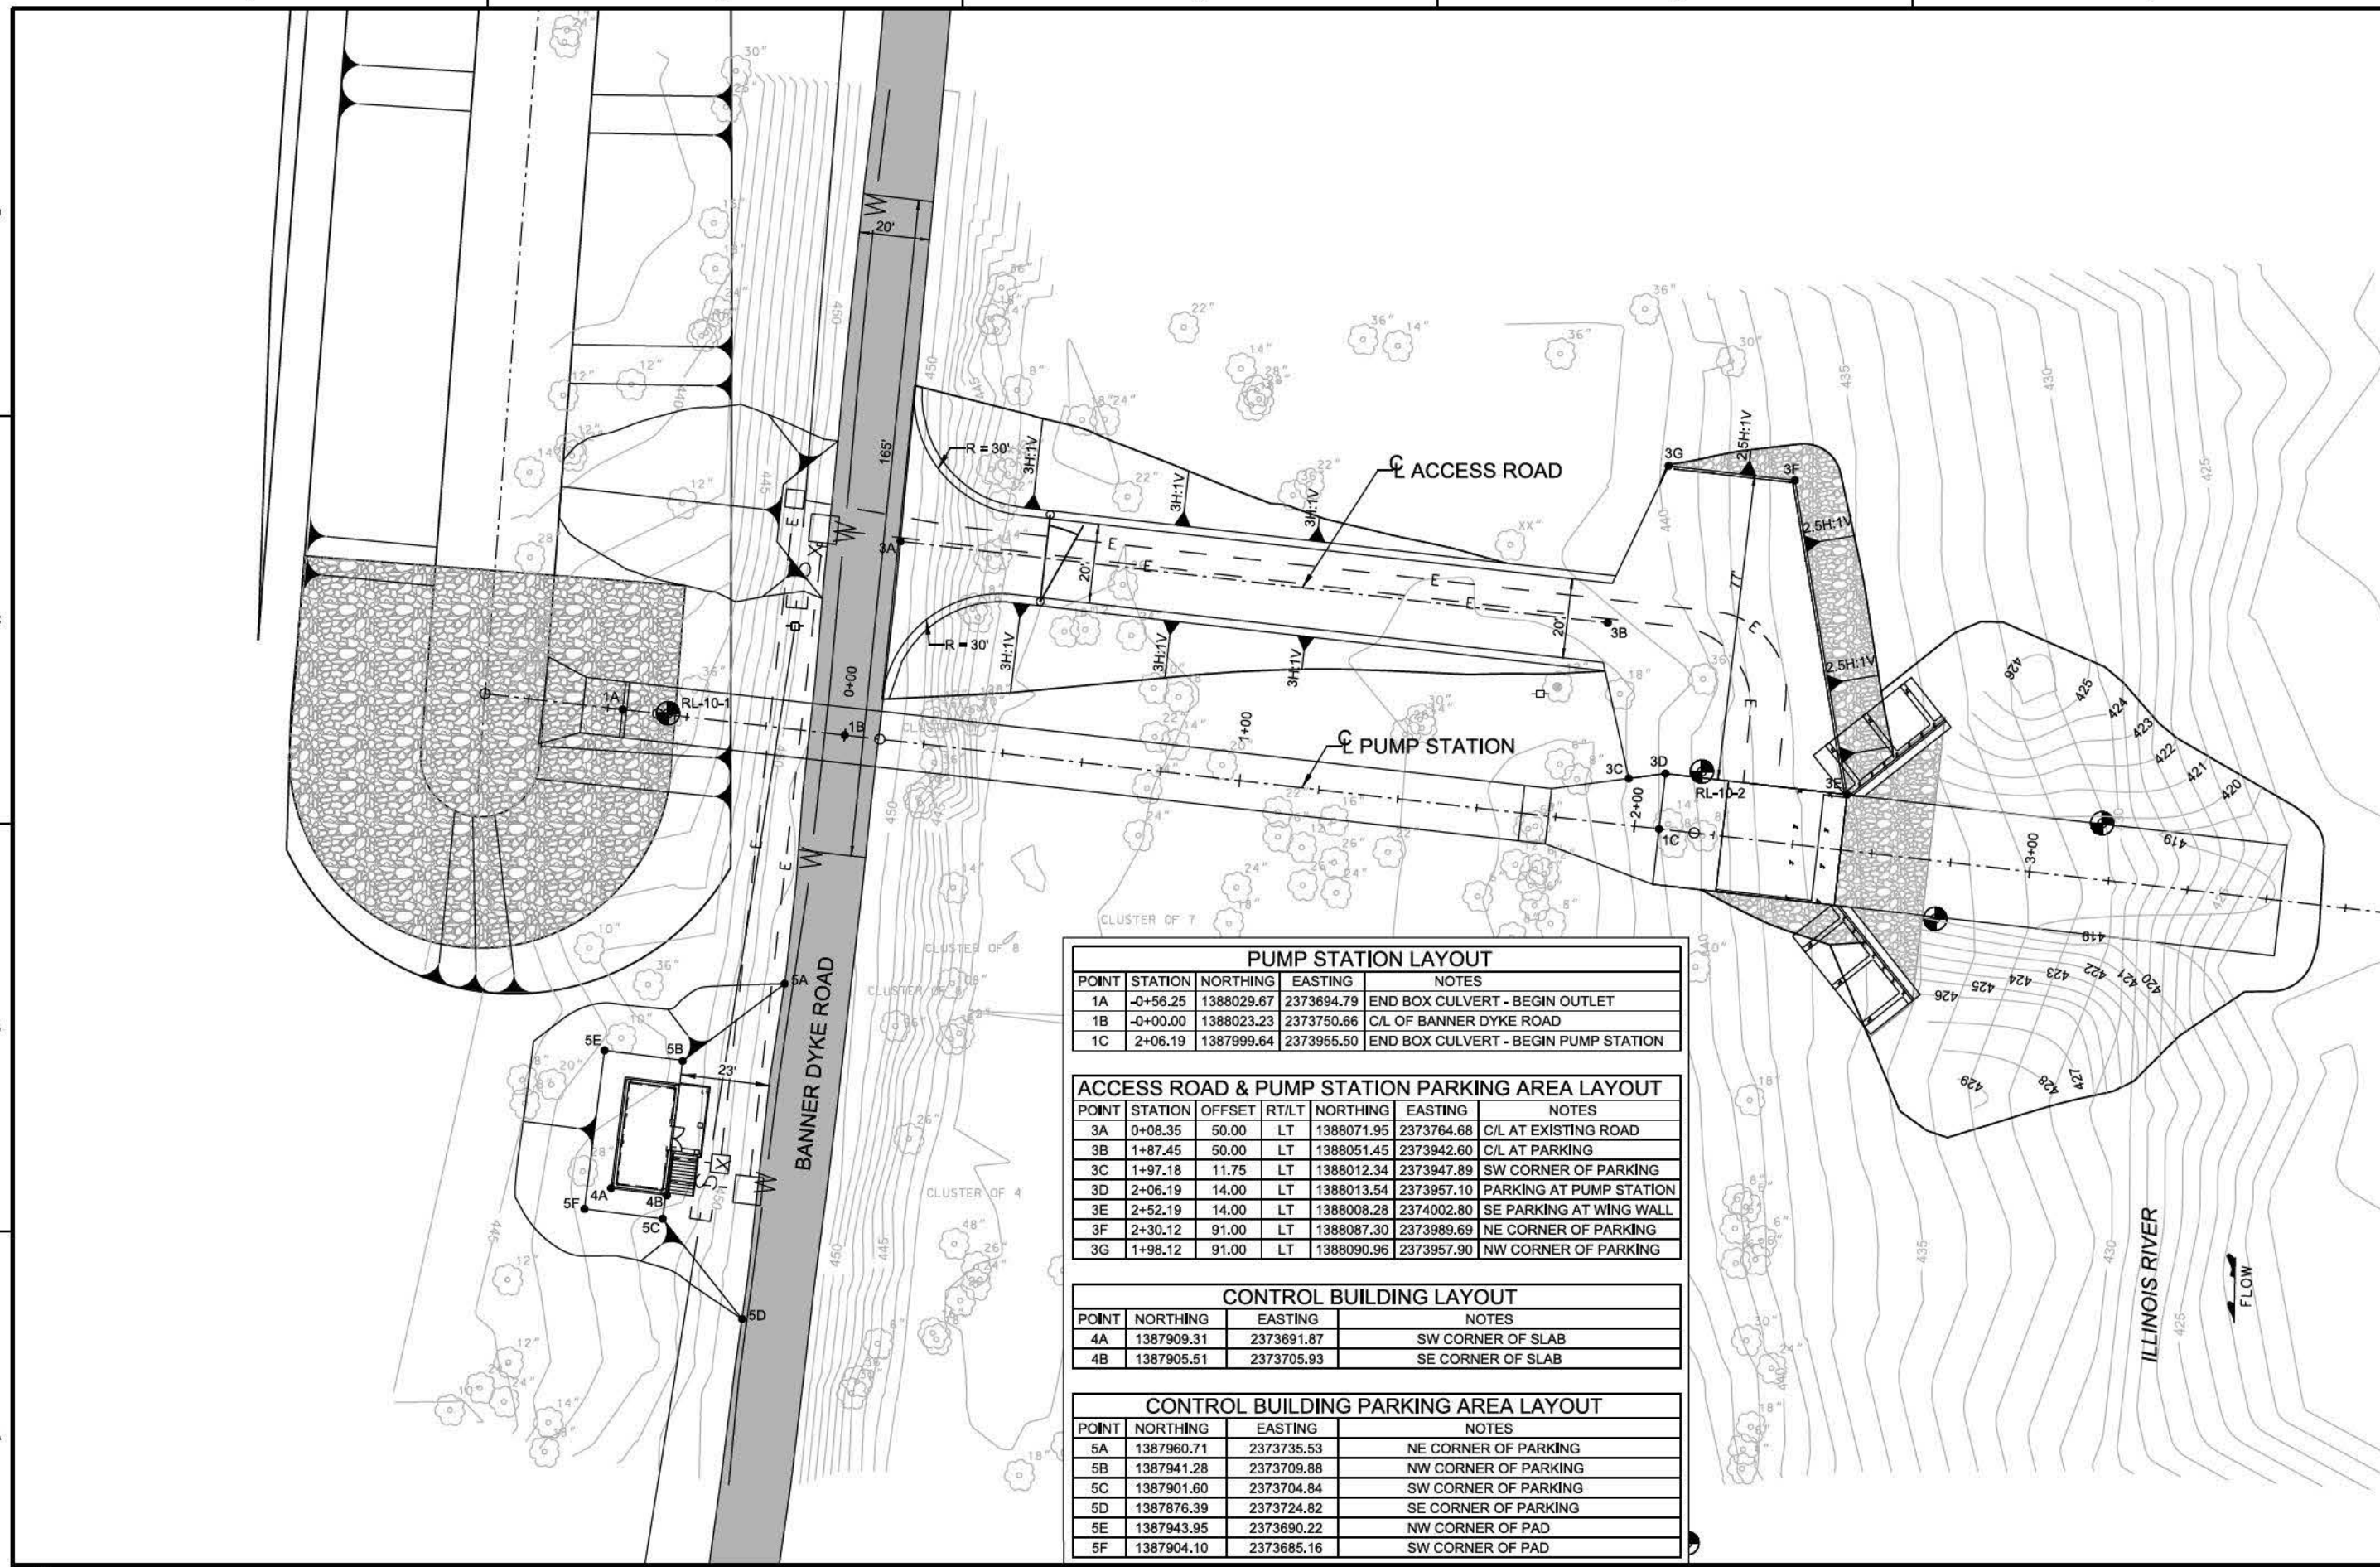

PUMP STATION LAYOUT					
POINT	STATION	NORTHING	EASTING	NOTES	
1A	-0+56.25	1388029.67	2373694.79	END BOX CULVERT - BEGIN OUTLET	
1B	-0+00.00	1388023.23	2373750.66	C/L OF BANNER DYKE ROAD	
1C	2+06.19	1387999.64	2373955.50	END BOX CULVERT - BEGIN PUMP STATION	

ACCESS ROAD & PUMP STATION PARKING AREA LAYOUT						
POINT	STATION	OFFSET	RT/LT	NORTHING	EASTING	NOTES
3A	0+08.35	50.00	LT	1388071.95	2373764.68	C/L AT EXISTING ROAD
3B	1+87.45	50.00	LT	1388051.45	2373942.60	C/L AT PARKING
3C	1+97.18	11.75	LT	1388012.34	2373947.89	SW CORNER OF PARKING
3D	2+06.19	14.00	LT	1388013.54	2373957.10	PARKING AT PUMP STATION
3E	2+52.19	14.00	LT	1388008.28	2374002.80	SE PARKING AT WING WALL
3F	2+30.12	91.00	LT	1388087.30	2373989.69	NE CORNER OF PARKING
3G	1+98.12	91.00	LT	1388090.96	2373957.90	NW CORNER OF PARKING

CONTROL BUILDING LAYOUT			
POINT	NORTHING	EASTING	NOTES
4A	1387909.31	2373691.87	SW CORNER OF SLAB
4B	1387905.51	2373705.93	SE CORNER OF SLAB

CONTROL BUILDING PARKING AREA LAYOUT			
POINT	NORTHING	EASTING	NOTES
5A	1387960.71	2373735.53	NE CORNER OF PARKING
5B	1387941.28	2373709.88	NW CORNER OF PARKING
5C	1387901.60	2373704.84	SW CORNER OF PARKING
5D	1387876.39	2373724.82	SE CORNER OF PARKING
5E	1387943.95	2373690.22	NW CORNER OF PAD
5F	1387904.10	2373685.16	SW CORNER OF PAD

US Army Corps of Engineers

DATE	DESCRIPTION
AS-BUILT AS OF 28 SEPTEMBER 2017	


DESIGNED BY: RCP	DATE: 26-10-2016	SOLICITATION NO.: 274
DRAWN BY: RCP	CHECKED BY: H.A.	CONTRACT NO.: W025K4-1-2006
PROJECT CODE: EP102	FILE NAME: EP102\1-102.dgn	ANALYST: ANALYST

ILLINOIS WATERWAY  
LAGRANGE POOL  
FISH HABITAT REPAIR & ENHANCEMENT  
STAGE I  
PUMP STATION LAYOUT

U.S. ARMY CORPS OF ENGINEERS  
ROCK ISLAND DISTRICT  
ROCK ISLAND, ILLINOIS

AS-BUILT



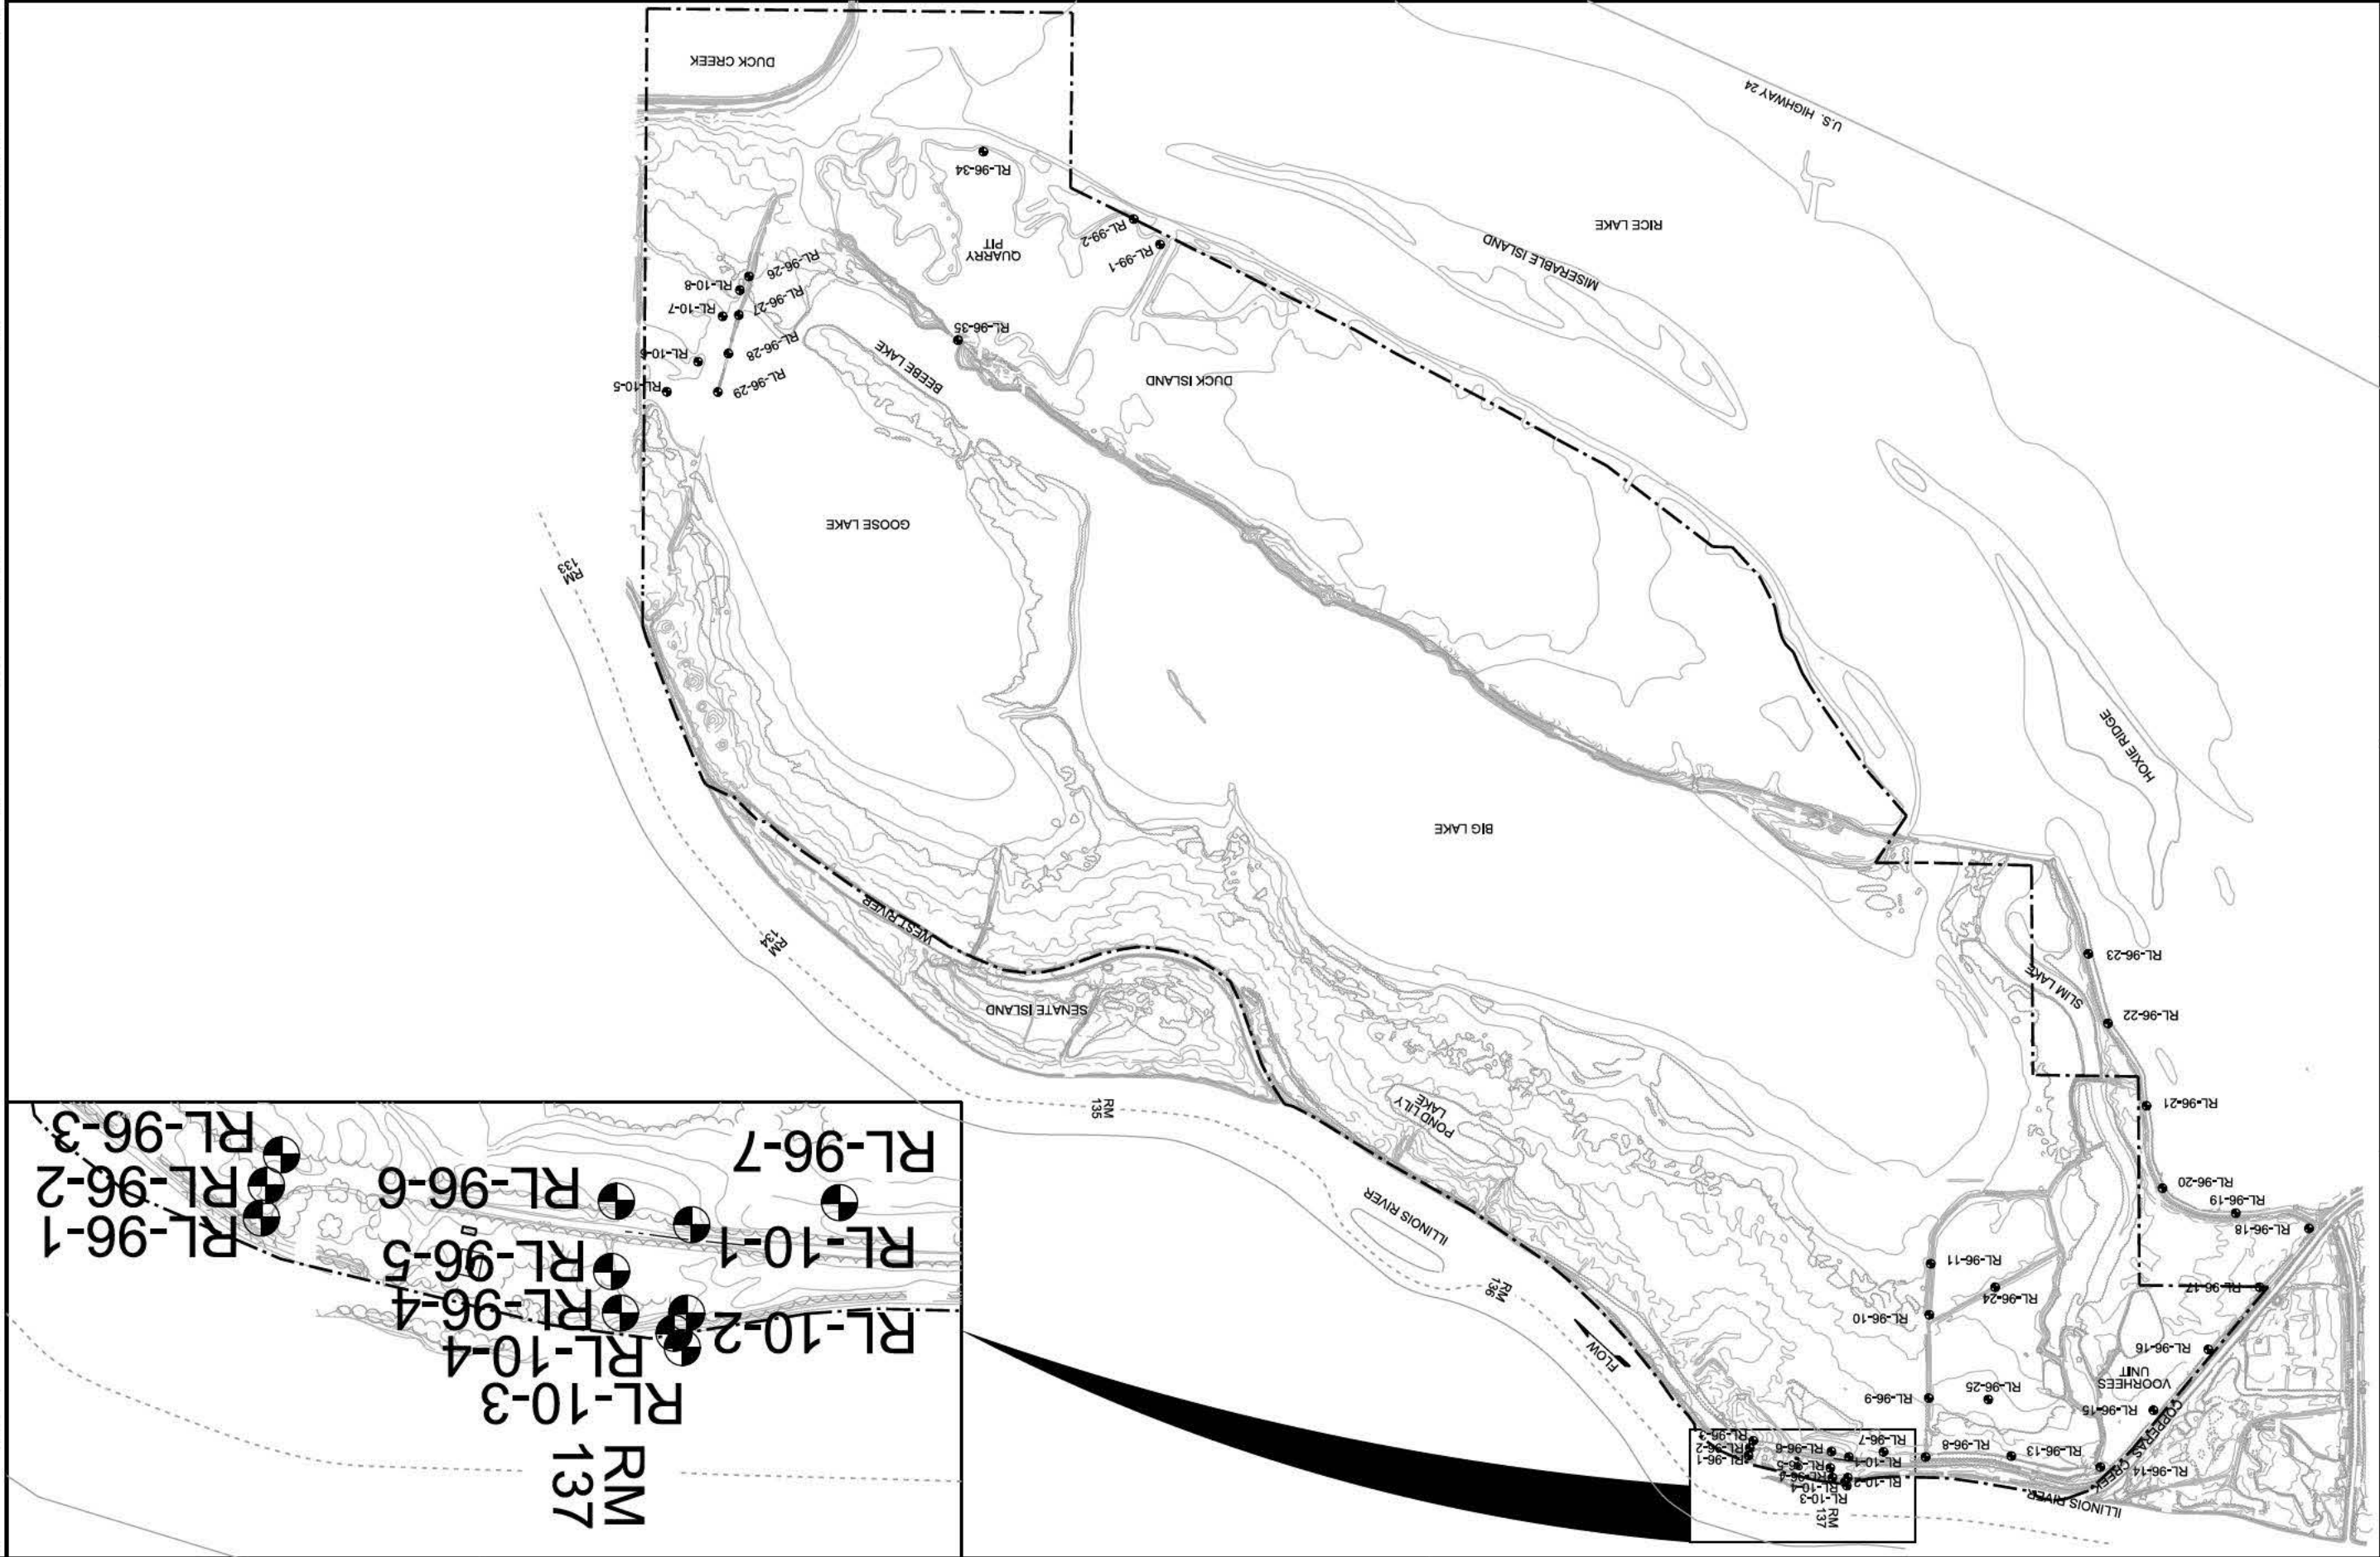

DESIGNED BY:				DATE:	
U.S. ARMY CORPS OF ENGINEERS				20100608	
ROCK ISLAND DISTRICT				SOLICITATION NO.:	
ROCK ISLAND, ILLINOIS				CONTRACT NO.:	
DRAWN BY:				CHECKED BY:	
SCALE:				PROJECT CODE:	
DATE:				PROJECT CODE:	
FILE NAME:				PROJECT CODE:	
PROJECT CODE:				PROJECT CODE:	

MARK	DESCRIPTION	DATE
AS-BUILT	AS OF 29 SEPTEMBER 2017	APR 17





US Army Corps  
of Engineers


DATE	DESCRIPTION
AS-BUILT AS OF 29 SEPTEMBER 2017	

DATE: 20170929	SOLICITATION NO.: W0125K4-14-0000
DESIGNED BY: PS	CONTRACT NO.: W0125K4-14-0000
DRAWN BY: BAK	PROJECT CODE: EP102
SUBMITTED BY: TEM	FILE NAME: EP102B301.dgn
U.S. ARMY CORPS OF ENGINEERS ROCK ISLAND DISTRICT ROCK ISLAND, ILLINOIS	

ILLINOIS WATERWAY  
LAGRANGE, ILLINOIS  
FLORISSANT, ILLINOIS  
RICE LAKE HABITAT REHAB & ENHANCEMENT  
STAGE I  
BORING LOGS I

Sheet  
ID  
B-301

AS-BUILT  
A-7

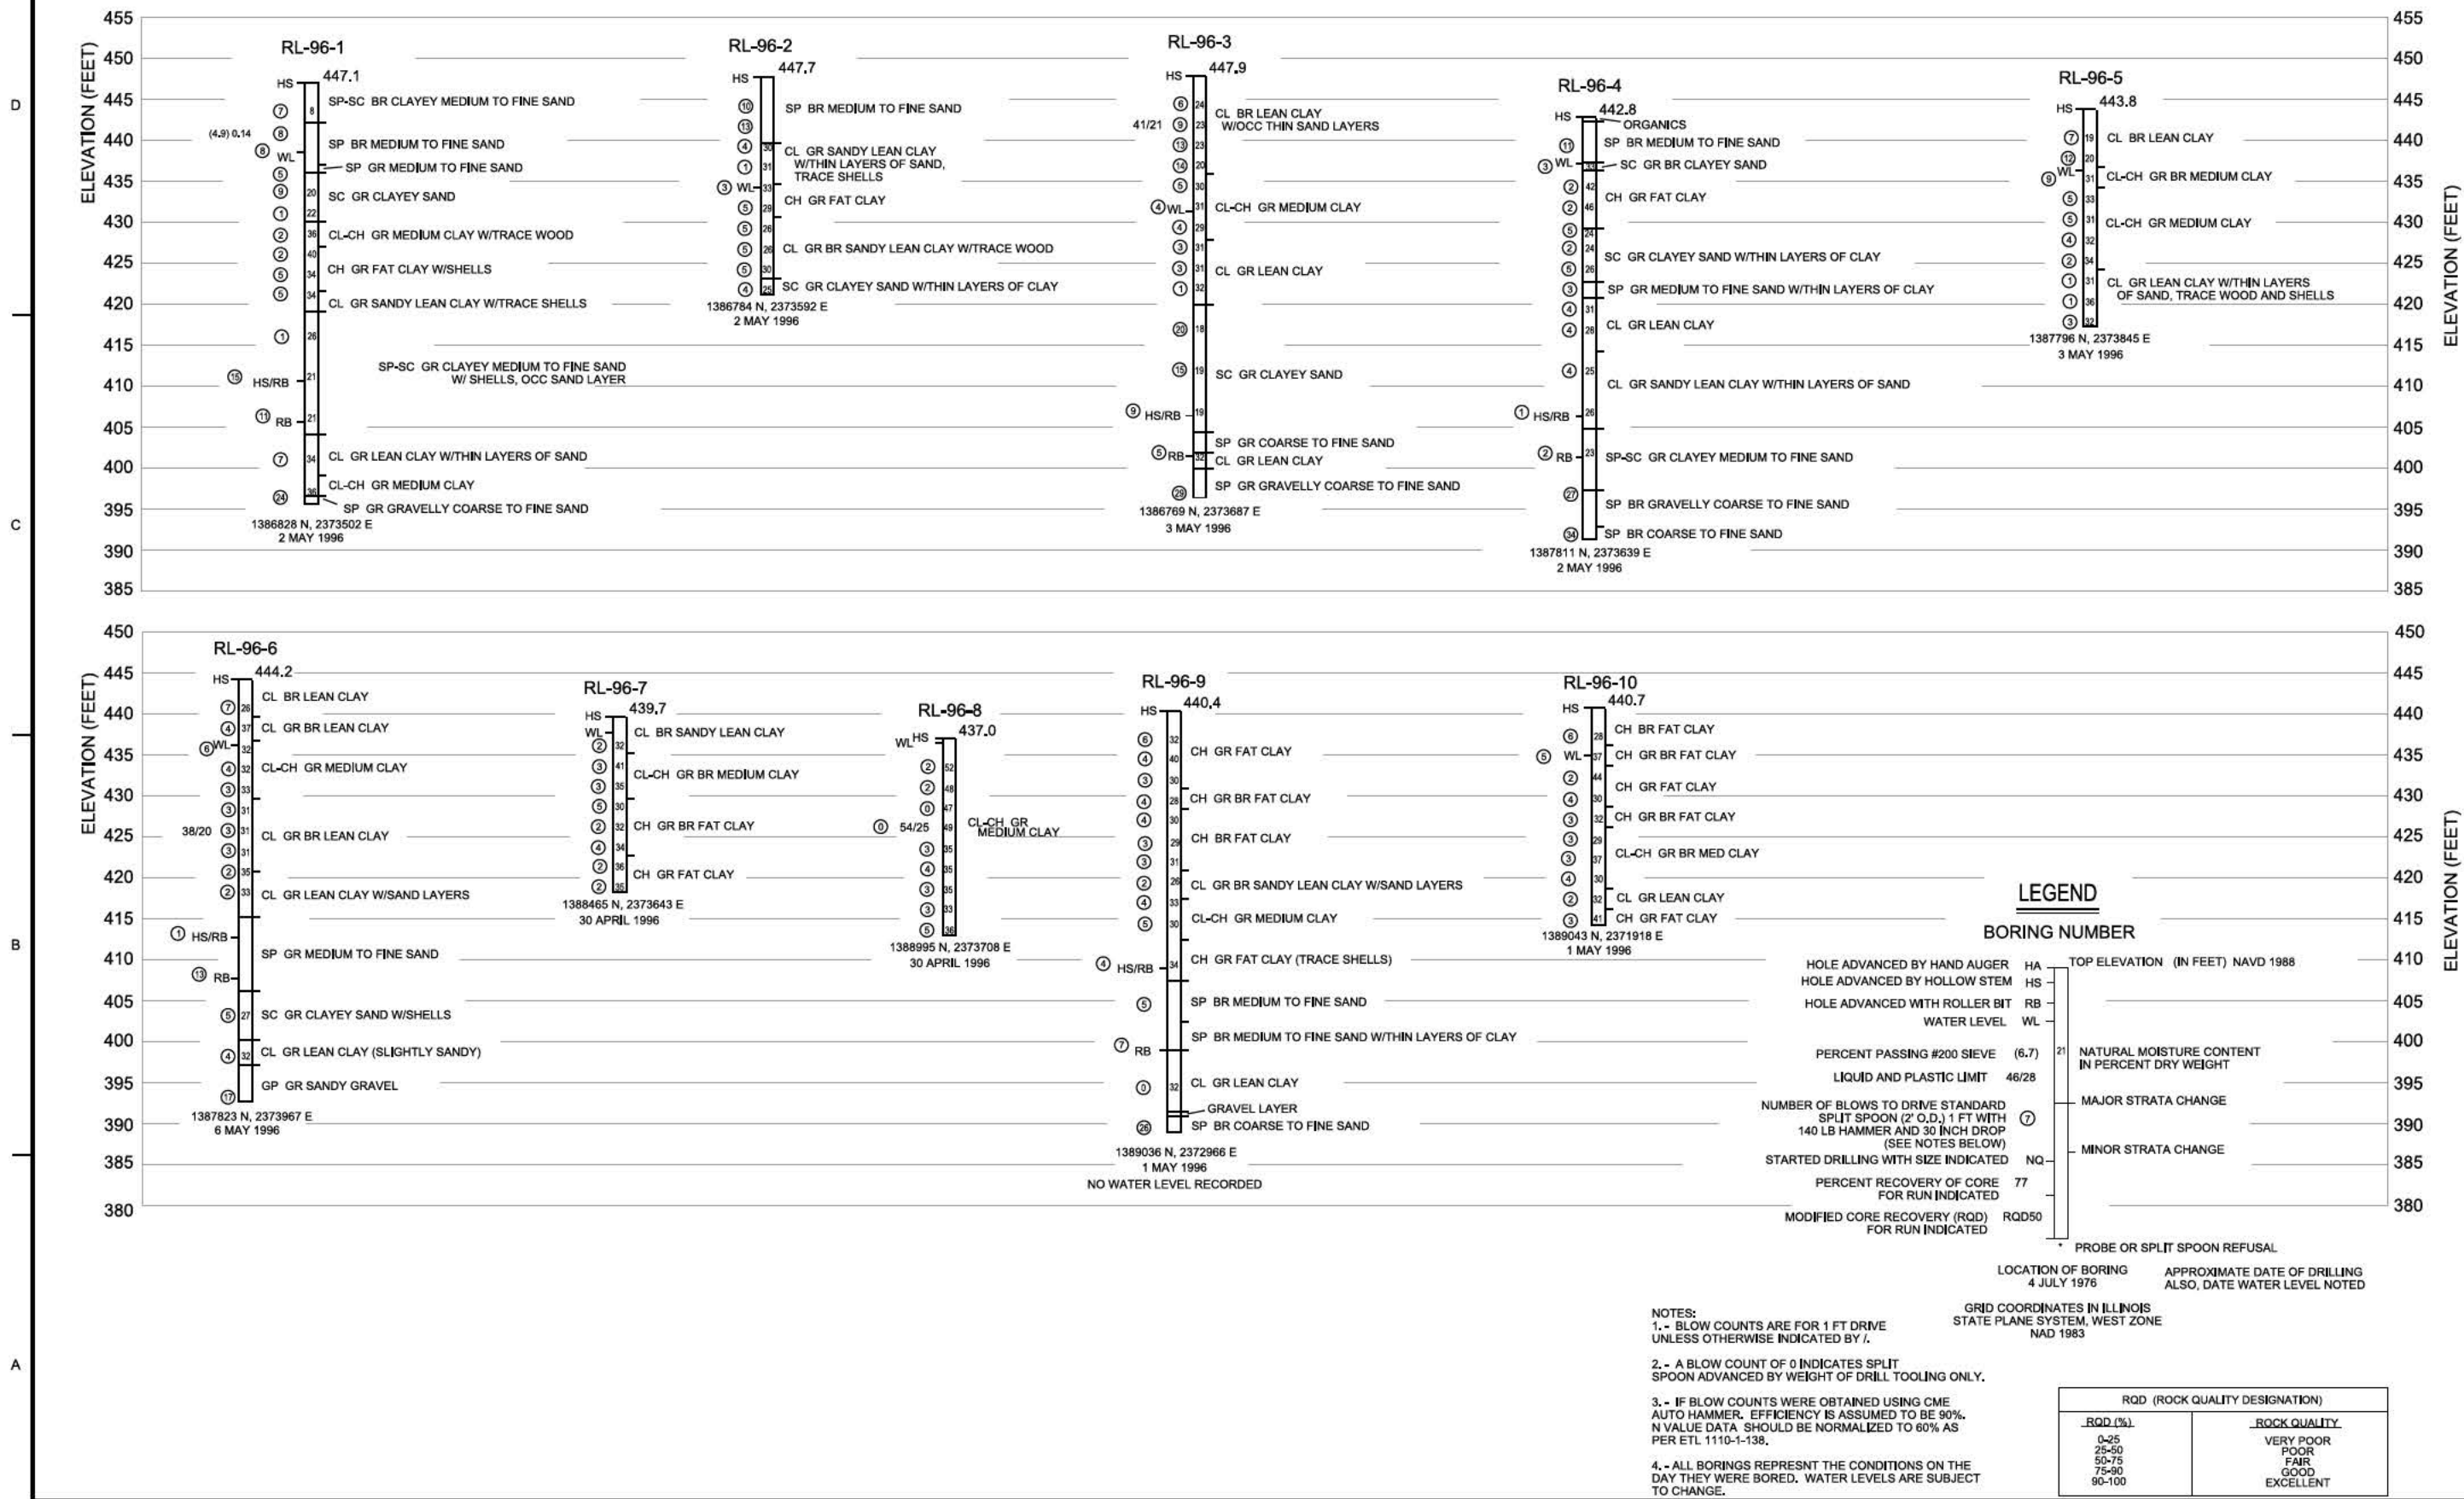

BORING LOGS I

NO SCALE











US Army Corps  
of Engineers

APPR.	DATE	DESCRIPTION
AS-BUILT AS OF 29 SEPTEMBER 2017		

DESIGNED BY:	DATE:	SOLIDATION NO.:
PS	26/10/2010	CONTRACT NO.:
OWN BY:	CONTRACT NO.:	PROJECT CODE:
SUBMITTED BY:	FILE NAME:	FILE D
ITEM	FILE NAME:	FILE D

ILLINOIS WATERWAY  
LA GRANGE POOL  
FLICKER HOLLOW  
RICE LAKE HABITAT REHAB & ENHANCEMENT  
STAGE I  
BORING LOGS IV

Sheet  
ID  
B-304


AS-BUILT  
A-10

D


C

B


A

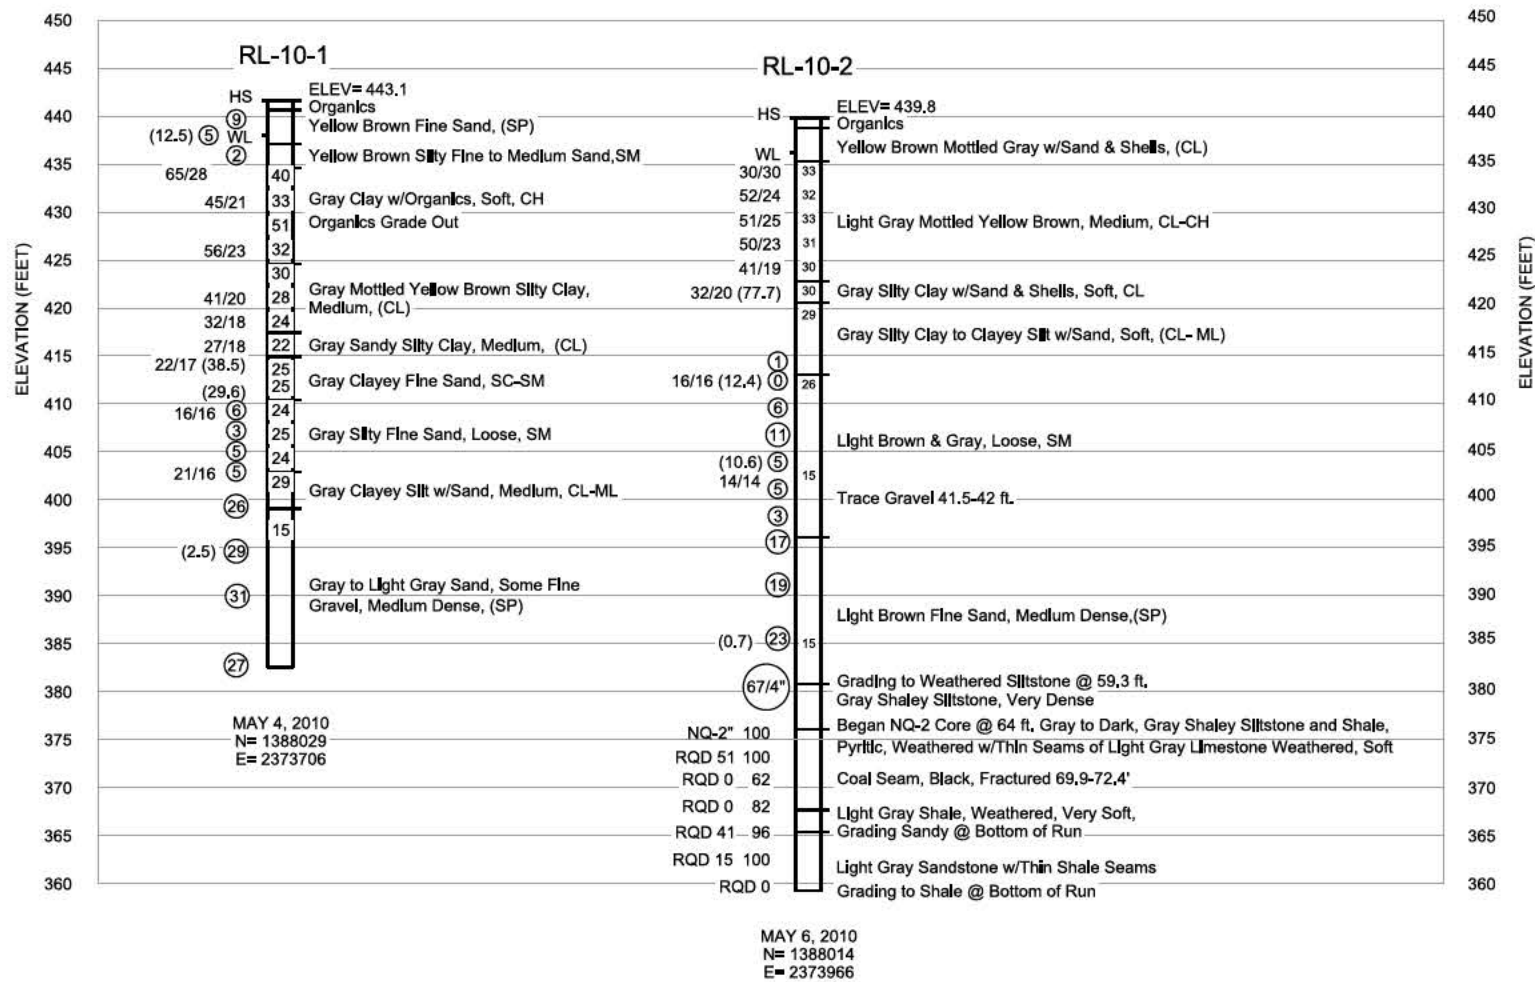

ELEVATION (FEET)

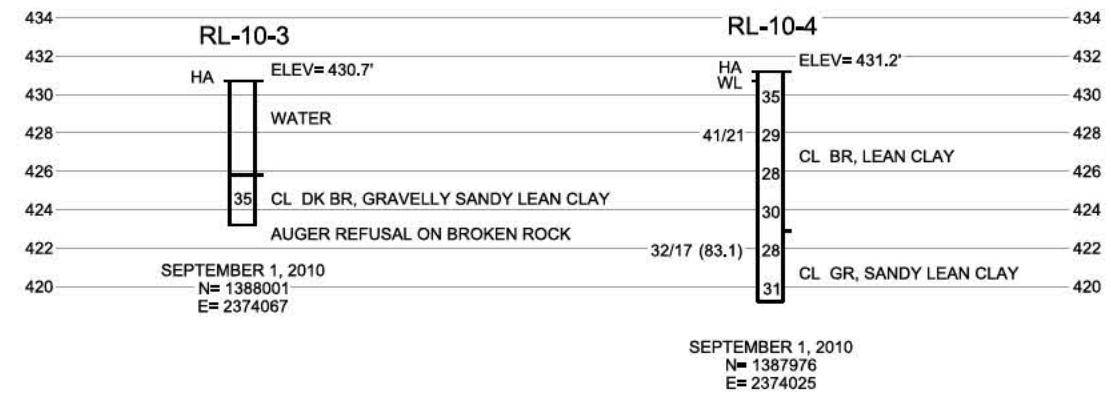

ELEVATION (FEET)

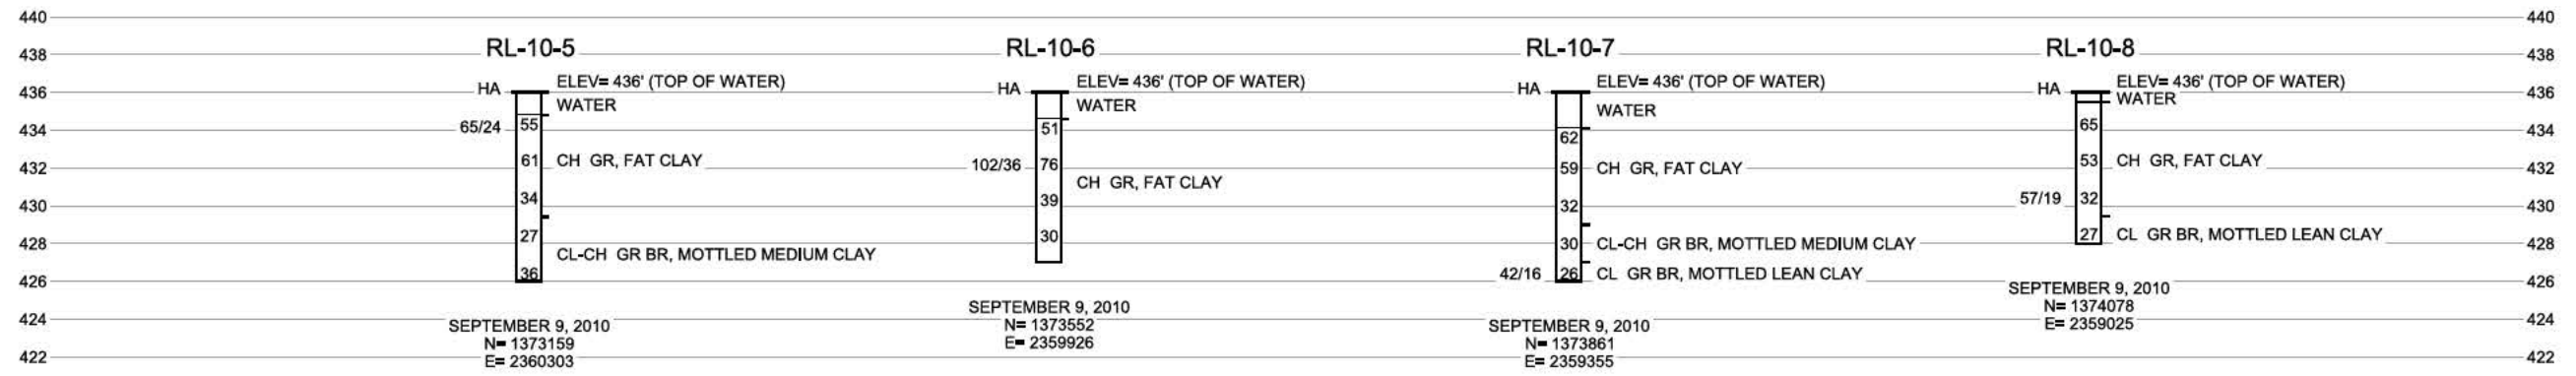


NOTE:  
1. FOR LEGEND SEE B-301.

BORING LOGS IV

NO SCALE



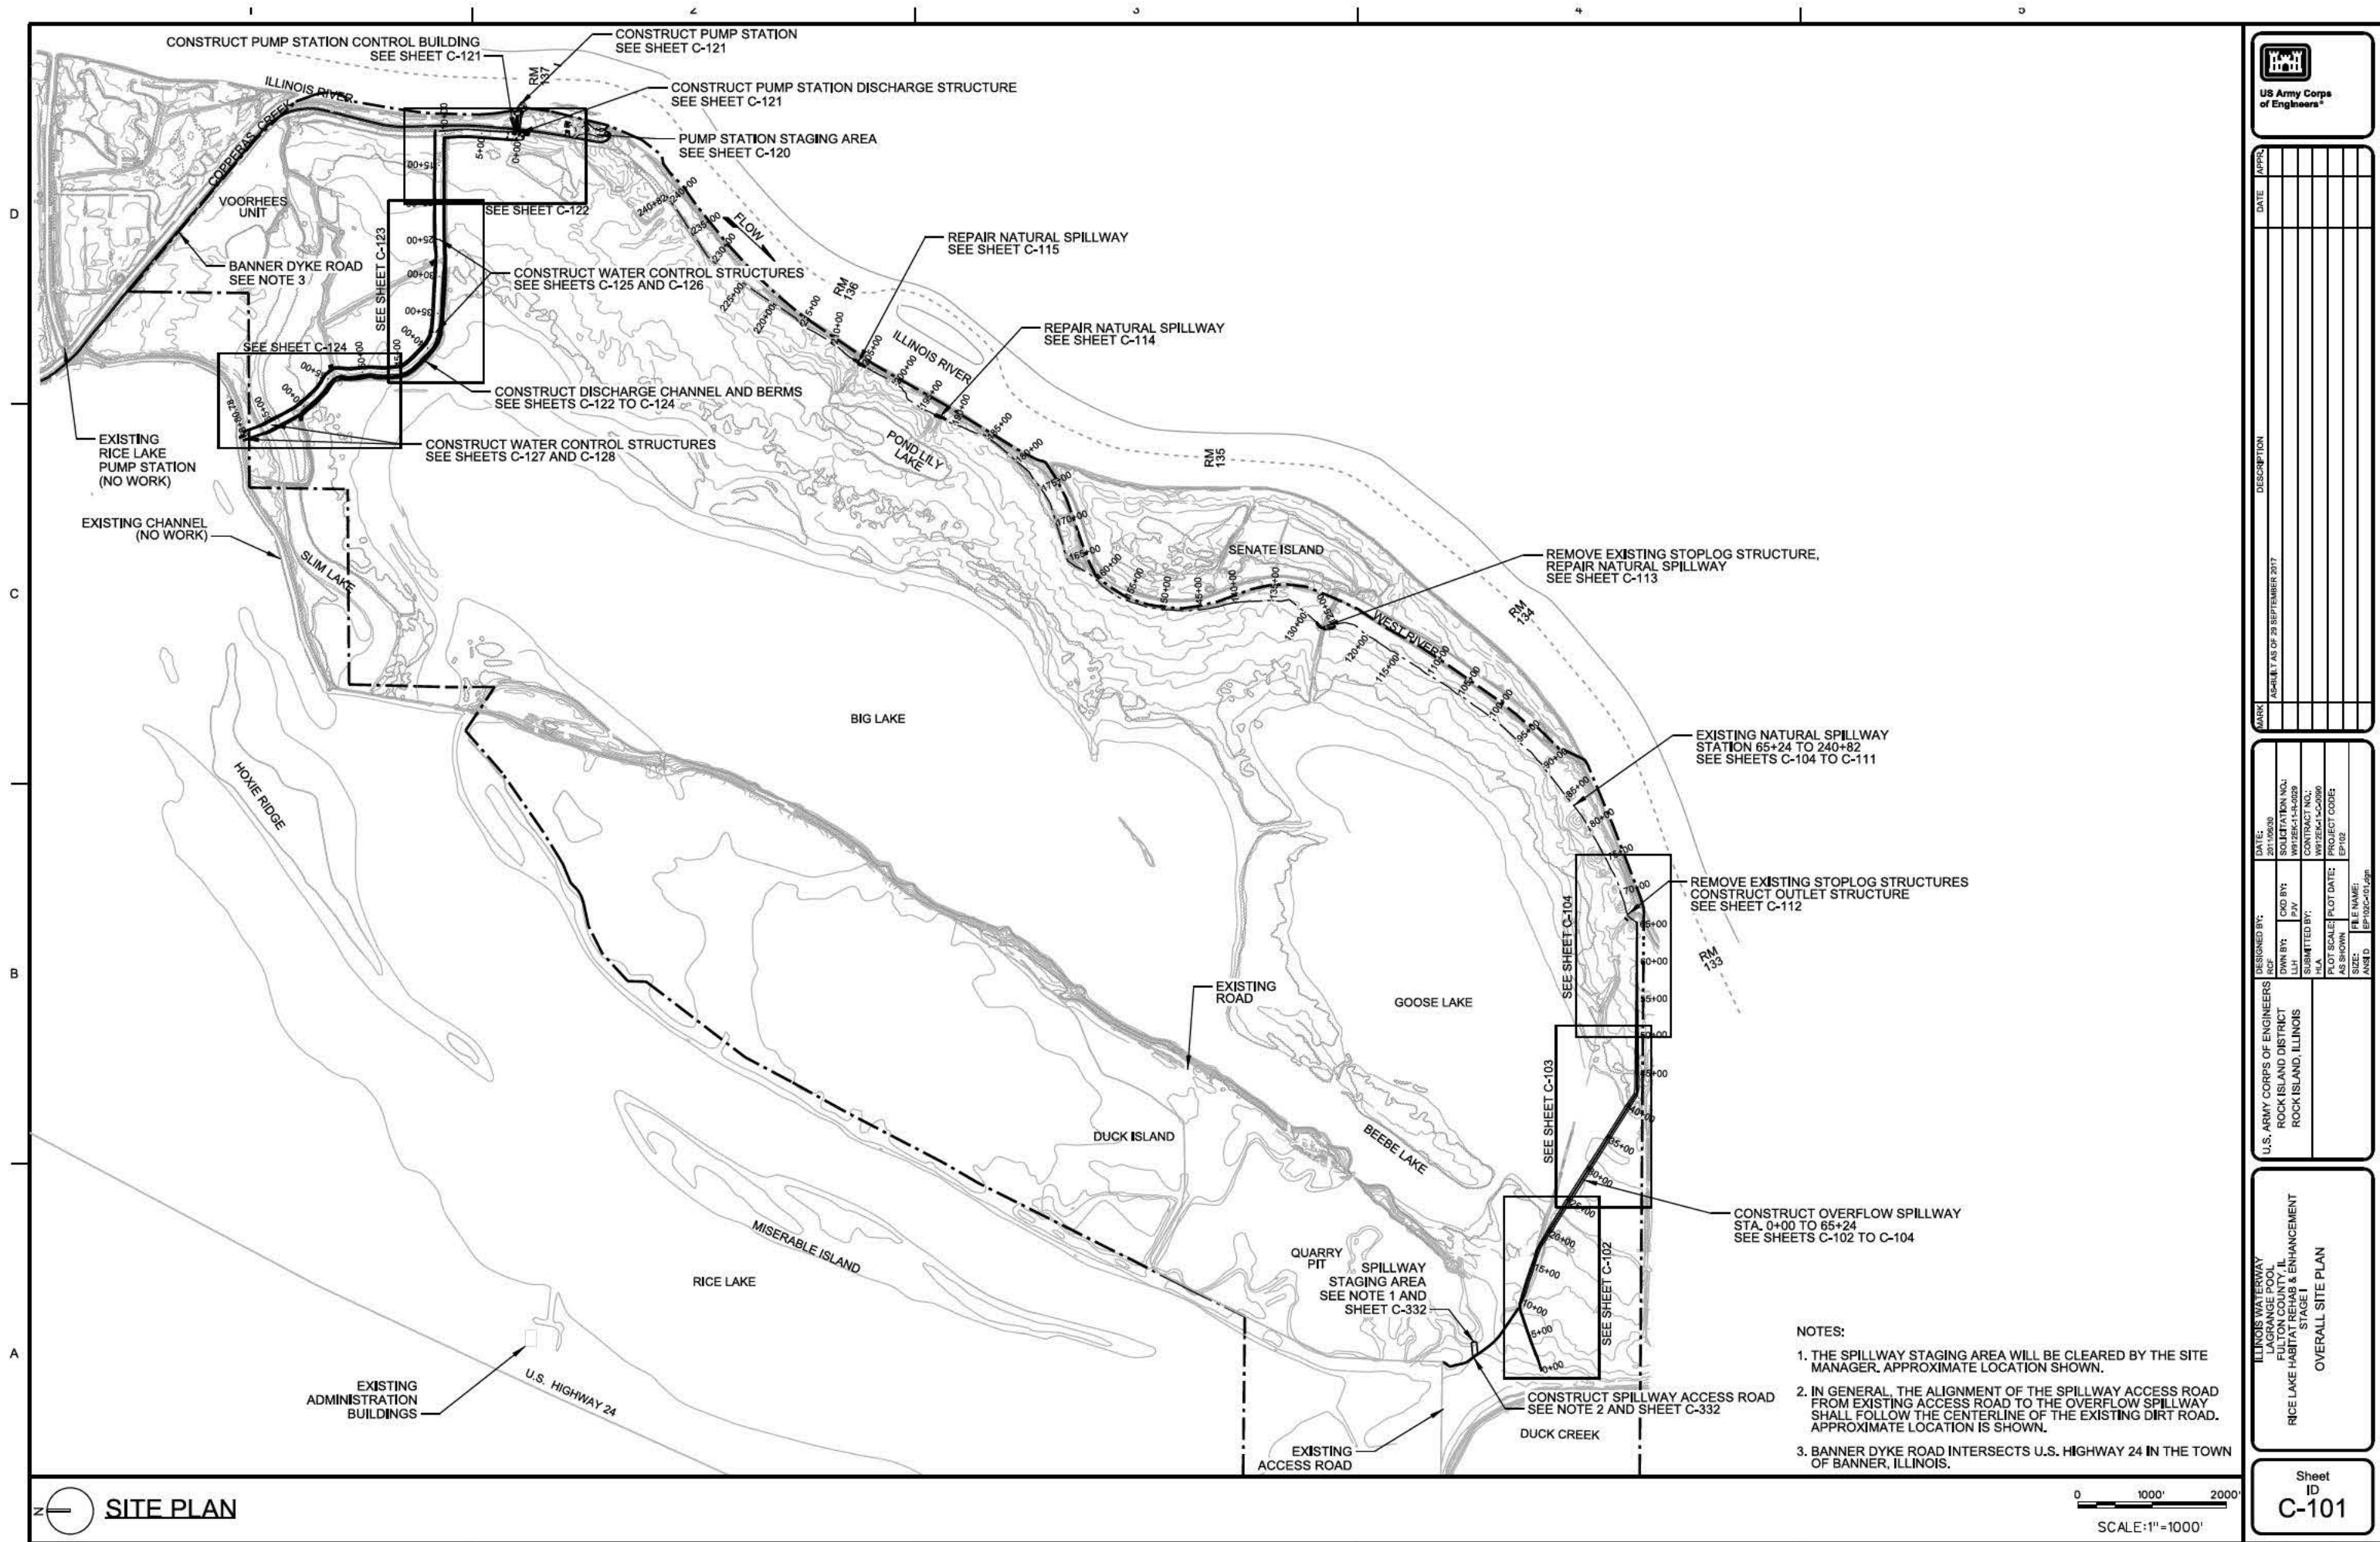

US Army Corps of Engineers

APPR.	DATE	DESCRIPTION
MARK	AS-BUILT AS OF 29 SEPTEMBER 2017	

DESIGNED BY:	DATE:	SOLICITATION NO.:
RCF	20-10000	274
OWN BY:	CONTRACT NO.:	CONTRACT NO.:
U.S. ARMY CORPS OF ENGINEERS	W123456789	W123456789
ROCK ISLAND DISTRICT	PROJECT CODE:	PROJECT CODE:
ROCK ISLAND, ILLINOIS	EP102	EP102


ILLINOIS WATERWAY	FILE NAME:
LAGRANGE POOL	EP102C-01.dgn
FLINT HILL	
RICE LAKE HABITAT REPAIR & ENHANCEMENT	
STAGE I	
OVERALL SITE PLAN	

Sheet ID  
**C-101**

AS-BUILT  
**A-11**

- NOTES:
1. THE SPILLWAY STAGING AREA WILL BE CLEARED BY THE SITE MANAGER. APPROXIMATE LOCATION SHOWN.
  2. IN GENERAL, THE ALIGNMENT OF THE SPILLWAY ACCESS ROAD FROM EXISTING ACCESS ROAD TO THE OVERFLOW SPILLWAY SHALL FOLLOW THE CENTERLINE OF THE EXISTING DIRT ROAD. APPROXIMATE LOCATION IS SHOWN.
  3. BANNER DYKE ROAD INTERSECTS U.S. HIGHWAY 24 IN THE TOWN OF BANNER, ILLINOIS.



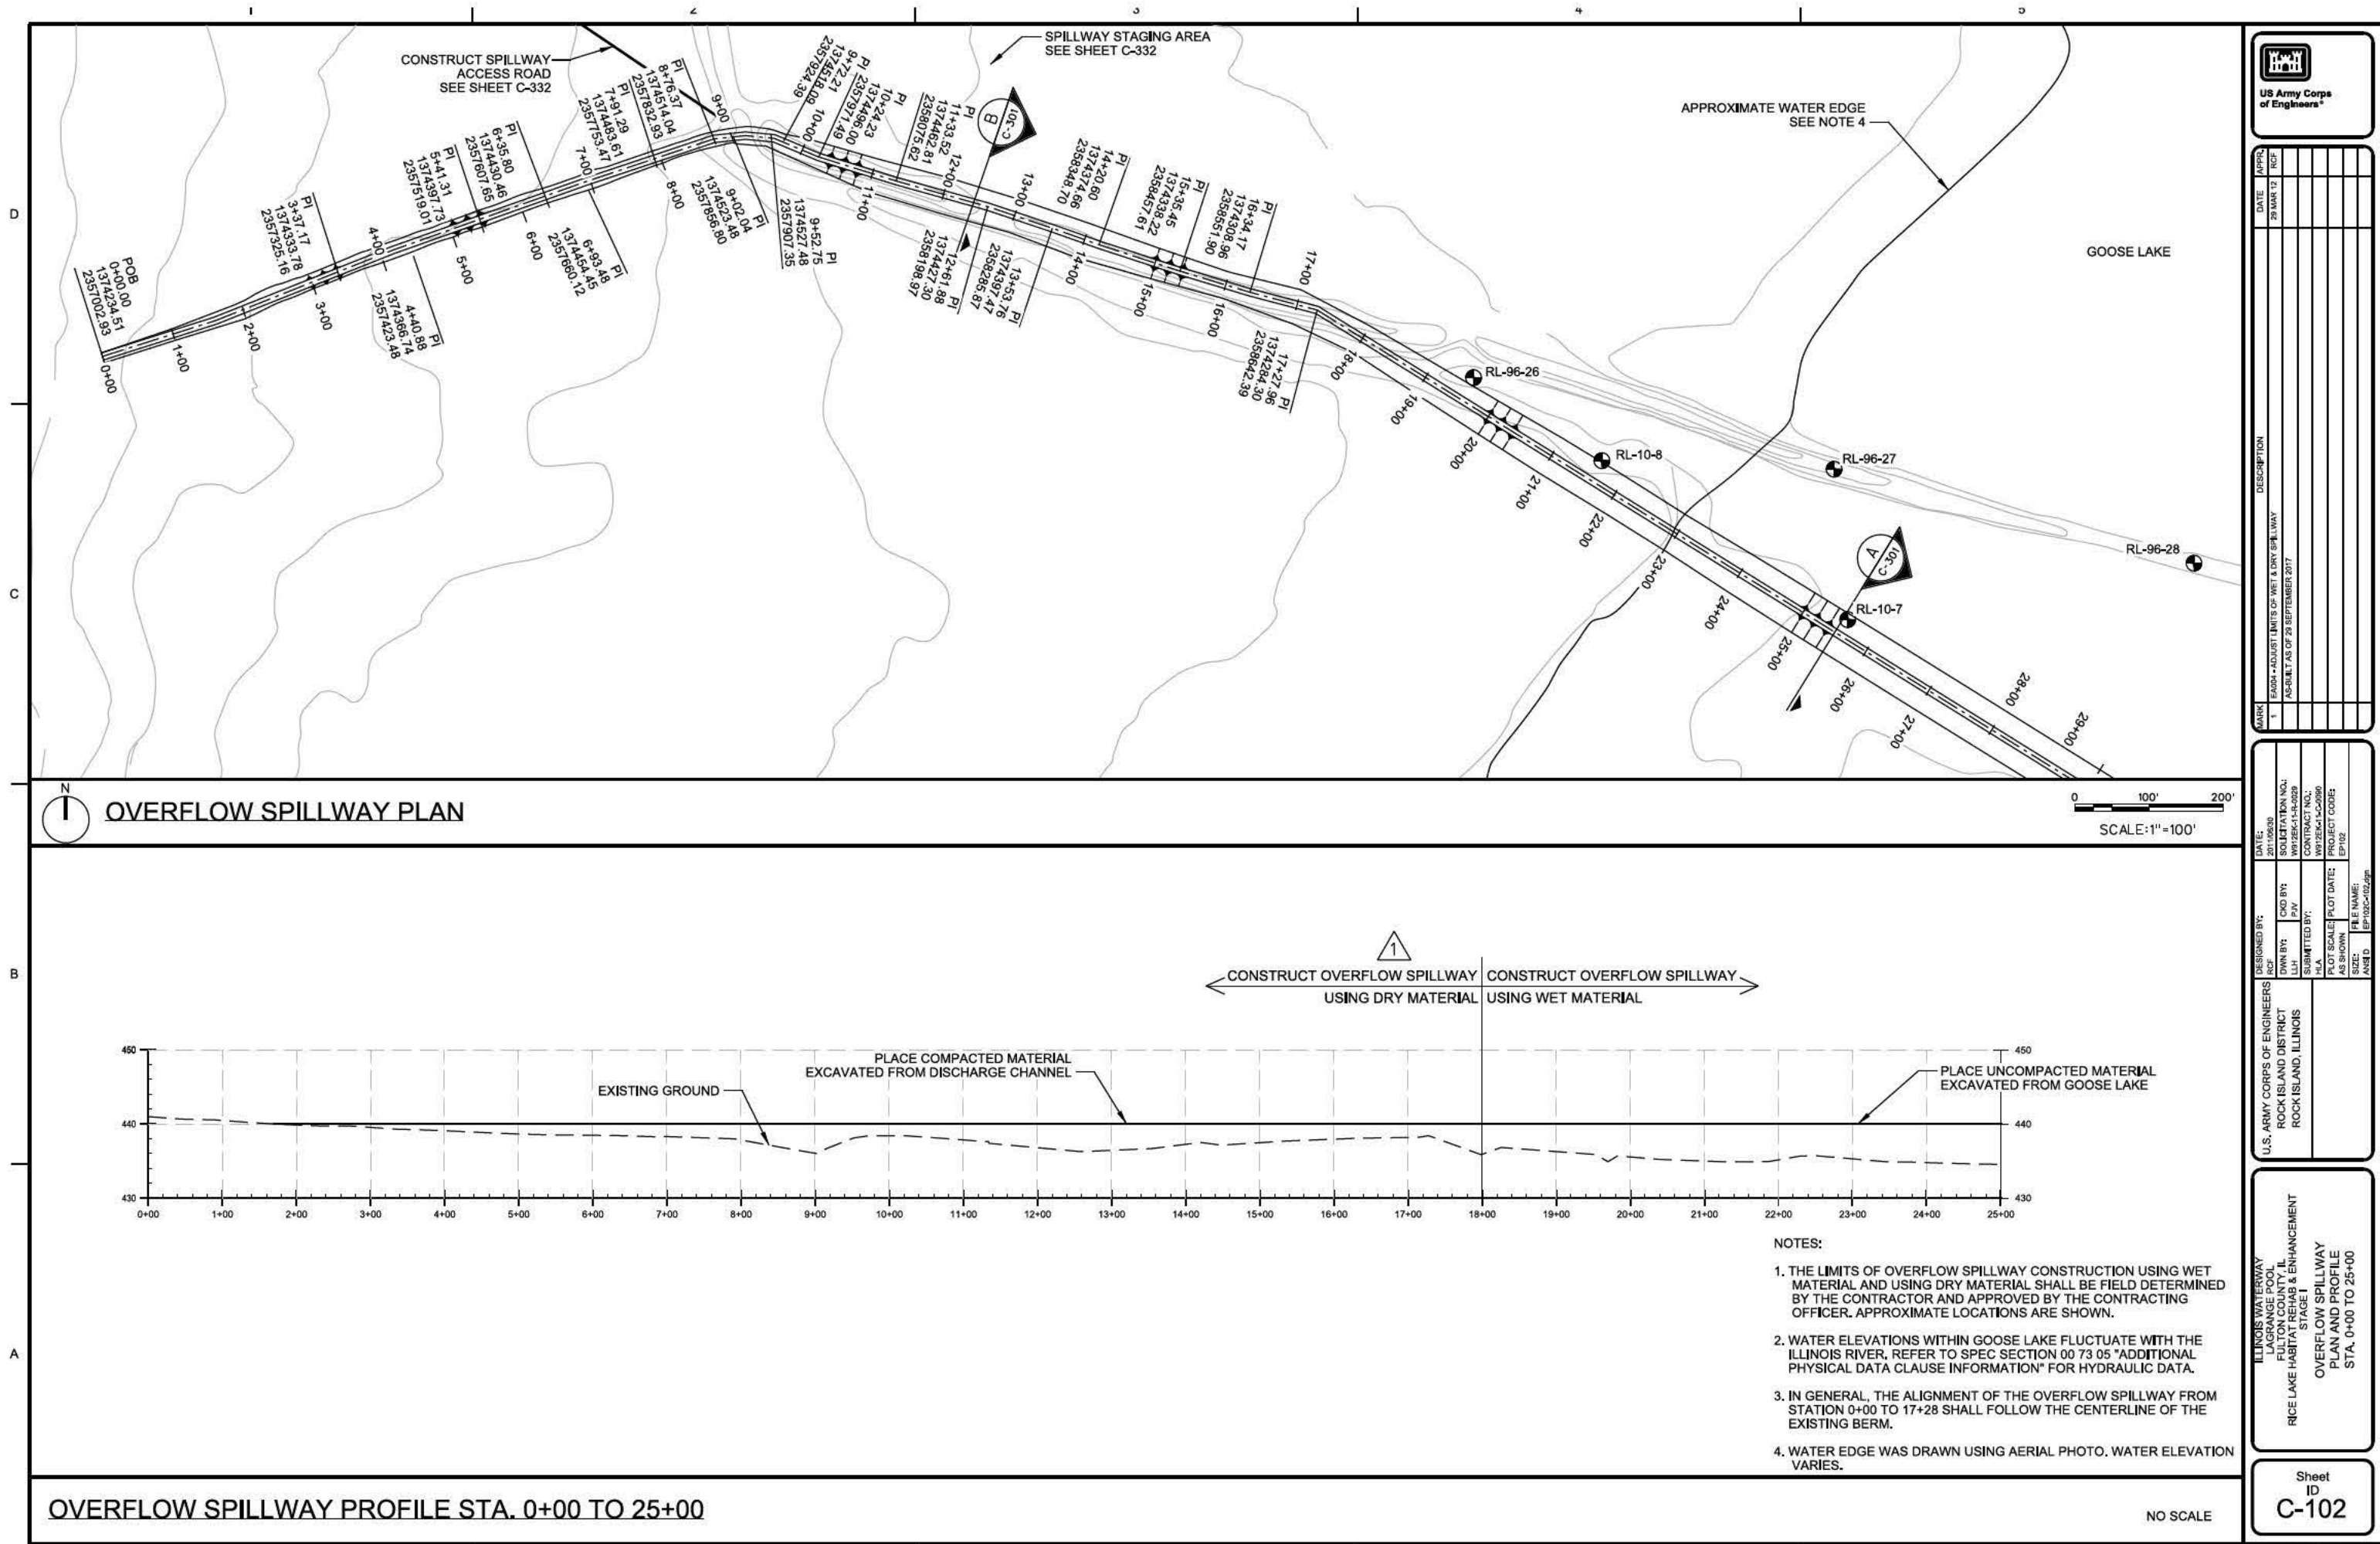








D

C




NATURAL SPILLWAY PLAN

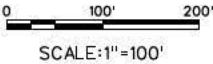

B

A

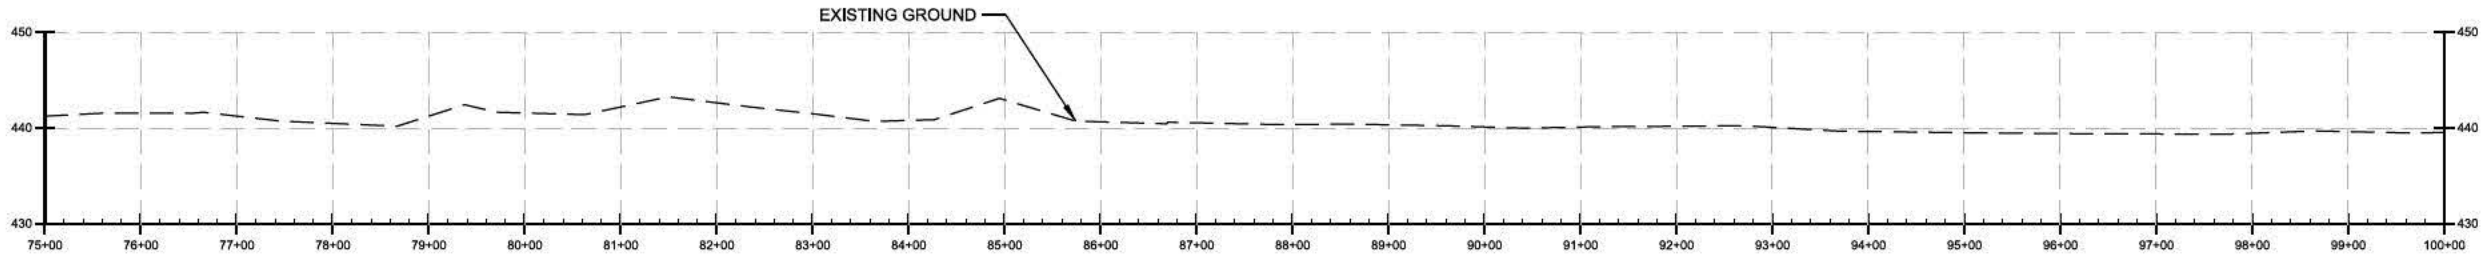

NOTE:  
1. IN GENERAL, THE ALIGNMENT OF THE NATURAL SPILLWAY  
FOLLOWS THE CENTERLINE OF THE EXISTING DIRT ROAD.

NATURAL SPILLWAY PROFILE STA. 75+00 TO 100+00

NO SCALE




DATE	DESCRIPTION
AS-BUILT AS OF 28 SEPTEMBER 2017	

U.S. ARMY CORPS OF ENGINEERS ROCK ISLAND DISTRICT ROCK ISLAND, ILLINOIS	DESIGNED BY: RCP	DATE: 28 SEP 2017
	DRAWN BY: CVA	SOLICITATION NO.:
	SUBMITTED BY: H.A.	CONTRACT NO.:
	PLAT SCALE:	PROJECT CODE:
	AS SHOWN	EP102
	SIZE:	FILE NAME:
	ANSI D	EP102C-105.dgn

ILLINOIS WATERWAY LAGRANGE POOL FLOOD CONTROL RICE LAKE HABITAT REHAB & ENHANCEMENT STAGE I	NATURAL SPILLWAY PLAN AND PROFILE STA. 75+00 TO 100+00
---	--


Sheet ID C-105
----------------------



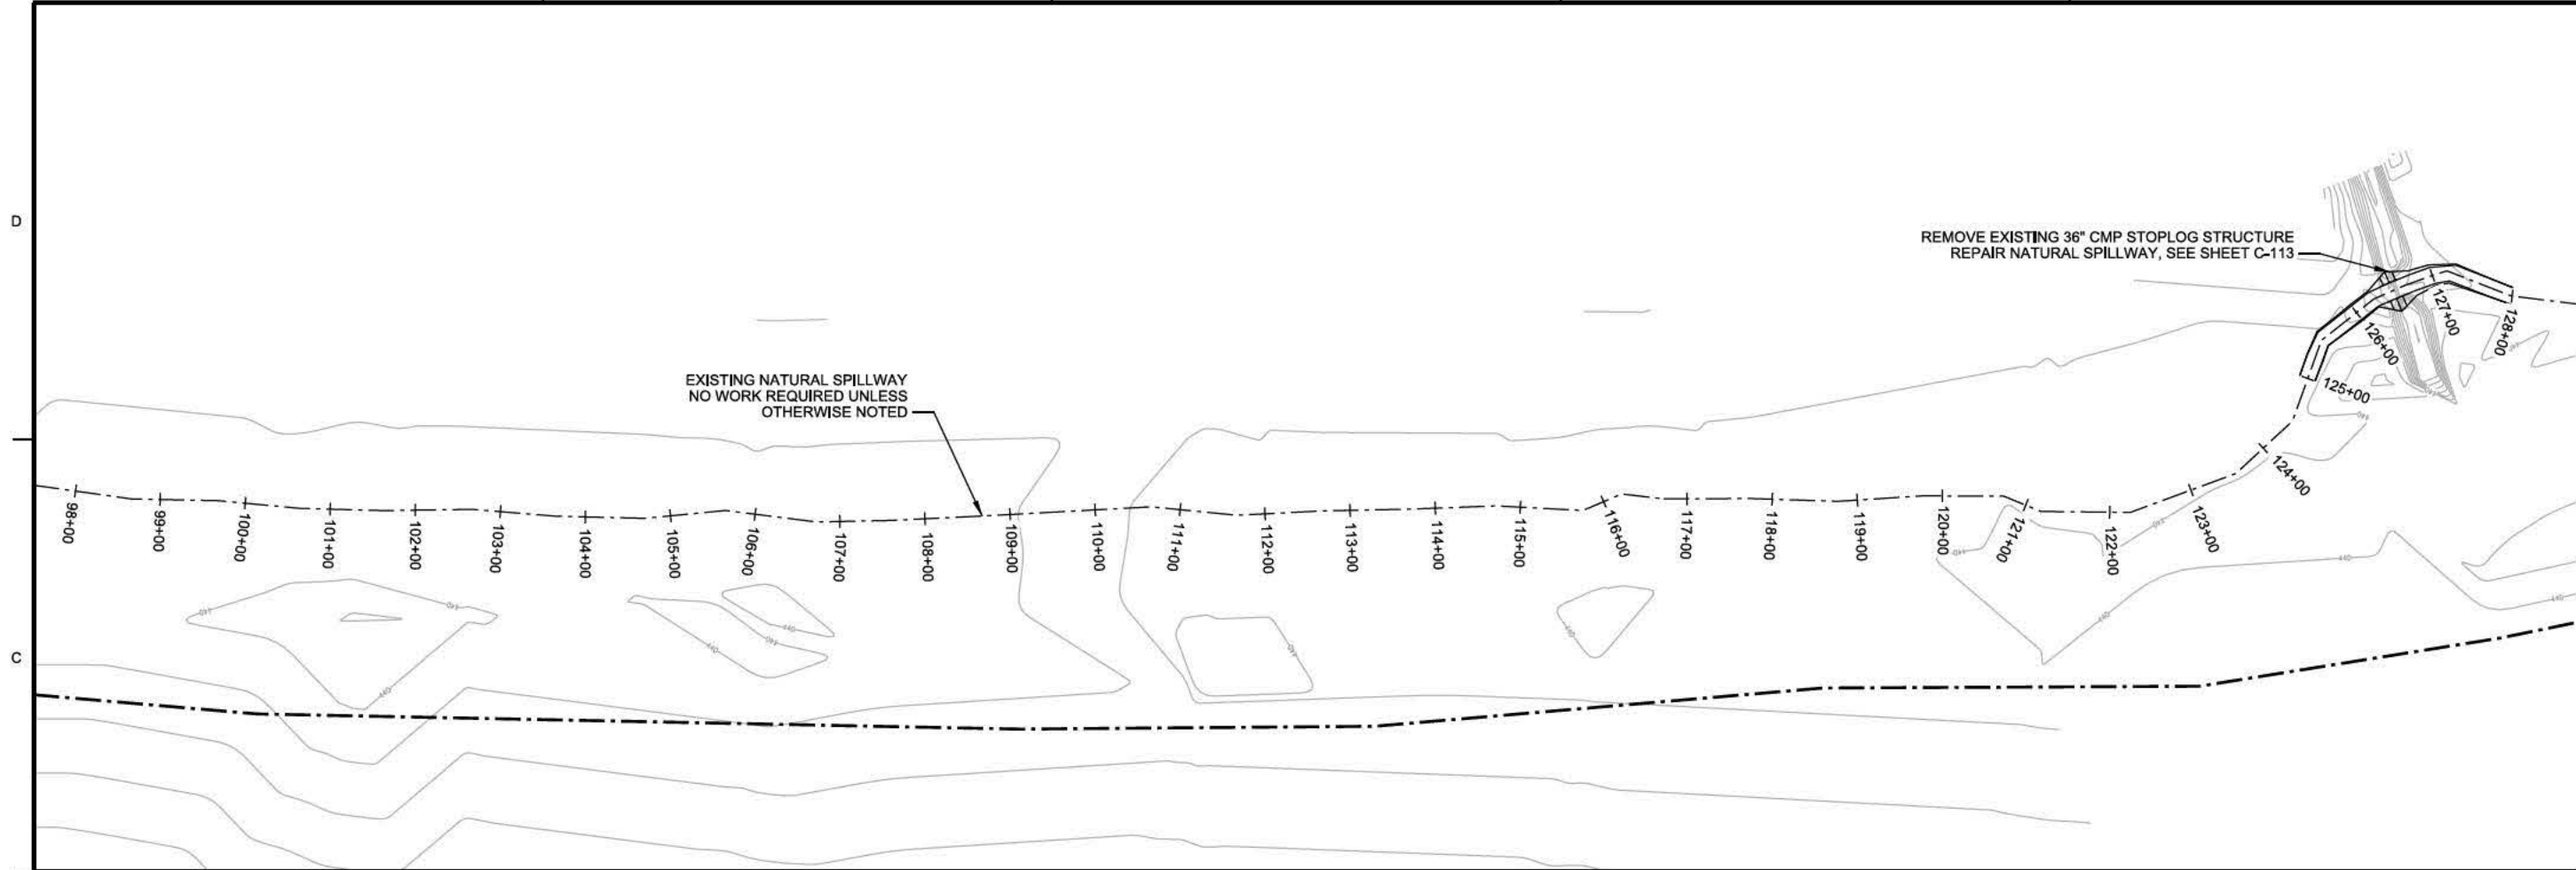

 **NATURAL SPILLWAY PLAN**


0 100' 200'  
SCALE: 1" = 100'

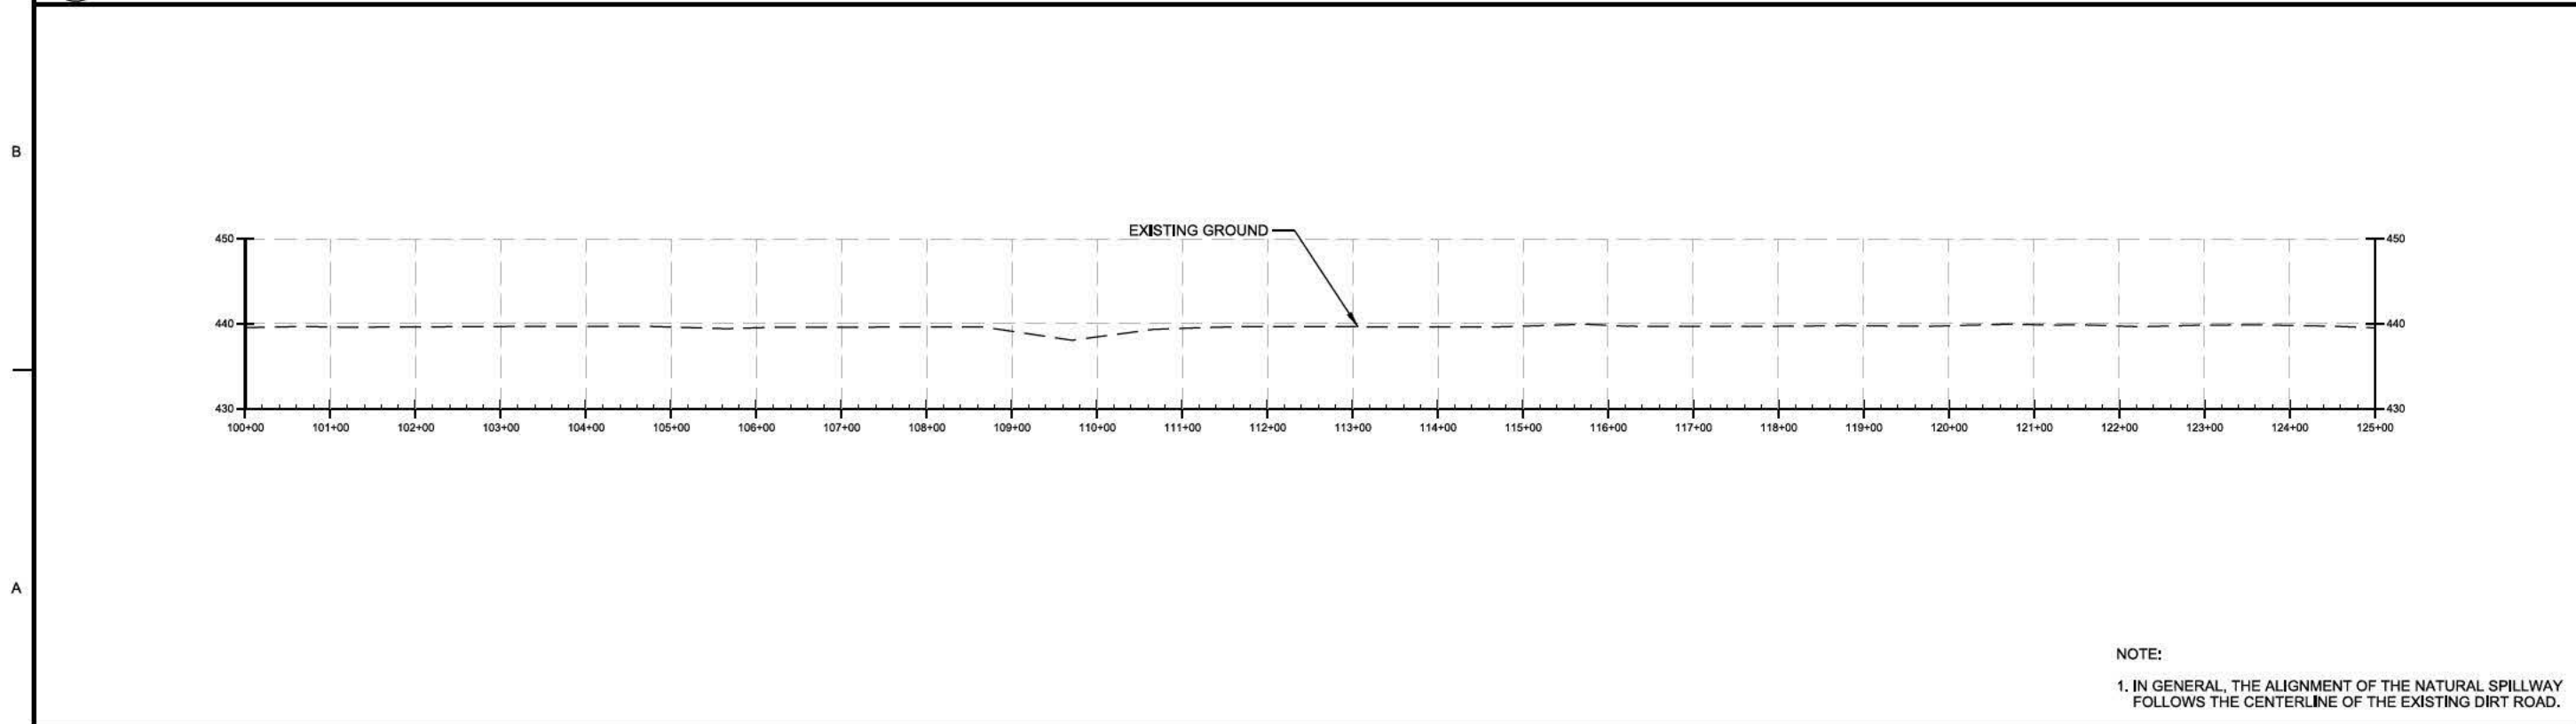

NOTE:  
1. IN GENERAL, THE ALIGNMENT OF THE NATURAL SPILLWAY  
FOLLOWS THE CENTERLINE OF THE EXISTING DIRT ROAD.

**NATURAL SPILLWAY PROFILE STA. 100+00 TO 125+00**

NO SCALE



US Army Corps  
of Engineers

MARK	DATE	DESCRIPTION
AS-BUILT	AS OF 28 SEPTEMBER 2017	

DATE:	DESIGNED BY:	OWN BY:	CHD BY:
26-10-2016	RCF	U.S. ARMY CORPS OF ENGINEERS	U.S. ARMY CORPS OF ENGINEERS

CONTRACT NO.	PROJECT CODE:	FILE NAME:
W123456789	EP102	EP102C-106.dgn

ILLINOIS WATERWAY  
LAGRANGE POOL  
FLOOD CONTROL  
RICE LAKE HABITAT REHAB & ENHANCEMENT  
STAGE I

NATURAL SPILLWAY  
PLAN AND PROFILE  
STA. 100+00 TO 125+00

Sheet  
ID  
**C-106**

AS-BUILT  
**A-16**






A-18



U.S. ARMY CORPS OF ENGINEERS  
ROCK ISLAND DISTRICT  
ROCK ISLAND, ILLINOIS

**NOTE:**

1. IN GENERAL, THE ALIGNMENT OF THE NATURAL SPILLWAY FOLLOWS THE CENTERLINE OF THE EXISTING DIRT ROAD.

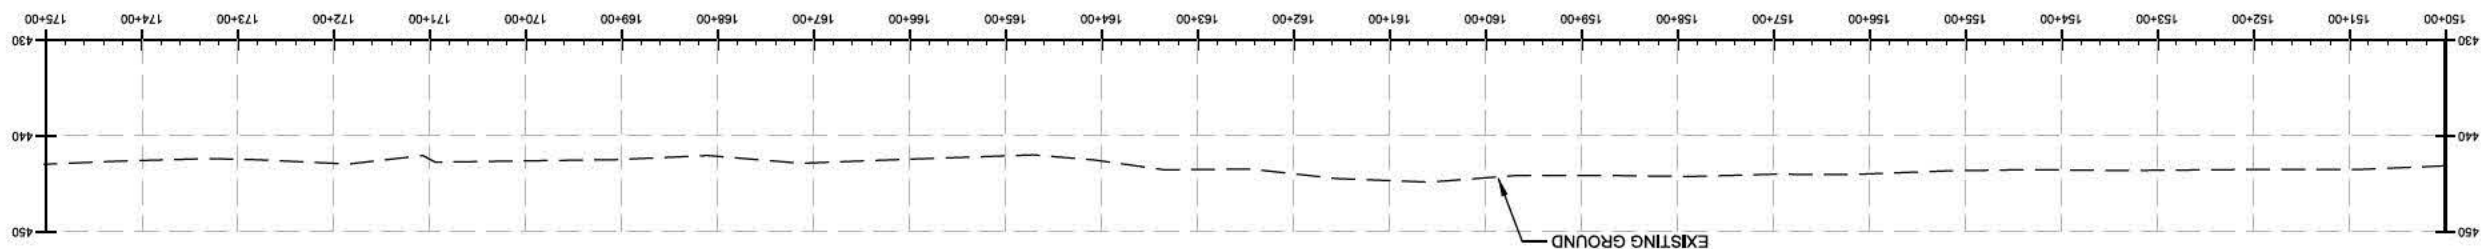


NATURAL SPILLWAY PLAN

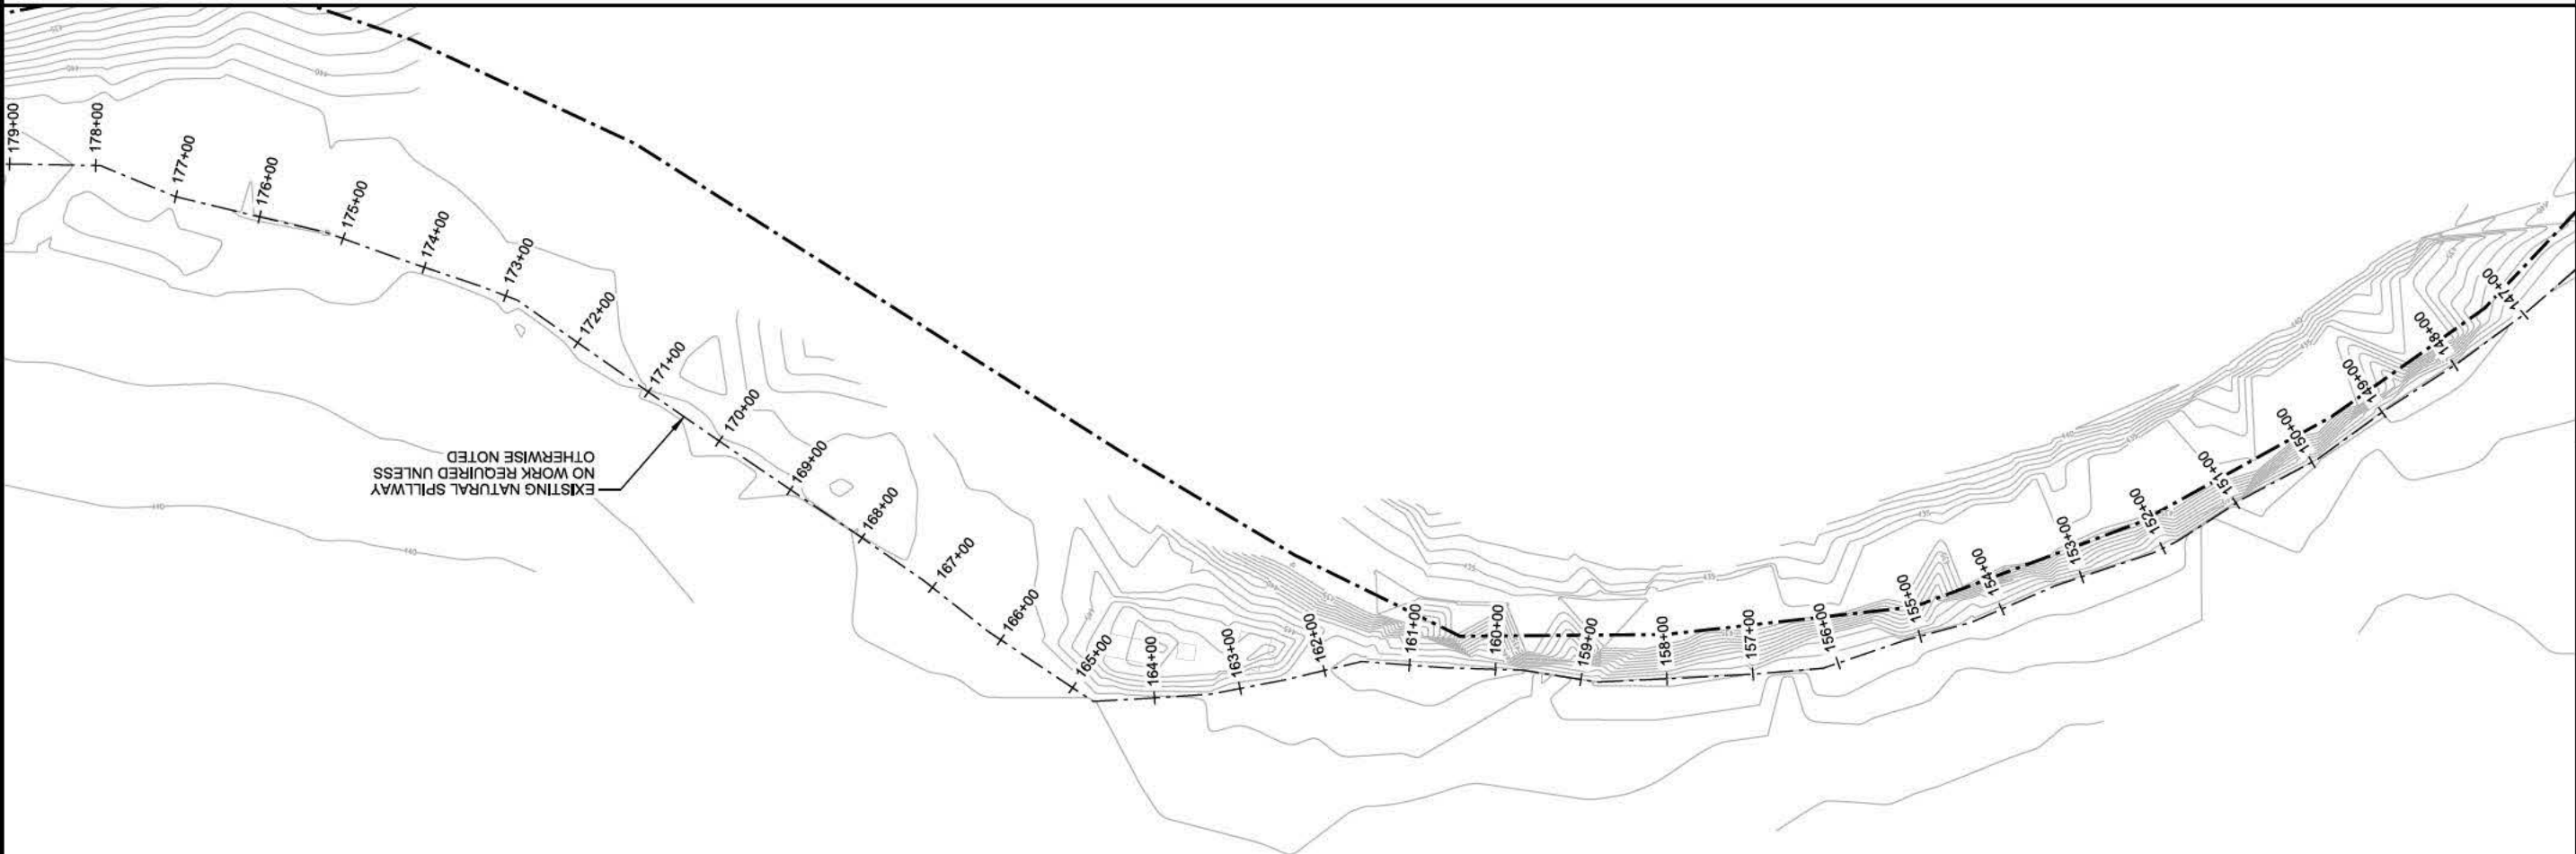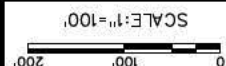

DESIGNED BY:	DATE:
RCE	201-06500
DWN BY:	CMD BY:
PLV	WY2BCH-H-0229
SUBMITTED BY:	CONTRACT NO.:
PLA	WY2BCH-H-0090
PLOT SCALE:	PROJECT CODE:
AS SHOWN	EP-102
SIZE:	FILE NAME:
ANND	EP102C-08.dgn

[illegible]

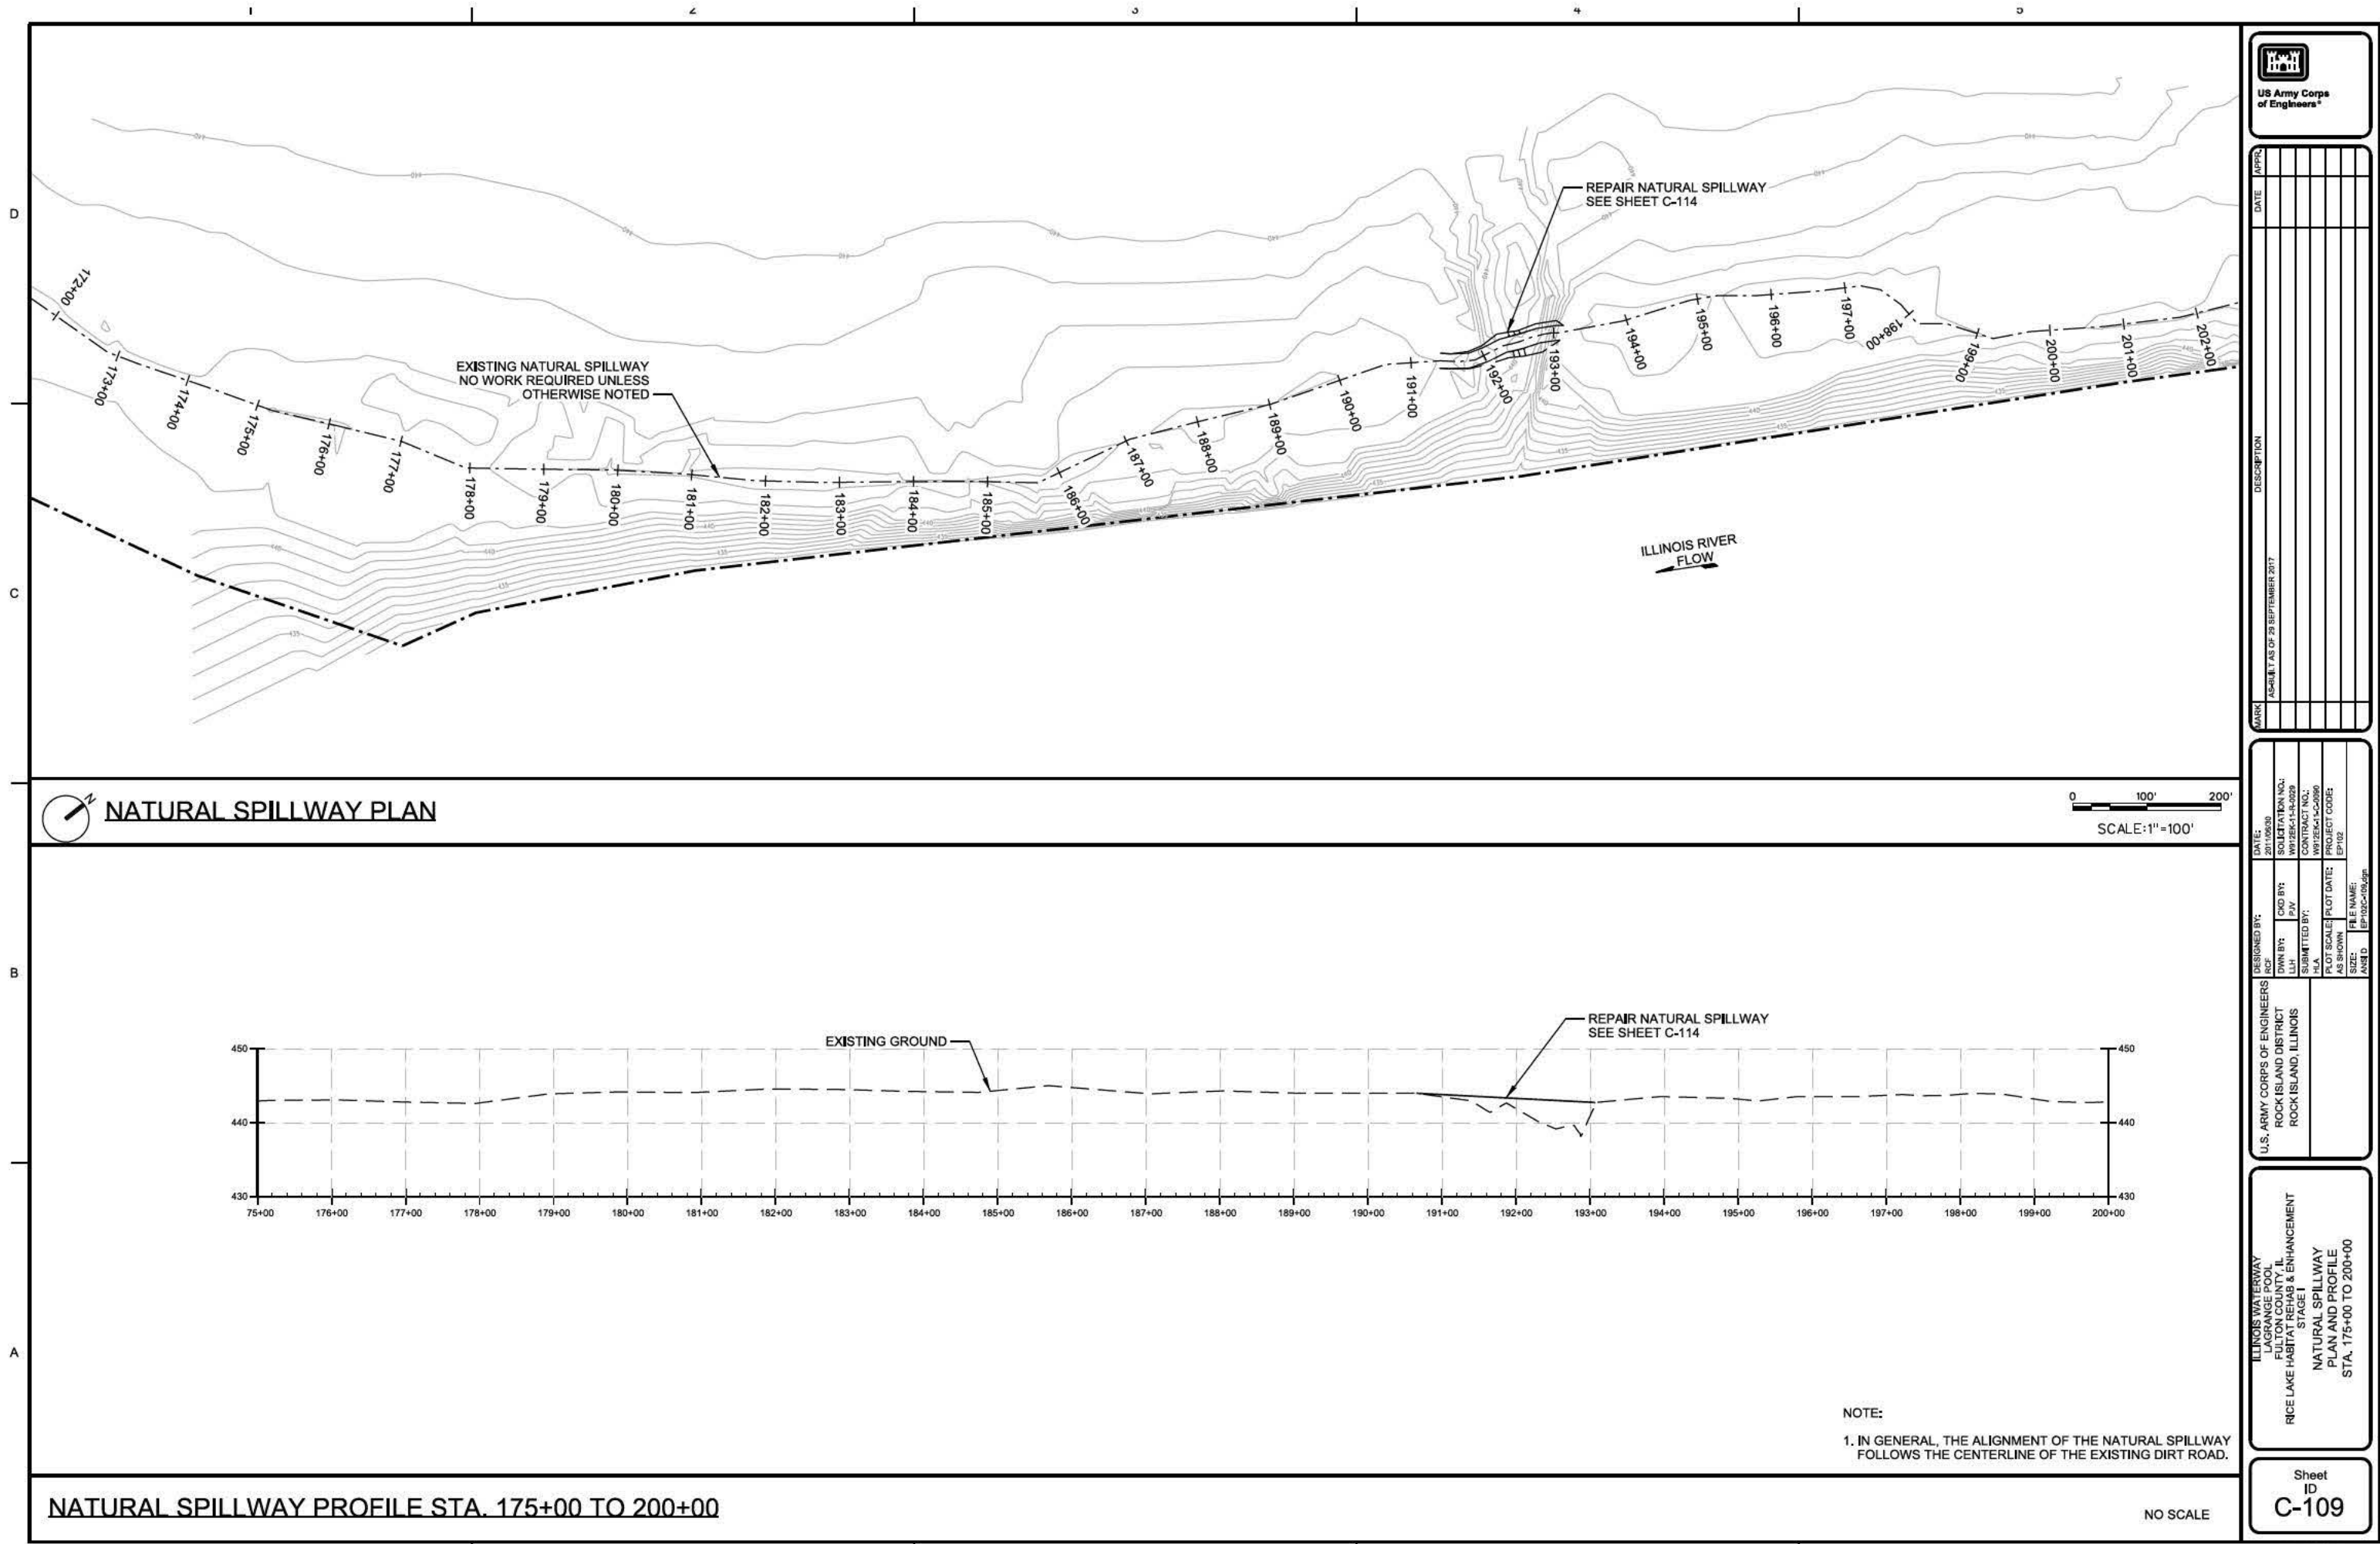










[illegible]

U.S. ARMY CORPS OF ENGINEERS		ISSUED BY:		DATE:	
ROCK ISLAND DISTRICT		OWN BY:		SLOT DATE:	
ROCK ISLAND, ILLINOIS		LH		AS SHOWN	
		CWD BY:		FILE NAME:	
		P/V		EP-10DC-12.jpg	
		CONTRACT NO.:		PROJECT CODE:	
		WY-25C-14-0029		EP102	
		SOLICITATION NO.:			
		WY-25C-14-0029			

ILLINOIS WATERWAY  
LAGRANGE POOL  
FULTON COUNTY, IL  
RICE LAKE HABITAT REHAB & ENHANCEMENT  
STAGE I  
OUTLET STRUCTURE  
SITE PLAN

Sheet  
ID  
C-112


AS-BUILT  
A-22

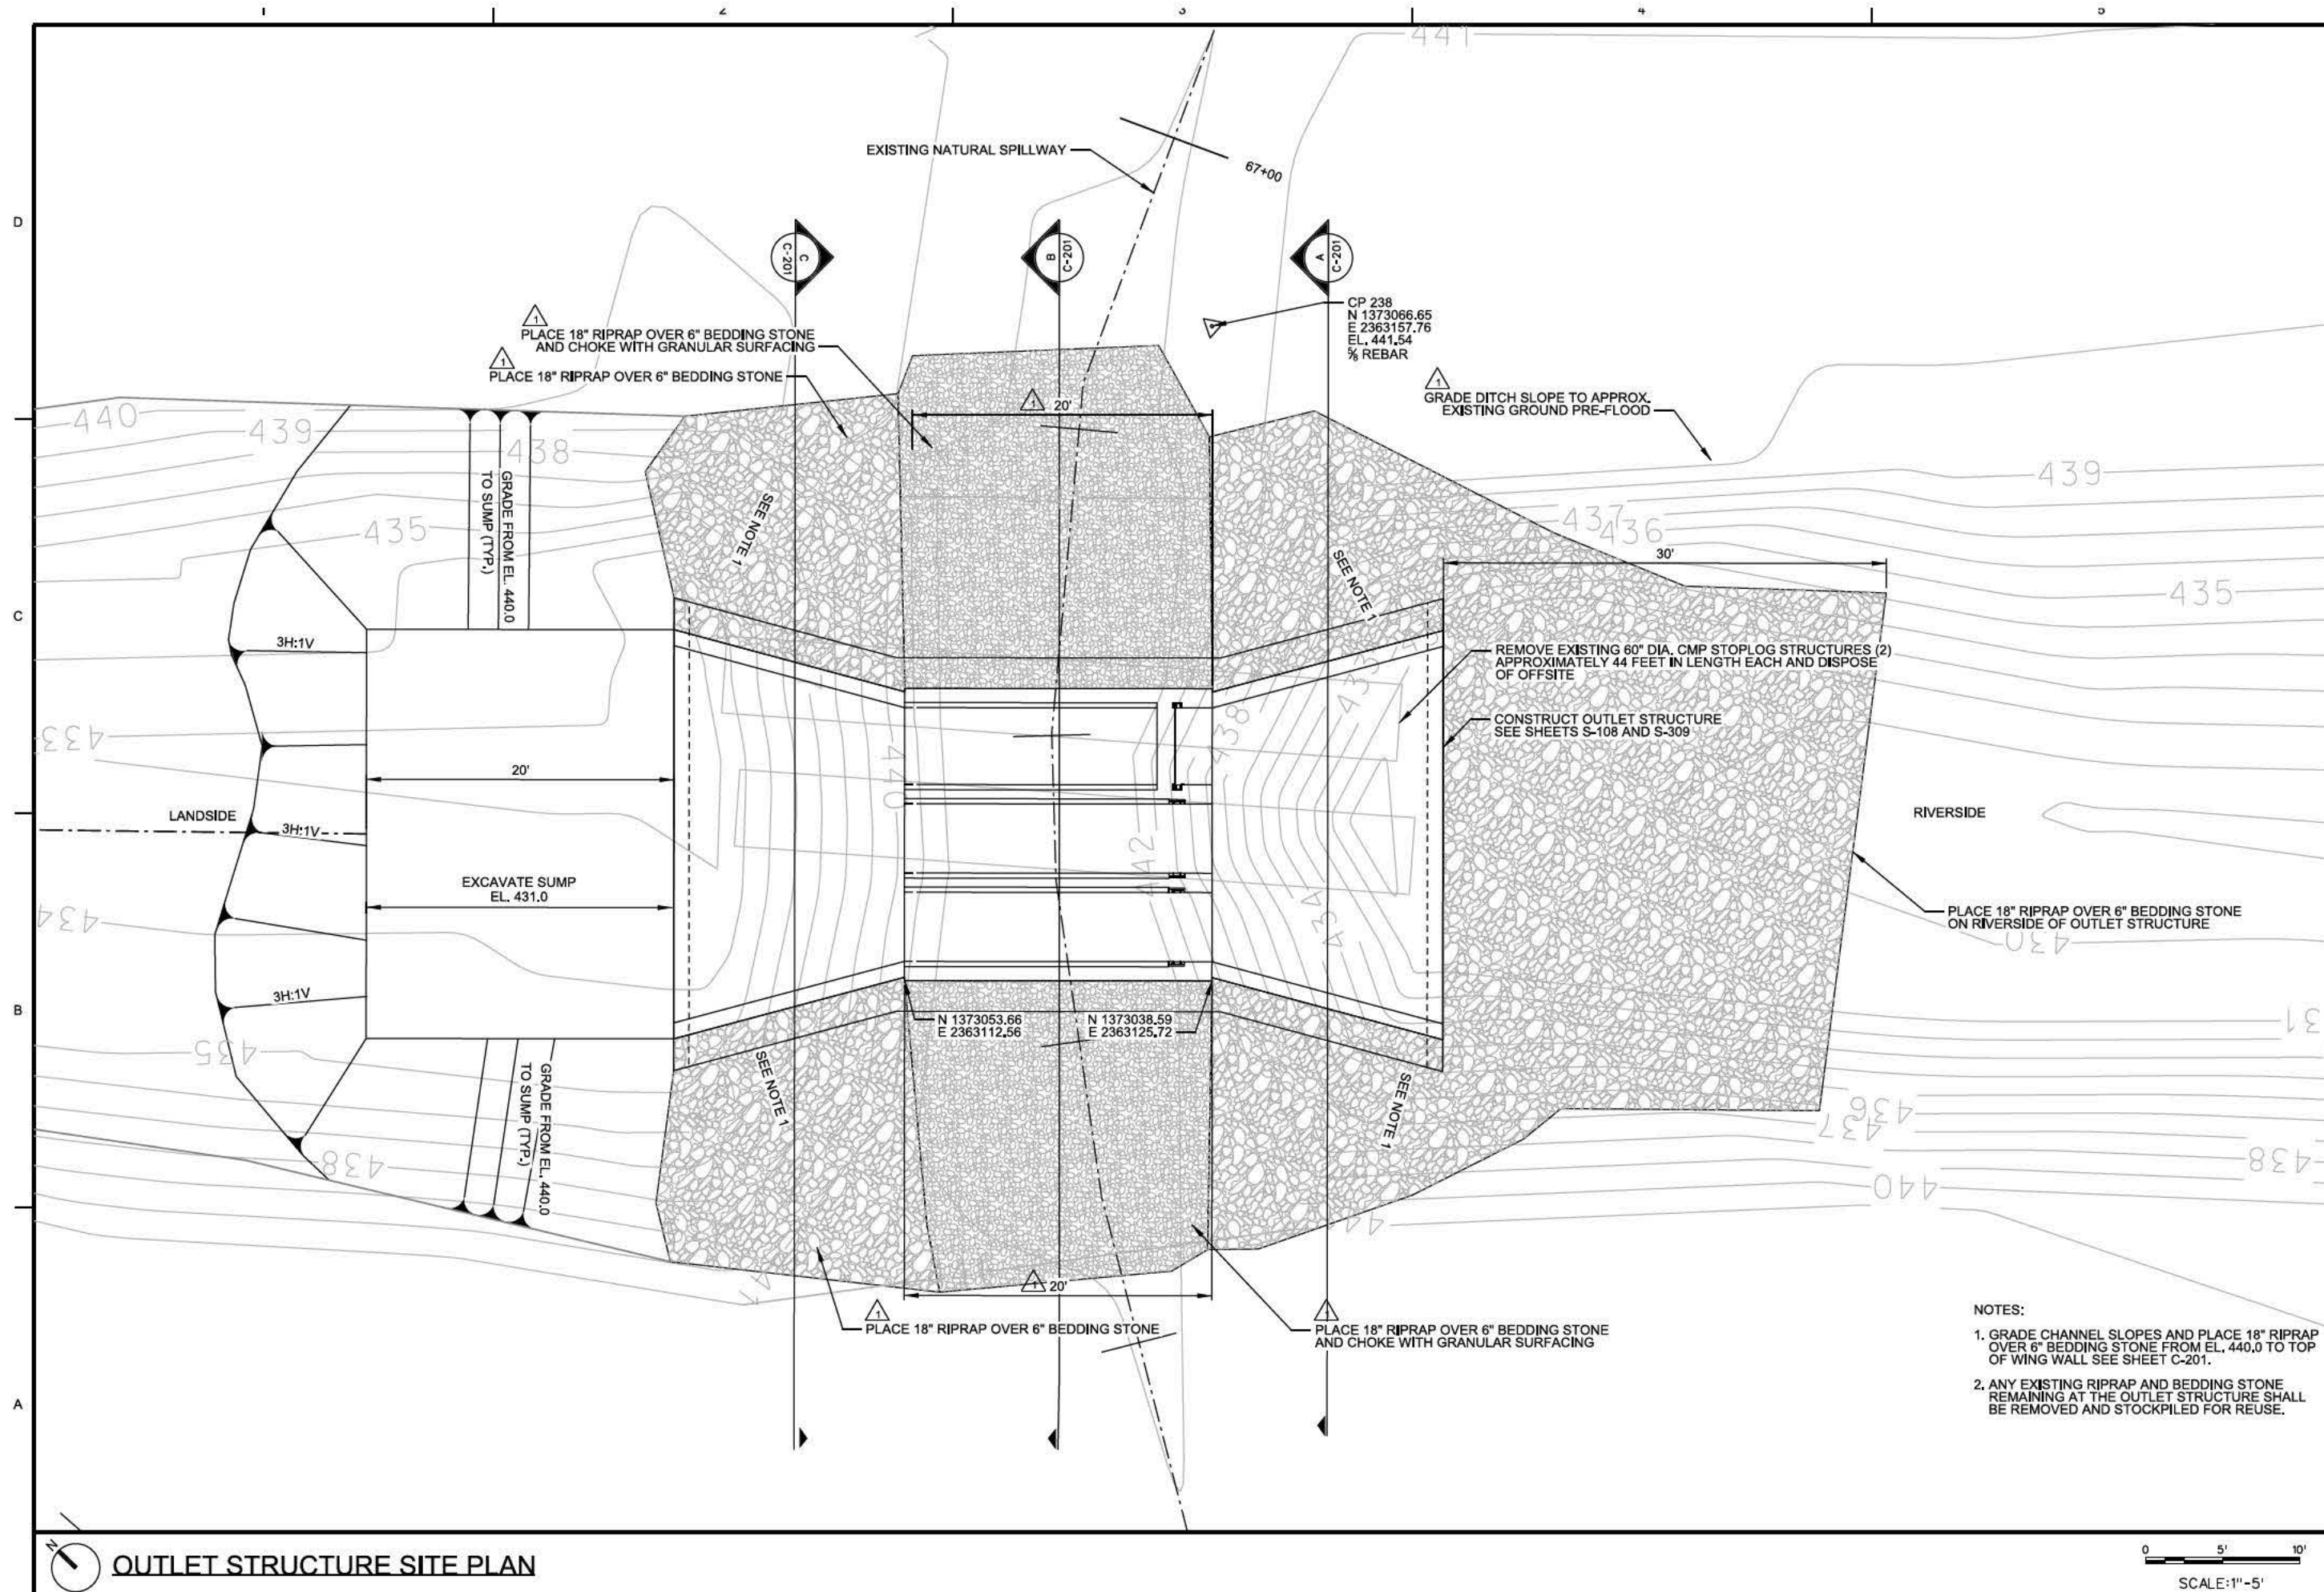





NATURAL SPILLWAY REPAIR AREA 1 SITE PLAN

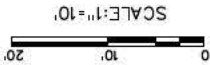


Sheet  
ID  
C-113

ILLINOIS WATERWAY  
FLORANGE POOL  
FLOOD CONTROL  
STAGE I  
NATURAL SPILLWAY  
REPAIR AREA 1  
SITE PLAN

U.S. ARMY CORPS OF ENGINEERS  
ROCK ISLAND DISTRICT  
ROCK ISLAND, ILLINOIS


DESIGNED BY:	DATE:
ROCK	20/10/2018
DRAWN BY:	SCALE:
SW	1/8"=1'-0"
SUBMITTED BY:	CONTRACT NO.:
H.A.	W125C1-13.000
AS SHOWN	PROJECT CODE:
	EP102
FILE NAME:	
EP102C1-13.000	
AWID	

MARK	DESCRIPTION	DATE
AS-BUILT	AS OF 29 SEPTEMBER 2017	APR

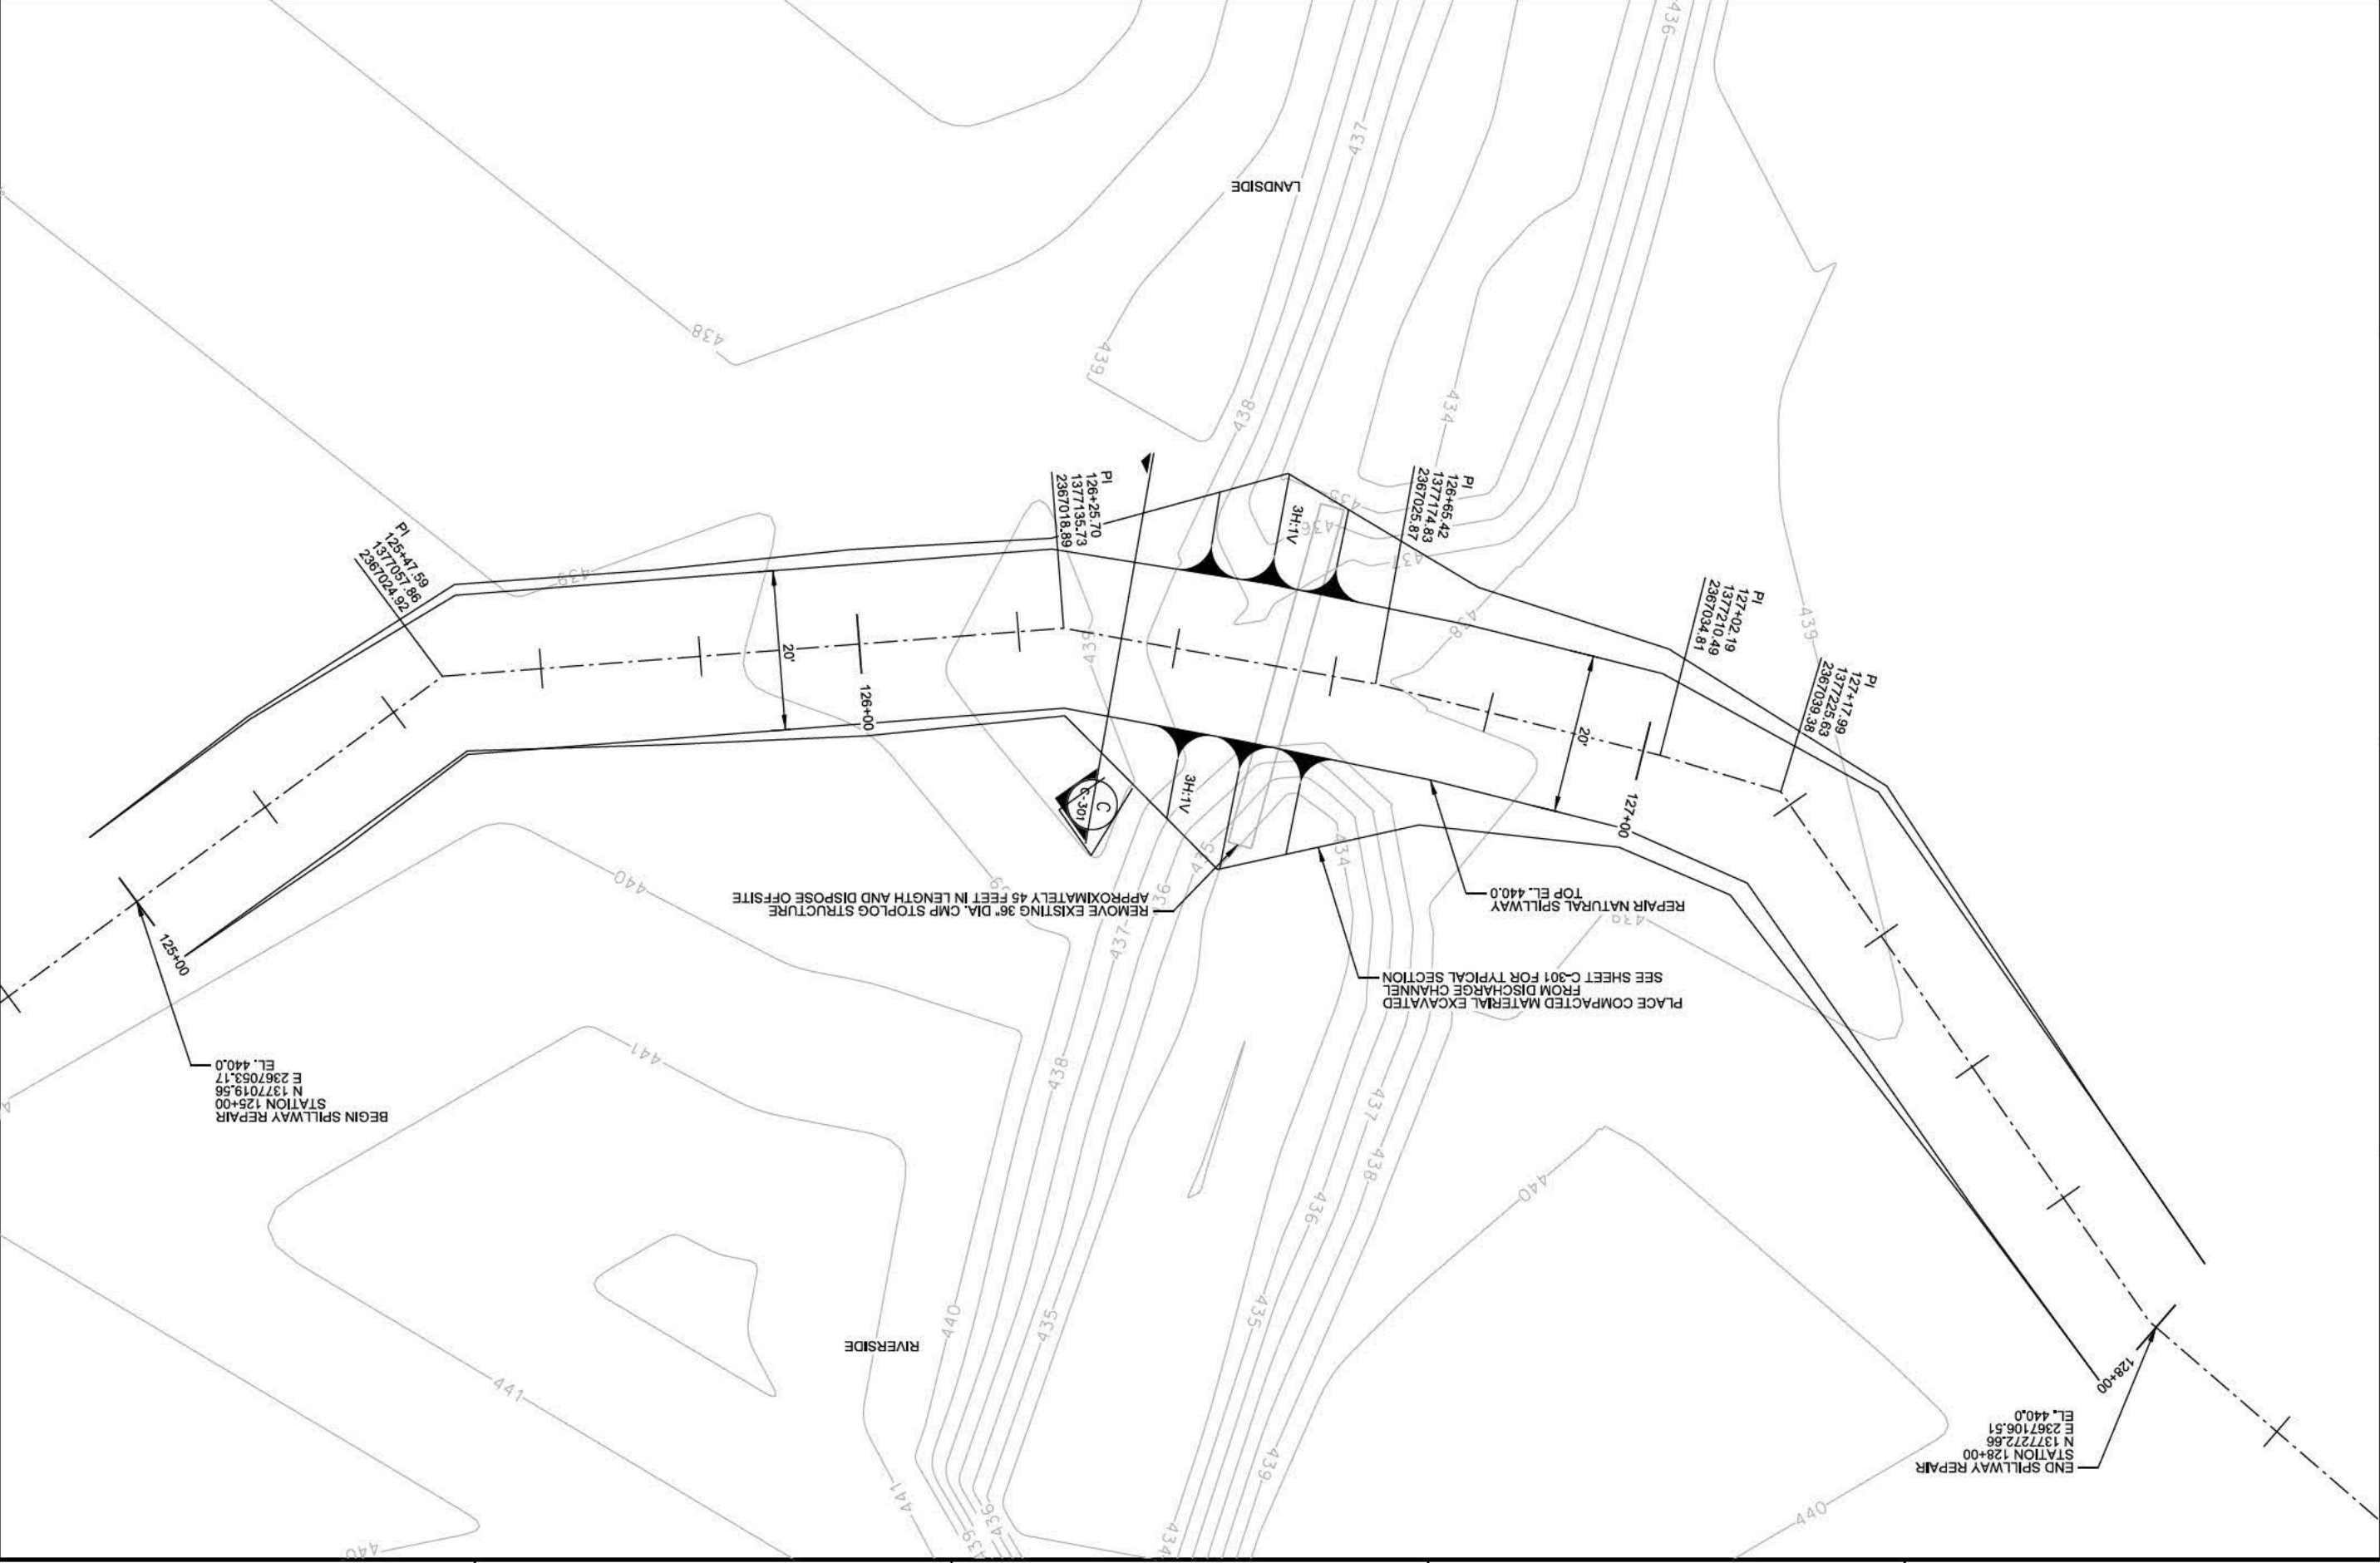






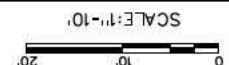

US Army Corps  
of Engineers®



c:\pwworking\mymt5\calh0153728\EP102C-120.dgn  
8/28/2018 3:11:18 PM  
BEDDLIN

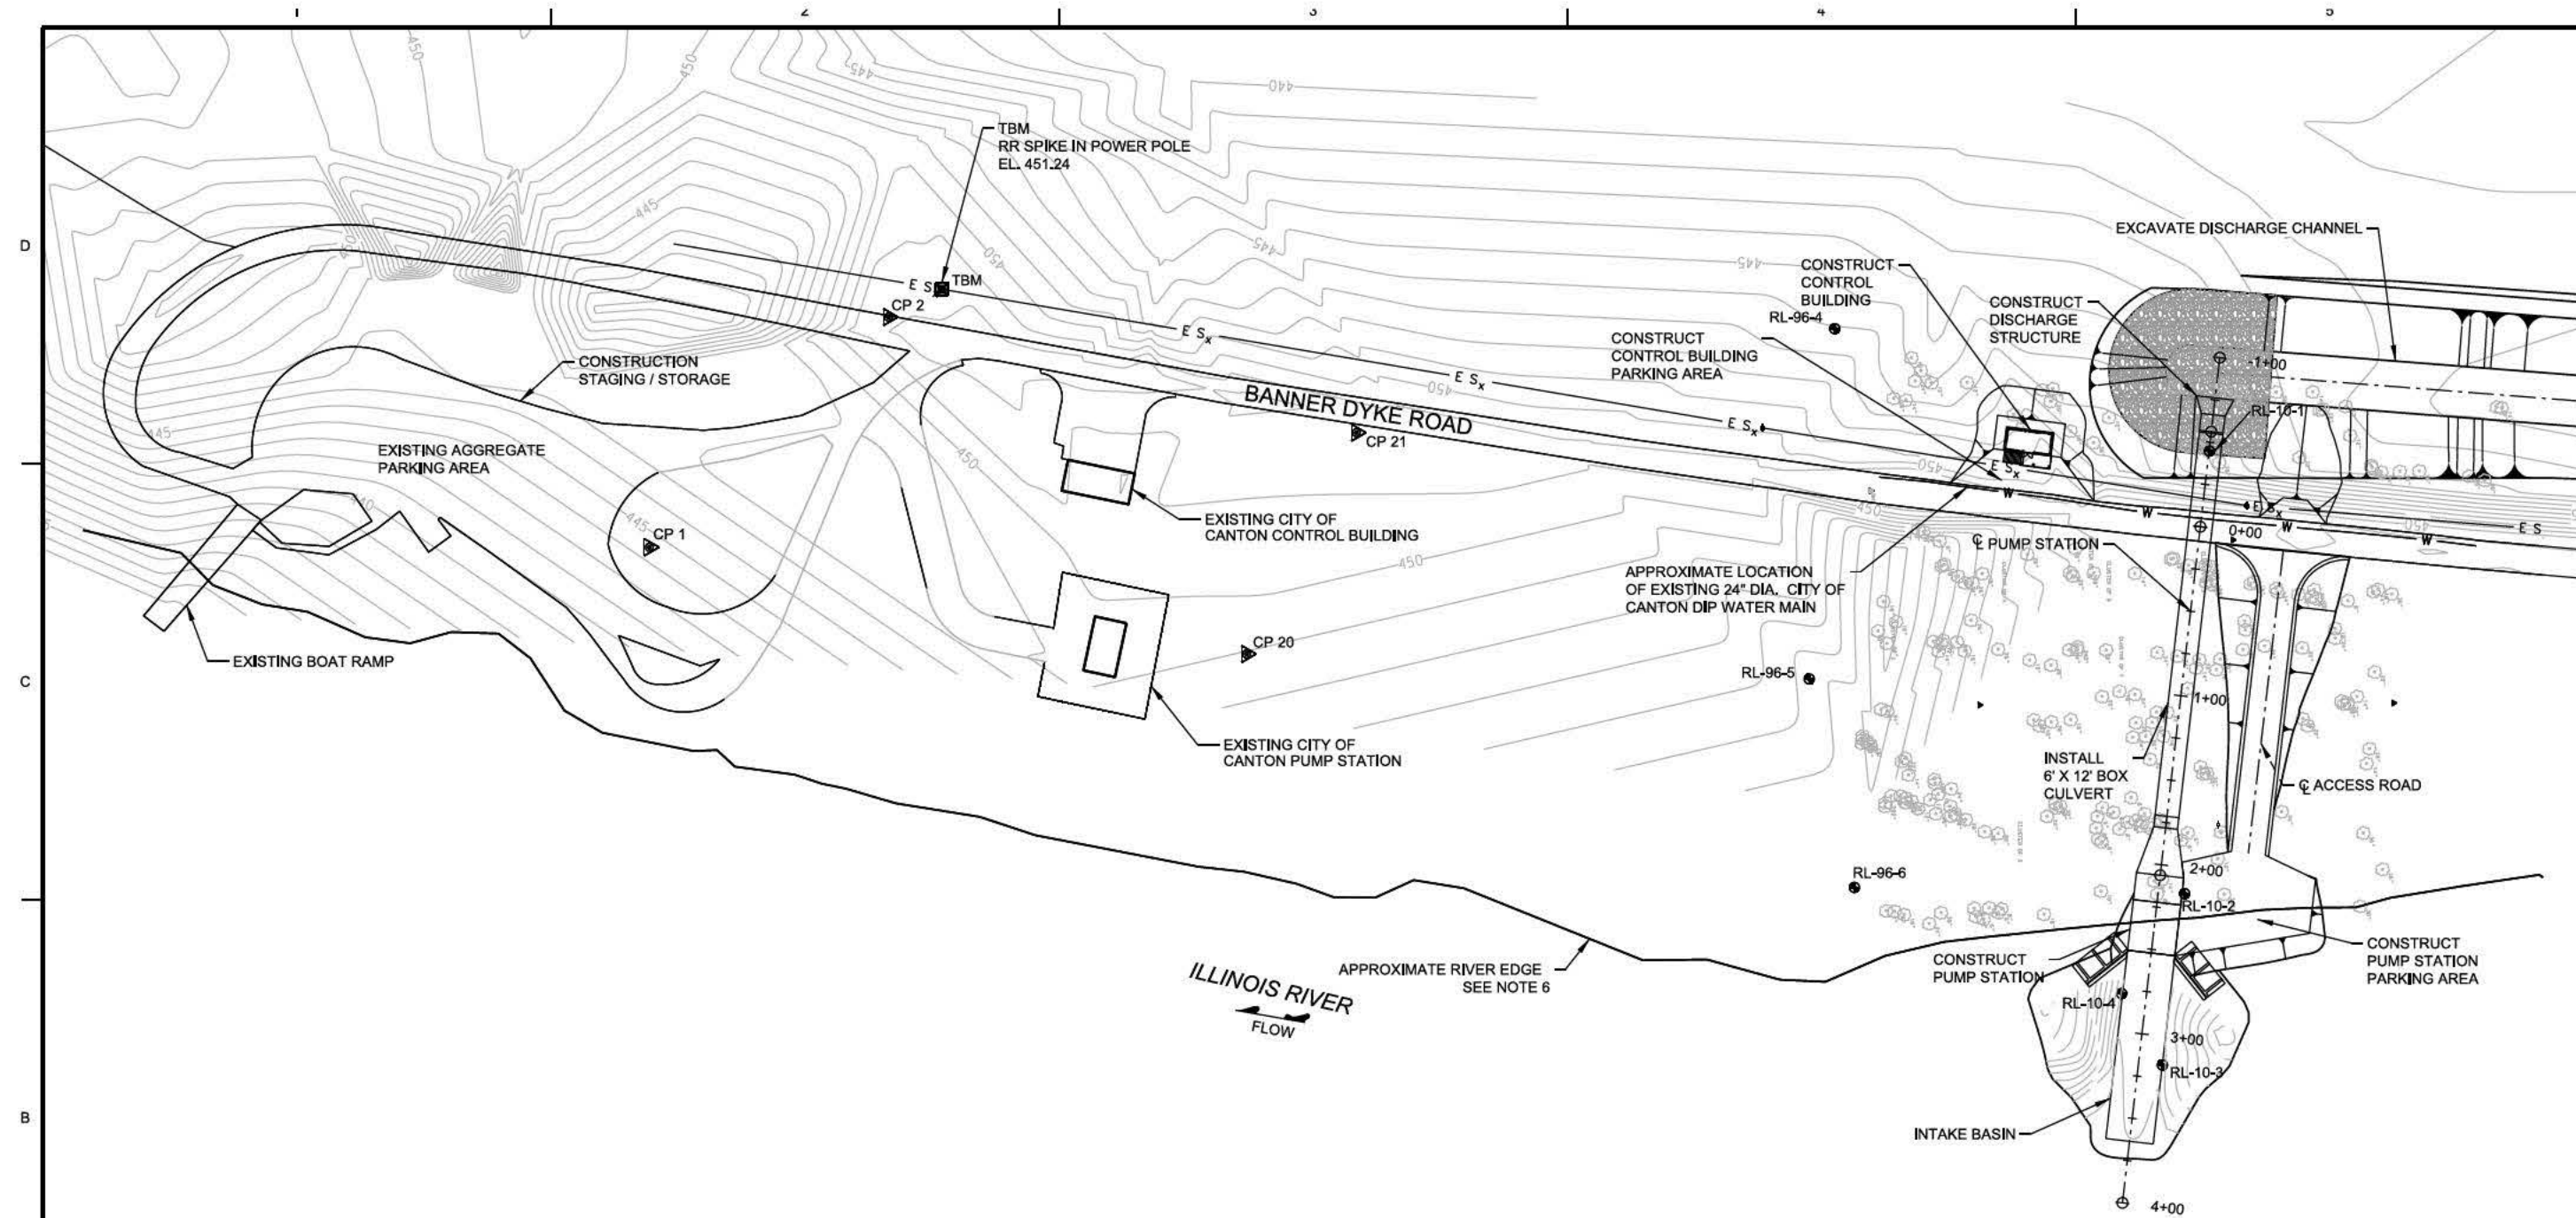

NOTES:

1. THE PUMP STATION TO BE CONSTRUCTED IS LOCATED 3.2 MILES SOUTH OF U.S. HIGHWAY 24 ALONG COUNTY ROAD 7 (FULTON ST / BANNER DYKE ROAD).
2. CONTRACTOR IS RESPONSIBLE FOR TRAFFIC CONTROL AND MUST STAGE WORK TO MAINTAIN ACCESS ALONG BANNER DYKE ROAD AT ALL TIMES DURING CONSTRUCTION. CONTRACTOR SHALL ALSO MAINTAIN ACCESS TO BOAT RAMP.
3. CONTRACTOR MAY USE THE AGGREGATE PARKING AREA FOR CONSTRUCTION STAGING. PARKING AREA SHALL BE REPAIRED BACK TO PRECONSTRUCTION CONDITIONS UPON COMPLETION OF CONSTRUCTION. PARKING AREA SUBJECT TO VARYING RIVER ELEVATIONS. SEE CP1 FOR ELEVATION REFERENCE.
4. COORDINATES FOR THE LAYOUT OF THE PUMP STATION AND ASSOCIATED FEATURES ARE PROVIDED ON SHEET V-102.
5. LOCATION OF EXISTING WATER MAIN IS APPROXIMATE. CONTRACTOR SHALL ALSO BE AWARE OF A POTENTIAL UNDERGROUND TELEPHONE LINE LOCATED ON THE EAST SIDE OF BANNER DYKE ROAD. CONTRACTOR SHALL LOCATE UTILITIES PRIOR TO CONSTRUCTION.
6. RIVER EDGE SHOWN WAS SURVEYED ON APRIL 22, 2010 AT APPROXIMATE EL. 438. RIVER ELEVATION VARIES.

 **PUMP STATION GENERAL PLAN**

0 50' 100'  
SCALE IN FEET




DATE	DESCRIPTION
AS-BUILT AS OF 28 SEPTEMBER 2017	

DESIGNED BY: RCP	DATE: 28-10-2016	SOLICITATION NO.:
DWN BY: CVA	CONTRACT NO.:	
SUBMITTED BY: H.A.	CONTRACT NO.:	
PLAT SCALE:	PROJECT CODE:	
AS SHOWN	EP102	
FILE NAME:		
ANAL D	EP102C-120.dgn	

ILLINOIS WATERWAY  
LAGRANGE POOL  
FLICKER HILL  
RICE LAKE HABITAT REHAB & ENHANCEMENT  
STAGE I  
PUMP STATION  
GENERAL PLAN

Sheet ID  
**C-120**



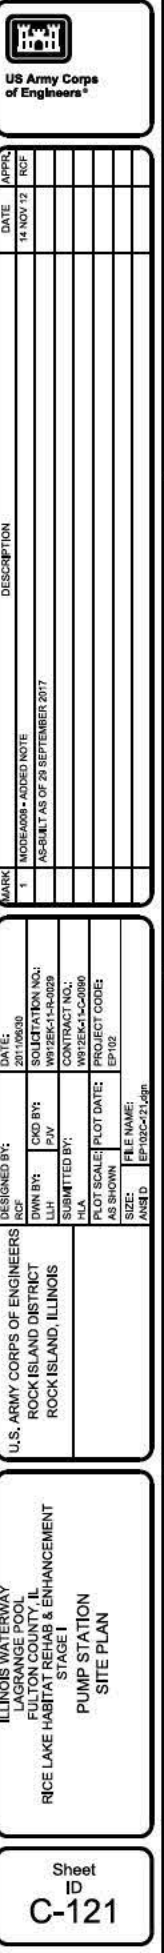




D

C


B

A

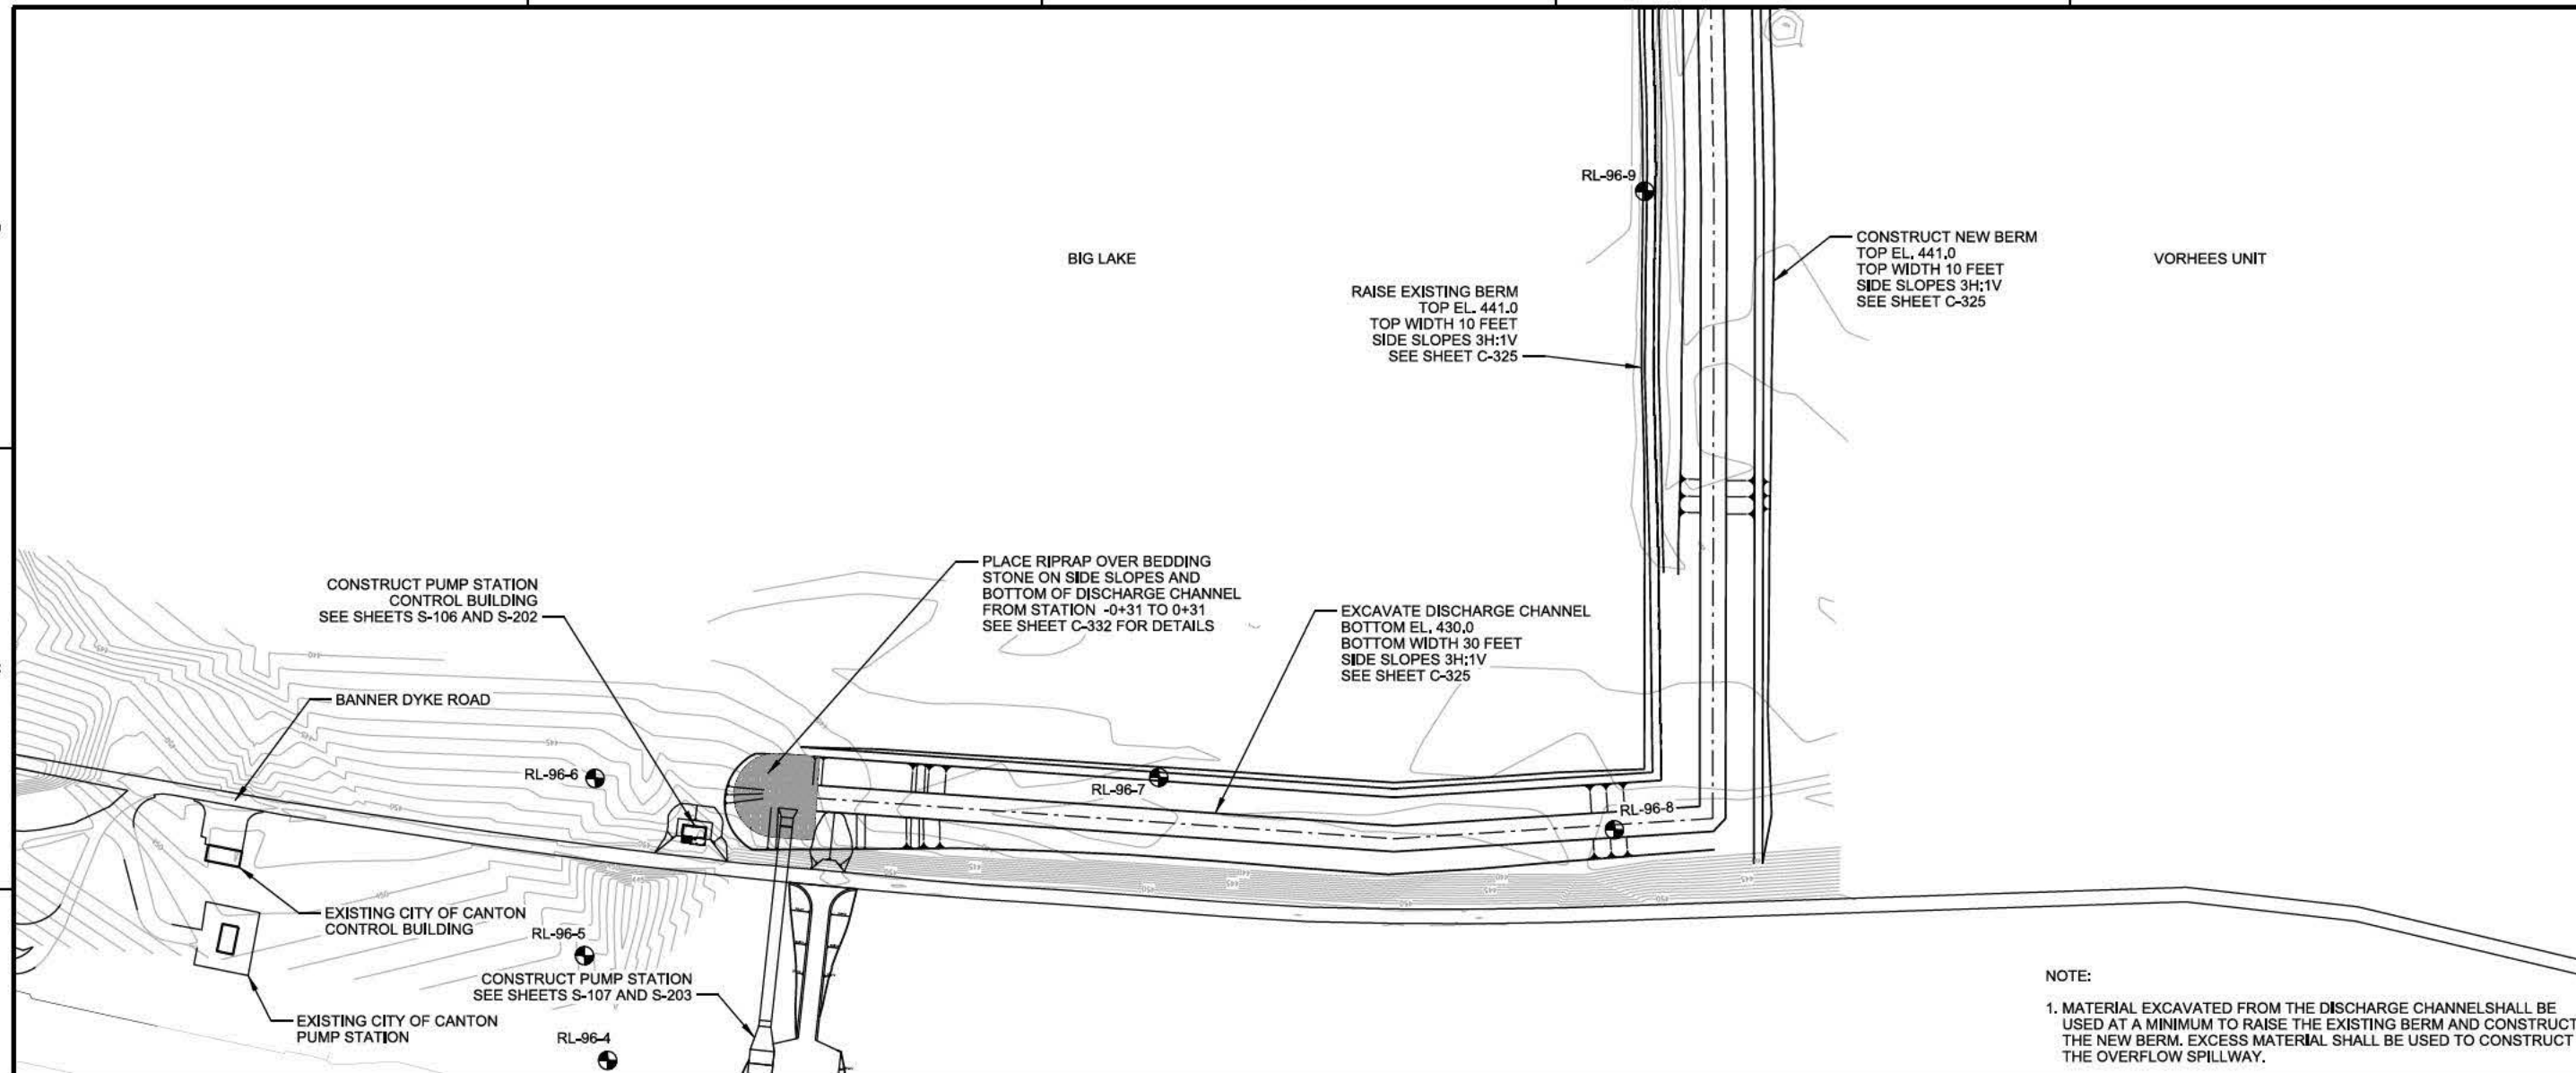

DISCHARGE CHANNEL PLAN

0 100' 200'  
SCALE: 1" = 100'

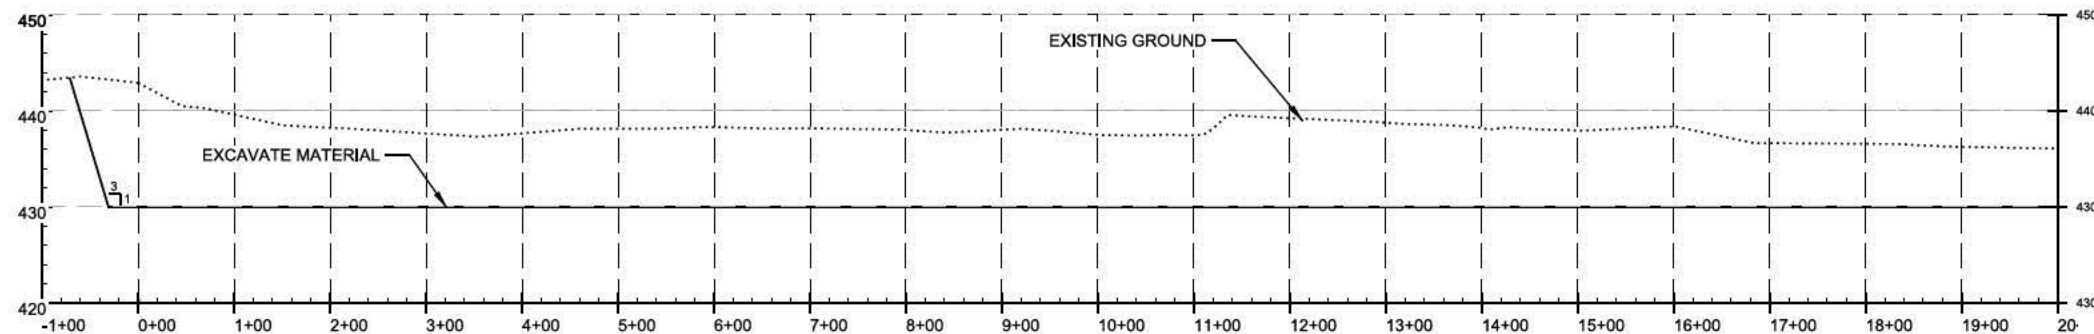

DISCHARGE CHANNEL PROFILE STA. 0+00 TO 20+00

NO SCALE



DATE	DESCRIPTION
AS-BUILT AS OF 28 SEPTEMBER 2017	

DESIGNED BY: RCP	DATE: 28 SEP 2017	SOLICITATION NO.: W123541-1-2017
DRAWN BY: H.A.	CONTRACT NO.: W123541-1-2017	PROJECT CODE: EP102
SUBMITTED BY: H.A.	FILE NAME: EP102C-122.dgn	ANALYST: H.A.
U.S. ARMY CORPS OF ENGINEERS ROCK ISLAND DISTRICT ROCK ISLAND, ILLINOIS		

ILLINOIS WATERWAY LAGRANGE POOL FLOOD CONTROL RICE LAKE HABITAT REPAIR & ENHANCEMENT STAGE 1 DISCHARGE CHANNEL PLAN AND PROFILE STA. 0+00 TO 20+00
---


Sheet ID C-122
----------------------









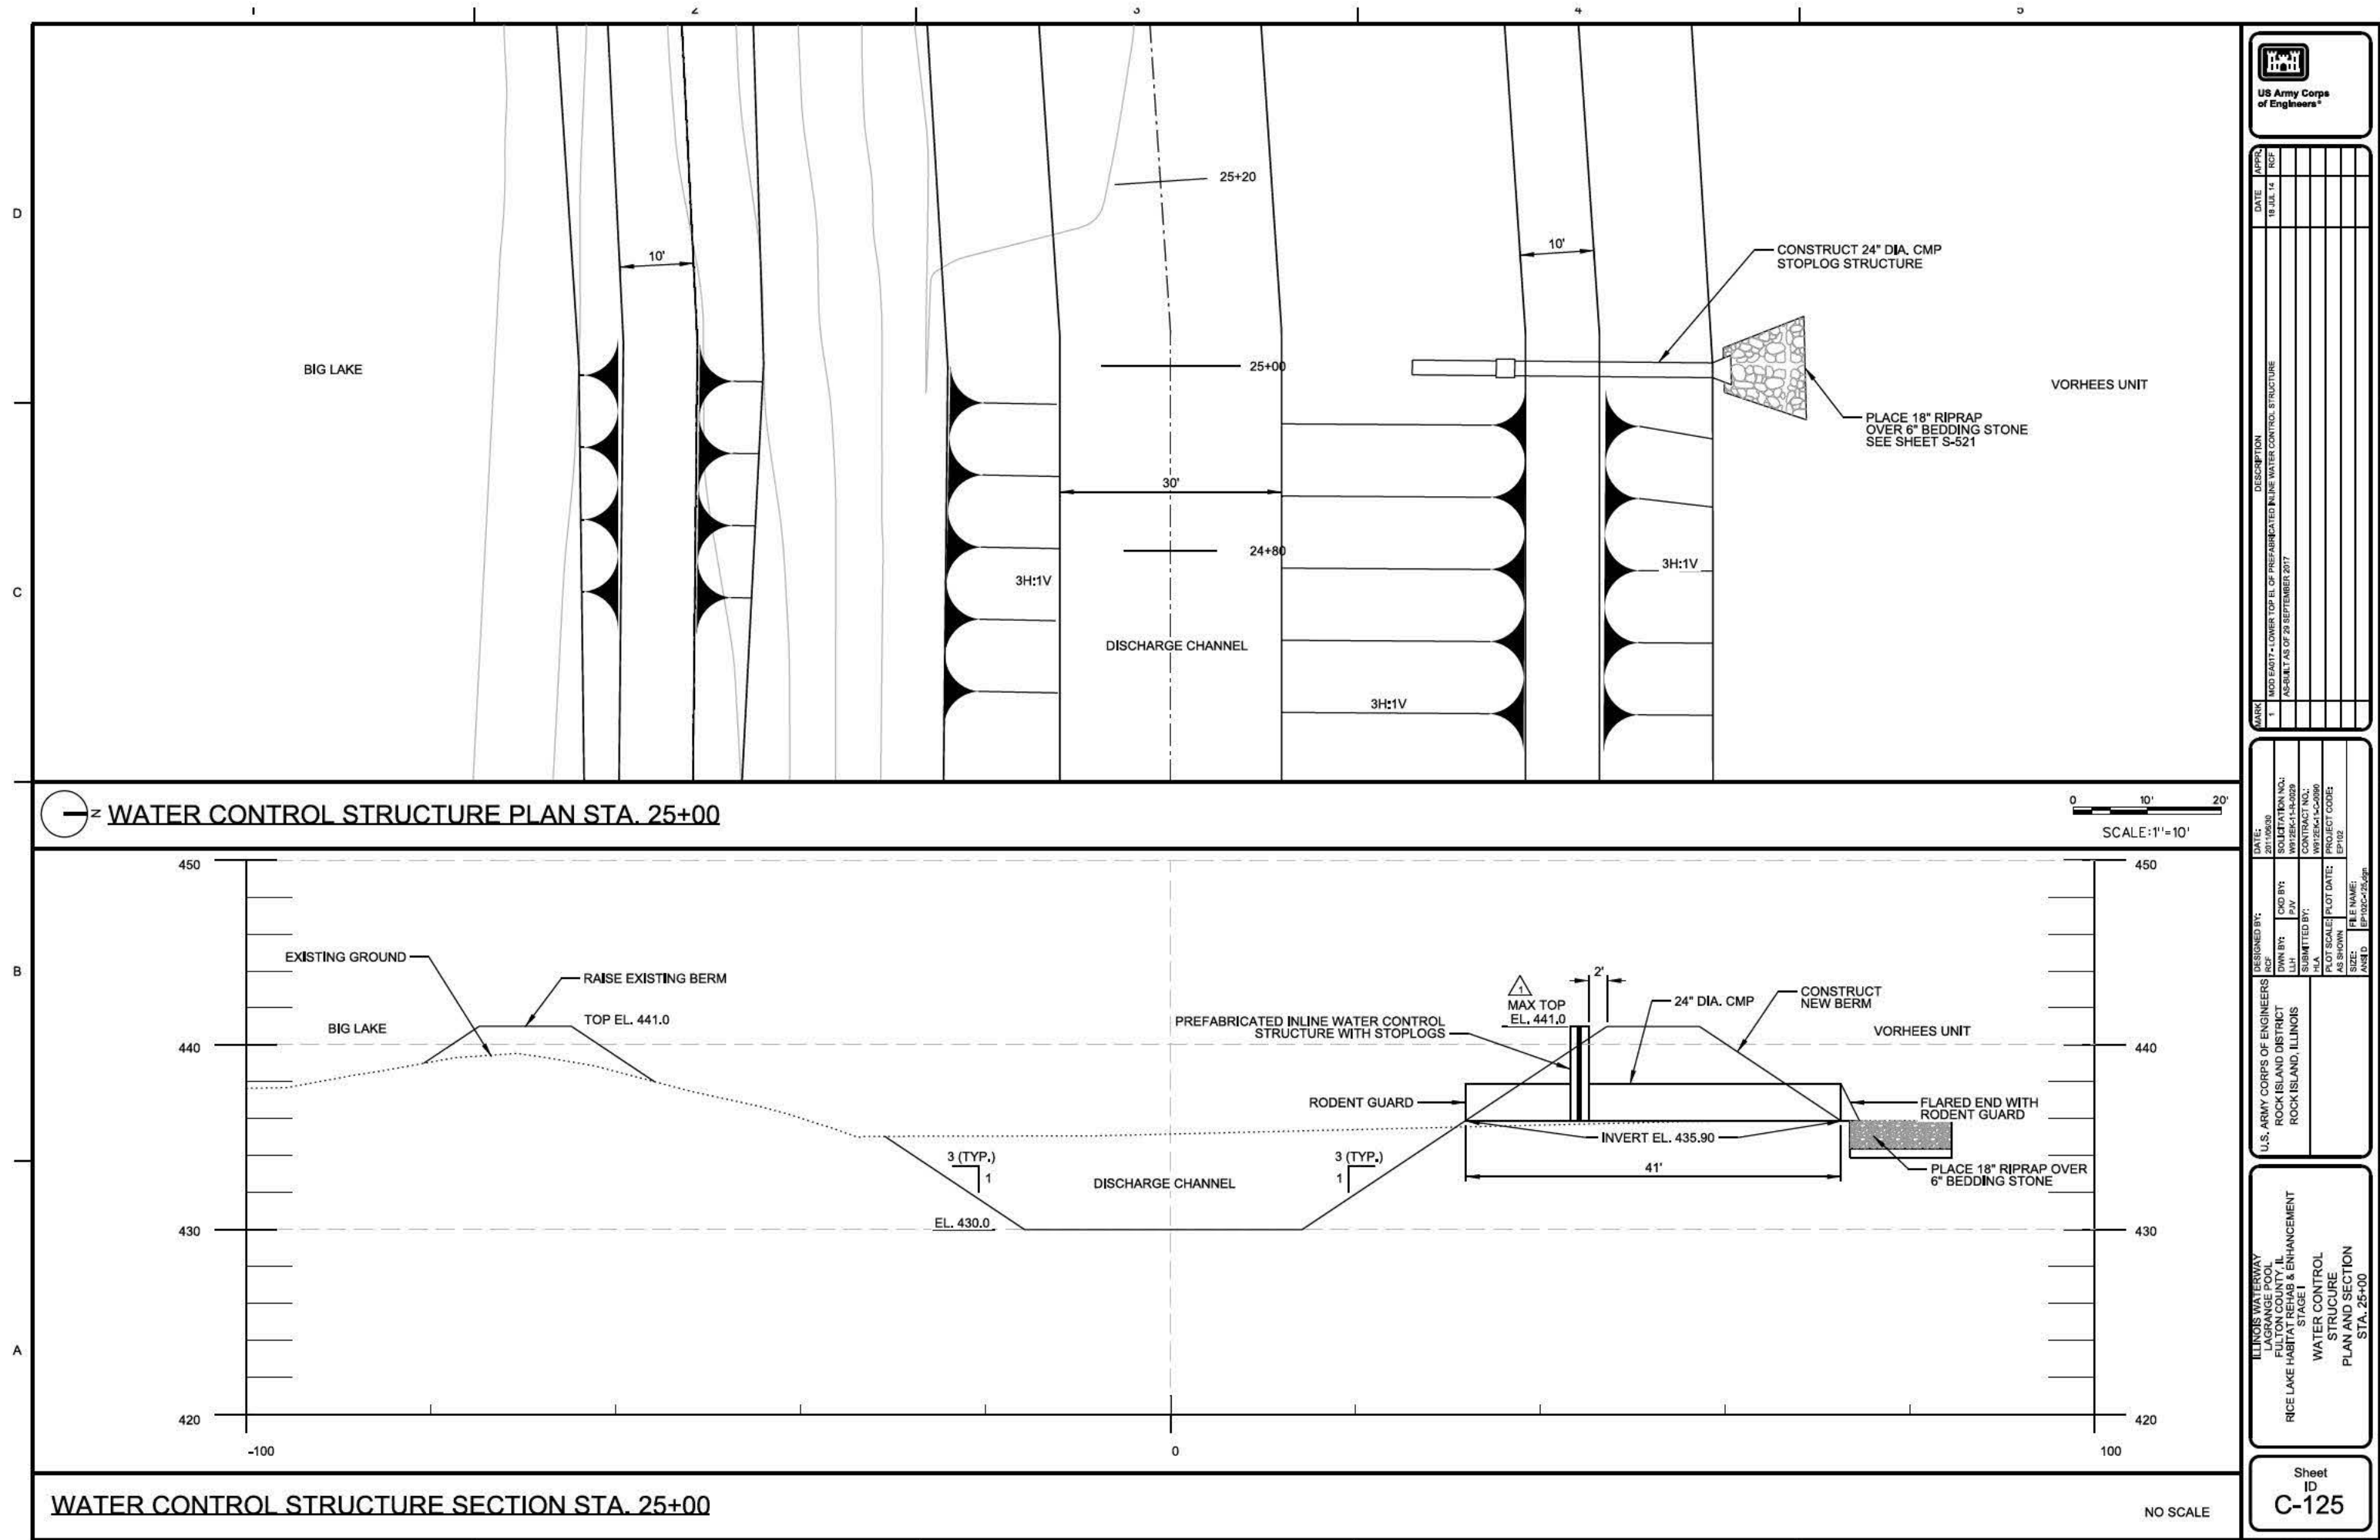




US Army Corps of Engineers

DATE	APPR.	RCF
18 JUL 14		

DESCRIPTION  
MOD EASIT-1 LOWER TOP EL OF PREFABRICATED INLINE WATER CONTROL STRUCTURE  
AS-BUILT AS OF 29 SEPTEMBER 2017

MARK	DATE	APPR.	RCF
1			

DESIGNED BY:	CHK BY:	DATE:	DESIGNED BY:	CHK BY:	DATE:
RCF	CVA	25-10-2010	RCF	CVA	25-10-2010

U.S. ARMY CORPS OF ENGINEERS	PROJECT NO.	PROJECT CODE
ROCK ISLAND DISTRICT	W012541-1-2006	EP102


U.S. ARMY CORPS OF ENGINEERS	PROJECT NO.	PROJECT CODE
ROCK ISLAND DISTRICT	W012541-1-2006	EP102

ILLINOIS WATERWAY  
LA GRANGE POOL  
FLOOD CONTROL  
RICE LAKE HABITAT REHAB & ENHANCEMENT  
STAGE I

WATER CONTROL  
STRUCTURE  
PLAN AND SECTION  
STA. 25+00


Sheet  
ID  
**C-125**

AS-BUILT  
**A-31**

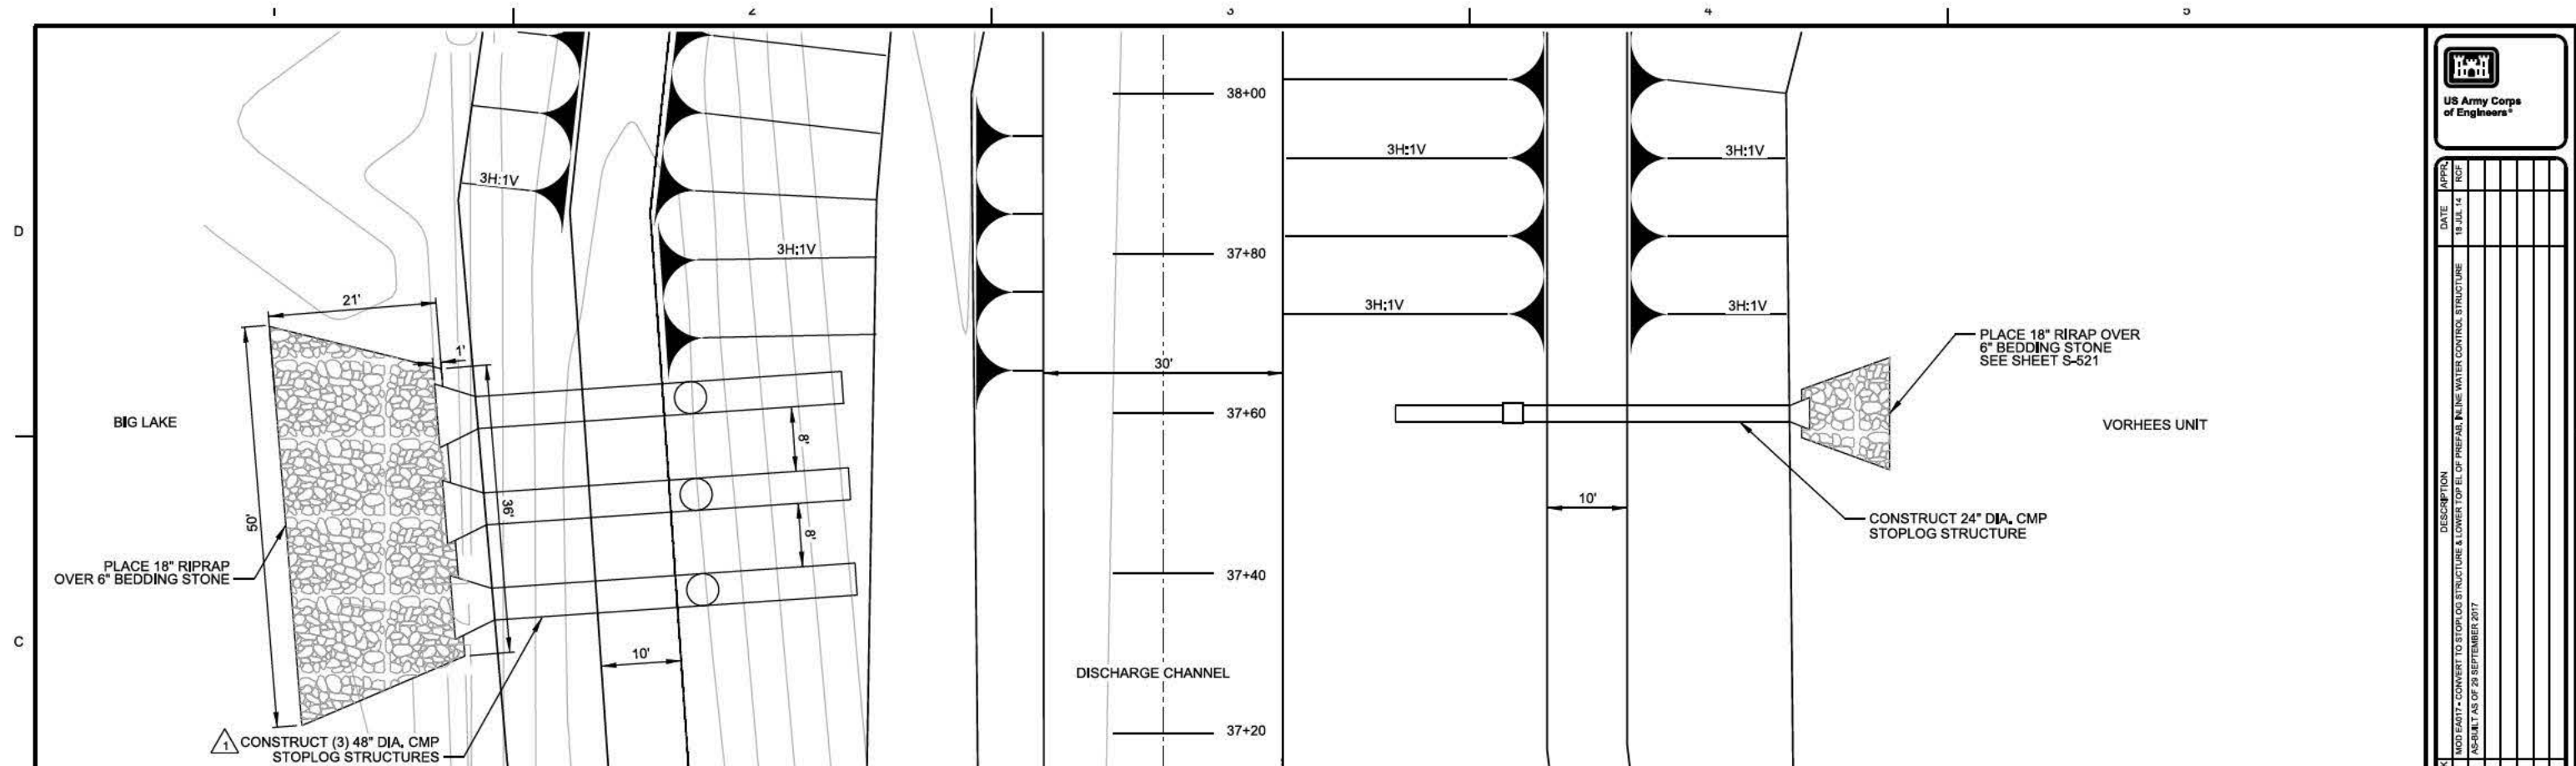

WATER CONTROL STRUCTURES PLAN STA. 37+60

0 10' 20'  
SCALE: 1"=10'

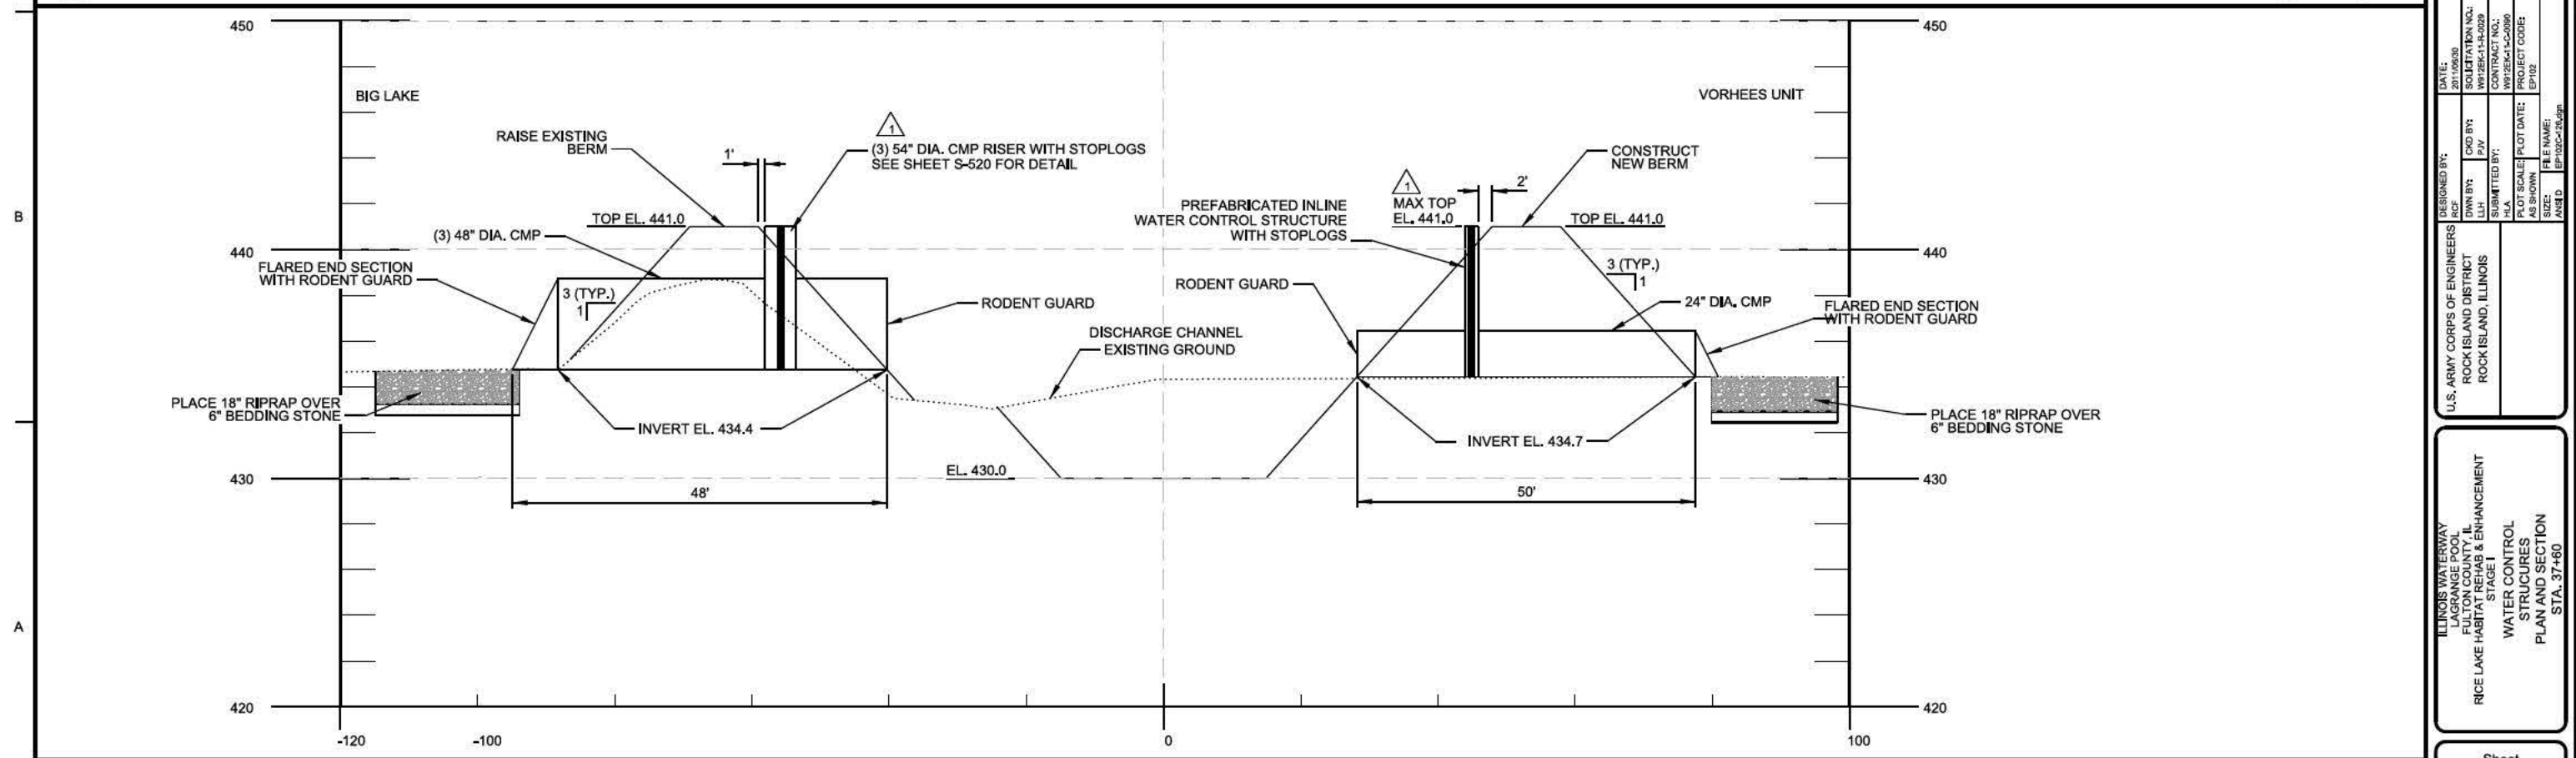

WATER CONTROL STRUCTURES SECTION STA. 37+60

NO SCALE

**US Army Corps of Engineers**

DATE: 18 JUL 14

APPR: RCF

DESCRIPTION: MOD EASIT - CONVERT TO STOPLOG STRUCTURE & LOWER TOP EL OF PREFAB. INLINE WATER CONTROL STRUCTURE AS-BUILT AS OF 29 SEPTEMBER 2017

MARK: 1

DESIGNED BY: RCF

DRAWN BY: CVA

SUBMITTED BY: H.A.

PROJECT CODE: EP102

FILE NAME: EP102C-25.dgn

DATE: 25-10-2010

SOLICITATION NO.: 274

CONTRACT NO.: W0325K4-1-2-000

PROJECT CODE: EP102

U.S. ARMY CORPS OF ENGINEERS

ROCK ISLAND DISTRICT

ROCK ISLAND, ILLINOIS

ILLINOIS WATERWAY

LAGRANGE POOL

FLAT CREEK IN ILL.

RICE LAKE HABITAT REHAB & ENHANCEMENT

STAGE I

WATER CONTROL

STRUCTURES

PLAN AND SECTION

STA. 37+60

Sheet ID

**C-126**

AS-BUILT


**A-32**









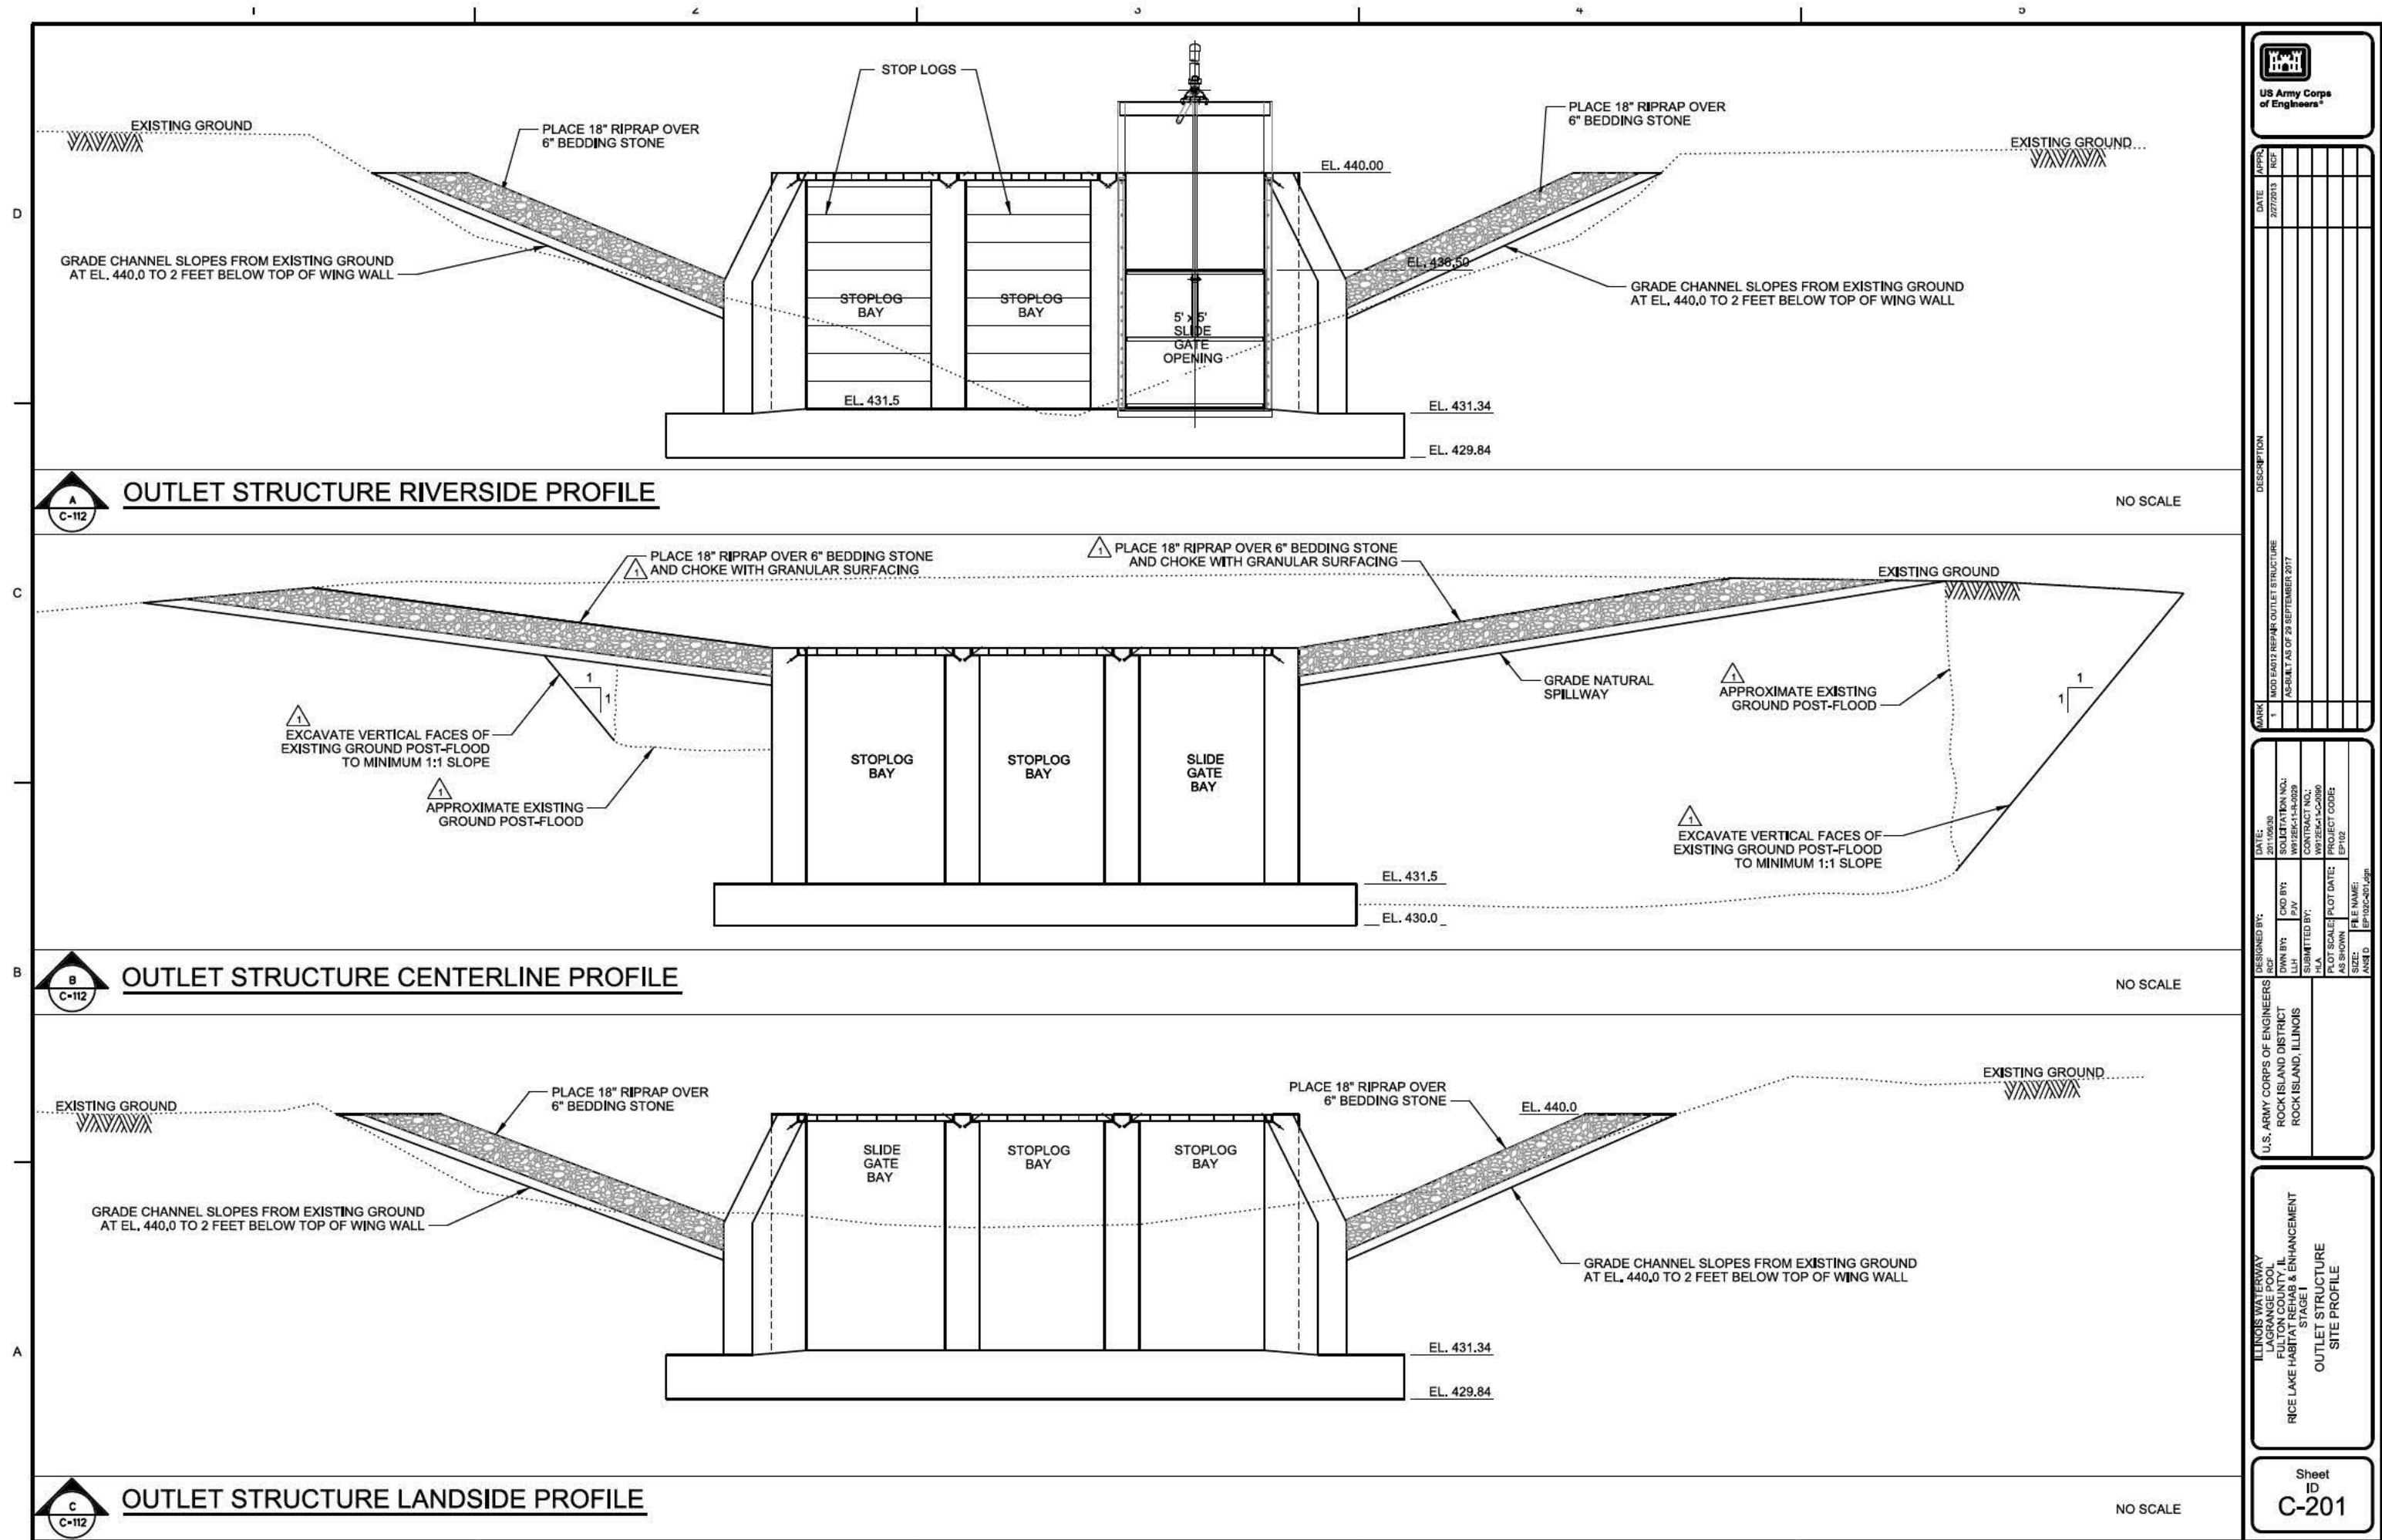


[illegible]

U.S. ARMY CORPS OF ENGINEERS ROCK ISLAND DISTRICT ROCK ISLAND, ILLINOIS	DESIGNED BY: ACF	DATE: 2/11/1963
	DWN BY: L.H.	SOLICITATION NO.: W125C13-0029
	CONTRACT NO.: W125C13-0096	
	PROJECT CODE: EP-102	
	PLOT SCALE: AS SHOWN	
	FILE NAME: EP-102-020.dgn	

ILLINOIS WATERWAY  
LAGRANGE POOL  
FULTON COUNTY, IL  
RICE LAKE HABITAT REHAB & ENHANCEMENT  
STAGE I  
PUMP STATION  
PROFILE

Sheet  
ID  
C-220

AS-BUILT  
A-36

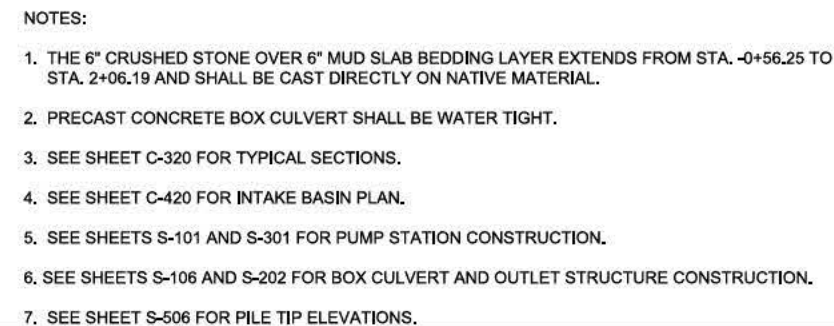

## PUMP STATION PROFILE

STATIONING ALONG CENTERLINE PUMP STATION

0 20' 40'

SCALE: 1"=20'






c:\pw\_working\mvr\lb5edd\hid0153728\EP102C-220.dgn  
8/28/2018 3:12:42 PM A












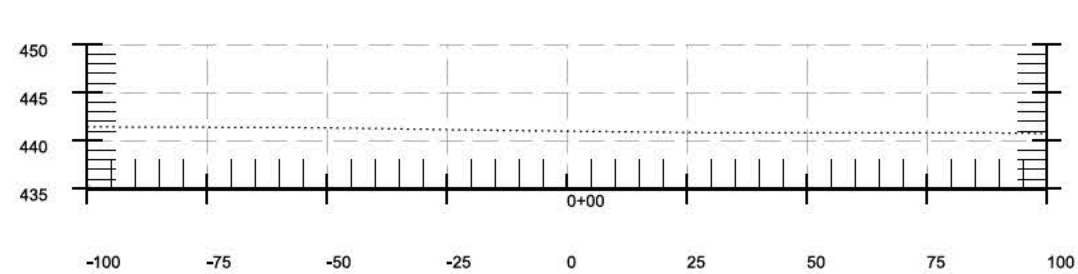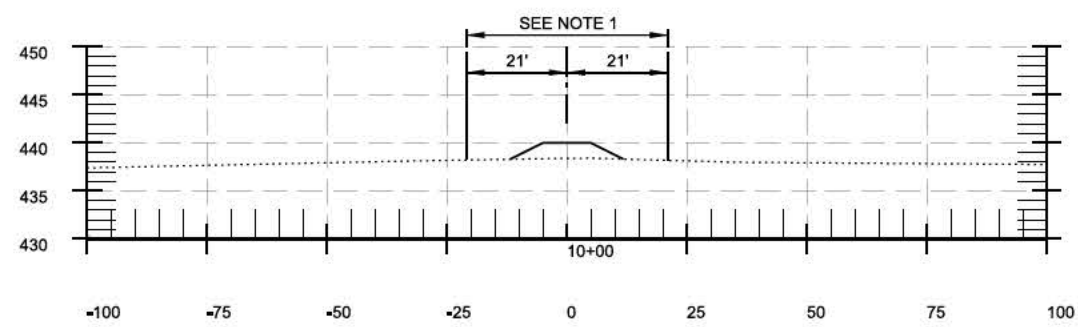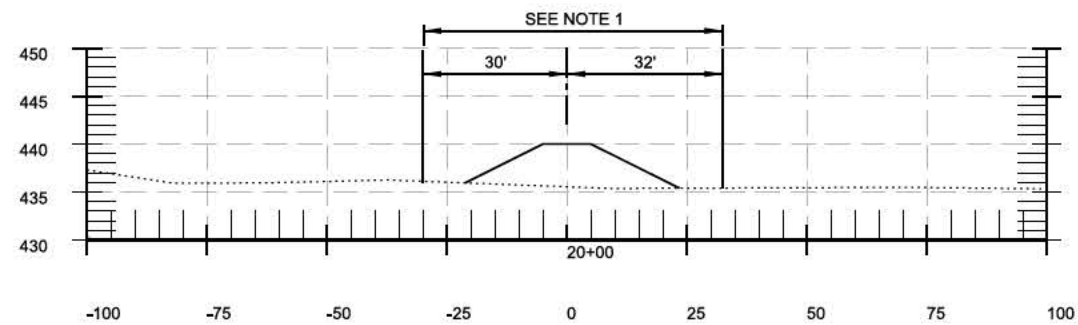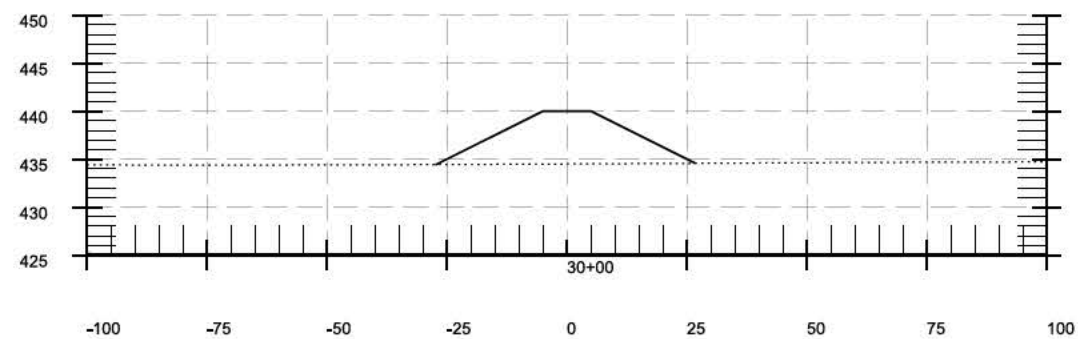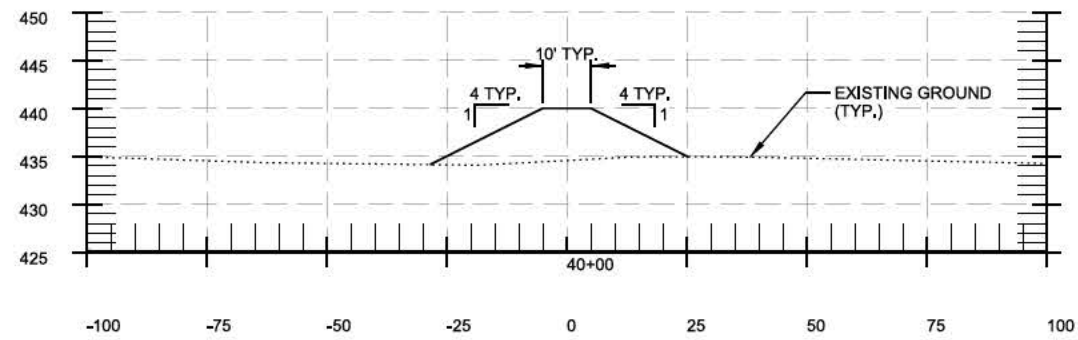

NOTES:

### 1. LIMITS OF CLEARING, GRUBBING, AND STRIPPING.

2. SINCE CONSTRUCTION IS IN THE WET FROM APPROX. STA. 22+00 TO APPROX. STA. 40+00, NO CLEARING, GRUBBING, AND STRIPPING WILL BE REQUIRED UNLESS DIRECTED BY THE CONTRACTING OFFICER,

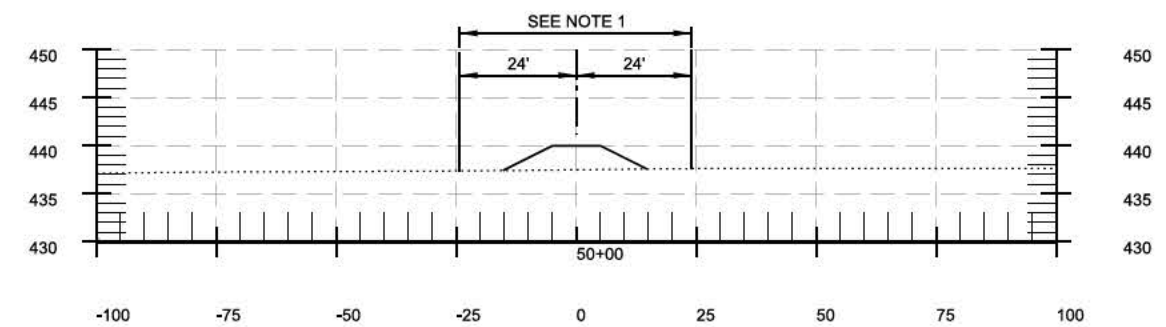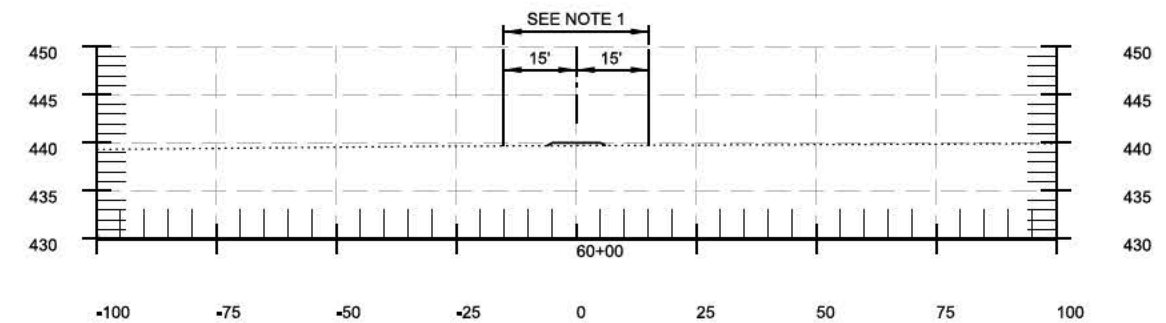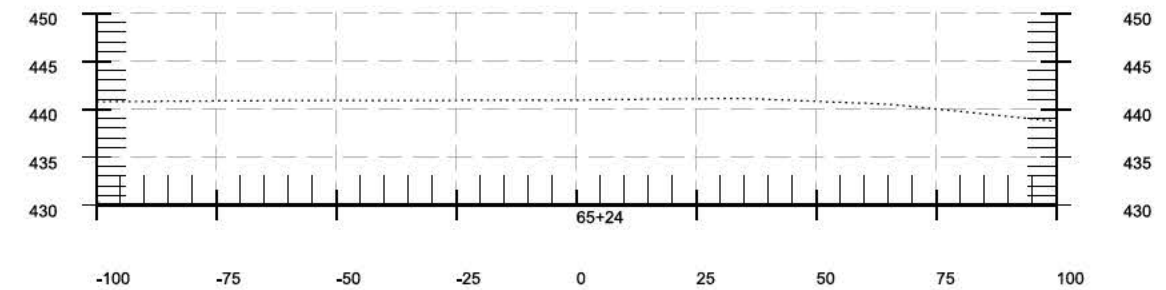

## OVERFLOW SPILLWAY SECTIONS

NO SCALE

[illegible]

U.S. ARMY CORPS OF ENGINEERS ROCK ISLAND DISTRICT ROCK ISLAND, ILLINOIS	DESIGNED BY: DATE:	DRAWN BY: L.H.	CWD BY: P.W.	SOLUTION NO.: W912E54-14-2029
	SUBMITTED BY: U.A.	PLOT SCALE: AS SHOWN	PLOT DATE: EP102	CONTRACT NO.: W912E54-52-0180
FILE NAME: EP102C-502.dgm				


ILLINOIS WATERWAY  
LAGRANGE POOL  
FULTON COUNTY, IL  
RICE LAKE HABITAT REHAB & ENHANCEMENT  
STAGE I  
OVERFLOW  
SPILLWAY SECTIONS

Sheet  
ID  
C-302

AS-BUILT  
A-39





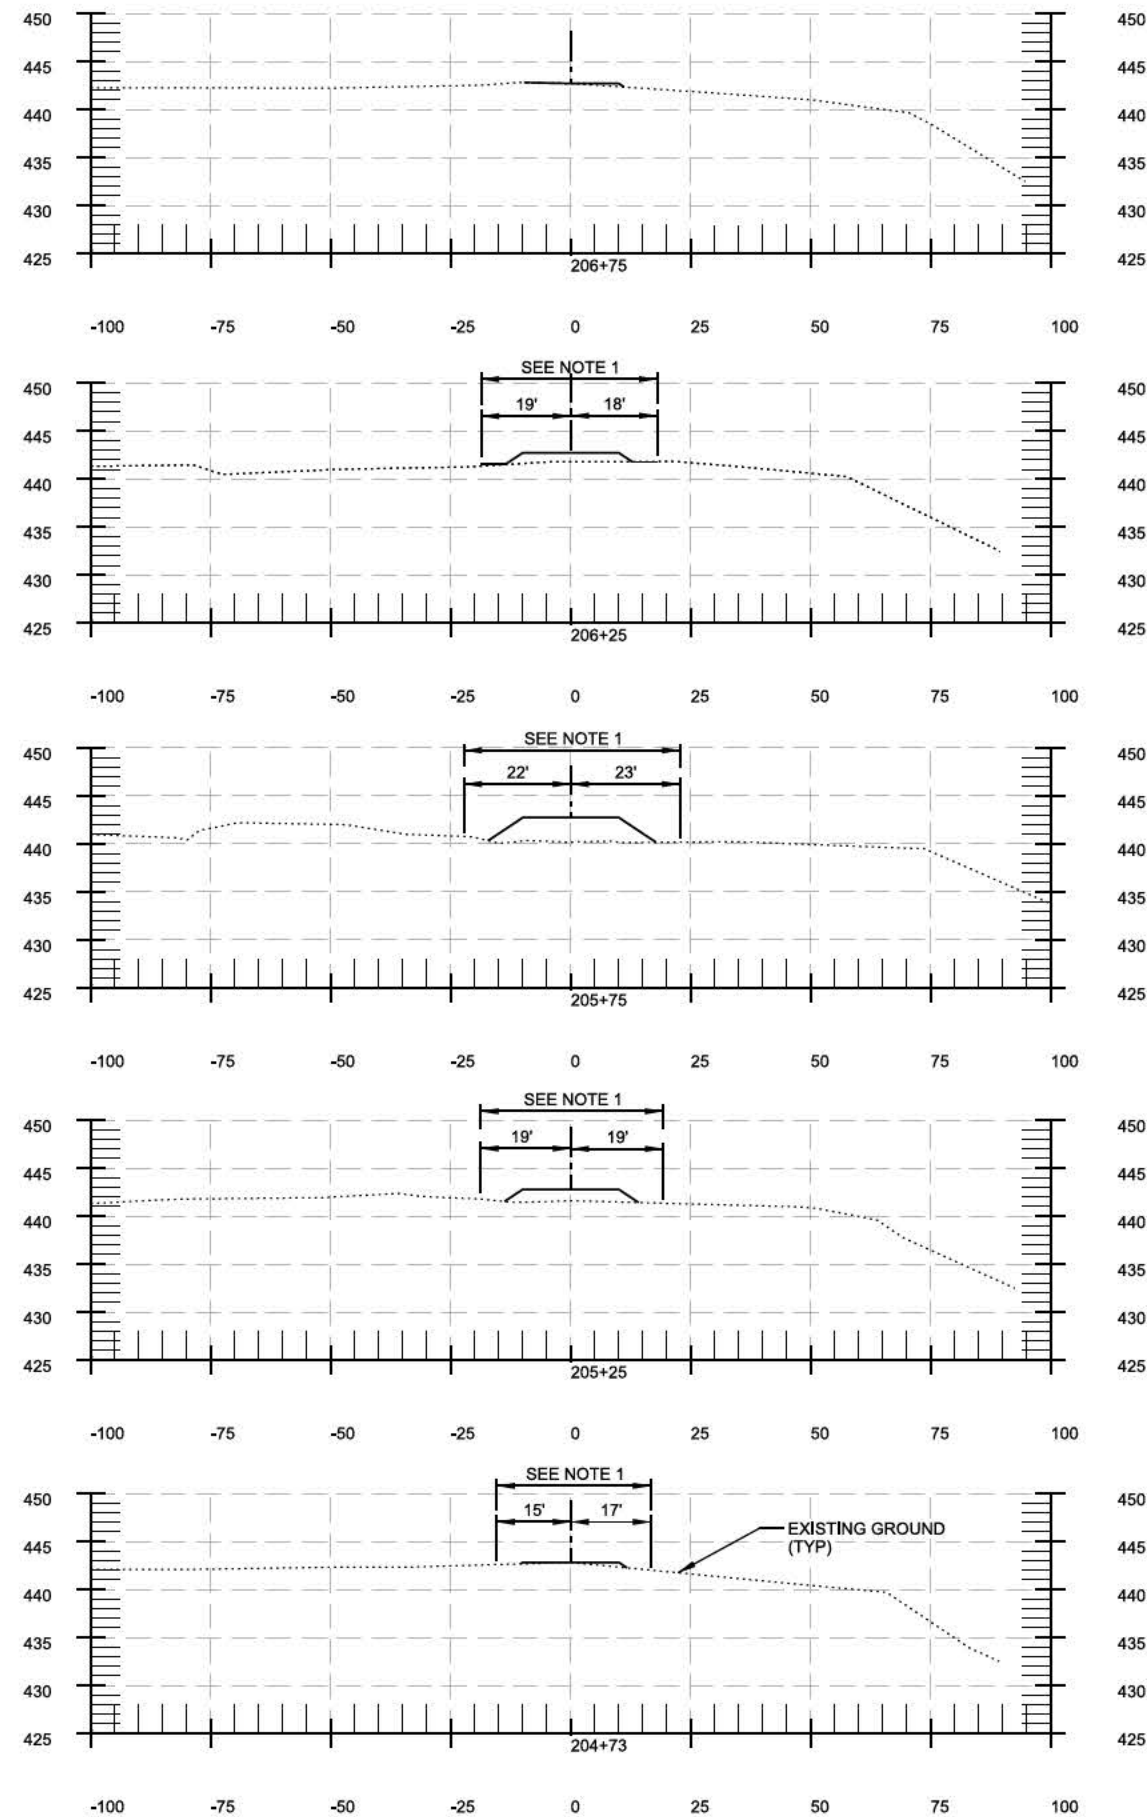

NOTE:

1. LIMITS OF CLEARING, GRUBBING, AND STRIPPING.

### NATURAL SPILLWAY REPAIR AREA 3 SECTIONS

NO SCALE

[illegible]


U.S. ARMY CORPS OF ENGINEERS		DESIGNED BY:		DATE:
ROCK ISLAND DISTRICT		CONTRACT NO.:	DRAWING NO.:	
ROCK ISLAND, ILLINOIS		PROJECT CODE:	SHEET NO.:	
		PILOT DATE:	PILOT SCALE:	
		FILE NAME:	SHEET SIZE:	
		ANSI D	EPP-100-000-000	

ILLINOIS WATERWAY  
LAGRANGE POOL  
FULTON COUNTY, IL  
RICE LAKE HABITAT REHAB & ENHANCEMENT  
STAGE I  
NATURAL  
SPILLWAY SECTIONS

Sheet  
ID  
C-304

c:\pwworking\mmt5ecad\153728\EP102C-320.dgn  
8/28/2018 3:14:17 PM  
BEDDLN

D

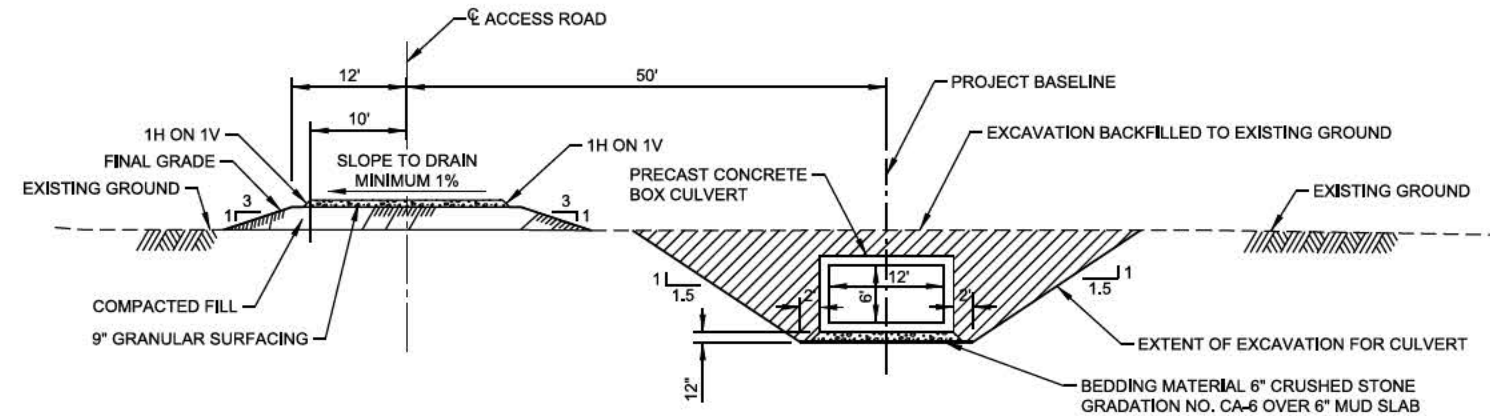


### BOX CULVERT AND PUMP STATION ACCESS ROAD

STA. 0+68.00 TO STA. 2+06.19

NO SCALE

C

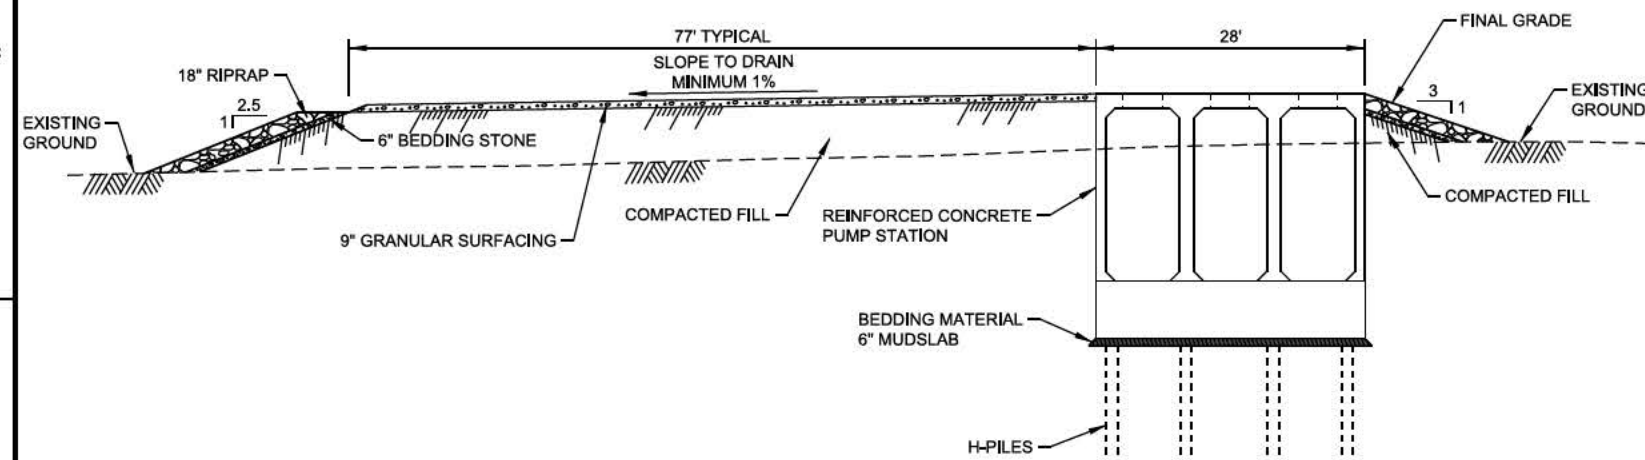


### PUMP STATION AND PUMP STATION PARKING AREA

STA. 2+18.48 TO STA. 2+52.19

NO SCALE

A

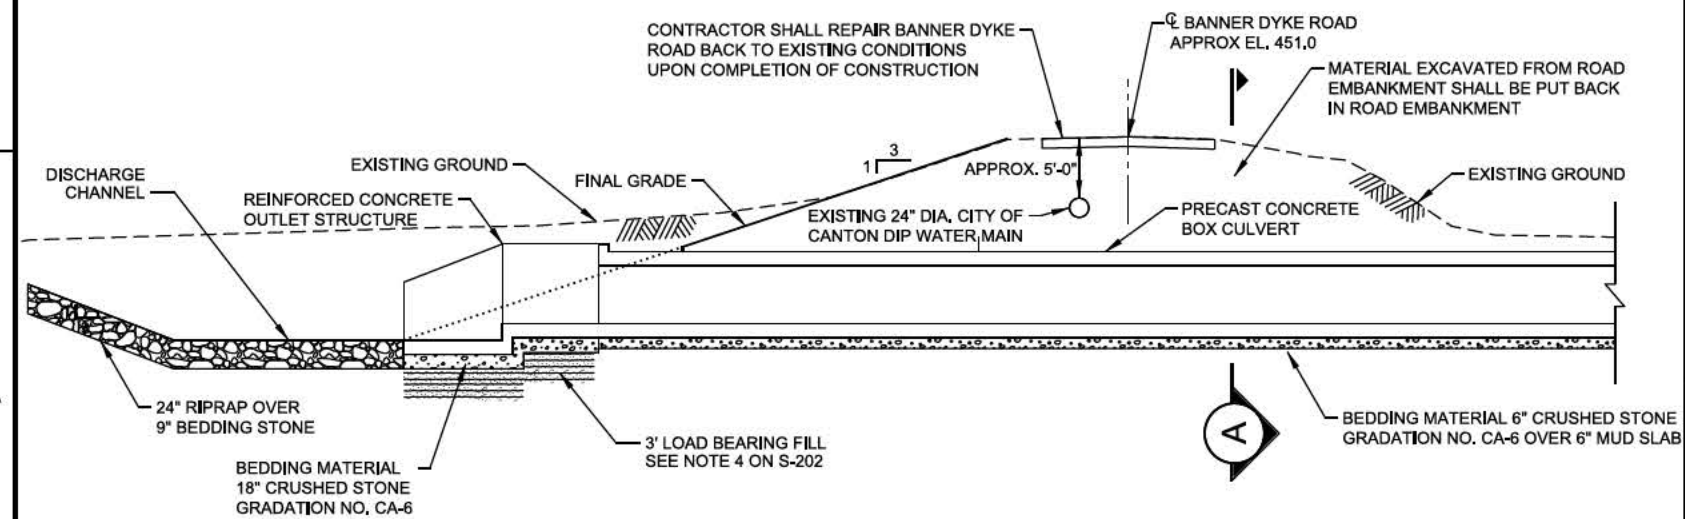


### BOX CULVERT PROFILE THROUGH BANNER DYKE ROAD EMBANKMENT

NO SCALE

### A BOX CULVERT THROUGH LEVEE EMBANKMENT

STA. -0+56.25 TO STA. 0+68.00

NO SCALE

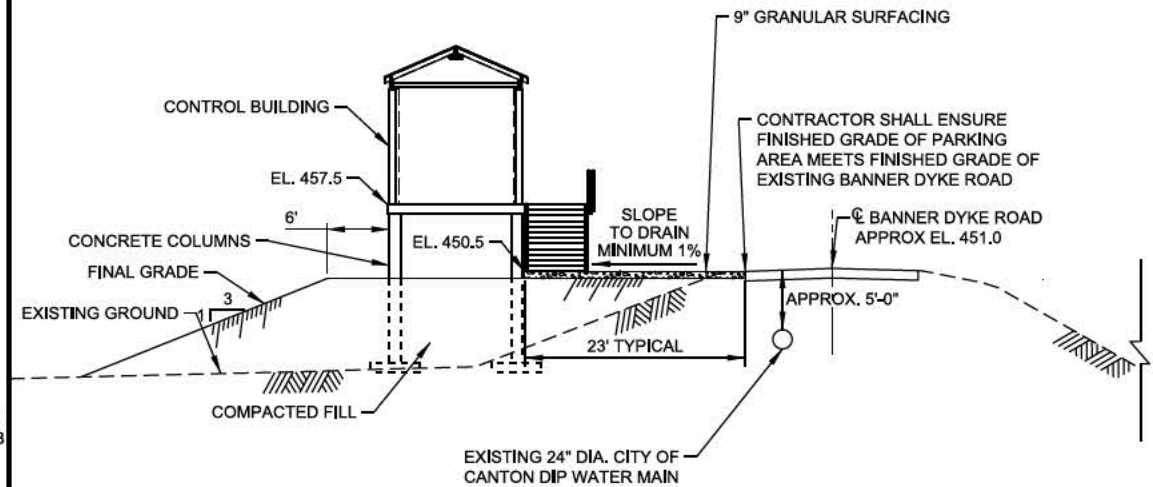

### CONTROL BUILDING PARKING AREA

NO SCALE



US Army Corps  
of Engineers

APPR.

DATE

DESCRIPTION

MARK

AS-BUILT AS OF 29 SEPTEMBER 2017

DATE

DESIGNED BY

OWN BY

CONTRACT NO.

PROJECT CODE

FILE NAME

AN# D

U.S. ARMY CORPS OF ENGINEERS

ROCK ISLAND DISTRICT

ROCK ISLAND, ILLINOIS

ILLINOIS WATERWAY

LAGRANGE, ILL.

RICE LAKE HABITAT REHAB. & ENHANCEMENT

STAGE I

PUMP STATION

TYPICAL SECTIONS


Sheet ID

C-320

AS-BUILT

A-42

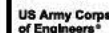

[illegible]


DESIGNED BY:	DATE:	SOLIDATION NO.:	
DWN BY:	10/10/30	W912EK1-R-0029	
LLH		CONTRACT NO.:	
PKW		W912EK1-C-0090	
SUBMITTED BY:		PROJECT CODE:	
HLA		EP102	
PLOT SCALE:		FILE NAME:	
AS SHOWN			
SIZE:			

U.S. ARMY CORPS OF ENGINEERS  
ROCK ISLAND DISTRICT  
ROCK ISLAND, ILLINOIS

ILLINOIS WATERWAY  
LAGRANGE POOL  
FULTON COUNTY, IL  
RICE LAKE HABITAT REHAB & ENHANCEMENT  
STAGE 1  
PUMP STATION  
CROSS SECTIONS  
SHEET 1 OF 4

Sheet  
ID  
C-321

AS-BUILT  
A-43

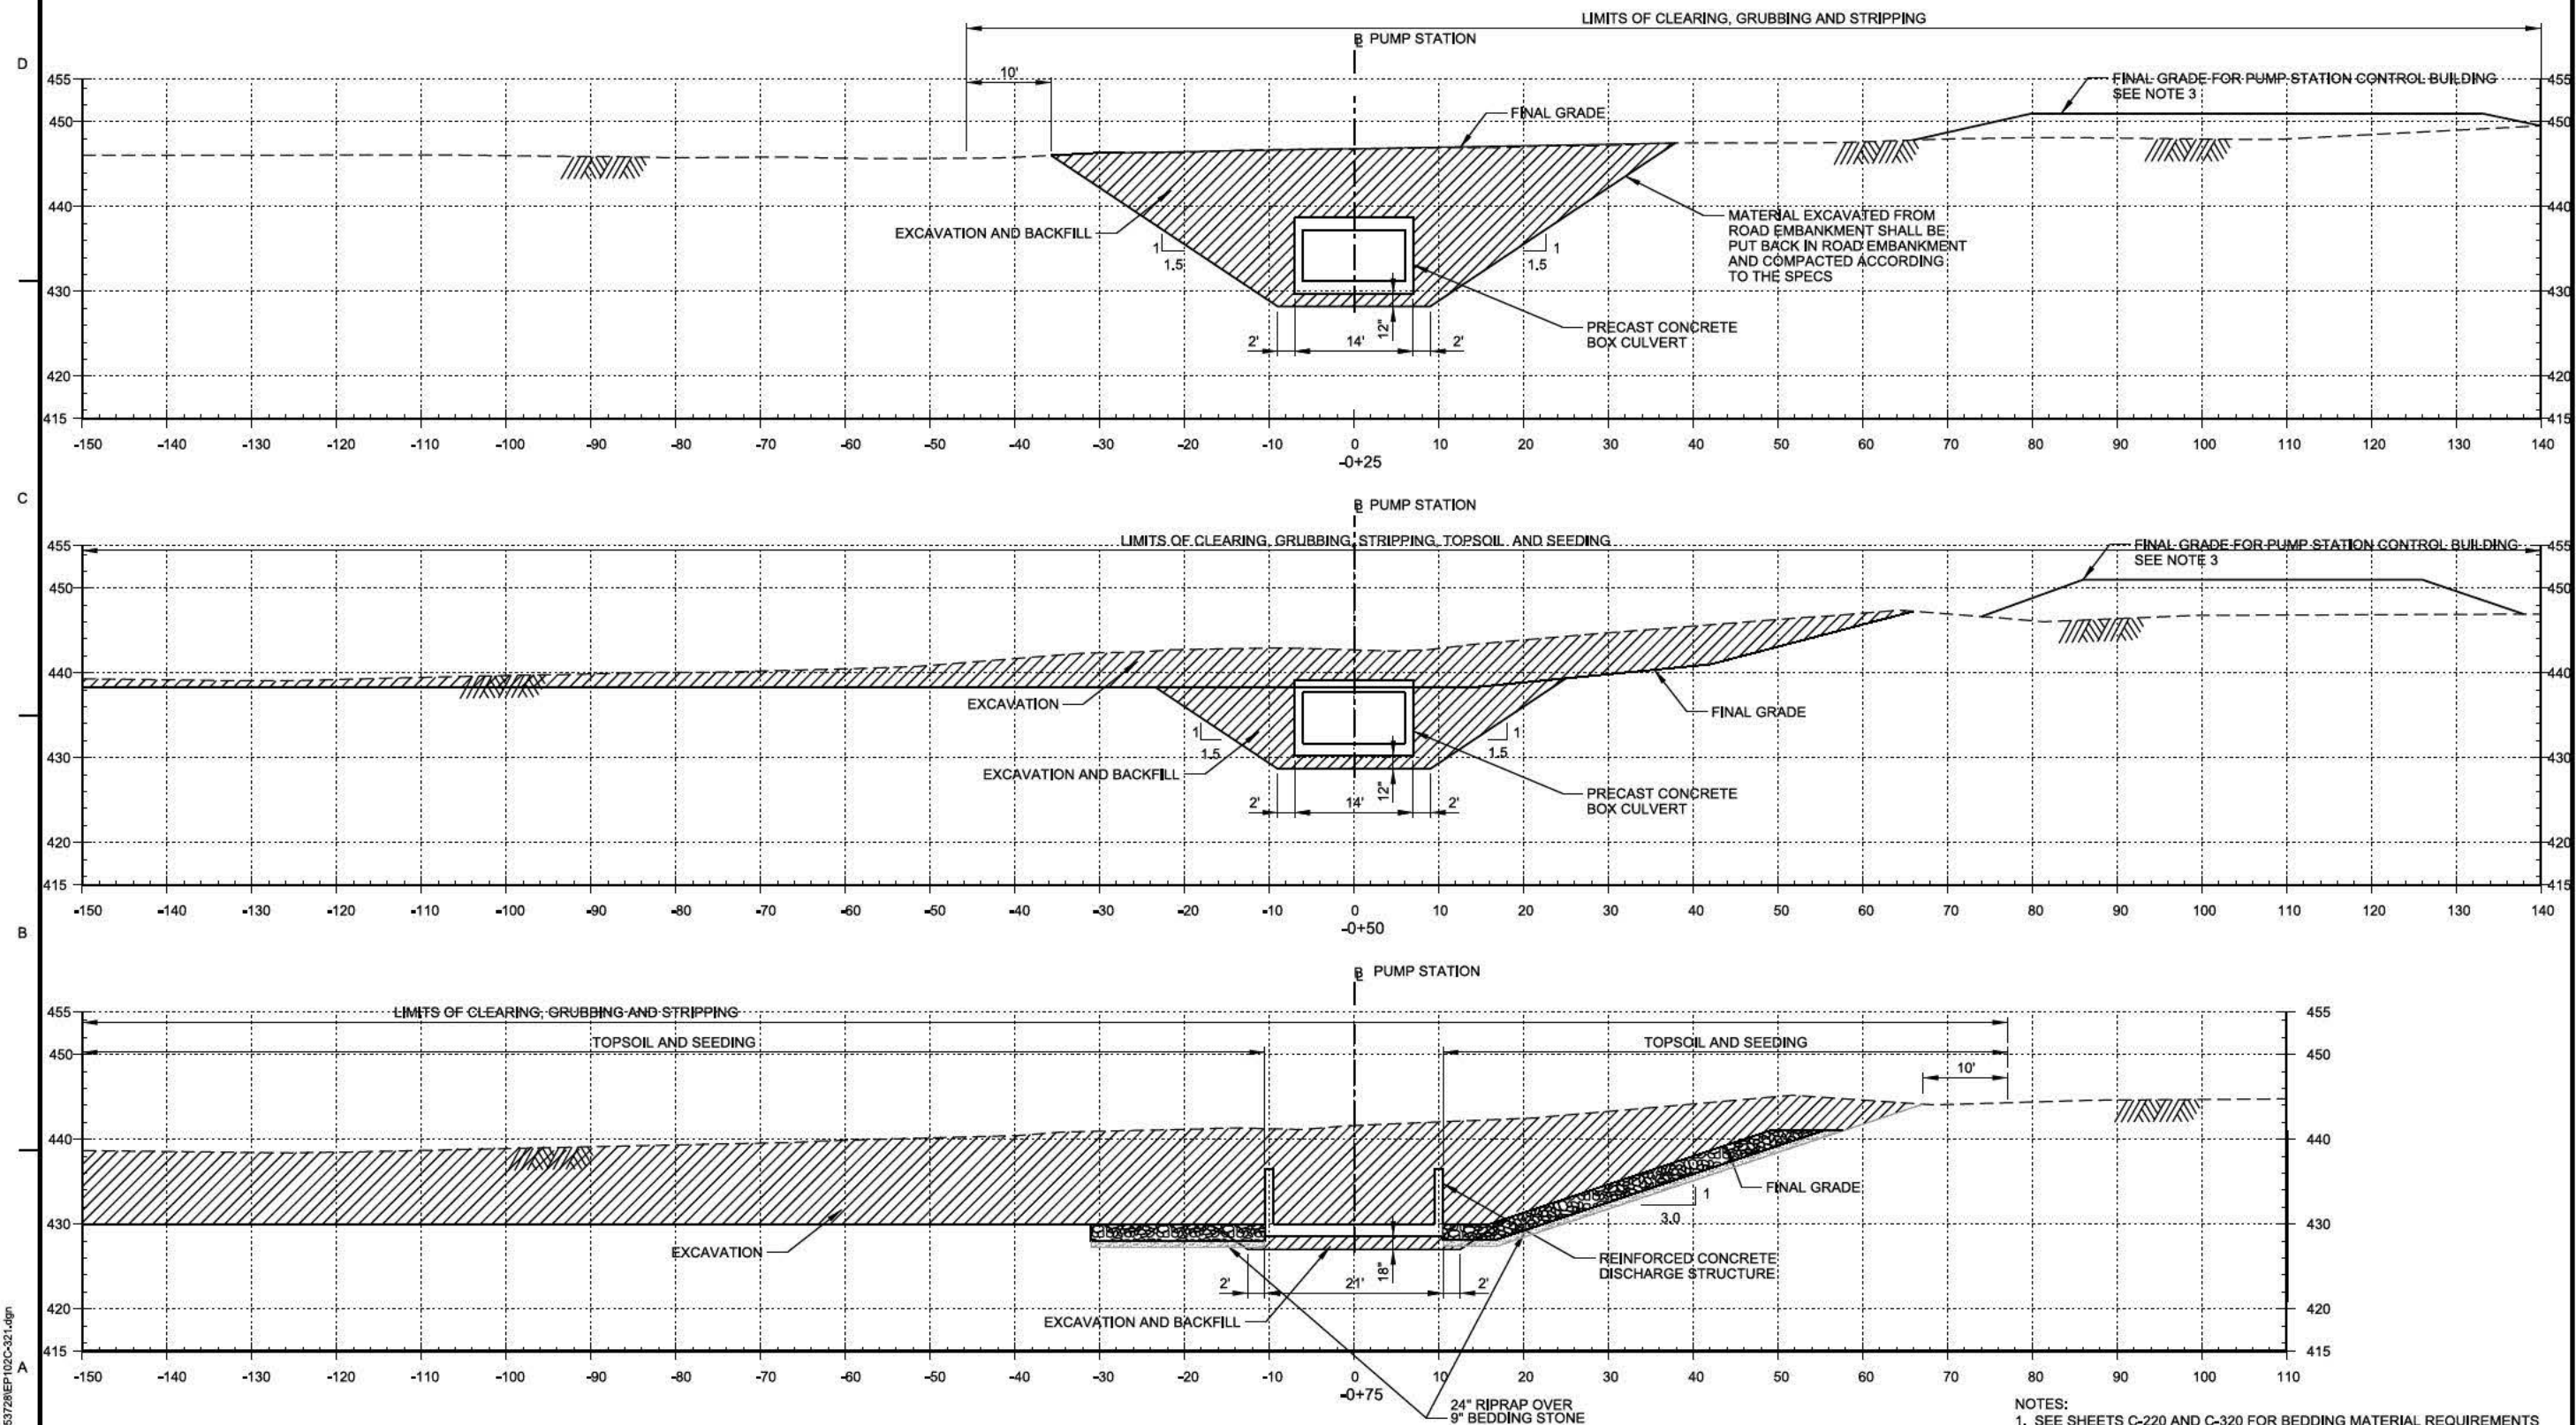

PUMP STATION CROSS SECTIONS SHEET 1 OF 4

NO SCALE

\\pw\_working\mvr\b5eddl\hd0153728\EP102C-321.dgn  
9/28/2018 3:14:21 PM A



**US Army Corps of Engineers**


[illegible]

U.S. ARMY CORPS OF ENGINEERS ROCK ISLAND DISTRICT ROCK ISLAND, ILLINOIS	DESIGNED BY: RCP	DATE: 2/17/0630
	DRAWN BY: LJH	DATE: 2/17/0630
	CHECK BY: P-W	CONTRACT NO.: W9126K-01-0-0020
	SUBMITTED BY: HJA	CONTRACT NO.: W9126K-01-0-0060
	SCALE:	PROJECT CODE: EP102
	PLOT SCALE: AS SHOWN	
	SIZE:	FILE NAME: EP102-022.dgn

ILLINOIS WATERWAY  
LAGRANGE POOL  
FULTON COUNTY, IL  
PRICE LAKE HABITAT REHAB & ENHANCEMENT  
STAGE 1  
PUMP STATION  
CROSS SECTIONS  
SHEET 2 OF 4

Sheet  
ID  
C-322

AS-BUILT  
A-44

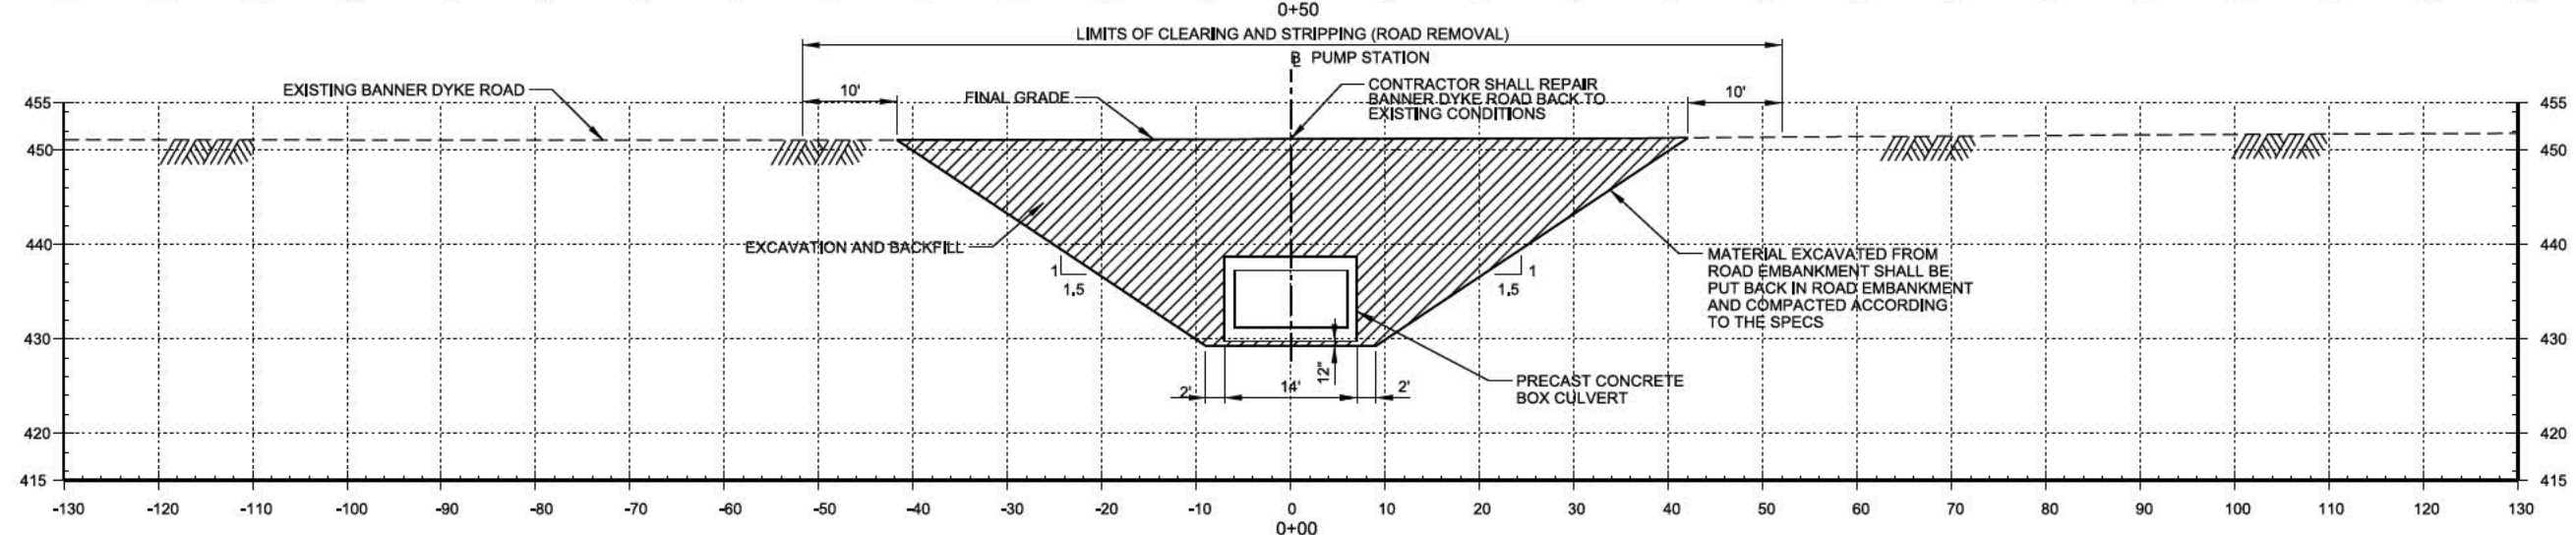

1. SEE SHEETS C-220 AND C-320 FOR BEDDING MATERIAL REQUIREMENTS.
2. SEE SHEET C-320 FOR PUMP STATION ACCESS ROAD REQUIREMENTS.

PUMP STATION CROSS SECTIONS SHEET 2 OF 4

NO SCALE

c:\pw\_working\mvr\b5edd\hd0153728\EP102C-322.dgn  
8/28/2018 3:14:25 PM A



[illegible]




DESIGNED BY:	DATE:
DWN BY:	SOLIDATION NO.:
LLH	W912EK1-L-0029
SUBMITTED BY:	CONTRACT NO.:
-HLA	W912EK1-L-0090
PLOT SCALE:	PROJECT CODE:
AS SHOWN	EP102
SIZE:	FILE NAME:

U.S. ARMY CORPS OF ENGINEERS  
ROCK ISLAND DISTRICT  
ROCK ISLAND, ILLINOIS

ILLINOIS WATERWAY  
LAGRANGE POOL  
FULTON COUNTY, IL  
RICE LAKE HABITAT REHAB & ENHANCEMENT  
STAGE I  
PUMP STATION  
CROSS SECTIONS  
SHEET 3 OF 4

Sheet  
ID  
C-323

AS-BUILT  
A-45

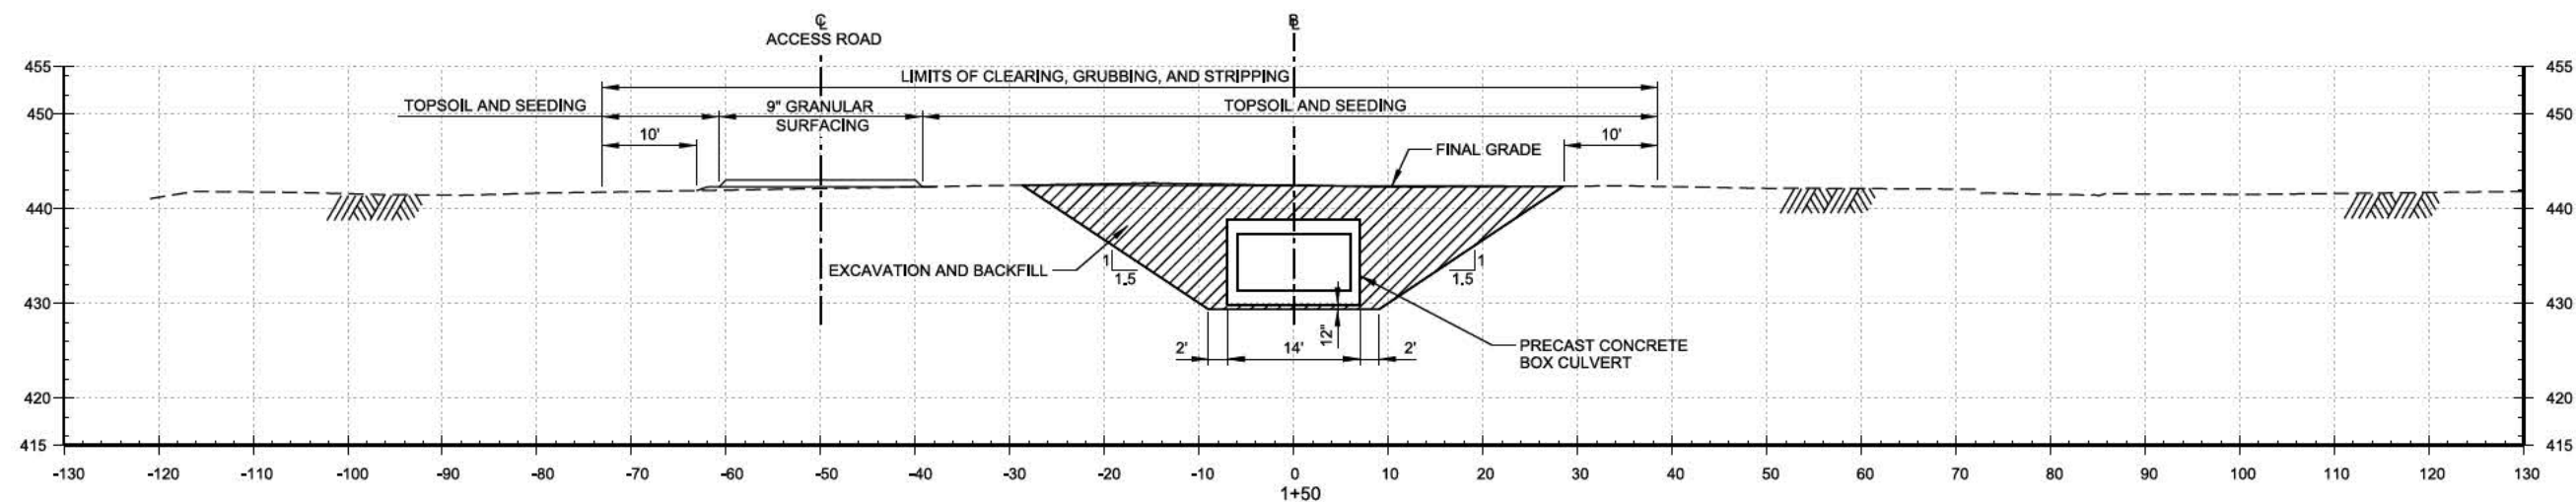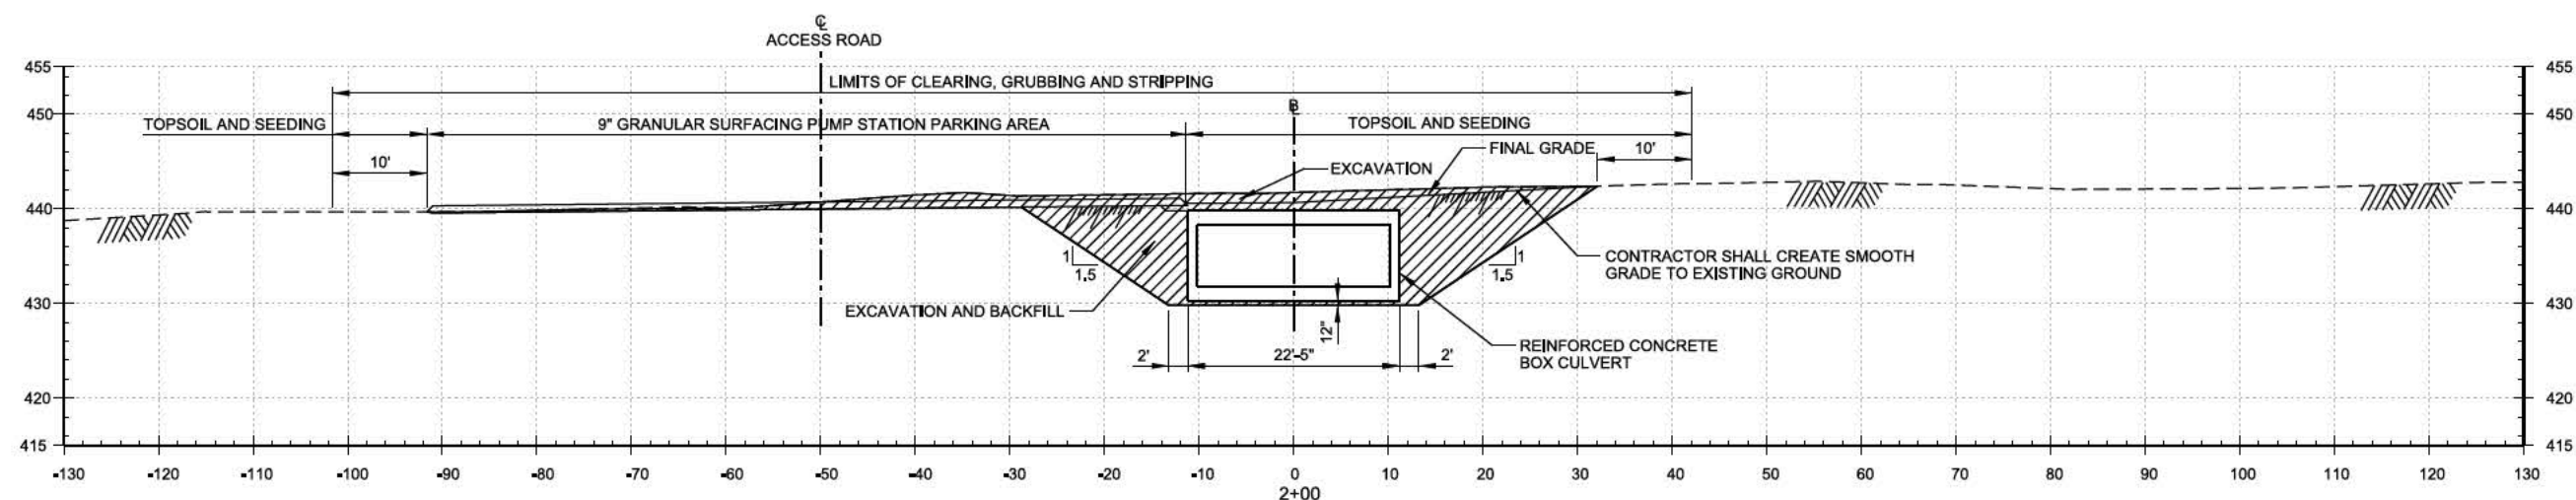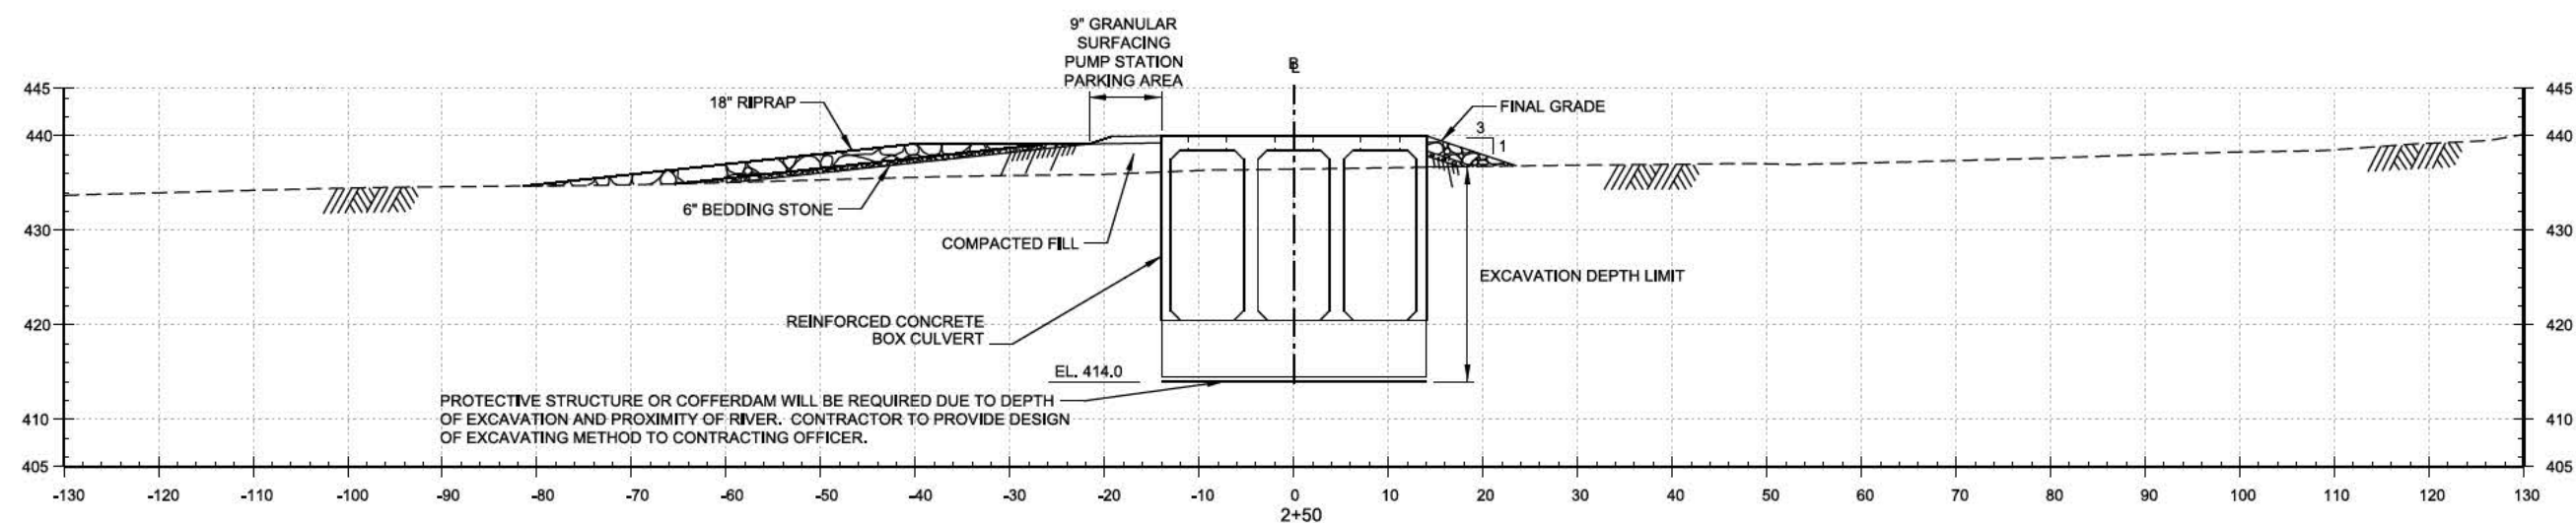

NOTES:

1. SEE SHEETS C-220 AND C-320 FOR BEDDING MATERIAL REQUIREMENTS.
2. SEE SHEET C-320 FOR PUMP STATION ACCESS ROAD AND PARKING AREA REQUIREMENTS.


PUMP STATION CROSS SECTIONS SHEET 3 OF 4

NO SCALE

c:\pw\_working\mvr\b5edd\hid0153728\EP102C-323.dgn  
8/28/2016 3:14:37 PM

c:\pwworking\mmt5\cadd\103728\EP102C-324.dgn  
8/28/2018 3:14:41 PM  
BEDDLIN

A  
B  
C  
D

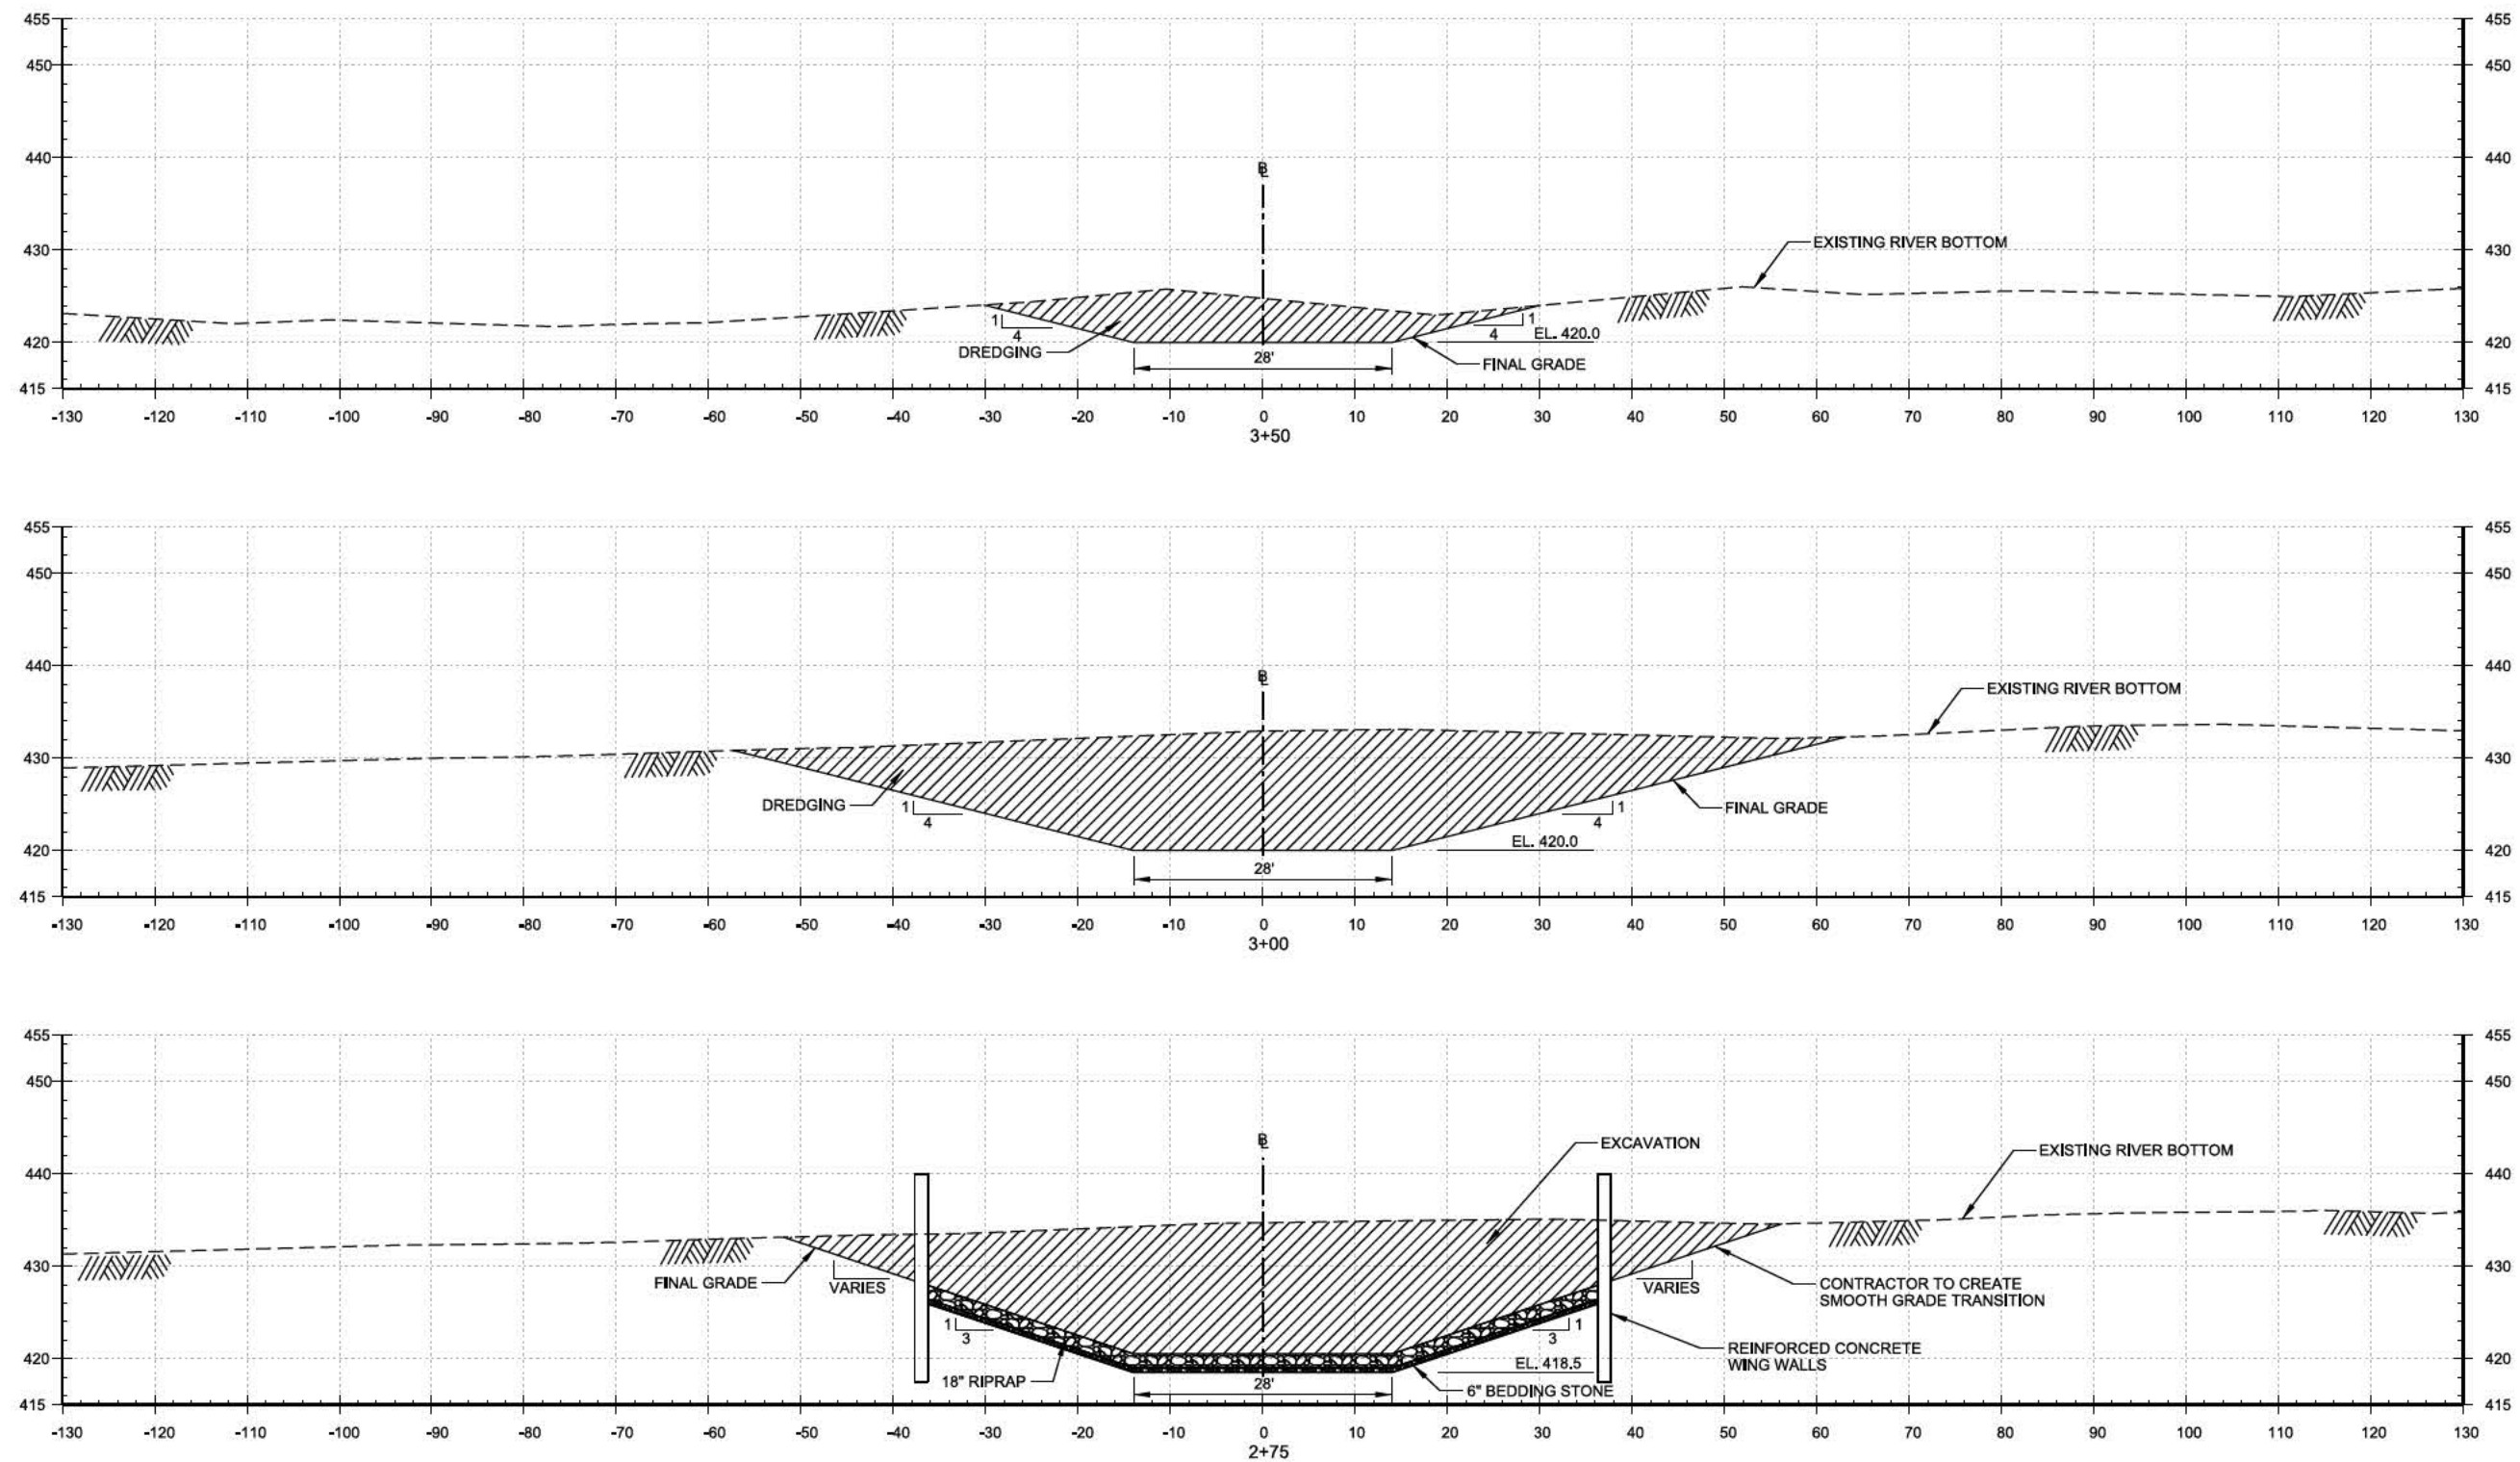

NOTES:

1. SEE SHEET C-420 FOR RIPRAP AND BEDDING MATERIAL REQUIREMENTS.
2. LOCAL FLAT POOL IS EL. 429. LOCAL NORMAL POOL IS EL. 434.5.

PUMP STATION CROSS SECTIONS SHEET 4 OF 4

NO SCALE



US Army Corps  
of Engineers

DATE	DESCRIPTION
AS-BUILT AS OF 29 SEPTEMBER 2017	


DESIGNED BY: RCP	DATE: 26-10-2016	SOLICITATION NO.:
DWN BY: CVA	CONTRACT NO.:	
SUBMITTED BY: H.A.	PROJECT CODE:	
PLT SCALE:	PLT DATE:	
AS SHOWN	FILE NAME:	
SIZE:	AN3 D	

ILLINOIS WATERWAY LAGRANGE POOL FLORANCE HILL RICE LAKE HABITAT REPAIR & ENHANCEMENT STAGE I	U.S. ARMY CORPS OF ENGINEERS ROCK ISLAND DISTRICT ROCK ISLAND, ILLINOIS
--	---

Sheet  
ID  
C-324

AS-BUILT  
A-46



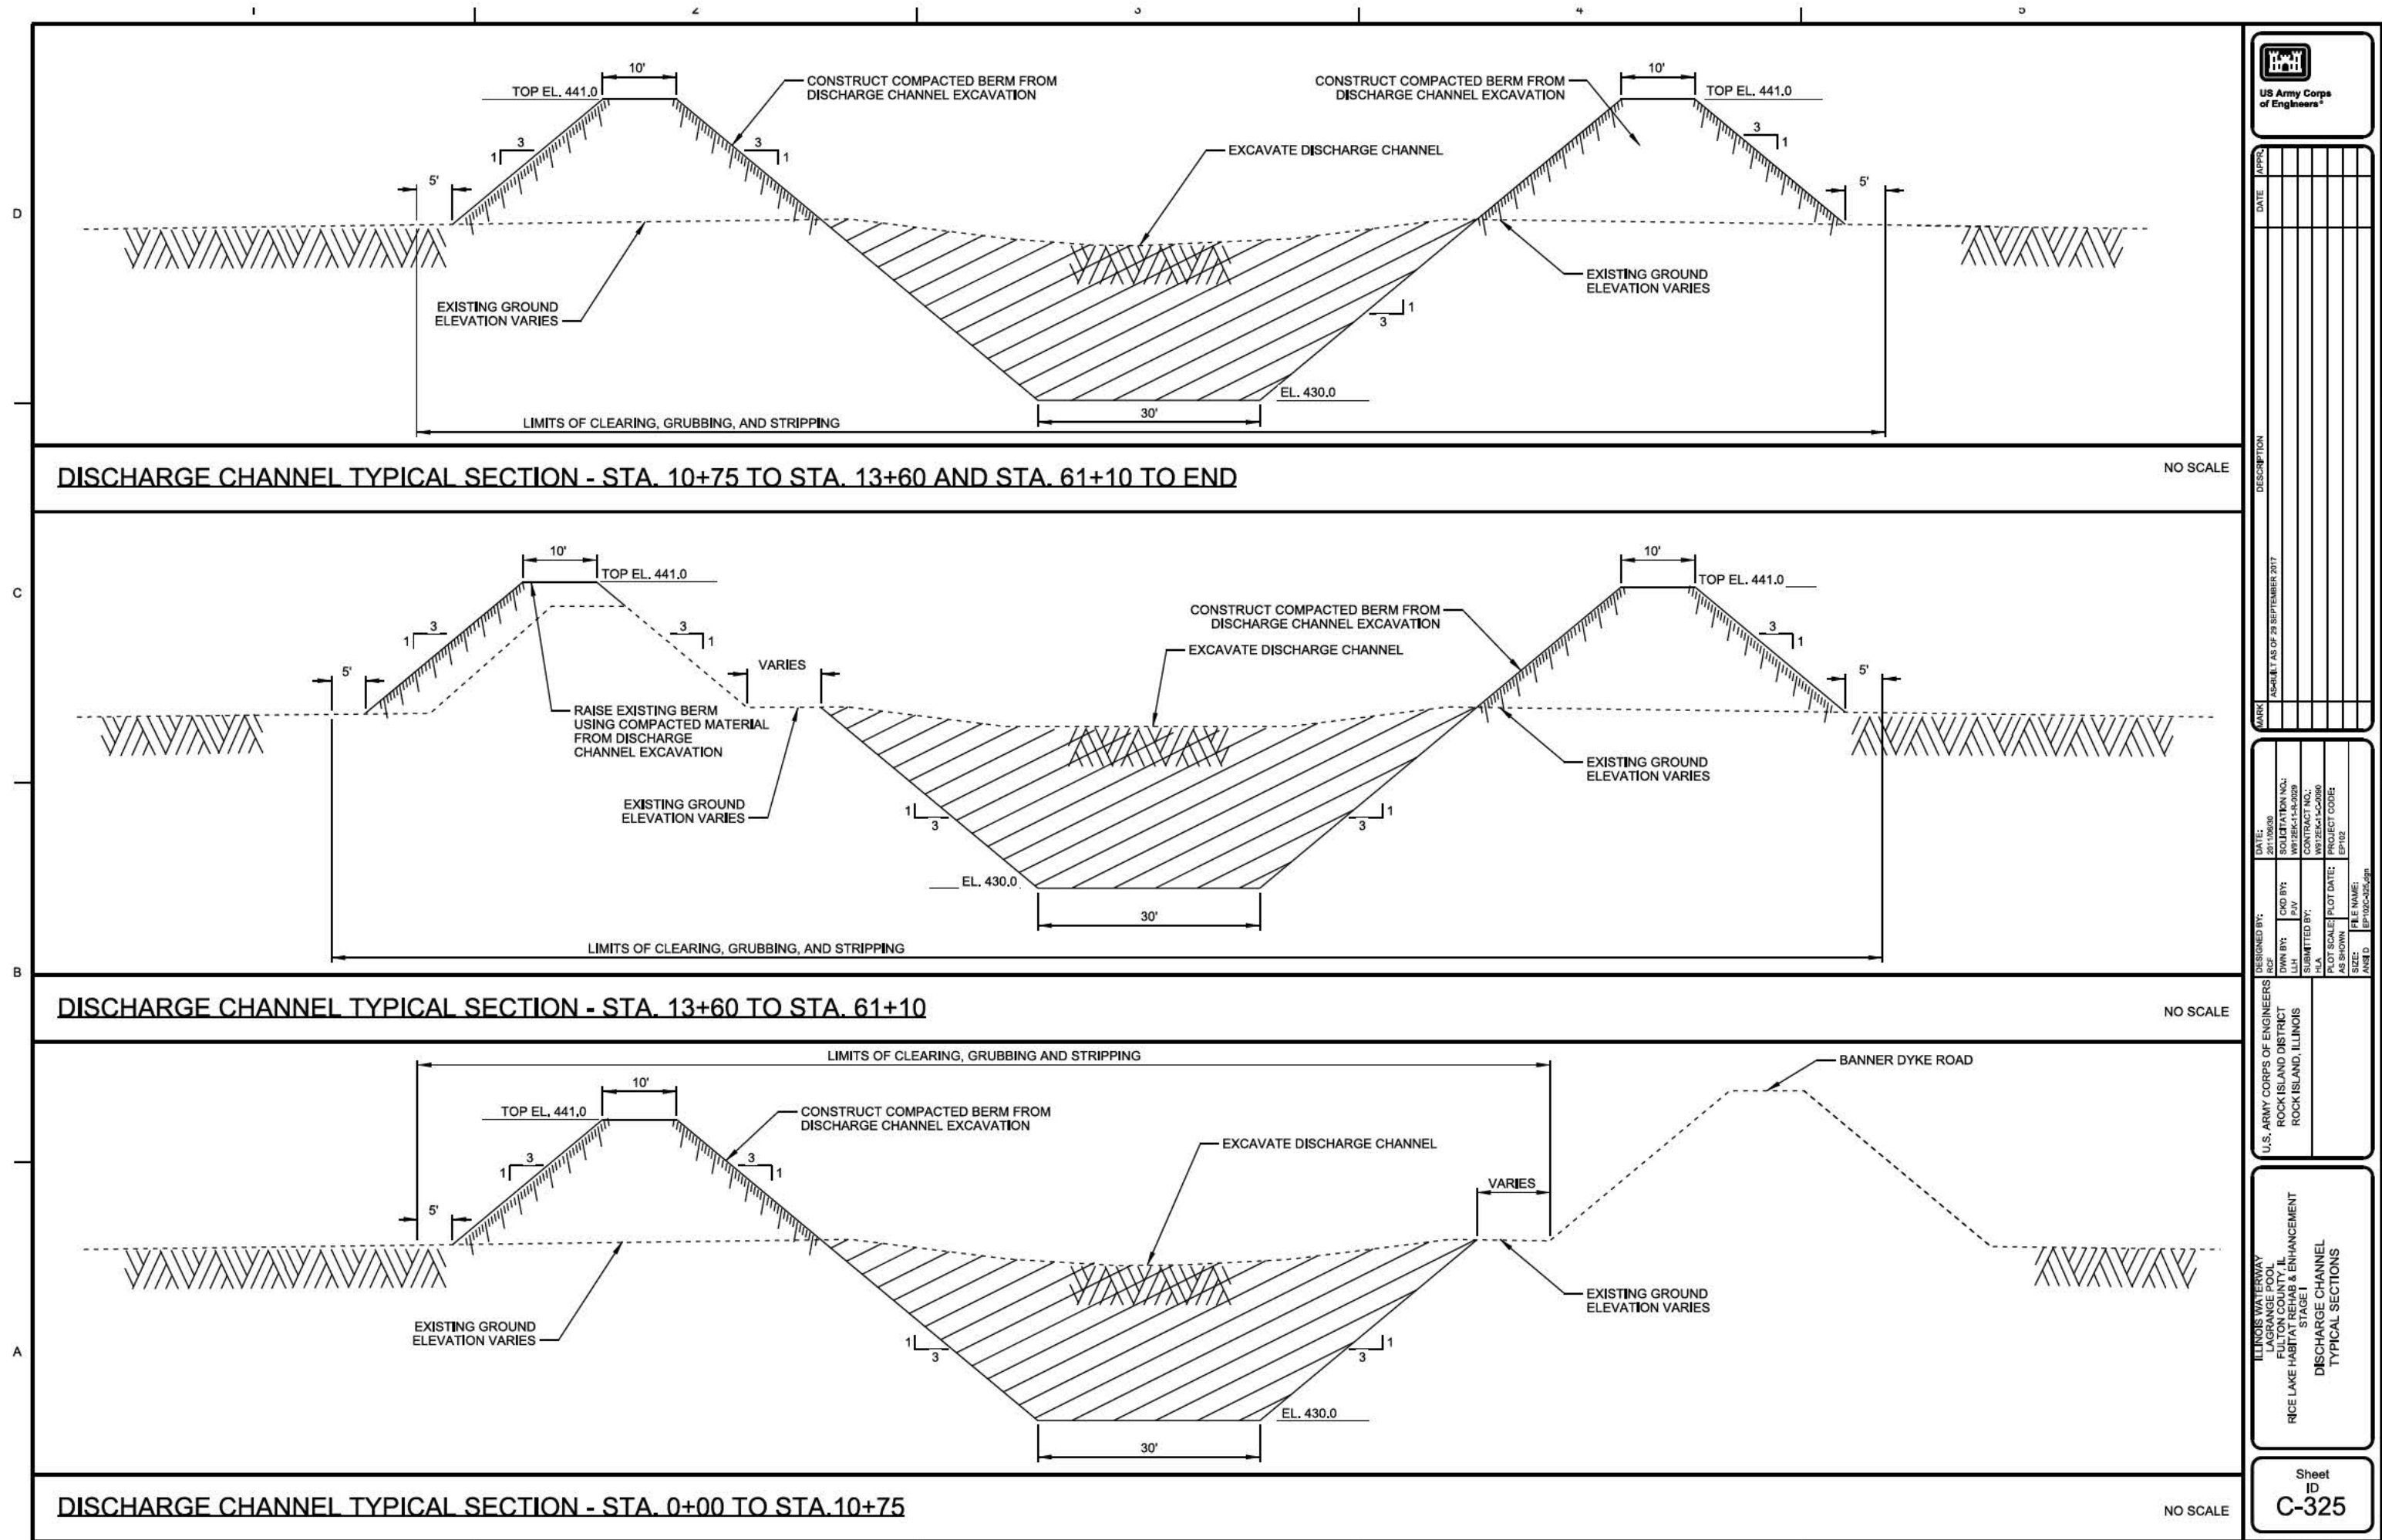

US Army Corps of Engineers

APPR.	DATE	DESCRIPTION
AS-BUILT	AS OF 29 SEPTEMBER 2017	

DESIGNED BY:	DATE:	SOLICITATION NO.:
OWN BY:	20110626	274
SUBMITTED BY:	CONTRACT NO.:	W0325K4-1-2006
AS SHOWN	PROJECT CODE:	EP102
FILE NAME:	FILE D:	EP102C325.dgn

U.S. ARMY CORPS OF ENGINEERS  
ROCK ISLAND DISTRICT  
ROCK ISLAND, ILLINOIS

ILLINOIS WATERWAY  
LA GRANGE POOL  
FLOOD CONTROL  
RICE LAKE HABITAT REHAB & ENHANCEMENT  
STAGE I  
DISCHARGE CHANNEL  
TYPICAL SECTIONS

Sheet ID  
**C-325**

AS-BUILT  
**A-47**










[illegible]

DESIGNED BY:	DATE:
DWN BY:	SOLIDATION NO.:
LLH	W912EK1-L-0029
SUBMITTED BY:	CONTRACT NO.:
HLA	W912EK1-L-0090
PLOT SCALE:	PROJECT CODE:
AS SHOWN	EP102
SIZE:	FILE NAME:

ILLINOIS WATERWAY  
LAGRANGE POOL  
FULTON COUNTY, IL  
PRICE LAKE HABITAT REHAB & ENHANCEMENT  
STAGE I  
DISCHARGE CHANNEL  
CROSS SECTIONS  
SHEET 1 OF 6

Sheet  
ID  
C-326

AS-BUILT  
A-48

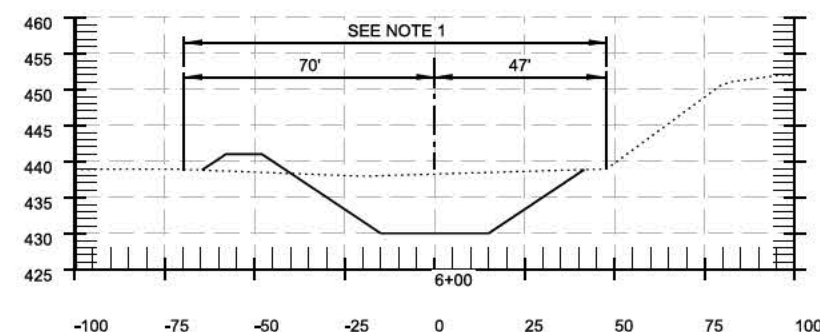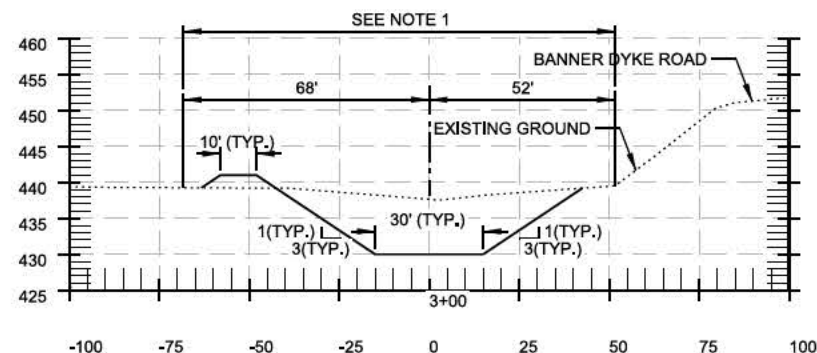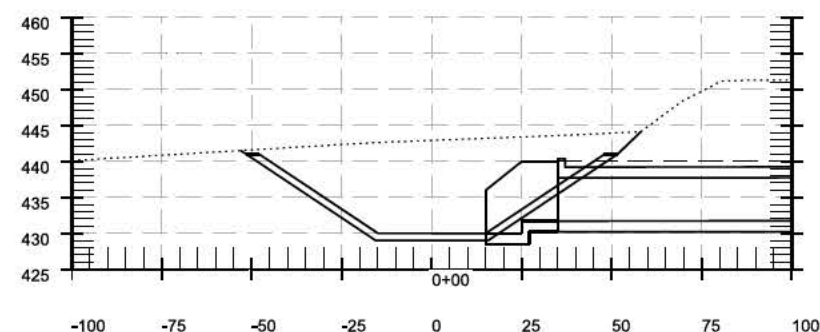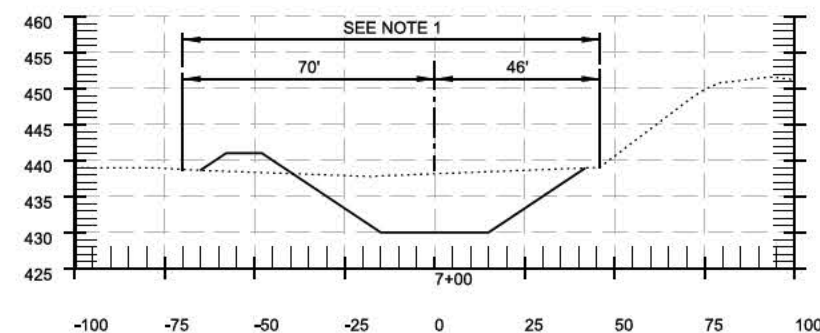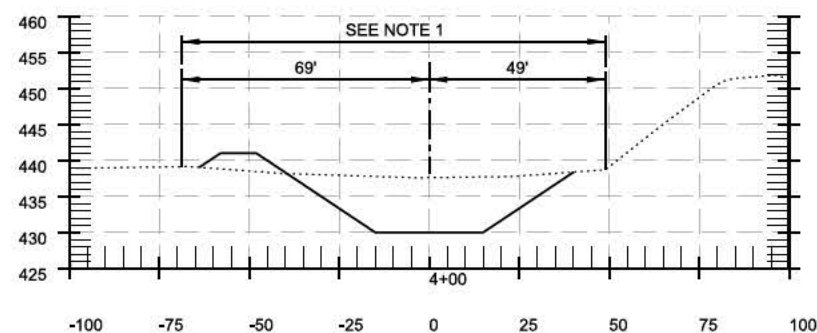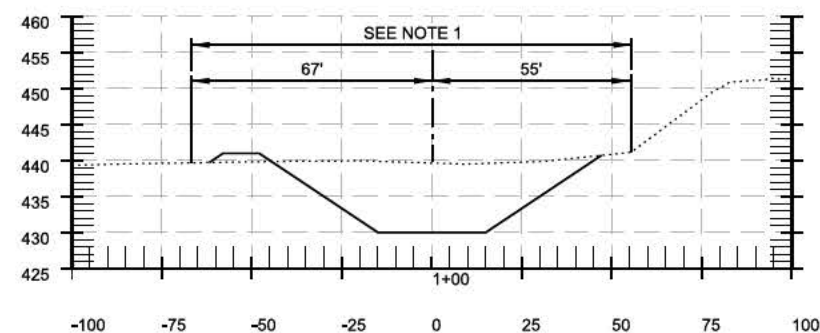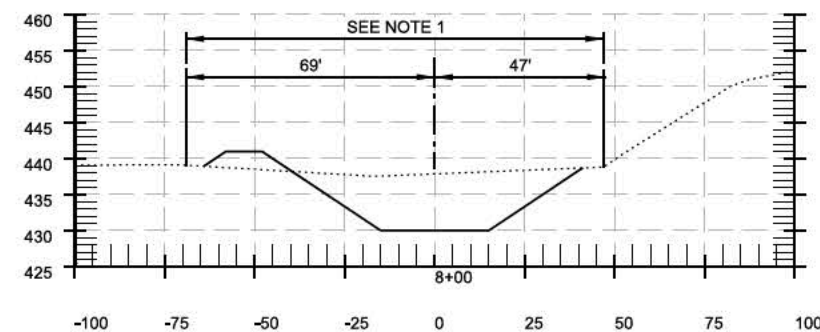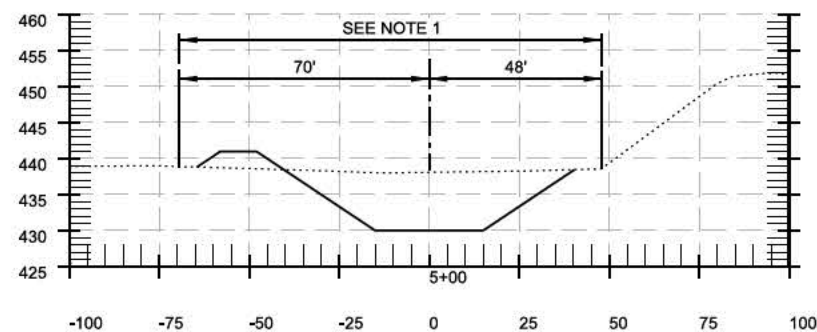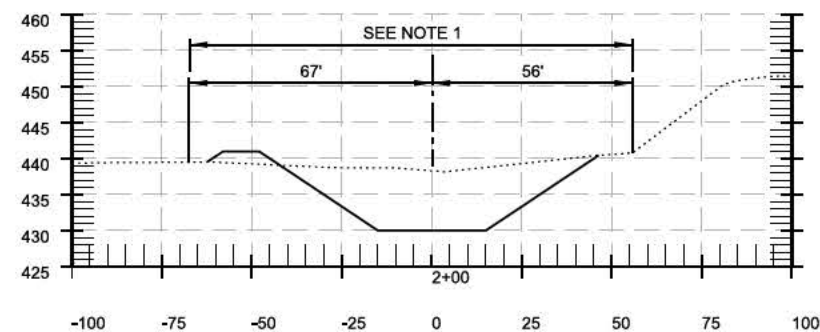

NOTE:

1. LIMITS OF CLEARING, GRUBBING AND STRIPPING.

## DISCHARGE CHANNEL CROSS SECTIONS

NO SCALE





DATE	DESCRIPTION
26-1-2020	AS-BUILT AS OF 29 SEPTEMBER 2017


DESIGNED BY: RCP	DATE: 26-1-2020	SOLICITATION NO.: W0325K1-1-2018
DWN BY: RCP	CHK BY: RCP	CONTRACT NO.: W0325K1-1-2018
SUBMITTED BY: RCP	FILE NAME: EP102	PROJECT CODE: EP102
PLT SCALE: AS SHOWN	PLT DATE: 26-1-2020	FILE D: EP102C327.dgn

ILLINOIS WATERWAY  
LAGRANGE POOL  
FLATWOOD DISTRICT  
RICE LAKE HABITAT REHAB & ENHANCEMENT  
STAGE I  
DISCHARGE CHANNEL  
CROSS SECTIONS  
SHEET 2 OF 6



Sheet  
ID  
C-327

AS-BUILT  
A-49


D

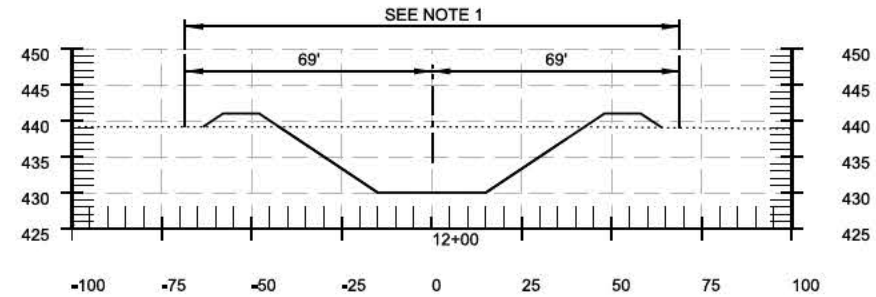









C

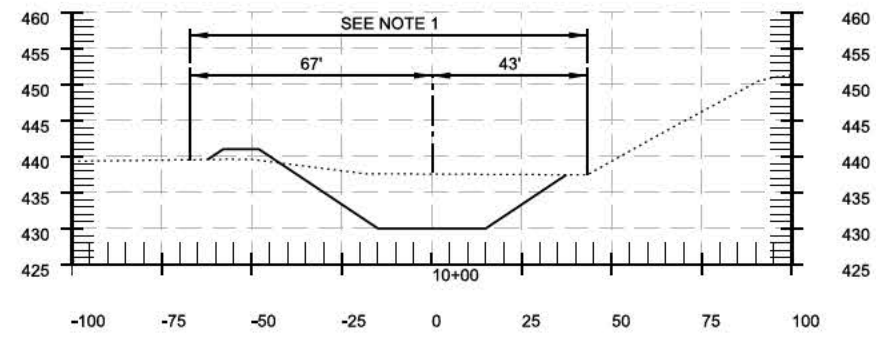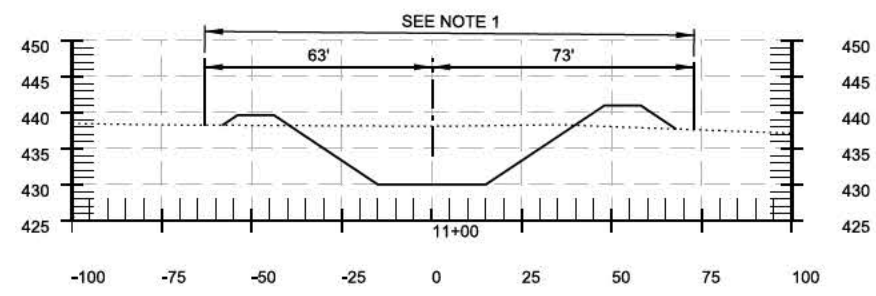

B

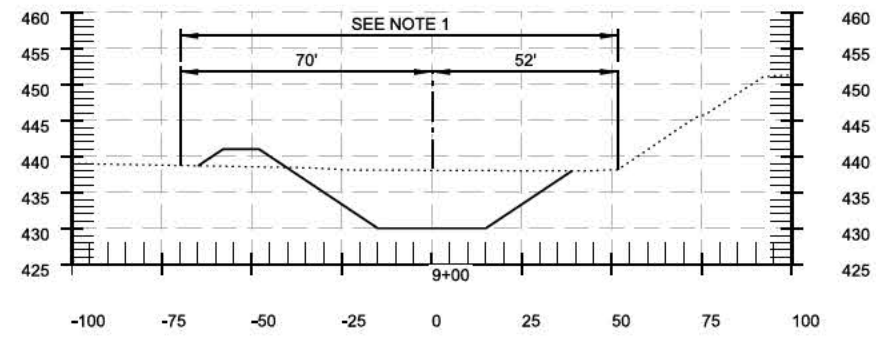

A

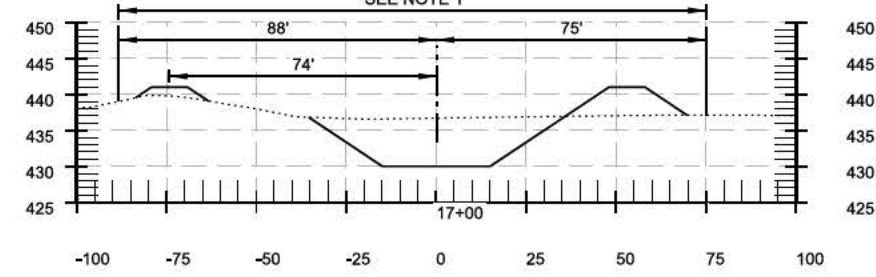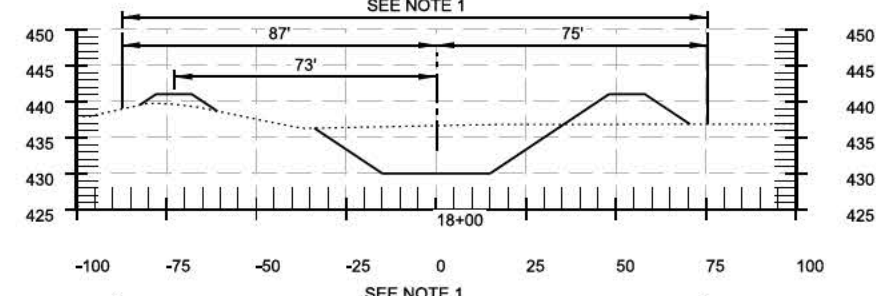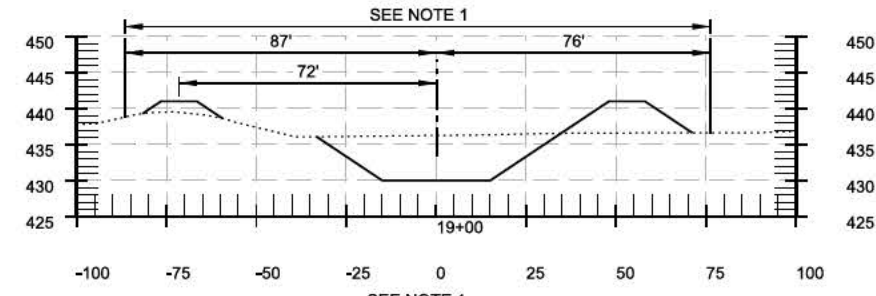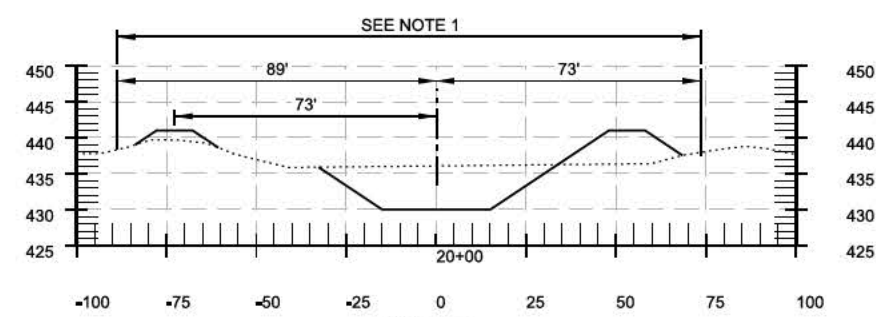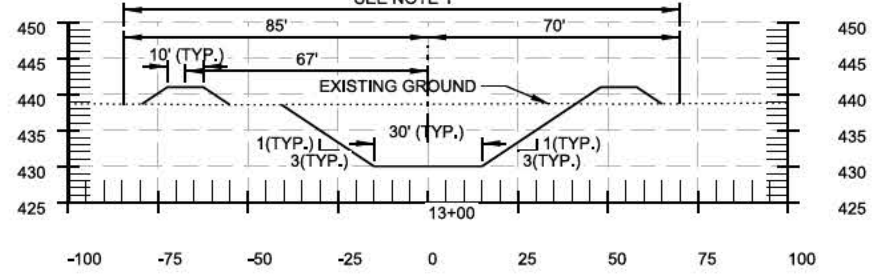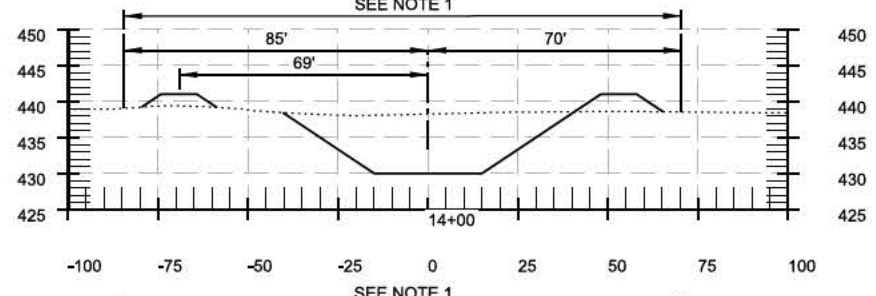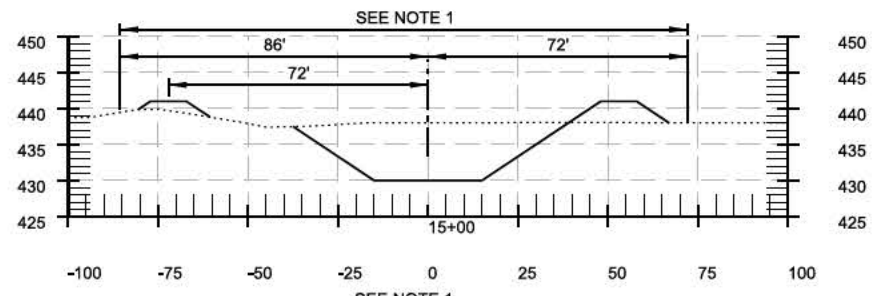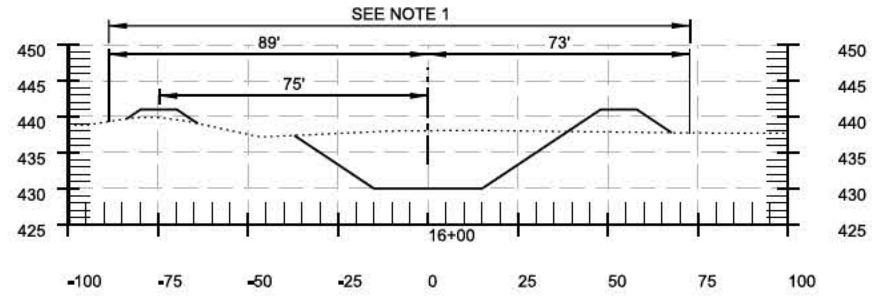

NOTE:  
1. LIMITS OF CLEARING, GRUBBING  
AND STRIPPING.

# DISCHARGE CHANNEL CROSS SECTIONS













NO SCALE

D

C

B

A

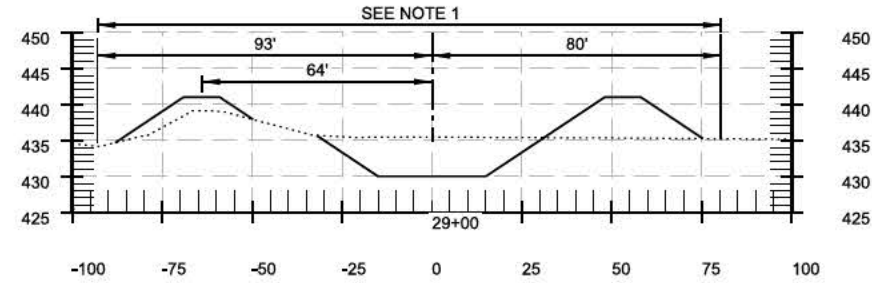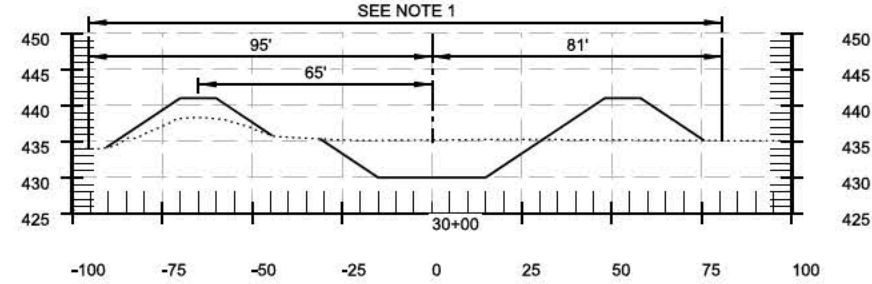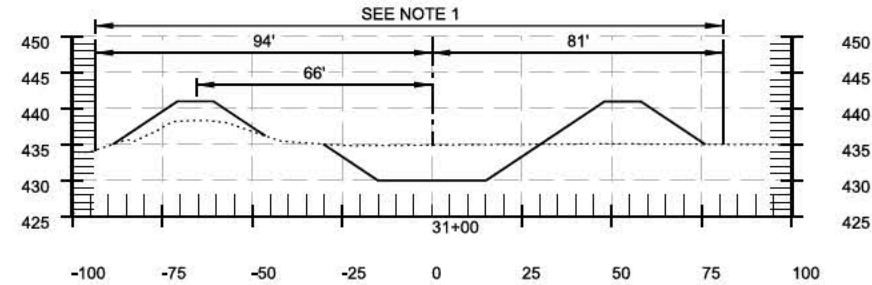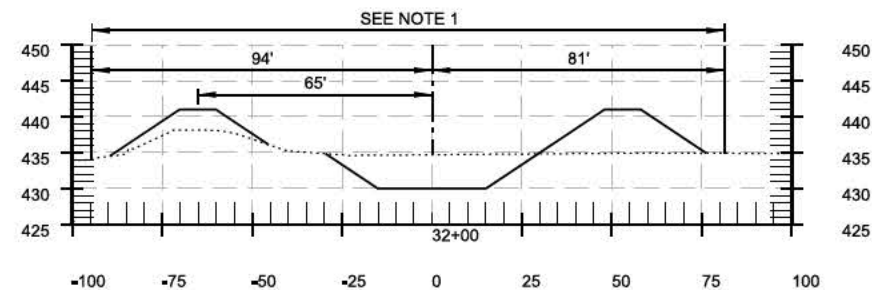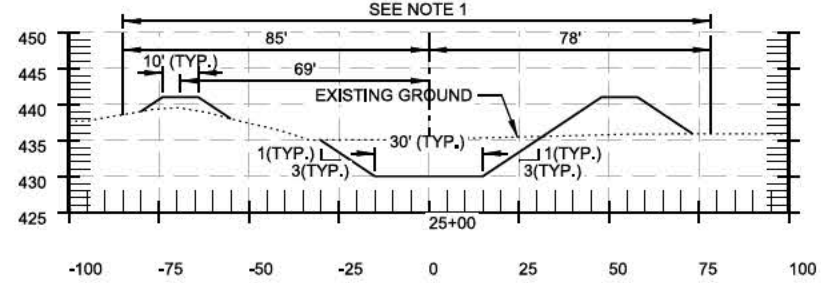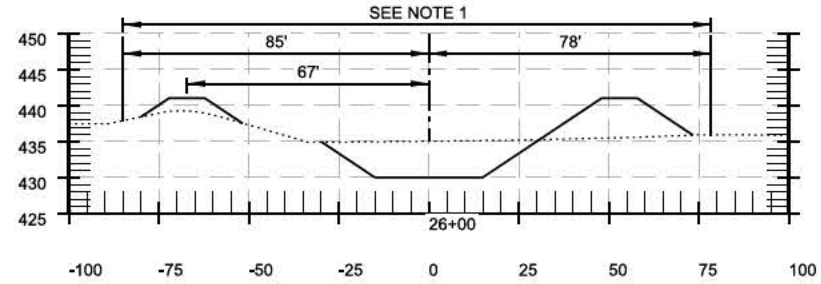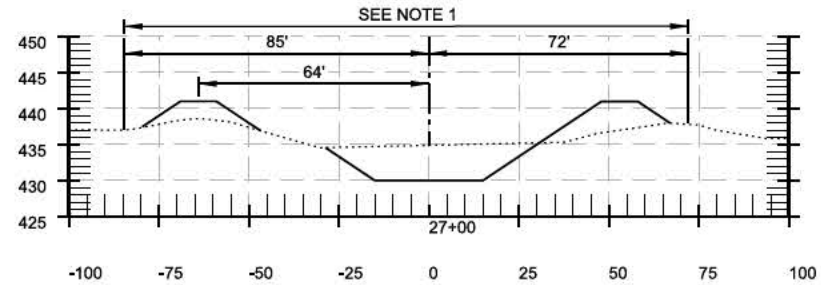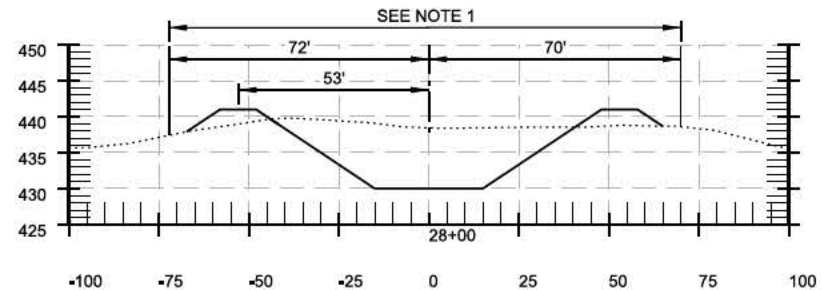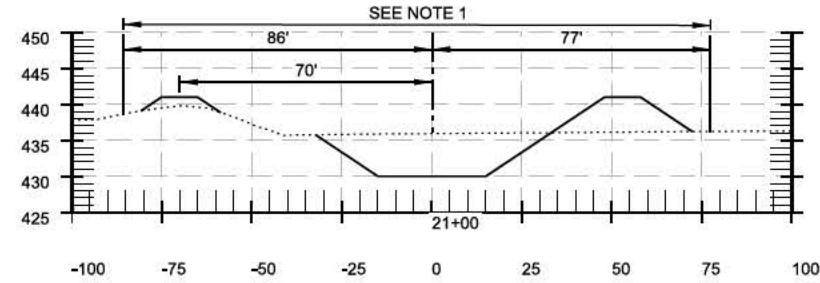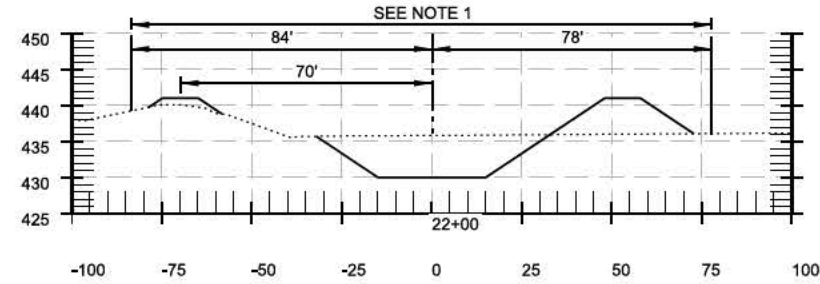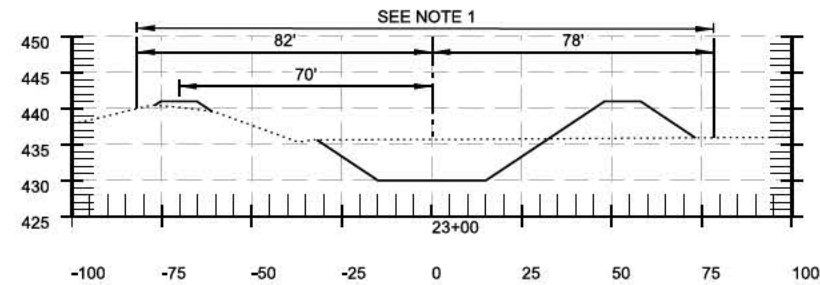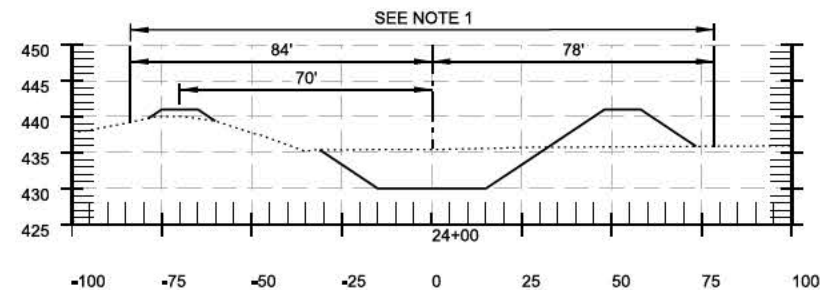

NOTE:  
1. LIMITS OF CLEARING, GRUBBING,  
AND STRIPPING.

# DISCHARGE CHANNEL CROSS SECTIONS

NO SCALE

US Army Corps of Engineers

DATE	26-10-2016
APPR.	
DESCRIPTION	AS-BUILT AS OF 29 SEPTEMBER 2017
MARK	

DESIGNED BY: RCP	CHECKED BY: JVA	DATE: 26-10-2016
DRAWN BY: JVA	CONTRACT NO: W92354-1-0000	SOLICITATION NO: EP102
SUBMITTED BY: JVA	PROJECT CODE: EP102	FILE NAME: EP102C325.dgn
AS SHOWN	AS SHOWN	AS SHOWN

U.S. ARMY CORPS OF ENGINEERS  
ROCK ISLAND DISTRICT  
ROCK ISLAND, ILLINOIS

ILLINOIS WATERWAY  
LAGRANGE POOL  
FLUOROCARBON  
RICE LAKE HABITAT REHAB & ENHANCEMENT  
STAGE I  
DISCHARGE CHANNEL  
CROSS SECTIONS  
SHEET 3 OF 6

Sheet ID  
C-328

AS-BUILT  
A-50















D

C

B

A

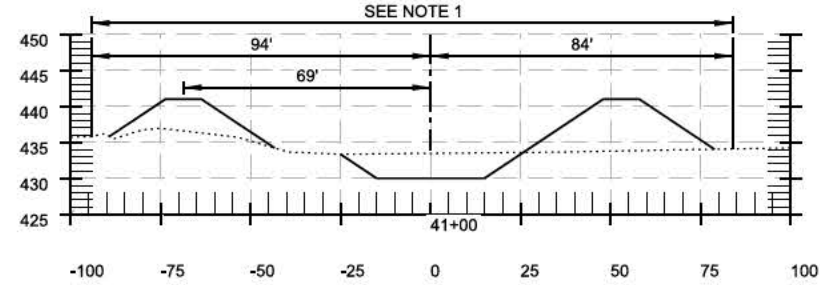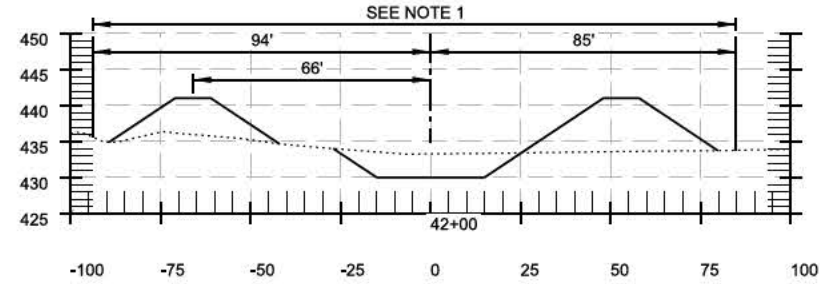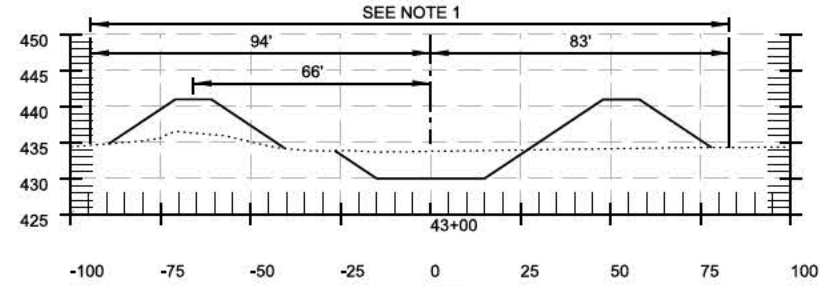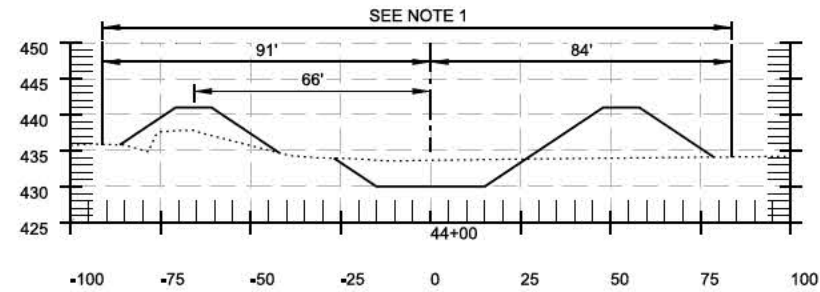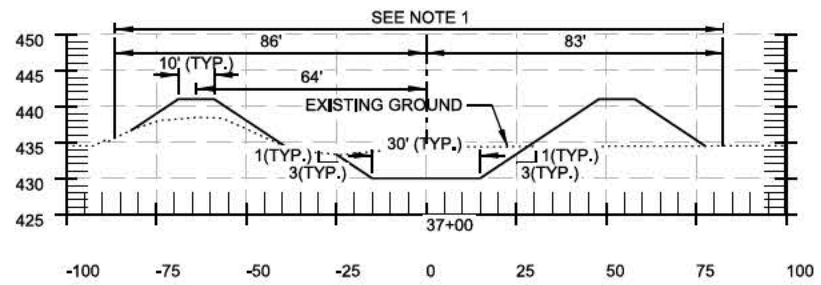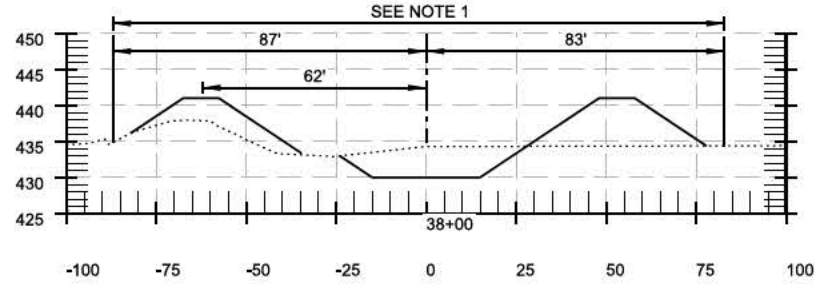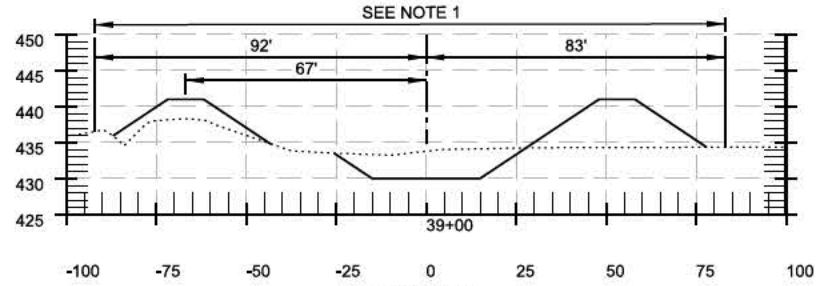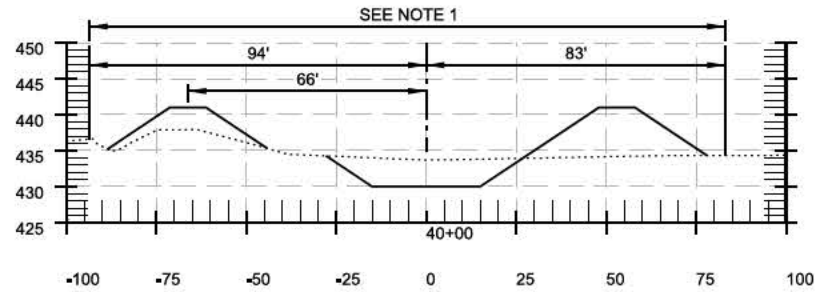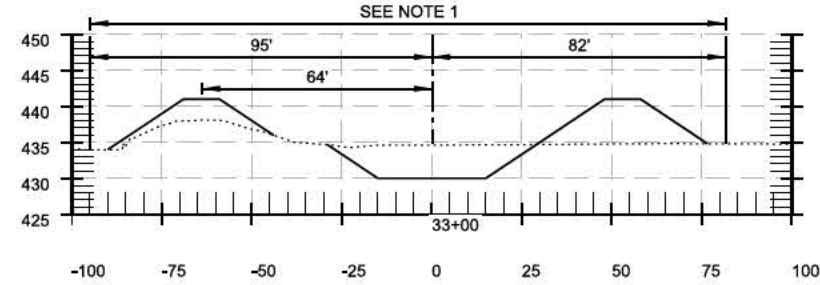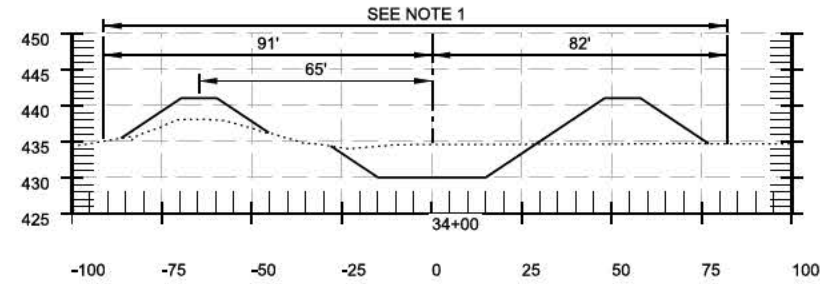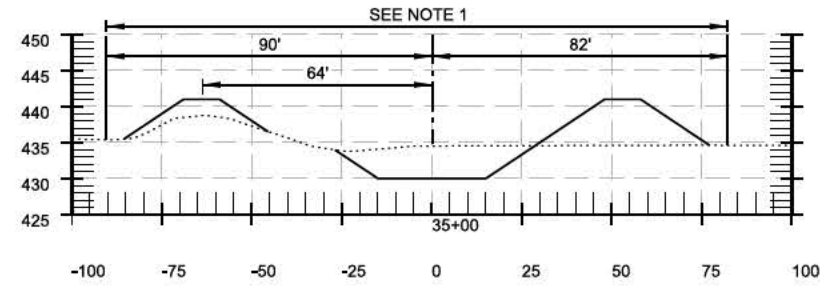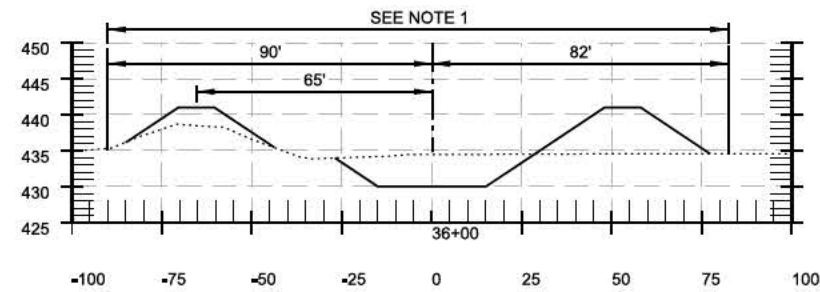

NOTE:  
1. LIMITS OF CLEARING, GRUBBING,  
AND STRIPPING.

DISCHARGE CHANNEL CROSS SECTIONS

NO SCALE



DATE	DESCRIPTION
26/1/2020	AS-BUILT AS OF 29 SEPTEMBER 2017

DESIGNED BY: RCP	DATE: 26/1/2020	SOLICITATION NO.:
DRAWN BY: RCP	CHD BY: RCP	CONTRACT NO.:
SUBMITTED BY: RCP	FILE NAME: EP102	PROJECT CODE:
FILE NO.:	FILE NAME:	FILE NO.:

ILLINOIS WATERWAY  
ENRICHMENT  
PROJECT  
RICE LAKE HABITAT REHAB & ENHANCEMENT  
STAGE I  
DISCHARGE CHANNEL  
CROSS SECTIONS  
SHEET 4 OF 6





Sheet  
ID  
C-329

AS-BUILT  
A-51













D

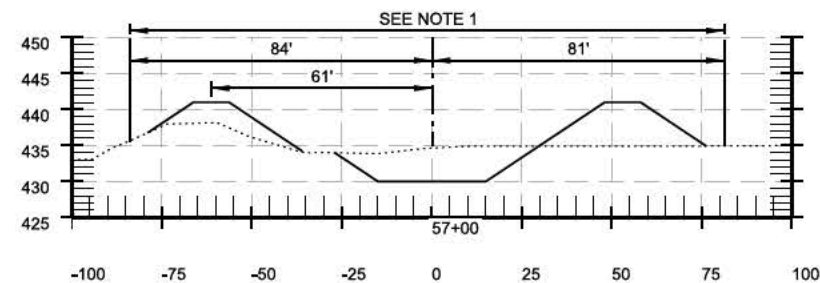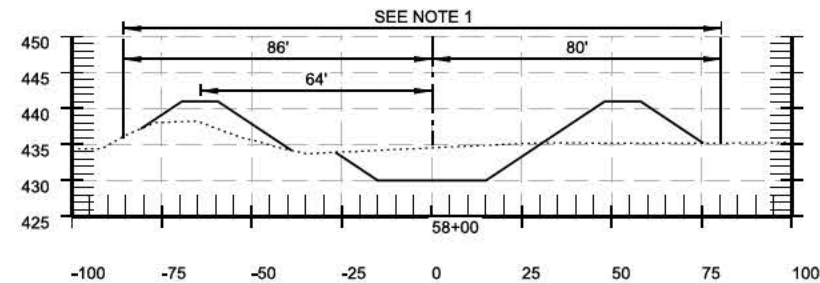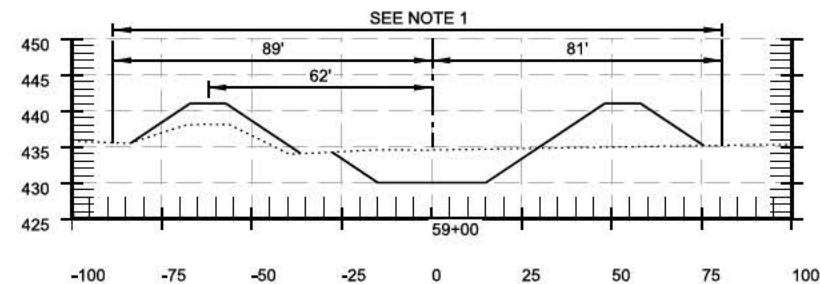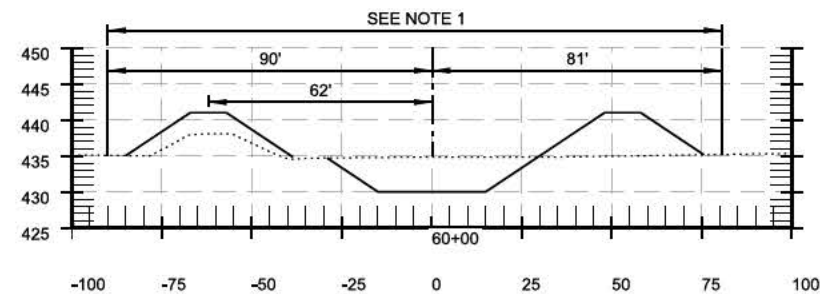



C

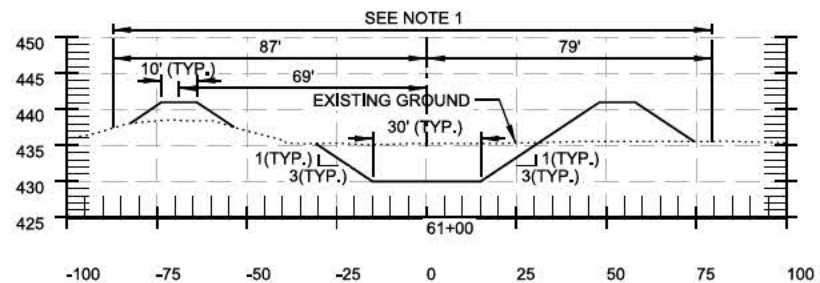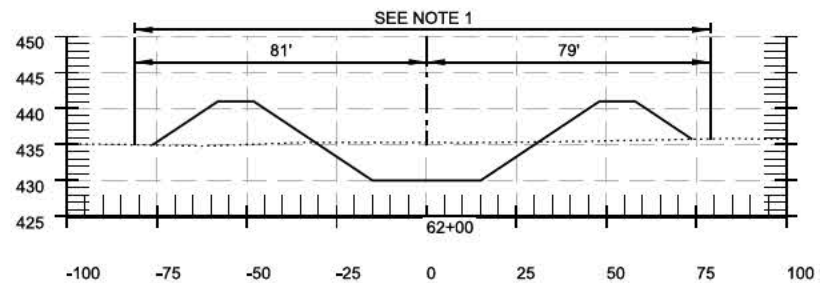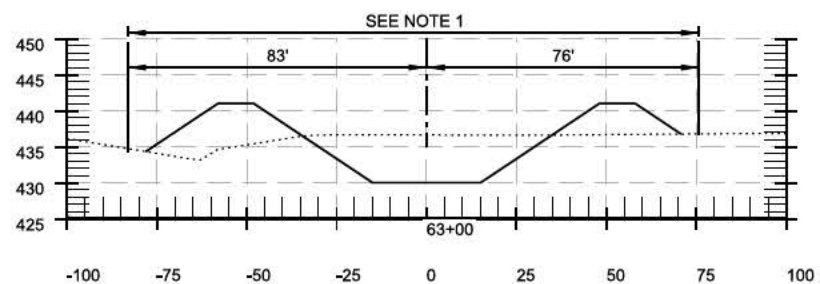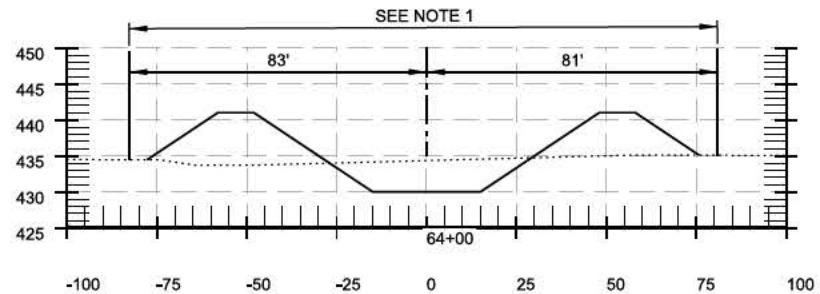

B

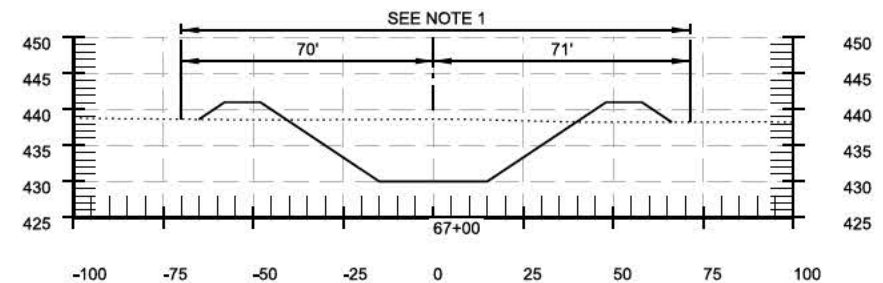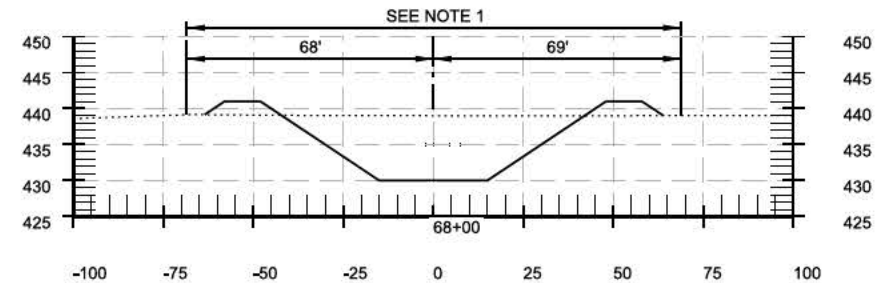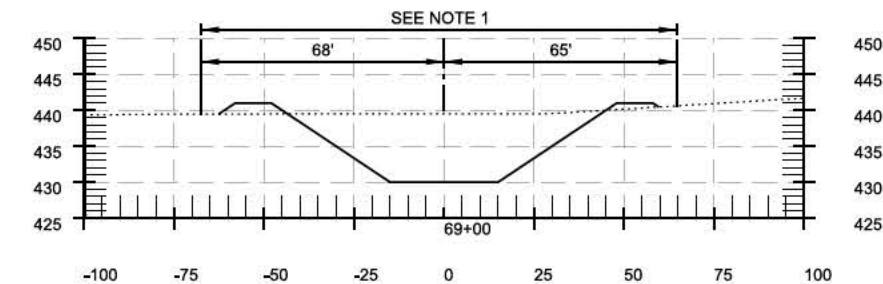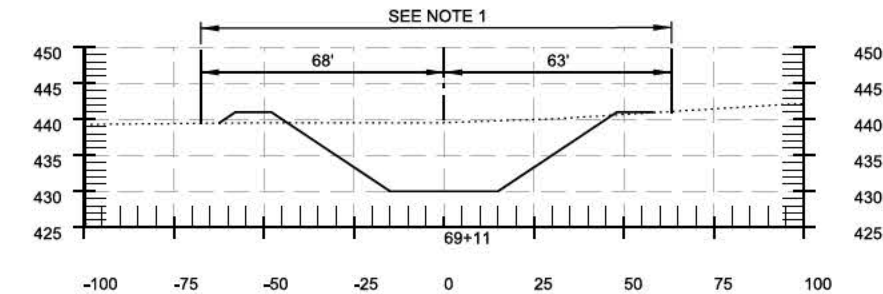


A

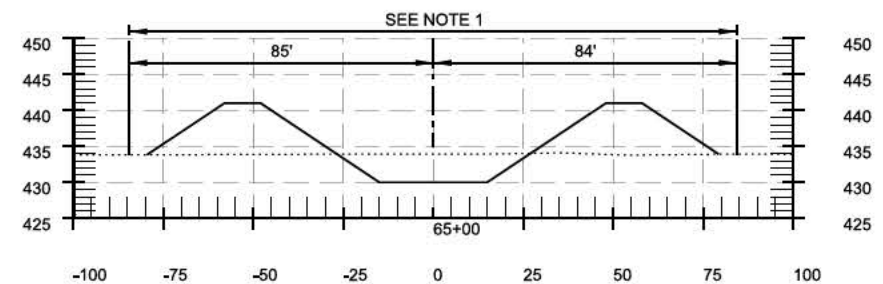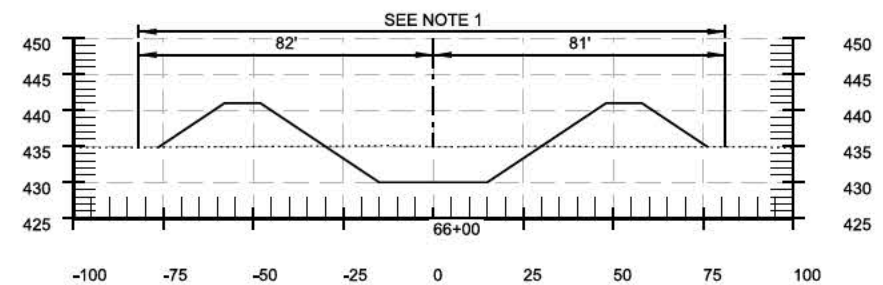

NOTE:  
1. LIMITS OF CLEARING, GRUBBING  
AND STRIPPING.

# DISCHARGE CHANNEL CROSS SECTIONS

NO SCALE



US Army Corps of Engineers

APPROVED	DATE	DESCRIPTION
AS-BUILT AS OF 29 SEPTEMBER 2017		

DESIGNED BY: RCP	CHECKED BY: RCP	DATE: 26-10-2016
DRAWN BY: RCP	CONTRACT NO: W123456789	SOLICITATION NO: 123456789
SUBMITTED BY: RCP	PROJECT CODE: EP102	FILE NAME: EP102C331.dgn
AS SHOWN	ANALYST: AN102	

ILLINOIS WATERWAY  
LA GRANGE POOL  
FLINT CREEK  
RICE LAKE HABITAT REHAB & ENHANCEMENT  
STAGE I

DISCHARGE CHANNEL  
CROSS SECTIONS  
SHEET 6 OF 6


Sheet ID  
**C-331**

AS-BUILT  
A-53





c:\pwworking\mmt5\cadd\153728\EP102C-420.dgn  
8/28/2018 3:15:33 PM  
BEDDLIN


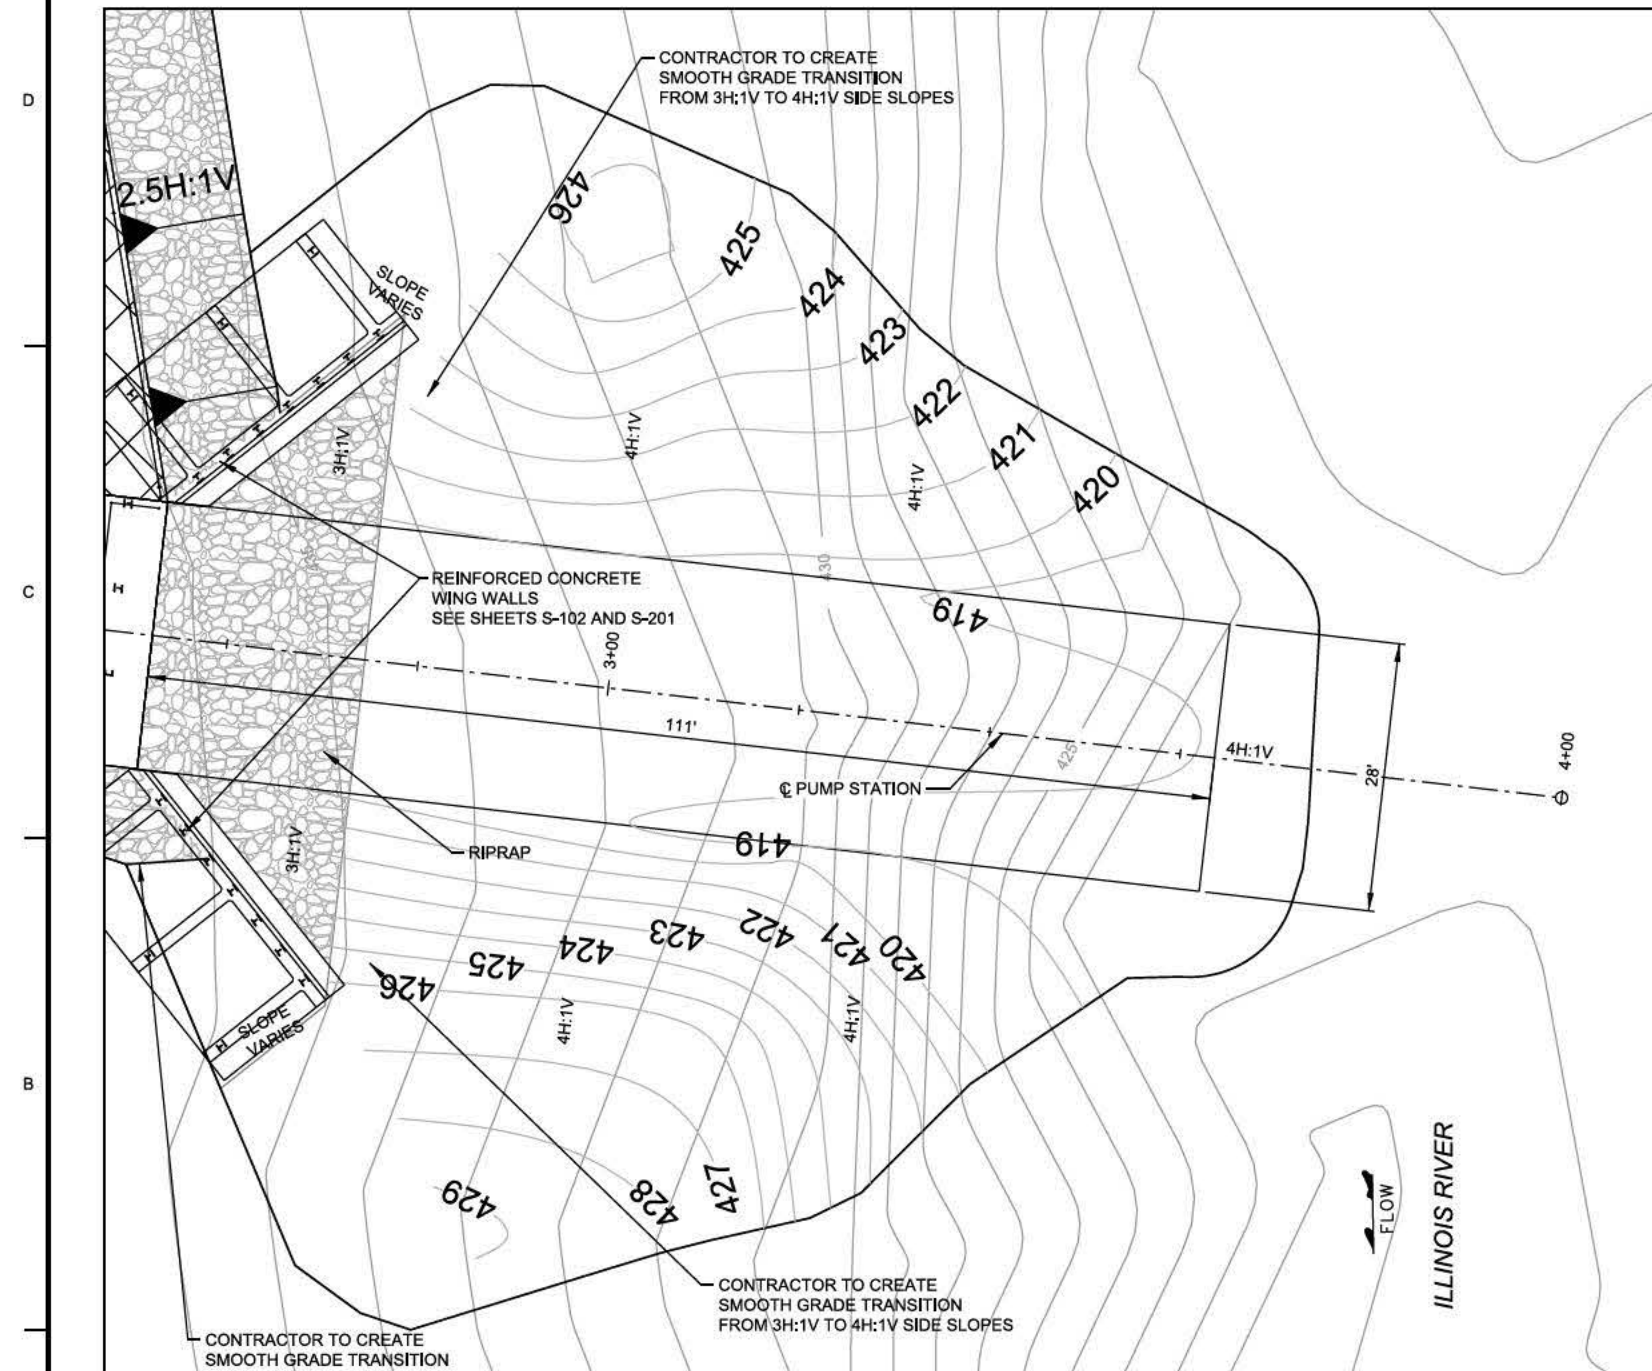


NOTES:

1. SEE SHEET C-220 FOR INTAKE BASIN PROFILE.
2. CONTRACTOR SHALL USE THE DREDGED MATERIAL FOR CONSTRUCTION OF THE PUMP STATION ACCESS ROAD/PARKING AREA AND CONTROL BUILDING PARKING AREA. IF ADDITIONAL MATERIAL IS NEEDED, CONTRACTOR SHALL OVEREXCAVATE THE INTAKE BASIN OUTSIDE THE LIMITS OF RIPRAP PLACEMENT.




INTAKE BASIN PLAN

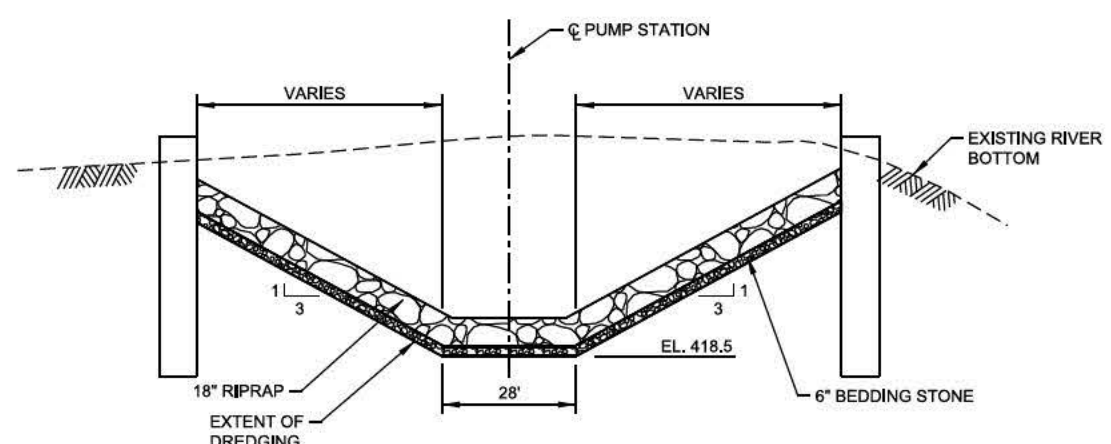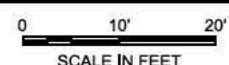

INTAKE BASIN RIPRAP TYPICAL SECTION

STA. 2+52.19 TO STA. 2+75

NO SCALE

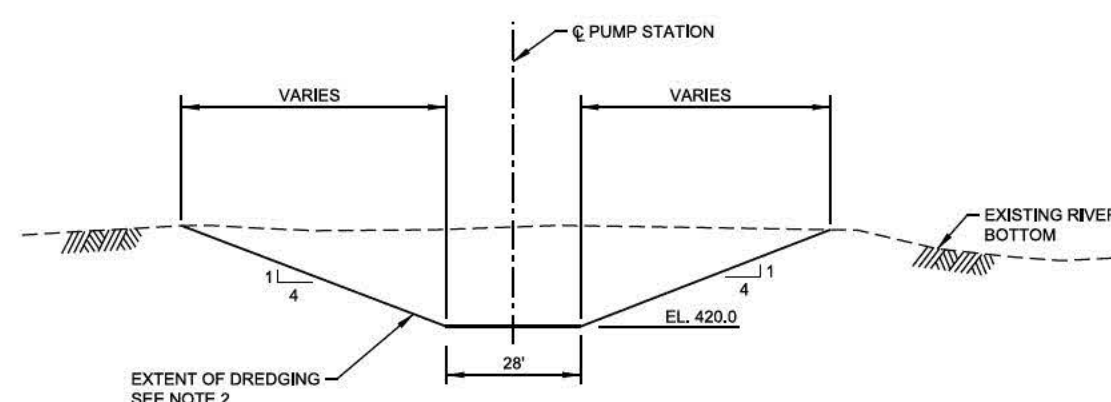

INTAKE BASIN TYPICAL SECTION

STA. 2+75 TO STA. 3+63.59

NO SCALE



DATE	DESCRIPTION
AS-BUILT AS OF 28 SEPTEMBER 2017	

DESIGNED BY: RCP	DATE: 28 SEP 2017	SOLICITATION NO.: S-102
DWN BY: RCP	CHK BY: CVA	CONTRACT NO.: EP102
SUBMITTED BY: H.A.	PLAT DATE: AS SHOWN	PROJECT CODE: EP102
FILE NAME: EP102C-420.dgn	FILE ID: A-55	

ILLINOIS WATERWAY  
LAGRANGE POOL  
FLOOD CONTROL  
RICE LAKE HABITAT REHAB & ENHANCEMENT  
STAGE I  
PUMP STATION INTAKE  
BASIN SITE PLAN

Sheet ID  
C-420

AS-BUILT  
A-55



THE FOLLOWING NOTES APPLY UNLESS NOTED OTHERWISE.

1. CONTRACT SPECIFICATIONS
2. EM 1110-2-2104, STRENGTH DESIGN FOR REINFORCED-CONCRETE HYDRAULIC STRUCTURES, AUGUST 2003.
3. ACI 318-08, BUILDING CODE REQUIREMENTS FOR REINFORCED CONCRETE AND COMMENTARY.
4. EM 1110-2-2105, DESIGN OF HYDRAULIC STEEL STRUCTURES, MAY 1994.
5. AISC, ALLOWABLE STRESS DESIGN, 13TH EDITION.
6. ASCE 7-05 AMERICAN SOCIETY OF CIVIL ENGINEERS. MINIMUM DESIGN LOADS FOR BUILDING AND OTHER STRUCTURE, 2005.
7. EM 1110-2-2502, RETAINING AND FLOOD WALLS, SEPTEMBER 1999.
8. EM 1110-2-3104, STRUCTURAL AND ARCHITECTURAL DESIGN OF PUMP STATION, JUNE 1989.
9. ETL 1110-2-563, GENERAL PRINCIPLES OF PUMP STATION DESIGN AND LAYOUT, FEBRUARY 1995.
10. AWS D1.1, STRUCTURAL WELDING CODE - STEEL
11. AWS D1.2 STRUCTURAL WELDING CODE - ALUMINUM
12. AWS D1.5 BRIDGE WELDING CODE.

1. ALL CONCRETE SHALL HAVE A MINIMUM COMPRESSIVE OF  $f_c=4000$  PSI AT 28 DAYS UNLESS NOTED OTHERWISE.
2. ALL REINFORCEMENT PLACEMENT AND DETAILING SHALL CONFORM TO AMERICAN CONCRETE INSTITUTE (ACI) 318-08, "BUILDING CODE REQUIREMENTS FOR REINFORCED CONCRETE AND COMMENTARY". UNO. THE WORDS "CONTRACTING OFFICER" SHALL BE SUBSTITUTED FOR THE WORD "ENGINEER" AND/OR "BUILDING OFFICIAL".
3. REINFORCEMENT REQUIREMENTS, EXCEPT AS OTHERWISE INDICATED:
  - A. REINFORCEMENT SHALL BE ASTM A615, GRADE 60 ( $F_y = 60,000$  PSI). DEFORMED BARS SHALL MEET THE REQUIREMENTS OF PARAGRAPH 3.5.3 OF ACI STANDARD 318-08.
  - B. WELDED OR FIELD BENT REINFORCING STEEL BARS SHALL CONFORM TO THE REQUIREMENTS OF ASTM A706. BAR SIZE NUMBERS ARE RECOGNIZED IN ASTM A615.
4. MINIMUM CLEAR COVER TO THE NEAREST SURFACE FOR REINFORCEMENT EXCEPT AS OTHERWISE INDICATED SHALL BE:
  - A. SURFACES PERMANENTLY EXPOSED TO WEATHER: 3".
  - B. 2-INCH MINIMUM FOR CONCRETE SECTIONS EQUAL TO OR LESS THAN 12 INCHES IN THICKNESS.
  - C. 3-INCH MINIMUM FOR CONCRETE SECTIONS GREATER THAN 12 INCHES AND LESS THAN 24 INCHES.

IN NO CASE SHALL THE COVER BE LESS THAN 1.5 TIMES THE NOMINAL MAXIMUM SIZE OF AGGREGATE. REINFORCEMENT SHALL HAVE A MINIMUM CLEARANCE ABOVE THE EXISTING LIFT OF CONCRETE EQUAL TO THE MAXIMUM AGGREGATE SIZE MULTIPLIED BY 1.5.
5. MINIMUM REINFORCEMENT EMBEDMENT LENGTH (CLASS A) AND TENSION LAP SPLICE LENGTH (CLASS B) FOR UNCOATED BARS SHALL BE AS FOLLOWS UNO.

A. LENGTHS SHOWN IN THE TABLE (INCHES) ARE FOR 4000 PSI NORMAL WEIGHT CONCRETE.

B. TOP BARS ARE SO PLACED THAT MORE 12" OF CONCRETE IS CAST BELOW THE REINFORCEMENT.

C. WHEN SPlicing SMALLER BARS TO LARGE BARS, THE LAP SPlice SHALL BE THE MINIMUM TENSION. LAP SPlice OR DEVELOPMENT LENGTH OF THE SMALLER BAR IN TENSION.

D. ALL LENGTHS SHOWN IN THE TABLE SHALL BE MULTIPLIED BY 1.5 UNLESS THE FOLLOWING CONDITIONS ARE SATISFIED.

- CLEAR SPACING OF BARS BEING DEVELOPED OR SPliced NOT LESS THE BAR DIAMETER.
- CLEAR COVER NOT LESS THAN THE BAR DIAMETER.




- 

8. ALL REINFORCEMENT SHALL BE DISCONTINUED AT CONTRACTION, EXPANSION OR MONOLITH JOINTS, UNO.
9. SUBJECT TO THE APPROVAL OF THE CONTRACTING OFFICER, REINFORCING BARS MAY BE SHIFTED OR BENT IN THE FIELD TO MISS SECOND PLACEMENTS, OPENINGS, EMBEDDED ITEMS AND OTHER OBSTRUCTIONS.
10. NO WELDING SHALL BE PERMITTED ON ANY REINFORCEMENT UNO.
11. BAR SPACING INDICATED ON REINFORCING DRAWINGS IS A MAXIMUM. ACTUAL SPACING OF REINFORCEMENT WILL BE DICTATED BY THE CONCRETE GEOMETRY AND THE DIMENSIONS INDICATED ON THE DRAWINGS.  
CONCRETE FORMED SURFACE FINISH FOR ALL CAST-IN-PLACE CONCRETE FORMWORK
12. TOLERANCES SHALL NOT EXCEED CLASS B REQUIREMENTS,

W AND HP SHAPES _____	ASTM A992 OR ASTM A572 GRADE 50
OTHER ROLLED STRUCTURAL SHAPES _____	
CHANNELS, ANGLES AND PLATES _____	ASTM A36
BOLTS, NUTS, WASHERS _____	ASTM A325
STUDS _____	ASTM A325
GALVANIZED STEEL _____	ASTM A123
GRATING _____	ASTM A653
TENSION BAR BAND _____	ASTM F626
CHAIN LINK FABRIC _____	ASTM A392 CLASS1 OR ASTM A491 TYPE I
POST _____	ASTM F1083
TUBE _____	ASTM A500 GRADE B
TRUSS ROD _____	ASTM F626

1. THE PROJECT VERTICAL DATUM IS THE NORTH AMERICAN VERTICAL DATUM (NAVD 88-2044.65). HORIZONTAL COORDINATES ARE BASED ON ILLINOIS STATE PLANE COORDINATE SYSTEM.



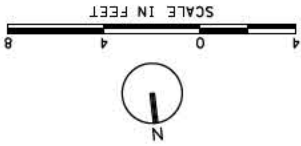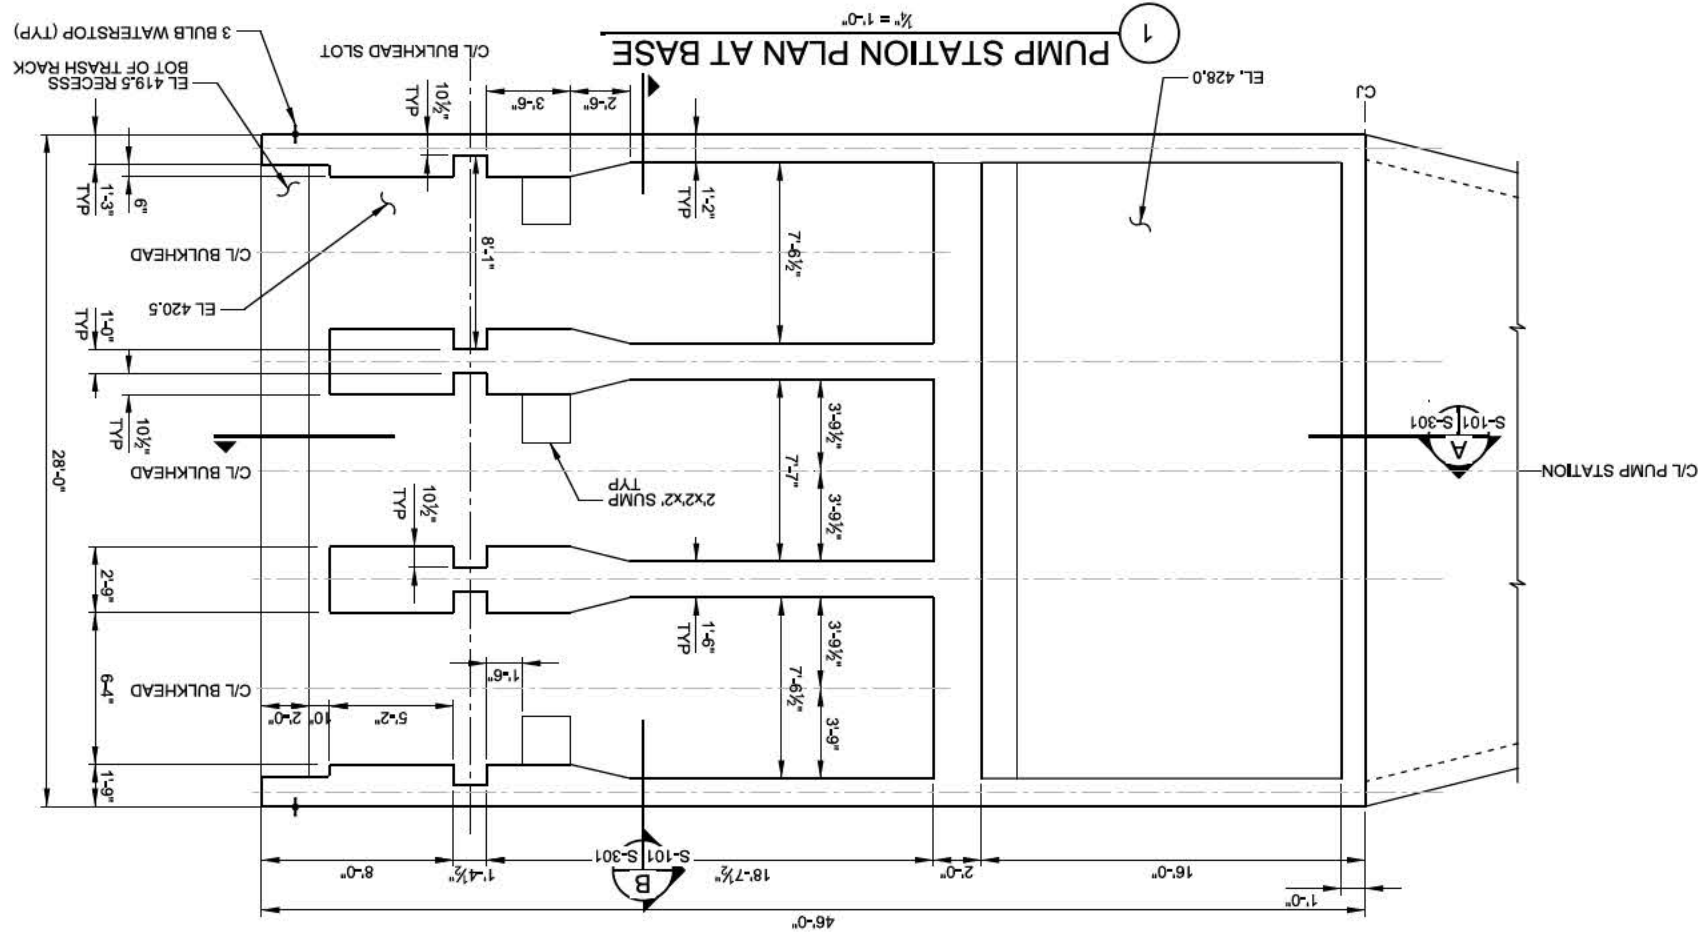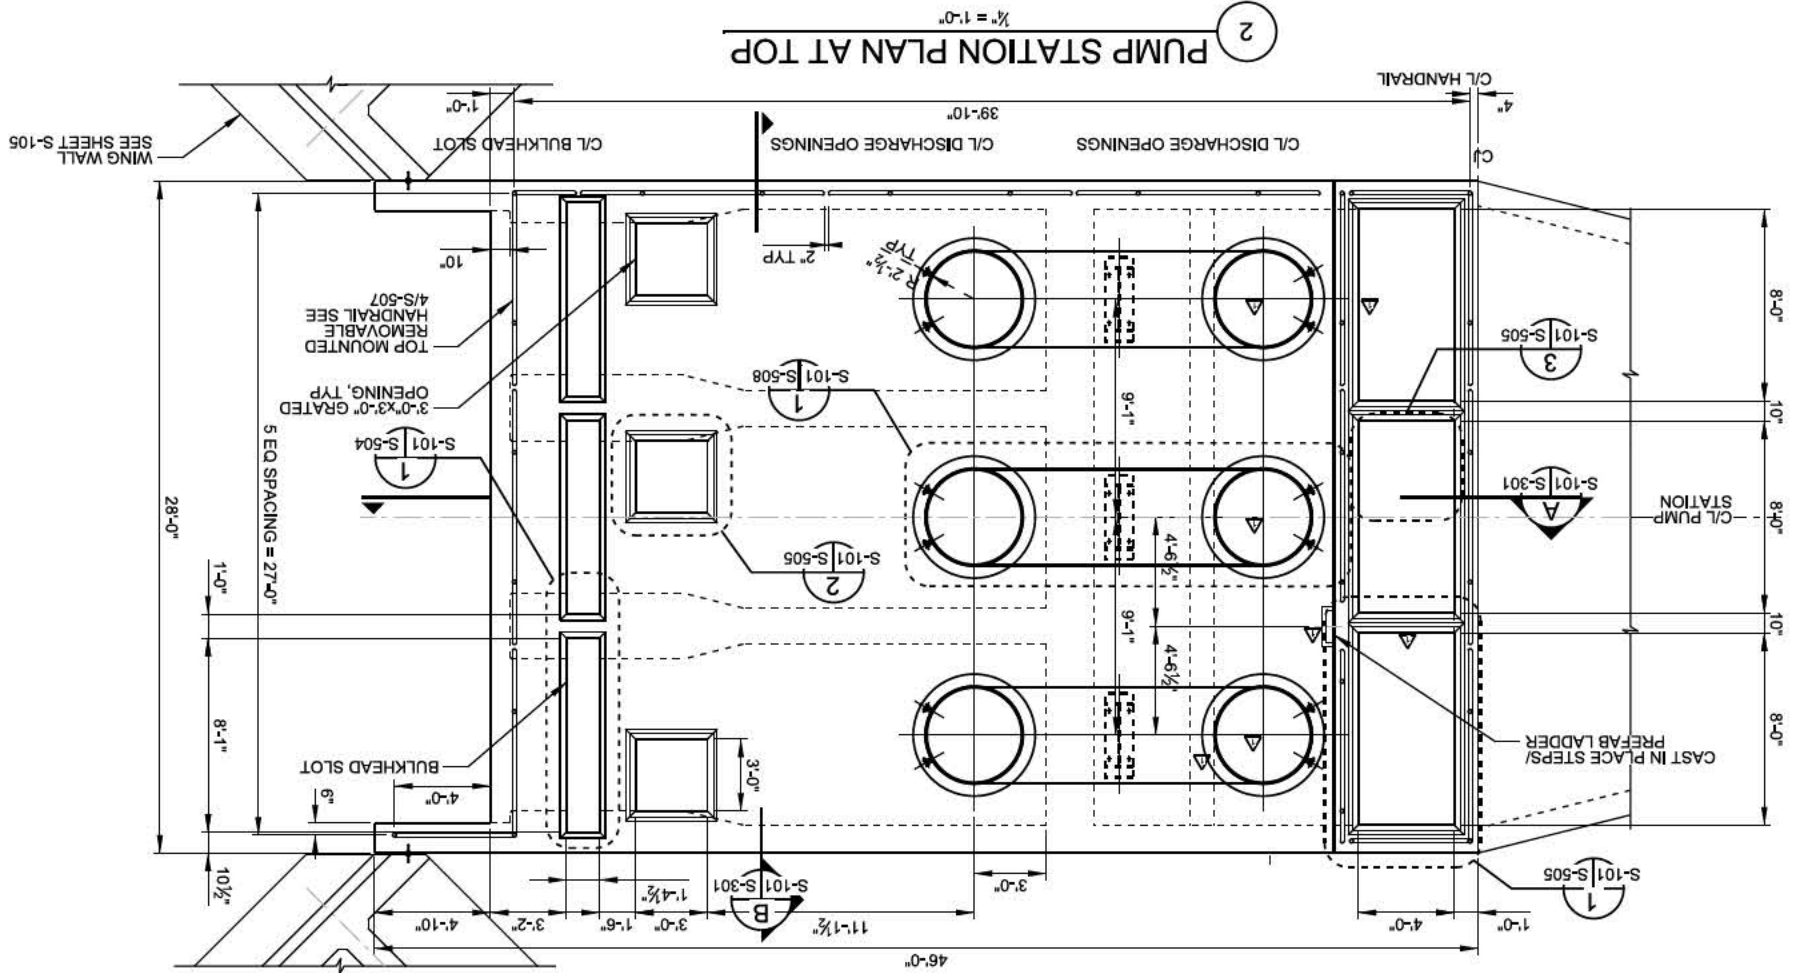

Sheet  
S-101

ILLINOIS WATERWAY  
LAWANOE POOL  
FLORISSANT, ILL.  
RICE LAKE HABITAT REPAIR & ENHANCEMENT  
PUMP STATION PLANS

U.S. ARMY CORPS OF ENGINEERS  
ROCK ISLAND DISTRICT  
ROCK ISLAND, ILLINOIS

DESIGNED BY:	DATE:
CDN BY:	20/10/2018
CHK BY:	SO/10/2018
STAMPED BY:	CONTRACT NO.
PLI:	W0125120180
AS SHOWN:	PROJECT CODE:
FILE NAME:	EP102
ANV ID:	EP102_S-101.dgn

MARK	DESCRIPTION	DATE	APPR.
1	MOD EXIST - ADD SURGE BASIN WALLS, LADDER AND HANDRAIL, MODIFY PIPE OPENINGS, ADD SLAB BEAM.	8/7/2012	CDN
AS-BUILT AS OF 28 SEPTEMBER 2017			




c:\pw\_working\mynt5\ced\h102\153734\EP102\_S-102.dgn  
8/28/2018 3:15:53 PM  
BEDDLH

D


C

B

A

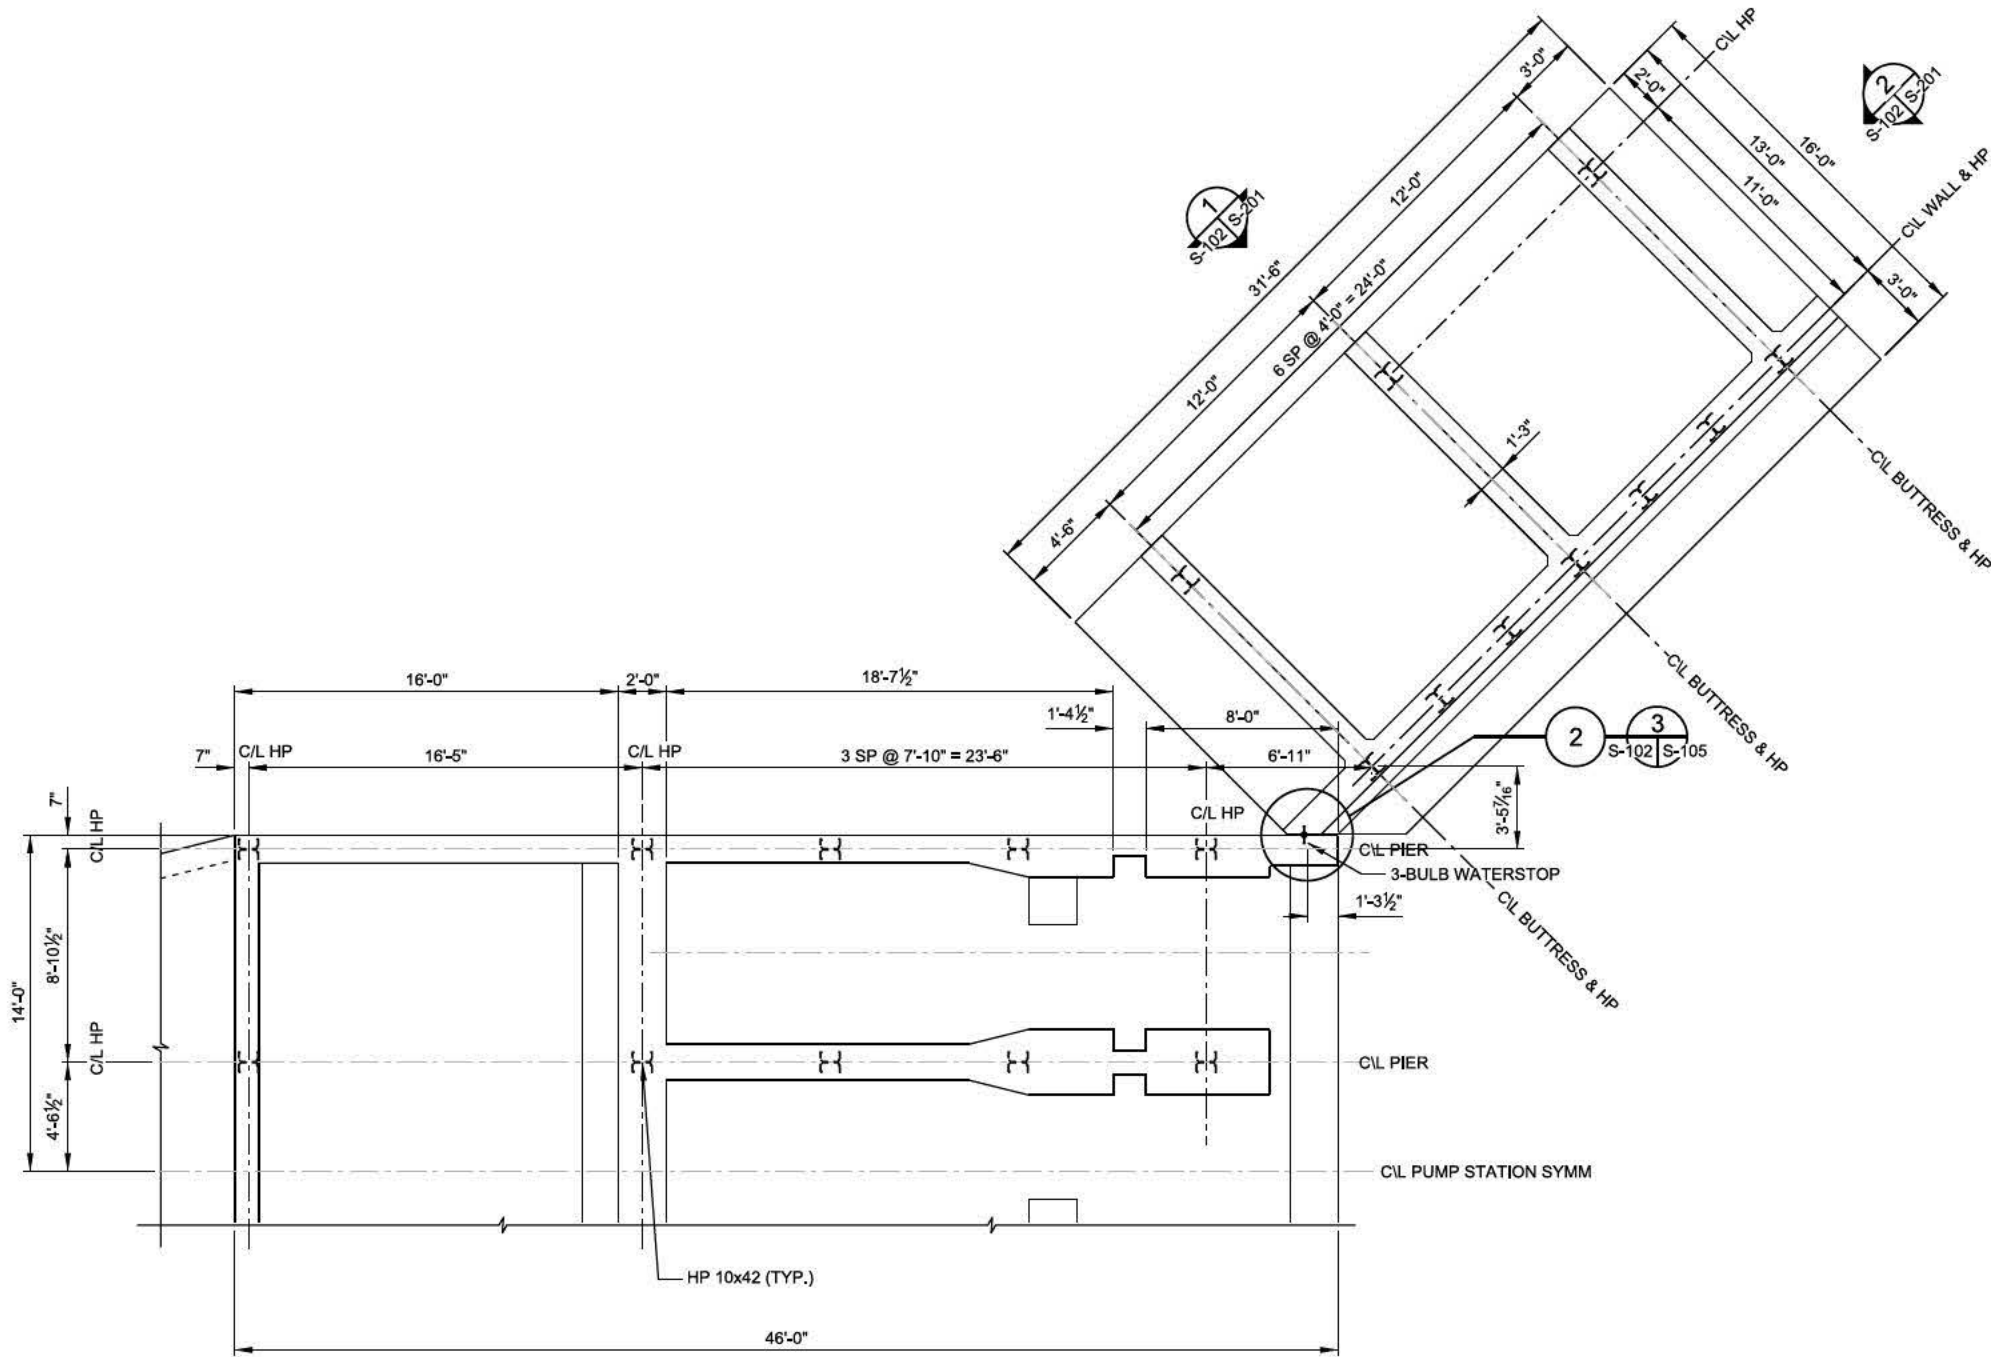

1 BASE SLAB LAYOUT PLAN  
1/4"=1'-0"

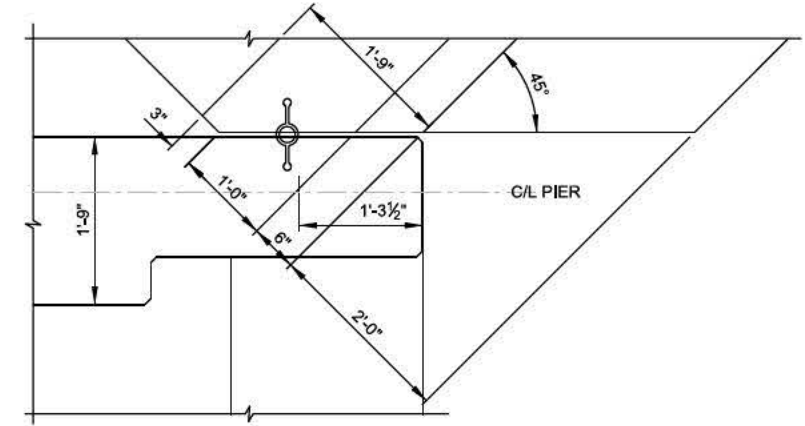


2 DETAIL  
1"=1'-0"

HP = H-PILE

NOTES ON H-PILES:

1. ALL H-PILES ARE HP 10x42 AND SHALL CONFORM TO THE ASTM A572, GRADE 50, STEEL SPECIFICATIONS.
2. DESIGN CAPACITY COMPRESSION WORKING LOAD 142 KIPS.
3. A PILE TIP ELEVATION OF 375 FEET SHALL BE USED FOR BID PREPARATION ONLY. THE FINAL PILE TIP ELEVATION WILL BE DETERMINED BY THE CONTRACTING OFFICER AFTER REVIEWING THE INDICATOR PILE TEST RESULTS AND REFUSAL DATA, AS SPECIFIED IN THE CONTRACT SPECIFICATIONS.
4. ADJUST PLACEMENT OF INDIVIDUAL BASE REINF. BARS TO MISS THE H-PILES.
5. H-PILE SPLICES IF REQUIRED ARE PROHIBITED IN THE UPPER THIRD OF PILE.

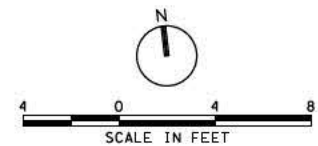

APPR.	DATE	DESCRIPTION
AS-BUILT AS OF 28 SEPTEMBER 2017		


DESIGNED BY: KCP	DATE: 26-10-2016	SOLICITATION NO.:
DWN BY:	CHK BY:	CONTRACT NO.:
SUBMITTED BY:	PROJECT CODE:	PROJECT NAME:
PLT SCALE:	PLT DATE:	PLT NAME:
1/2" = 1'-0"		EP102
SIZE:	ANSI D	EP102_S-102.dgn

ILLINOIS WATERWAY LAGRANGE POOL FLOOD CONTROL RICE LAKE HABITAT REHAB & ENHANCEMENT STAGE I	PUMP STATION AND WING WALL PILE LAYOUT PLAN
---	---

Sheet  
ID  
S-102



c:\pwworking\mmt5ecad\h0153734\EP102\_S-103.dgn  
8/28/2018 3:15:57 PM  
BEDDLIN

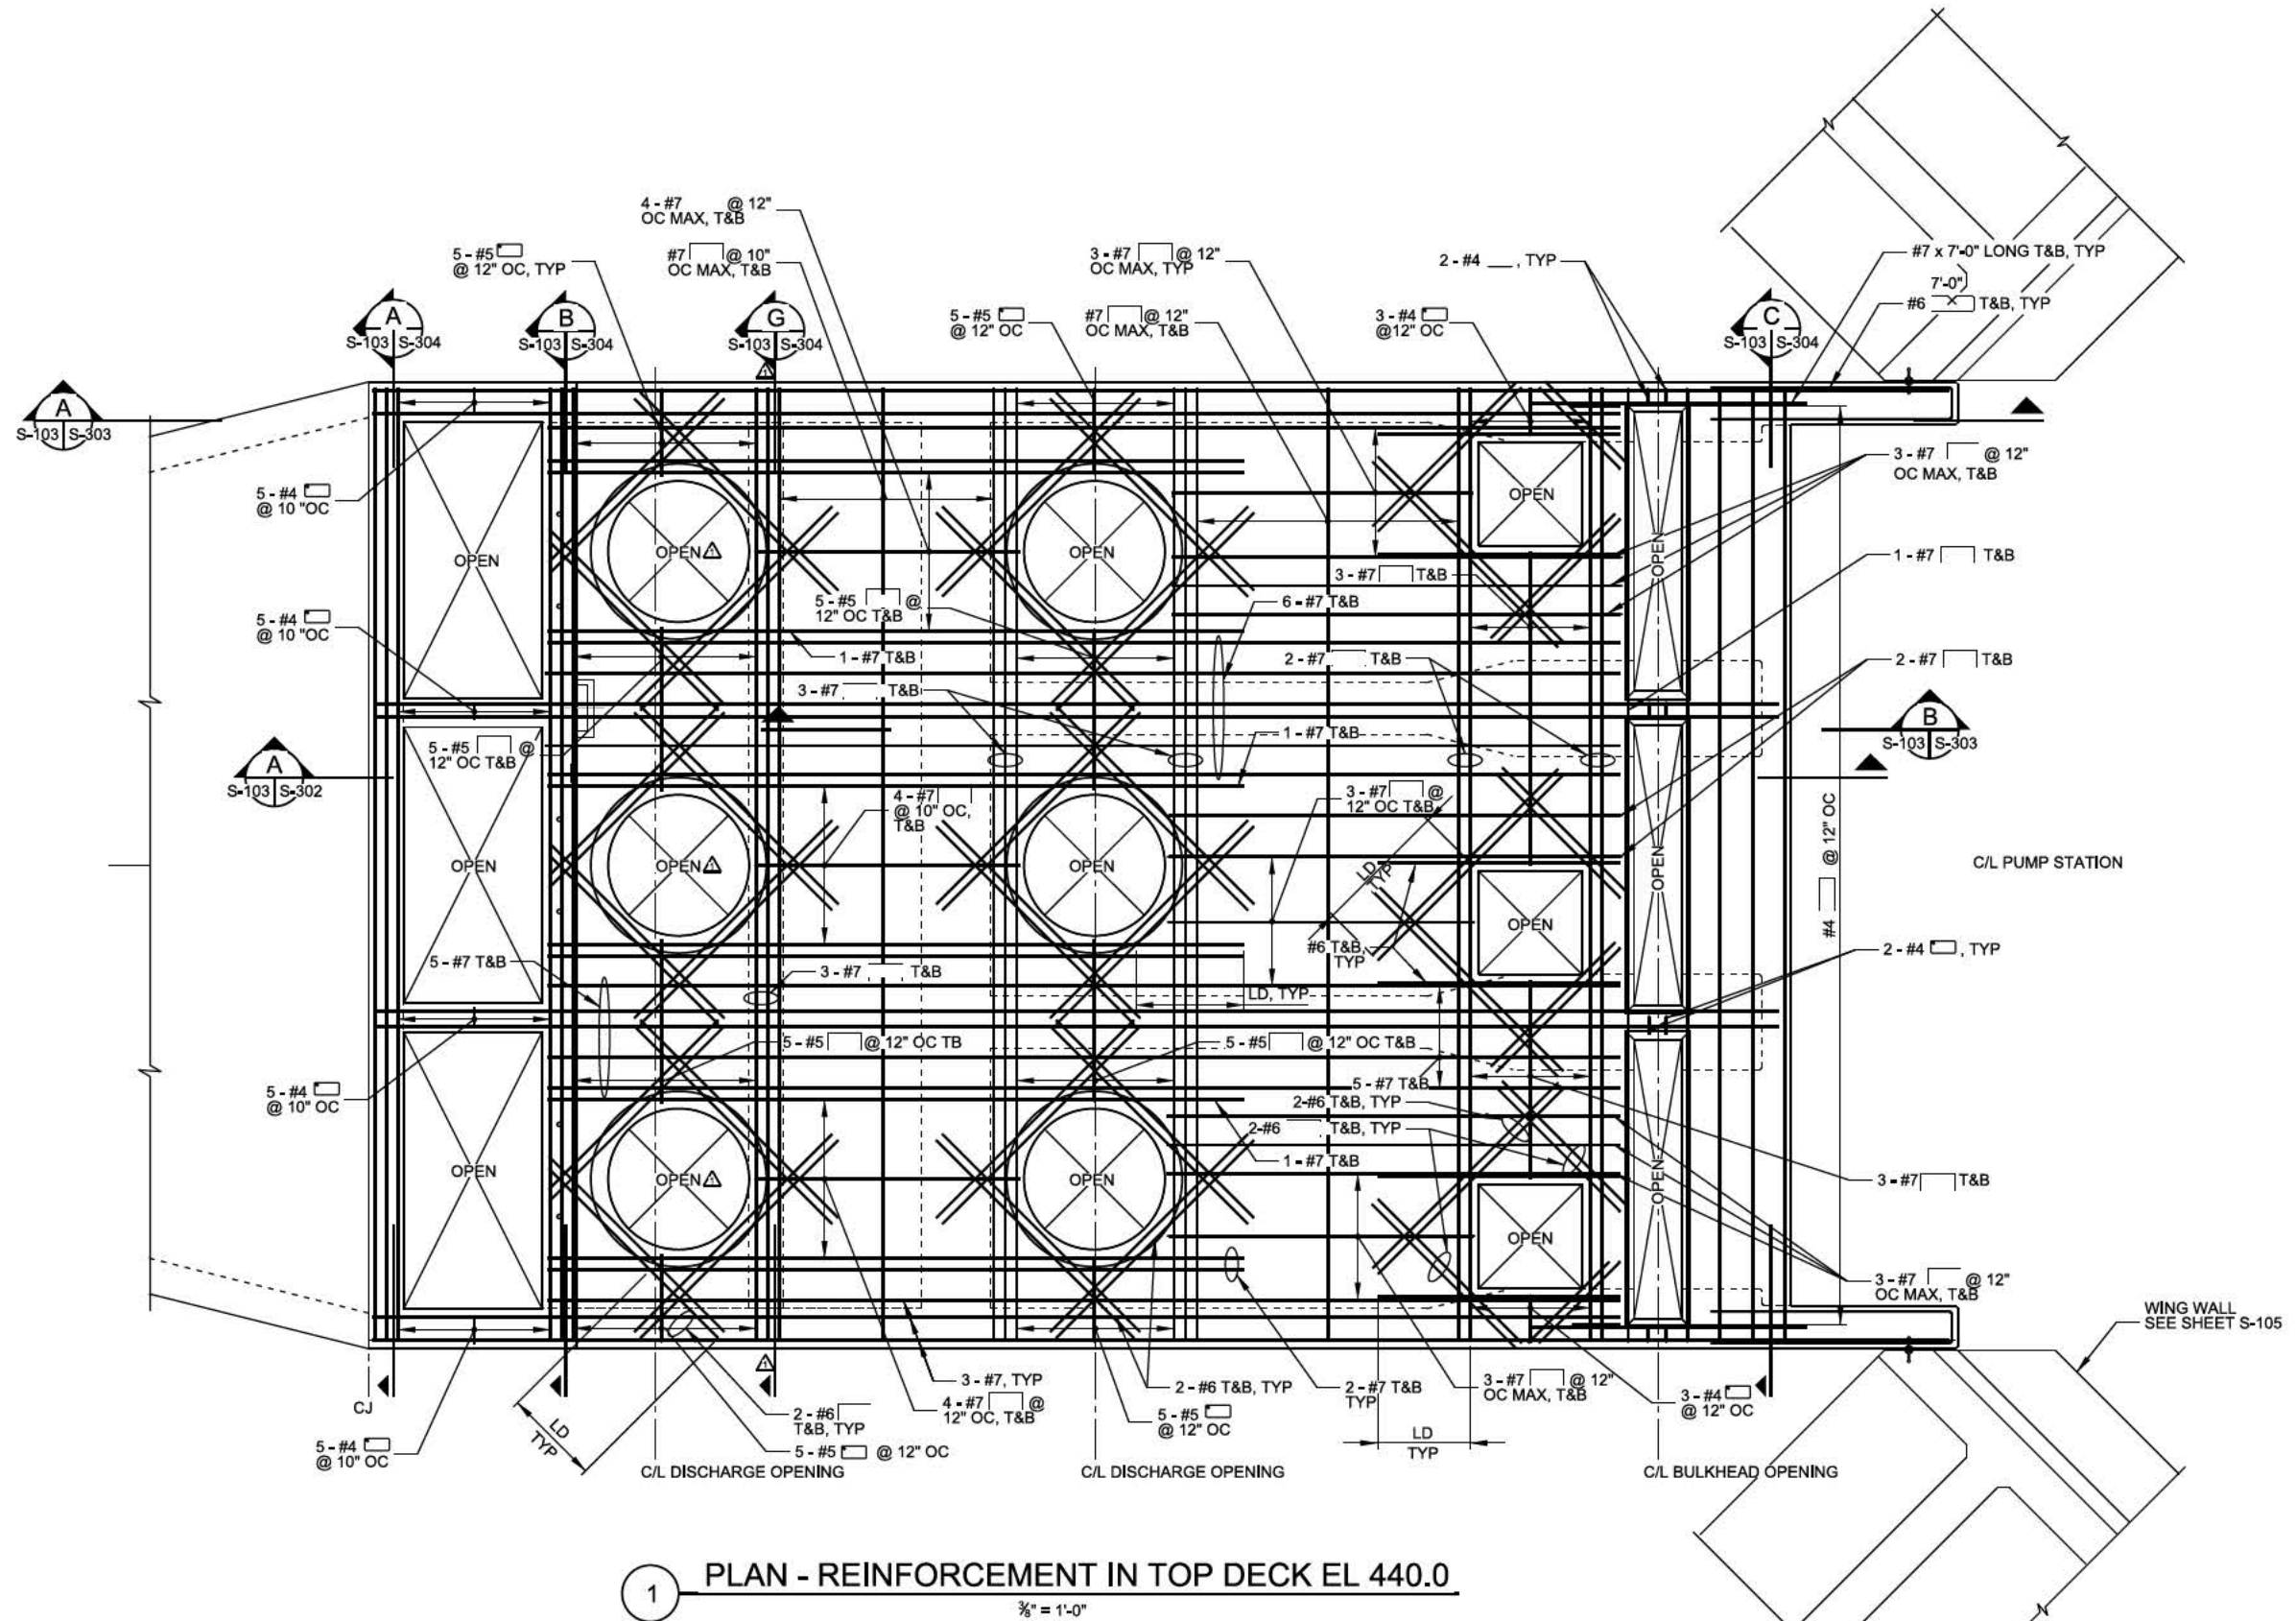

DATE	APPR.	DESCRIPTION
5/22/2012	DD	MOD EAS-100E TYPE OPENINGS, AND SLAB BEAM.
1		AS-BUILT AS OF 29 SEPTEMBER 2017


DATE:	DESIGNED BY:	CHK BY:	DATE:
2/1/2008	KCP	DD	5/22/2012
SUBMITTED BY:	PROJECT CODE:	FILE NAME:	SIZE:
DD	EP102	EP102_S-103.dgn	4MB

ILLINOIS WATERWAY  
LA GRANGE, ILL.  
RICE LAKE HABITAT REHAB & ENHANCEMENT  
STAGE I  
PUMP STATION  
REINFORCEMENT  
IN TOP DECK


Sheet  
ID  
**S-103**

AS-BUILT  
**A-59**


PLAN - SURGE BASIN WALLS

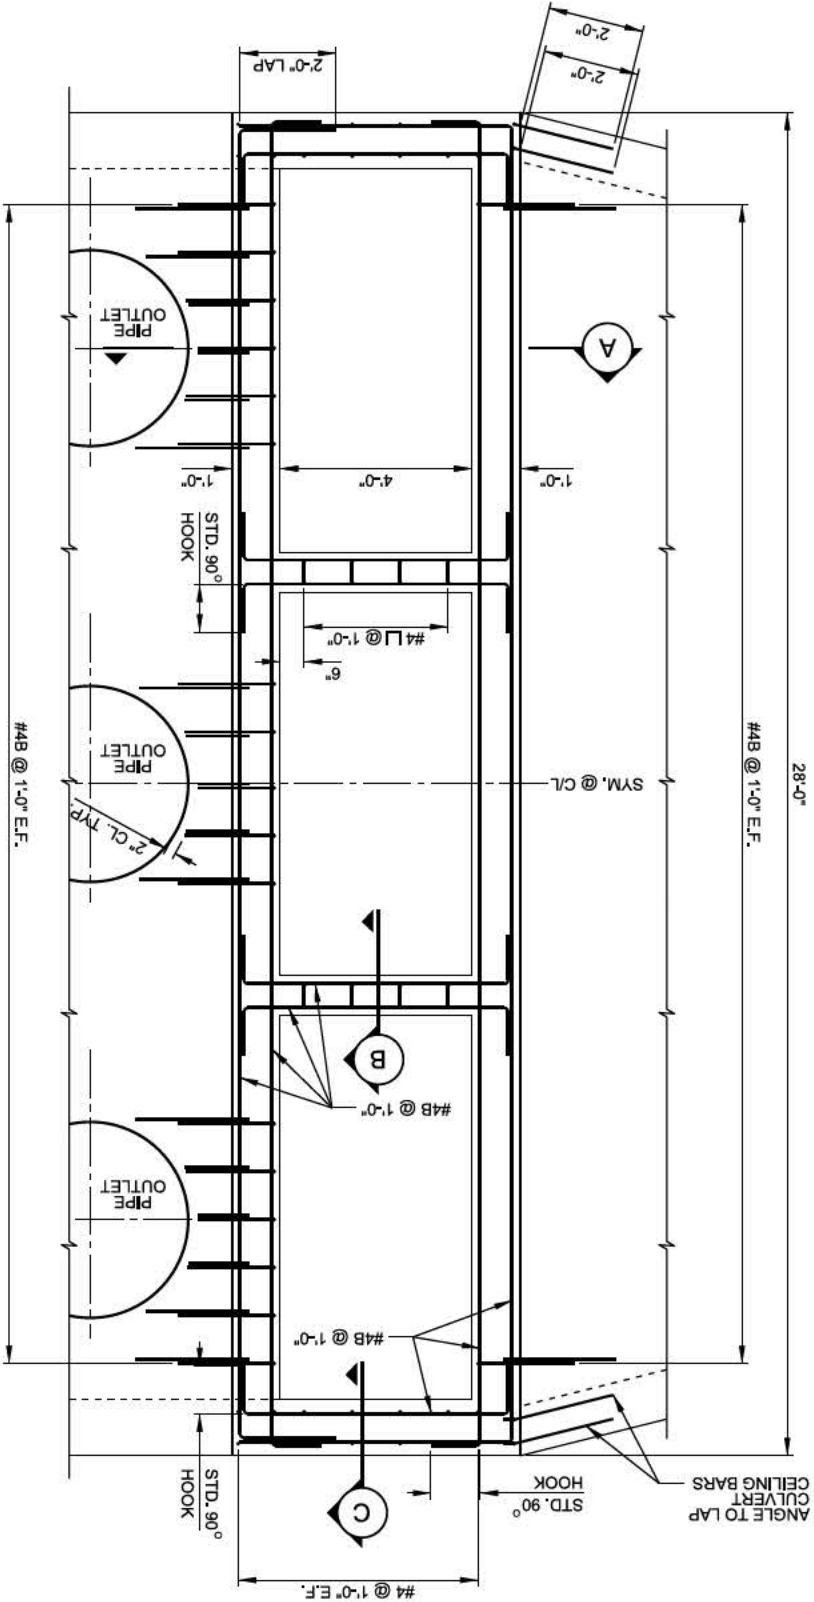


SECTION A

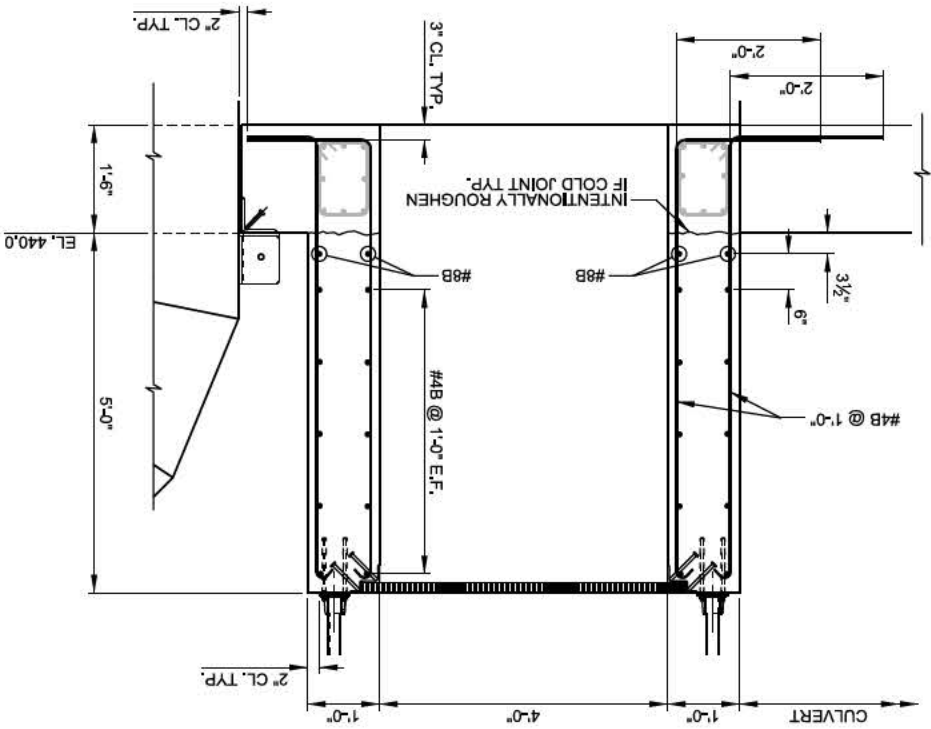

SECTION A

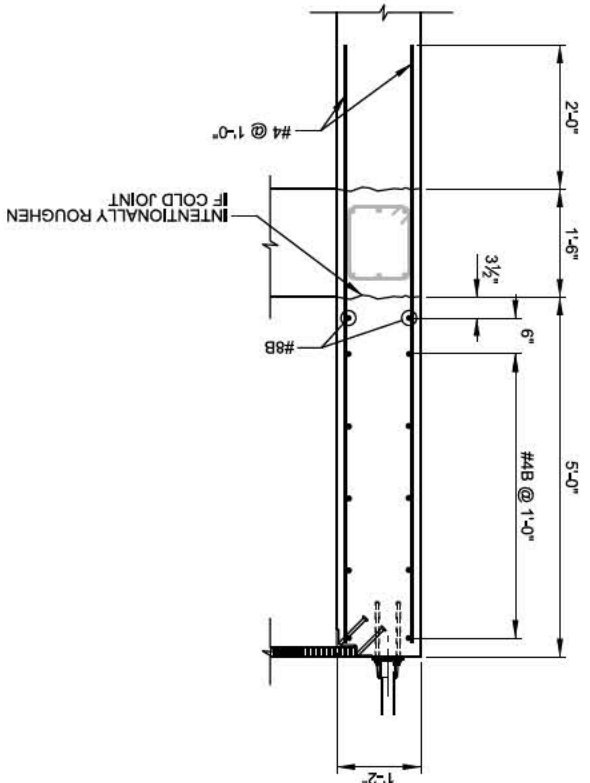


SECTION C

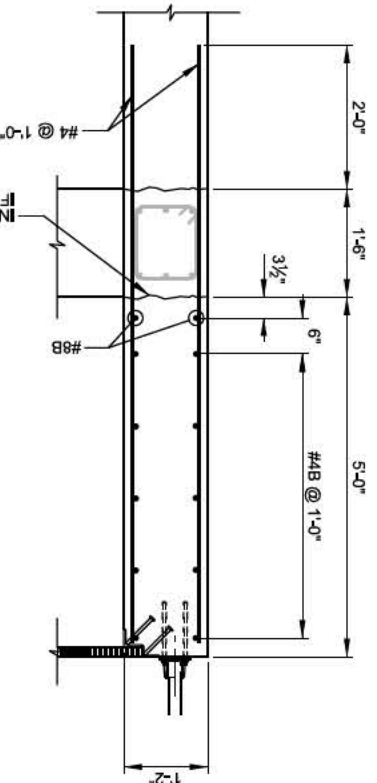

SECTION C

SECTION B

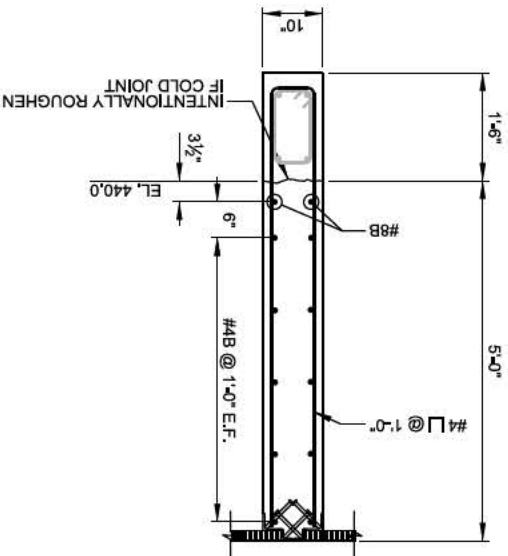

SECTION B

S-103A

Sheet ID  
RICE LAKE HABITAT REPAIR & ENHANCEMENT  
PUMP STATION  
SURGE BASIN WALLS  
REINFORCEMENT

U.S. ARMY CORPS OF ENGINEERS  
ROCK ISLAND DISTRICT  
ROCK ISLAND, ILLINOIS  
DESIGNED BY: DATE: 2/11/2008  
DRAWN BY: CHK BY: SUBMITTAL NO.:  
SUBMITTED BY: CONTRACT NO.:  
PLOT SCALE: PLOT DATE: PROJECT CODE:  
AS SHOWN: EPI02 S-103A.dgn

MARK	DESCRIPTION	DATE	APPROVED
1	MOD. EX-005 - NEW SHEET ADDED, AND SURGE BASIN WALLS, MODIFY PIPE OPENINGS.	5/22/2012	CD
2	AS-BUILT AS OF 28 SEPTEMBER 2017		
3			
4			
5			
6			
7			
8			
9			
10			







[illegible]

U.S. ARMY CORPS OF ENGINEERS	DESIGNED BY: KCP	DATE: 2011/06/30
ROCK ISLAND DISTRICT	DWN BY: NPP	SOLICITATION NO.: W125K411-0029
ROCK ISLAND, ILLINOIS	SUBMITTED BY: FJU	CONTRACT NO.: W125K411-0080
	PLOT SCALE: 3/8" = 1'-0"	PROJECT CODE: EP102
	FILE NAME:	

**ILLINOIS WATERWAY  
LAGRANGE POOL  
FULTON COUNTY, IL  
PRICE LAKE HABITAT REHAB & ENHANCEMENT  
STAGE I  
PUMP STATION  
REINFORCEMENT  
IN WALLS**

Sheet  
ID  
S-104

AS-BUILT  
A-61

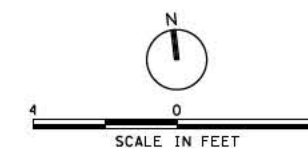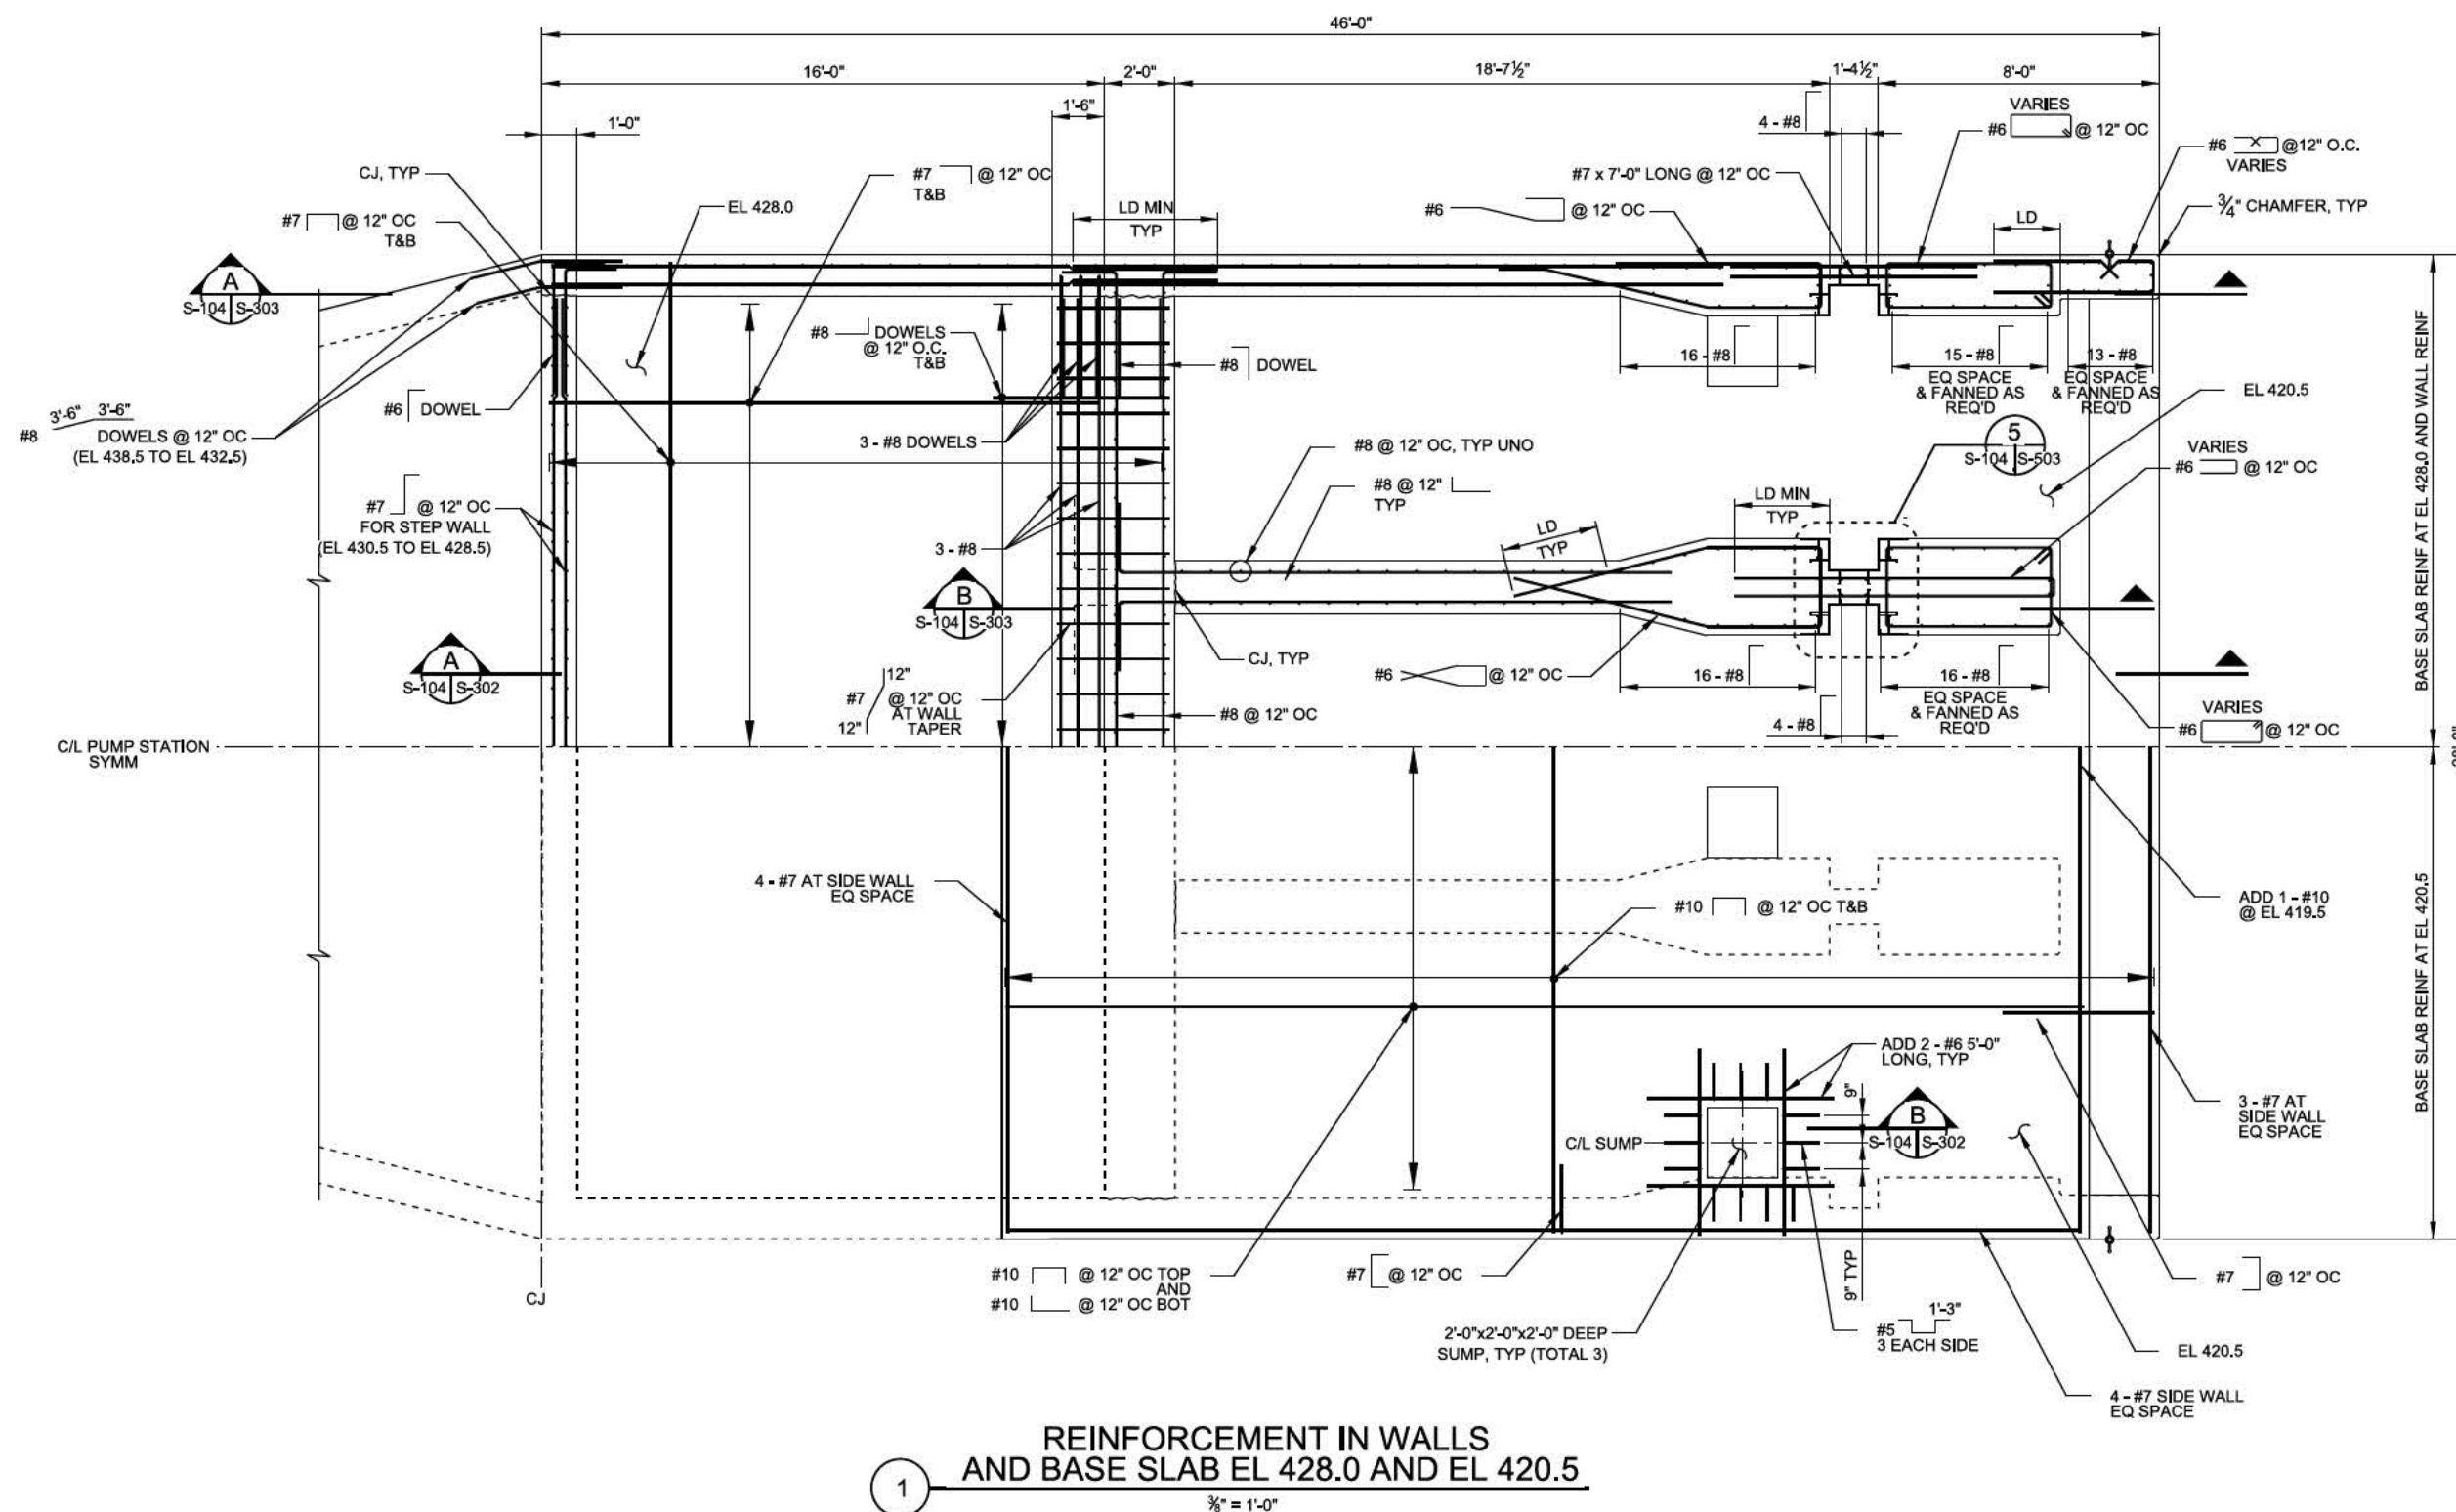


\\psw-working\mvr\b5eddlh\0153734\EP102\_S-104.dgn 3/28/2018 3:16:15 PM A

[illegible]

U.S. ARMY CORPS OF ENGINEERS ROCK ISLAND DISTRICT ROCK ISLAND, ILLINOIS	DESIGNED BY:	DATE:
	DRAWN BY:	DATE:
	CHECK BY:	SCALIFICATION NO.:
		W91256A-1-5-2039
	SUBMITTED BY:	CONTRACT NO.:
	FILE	W91256A-1-5-2080
	PLOT SCALE:	PROJECT CODE:
	PLOT SIZE:	EP102
	FILE NAME:	
	SIZE:	
	ANSI D	EP102, 5x10.625in


ILLINOIS WATERWAY  
LAGRANGE POOL  
FULTON COUNTY, IL  
RICE LAKE HABITAT REHAB & ENHANCEMENT  
STAGE I  
PUMP STATION  
REINFORCEMENT  
IN WING WALLS  
AND BASE SLAB

Sheet  
ID  
S-105

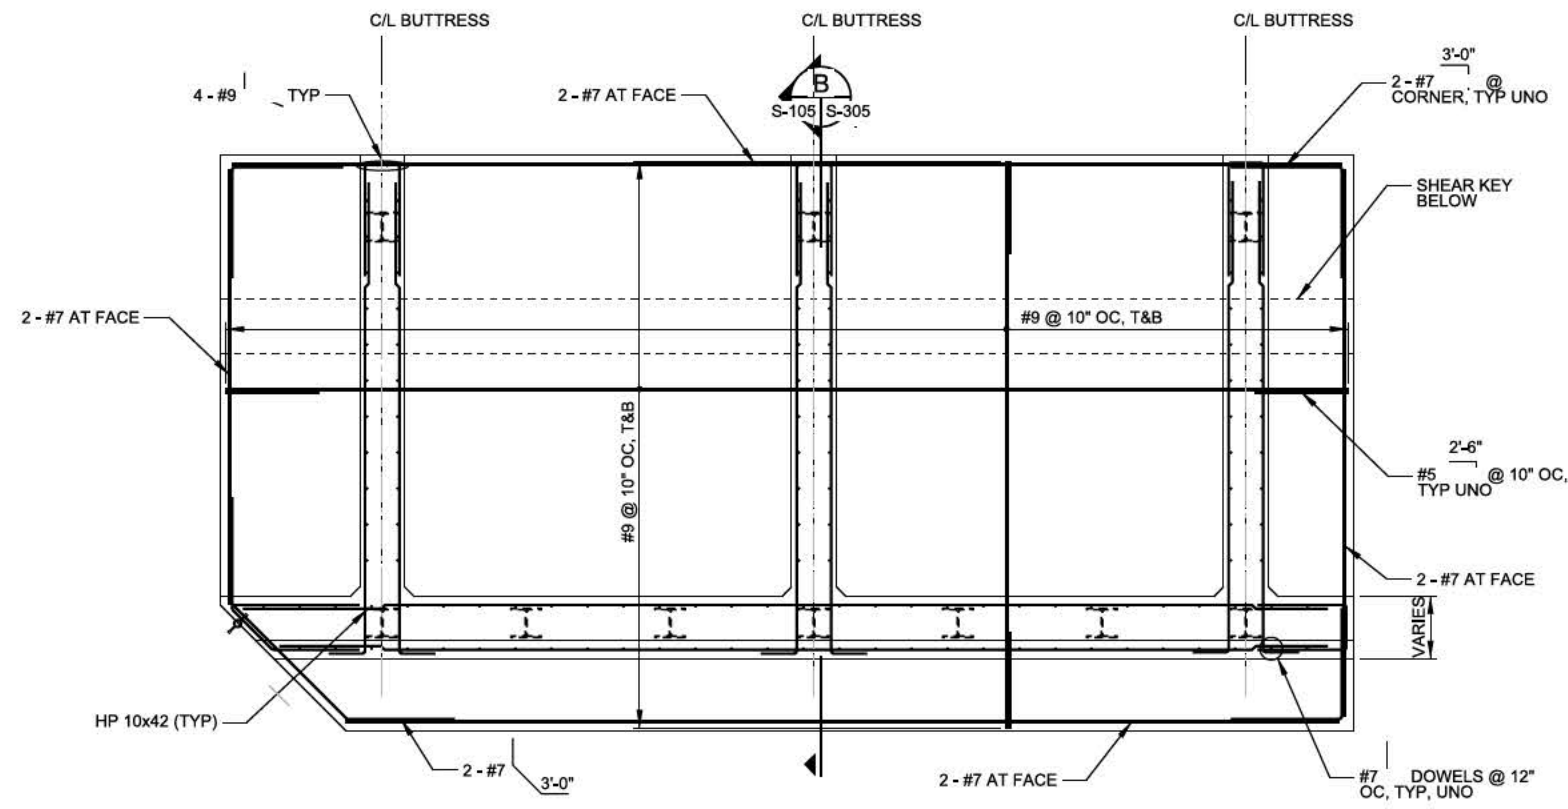

1 PLAN - BASE SLAB REINFORCEMENT


NOTE: EAST WING WALL AS SHOWN, WEST WING WALL OPPOSITE.

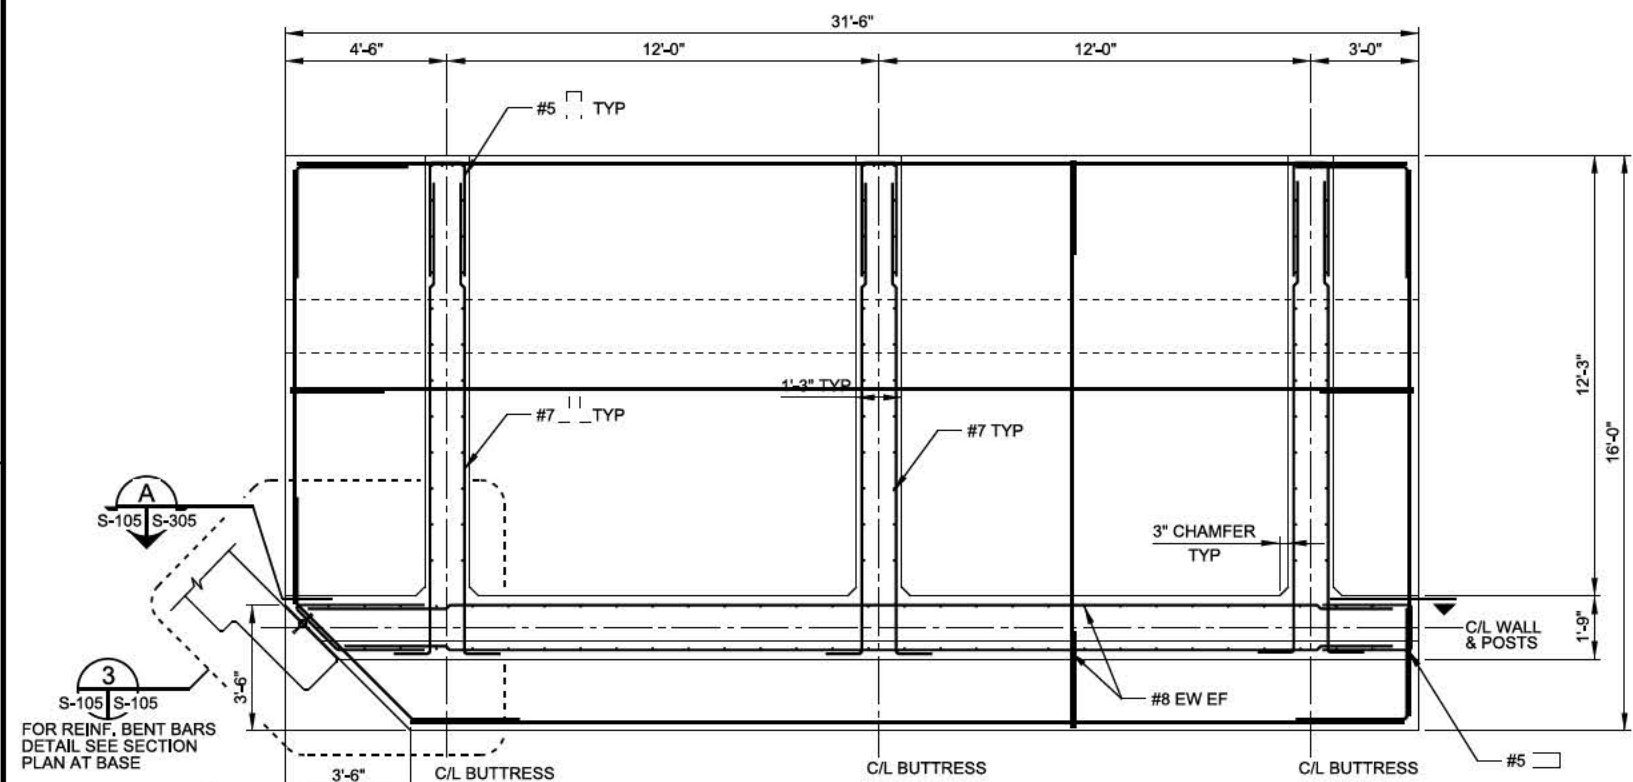

## 2 PLAN - WALL AND BUTTRESS REINFORCEMENT


NOTE: EAST WING WALL AS SHOWN, WEST WING WALL OPPOSITE.

H-PILES NOT SHOWN FOR CLARITY.

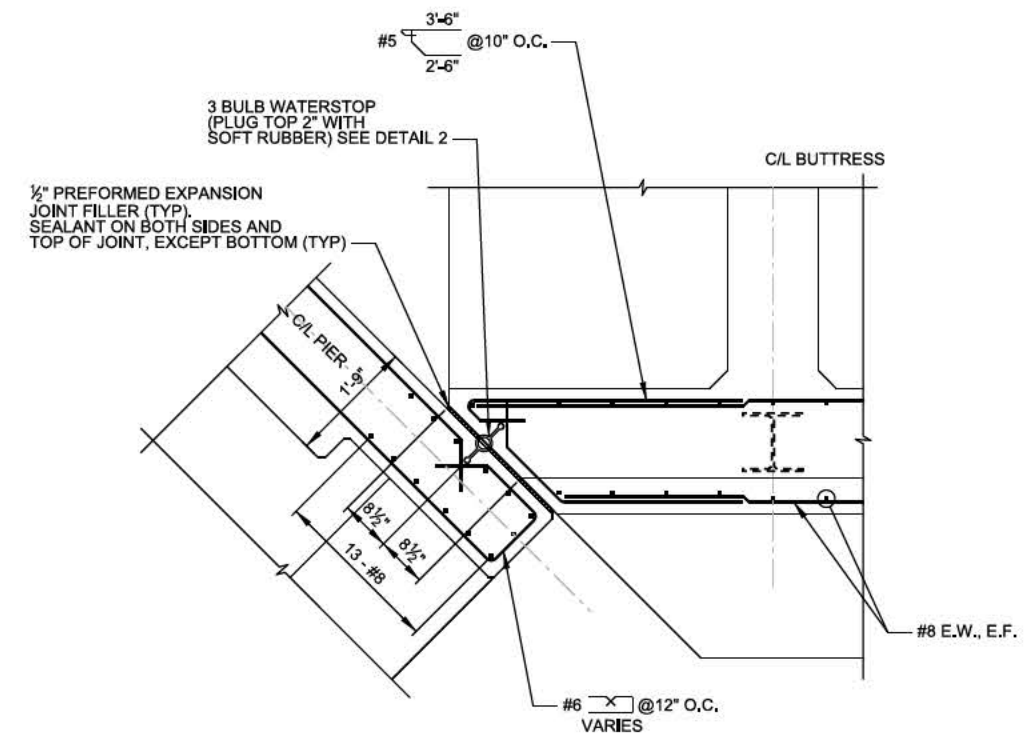

3 SECTION PLAN AT BASE

S-105 | S-105       $\frac{3}{4}" = 1'-0"$

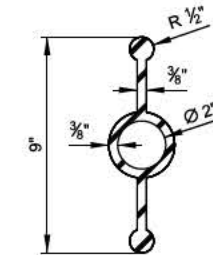

### DETAIL-3 BULB WATERSTOP

3" = 1'-0"





c:\pwworking\mmt5ecad\h0153734\EP102\_S-106.dgn  
8/28/2018 3:16:24 PM  
BEDDLH

D


C

B

A

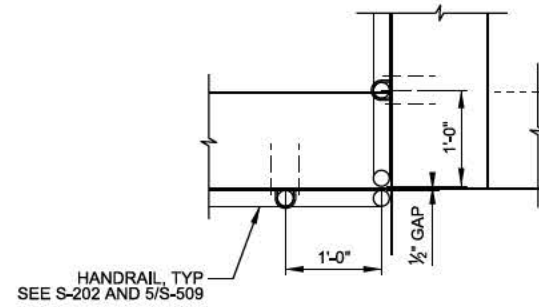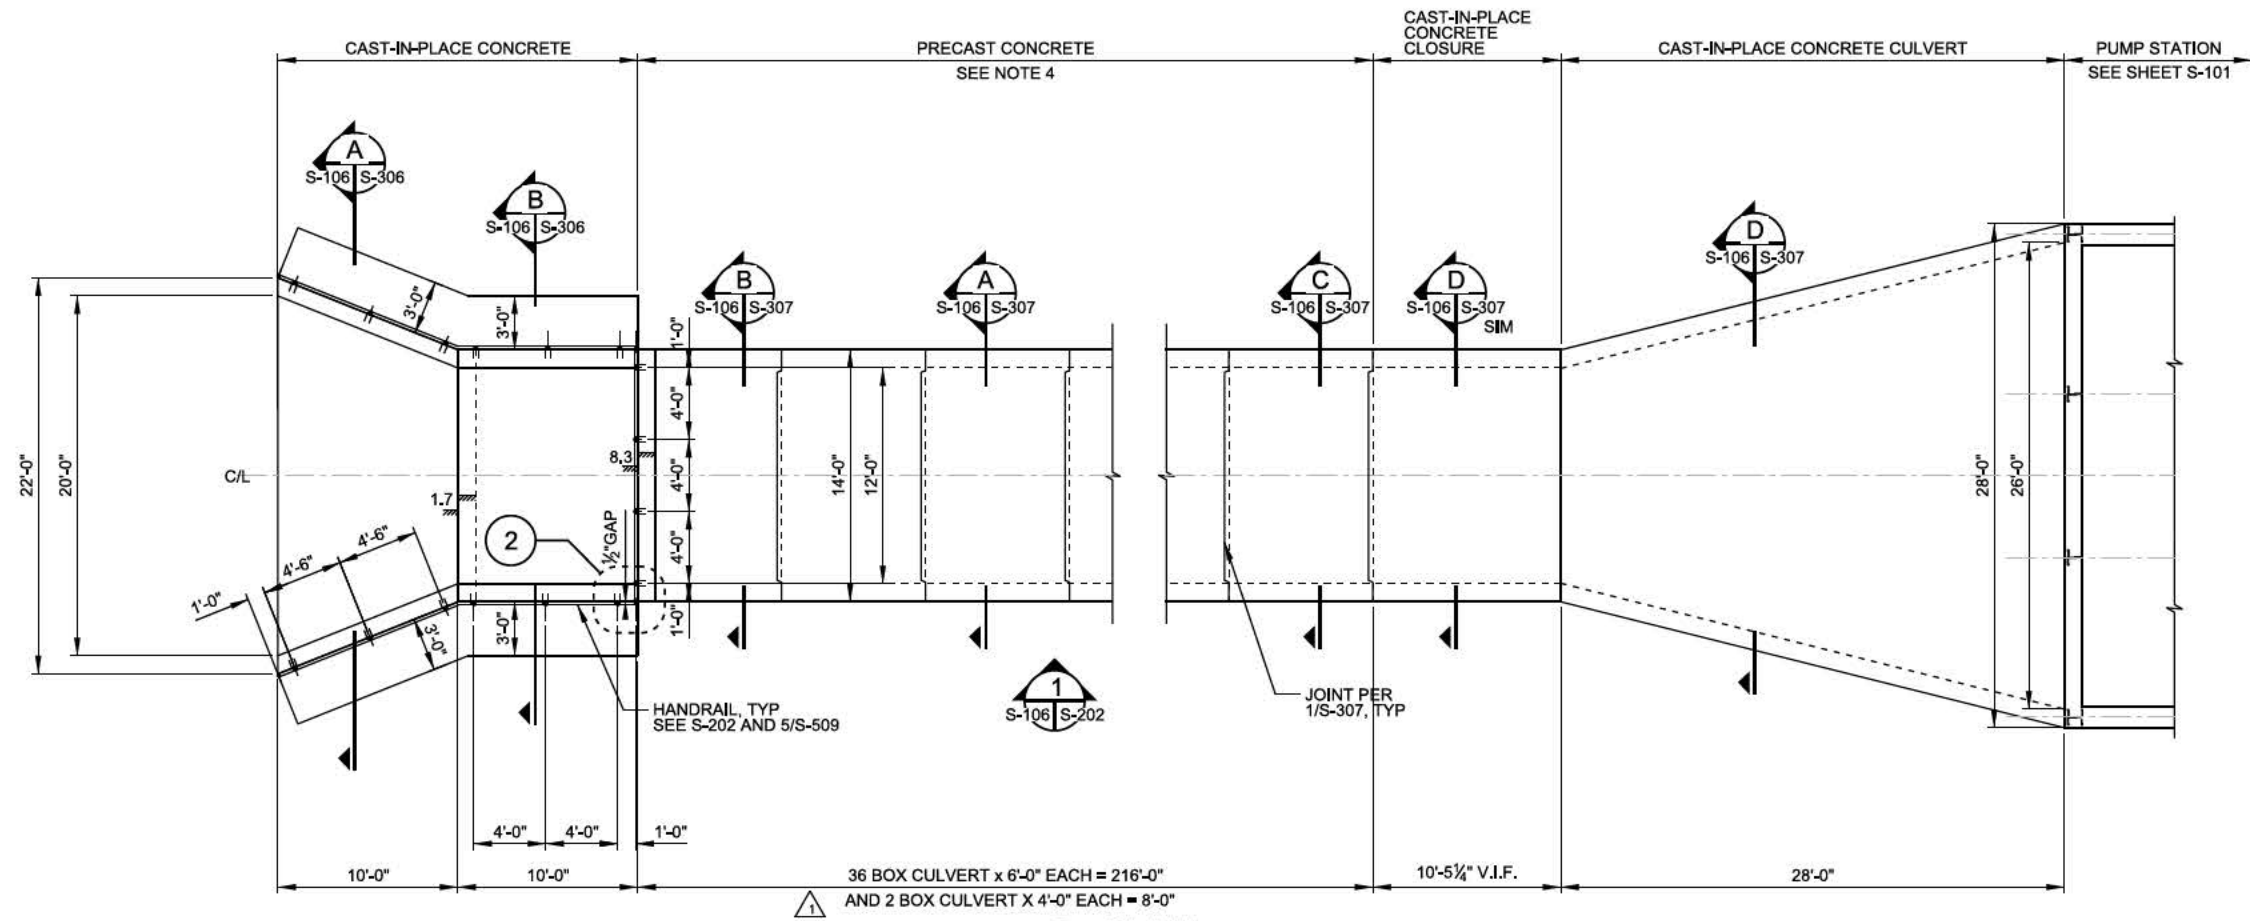


- NOTES:
1. REFER TO C-220 FOR ALL ELEVATIONS.
  2. # INDICATES DROP IN ELEVATIONS, WITH DIMENSIONS IN FEET.
  3. ○ DENOTES BEND OR ELBOW OF HANDRAIL  
□ DENOTES HANDRAIL POST WITH ATTACHMENT TO SLAB/STAIR
  4. CONTRACTOR MAY SUBMIT PRECAST CONCRETE CULVERT IN ACCORDANCE WITH ASTM C1433 FOR GOVERNMENT APPROVAL.

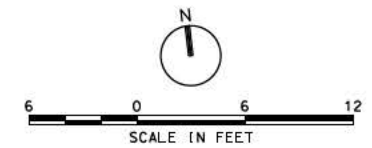


APPR.	DATE
DESCRIPTION	
AS-BUILT AS OF 29 SEPTEMBER 2017	
MARK	
DESIGNED BY:	DATE:
OWN BY:	SOLICITATION NO.:
SUBMITTED BY:	CONTRACT NO.:
AS SHOWN:	PROJECT CODE:
FILE NAME:	FILE ID:
U.S. ARMY CORPS OF ENGINEERS	
ROCK ISLAND DISTRICT	
ROCK ISLAND, ILLINOIS	
ILLINOIS WATERWAY	
LA GRANGE POOL	
FILL RESTORATION	
RICE LAKE HABITAT REHAB & ENHANCEMENT	
STAGE I	
DISCHARGE STRUCTURE	
AND CULVERT PLAN	
Sheet ID	
S-106	
AS-BUILT	
A-63	


c:\pwworking\mmt5\cd\10153734\EP102\_S-107.dgn  
8/28/2018 3:16:28 PM  
BEDDLIN

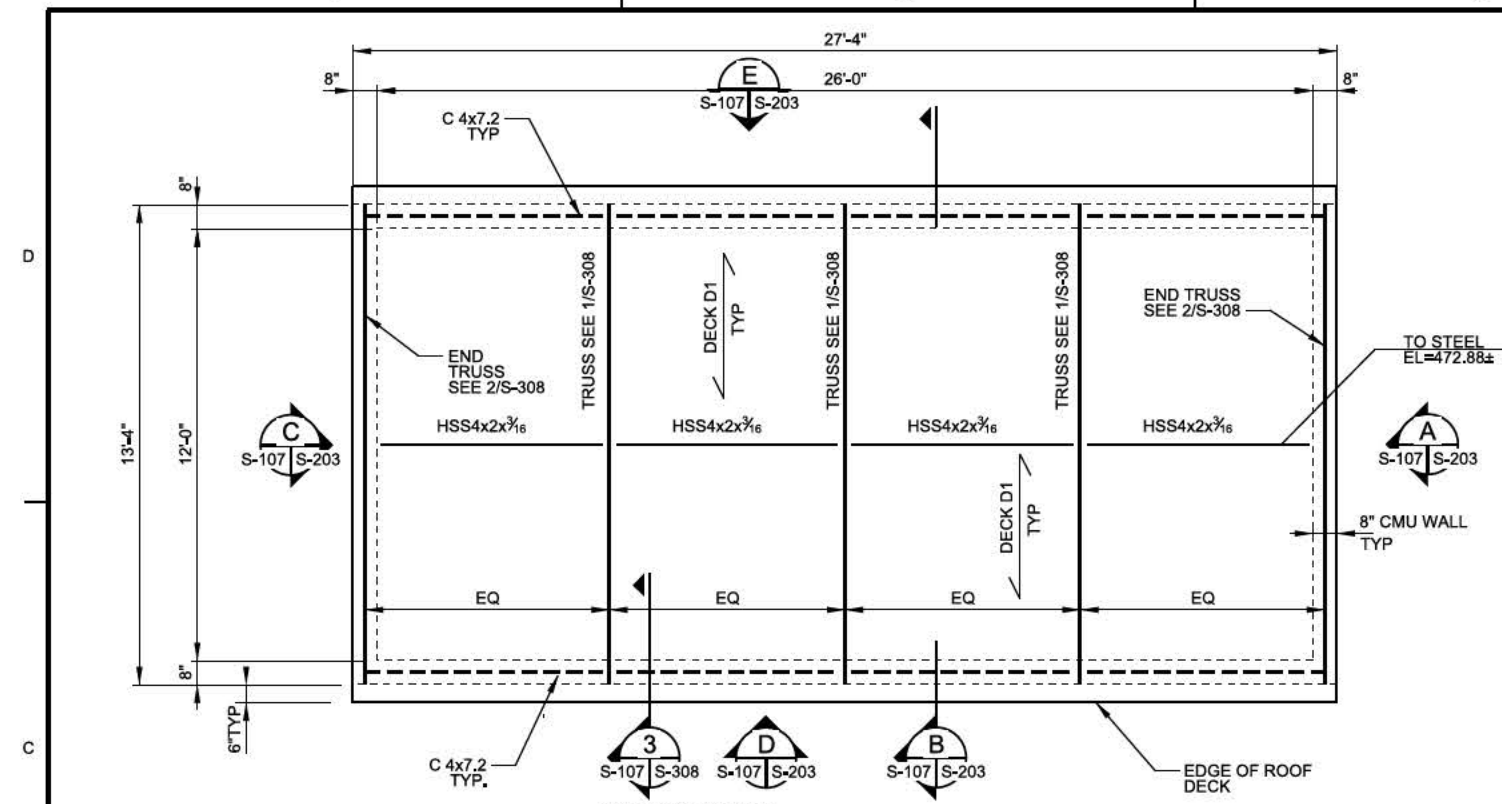

CONTROL BUILDING ROOF PLAN

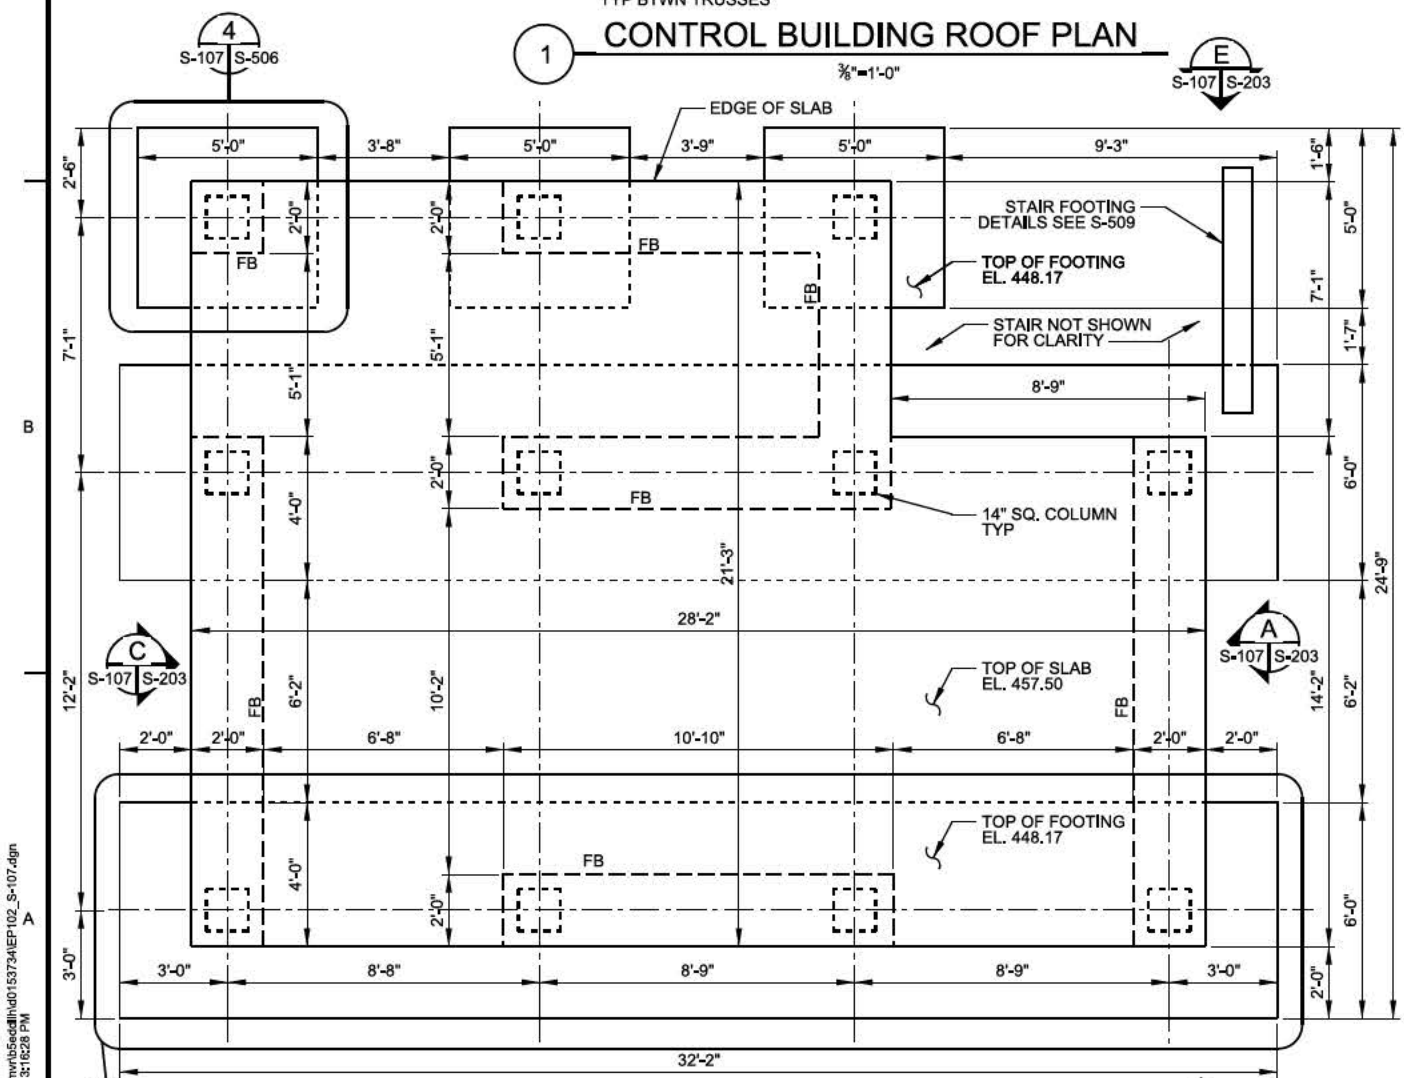

CONTROL BUILDING FOOTING & FOUNDATION PLAN

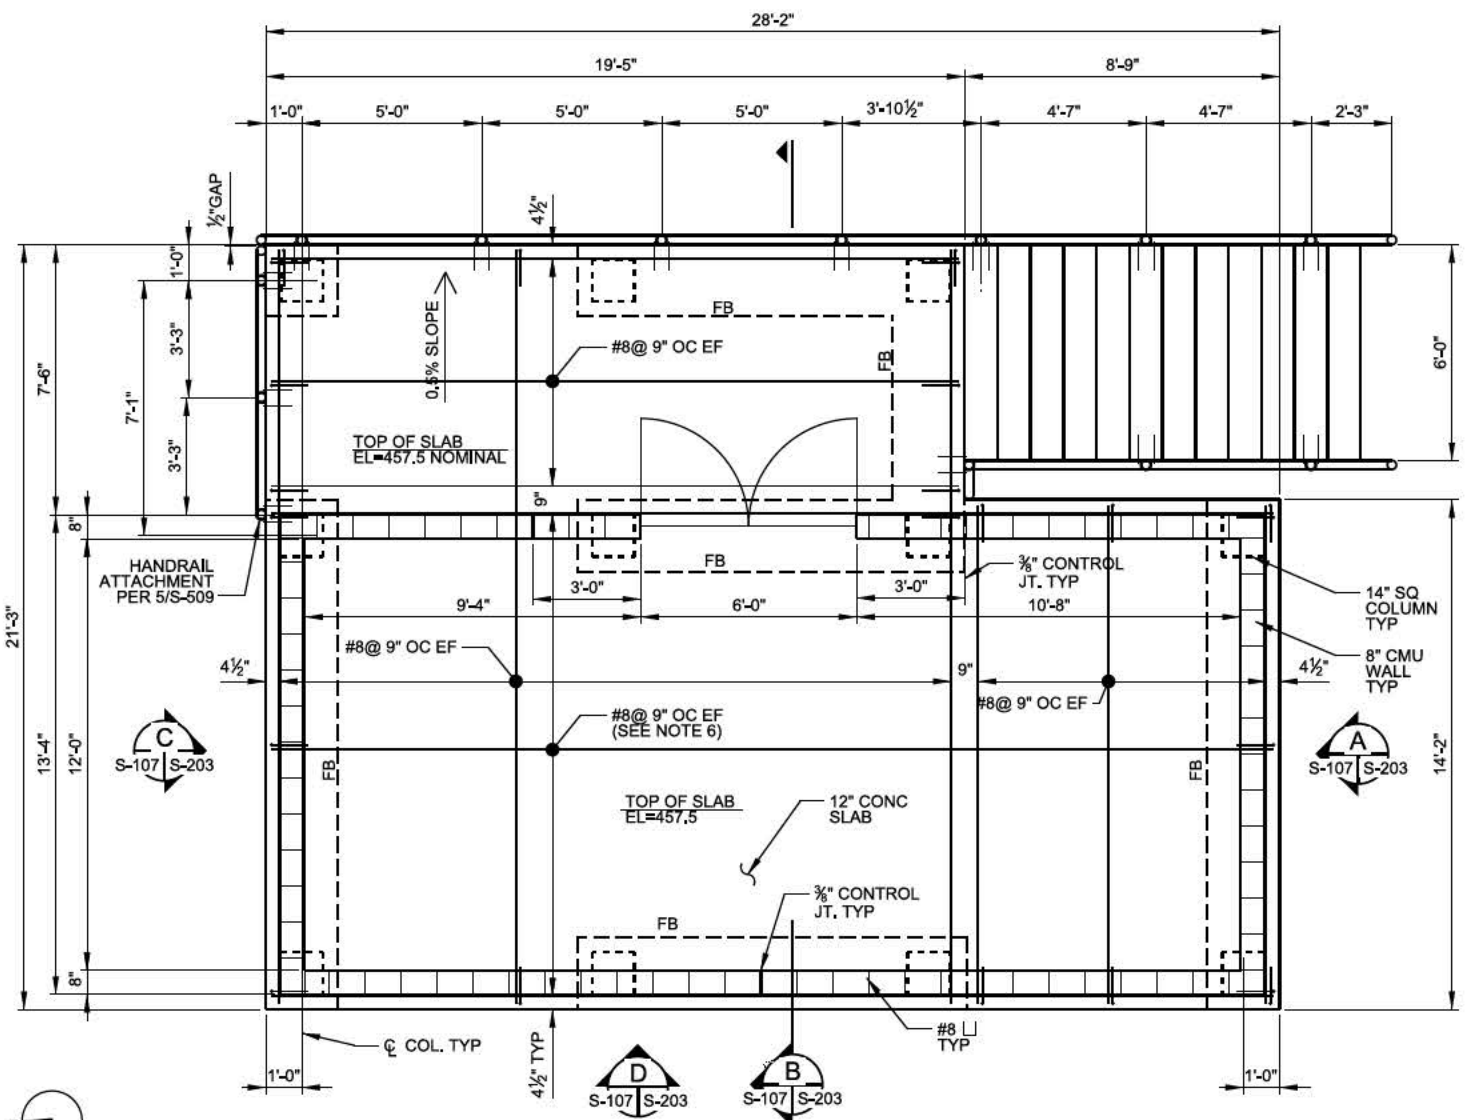

CONTROL BUILDING FOUNDATION PLAN


- NOTES:
1. SEE SHEET S-001 FOR GENERAL NOTES.
  2.  $\triangle D$  INDICATE METAL DECK TYPE, SEE SHEET S-308.
  3. FB DENOTES FRAME BEAM, SEE SHEET S-510.
  4. FOR TRUSS PROFILE, SEE SHEET S-308.
  5. MAXIMUM SPACING FOR HANDRAIL POSTS NOT TO EXCEED 5'-0".
  6. PROVIDE (2) #8 TOP AND BOTTOM AT ALL EDGES OF FLOOR SLAB.
  7.  $\circ$  DENOTES BEND OR ELBOW OF HANDRAIL  
 $\perp$  DENOTES HANDRAIL POST WITH ATTACHMENT TO SLAB/STAIR.

DATE	26-10-2018
APPROVED	
DESIGNED BY	KCP
DRAWN BY	CDY BY:
CHECKED BY	CDY BY:
PROJECT NO.	W032541-1-0000
PROJECT CODE	EP102
FILE NAME	EP102_S-107
ANALYST	ANALYST
U.S. ARMY CORPS OF ENGINEERS ROCK ISLAND DISTRICT ROCK ISLAND, ILLINOIS	
ILLINOIS WATERWAY LAGRANGE, ILLINOIS RICE LAKE HABITAT REHAB & ENHANCEMENT STAGE I CONTROL BUILDING PLAN	
Sheet ID S-107	
AS-BUILT A-64	





SECTION @ EL 432.0 FT

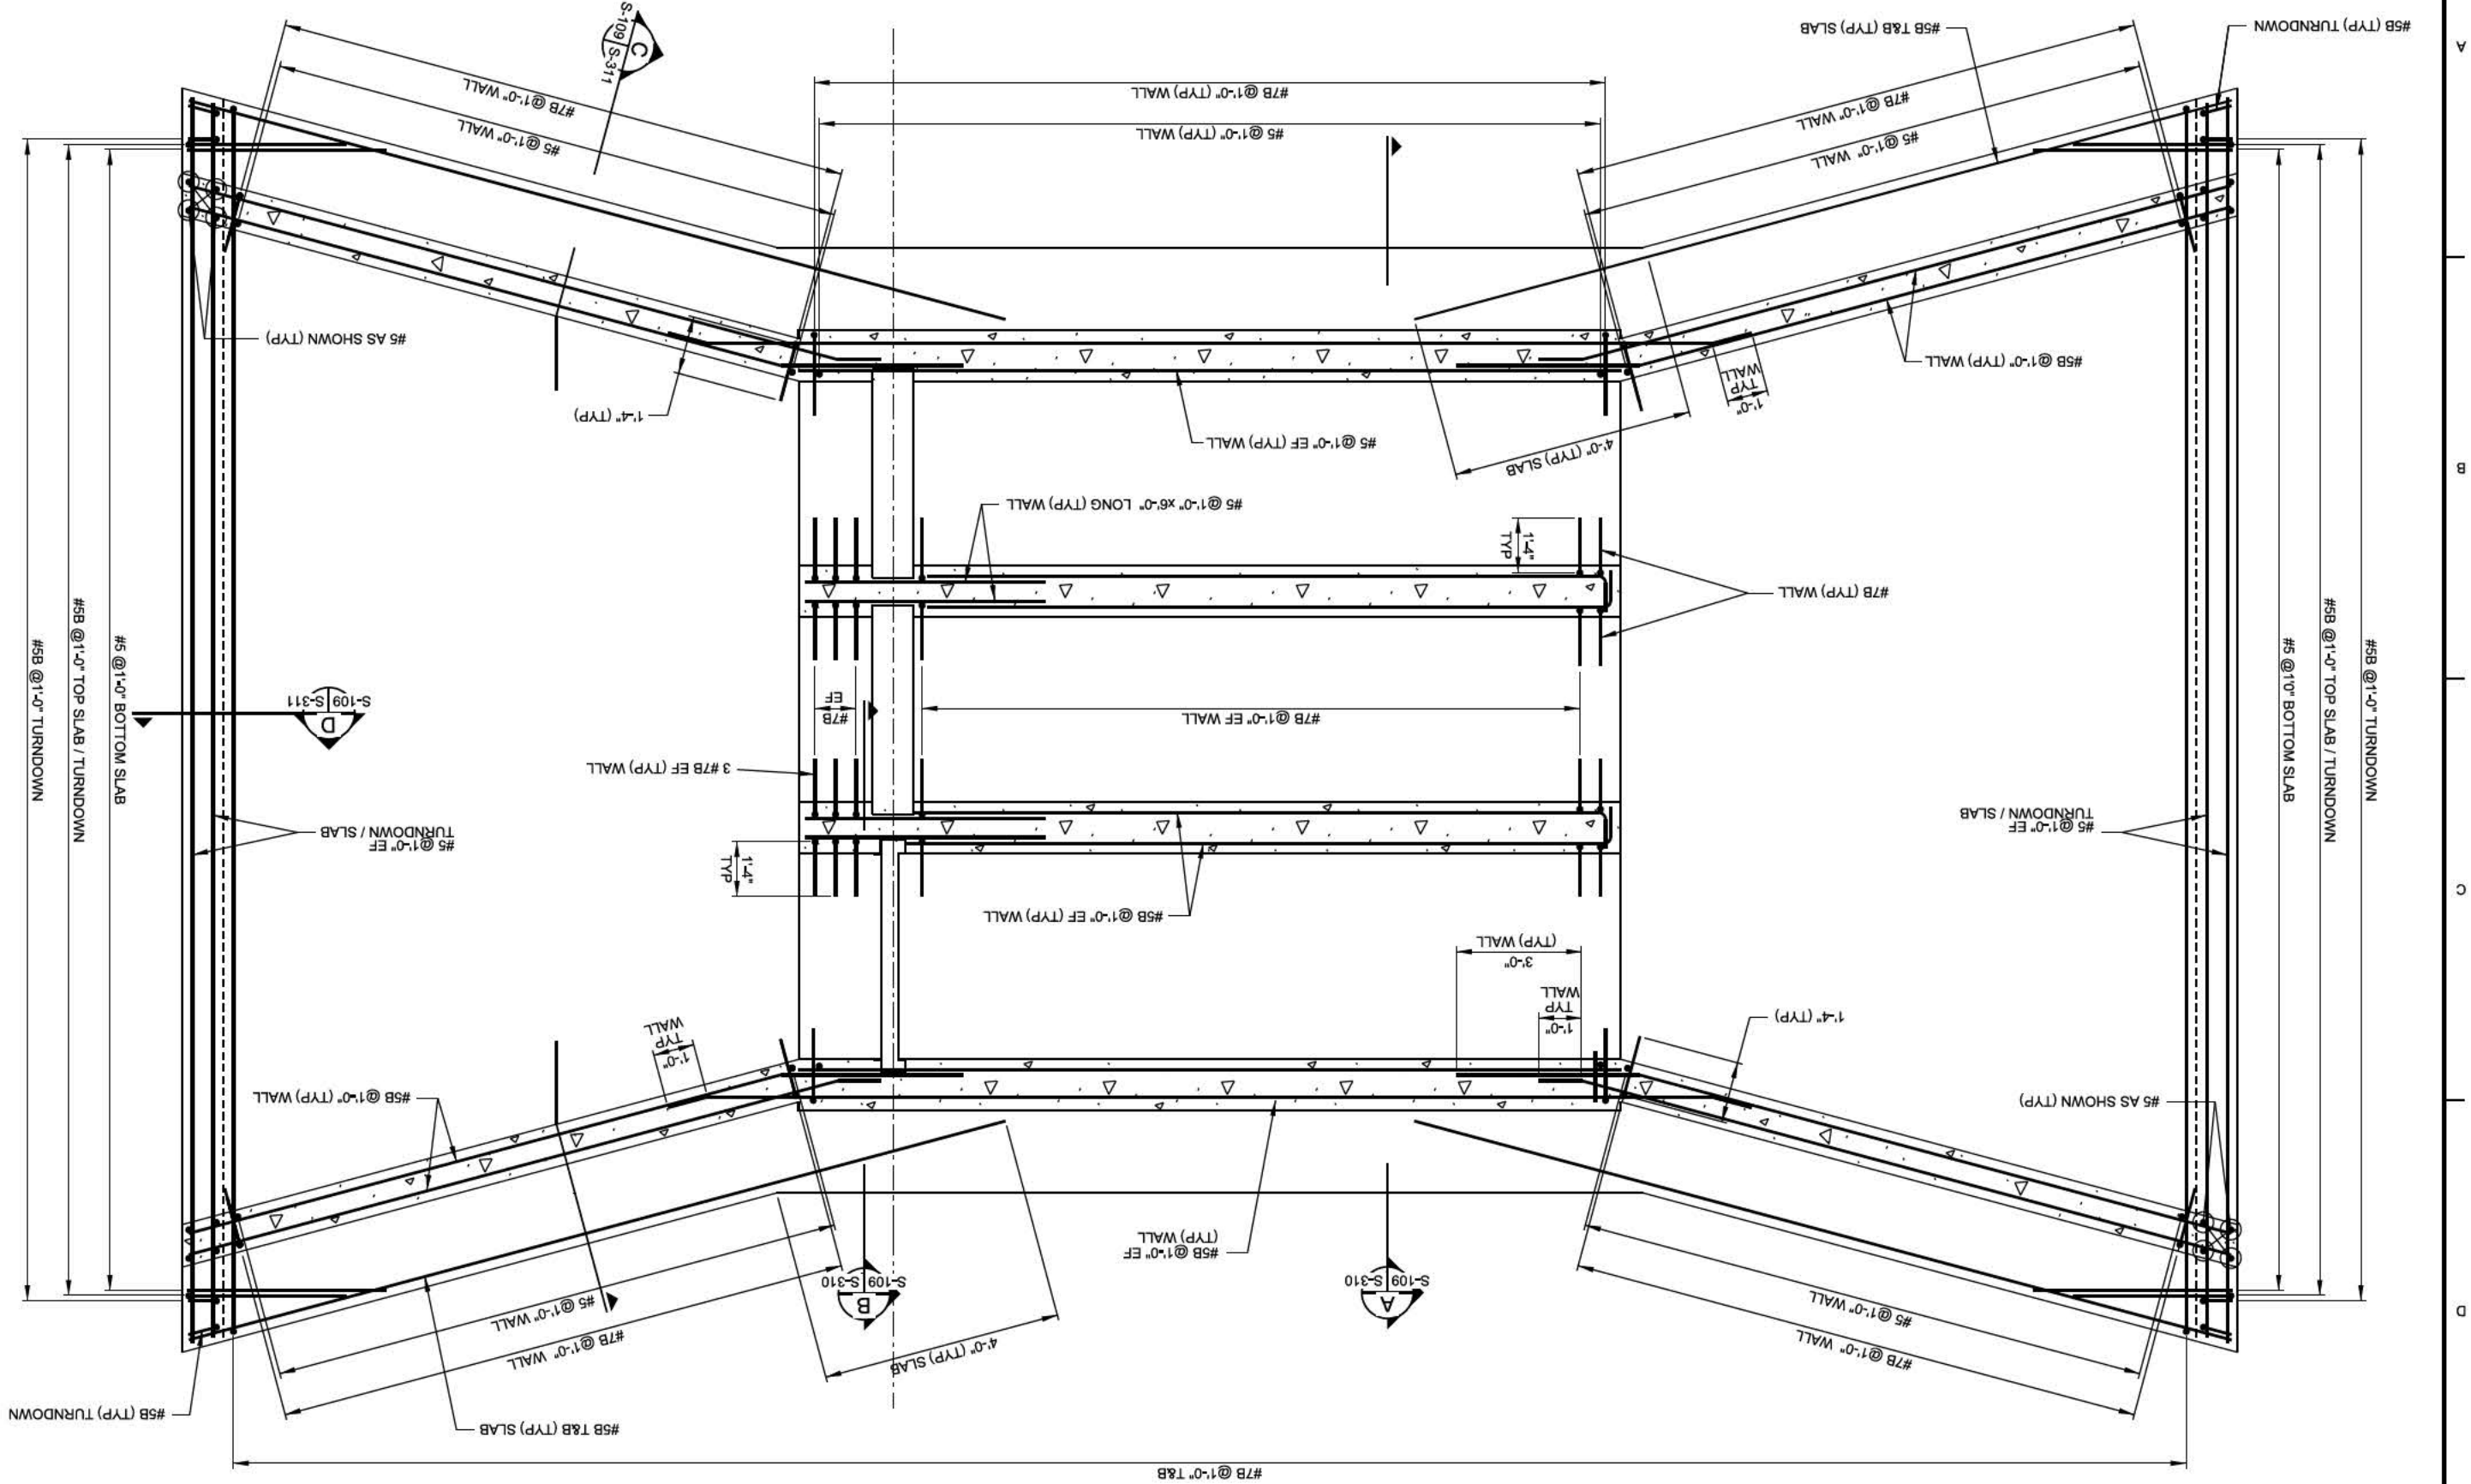

EF = EACH FACE  
T&B = TOP AND BOTTOM

SCALE IN FEET  
0 4

S-109

Sheet ID

AS-BUILT

A-66

ILLINOIS WATERWAY  
LAWANOE POOL  
FLOODING AND  
OUTLET STRUCTURE  
CONCRETE  
REINFORCEMENT  
PLAN

U.S. ARMY CORPS OF ENGINEERS  
ROCK ISLAND DISTRICT  
ROCK ISLAND, ILLINOIS

DESIGNED BY:	DATE:
CHKD BY:	20110608
REVIEWED BY:	20110608
PROJECT CODE:	EP102

MARK	DESCRIPTION	DATE
AS-BUILT	AS OF 29 SEPTEMBER 2017	APRIL

SIZE	FILE NAME:	PROJECT CODE:
AS SHOWN	EP102_2-109.dgn	EP102












c:\pwworking\mmt5ecad\h0153734\EP102\_S-203.dgn  
8/28/2018 3:17:15 PM  
BEDDLH

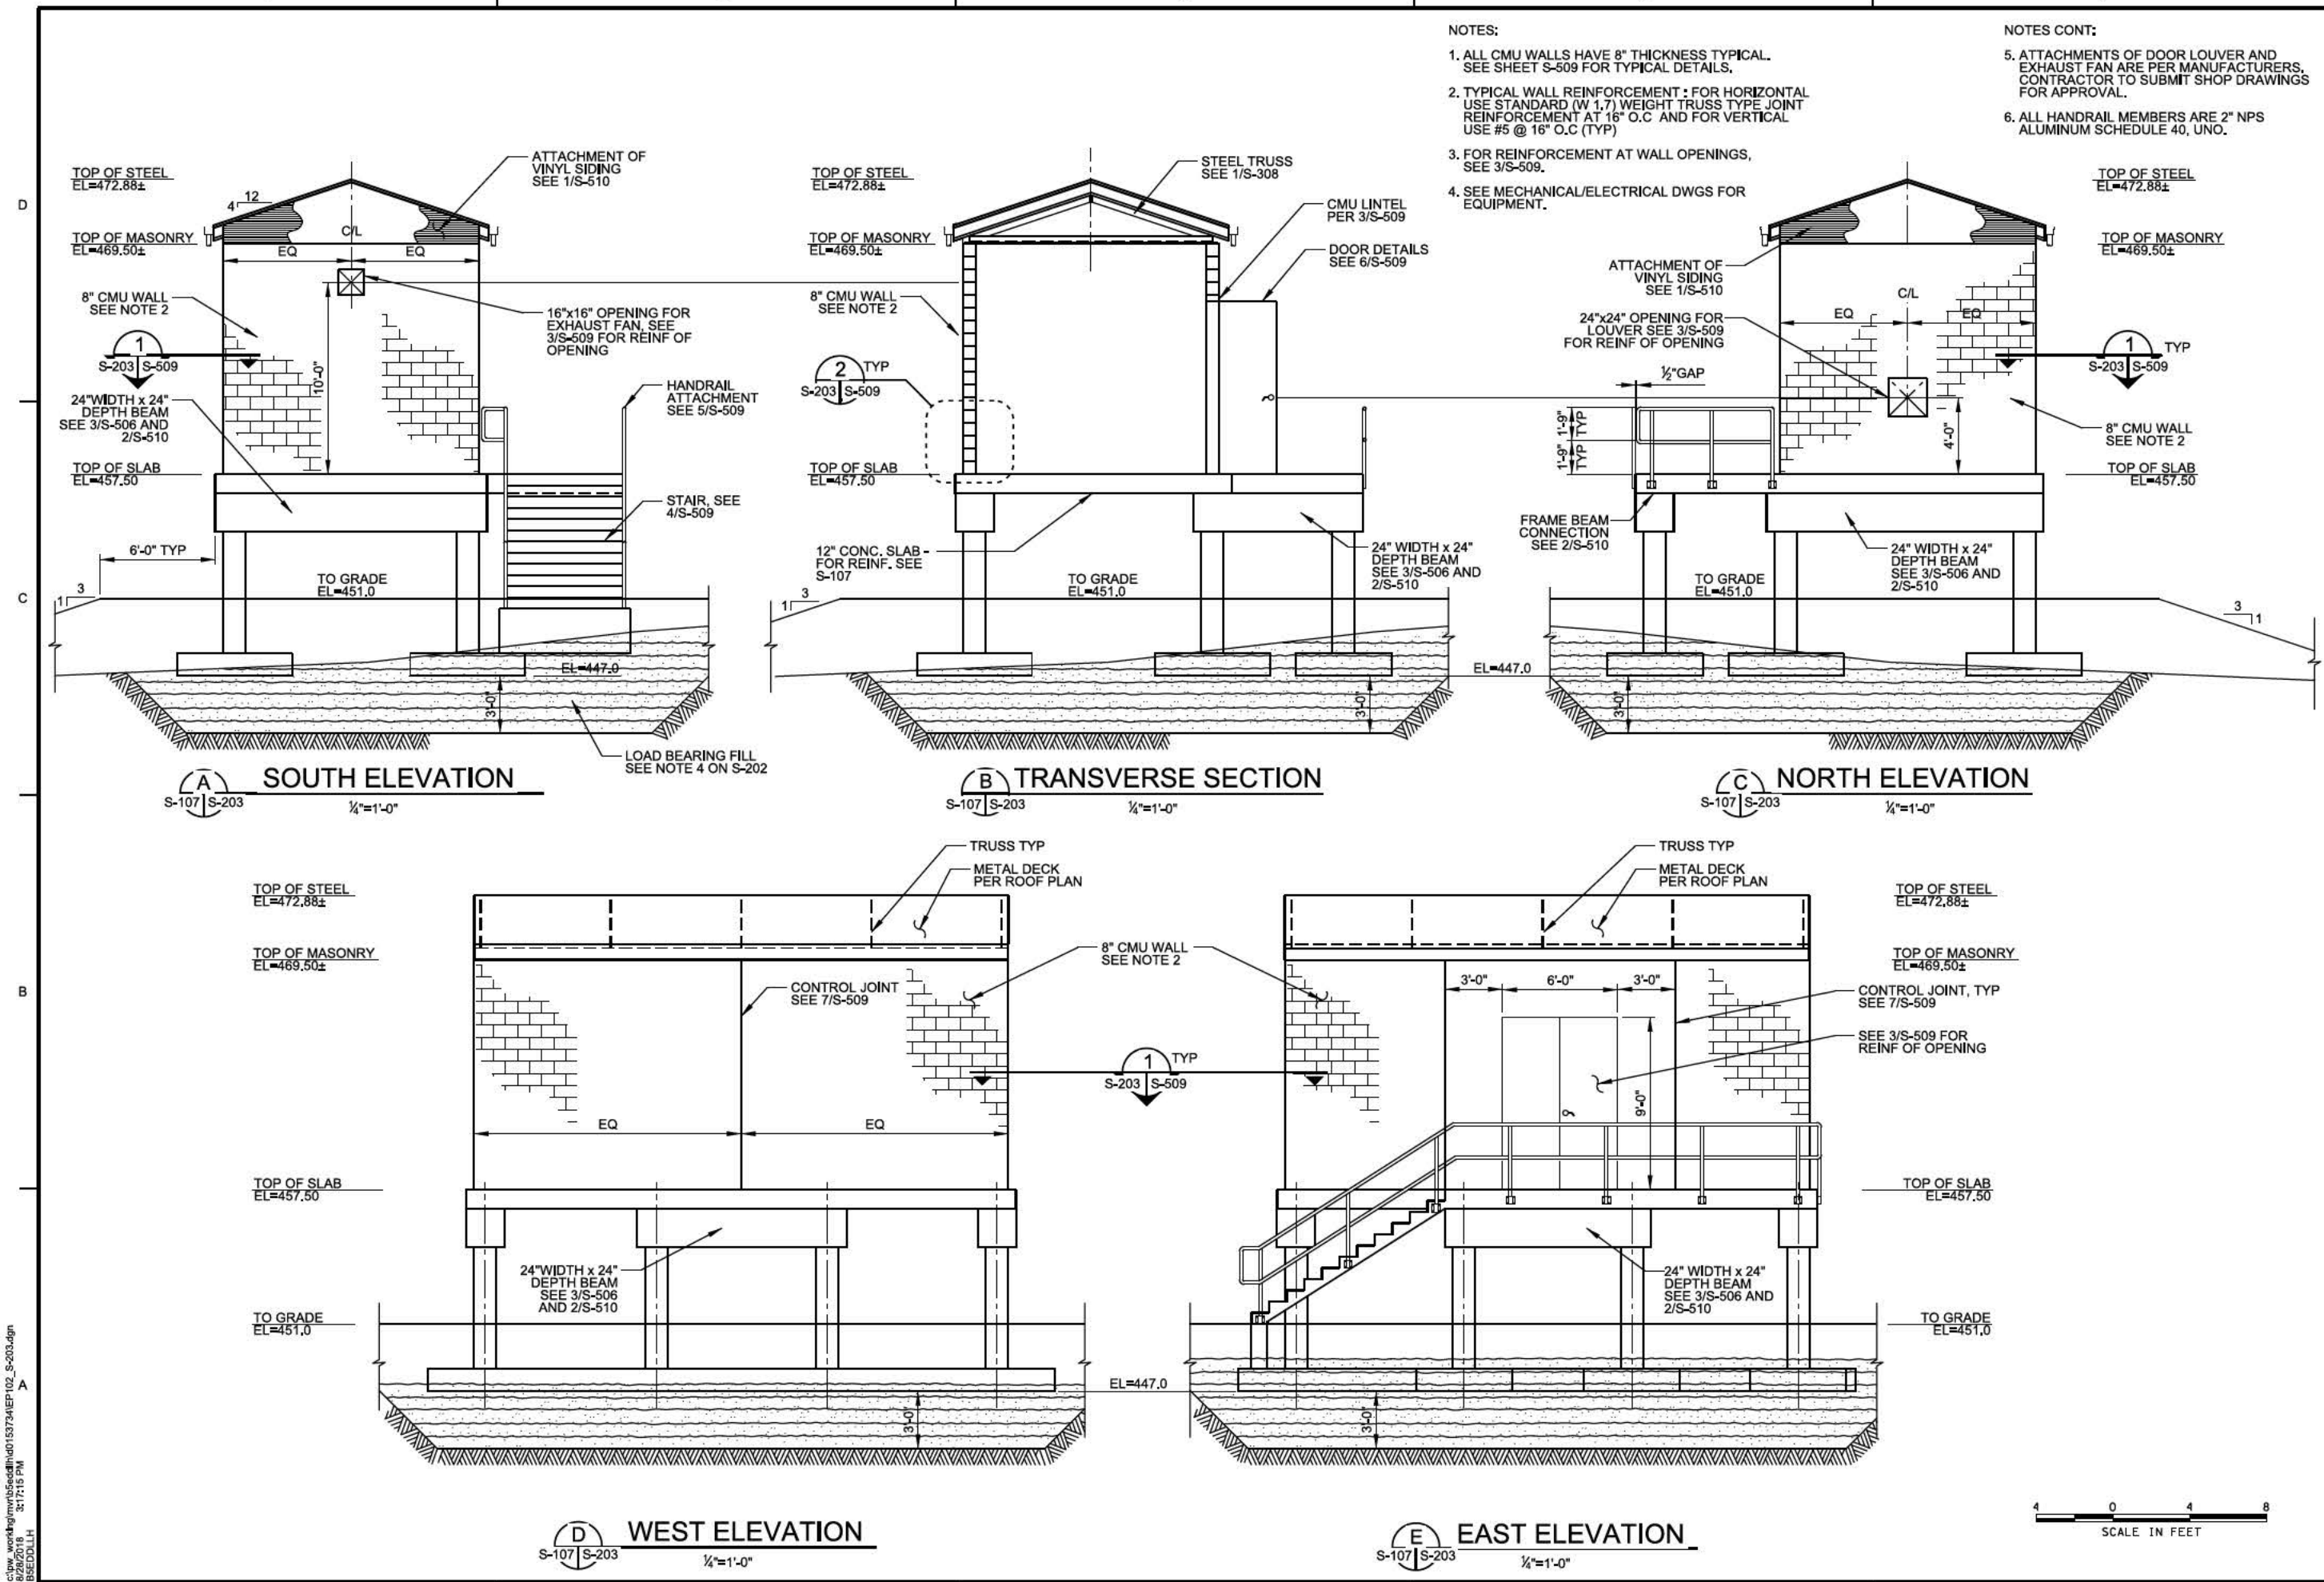

US Army Corps of Engineers	
APPROVED	DATE
DESCRIPTION	
AS-BUILT AS OF 29 SEPTEMBER 2017	
DATE: 26/10/2018	SOLICITATION NO.: 153734
DESIGNED BY: KCP	CHKD BY: JRU
U.S. ARMY CORPS OF ENGINEERS	PROJECT NO.: W032541-2-0000
ROCK ISLAND DISTRICT	PROJECT CODE: EP102
ROCK ISLAND, ILLINOIS	FILE NAME: EP102_S-203.dgn
ILLINOIS WATERWAY	SIZE: A3
LAGRANGE POOL	AN3 D
FLORISSANT POOL	
RICE LAKE HABITAT REHAB & ENHANCEMENT	
STAGE 1	
CONTROL BUILDING	
ELEVATIONS	
AND SECTION	
Sheet ID	
S-203	
AS-BUILT	
A-69	


[illegible]

U.S. ARMY CORPS OF ENGINEERS		ISSUED BY:		2011/06/30	
ROCK ISLAND DISTRICT		OWN BY:		SOLICITATION NO.:	
ROCK ISLAND, ILLINOIS		DOP		WY-25C-14-0029	
		SUBMITTED BY:		CONTRACT NO.:	
				WY-25C-14-0086	
		PRO SCALE:		PROJECT CODE:	
		AS SHOWN		EP102	
		SLOT DATE:			
		SIZE:		FILE NAME:	
		A4E1 D		EP102_50-00-000	


ILLINOIS WATERWAY  
LAGRANGE POOL  
FULTON COUNTY, IL  
RICE LAKE HABITAT REHAB & ENHANCEMENT  
STAGE I  
OUTLET STRUCTURE  
ELEVATIONS

Sheet  
ID  
S-204


AS-BUILT  
A-70

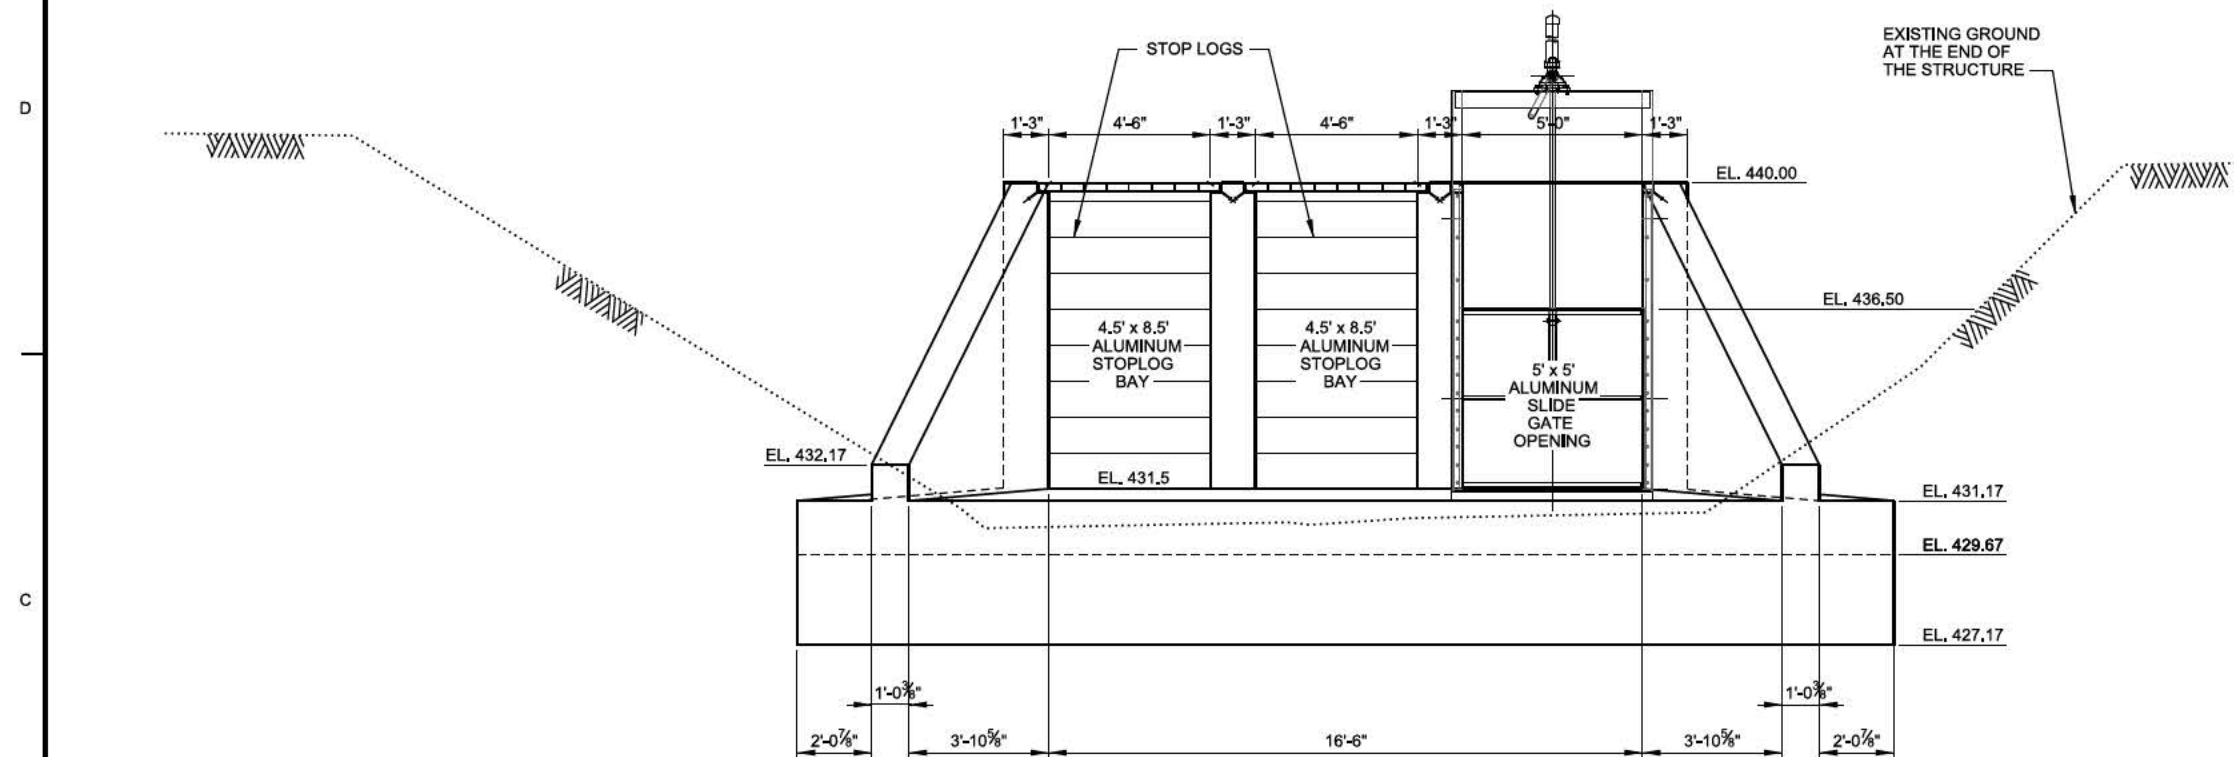

**ELEVATION - RIVER SIDE**

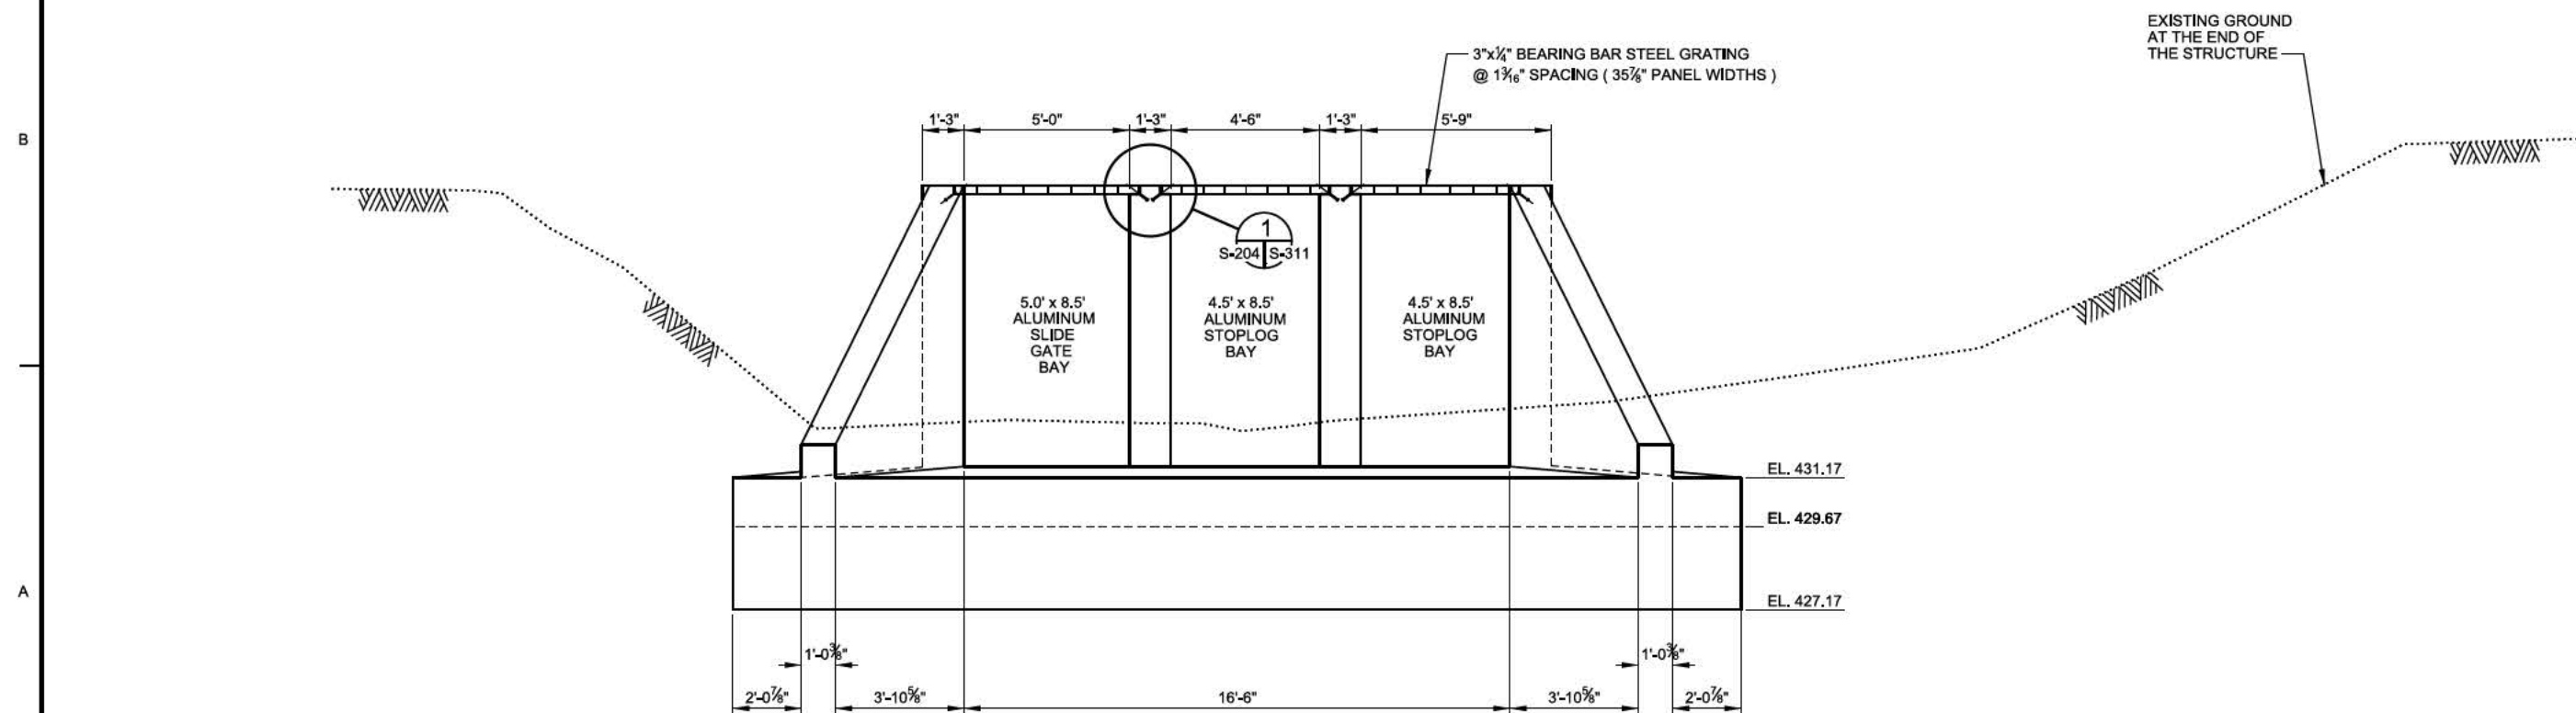

**ELEVATION - LAND SIDE**

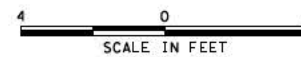








MARK	DATE	DESCRIPTION
1	5/22/2012	MOD E4005 - ADD SURGE BASIN WALLS, MODIFY PIPE OPENINGS, ADD SLAB BEAM, AS-BUILT AS OF 29 SEPTEMBER 2017

DESIGNED BY: KCP	DATE: 2/1/2008	SOLICITATION NO.:
DWN BY: JRU	CHK BY:	CONTRACT NO.:
SUBMITTED BY:	PROJECT CODE:	CONTRACT NO.:
PLT SCALE:	PLT DATE:	PROJECT CODE:
AS SHOWN	FILE NAME:	AS-BUILT
AS-BUILT	FILE NAME:	AS-BUILT

ILLINOIS WATERWAY  
LAGRANGE POOL  
RICE LAKE HABITAT REPAIR & ENHANCEMENT  
STAGE I  
PUMP STATION  
REINFORCEMENT

Sheet  
ID  
**S-302**

AS-BUILT  
A-72

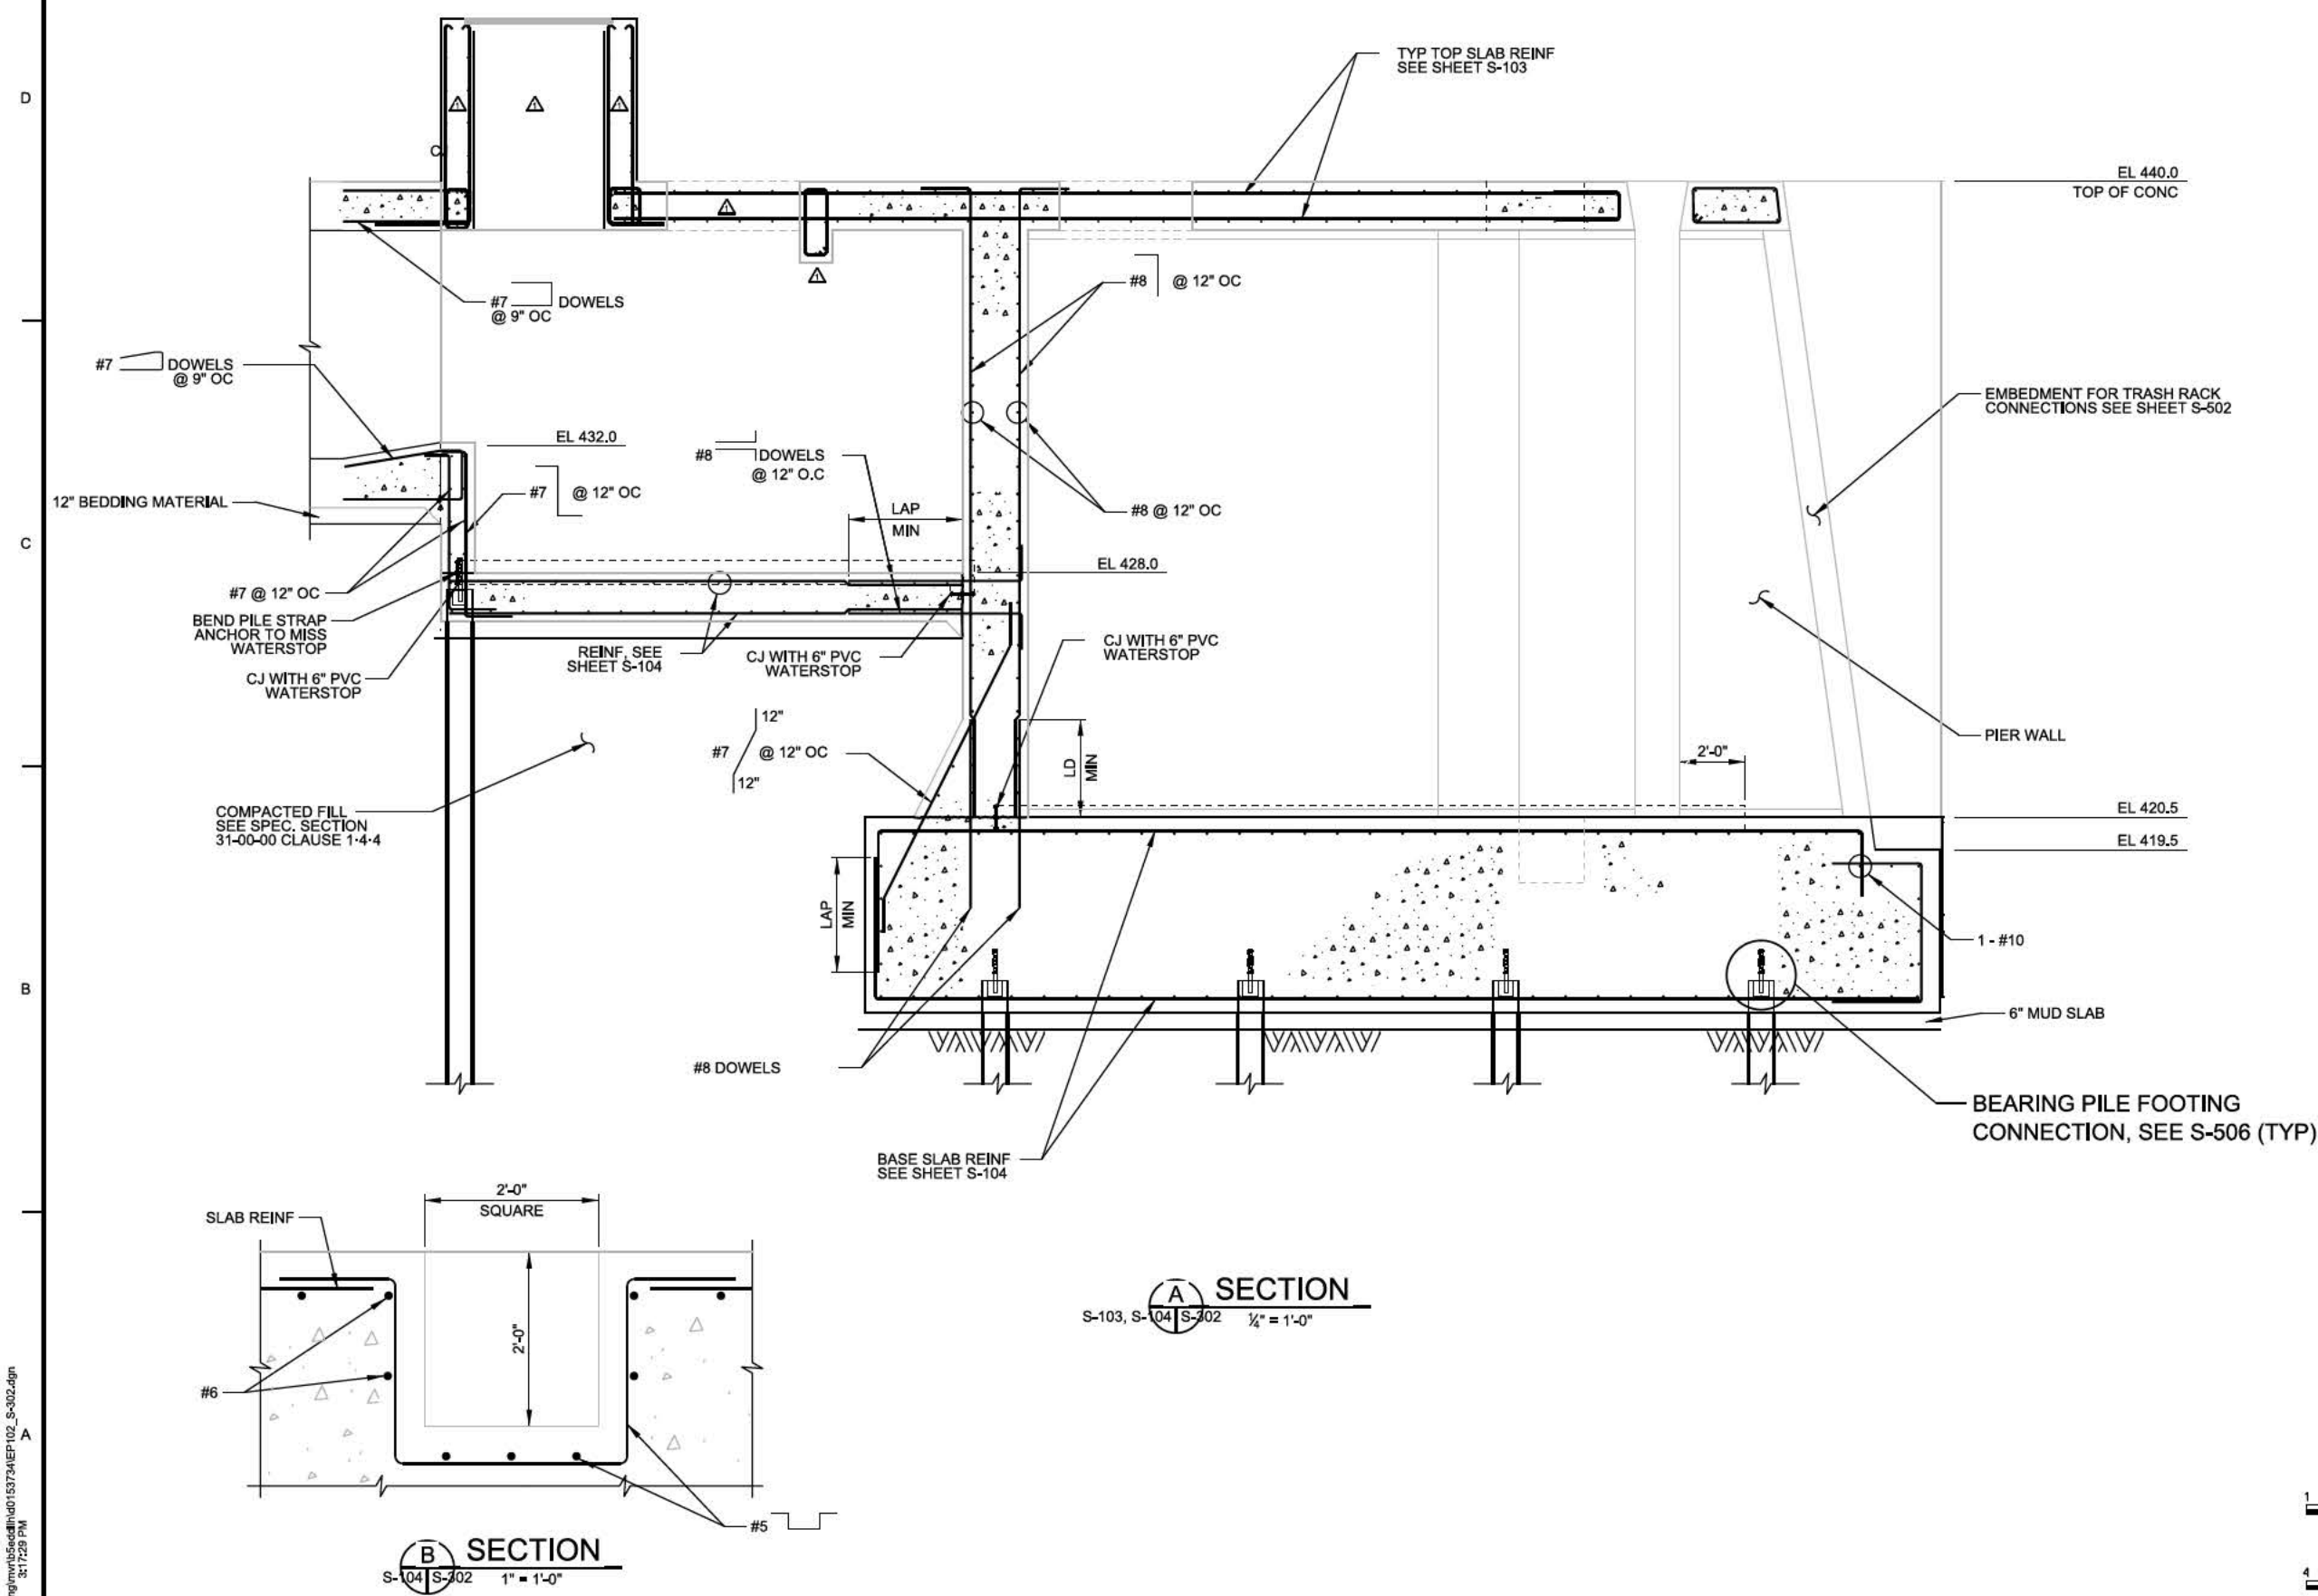

c:\pwworking\mmt5\cadd\15373\AEP102\_S-302.dgn  
8/28/2018 3:17:23 PM  
BEDDLN














US Army Corps of Engineers

B

C

D

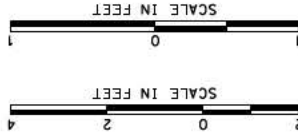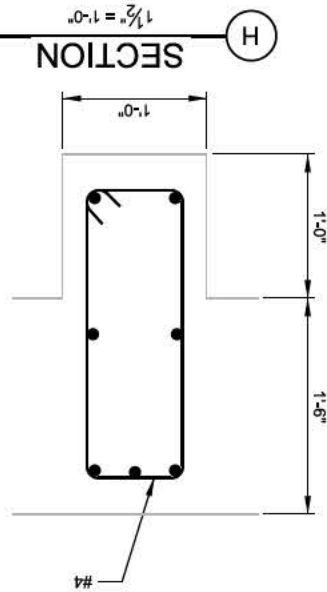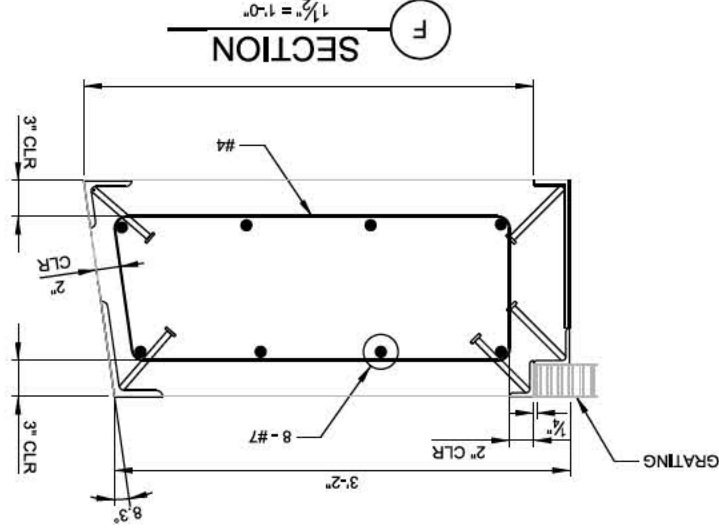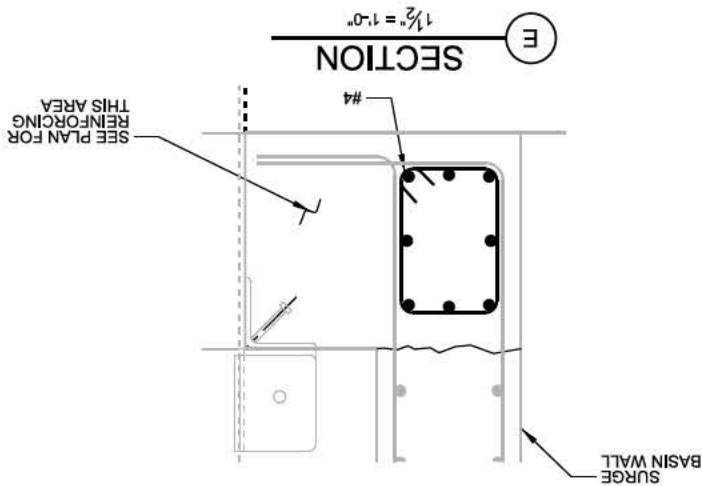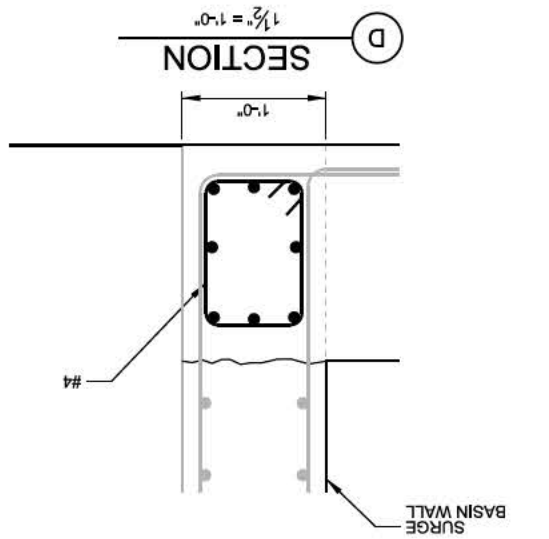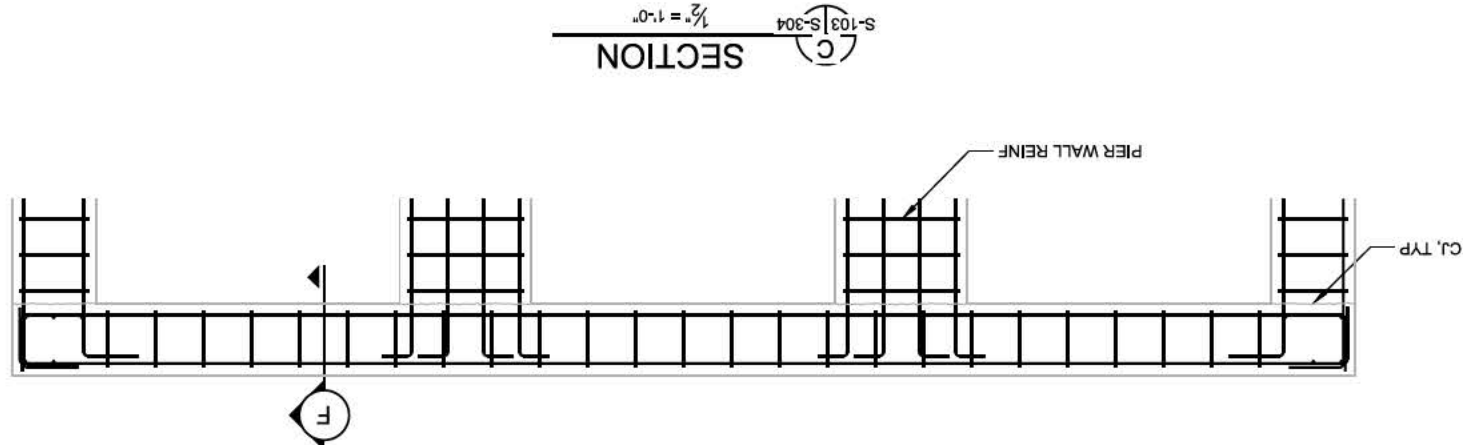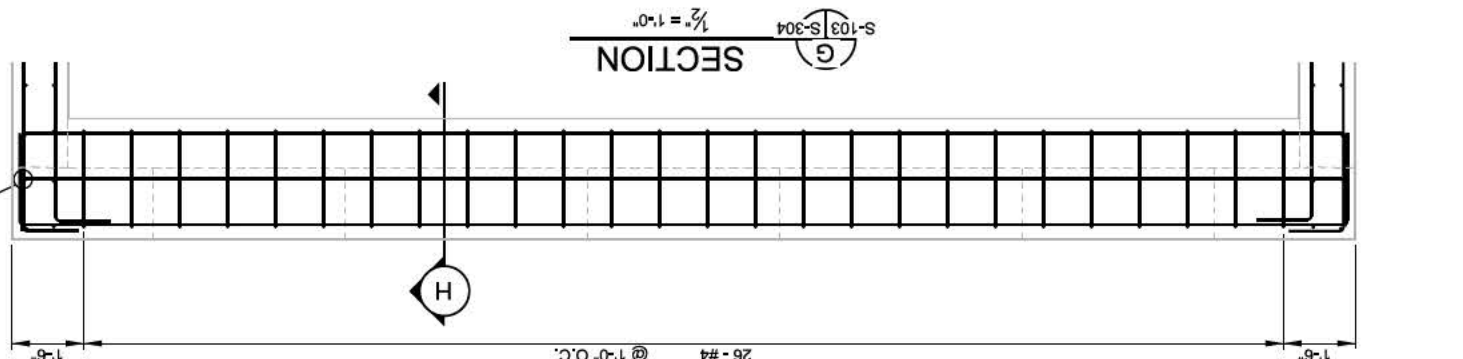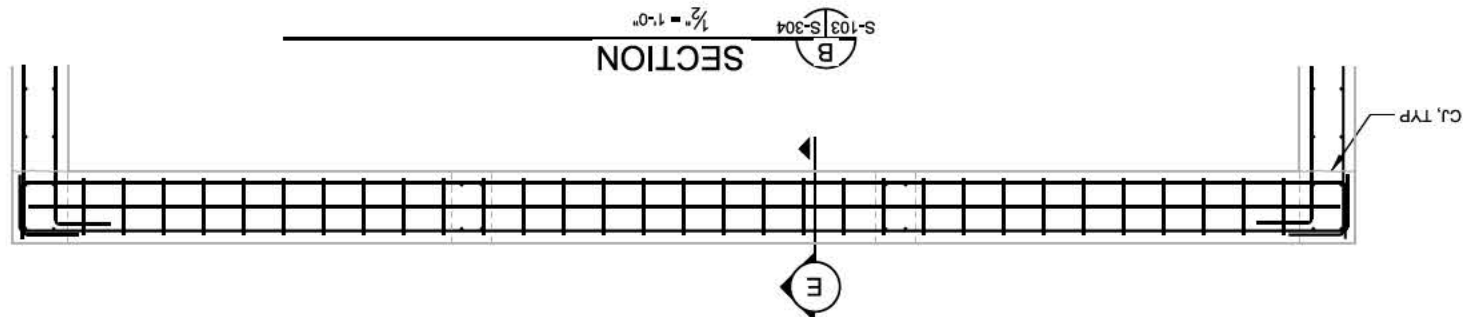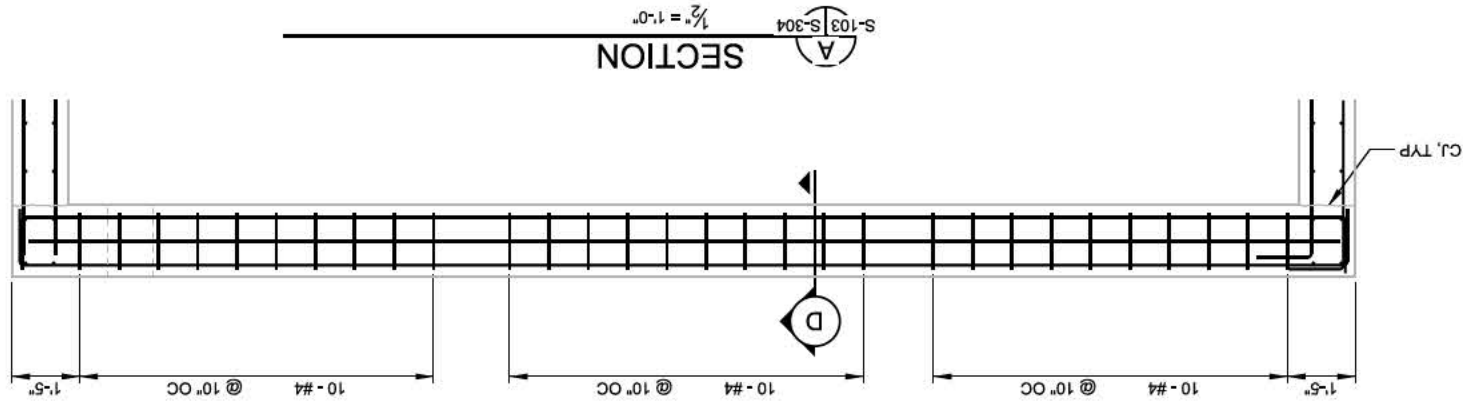

Sheet  
S-304

ILLINOIS WATERWAY  
LANSING POOL  
FLOOD WALL REPAIR & ENHANCEMENT  
PUMP STATION  
REINFORCEMENT  
IN BEAMS

U.S. ARMY CORPS OF ENGINEERS  
ROCK ISLAND DISTRICT  
ROCK ISLAND, ILLINOIS


DESIGNED BY:	DATE:
WCO	2/11/2018
CHK BY:	SOULIER/NO.1
REVIEWED BY:	WCO/NO.2
APPROVED BY:	WCO/NO.3
DATE:	2/11/2018
PROJECT CODE:	EP102

MARK	DESCRIPTION	DATE	APPROVED
1	WCO EX-005 - ADD 5. AB BEAM, AS-BUILT AS OF 28 SEPTEMBER 2017	5/22/2017	CD







c:\pwworking\mmt5\cd\153734\EP102\_S-305.dgn  
8/28/2018 3:17:52 PM  
BEDDLH

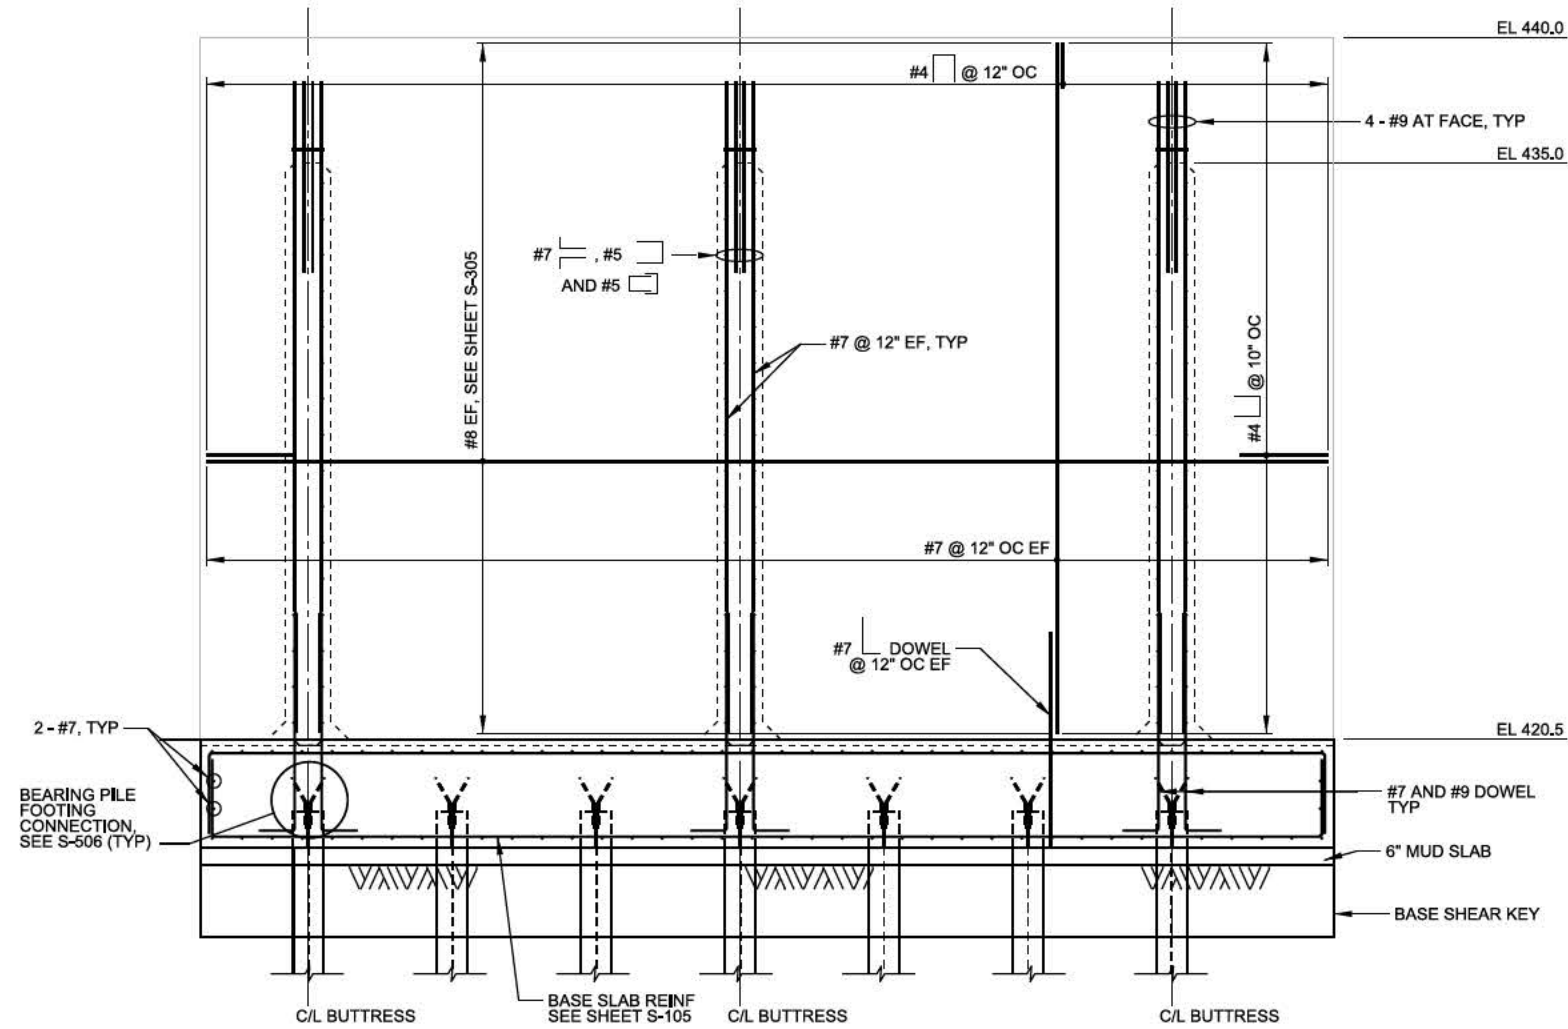


**A** SECTION  
S-105 | S-305  $\frac{3}{8}'' = 1'-0''$

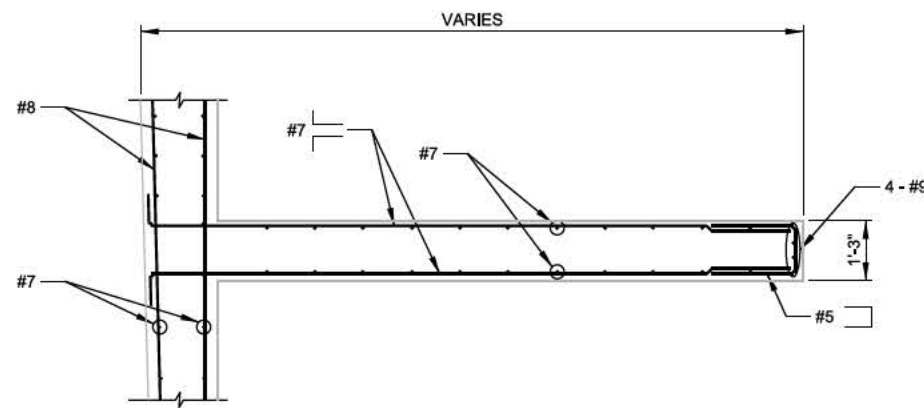

**C** SECTION TYPICAL AT MID HEIGHT  
 $\frac{1}{2}'' = 1'-0''$

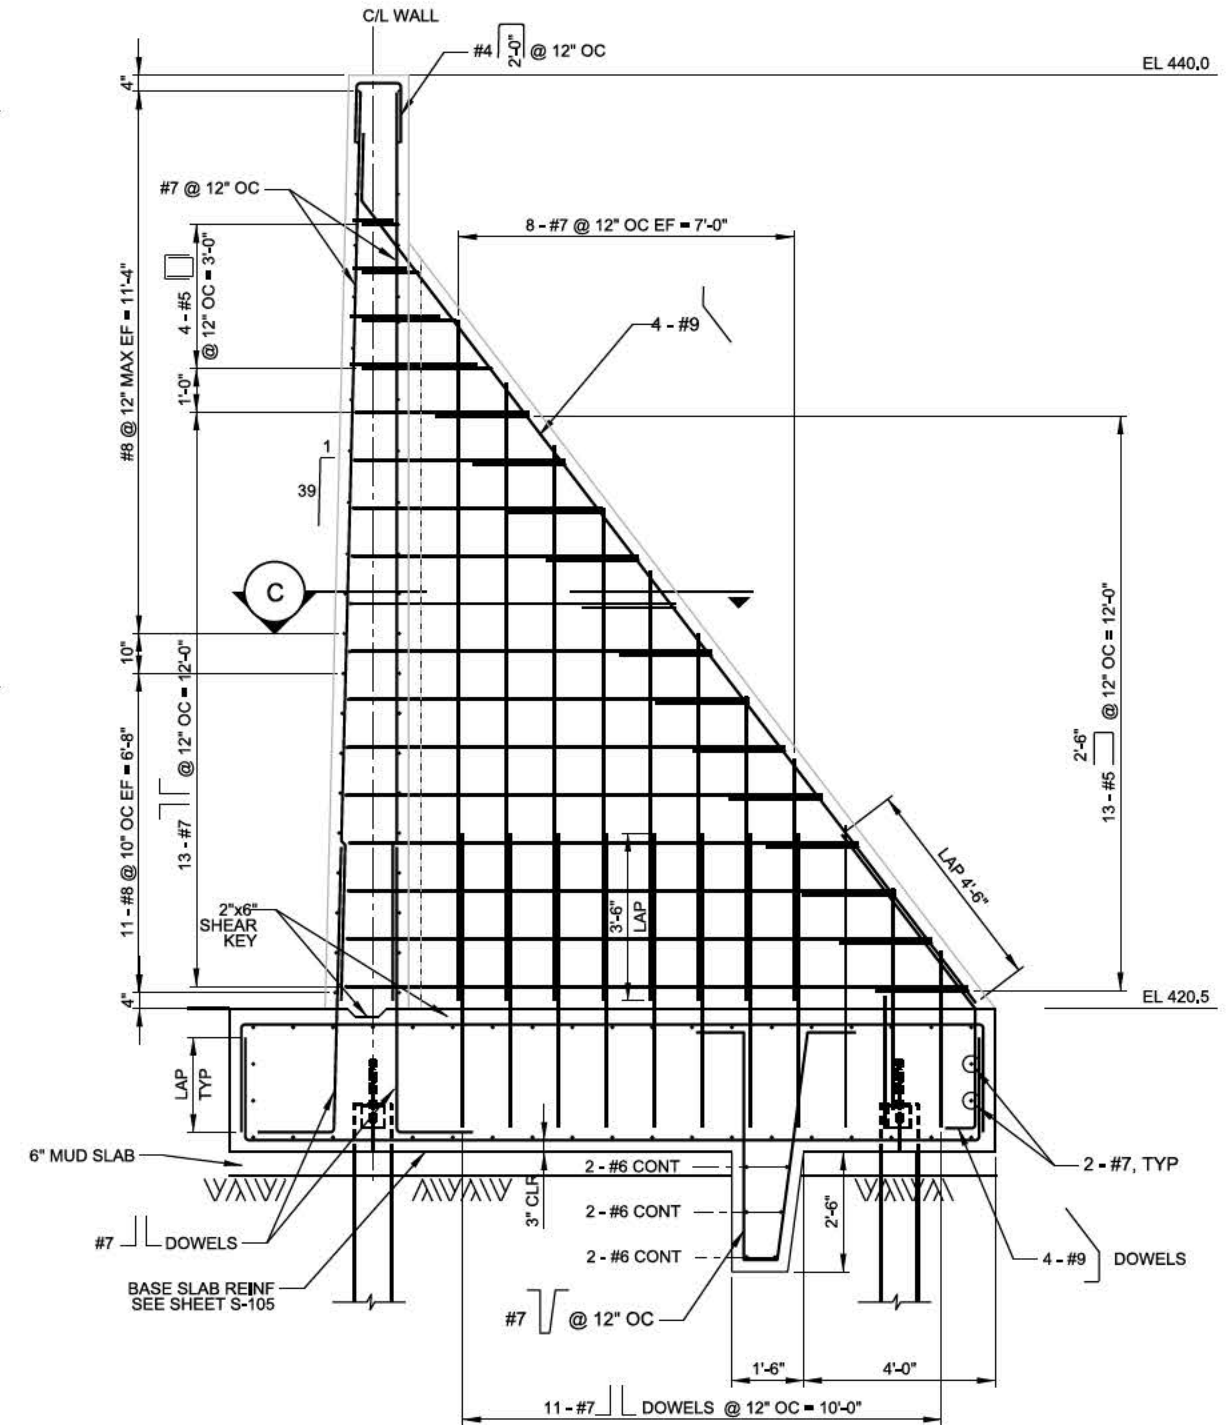

**B** SECTION  
S-105 | S-305  $\frac{1}{2}'' = 1'-0''$

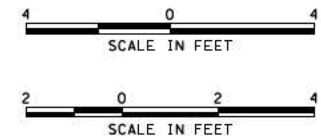

US Army Corps  
of Engineers



APPR.	DATE	DESCRIPTION
AS-BUILT	AS OF 28 SEPTEMBER 2017	

DESIGNED BY: KCP	DATE: 26-10-2016	SOLICITATION NO.:
DWN BY: KCP	CHK BY:	CONTRACT NO.:
SUBMITTED BY: RJR	PROJECT CODE:	PROJECT NAME:
AS SHOWN	FILE NAME:	FILE D:

ILLINOIS WATERWAY  
LAGRANGE POOL  
FILLING PROJECT  
RICE LAKE HABITAT REHAB & ENHANCEMENT  
STAGE I  
PUMP STATION  
WING WALL REINFORCEMENT

Sheet  
ID  
**S-305**

AS-BUILT  
A-75

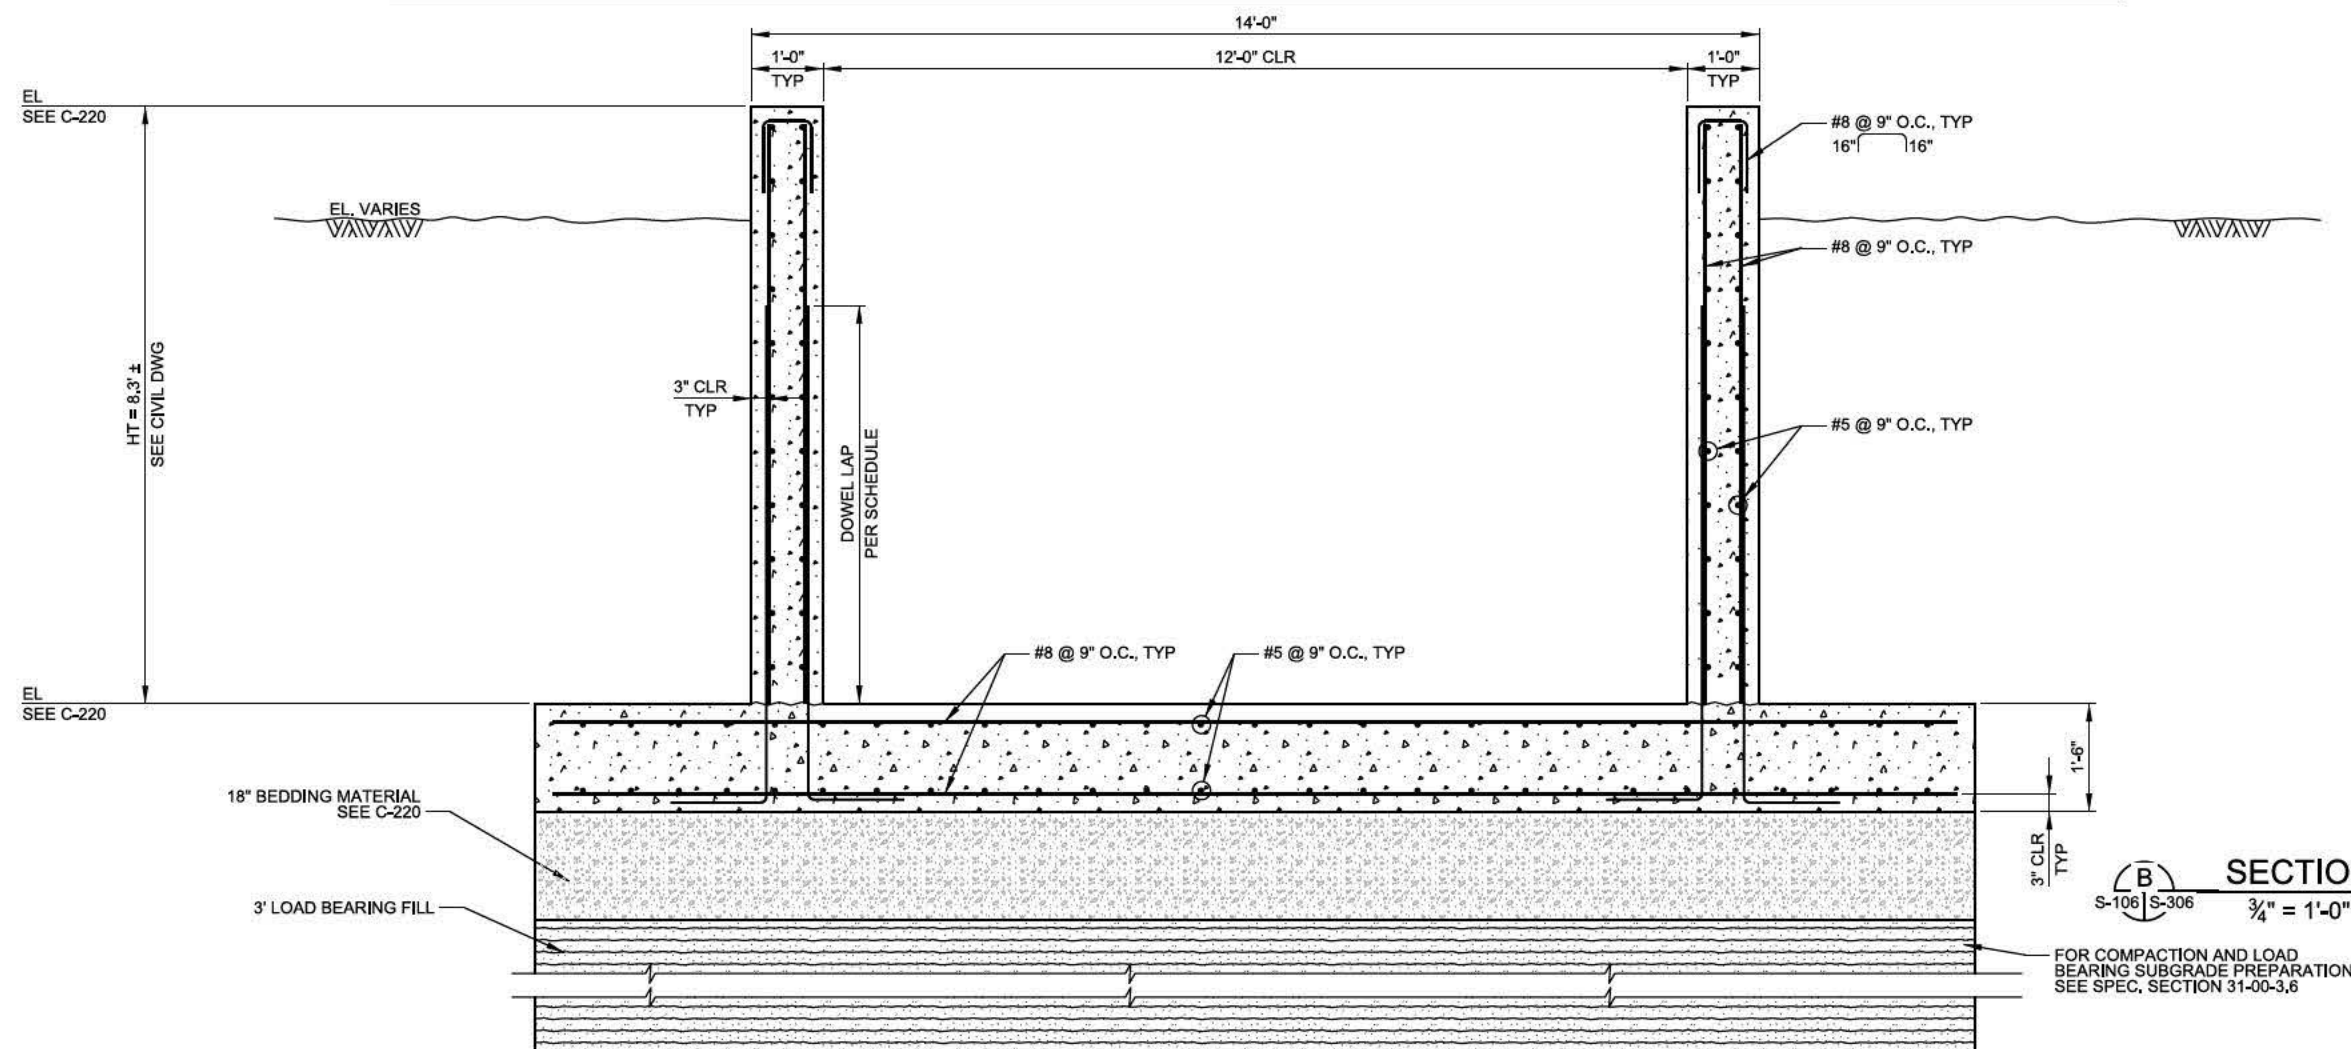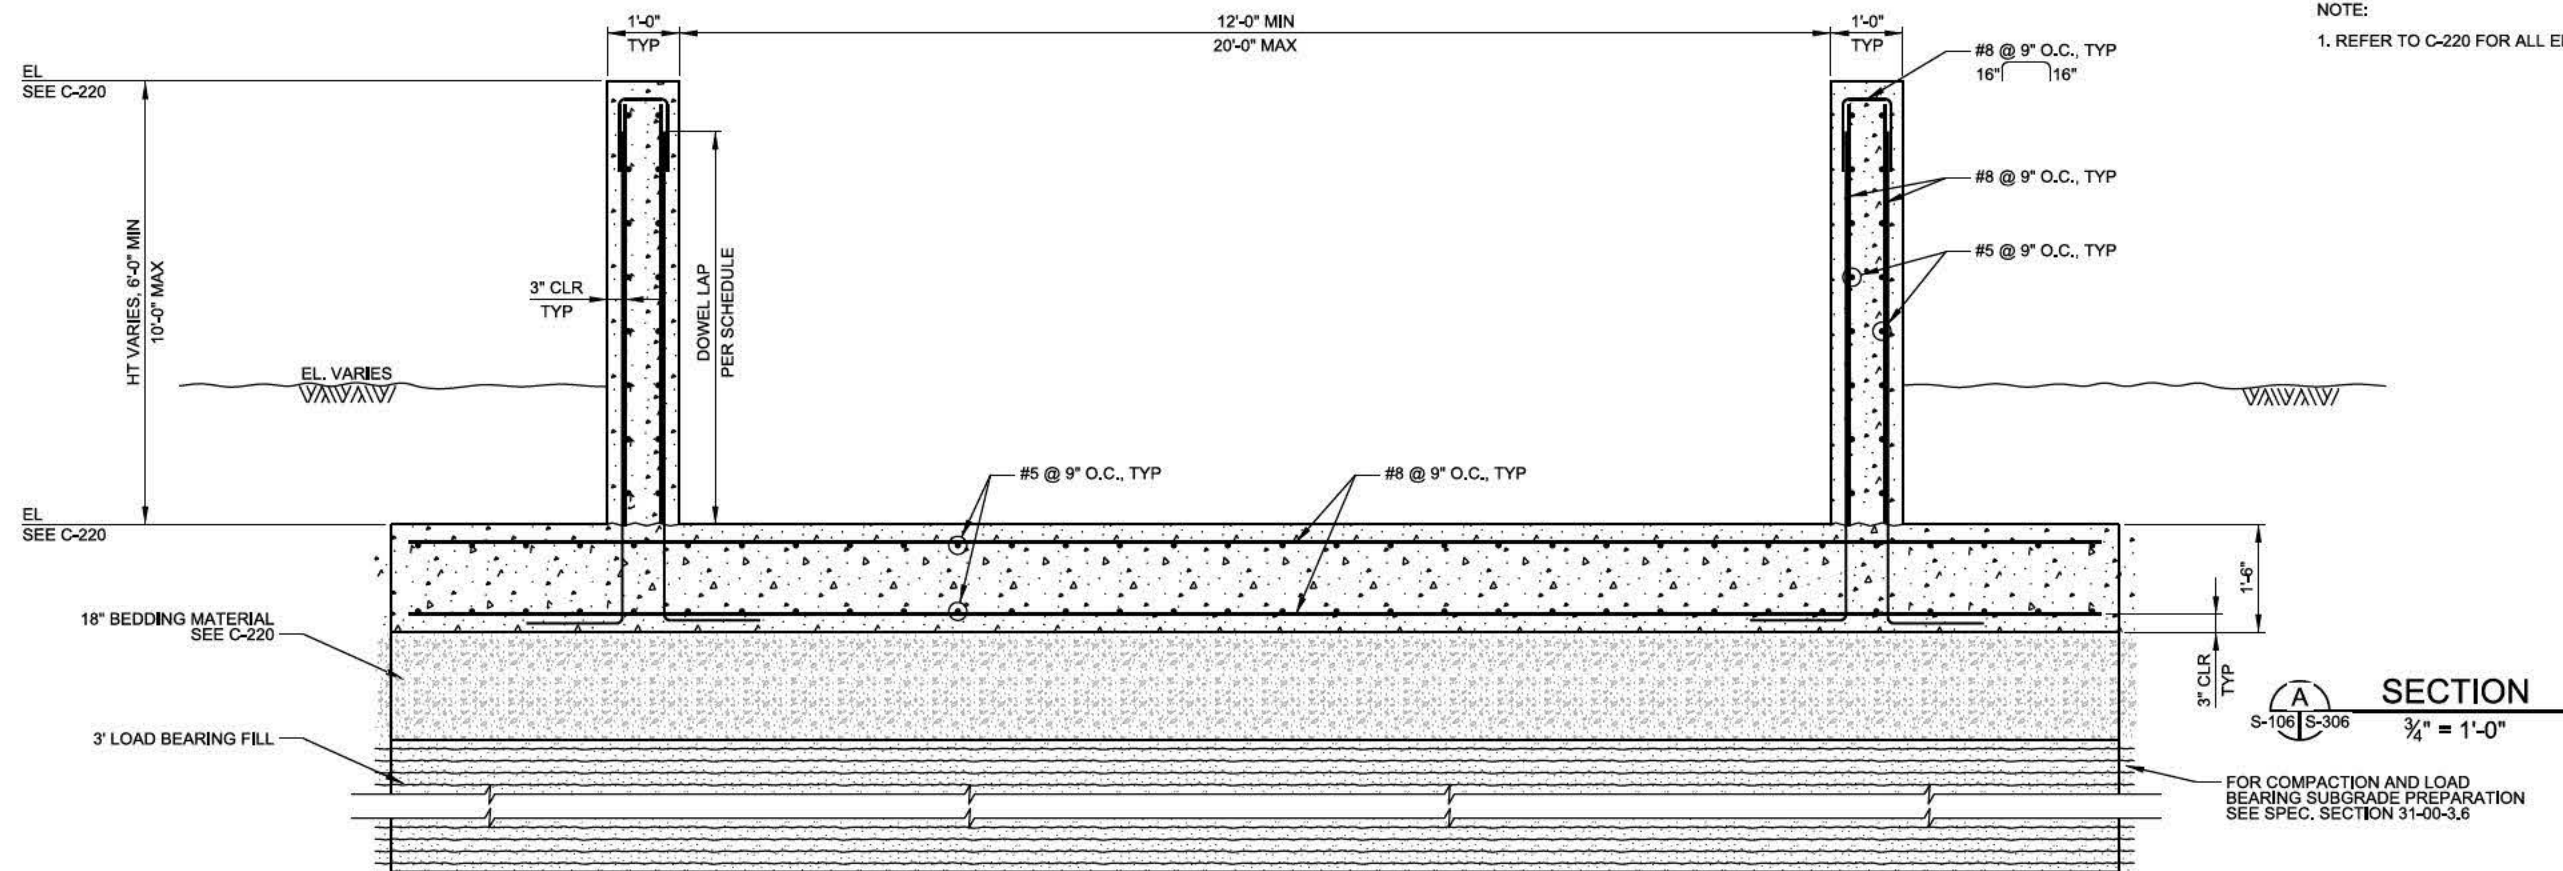



A horizontal scale bar with a central point labeled '0'. To the left of '0' is a tick mark labeled '2', and to the right is another tick mark labeled '2'. The bar is divided into four equal segments by these marks and the central '0' mark. Below the bar is the text 'SCALE IN FEET'.









c:\pwworking\mvt5\cedid\153734\EP102\_S-308.dgn  
8/28/2018 3:18:12 PM  
BEDDLN

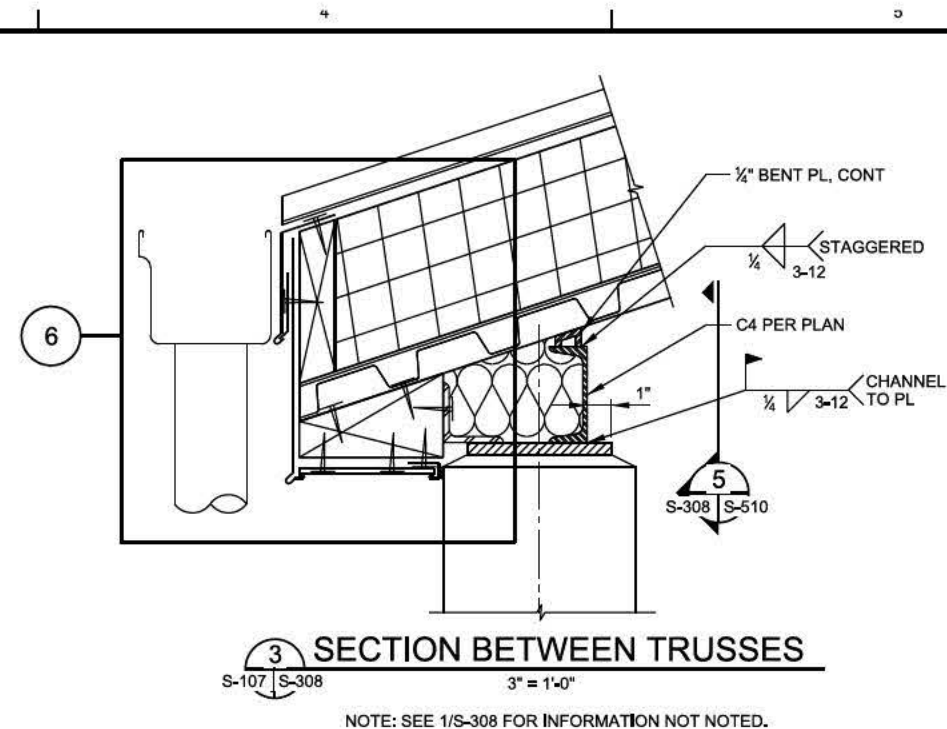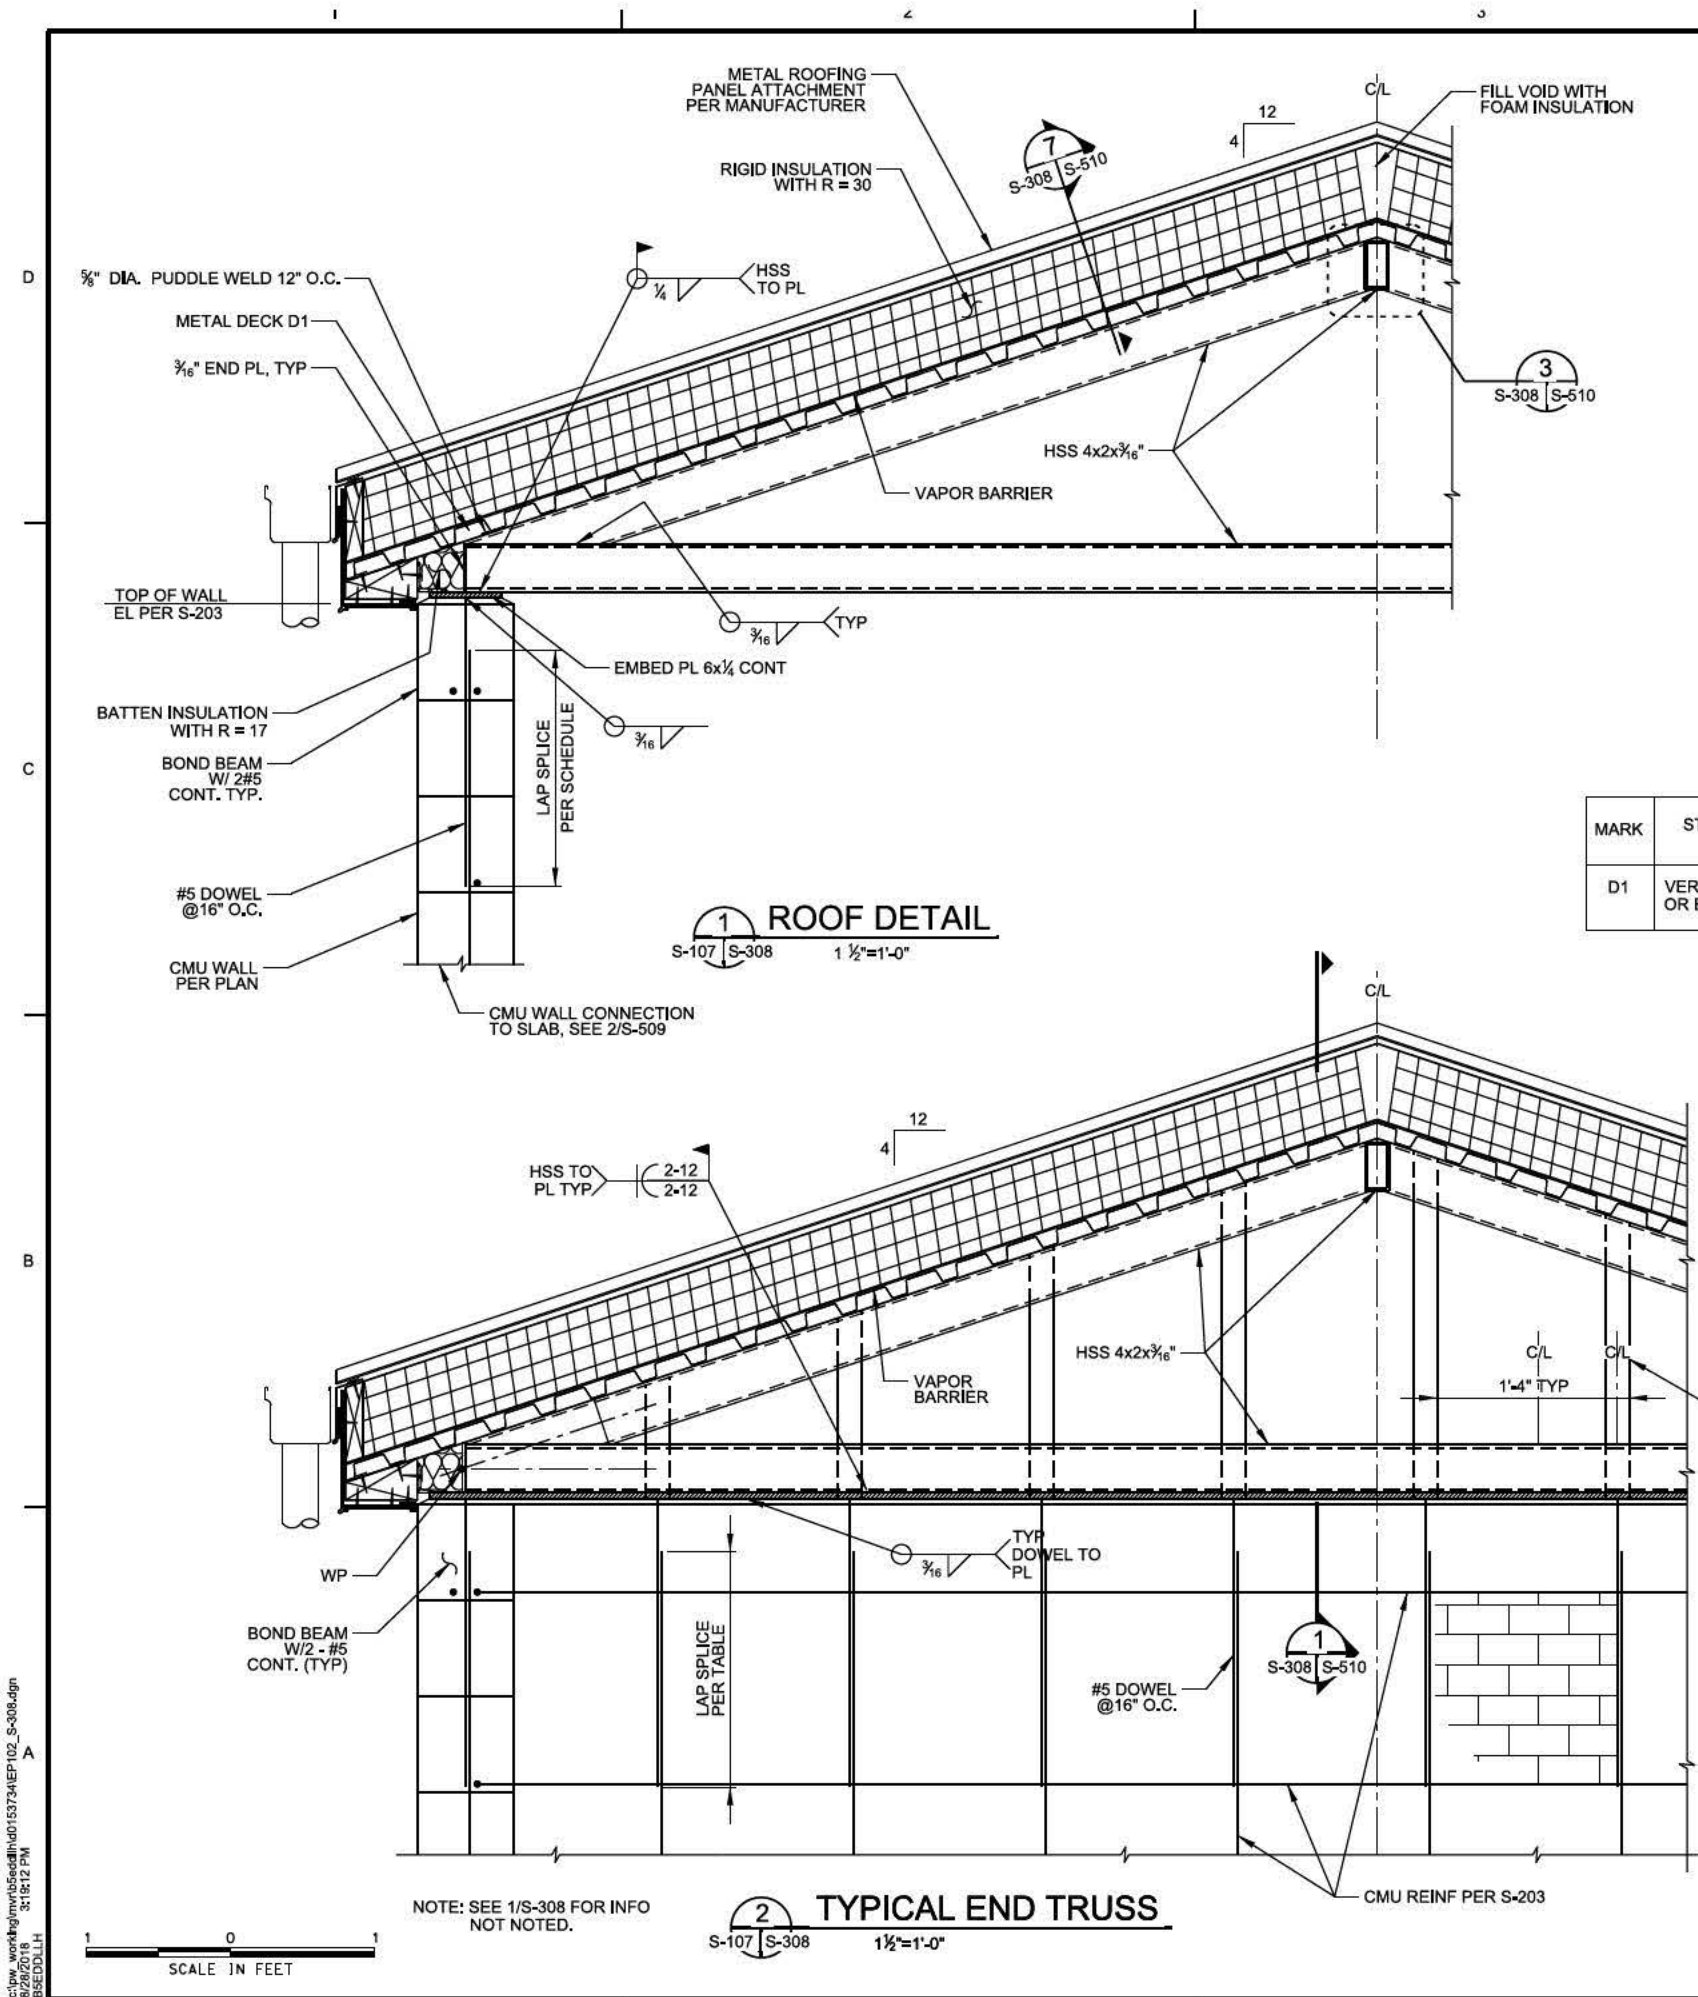

MARK	STEEL DECK TYPE	GAUGE	STEEL DECK PATTERN				SECTION PROPERTIES PER FT OF WIDTH		
			END	INT	SEAM	MARGINAL	I, IN <sup>4</sup>	+S, IN <sup>3</sup>	-S, IN <sup>3</sup>
D1	VERCO HSB-36 OR EQUIVALENT	20	3/4"Ø PUDDLE WELD @ 12" OC	3/4"Ø PUDDLE WELD @ 12" OC	BUTTON PUNCH @ 12" OC	3/4"Ø PUDDLE WELD @ 12" OC	0.216	0.235	0.248

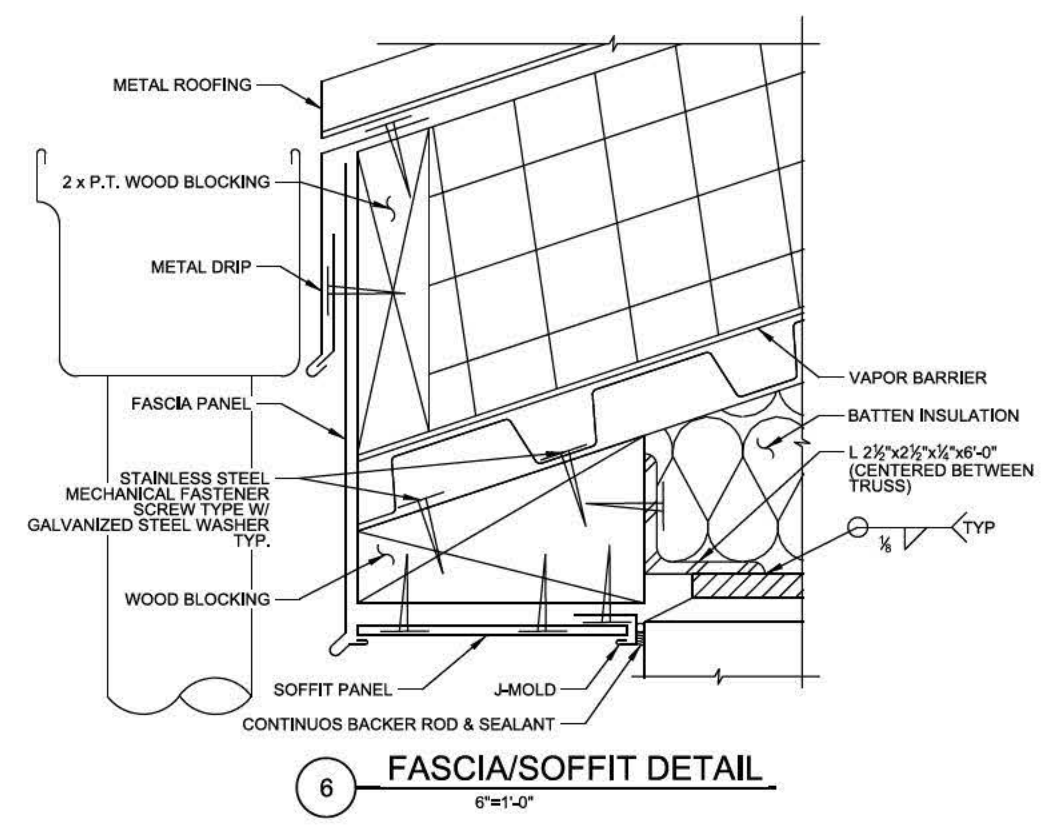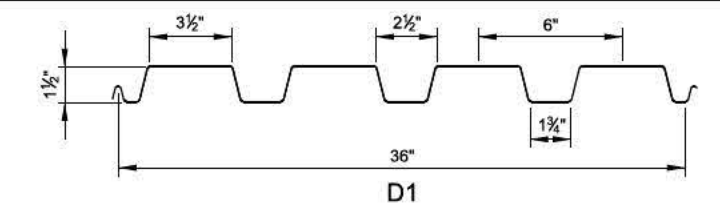

US Army Corps of Engineers

APPR.	DATE	DESCRIPTION
AS-BUILT AS OF 29 SEPTEMBER 2017		

MARK	DATE	DESIGNED BY:	CHKD BY:	SUBMITTED BY:	PROJECT CODE:	FILE NAME:
		KCP		FRU	EP102	EP102_S-308.dgn

U.S. ARMY CORPS OF ENGINEERS	ILLINOIS WATERWAY	CONTROL BUILDING
ROCK ISLAND DISTRICT	LAGRANGE, ILL.	ROOF FRAMING
ROCK ISLAND, ILLINOIS	FLORISSANT, ILL.	
	STAGE I	
	REPAIR & ENHANCEMENT	

Sheet ID

**S-308**

AS-BUILT

A-78







US Army Corps  
of Engineers


DATE	DESCRIPTION
AS-BUILT AS OF 29 SEPTEMBER 2017	

DATE: 26-10-2016	SOLICITATION NO.: W0125K4-14-0000	PROJECT CODE: EP102
DESIGNED BY: CDD	CHK BY: FRU	FILE NAME: EP102_S-310.dgn
U.S. ARMY CORPS OF ENGINEERS	ROCK ISLAND DISTRICT	
ROCK ISLAND DISTRICT	ROCK ISLAND, ILLINOIS	

ILLINOIS WATERWAY  
LAGRANGE, ILL.  
RICE LAKE HABITAT REHAB & ENHANCEMENT  
STAGE I  
OUTLET STRUCTURE  
CONCRETE  
REINFORCEMENT  
DETAILS SHEET 1 OF 2


Sheet  
ID  
**S-310**

AS-BUILT  
A-80

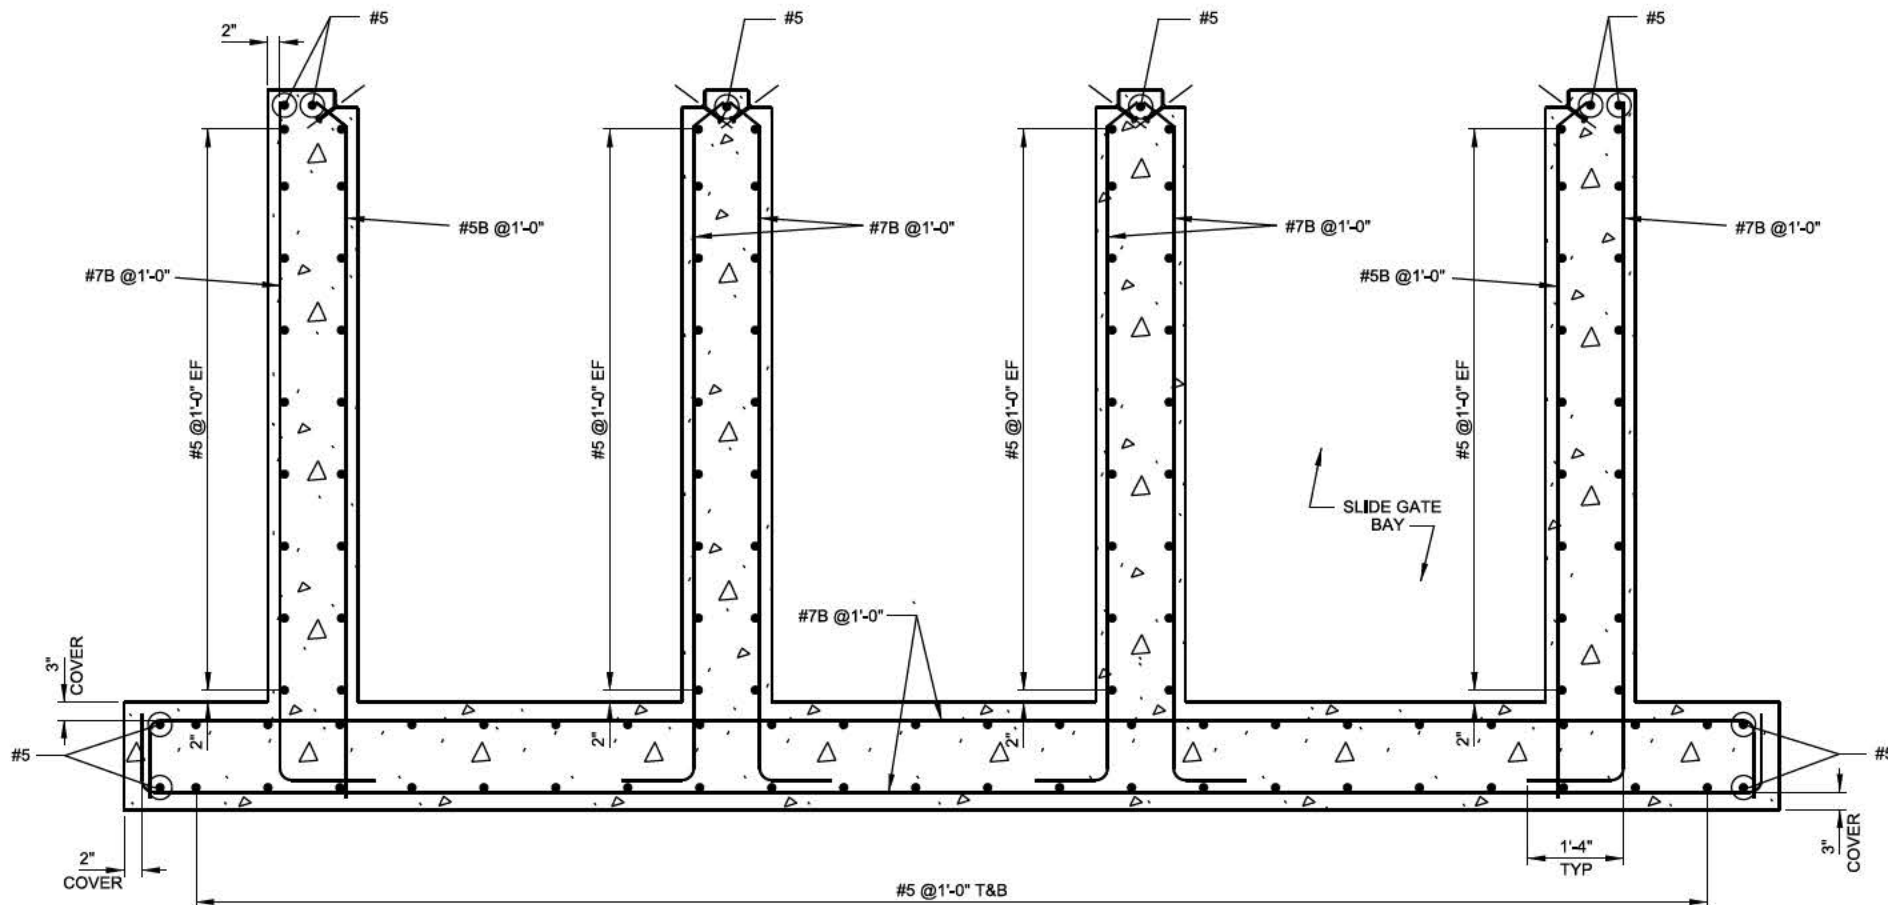

**A** SECTION  
S-109 | S-310


2 0 2  
SCALE IN FEET

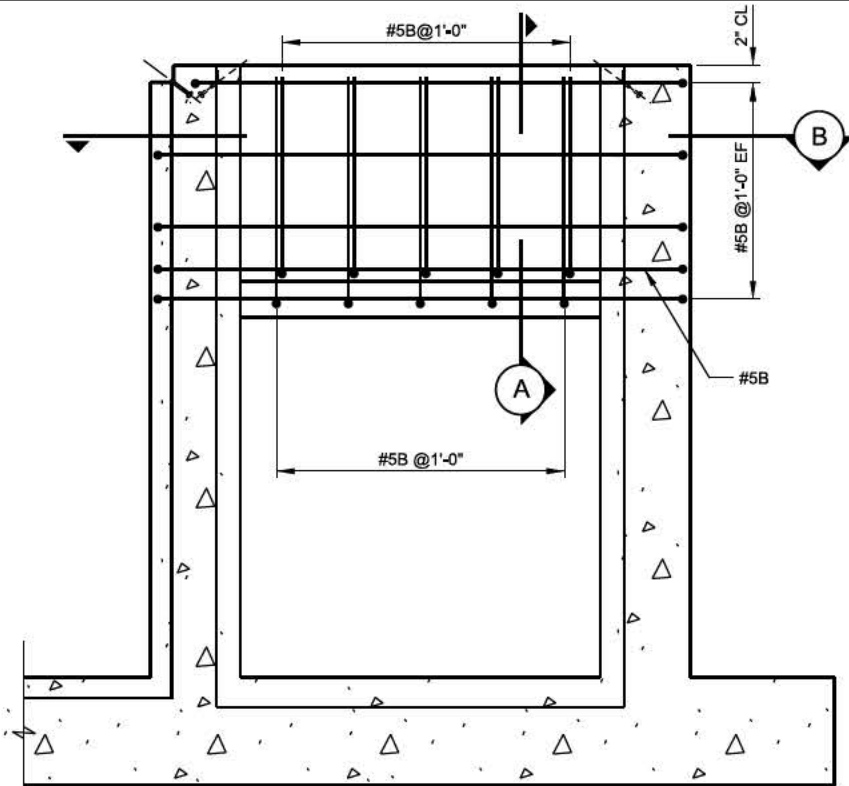

NOTE: WALL AND SLAB REINFORCING NOT SHOWN.

**B** SECTION  
S-109 | S-310


2 0 2  
SCALE IN FEET

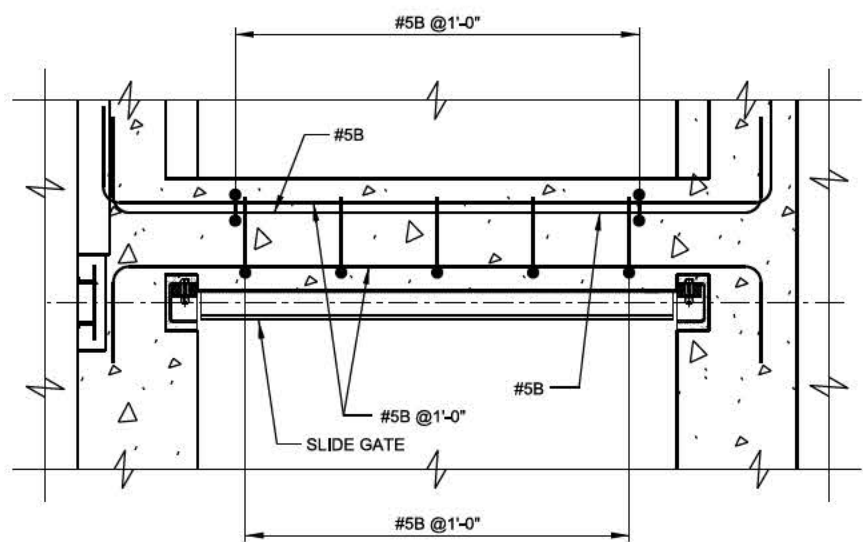

NOTE: WALL REINFORCING NOT SHOWN.

**B** SECTION

1 0 1  
SCALE IN FEET

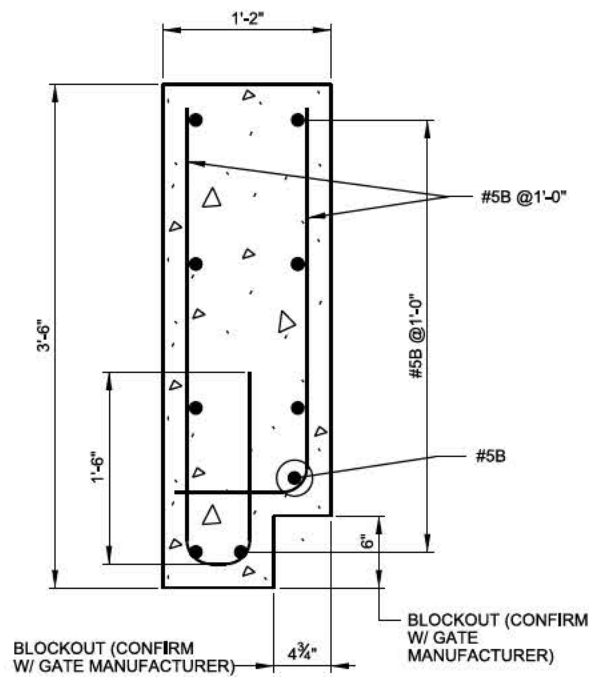

BLOCKOUT (CONFIRM W/ GATE MANUFACTURER) 4 3/4"



**A** SECTION

4 0 4  
SCALE IN FEET






c:\pwworking\mvt\564\153734\EP102\_S-501.dgn  
8/28/2018 3:18:39 PM  
BEDDLH

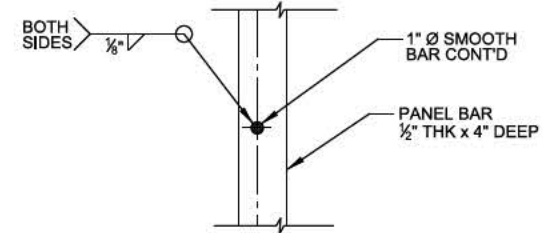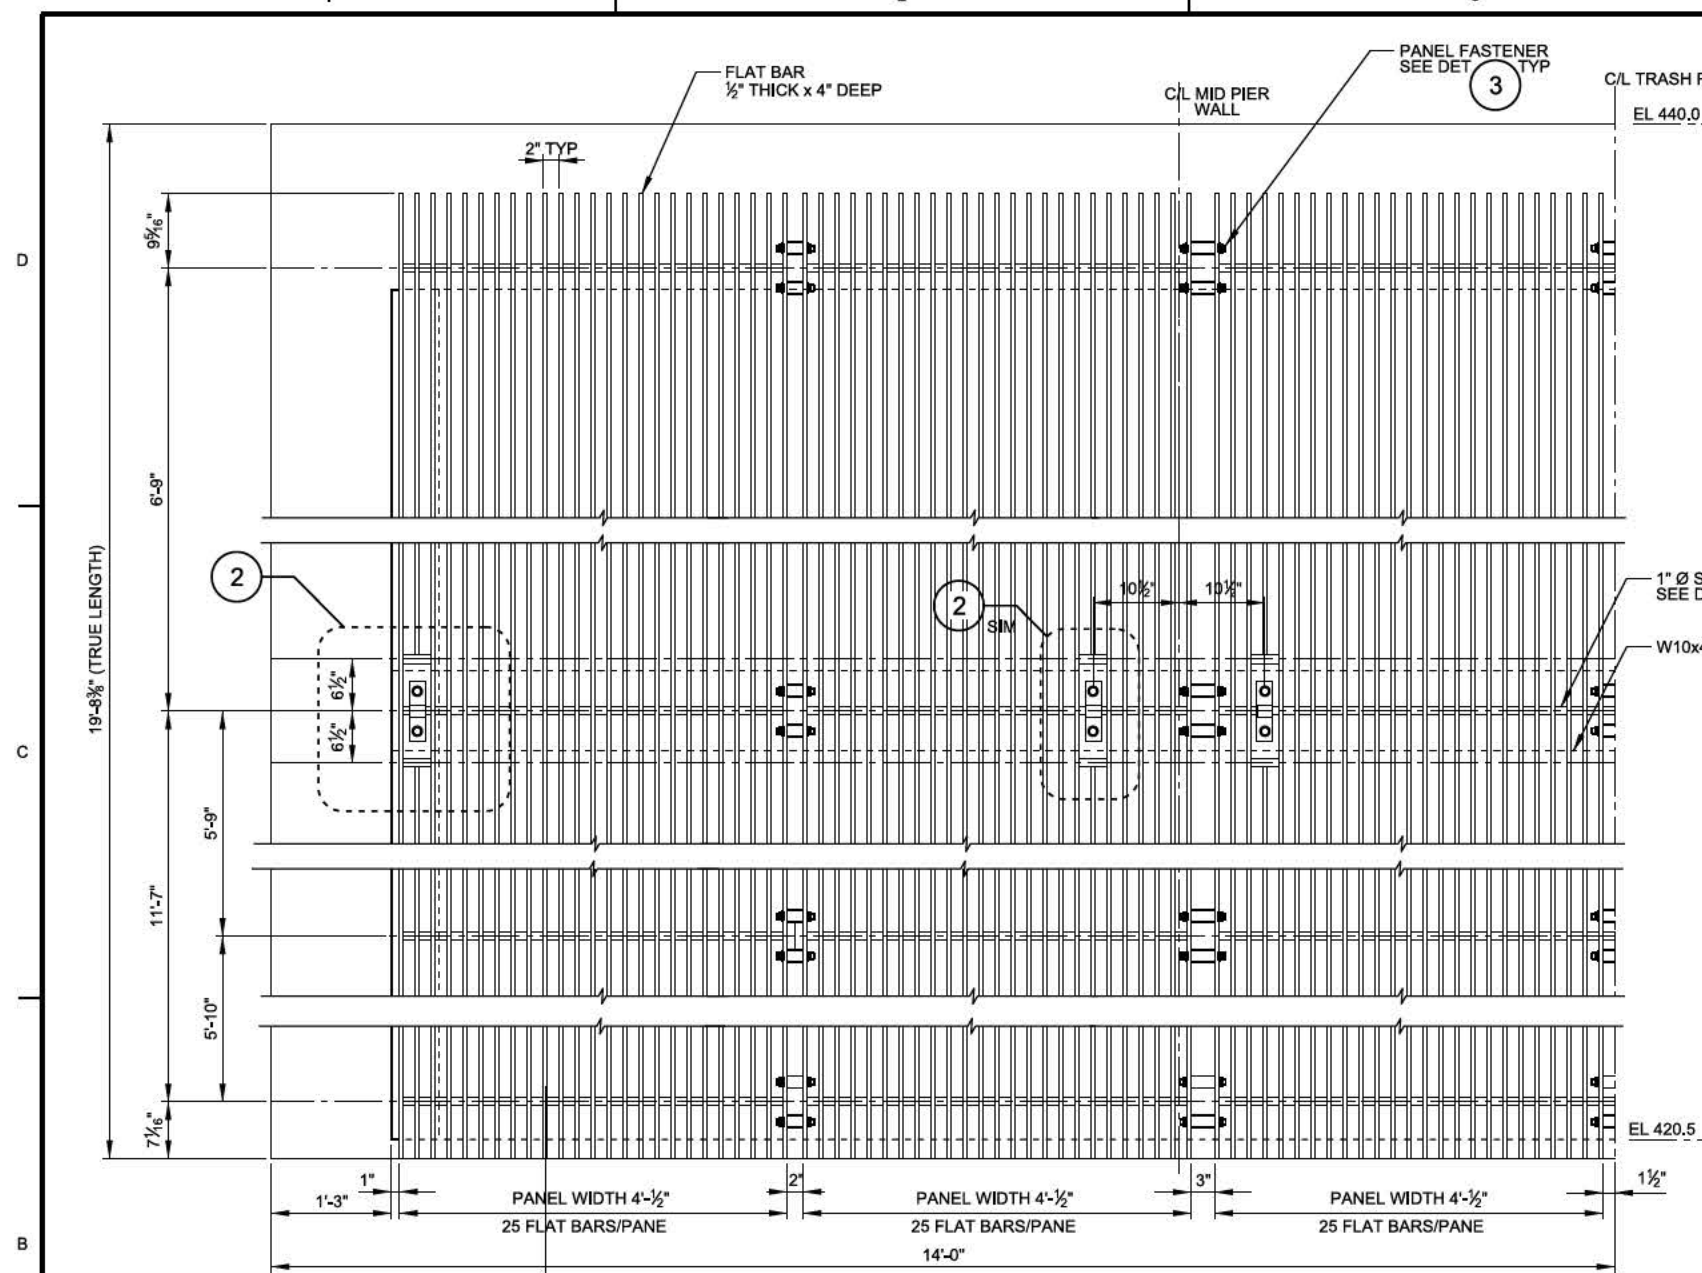

4  
1 1/2"=1'-0"

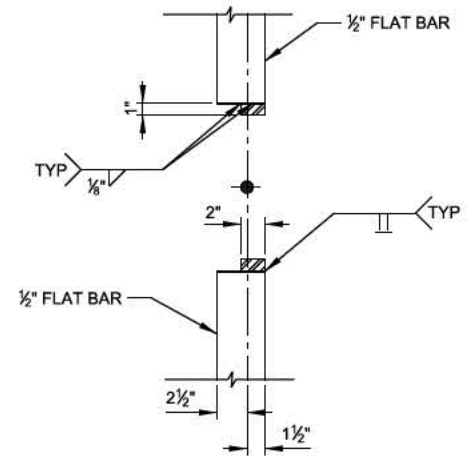

5  
1 1/2"=1'-0"

- NOTE:
1. THE EMBEDMENT FOR THE TRASH RACK'S ANCHOR BOLT LOCATIONS SHALL BE IDENTIFIED PER TRASH RACK MANUFACTURER'S SPECIFICATION AND INCLUDED IN SHOP DRAWINGS.
  2. TRASH RACK PANEL SHALL BE PAINTED WITH SYSTEM NO. 5-E-Z. SEE CONTRACT SPECIFICATION FOR DETAILED REQUIREMENTS.



MARK	DATE	DESCRIPTION
AS-BUILT AS OF 29 SEPTEMBER 2017		


DESIGNED BY: KCP	DATE: 26-10-2016	SOLICITATION NO.:
DWN BY: KCP	CHK BY: KCP	CONTRACT NO.:
SUBMITTED BY: KCP	PROJECT CODE:	PROJECT NO.:
FILE NAME: EP102_S-501.dgn	FILE NO.:	FILE DATE:

ILLINOIS WATERWAY  
LA GRANGE, ILL.  
RICE LAKE HABITAT REPAIR & ENHANCEMENT  
STAGE I  
PUMP STATION  
TRASH RACK DETAILS  
SHEET 1 OF 2


Sheet  
ID  
S-501

AS-BUILT  
A-82


1  
1"=1'-0"

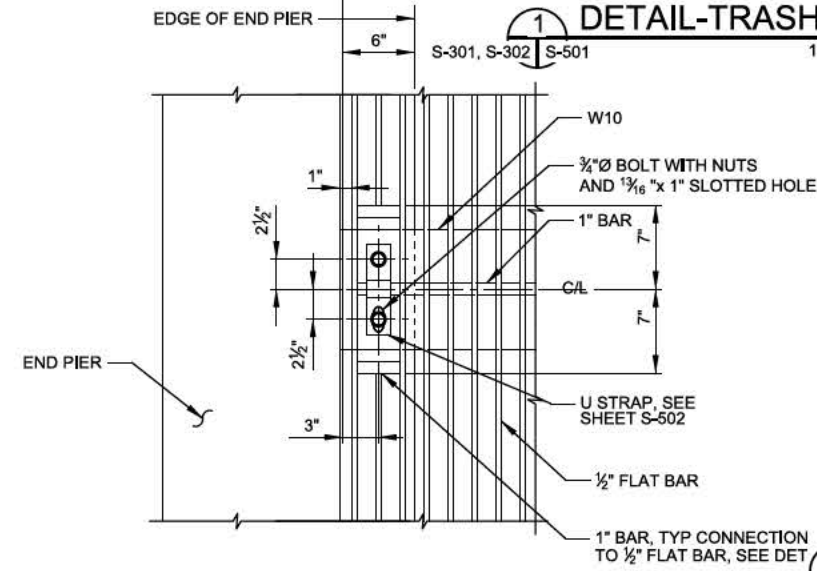






2  
1 1/2"=1'-0"

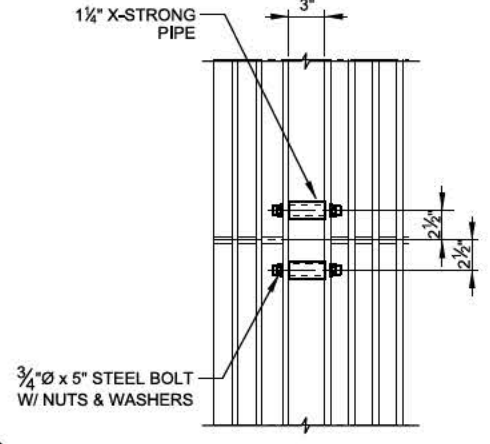


3  
1 1/2"=1'-0"

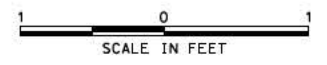




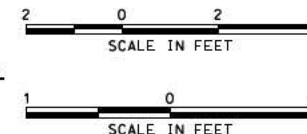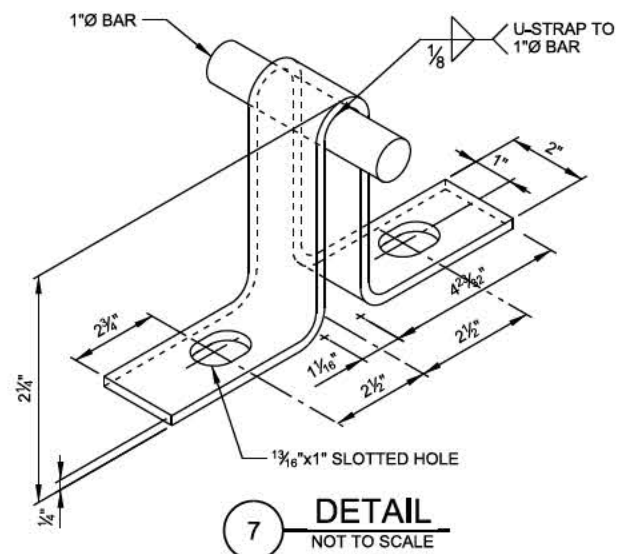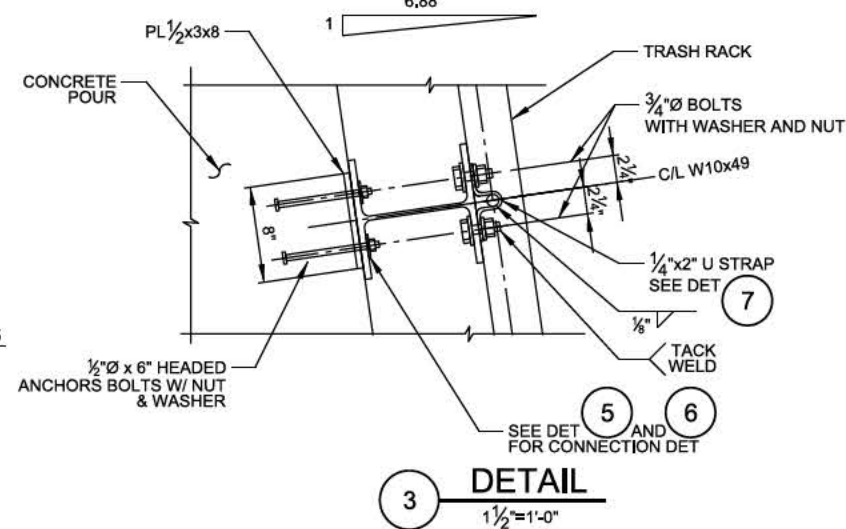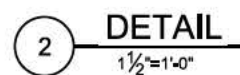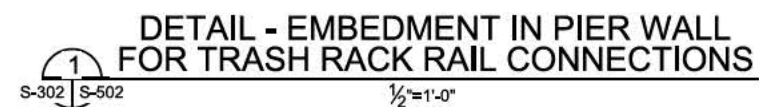


c:\pwworking\mmt5\cadd\15373\AEP102\_S-503.dgn  
8/28/2018 3:18:48 PM  
BEDDLH

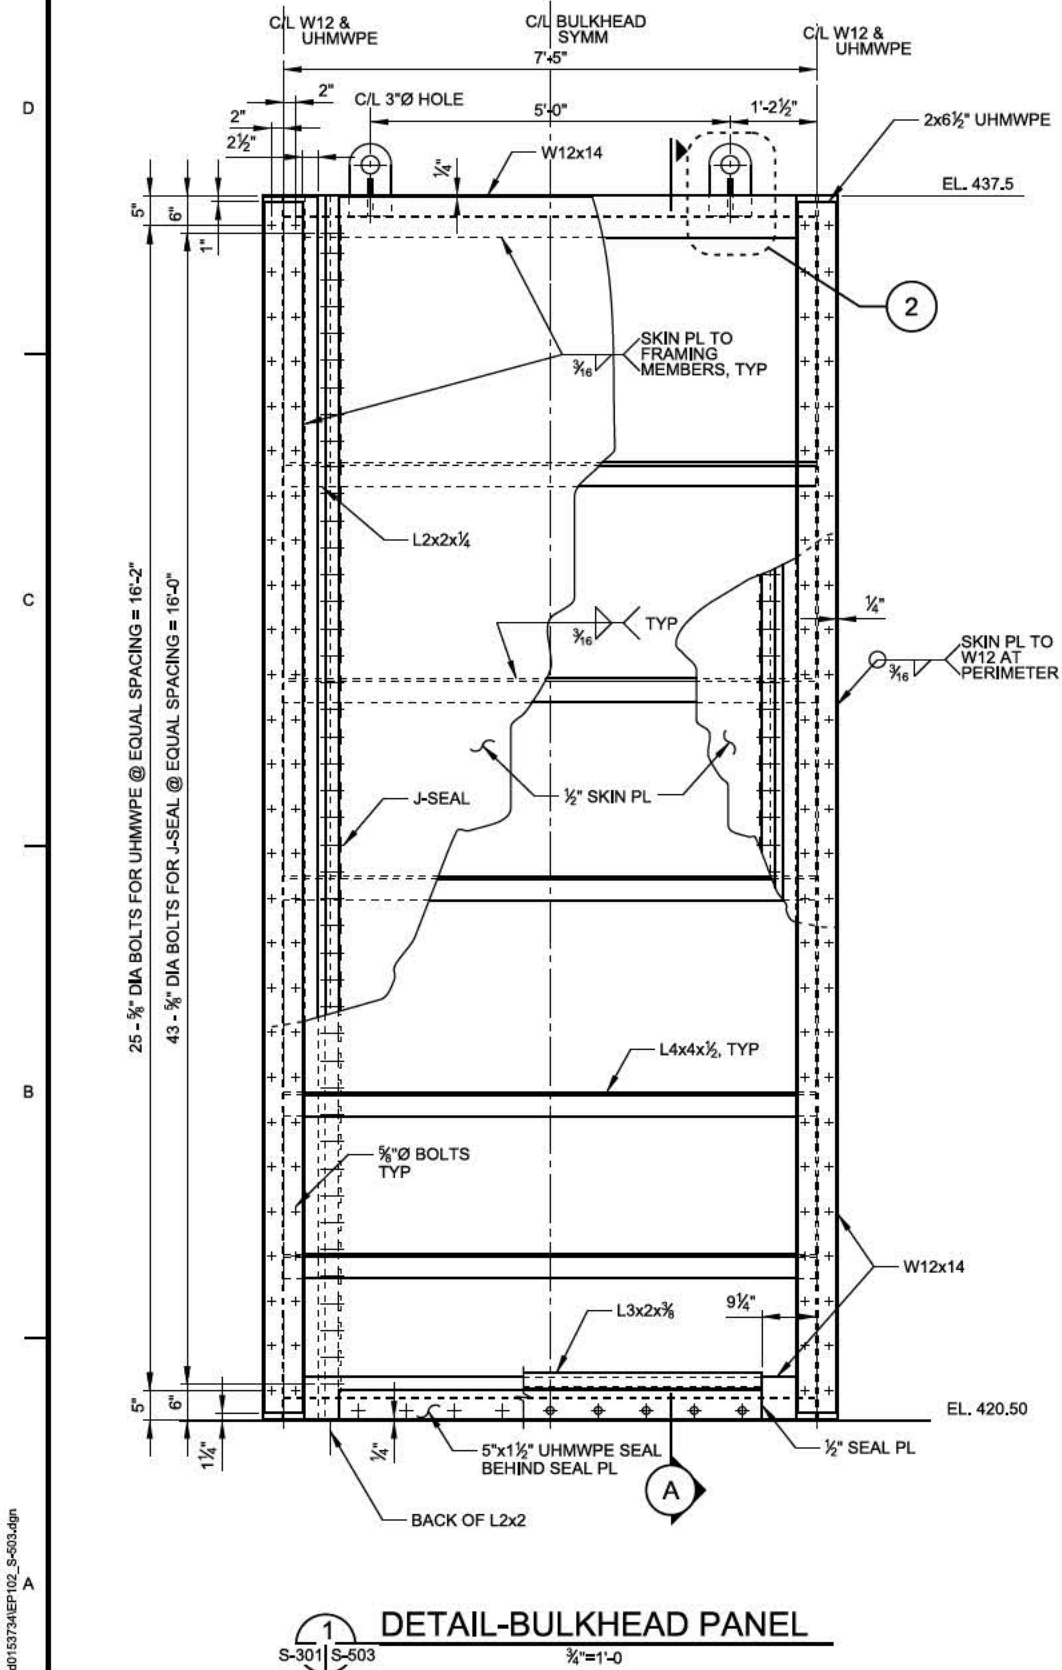


**1** **DETAIL-BULKHEAD PANEL**  
S-301 | S-503 3/4"=1'-0"

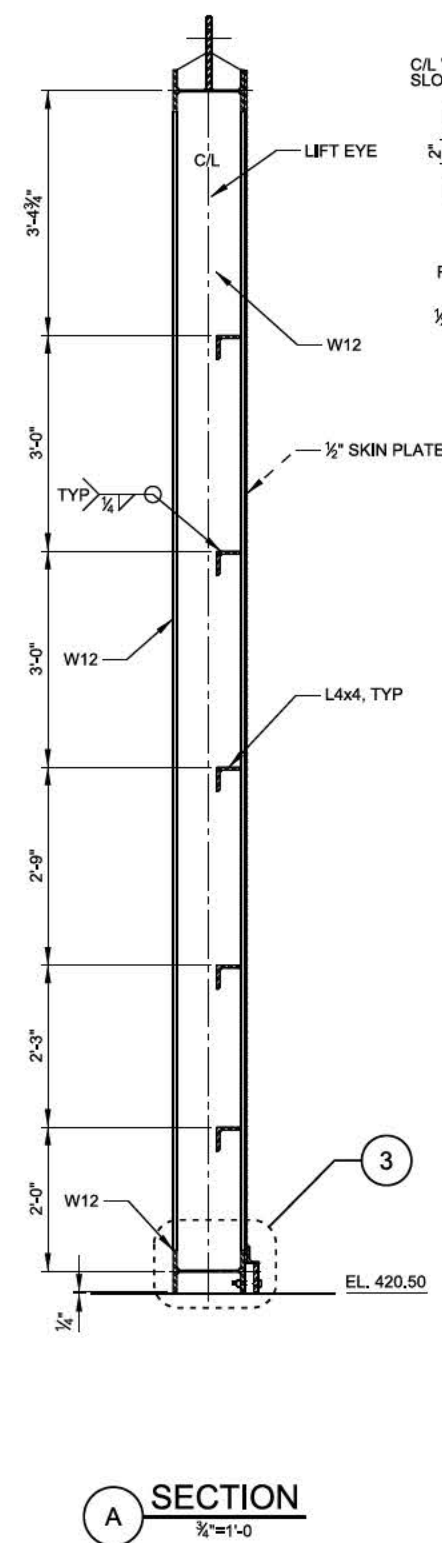


**A** **SECTION**  
3/4"=1'-0"

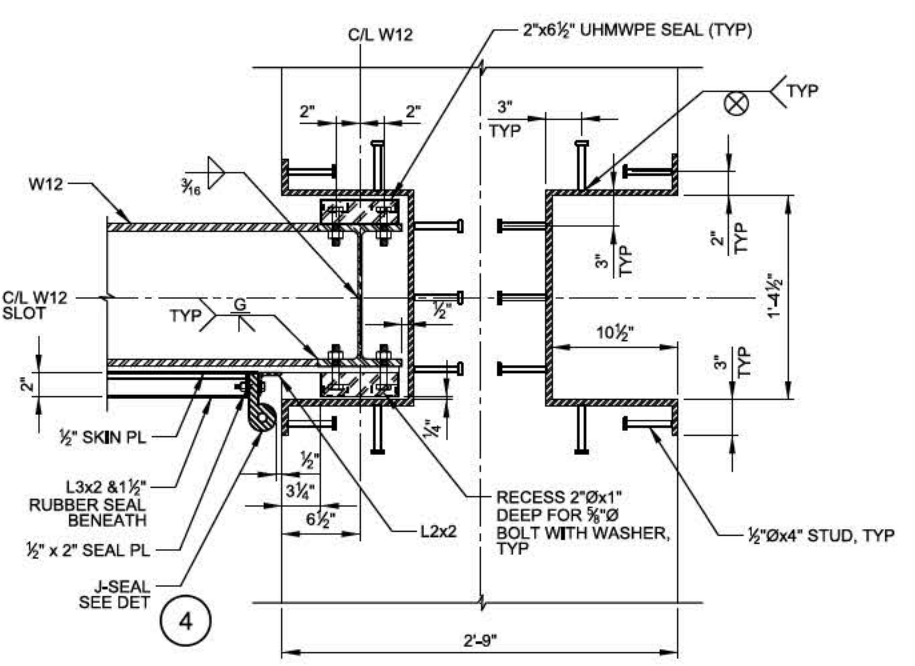


**5** **DETAIL - BULKHEAD ARMOR PLATE**  
S-104 | S-503 1 1/2"=1'-0"

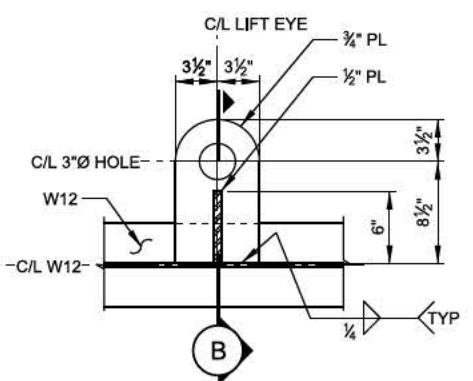


**2** **LIFT EYE DETAIL**  
1 1/2"=1'-0"

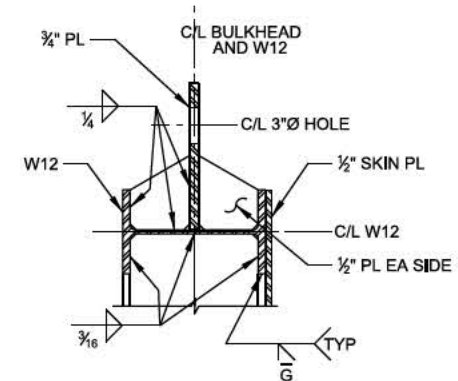

**B** **SECTION**  
1 1/2"=1'-0"

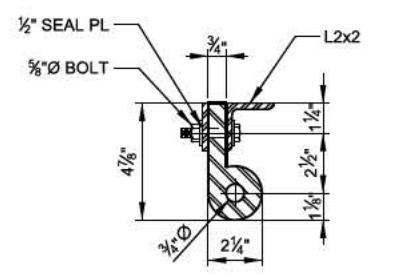


**4** **J-SEAL DETAIL**  
3"=1'-0"

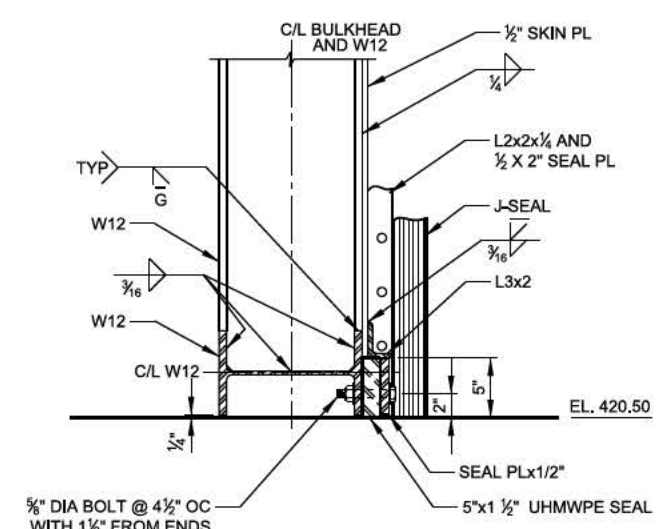

**3** **DETAIL**  
1 1/2"=1'-0"

**NOTE:**  
THE CONTRACTOR WILL HAVE THE OPTION TO SUBMIT A MANUFACTURER'S (HYDROGATE OR EQUAL) DESIGN FOR A PREFABRICATED BULKHEAD. THE MANUFACTURER'S ALTERNATE DESIGN SHALL INCLUDE COMPUTATIONS AND SHOP DRAWINGS FOR THE PREFABRICATED BULKHEAD. THE ALTERNATE DESIGN SHALL SATISFY ALL US ARMY CORPS OF ENGINEERS' ENGINEERING CRITERIA. THE DESIGN AND DRAWINGS SHALL BE SIGNED AND SEALED BY A REGISTERED PROFESSIONAL CIVIL OR STRUCTURAL ENGINEER LICENSED IN THE STATE OF ILLINOIS AND SUBMITTED TO THE CONTRACTING OFFICER FOR APPROVAL.

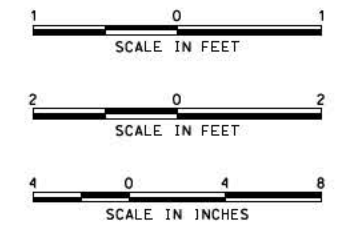

DATE	APPROVAL
8-17-11	RCF
AMD 0001 REVISE NOTE AS-BUILT AS OF 29 SEPTEMBER 2017	
DESCRIPTION	
1	
DESIGNED BY:	DATE:
CHKD BY:	20-10-2010
PROJECT NO.:	SOLICITATION NO.:
CONTRACT NO.:	CONTRACT NO.:
PROJECT CODE:	PROJECT CODE:
FILE NAME:	FILE NAME:
ANALYST:	ANALYST:
U.S. ARMY CORPS OF ENGINEERS ROCK ISLAND DISTRICT ROCK ISLAND, ILLINOIS	
ILLINOIS WATERWAY LA GRANGE, ILLINOIS RICE LAKE HABITAT REPAIR & ENHANCEMENT STAGE I PUMP STATION BULKHEAD	
Sheet ID <b>S-503</b>	
AS-BUILT <b>A-84</b>	




MARKS	DESCRIPTION	DATE	APPROVED
	ASCR 1 AS OF 29 SEPTEMBER 2017		





U.S. ARMY CORPS OF ENGINEERS ROCK ISLAND DISTRICT ROCK ISLAND, ILLINOIS	DESIGNED BY:	DATE:
	KCP	20100830
	DRAWN BY:	SOLICITATION NO.:
	NWP	W72ZF-1-8-0029
	SUBMITTED BY:	CONTRACT NO.:
	MAK	
	PLOT SCALE:	PLOT DATE:
	AS SHOWN	PROJECT CODE:
	SIZE:	FILE NAME:
	ANSI D	EP102_5-004291

ILLINOIS WATERWAY  
LAGRANGE POOL  
FULTON COUNTY, IL  
RICE LAKE HABITAT REHAB & ENHANCEMENT  
STAGE I  
PUMP STATION  
BULKHEAD OPENINGS

Sheet  
ID  
S-504

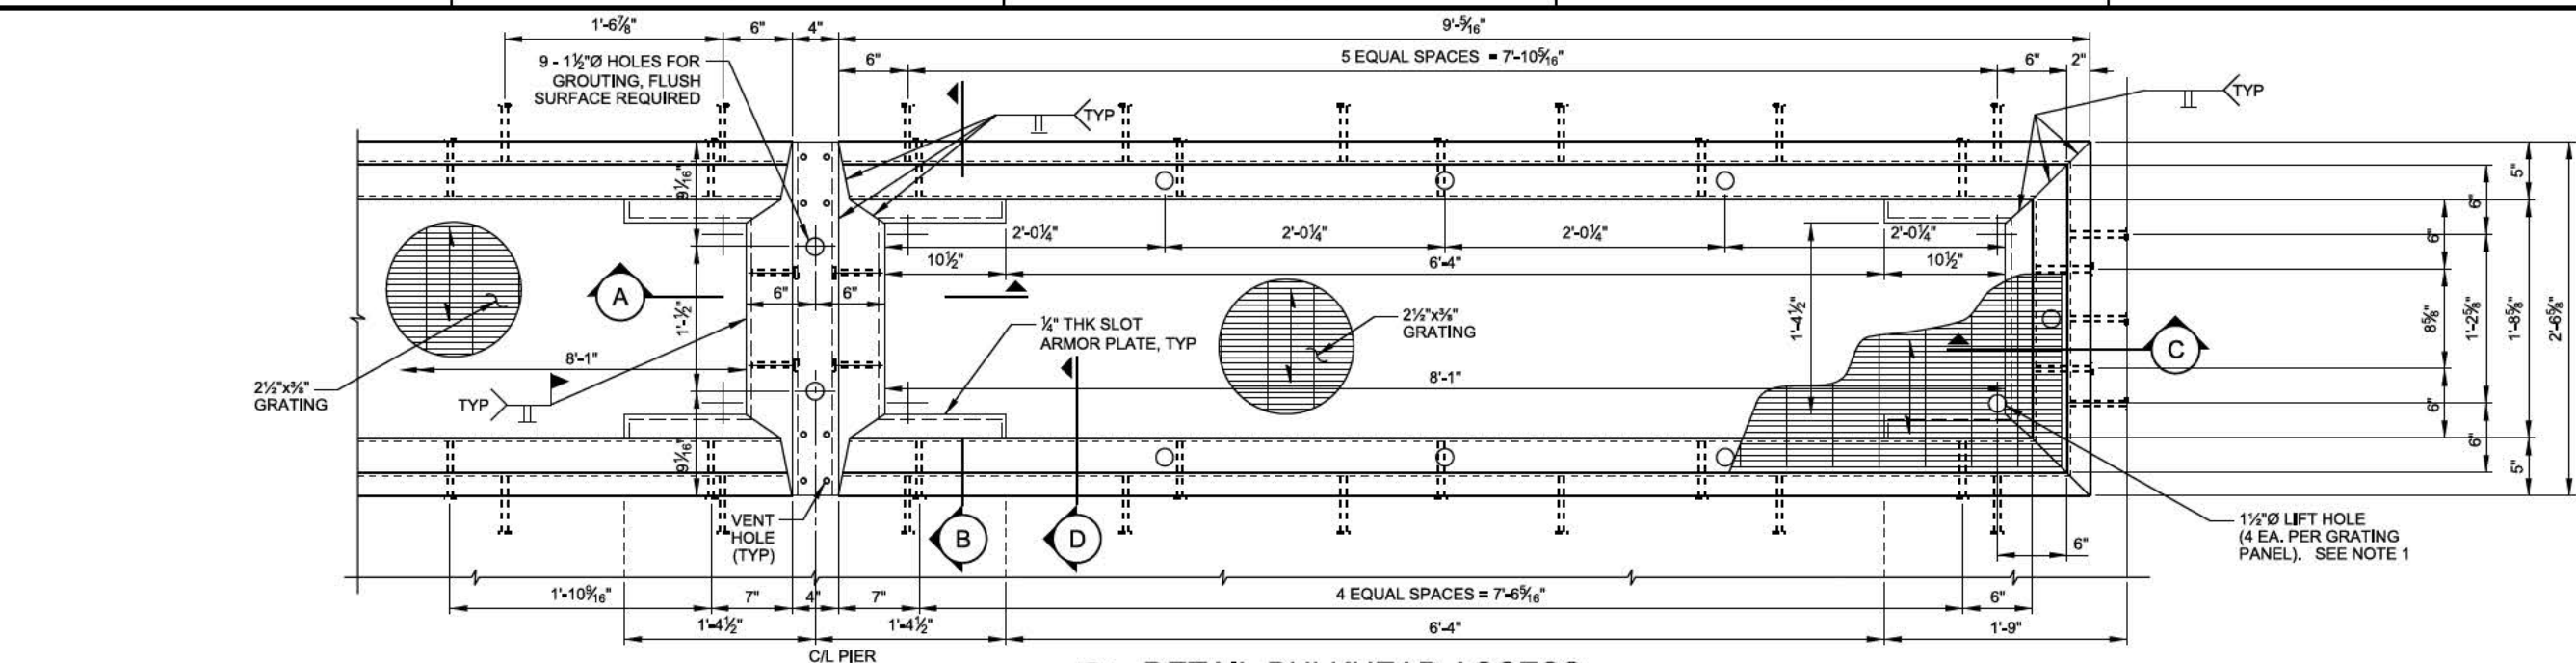


**DETAIL-BULKHEAD ACCESS**

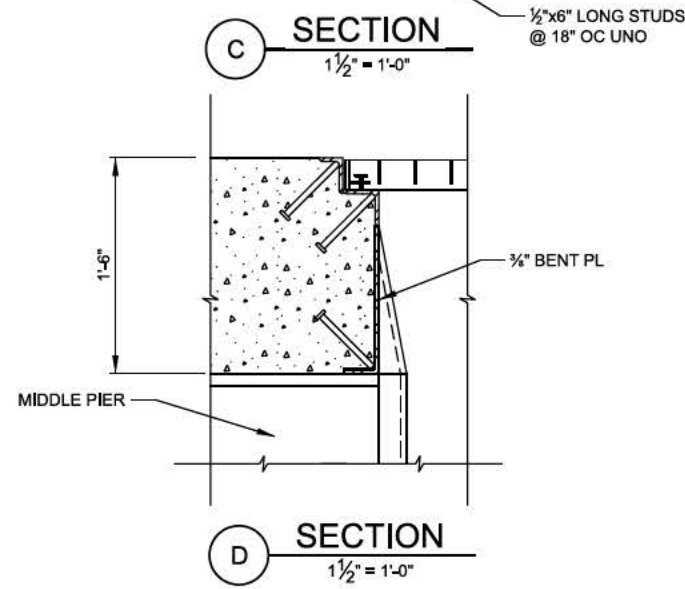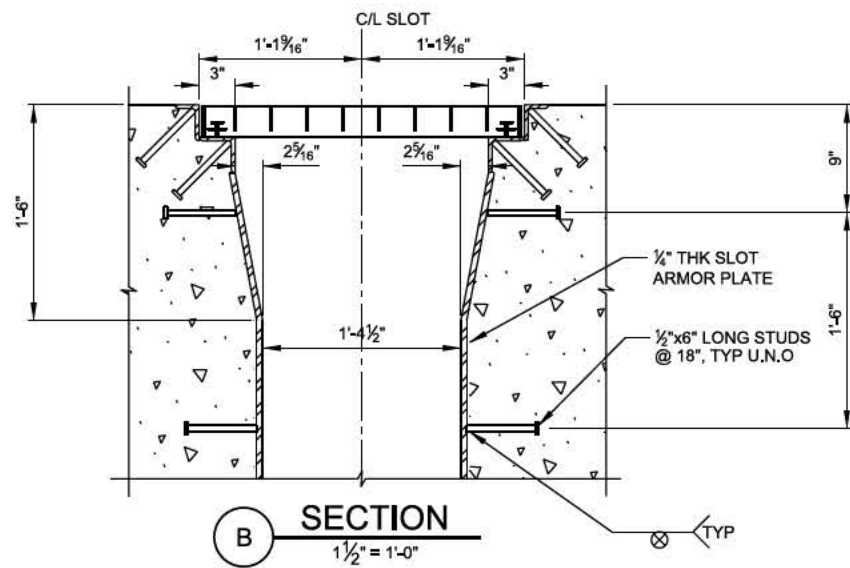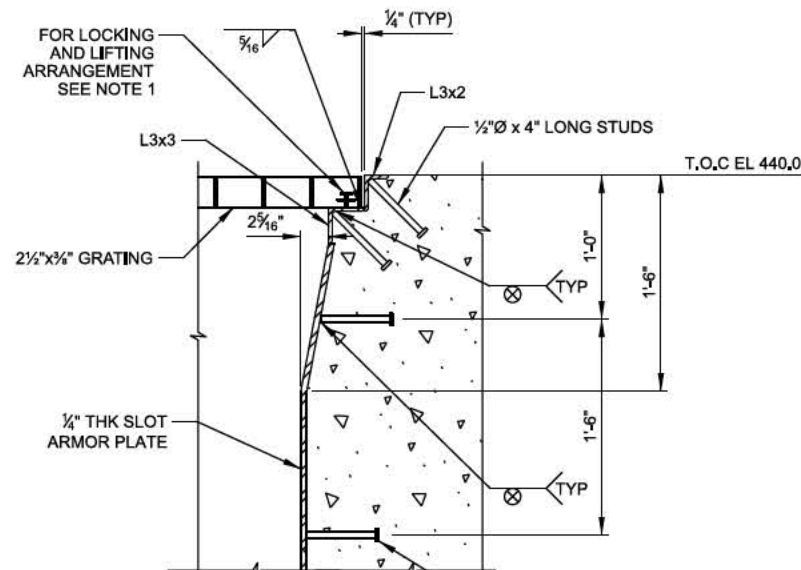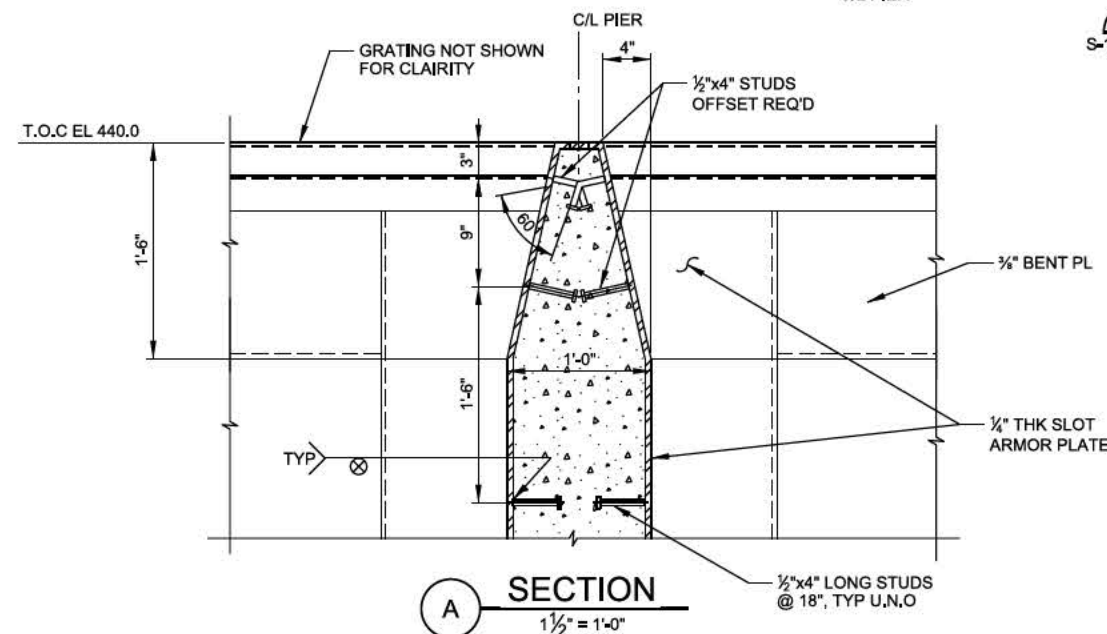

**NOTE:**

1. MANUFACTURER SHALL PROVIDE LOCKING AND LIFTING ARRANGEMENT FOR GRATING OVER OPENINGS AND OBTAIN APPROVAL FROM CONTRACTING OFFICER.

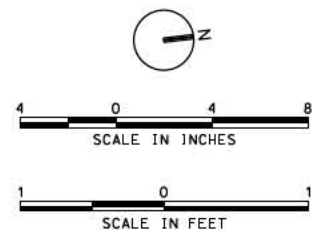



**SECTION**  
3" = 1'-0"

 **DETAIL - GRATED OPERABLE HATCH**   
S-101 S-505 1" = 1'-0"








c:\pwworking\mmt\506\15373\AEP102\_S-506.dgn  
8/28/2018 3:20:14 PM  
BEDDLN

D



C

B

A

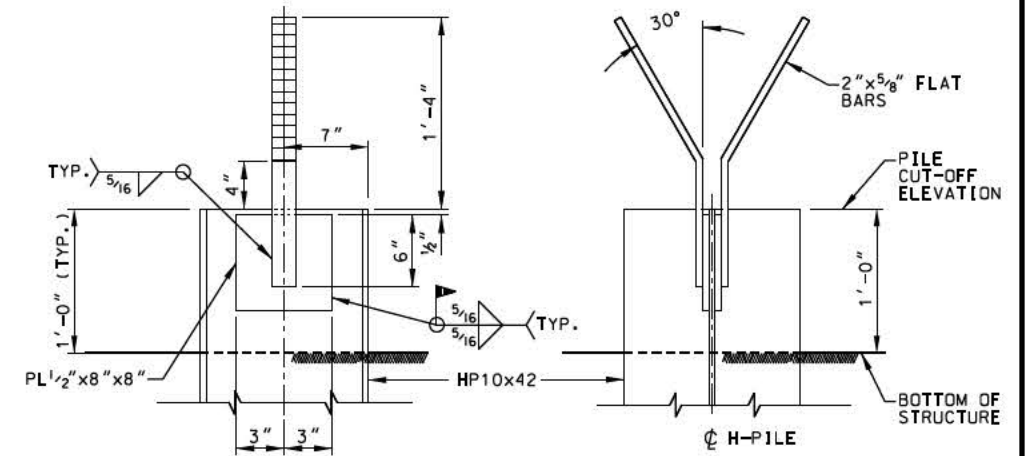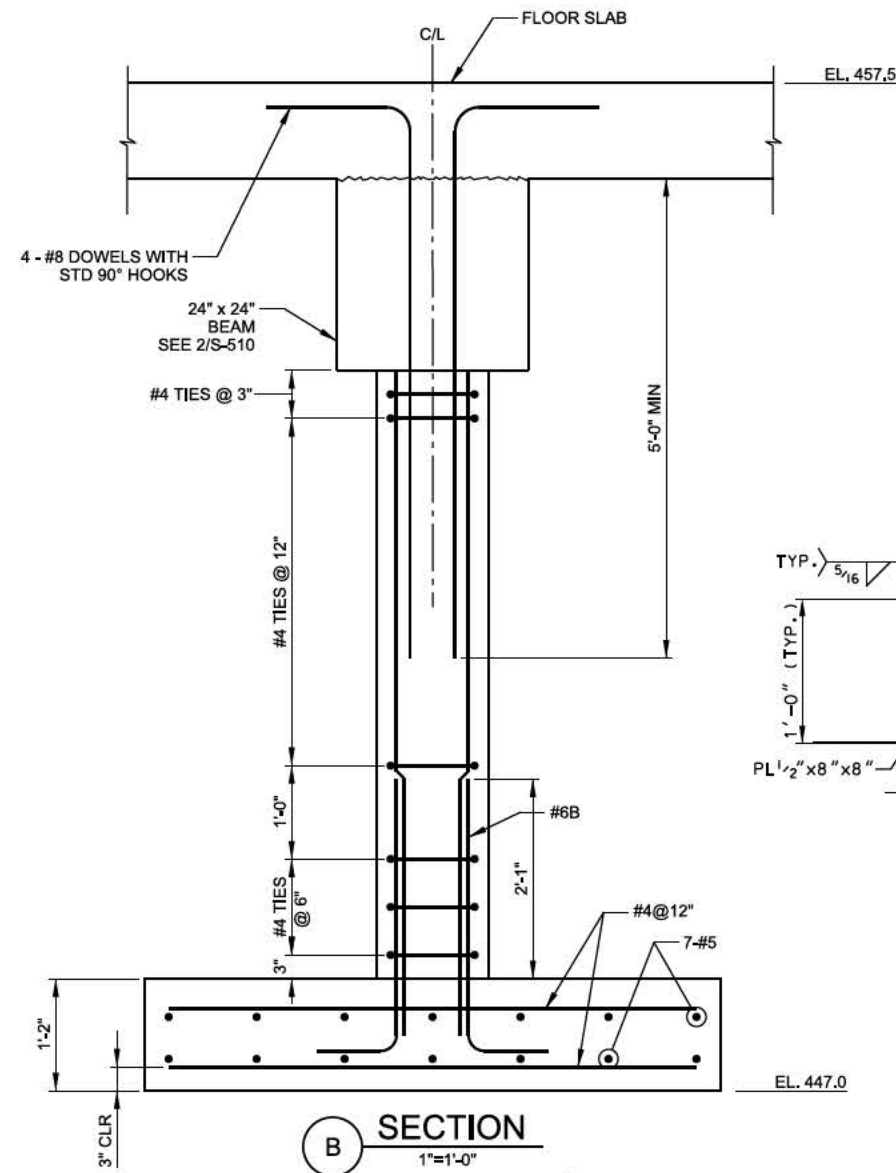
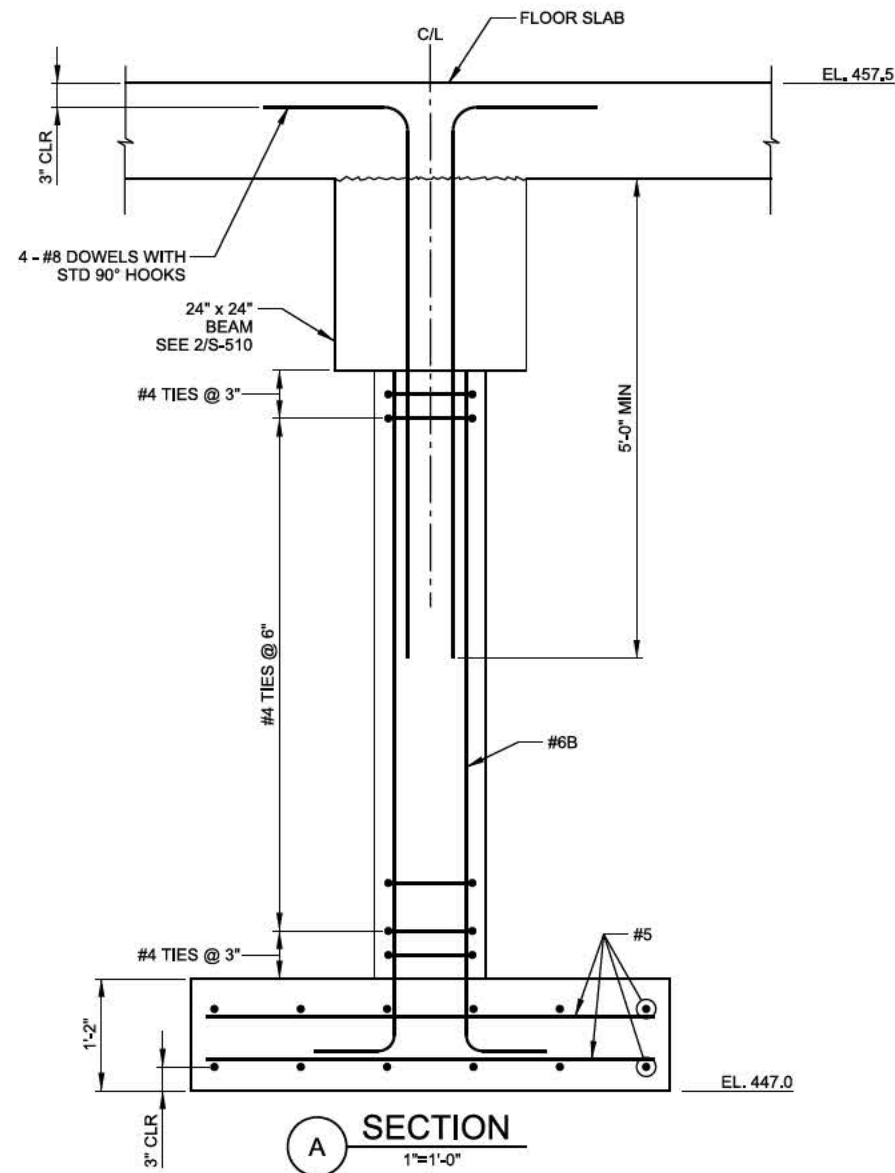


WEB ELEVATION  
FLANGE ELEVATION  
BEARING PILE FOOTING CONNECTION  
SCALE IN FEET

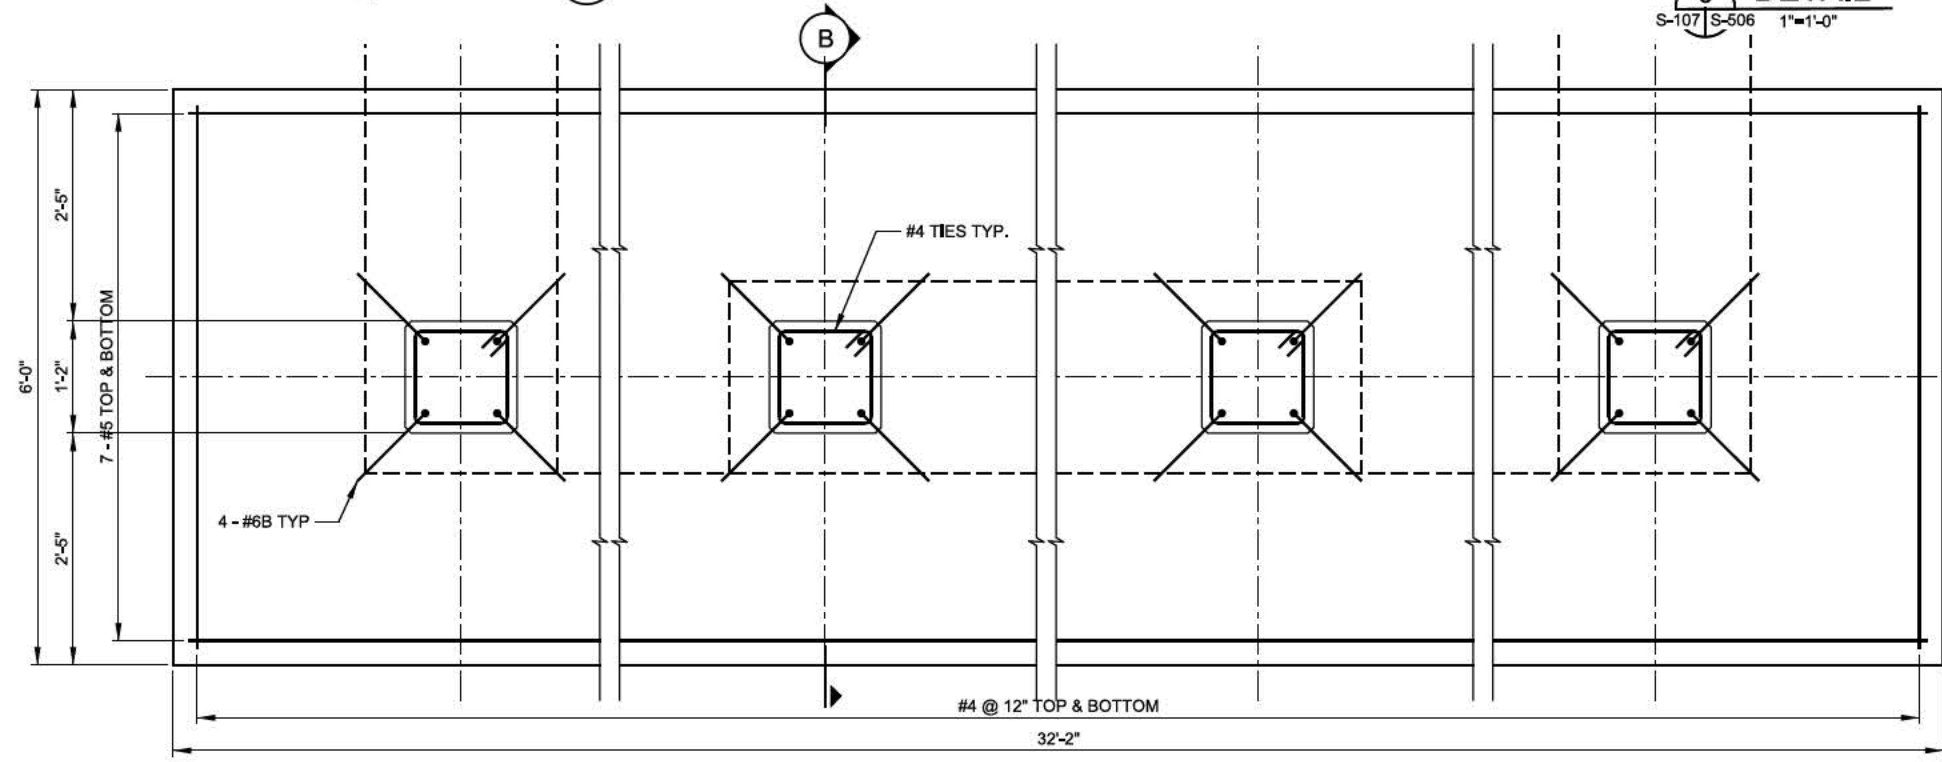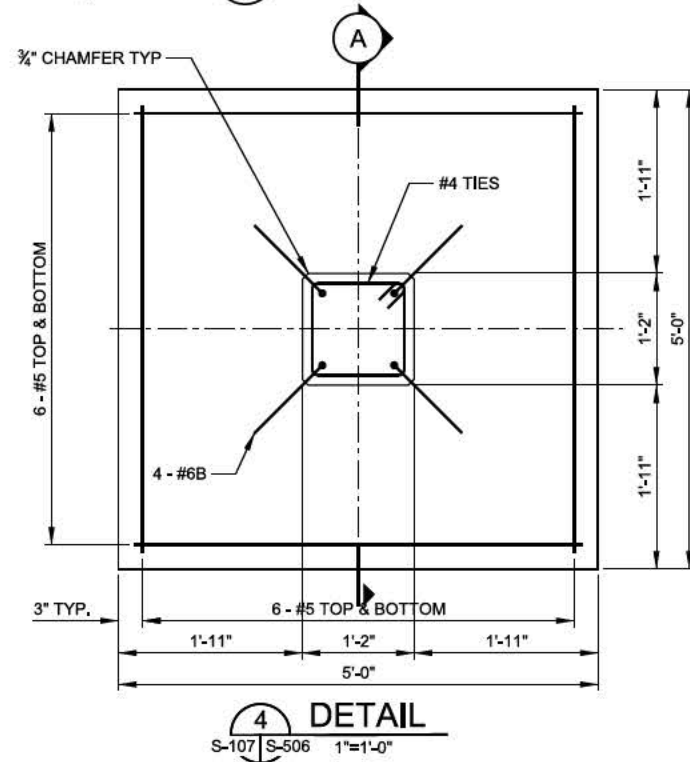








APPR.	DATE
AS-BUILT AS OF 29 SEPTEMBER 2017	
DESCRIPTION	
U.S. ARMY CORPS OF ENGINEERS ROCK ISLAND DISTRICT ROCK ISLAND, ILLINOIS	
DESIGNED BY: KCP	DATE: 26-1-2008
DWN BY: RJR	CHK BY: RJR
SUBMITTED BY: RJR	CONTRACT NO. W935K4-1-2-080
PROJECT CODE: EP102	FILE NAME: EP102_S-506.dgn
SIZE: 12\"/>	
ILLINOIS WATERWAY LAGRANGE, ILL. FLICKER HILL RICE LAKE HABITAT REHAB. & ENHANCEMENT STAGE I CONTROL BUILDING FOUNDATION REINFORCEMENT & PILE CONNECTION DETAILS	
Sheet ID S-506	
AS-BUILT A-87	

1. RAILING SHALL CONFORM TO HORIZONTAL AND VERTICAL ALIGNMENT. POSTS SHALL BE VERTICAL.
2. ALL HANDRAIL PIPE SHALL BE 2"Ø NPS ALUMINUM, SCHEDULE 80, FOR RAILS AND POSTS, UNO. ALUMINUM SHALL BE ALLOY 6061-T6, CONFORMING TO ASTM B221 OR B209.
3. IN ALL AREAS WHERE ALUMINUM AND CONCRETE CAN COME INTO CONTACT USE A 1/8" NEOPRENE GASKET BETWEEN THEM.
4. ALL DIMENSIONS SHALL BE CHECKED AGAINST FIELD SURVEY AND BE ADJUSTED TO FIT.

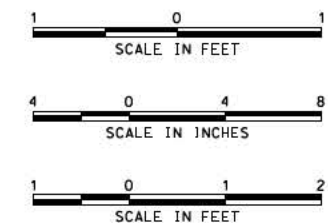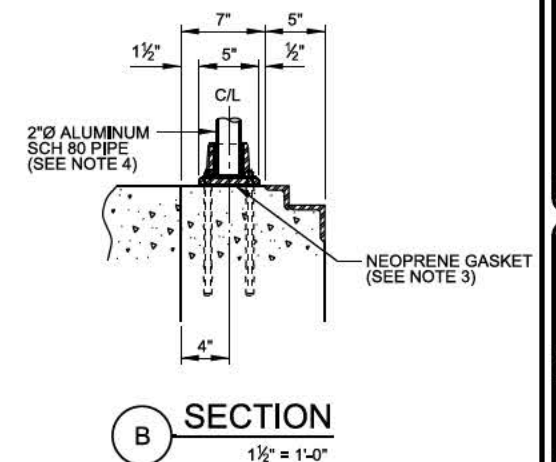



c:\pw\_working\mnt\5\ep102\153734\EP102\_S-508.dgn  
8/28/2018 3:20:37 PM  
BEDDLH

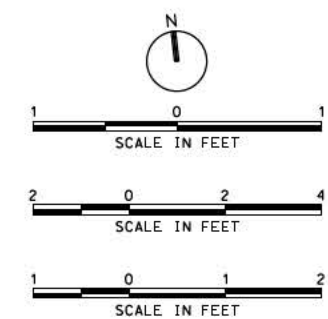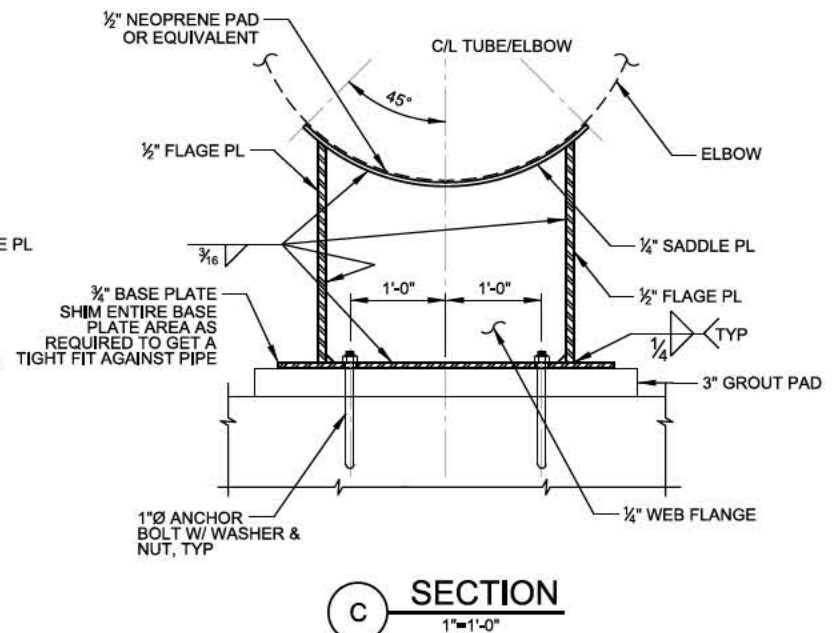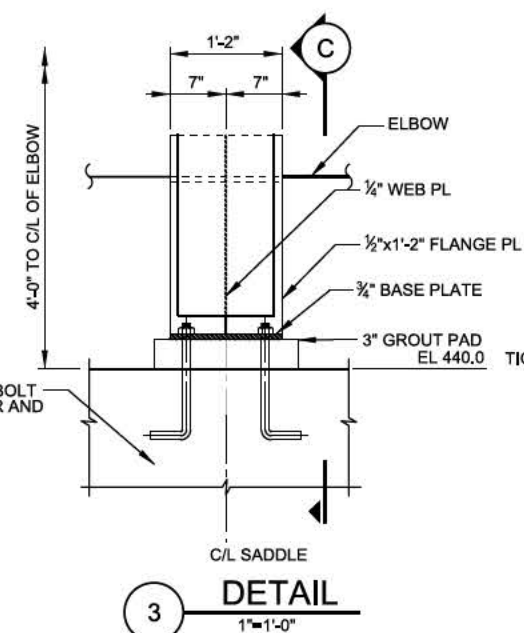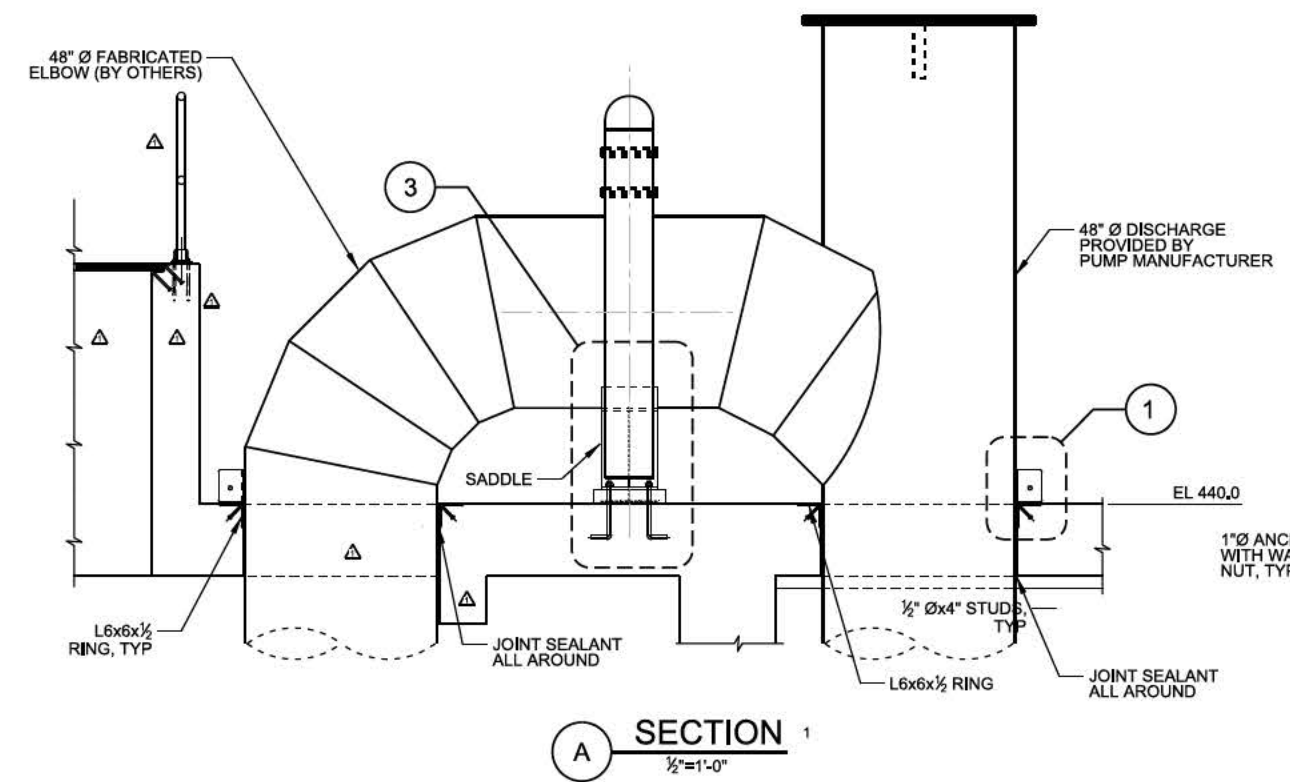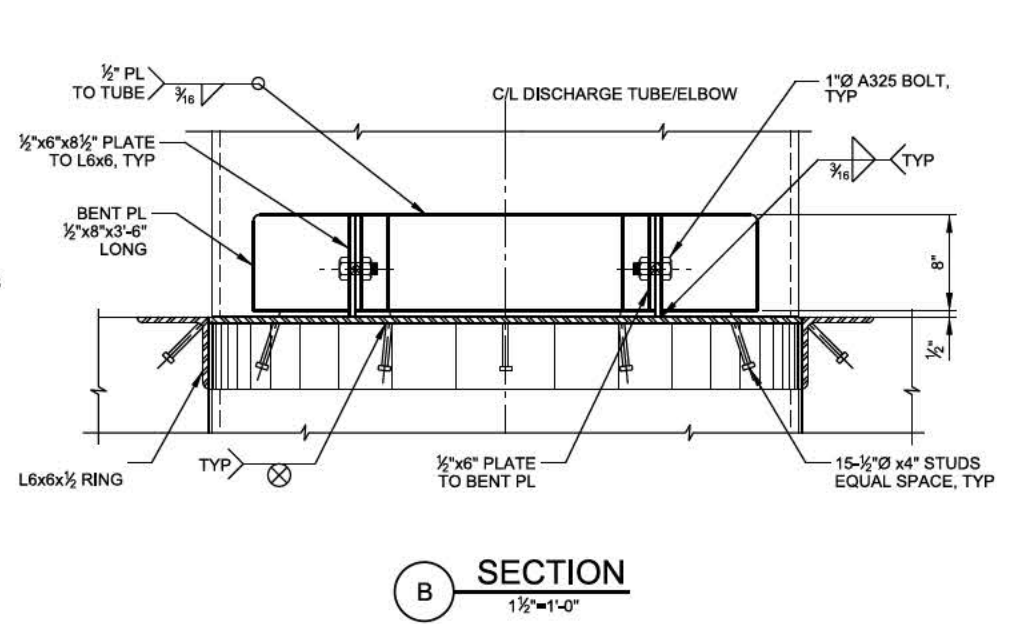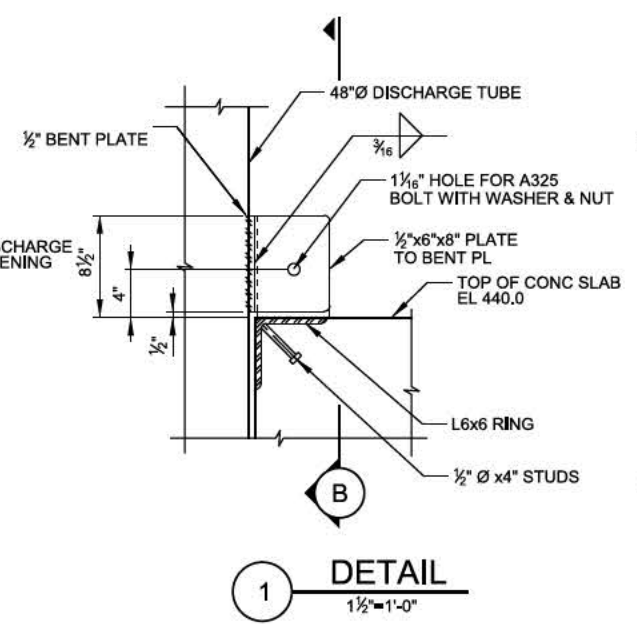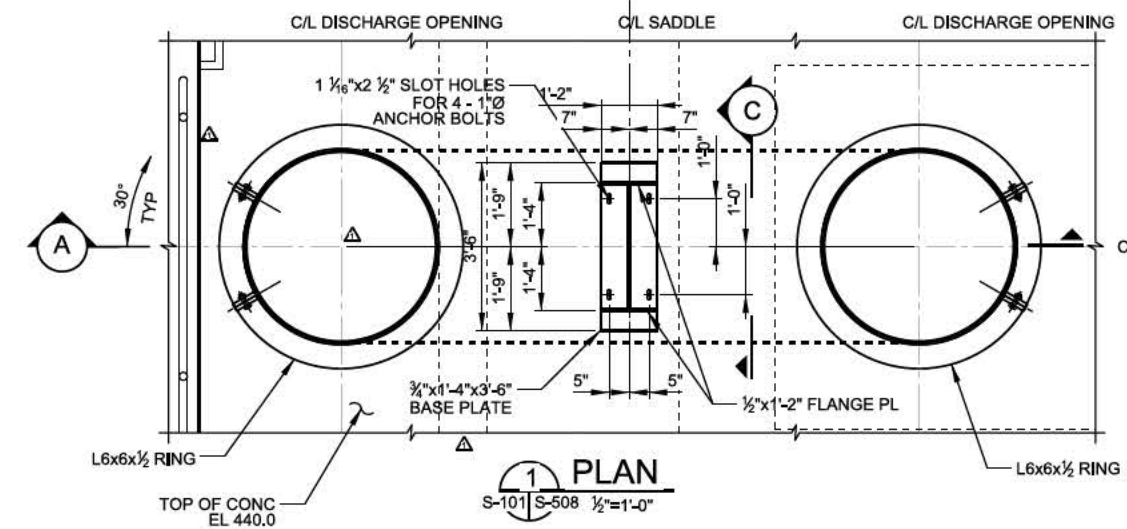

APPROVED	DATE
1	8/21/2012
DESCRIPTION	
MOD E4005-ADD BURGE BASIN WALLS, LADDER AND HANDRAIL, MODIFY PIPE OPENINGS, ADD SLAB BEAM, AS-BUILT AS OF 29 SEPTEMBER 2017	
MARK	FILE NAME
	EP102_S-508.dgn
DESIGNED BY	DATE
KCP	20110626
OWN BY	CHK BY
EP102	EP102
SUBMITTED BY	CONTRACT NO.
EP102	W1235K1-LC4006
PROJECT CODE	PROJECT CODE
EP102	EP102
SIZE	FILE NAME
A4x8 D	EP102_S-508.dgn
U.S. ARMY CORPS OF ENGINEERS ROCK ISLAND DISTRICT ROCK ISLAND, ILLINOIS	
ILLINOIS WATERWAY LAGRANGE POOL RICE LAKE HABITAT REHAB & ENHANCEMENT STAGE I PUMP STATION SIPHON OPENING DETAILS	
Sheet ID S-508	
AS-BUILT A-89	








U.S. ARMY CORPS OF ENGINEERS		FORMED BY:		SOLICITATION NO.:	
ROCK ISLAND DISTRICT		OWN BY:		W9-25C-14-0029	
ROCK ISLAND, ILLINOIS		NPP		CONTRACT NO.:	
		SUBMITTED BY:		W9-25C-14-0096	
		FRG		PROJECT CODE:	
		AS SHOWN		EP102	
		SLOT DATE:		FILE NAME:	
		SIZE:		EP102_04-10-20	
		ANGL D.			


ILLINOIS WATERWAY  
LAGRANGE POOL  
FULTON COUNTY, IL  
RICE LAKE HABITAT REHAB & ENHANCEMENT  
STAGE I  
CONTROL BUILDING  
DETAILS  
SHEET 2 OF 2

Sheet  
ID  
S-510


AS-BUILT  
A-91

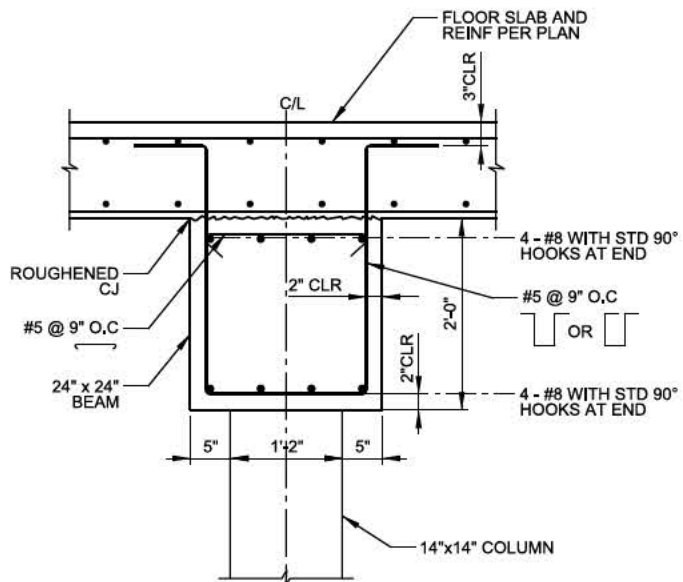


2 FRAME BEAM DETAIL  
S-203 | S-510 1"=1'-0"

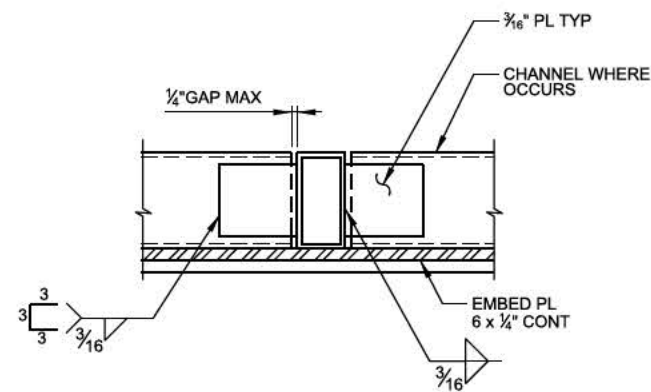


5 CONNECTION DETAIL  
S-308 | S-510 3"=1'-0"

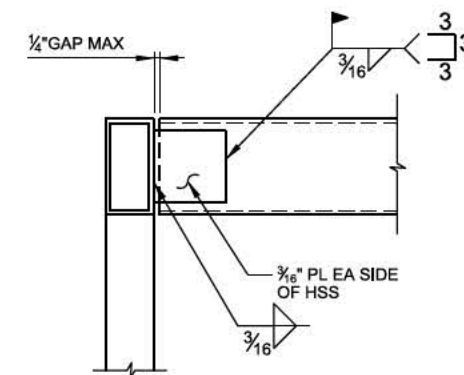

6 CONNECTION DETAIL

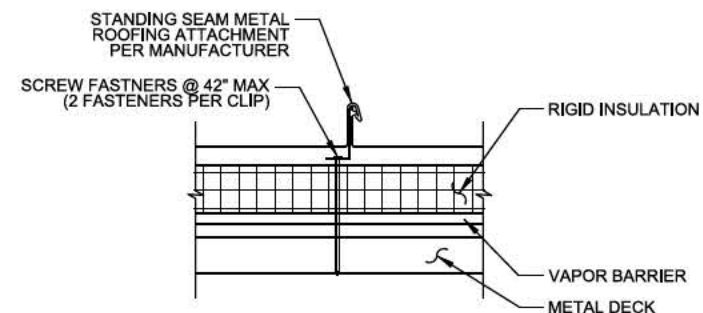

**METAL ROOFING  
INSTALLATION OVER INSULATION**

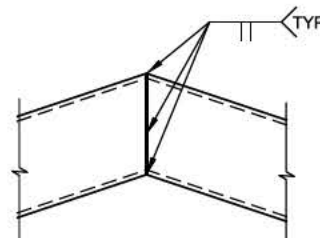


4 ROOF TRUSS SPLICE DETAIL

1. SEE SPECIFICATION SECTION 05 40 00 FOR METAL STUDS REQUIREMENTS.


SECTION	AREA (IN <sup>2</sup> )	EFFECTIVE I <sub>xx</sub> (IN <sup>4</sup> )	EFFECTIVE S <sub>xx</sub> (IN <sup>3</sup> )
- 2½ x 1½" FLANGE x20 GA STUD	0.197	0.203	0.156
- 2½ x 1½" FLANGE x18 GA TRACK	0.225	0.231	0.147

SECTION	AREA (IN <sup>2</sup> )	EFFECTIVE I <sub>xx</sub> (IN <sup>4</sup> )	EFFECTIVE S <sub>xx</sub> (IN <sup>3</sup> )
- 2½ x 1½" FLANGE x20 GA STUD	0.197	0.203	0.156
- 2½ x 1½" FLANGE x18 GA TRACK	0.225	0.231	0.147


c:\pw\_working\mrvlb5edd\hd0153734\EP102\_S-510.dgn  
8/28/2018 3:20:47 PM  
B5EDDLH A

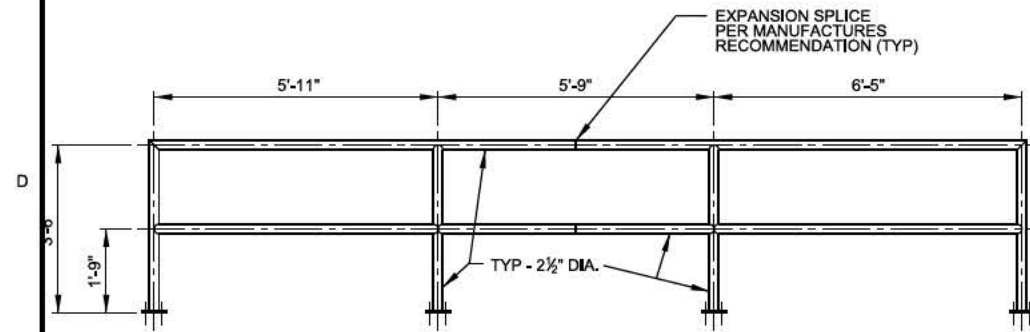


**RIVER SIDE RAILING ELEVATION**  
(MAKE 1 EA - PAINT GRAY)

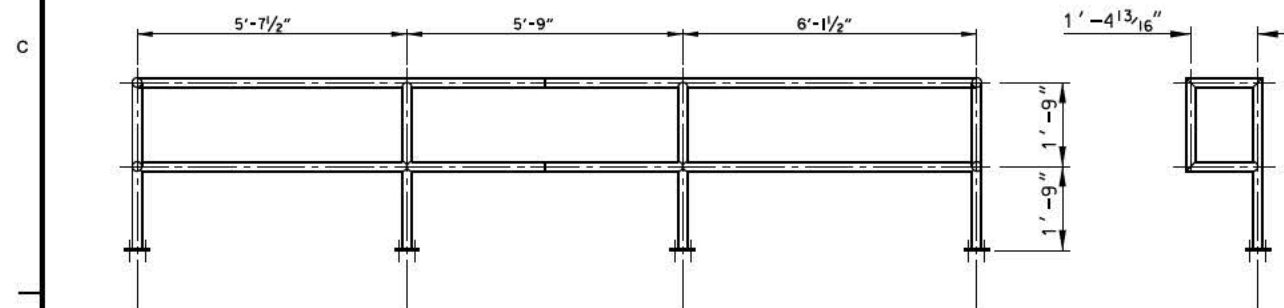


**LAKE SIDE RAILING ELEVATION**  
(MAKE 1 EA - PAINT GRAY)

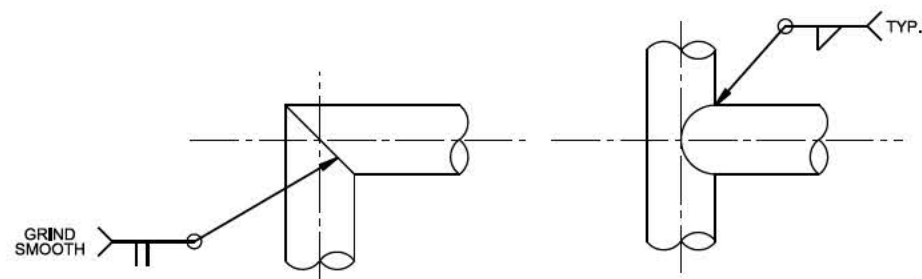


**TYPICAL RAILING PIPE CONNECTIONS**

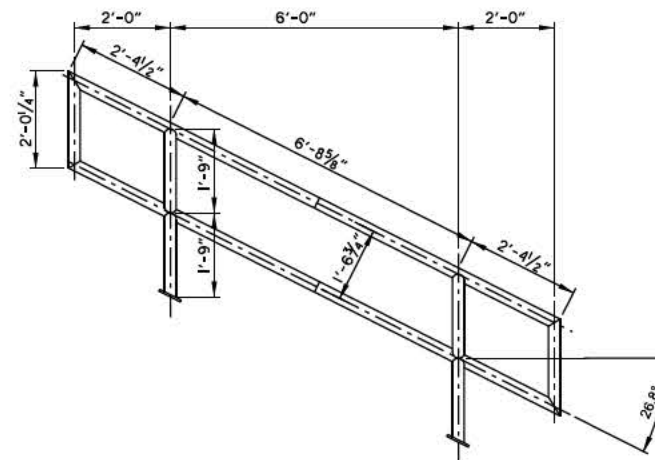


**TYPICAL WINGWALL RAILING ELEVATION**  
(MAKE 4 EA - PAINT GRAY)

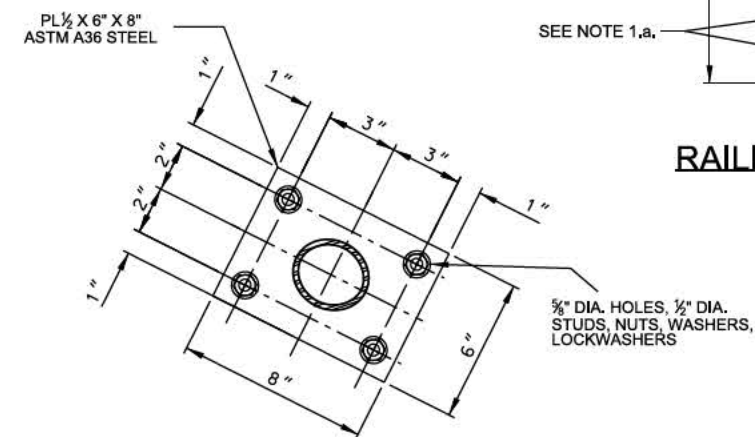


**WING WALL RAILING BASE PLATE - DETAIL PLAN**

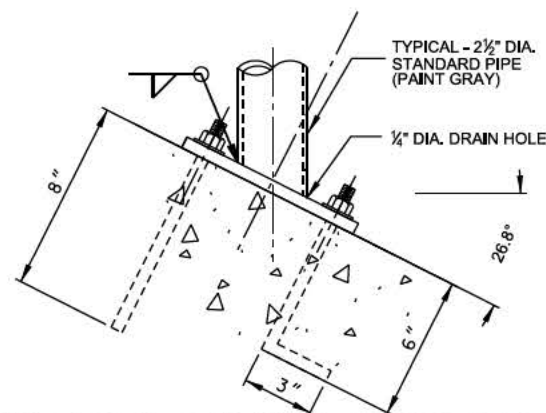

**WING WALL RAILING BASE PLATE - SECTION**

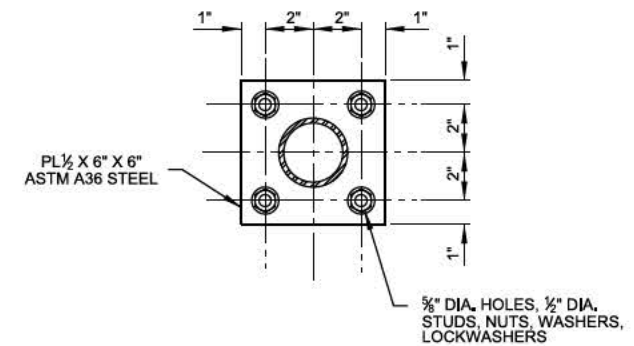

**RAILING BASE PLATE - DETAIL PLAN**

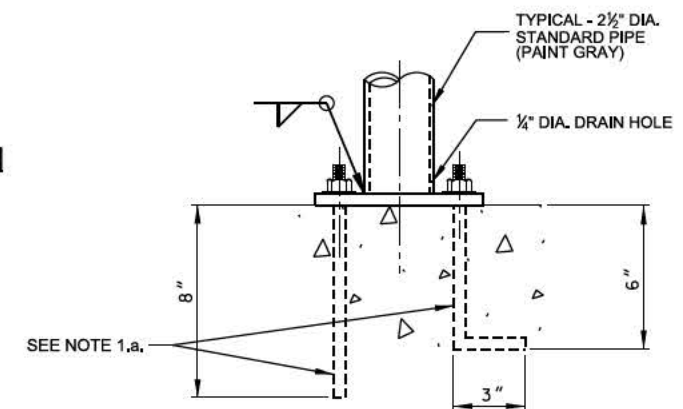

**RAILING BASE PLATE - SECTION**

**NOTES:**

- ANCHORS SHALL CONSIST OF THE FOLLOWING:
  - ANCHOR RODS, NUTS AND WASHERS SHALL BE GALVANIZED STEEL, ANCHOR RODS SHALL BE ASTM A307 (OR BETTER) 1/2" DIA. WITH 8" MIN. EMBEDMENT OR WITH 6" MIN. EMBEDMENT W/HOOK.
  - EPOXY ADHESIVE SHALL PROVIDE A MIN. ALLOWABLE TENSILE STRENGTH EQUAL TO OR GREATER THAN THE TENSILE STRENGTH OF THE ANCHOR ROD.
- ALL RAILING SHALL BE FABRICATED FROM 2 1/2" DIA. ASTM A53 STEEL, GRADE B, STANDARD WEIGHT PIPE. BASE PLATES SHALL BE FABRICATED FROM 1/2" ASTM A36 STEEL PLATE.
- RAILING ASSEMBLIES SHALL BE PAINTED GRAY WITH AN APPROVED PAINT AFTER FABRICATION.

<p>US Army Corps of Engineers</p>	
<p>APPROVED</p> <p>DATE: 07 JUL 10</p> <p>BY: [Signature]</p>	<p>AS-BUILT AS OF 29 SEPTEMBER 2017</p>
<p>DESIGNED BY:</p> <p>CHKD BY:</p> <p>DRN BY:</p> <p>SRV BY:</p> <p>PLT SCALE:</p> <p>AS SHOWN</p>	<p>DATE: 26-10-2006</p> <p>SOLICITATION NO.:</p> <p>CONTRACT NO.:</p> <p>PROJECT CODE:</p> <p>FILE NAME:</p> <p>SIZE:</p> <p>ANSI D</p>
<p>U.S. ARMY CORPS OF ENGINEERS</p> <p>ROCK ISLAND DISTRICT</p> <p>ROCK ISLAND, ILLINOIS</p>	<p>ILLINOIS WATERWAY</p> <p>LAGRANGE, ILL.</p> <p>FLORIAN H. HANSEN</p> <p>RICE LAKE HABITAT REHAB. &amp; ENHANCEMENT</p> <p>STAGE 1</p> <p>OUTLET STRUCTURE</p> <p>HANDRAIL DETAIL</p>
<p>Sheet ID</p> <p><b>S-511</b></p>	
<p>AS-BUILT</p> <p><b>A-92</b></p>	







ITEM	TYPE	QTY	UOM
1" BASE PLATE	ASTM A36	84	SF
1/8" STEEL PLATE	ASTM A36	1	SF
BEAMS	W30x173, A992	3	EA
THREADED ROD	ASTM A 193 B8	60	EA
NUTS	ASTM A 194 GRADE 8	60	EA
WASHERS	ASTM S5304	60	EA



## SCALE: 6"=1'-0"

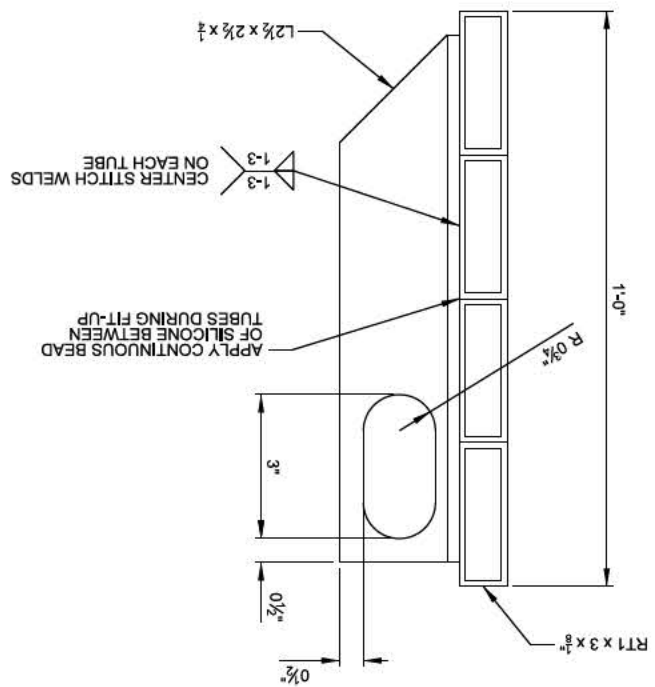


SCALE: 6"=1'-0"

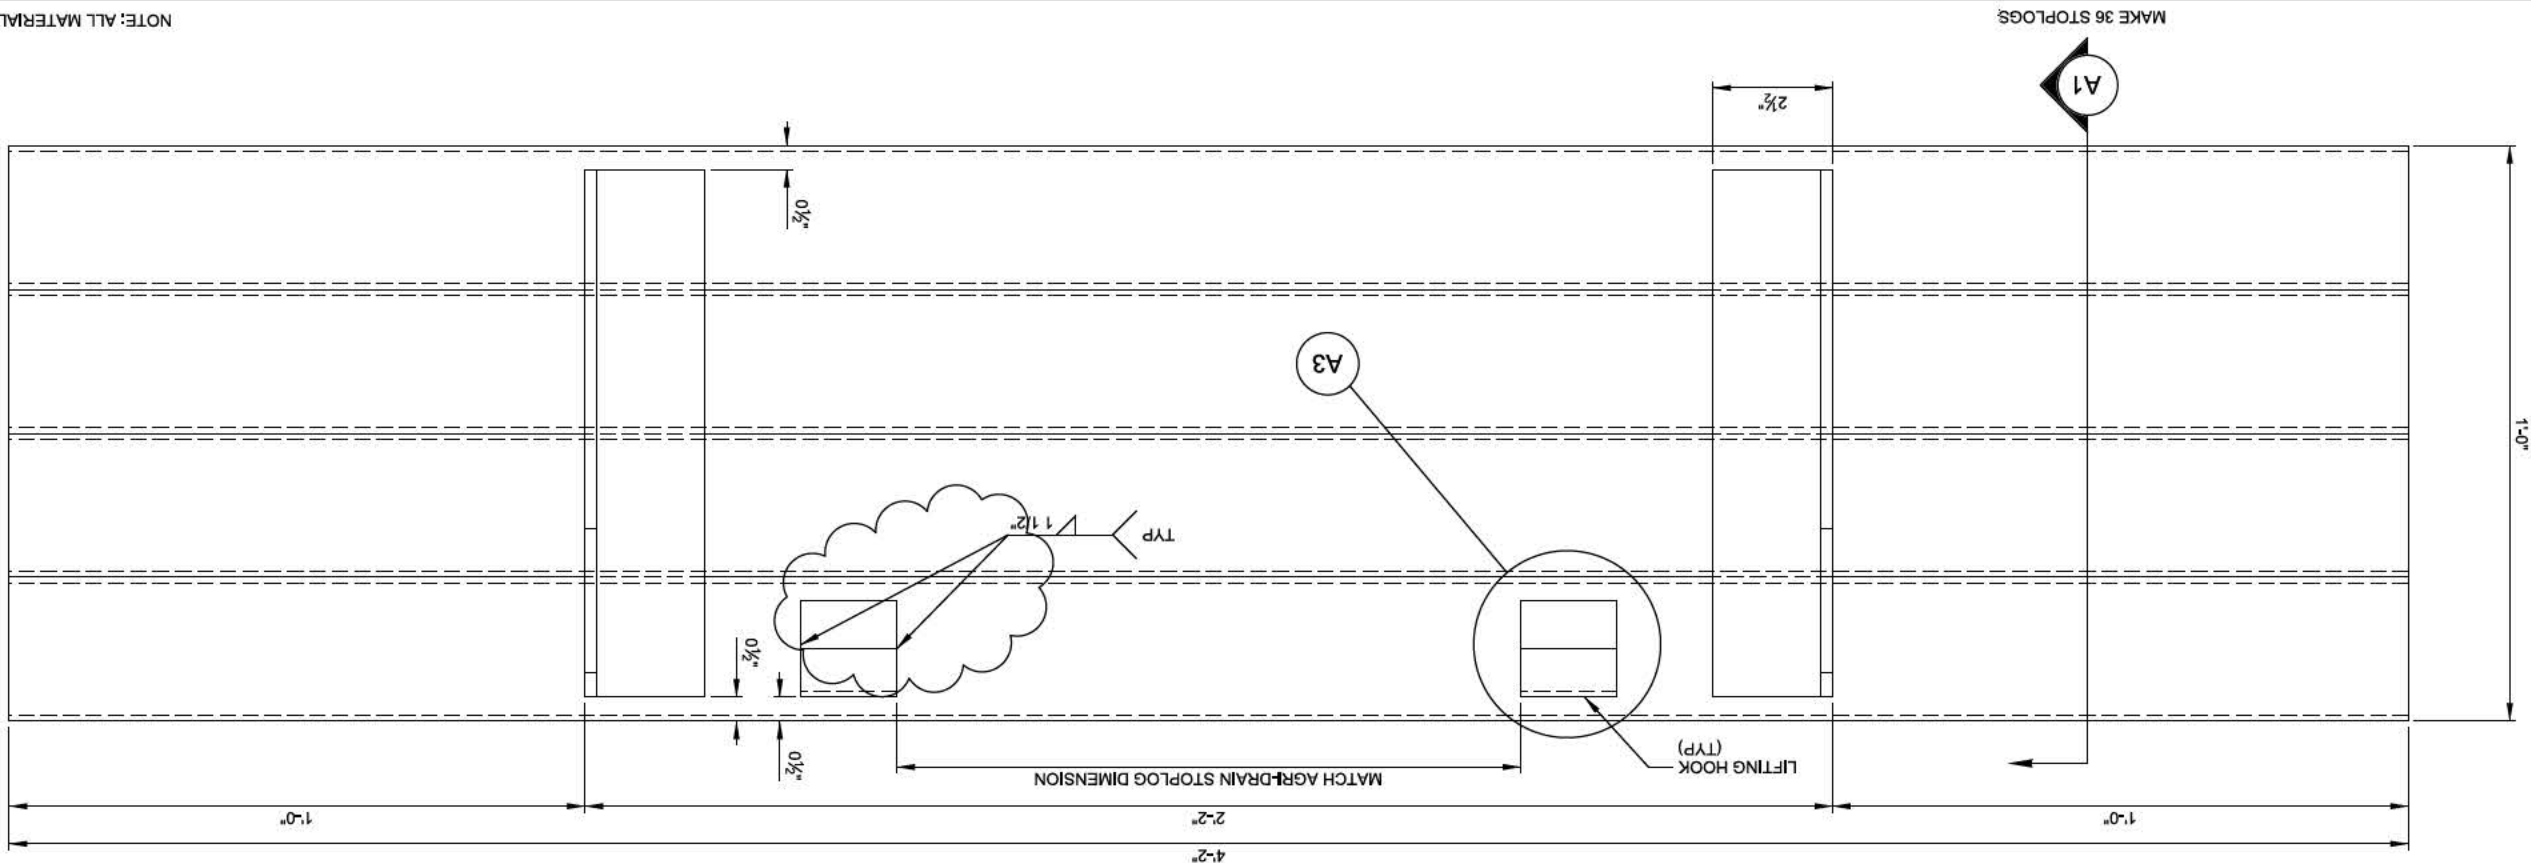

NOTE: ALL MATERIAL TO BE 6061 T6 ALUMINUM

A3

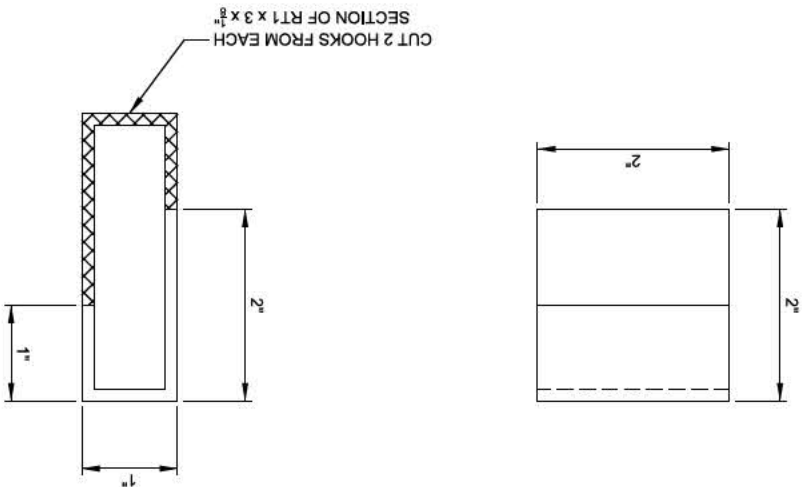

CUT 2 HOOKS FROM EACH SECTION OF RT1 x 3 x  $\frac{3}{8}$ "

S-519

**ILLINOIS WATERWAY  
LAGRANGE POOL  
FULTON COUNTY, IL  
RICE LAKE HABITAT REHAB & ENHANCEMENT  
STAGE I  
SLIDE GATE TO STOPLOG  
CONVERSION DETAILS**

U.S. ARMY CORPS OF ENGINEERS  
ROCK ISLAND DISTRICT  
ROCK ISLAND, ILLINOIS

DATE:		DATE BY:	
2017/06/30		KORIBICH	
SOLICITATION NO.:		DWN BY:	
WY12EK1-1-P-0029		NPP	
CONTRACT NO.:		SUBMITTED BY:	
WY12EK1-P-C-0080		FRI	
PROJECT CODE:		PLOT SCALE:	
EP102		AS SHOWN	
FILE NAME:		SIZE:	
EP102_5-619.dwg		AND	

**D**

AS-BUILT AS OF 29 SEPTEMBER 2017

DESCRIPTION


DATE	APPROF
------	--------




US Army Corps of Engineers®



- NOTES:
1. INSTALL SLIDE GATE AND STEM SUPPORTS PER MANUFACTURER'S SPECIFICATIONS.
  2. 48" AND 54" CMP SHALL CONFIRM TO ASHTO M190 TYPE A AND ASTM A760/A AND ASTM A798/A.
  3. PLACE AND COMPACT THE BACKFILL IN 6 TO 12 INCHES OF THICKNESS OF COMPACTED LIFTS.

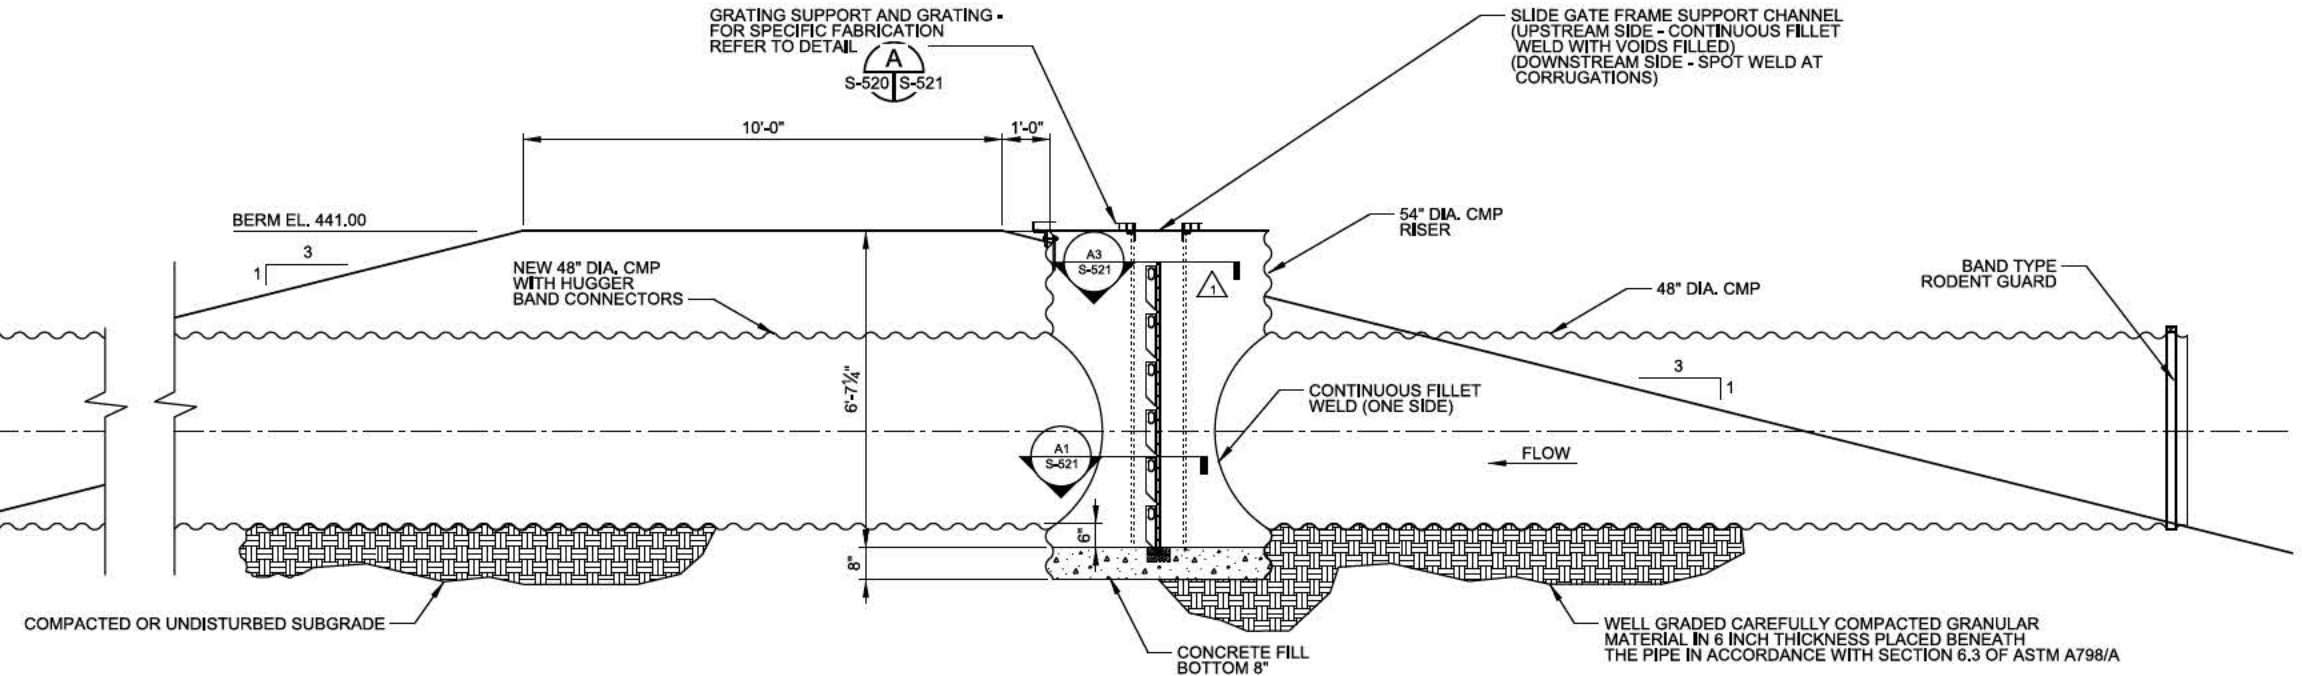


48" CMP GATE STRUCTURE - PROFILE

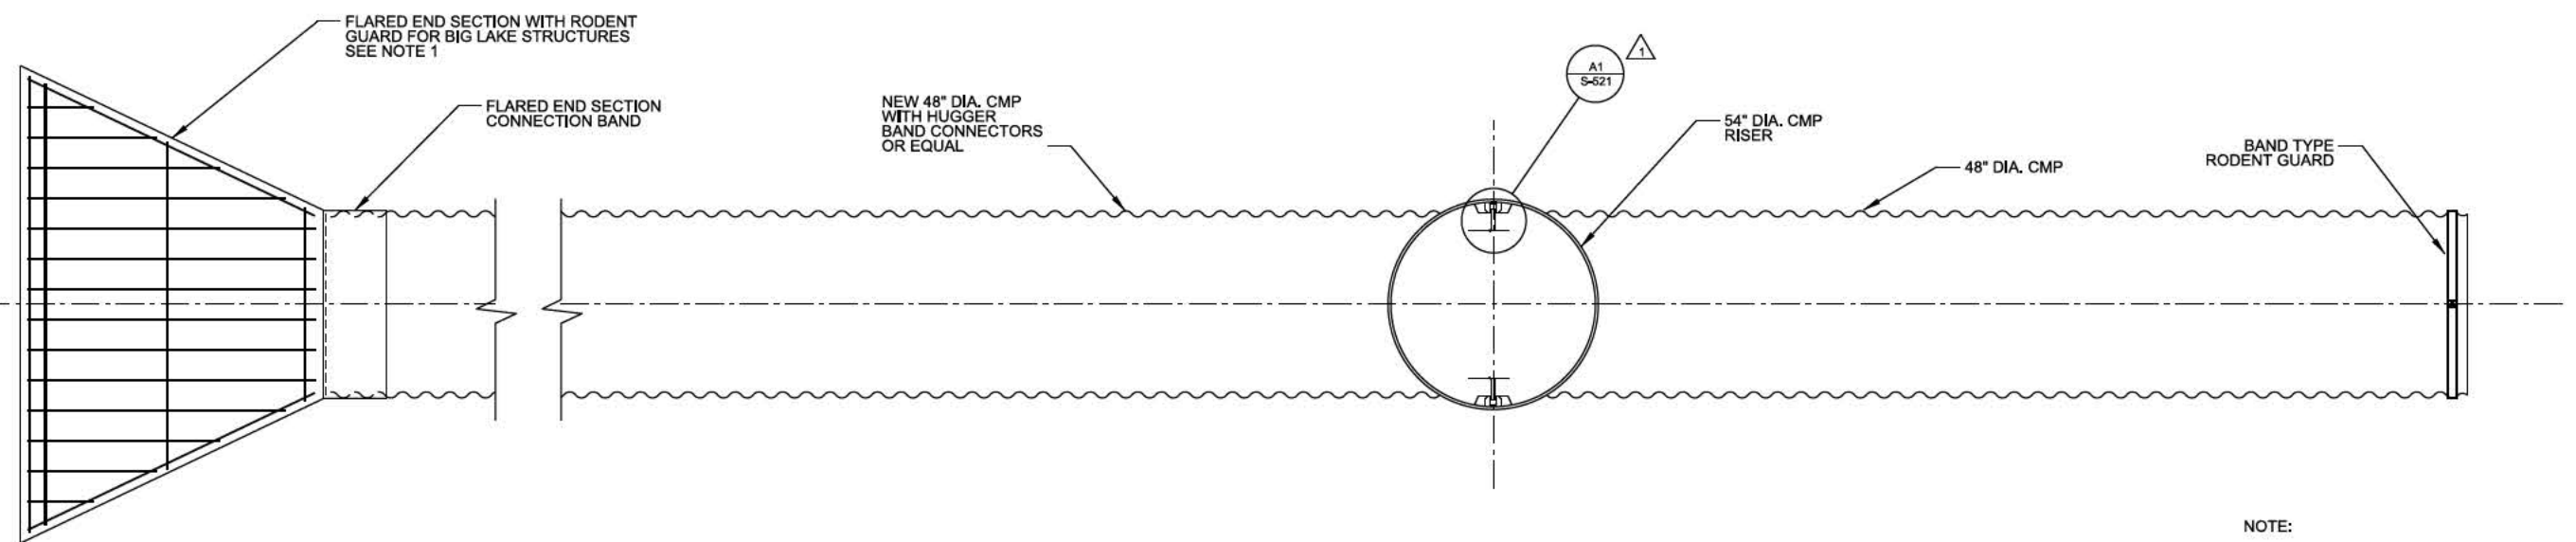

- NOTE:
1. FOR RICE LAKE STRUCTURES, INSTALL BAND TYPE RODENT GUARD.

48" CMP GATE STRUCTURE - PLAN

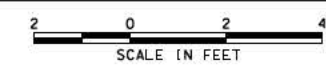


DATE	DESCRIPTION
08/02/2014	1. EADIT CONVERT SLIDE GATE TO STOPLOG AS-BUILT AS OF 29 SEPTEMBER 2017

DESIGNED BY:	DATE:	SOLICITATION NO.:
CHKD BY:	20110626	
DRN BY:		
SUBMITTED BY:		
FILE NAME:		
FILE ID:		


ILLINOIS WATERWAY LA GRANGE POOL FLUORIDE TREATMENT RICE LAKE HABITAT REHAB & ENHANCEMENT STAGE 1	U.S. ARMY CORPS OF ENGINEERS ROCK ISLAND DISTRICT ROCK ISLAND, ILLINOIS
---	---

WATER CONTROL STRUCTURES DETAILS SHEET 1 OF 2
--


c:\pwworking\mrvts\cadd\103734\EP102\_S-521.dgn  
8/28/2018 3:21:21 PM  
BEDDLH

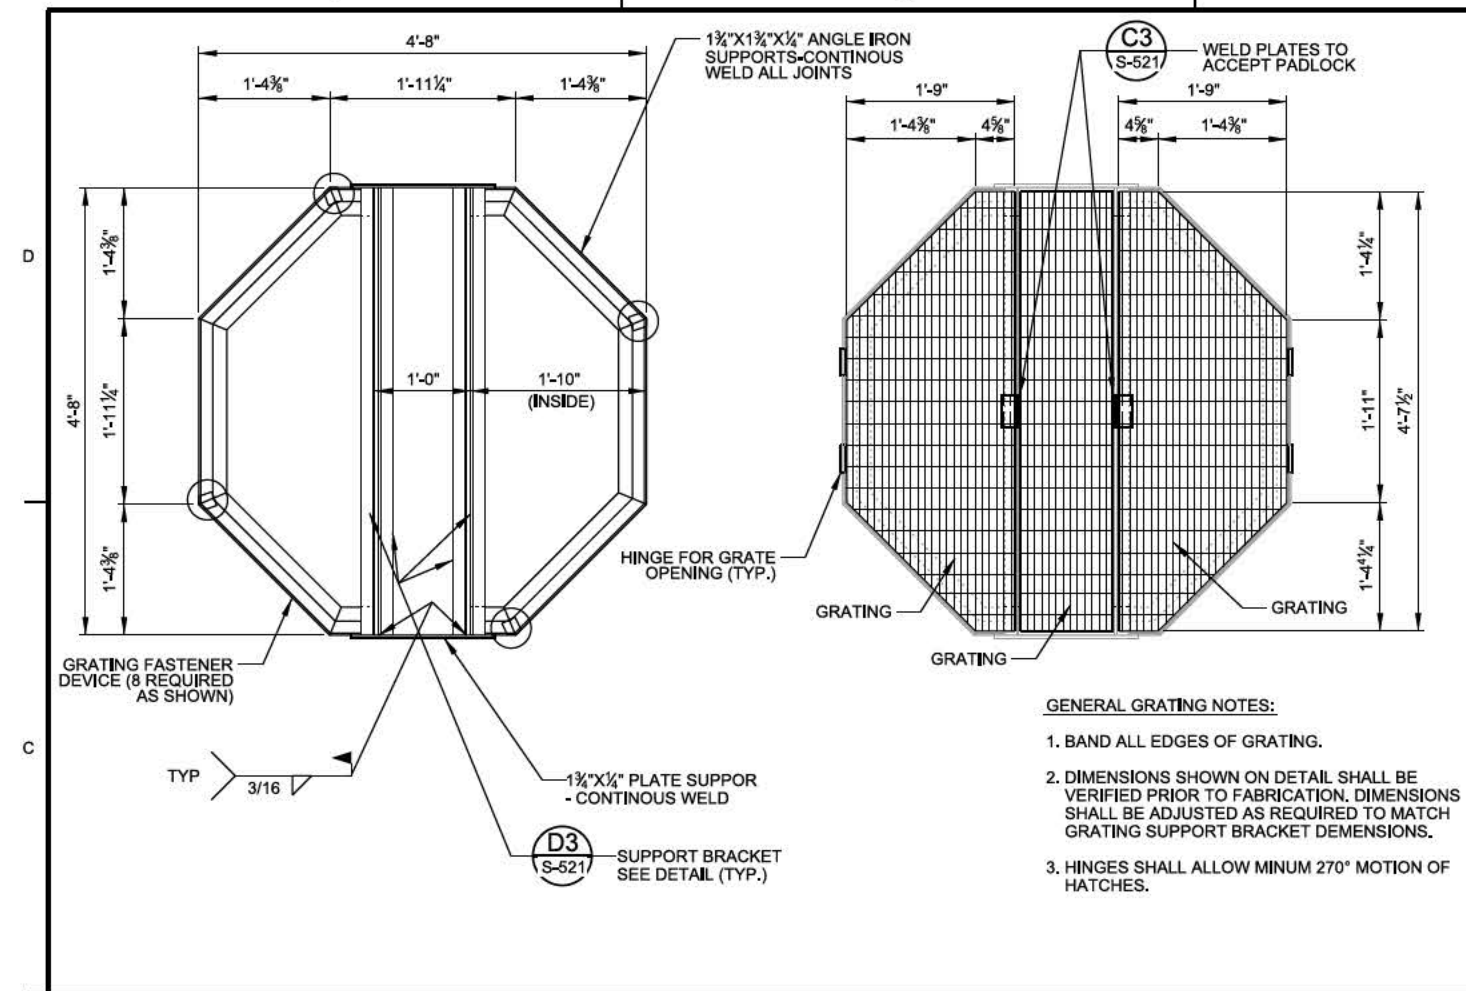


**A** GRATING SUPPORT BRACKET & GRATING  
S-520 S-521 NO SCALE

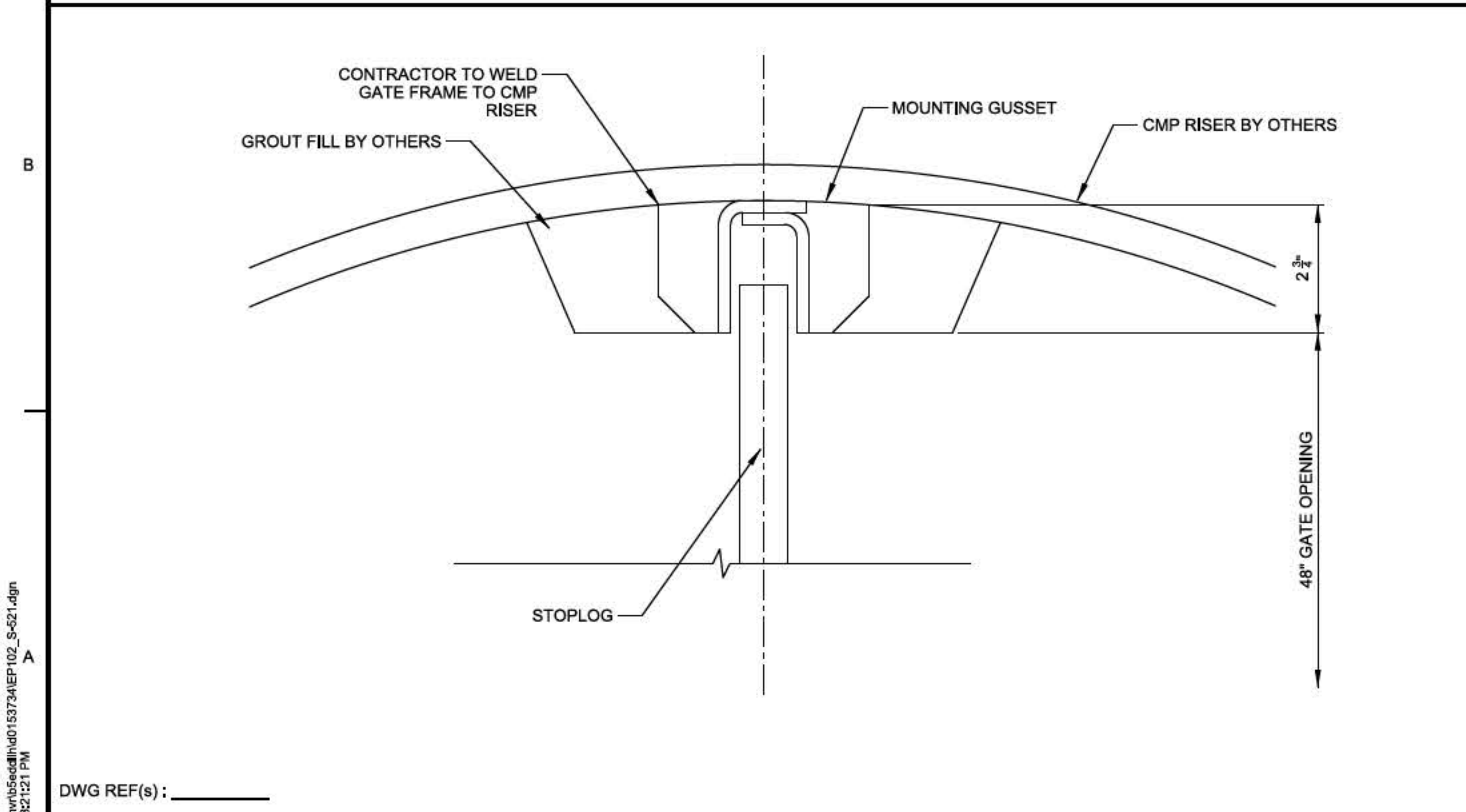


**A1** GATE CHANNEL  
SCALE: NO SCALE

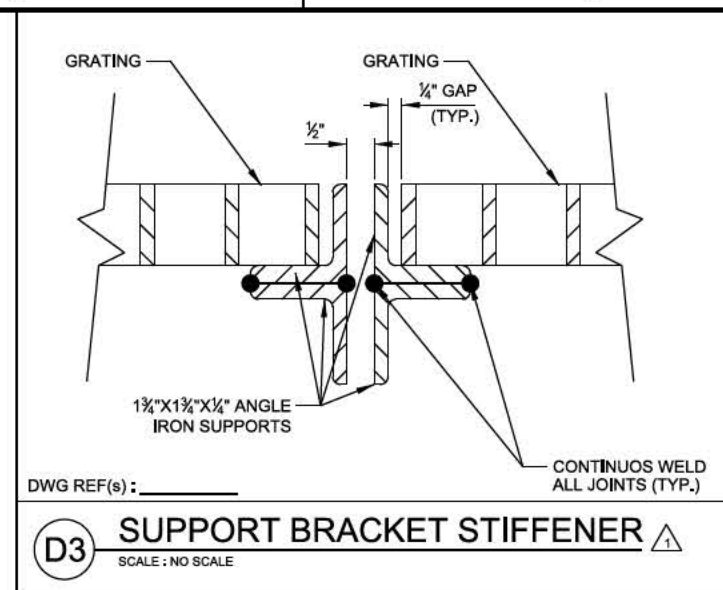

**D3** SUPPORT BRACKET STIFFENER  
SCALE: NO SCALE

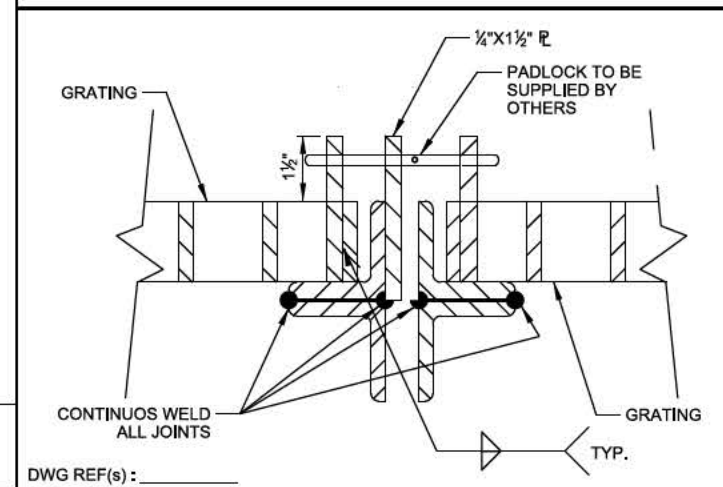

**C3** LOCKING  
SCALE: NO SCALE

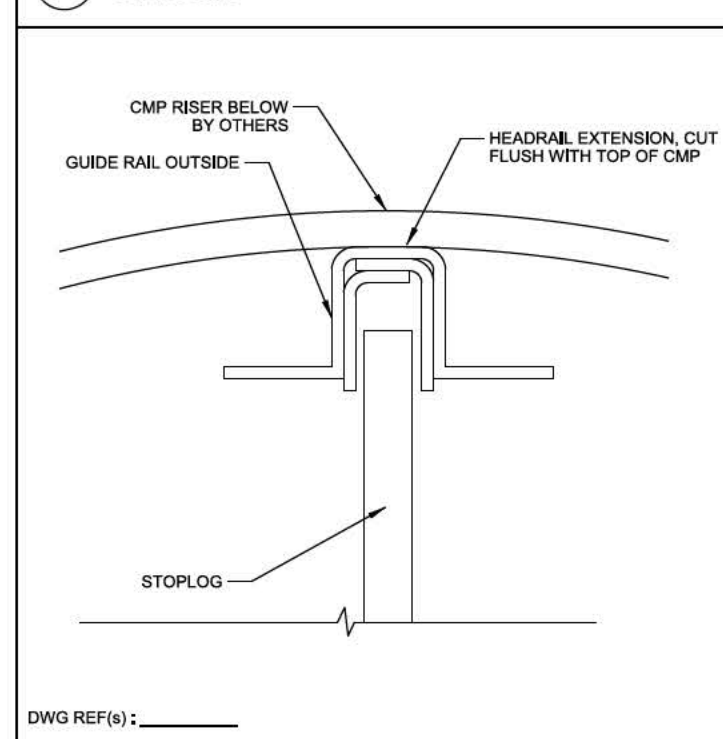

**A3** GATE CHANNEL  
SCALE: NO SCALE

DATE: 08/02/2014	DESCRIPTION: EAD017 REVISED TO CONVERT SLIDE GATE TO STOPLOG, GRATING AND ANGLE ADDED
APPROVED: [Signature]	AS-BUILT AS OF 29 SEPTEMBER 2017
DESIGNED BY: KCP	CHECKED BY: [Signature]
DRAWN BY: [Signature]	SUBMITTED BY: [Signature]
PROJECT NO: W032541-1-2008	PROJECT CODE: EP102
FILE NAME: EP102_S-521.dgn	ANALYST: [Signature]
ILLINOIS WATERWAY LA GRANGE, ILL. RICE LAKE HABITAT REPAIR & ENHANCEMENT STAGE I WATER CONTROL STRUCTURES DETAILS	
SHEET 2 OF 2	
Sheet ID S-521	
AS-BUILT A-96	





PUMP STATION SECTIONAL PLAN - EL. 432.0



SCALE IN FEET

Sheet  
ID  
M-101

ILLINOIS WATERWAY  
LAGRANGE POOL  
FULTON COUNTY, IL  
RICE LAKE HABITAT REHAB & ENHANCEMENT  
STAGE I  
PUMP STATION  
SECTIONAL PLAN

U.S. ARMY CORPS OF ENGINEERS  
ROCK ISLAND DISTRICT  
ROCK ISLAND, ILLINOIS

DESIGN NO. 91.	DATE
1/10/63/30	
DOWN BY:	CKD BY:
DEED	MKS
SUBMITTED BY:	SOLICITATION NO.:
	W912EK-1-R-0029
	CONTRACT NO.:

AS-BUILT AS OF 28 SEPTEMBER 2017


## DESCRIPTION

DATE	APPRN.

US Army Corps  
of Engineers


c:\pwworking\mmt5\cad\h0153755\EP102M-102.dgn  
3/21/17 PM  
BEDDLN

# PUMP STATION TOP PLAN

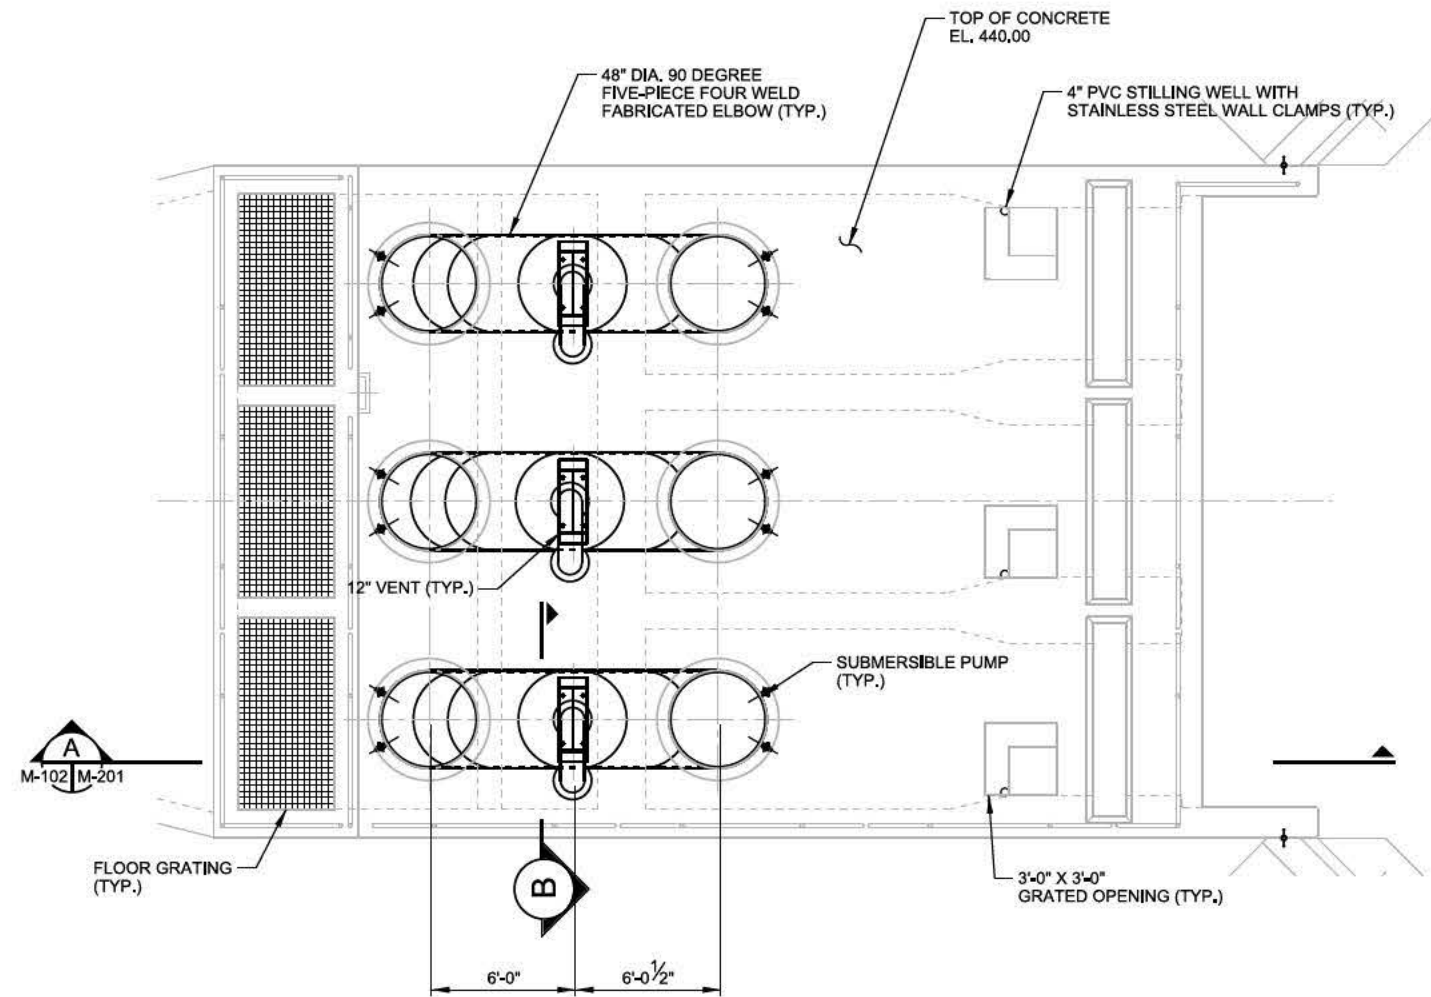

0 2' 4' 8'  
SCALE IN FEET

## B VENT DETAIL (TYP.) NOT TO SCALE

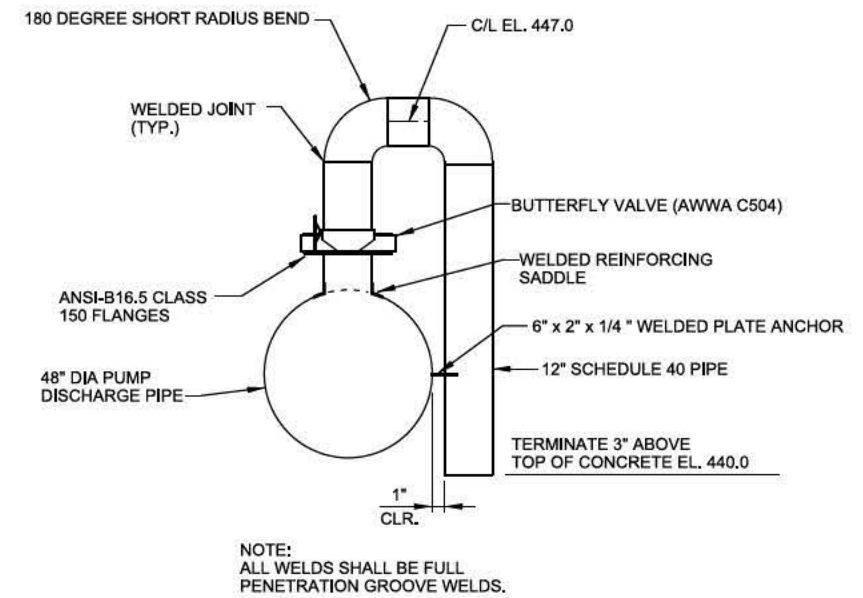

DATE	DESCRIPTION
AS-BUILT AS OF 28 SEPTEMBER 2017	

DESIGNED BY: JWS	DATE: 2/1/2016	SOLICITATION NO.: W123541-1-2016
DRAWN BY: JWS	CAD BY: JWS	CONTRACT NO.: W123541-1-2016
SUBMITTED BY: JWS	PLAT DATE: AS SHOWN	PROJECT CODE: EP102
FILE NAME: EP102M-102.dgn	SIZE: ANSI D	


ILLINOIS WATERWAY  
LAGRANGE POOL  
FLUOROCARBON  
RICE LAKE HABITAT REHAB & ENHANCEMENT  
STAGE I  
PUMP STATION  
TOP PLAN

Sheet  
ID  
M-102

AS-BUILT  
A-98



c:\pwworking\mmt5\calh0153755\EP102M-201.dgn  
3/21/14 PM  
BEDDLN

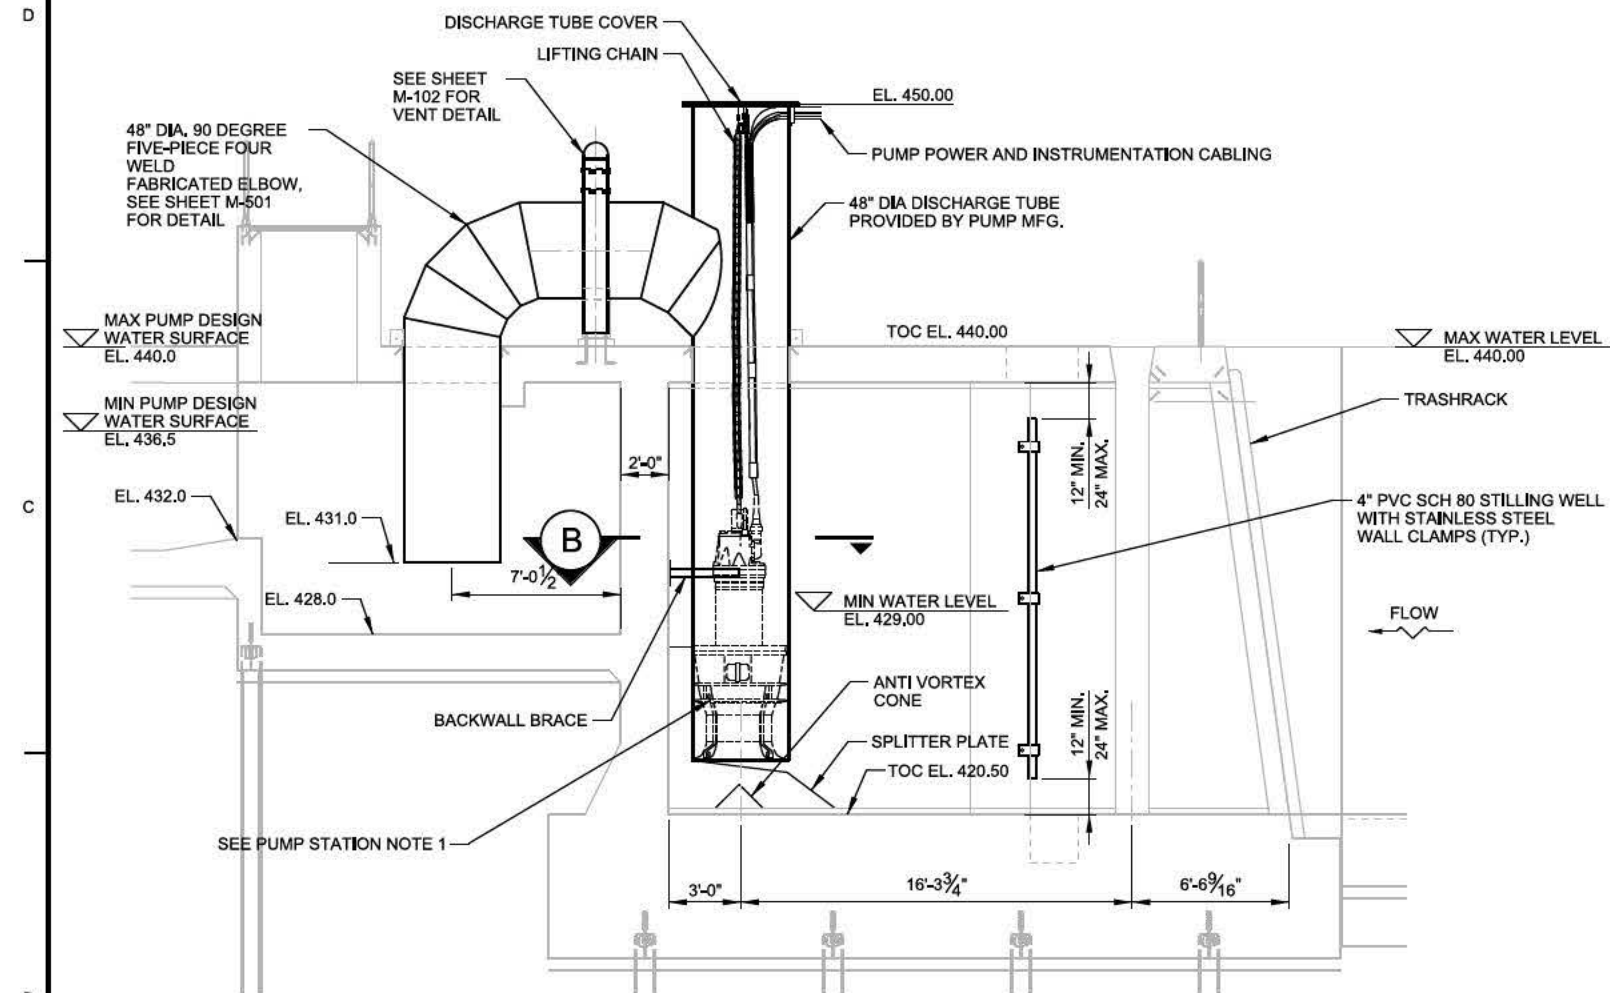

**PUMP STATION NOTES:**


1. THE BASIS OF DESIGN IS PROVIDED FOR EACH PUMP'S HORSEPOWER (HP) AND FULL LOAD AMPS (FLA). ALSO SEE DIAGRAM AND GENERAL NOTE 1 ON SHEET E-601. THE CONTRACTOR SHALL BE RESPONSIBLE TO RE-SIZE AND PROVIDE LARGER ELECTRICAL EQUIPMENT TO ACCOMMODATE LARGER PUMPS IF THE ACTUAL PUMPS PROVIDED ARE DIFFERENT THAN THE BASIS OF DESIGN.

**A PUMP STATION SECTION**

M-101 M-201  
M-102

0 2' 4' 8'  
SCALE IN FEET

**B PUMP DISCHARGE TUBE BACKWALL BRACE DETAIL (TYP)**

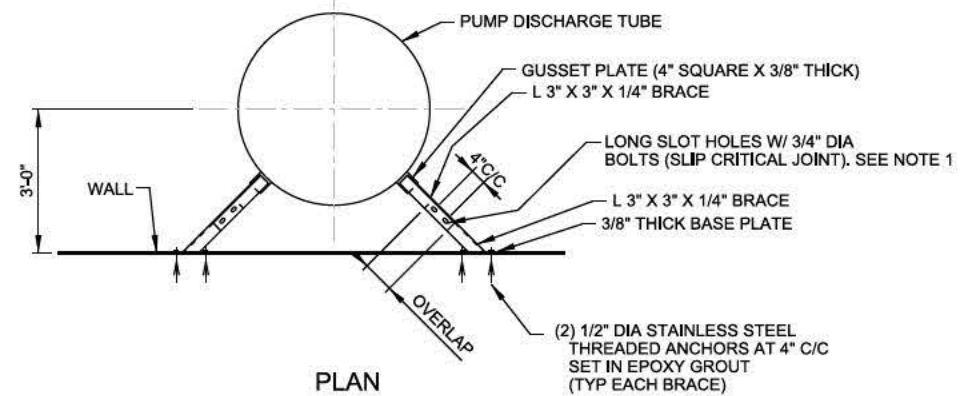

**BACKWALL BRACE NOTES:**

1. NO PAINT OR PRIMER WITHIN 1" OF EDGE OF HOLES PRIOR TO BOLT TENSIONING.
2. PROVIDE SLOTS IN PLY(ANGLE), NOT BOTH L 3" X 3" X 1/4"
3. PRE-TENSION BOLTS AT SLOTS.

0 1' 2' 4'  
SCALE IN FEET



DATE	DESCRIPTION
20170920	AS-BUILT AS OF 29 SEPTEMBER 2017


DESIGNED BY: JMS	DATE: 20170920	SOLICITATION NO.:
DWN BY: JMS	COG BY: JMS	CONTRACT NO.:
SUBMITTED BY: H.A.	PROJECT CODE:	PROJECT NAME:
FILE NAME: EP102M-201.dgn	FILE NAME:	FILE NAME:

ILLINOIS WATERWAY LARGESCALE FLIGHTS RICE LAKE HABITAT REPAIR & ENHANCEMENT STAGE I	PUMP STATION SECTION
---	-------------------------

Sheet ID  
**M-201**

AS-BUILT  
A-99

## DISCHARGE PIPE - PLAN

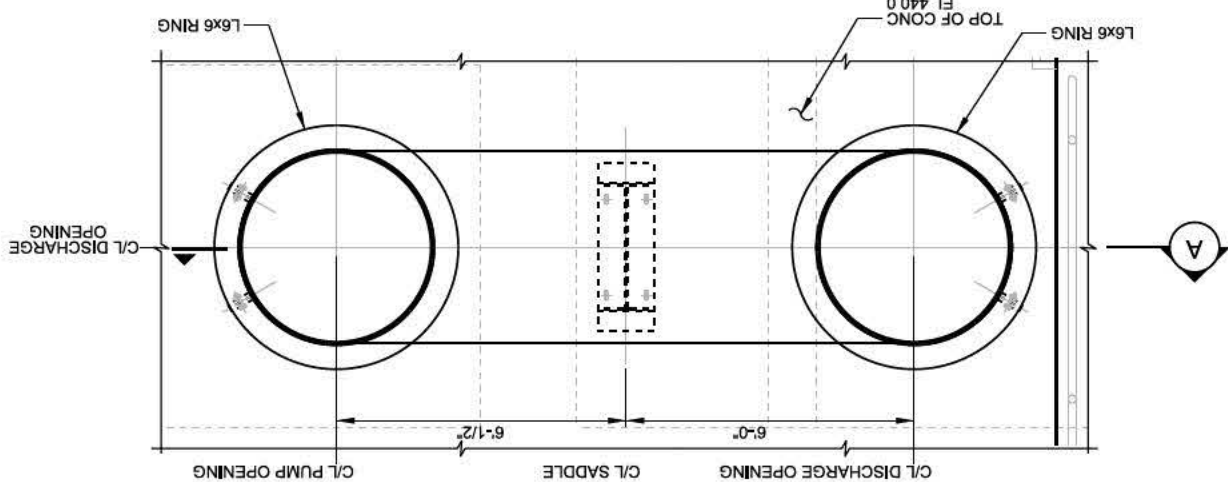

SCALE IN FEET

A horizontal scale bar with a black and white alternating pattern. It is labeled "SCALE IN FEET" at the top. Below the bar, there are numerical markings at 0, 1, 2, and 4. The bar is divided into segments: a black segment from 0 to 1, a white segment from 1 to 2, a black segment from 2 to 3, and a white segment from 3 to 4.

- NOTES:

[illegible]










c:\pwworking\mmt5ecad\h0153758\EP102E-101.dgn  
3/22/2013 PM 3:22:03  
BEDDLIN

A  
B  
C  
D



# ELECTRICAL SITE PLAN

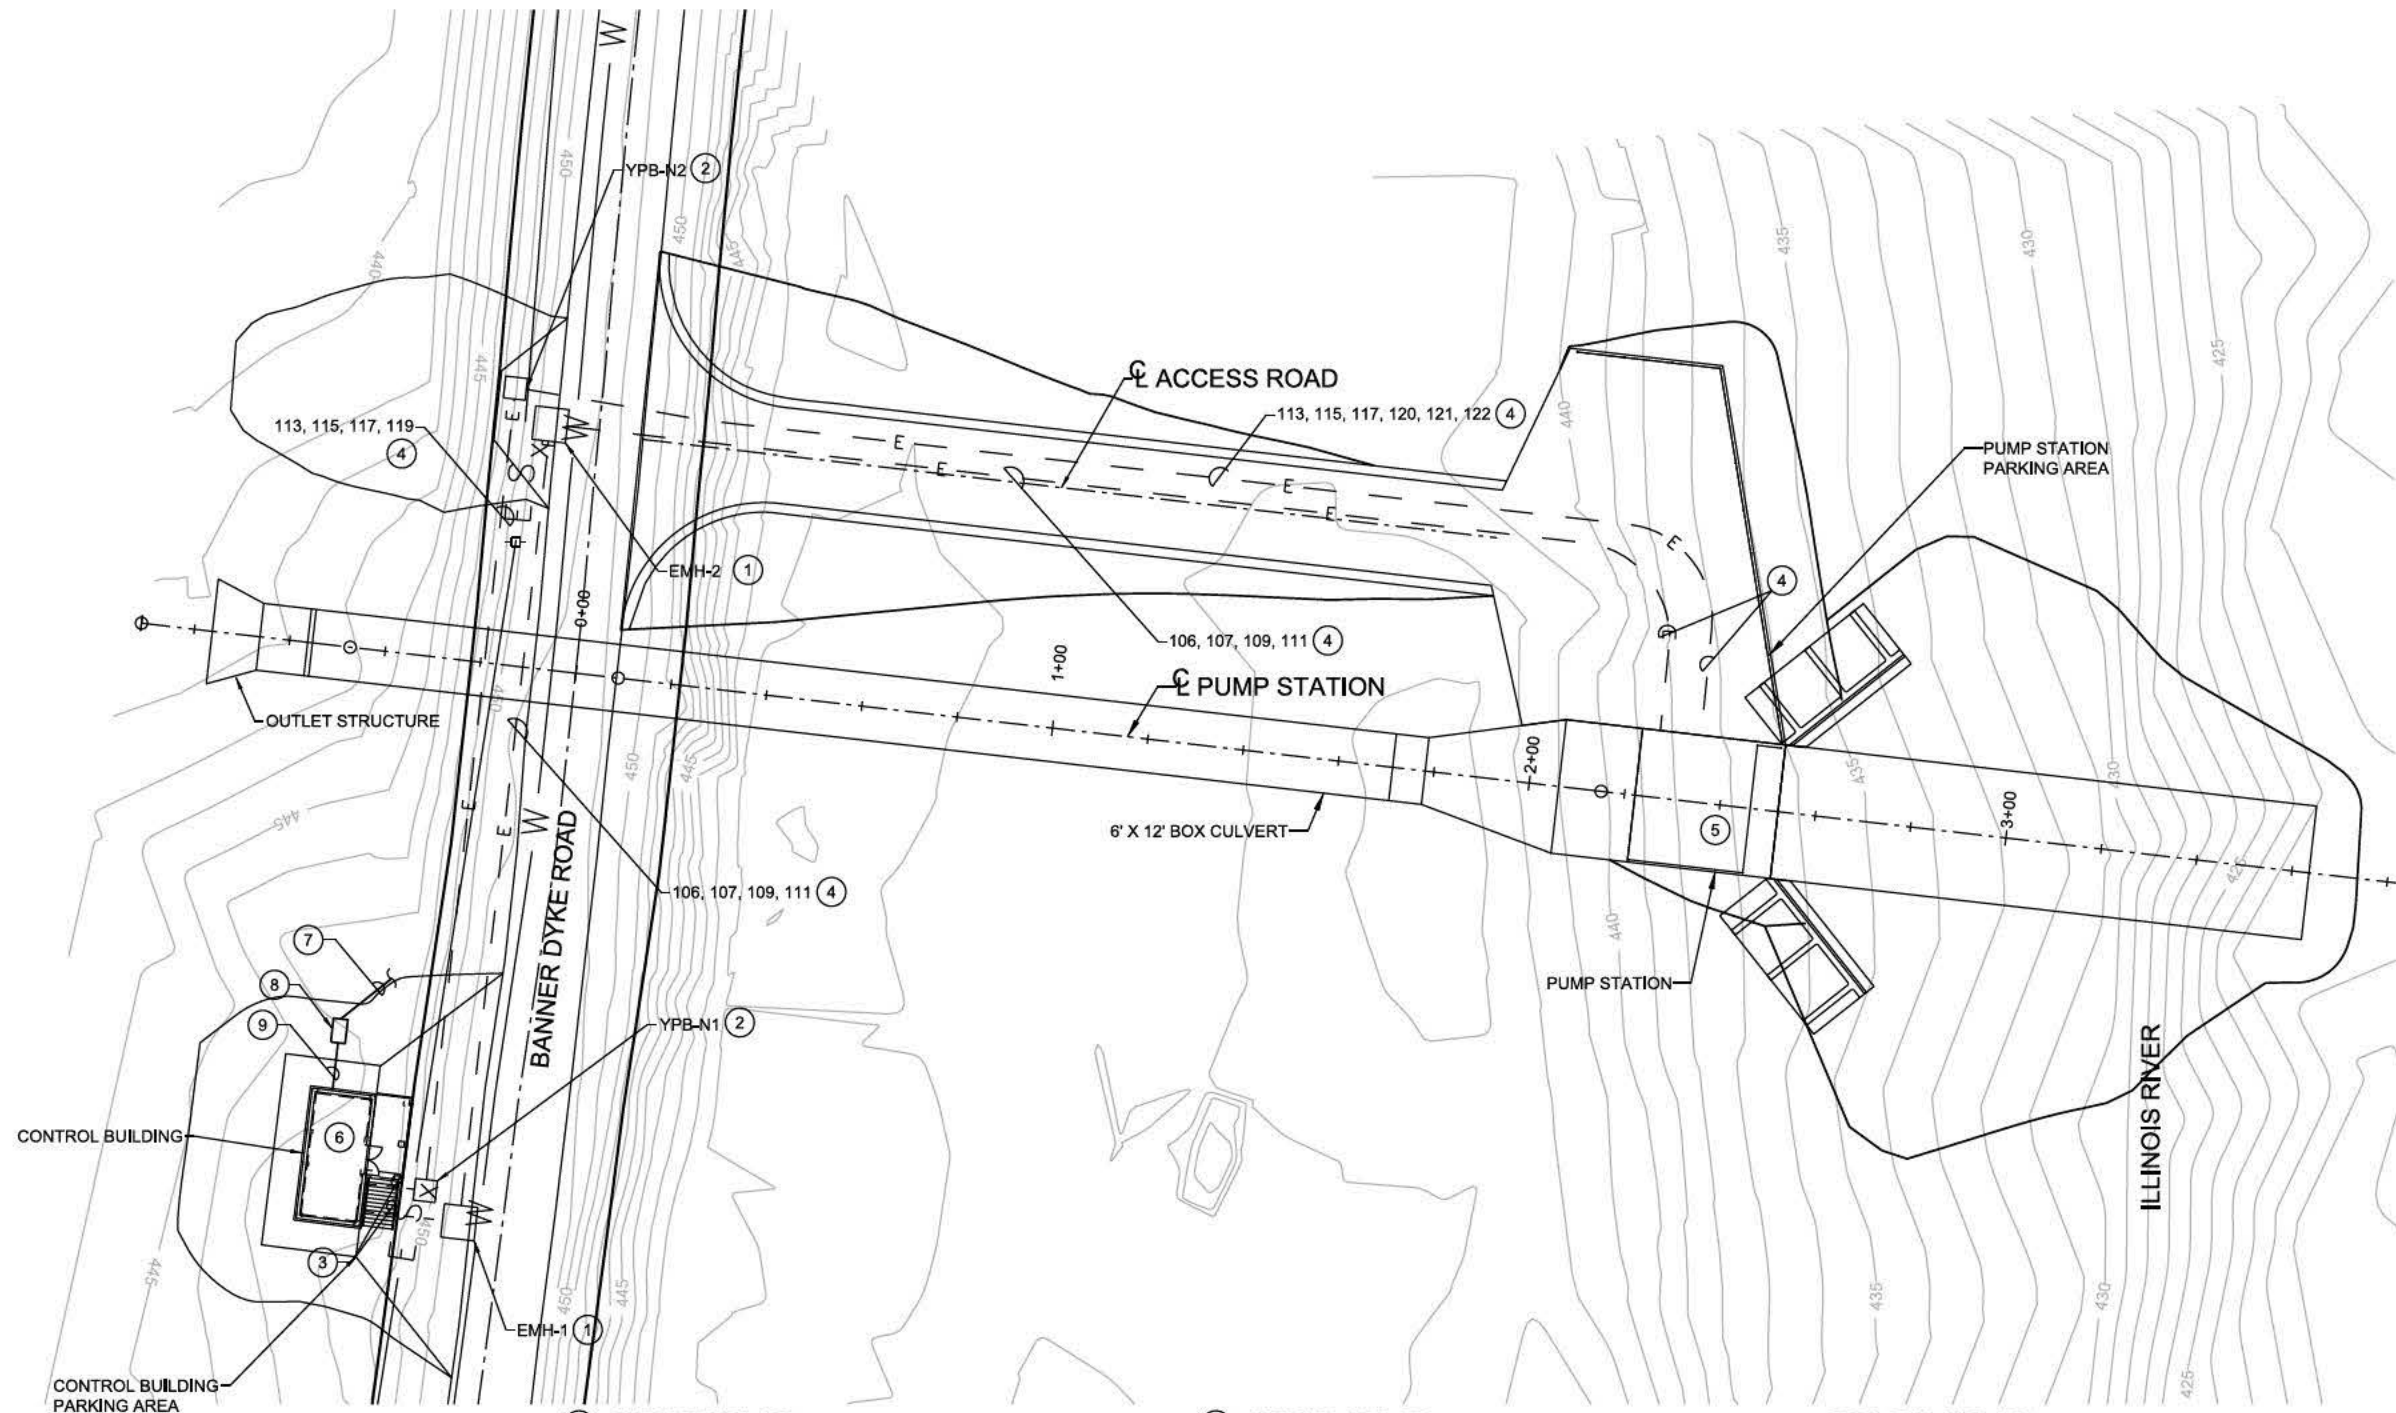

## # KEYED NOTES:

- 1 6' X 6' X 7' HIGH PRECAST ELECTRICAL MANHOLE. REFER TO THE PLAN VIEW ON SHEET E-501.
- 2 YARD PULL BOX PER DETAIL 3 ON SHEET E-105. PROVIDE 36" MINIMUM (1 LOOP) OF CABLE WITHIN THE PULL BOX FOR FUTURE ADJUSTMENTS OR OTHER CHANGES AS REQUIRED.
- 3 CONDUITS ROUTED FROM EMH-1 INTO CONTROL BUILDING AND FROM YPB-N1 INTO CONTROL BUILDING SHALL BE PVC COATED RIGID STEEL CONDUIT TYPE.
- 4 CONDUITS SHALL BE CONCRETE ENCASED. SEE DETAIL 1 ON SHEET E-502 AND KEYED NOTE 8 ON SHEET E-102.
- 5 SEE SHEET E-102 FOR ENLARGED PLAN AND ADDITIONAL DETAILS FOR WORK REQUIRED AT PUMP STATION.
- 6 SEE SHEETS E-103, E-104, AND E-105 FOR ENLARGED PLANS AND ADDITIONAL DETAILS FOR WORK REQUIRED AT THE CONTROL BUILDING.

## # KEYED NOTES:

- 7 PRIMARY OVERHEAD LINE TO BE RECONSTRUCTED BY AMEREN, INCLUDING THE PRIMARY OVERHEAD SERVICE TO THE TRANSFORMER.
- 8 OVERHEAD TRANSFORMER STRUCTURE INCLUDING TRANSFORMER TO BE CONSTRUCTED BY AMEREN. STRUCTURE TO BE LOCATED APPROXIMATELY 15' NORTH OF THE CONTROL BUILDING. COORDINATE FINAL LOCATION WITH AMEREN.
- 9 OVERHEAD SECONDARY CONDUCTORS BETWEEN THE TRANSFORMER AND THE CONTROL BUILDING TO BE INSTALLED BY AMEREN. CONTRACTOR SHALL COORDINATE WITH AMEREN AND INSTALL ANY ATTACHMENT HARDWARE THAT AMEREN REQUIRES FOR ATTACHMENT OF THEIR SECONDARY LINES TO THE BUILDING. AMEREN SHALL MAKE ALL SECONDARY CONDUCTOR SPLICES AT THE BUILDING. REFER TO SHEET E-103, KEYED NOTES #1 - #3 AND SHEET E-601, KEYED NOTES #4 AND #5 FOR INTERFACE REQUIREMENTS AT THIS LOCATION.

## GENERAL NOTES:

- A. THE CONSTRUCTION CONTRACTOR SHALL COORDINATE ALL ELECTRIC UTILITY CONSIDERATIONS WITH THE LOCAL UTILITY COMPANY (AMEREN ILLINOIS POWER COMPANY) TO PROVIDE ELECTRICAL SERVICE TO THIS SITE. THE AMEREN ILLINOIS POWER COMPANY (AMEREN ILLINOIS) CONTACT PERSON IS:
- MR. LENNIE MOORE  
OFFICE: (217) 479-5234  
CELL: (217) 741-6548
- CONTRACTOR SHALL PERFORM COORDINATION IN A TIMELY MANNER TO FACILITATE EQUIPMENT DELIVERY LEAD TIMES. (e.g. THE POWER COMPANY PROVIDED POWER FACTOR (PF) CORRECTION CAPACITORS REQUIRE THE ELECTRICAL INFORMATION OF THE ACTUAL PUMPS THAT WILL BE PROVIDED). AMEREN ILLINOIS WILL RECONSTRUCT THE PRIMARY LINE, CONSTRUCT THE SERVICE TRANSFORMER STRUCTURE AND THE TRANSFORMER, PROVIDE AND INSTALL POLES, WIRES, PF CORRECTION CAPACITORS, AND INSTALL THE SECONDARY CONDUCTORS BETWEEN THE TRANSFORMER AND THE NEW CONTROL BUILDING. THE CONSTRUCTION CONTRACTOR SHALL PAY ALL COSTS INCURRED FOR ALL WORK PERFORMED AND PROVIDED BY AMEREN ILLINOIS AS A PART OF THIS CONTRACT.

0 20' 40'  
SCALE IN FEET



DATE	DESCRIPTION
AS-BUILT AS OF 29 SEPTEMBER 2017	

U.S. ARMY CORPS OF ENGINEERS	DESIGNED BY:	DATE:
ROCK ISLAND DISTRICT	DRN BY:	26-10080
ROCK ISLAND, ILLINOIS	CHK BY:	SOLICITATION NO.:
	SUBMITTED BY:	CONTRACT NO.:
	PLT SCALE:	PROJECT CODE:
	AS SHOWN	EP102
	SIZE:	FILE NAME:
	ANSI D	EP102E-101.dgn

ILLINOIS WATERWAY ENRANGEMENT FLORISSANCE, ILL. RICE LAKE HABITAT REHAB & ENHANCEMENT STAGE I ELECTRICAL SITE PLAN
--

Sheet ID E-101
----------------------










c:\pwworking\mrvts\ced\h0153758\EP102E-103.dgn  
3/22/2014 10:10 PM  
BREDLIN

D

C

B

A

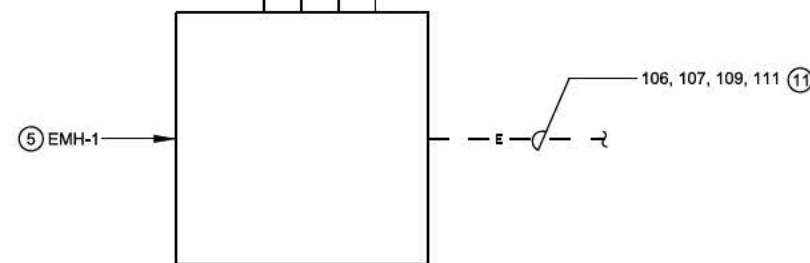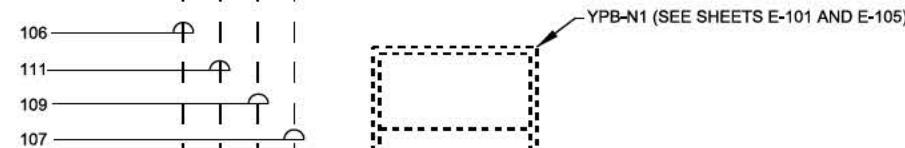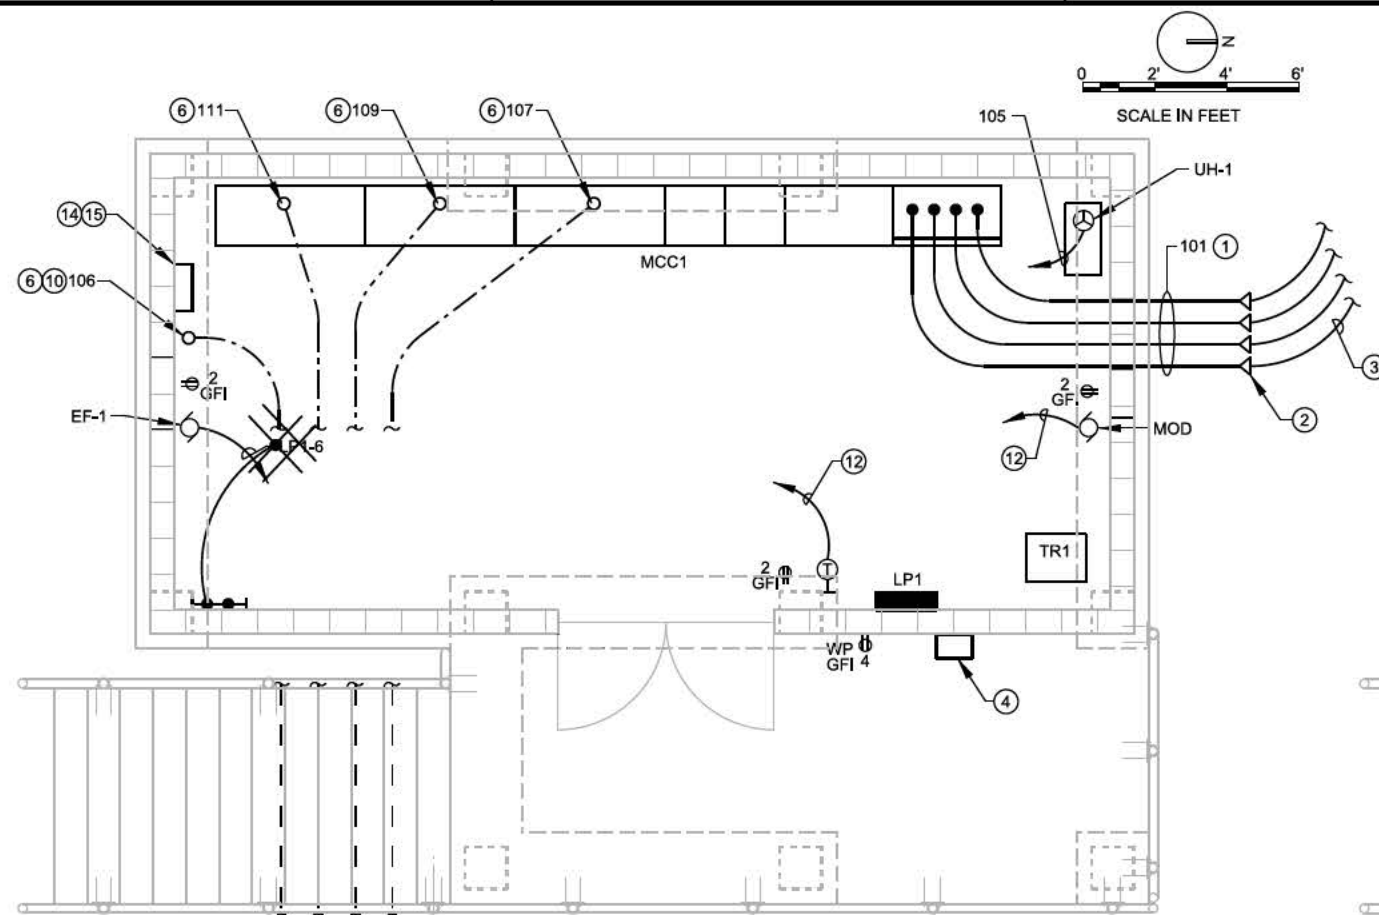

## 1 POWER PLAN


### GENERAL NOTES:

- NOT ALL CONDUITS ARE SHOWN (FOR CLARITY). ALL CONDUITS INSTALLED INDOORS SHALL BE SURFACE MOUNTED RIGID GALVANIZED STEEL (RGS) CONDUIT WITH ONE HOLE STRAPS AND CLAMP BACKS UNLESS NOTED OTHERWISE. REFER TO SINGLE-LINE DIAGRAM ON SHEET E-601, CONDUIT & CABLE SCHEDULE ON SHEET E-602, AND PANELBOARD SCHEDULE ON SHEET E-602.
- ALL LIGHTING AND RECEPTACLE CIRCUITS SHALL BE FED FROM PANEL "LP1", TO THE CIRCUIT INDICATED.
- ALL LIGHT SWITCHES AND INTERIOR RECEPTACLES SHALL BE MOUNTED AT A HEIGHT OF 48" A.F.F., UNLESS NOTED OTHERWISE.
- ALL EXTERIOR RECEPTACLES SHALL BE MOUNTED AT A HEIGHT OF 18" A.F.F., UNLESS NOTED OTHERWISE.

### GENERAL NOTES (CONTINUED):

- ALL CONDUITS WHICH ENTER OR EXIT THE CONTROL BUILDING SHALL BE SEALED WITH 2-PART NON-HARDENING SILICONE EXPANDING FOAM TO PREVENT ENTRANCE OF MOISTURE INTO BUILDING. INSTALL FOAM SO CONDUIT IS RE-ENTERABLE.
- THE CONTRACTOR SHALL BE RESPONSIBLE FOR ALL POWER UTILITY COORDINATION.

SCALE IN FEET  
0 2' 4' 6'

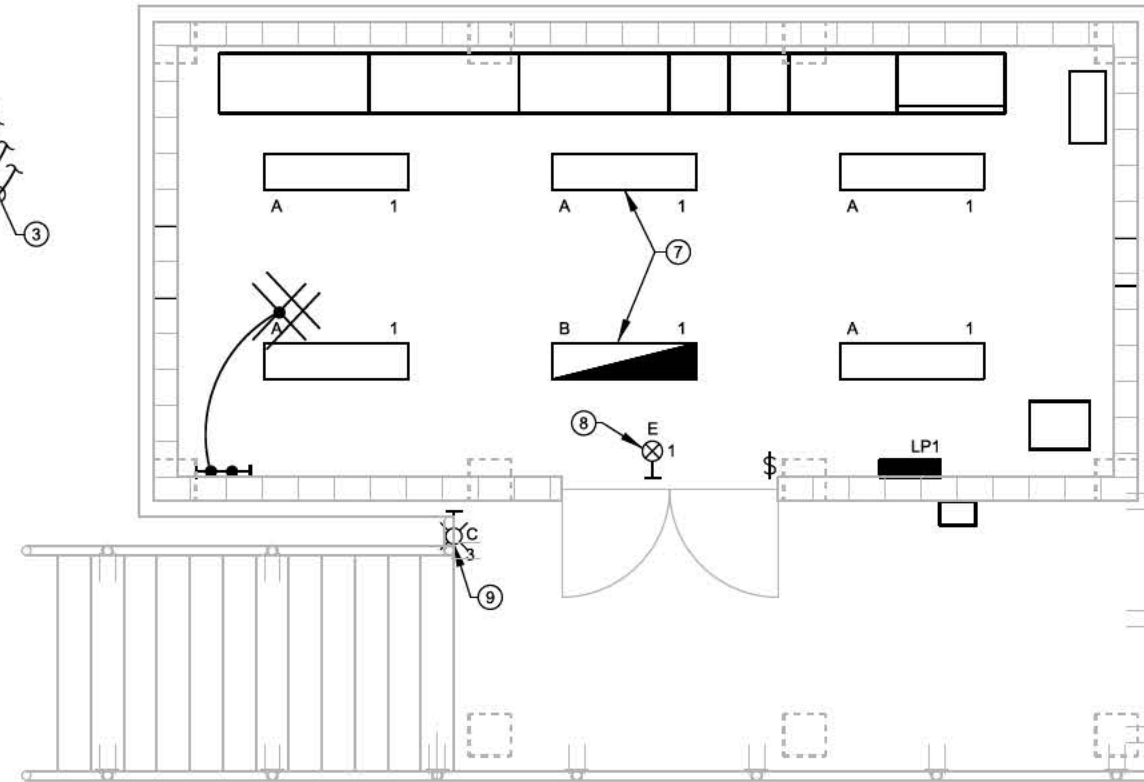

## 2 LIGHTING PLAN

### # KEYED NOTES:

- CONTRACTOR SHALL INSTALL THE (4) 4" RGS CONDUITS OUT OF THE TOP OF THE MCC, THEN TURN HORIZONTALLY AT AN ELEVATION OF 11'-0" A.F.F. TO THE BOTTOM OF THE CONDUITS, AND EXIT THROUGH THE WALL STOPPING 2' PAST THE WALL. CORE DRILL THROUGH THE WALL WITH A MINIMUM OF 6" SEPARATION BETWEEN CONDUITS, AND SEAL AROUND THE CONDUITS TO MAKE THE PENETRATIONS WATERTIGHT. SUPPORT CONDUITS FROM THE CEILING INSIDE THE BUILDING TO PREVENT HORIZONTAL OR VERTICAL MOVEMENT OF THE CONDUITS.
- CONTRACTOR SHALL INSTALL WEATHERHEADS ON THE ENDS OF THE (4) 4" CONDUITS.
- CONTRACTOR SHALL INSTALL THE WIRING FROM THE MCC, LEAVING A MINIMUM OF 3 FEET OF EXTRA WIRING OUT OF THE ENDS OF EACH OF THE WEATHERHEADS FOR CONNECTION BY THE LOCAL UTILITY COMPANY, AMEREN ILLINOIS. TYPICAL.
- METER SOCKET SHALL BE PROVIDED AND INSTALLED BY THE CONTRACTOR, AT A HEIGHT OF 5'-0" ABOVE THE WALKWAY TO THE TOP OF THE METER SOCKET. CONTRACTOR SHALL COORDINATE WITH AMEREN TO ENSURE METER SOCKET MEETS AMEREN'S REQUIREMENTS. CONTRACTOR SHALL INSTALL AN EMPTY 1 1/2" SCHEDULE 40 PVC CONDUIT FROM THE METER SOCKET TO THE UTILITY METERING SECTION OF THE MCC. AMEREN ILLINOIS POWER COMPANY SHALL PROVIDE, INSTALL, AND TERMINATE ALL METERING CONDUCTORS.
- 6' X 6' X 7' HIGH PRECAST ELECTRICAL MANHOLE. LOCATE APPROXIMATELY 10 FEET FROM CONTROL BUILDING WALL. REFER TO PLAN VIEW ON SHEET E-501.
- INSTALL PVC-COATED RGS CONDUITS THROUGH THE FLOOR, DOWN INTO THE GROUND, THEN TURN HORIZONTALLY AND ROUTE INTO THE ELECTRICAL MANHOLE. CONTRACTOR TO INSTALL GALVANIZED STEEL HORIZONTAL SUPPORT CHANNELS BETWEEN THE FOUNDATION PILES TO SUPPORT THE VERTICAL SECTIONS OF CONDUITS. THE HORIZONTAL SUPPORTS MUST BE SPACED NO GREATER THAN 10' APART.

### # KEYED NOTES (CONTINUED):

- INSTALL TYPES "A" AND "B" LIGHT FIXTURES CHAIN HUNG FROM CEILING AT A HEIGHT OF 10'-0" A.F.F., TO THE BOTTOM OF THE FIXTURE.
- INSTALL TYPE "E" EXIT LIGHT FIXTURE ABOVE THE DOOR OPENINGS, AT A HEIGHT OF 10'-0" A.F.F., TO THE BOTTOM OF THE FIXTURE. CONNECT TO "UNSWITCHED" CIRCUIT AS INDICATED.
- INSTALL TYPE "C" EXTERIOR WALLPACK FIXTURE AT A HEIGHT OF 10'-0" A.F.F., USING STAINLESS STEEL HARDWARE.
- STUB UP SPARE CONDUITS IN THIS LOCATION NOT LESS THAN 2" AFF AND TERMINATE WITH CONDUIT COUPLING AND PLUG.
- REFER TO ELECTRICAL SITE PLAN ON SHEET E-101 FOR CONTINUATION.
- 3/4" CONDUIT WITH 2 #12 AND 1 #12 GROUND TO EF-1. REFER TO CONTROL DIAGRAM ON SHEET E-603.
- NOT USED
- PROVIDE AND INSTALL A LOCKOUT AND TAGOUT WALL STATION. THE LOCATION OF THE WALL STATION SHALL BE AS SHOWN AT APPROXIMATELY 6 FEET AFF UNLESS OTHERWISE COORDINATED. THIS WALL STATION SHALL HAVE NOT LESS THAN THREE AND NOT MORE THAN SIX PADLOCKS. SHALL BE PROVIDED WITH AND HOLD UP TO 3" WIDE HEAVY DUTY TAGS AND LOCKABLE METAL HASPS AS COORDINATED. LOCKOUT STATION FEATURES SHALL MEET THE INTENTIONS OF OSHA AND NFPA 70E AND SHALL BE COORDINATED BY CONTRACTOR FOR PADLOCKS TO BE SIZED COMPATIBLE WITH THE ACTUAL MCC PROVIDED. LOCKOUT AND TAGOUT WALL STATION SHALL BE SUBMITTED FOR APPROVAL.
- PROVIDE AND INSTALL A HEAVY-DUTY, FRAMED, LAMINATED COPY OF LOCKOUT/TAGOUT PROCEDURE. THE CONTRACTOR SHALL FINALIZE THE LOCKOUT & TAGOUT PROCEDURE BASED ON THE SAMPLE PROCEDURE DERIVED FROM NFPA 70E ANNEX G AS PROVIDED IN THE SPECIFICATIONS.



APPR.	DATE	DESCRIPTION
		AS-BUILT AS OF 29 SEPTEMBER 2017

DESIGNED BY: BGR	DATE: 20-10-2010	SOLICITATION NO.: W0125K4-14-0000
DRAWN BY: BGR	CHECKED BY: BGR	CONTRACT NO.: W0125K4-14-0000
SUBMITTED BY: BGR	PROJECT CODE: EP102	FILE NAME: EP102E-103.dgn
U.S. ARMY CORPS OF ENGINEERS ROCK ISLAND DISTRICT ROCK ISLAND, ILLINOIS		

ILLINOIS WATERWAY LA GRANGE, ILL. RICE LAKE HABITAT REHAB. & ENHANCEMENT STAGE 1 CONTROL BUILDING POWER AND LIGHTING PLANS
--


Sheet  
ID  
**E-103**

AS-BUILT  
A-105



Sheet  
ID  
E-104

AS-BUILT  
A-106

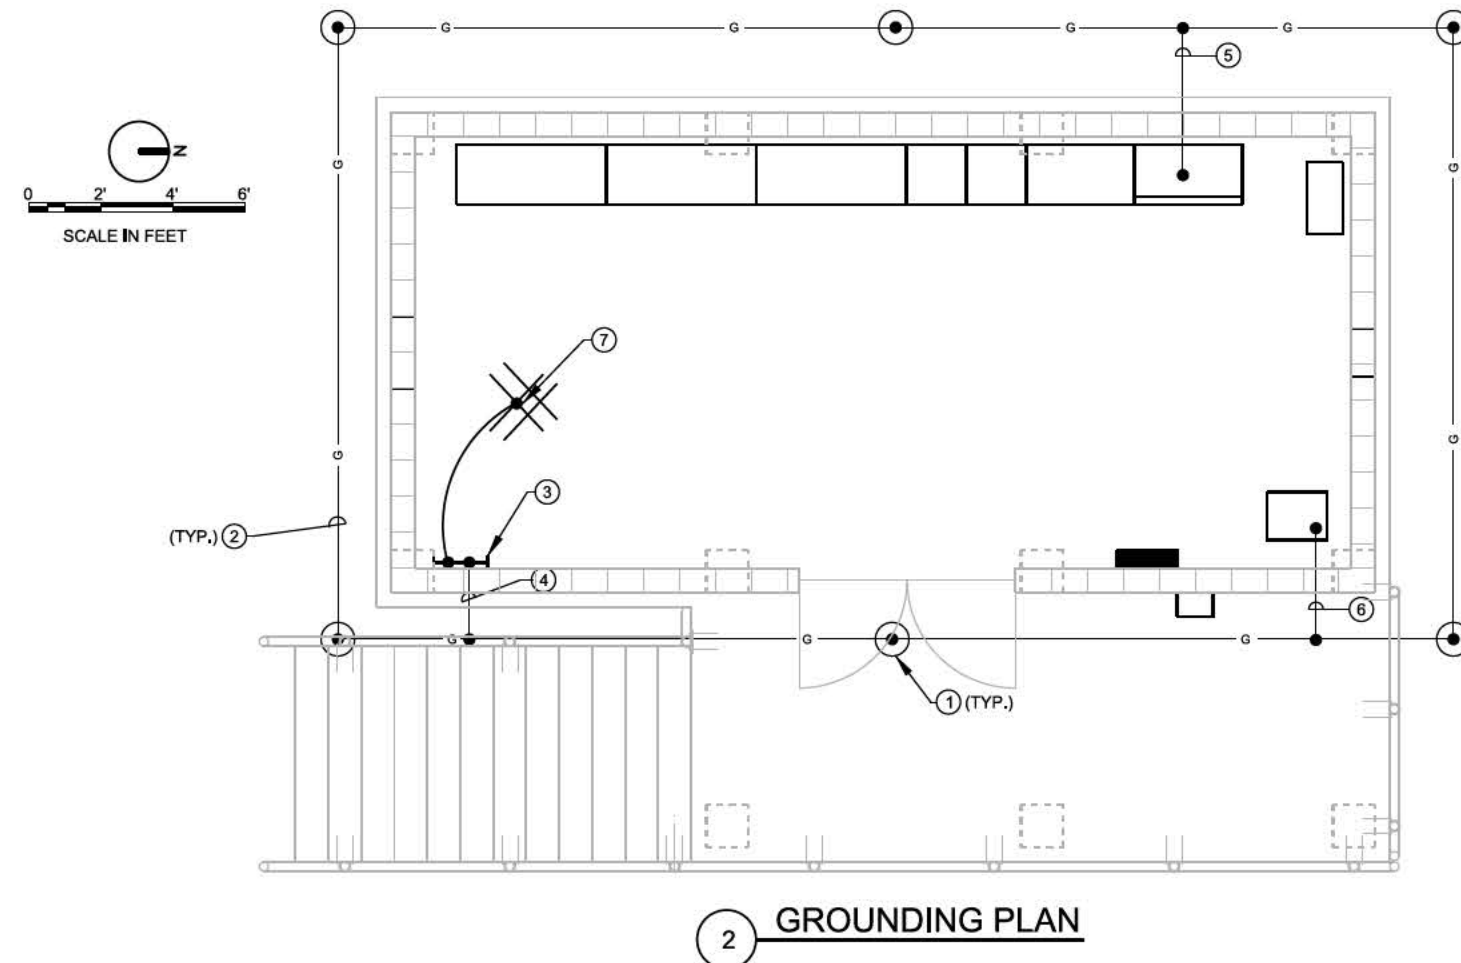

- ① 3/4" X 10'-0" COPPER CLAD GROUND ROD, (TYPICAL) (6)
- ② #4/0 AWG BARE COPPER GROUNDING ELECTRODE CONDUCTOR FORMING A COUNTERPOISE RING. (TYPICAL)
- ③ 2" HIGH X 1/4" THICK X 24" LONG BARE COPPER GROUND BUS. ATTACH TO WALL WITH STAND-OFF INSULATORS, AT A HEIGHT OF 24" A.F.F.
- ④ 1" SCHEDULE 80 PVC CONDUIT WITH (1) #4/0 BARE COPPER GROUNDING CONDUCTOR FROM THE GROUND COUNTERPOISE RING TO THE GROUND BUS INSIDE THE CONTROL BUILDING.
- ⑤ 1" SCHEDULE 80 PVC CONDUIT WITH (1) #4/0 BARE COPPER GROUNDING CONDUCTOR FROM THE GROUND COUNTERPOISE RING TO THE MOTOR CONTROL CENTER GROUND BUS.
- ⑥ 1" SCHEDULE 80 PVC CONDUIT WITH (1) #6 BARE COPPER GROUNDING CONDUCTOR FROM THE GROUND COUNTERPOISE RING TO THE LIGHTING TRANSFORMER.
- ⑦ BOND GROUNDING SYSTEM TO BUILDING STEEL IN NOT LESS THAN FOUR LOCATIONS AT OR NEAR EACH CORNER OF THE BUILDING.
- ⑧ CLASS I AIR TERMINAL, ATTACHED TO ROOF. MAKE ALL ROOF PENETRATIONS WATERTIGHT (TYPICAL OF 8), 3/8"x18" AT AND SADDLE BASE.
- ⑨ CLASS I BARE COPPER LIGHTNING PROTECTION LOOP CONDUCTOR. CONDUCTOR SHALL BE CLASS I MATERIALS PER NFPA 780, 57,400 CIRCULAR MIL CROSS SECTION AREA, 187 LB/1000 FT, WITH 17 AWG MINIMUM STRAND SIZE.
- ⑩ CLASS I BARE COPPER LIGHTNING PROTECTION CROSS CONDUCTOR. CONDUCTOR SHALL BE CLASS I MATERIALS PER NFPA 780, 57,400 CIRCULAR MIL CROSS SECTION AREA, 187 LB/1000 FT, WITH 17 AWG MINIMUM STRAND SIZE. TYPICAL MAIN CONDUCTOR IS #CCHB-29-17.
- ⑪ CLASS I BARE COPPER LIGHTNING PROTECTION DOWN CONDUCTOR EXTENDING VERTICALLY DOWN FROM THE AIR TERMINALS ON THE ROOF TO THE GROUND COUNTERPOISE RING. EXOTHERMIC-WELD CONNECTIONS AT THE GROUND RING. CONDUCTOR SHALL BE CLASS I MATERIALS PER NFPA 780, 57,400 CIRCULAR MIL CROSS SECTION AREA, 187 LB/1000 FT, WITH 17 AWG MINIMUM STRAND SIZE.

c:\pw\_working\mvr\b5edd\hd0153758\EP102E-104.dgn  
3:22:28 PM  
B5EDDLH




D



B



..:lpw working\mvr\5edd\hd0153758\EP102E-105.dgn  
A  
1:22:32 PM  
35EDD.LH

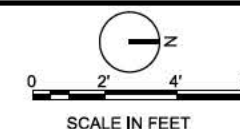

A. ALL CONDUITS WHICH ENTER OR EXIT THE CONTROL BUILDING SHALL BE SEALED WITH 2-PART NON-HARDENING SILICONE EXPANDING FOAM TO PREVENT ENTRANCE OF MOISTURE INTO BUILDING. INSTALL FOAM SO CONDUIT IS RE-ENTERABLE.

① YARD PULL BOX PER DETAIL THIS SHEET. PROVIDE 36 INCHES MINIMUM (1 LOOP) OF EACH CABLE WITHIN PULL BOX FOR FUTURE ADJUSTMENTS OR OTHER CHANGES AS REQUIRED, SEE SHEETS #E-101 AND #C-121 FOR LOCATION.

② NOT USED

③ NOT USED

④ 3/4" CONDUIT WITH 1 #18 TSP ANALOG (4-20 MA DC) SIGNAL CABLE BETWEEN LEVEL INDICATOR AND JUNCTION BOX.

⑤ 3/4" CONDUIT WITH 4 #18, 1 #18 GROUND BETWEEN LEVEL INDICATORS OUTPUT RELAYS AND RESPECTIVE PUMP STARTER.

⑥ 3/4" PVC CONDUIT, 1 #4 TO MAIN GROUNDING BUS.

⑦ SEE DETAIL 2, LEVEL INDICATOR RISER DIAGRAM, ON THIS SHEET.

⑧ MAIN GROUNDING BUS. SEE SHEET E-104.

⑨ NOT USED



US Army Corps  
of Engineers®

[illegible]

U.S. ARMY CORPS OF ENGINEERS		DESIGNED BY:		DATE:
ROCK ISLAND DISTRICT		DRAW BY:	QUALIFICATION NO.:	10/20/90
ROCK ISLAND, ILLINOIS		DED:	WY2EEK-1-R-9-2029	
		SUBMITTED BY:	CONTRACT NO.:	
		WBS:	WY2EEK-1-C-0086	
		WBS SCALE:	PROJECT CODE:	
		AS SHOWN:	EP102	
		SIZE:	FILE NAME:	

ILLINOIS WATERWAY  
LAGRANGE POOL  
FULTON COUNTY, IL  
RICE LAKE HABITAT REHAB & ENHANCEMENT  
STAGE I  
CONTROL BUILDING  
INSTRUMENTATION  
PLAN


Sheet  
ID  
E-105

AS-BUILT  
A-107







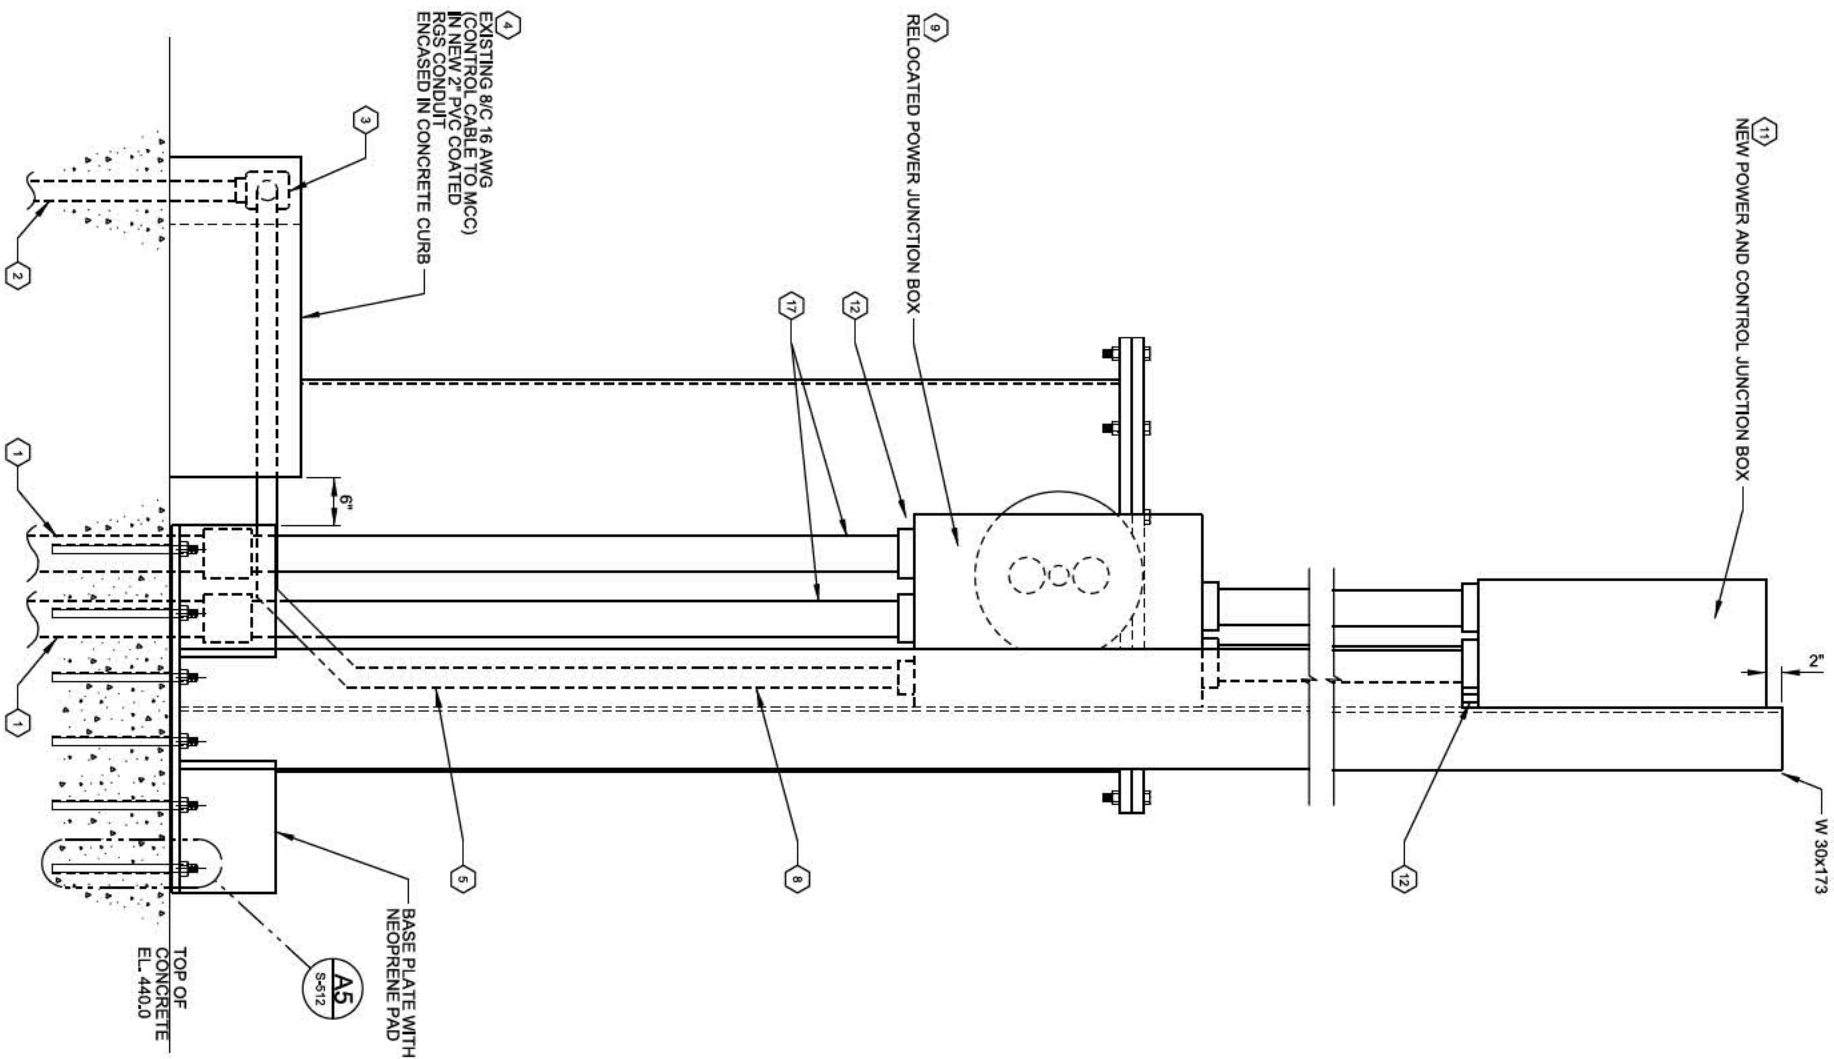

**A1** NEW JUNCTION BOX ELEVATION (TYPICAL FOR ALL 3 PUMPS)

SCALE: 1"=1'-0"



**SHEET GENERAL NOTES**

- SEE SHEET KEY NOTES ON SHEET E-301.



MARK	DESCRIPTION	DATE	APPR.

DESIGNED BY: BGR		DATE: 2016/06/17	
DWN BY: GLW	CKD BY: RLW	SOLICITATION NO.: W912EKC-15-R-0029	
SUBMITTED BY: JWB		CONTRACT NO.:	
PLOT SCALE: AS SHOWN	PLOT DATE:	PROJECT CODE: EP102	
SIZE: ANSI D	FILE NAME: EP102E-302.dgn		

U.S. ARMY CORPS OF ENGINEERS  
ROCK ISLAND DISTRICT  
ROCK ISLAND, ILLINOIS


ILLINOIS WATERWAY  
LAGRANGE POOL  
FULTON COUNTY, IL  
RICE LAKE HABITAT REHAB & ENHANCEMENT  
STAGE I  
  
PUMP STATION  
NEW JUNCTION BOX ELEVATION

Sheet  
ID  
**E-302**


AS-BUILT  
A-110



ctbpc\_worlkgmrvbseddlhd01537581EP102E-501.dgn  
3/22/23 3:28 PM  
BSED011

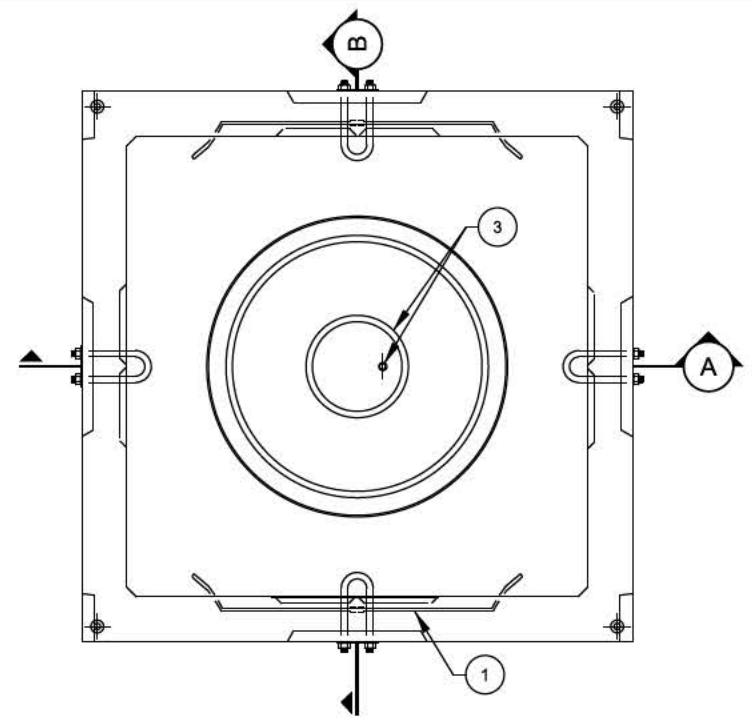

**PLAN VIEW**  
NOT TO SCALE

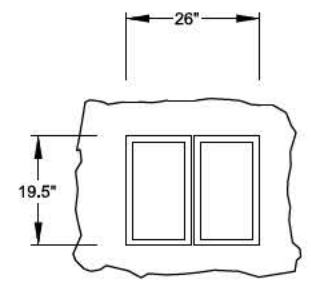

**C INSIDE CASTING KNOCKOUT DETAIL**  
NOT TO SCALE

- DESIGN CRITERIA:**
- 1.) CONCRETE MINIMUM COMPRESSIVE STRENGTH  $F'_c = 4,500$  P.S.I. @ 28 DAYS
  - 2.) REINFORCING STEEL: ASTM A706,  $F_y = 60,000$  P.S.I.
  - 3.) DESIGN SPECIFICATIONS: ACI 318, AASHTO LOAD FACTOR DESIGN
  - 4.) DESIGN LOADING: AASHTO HS20
- DESIGN ASSUMPTIONS:**
- 1.) GROUND WATER LEVEL: 3'-6"
  - 2.) EARTH COVER: 2'-0" MIN. TO 5'-0" MAX.
  - 3.) LIVE LOAD IMPACT: 2'-0"  $I = 20\%$   
2'-1" TO 2'-11"  $I = 10\%$   
3'-0" TO 5'-0"  $I = 0\%$
- CASTING DATA:**
- 1.) TOP CASTING WEIGHT:.....7,750 LBS. (INCLUDES WEIGHT OF REINFORCING STEEL)
  - 2.) BOTTOM CASTING WEIGHT:..15,850 LBS. (INCLUDES WEIGHT OF REINFORCING STEEL)
  - 3.) TOTAL CASTING WEIGHT:.....23,600 LBS.

MANHOLE FRAME AND COVER INSTALLED NEAR FLUSH WITH SURROUNDING PARKING LOT OR SOIL GRADE, BUT INSTALL SLIGHTLY HIGHER TO ALLOW DRAINAGE AWAY FROM COVER. FRAME AND COVER SHALL HAVE 30" DIAMETER OPENING AND HEIGHT OF 10". PROVIDE COVER LABELED WITH TEXT, "ELECTRIC"


6" GRADE RING WITH STEP

12" GRADE RING WITH STEP


CIRCLED ITEM	REQ.	DESCRIPTION
①	4	GROUND WELD CONNECTION (SILICON BRONZE)
②	4	PULL-IN IRON ASS'Y
③	1	14 DIA. SUMP W/ 3/4 DIA. P.V.C. WEEP HOLE

**NOTE:**

THE DIMENSIONS SHOWN INDICATE THE GENERAL INTENTION FOR THE MANHOLE CONSTRUCTION. THE ACTUAL FINAL REQUIRED DIMENSIONS SHALL BE DETERMINED AND SUBMITTED BY THE MANUFACTURER AS REQUIRED TO FABRICATE THE MANHOLE AND ITS FEATURES TO MEET AASHTO STANDARDS. HARTFORD CONCRETE PRODUCTS (OLDCASTLE PRECAST) IS THE BASIS OF DESIGN. OTHER MANUFACTURERS THAT MEET THE DESIGN INTENT WILL BE ACCEPTABLE.

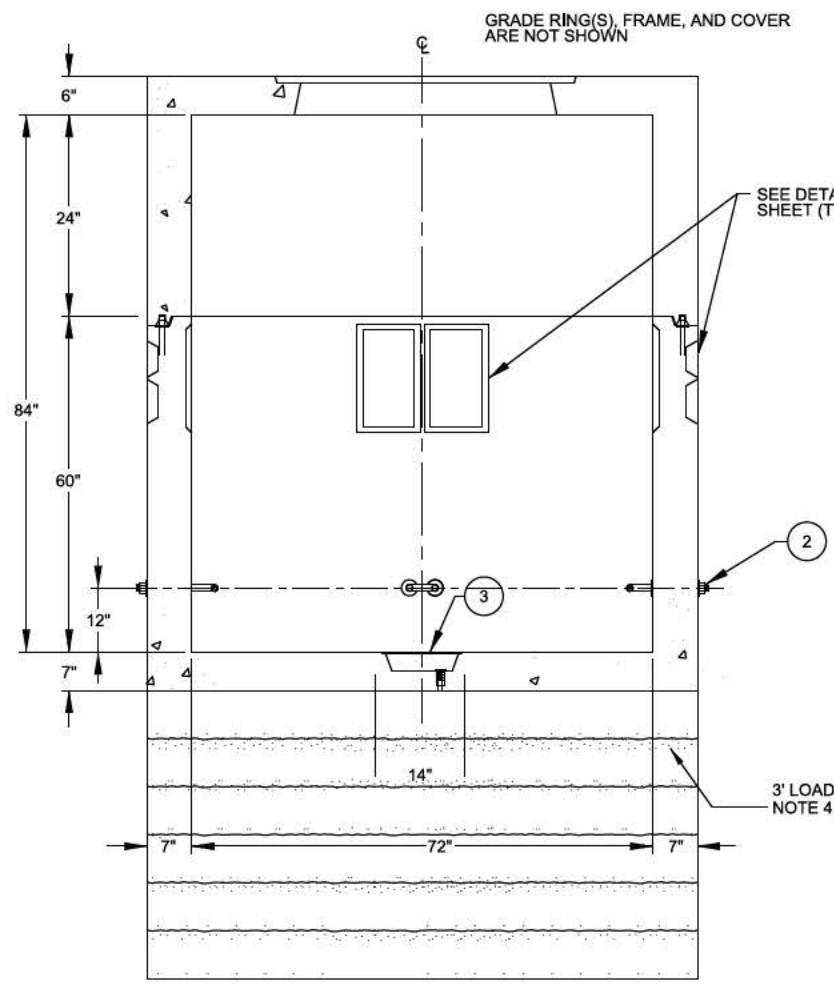

**A SECTION VIEW "A"- "A"**  
NOT TO SCALE

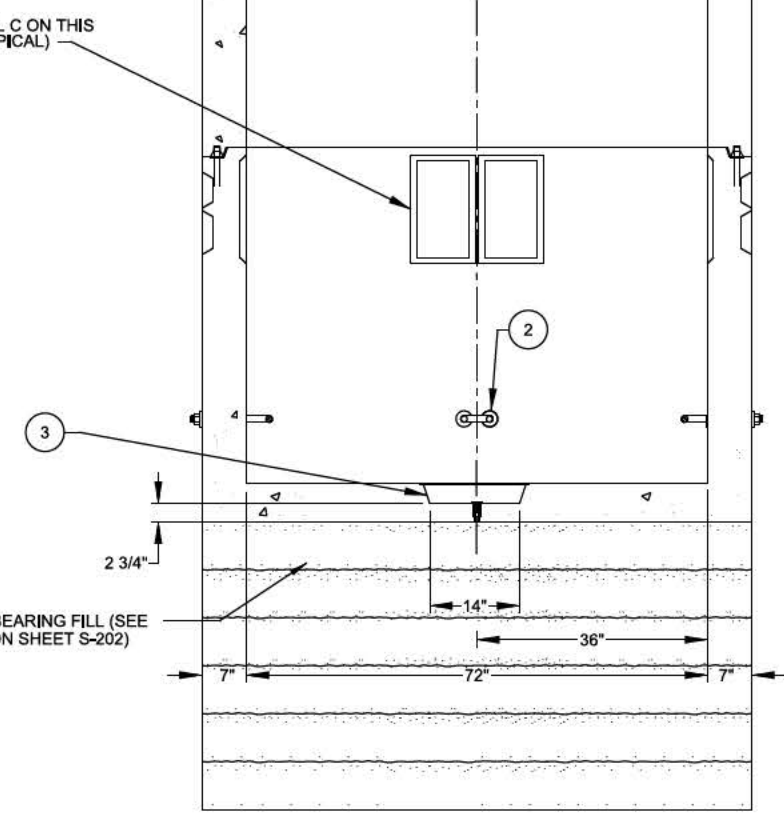

**B SECTION VIEW "B"- "B"**  
NOT TO SCALE

**6' x 6' x 7' HIGH PRECAST MANHOLE DETAILS**

US Army Corps of Engineers

DATE	APPROVED	DESCRIPTION
AS-BUILT AS OF 29 SEPTEMBER 2017		

DESIGNED BY: BGR

DRAWN BY: CAD BT

CHECKED BY: JWB

DATE: 20110930

PROJECT NO.: 102E-501

CONTRACT NO.: 102E-501

PROJECT CODE: EP102

FILE NAME: EP102E-501.dgn

ANSI D

U.S. ARMY CORPS OF ENGINEERS

ROCK ISLAND DISTRICT

ROCK ISLAND, ILLINOIS

ILLINOIS WATERWAY

FLUOR CORP.

FLUOR CORP. ILL.

RICE LAKE HABITAT REHAB & ENHANCEMENT


STAGE I

MANHOLE DETAILS

Sheet ID

**E-501**

CONDUIT SPACER SCHEDULE	
CONDUIT SIZE	SPACER
3/4" - 2"	1 1/2"
2-1/2" - 3"	2"
4" - 6"	3"

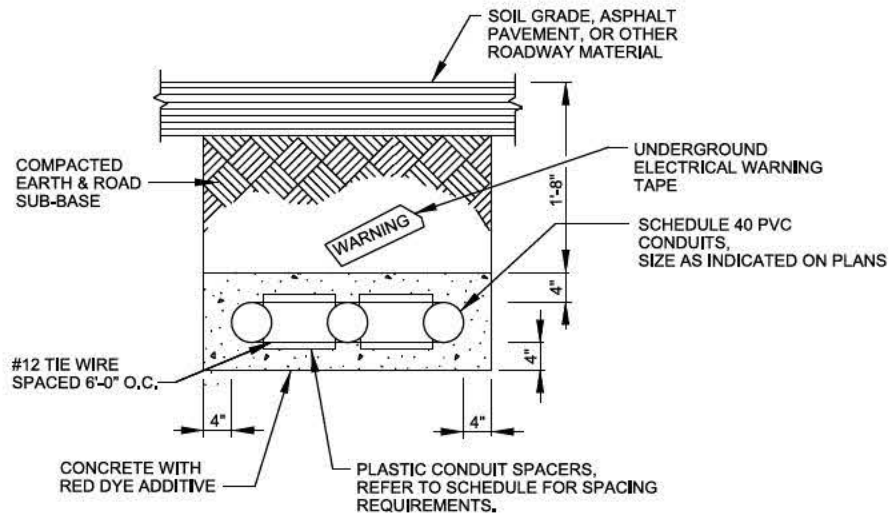

NOTES:

1. THIS DETAIL INDICATES THE MINIMUM CRITERIA REQUIREMENTS FOR ALL DUCT BANKS AND DOES NOT DEPICT A SPECIFIC DUCT BANK. THE CONTRACTOR SHALL CONSTRUCT EACH REQUIRED DUCT BANK IN ACCORDANCE WITH THIS CRITERIA.
2. CONCRETE DUCT BANKS SHALL RUN FROM MANHOLE, TO MANHOLE.
3. THE CONCRETE ENCASED DUCTS TRAVERSING THE PAVEMENT SHALL HAVE 1'-8\"/>

1 CONCRETE ENVELOPE DUCT BANK  
NOT TO SCALE



"USE LOCKOUT ... LEVEE." - BLACK LETTERS ON WHITE FIELD

(TYPICAL OF 1 SIGN INSTALLED ON EACH PUMP STARTER COMPARTMENT / 3 TOTAL)

2 MCC LOCKOUT & TAGOUT SIGN DETAIL  
NOT TO SCALE

NOTES:

1. CUSTOM LOCKOUT SIGNS SHALL BE 7" HIGH X 10" WIDE WITH LABEL AS SHOWN. SIGNS SHALL BE THE SELF-ADHESIVE, LAMINATED-VINYL MATERIAL TYPE WITH ESTIMATED EXPECTED OUTDOOR LIFE OF NOT LESS THAN FIVE YEARS, SMOOTHLY ADHERED TO THE DOOR OF EACH PUMP STARTER MCC COMPARTMENT FOR PUMP NO. 1, PUMP NO. 2, AND PUMP NO. 3 - (3 SIGNS TOTAL). THE BASIS OF DESIGN IS "MY LOCKOUT TAGS PART # S-3057, CUSTOM SIGNS THAT MEET OR EXCEED THE STATED INTENTION, CONTAIN SPECIFIC LABEL TEXT, MATERIAL, AND HAVE EXPECTED LIFE WILL BE ACCEPTABLE.
2. LABELS ON POWER JUNCTION BOXES AND CONTROL PULL BOXES AT PUMPING STATION ARE SHOWN IN DETAIL 3 ON SHEET E-503. THE LABEL TEXT REQUIRED FOR THE PUMPING STATION ELECTRICAL ENCLOSURES DIFFER THAN THE SIGN SHOWN HERE.



DATE	DESCRIPTION	MARK
AS-BUILT AS OF 29 SEPTEMBER 2017		

DATE: 28/11/2017	DESIGNED BY: BGR	DESIGNED BY: CAD BY: DWN BY: SUBMITTED BY: JWB	DESIGNED BY: CAD BY: DWN BY: SUBMITTED BY: JWB	DESIGNED BY: CAD BY: DWN BY: SUBMITTED BY: JWB
PROJECT NO.: 101256-1-1-0000	PROJECT CODE: EP102	PROJECT CODE: EP102	PROJECT CODE: EP102	PROJECT CODE: EP102
FILE NAME: EP102E-502.dgn	ANSI D	ANSI D	ANSI D	ANSI D

ILLINOIS WATERWAY JACKSONVILLE FLORIDA COUNTY, IL RICE LAKE HABITAT REHAB & ENHANCEMENT STAGE 1 DUCT BANK AND MISCELLANEOUS ELECTRICAL DETAILS
--


Sheet ID E-502
----------------------





## SCALE : NO SCALE

(TYPICAL OF 1 SIGN INSTALLED ON EACH ENCLOSURE / 6 TOTAL)

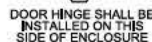

## SCALE • NO SCALE

ITEM	TYPE	QTY	UOM
4" PVC-COATED RGS CONDUIT	PVC-COATED RGS	120	LF
4" PVC-COATED RGS CONDUIT COUPLING	PVC-COATED RGS	10	EA
4" PVC-COATED BOX HUB (MYERS HUB)	PVC-COATED RGS	24	EA
REGASKET EXISTING JUNCTION BOXES	NEOPRENE GASKET	5	EA
DANGER ADHESIVE WARNING LABELS	CUSTOM	4	EA
16 AWG BUTT SPLICE FITTING	CU/AL LISTED	48	EA
1/C - 16 AWG HEAT SHRINK TUBES (CONTROL WIRES)	TUBES	24	EA
1" HEAT SHRINK KIT (CONTROL CABLE (8/C - 16 AWG)	TUBES	3	EA
1/C - 250 KCMIL COMPRESSION BARREL SPLICE FITTING	CU/AL UL LISTED	24	EA
1/C - 250 KCMIL HEAT SHRINK KITS (POWER WIRES)	TUBES	6	EA
2-1/2" HEAT SHRINK KIT (4/C - 250 KCMIL POWER CABLE)	TUBES	6	EA
4/C MOLDED CABLE TERMINATION HEAT SHRINK KIT	MOLDED UNIT	6	EA
1/C - 250 KCMIL, 600 VOLT, TYPE XHHW, 90 DEG. CELSIUS, CU CABLE	SINGLE CONDUCTOR	400	LF
1/C - 1/0 AWG, 600 VOLT, TYPE XHHW, CU, GREEN GROUND CABLE	SINGLE CONDUCTOR	120	LF
1/C - 1/0 AWG COMPRESSION BARREL SPLICE FITTING	600 VOLT	6	EA
1/C - 1/0 AWG HEAT SHRINK KITS (GREEN GROUNDING WIRES)	TUBES	6	EA
8/C - 16 AWG, 600 VOLT, CABLE TRAY RATED, 90 DEG. CELSIUS, CU CABLE	MULTICONDUCTOR	60	LF
36"H X 24"W X 24"D, NEMA 4X, TYPE 304 STAINLESS STEEL JUNCTION BOX	TYPE 304	1	EA
36"H X 30"W X 16"D, NEMA 4X, TYPE 304 STAINLESS STEEL JUNCTION BOX (WITH BACK PANEL AND NEMA 4X DRAIN)	TYPE 304	3	EA
3-POLE POWER DISTRIBUTION BLOCKS (PHASES)	600 VOLT	9	EA
1-POLE POWER DISTRIBUTION BLOCKS (GROUNDING)	600 VOLT	3	EA
TERMINAL STRIPS	600 VOLT	3	EA
3" PVC-COATED RGS CONDUIT	PVC-COATED	30	LF
3" PVC-COATED RGS CONDUIT BOX HUB (MYERS HUB)	PVC-COATED	12	EA
1" THICK STEEL PLATE / PLUGS (FOR PIPE STUBS)	STEEL	1	EA
2" PVC-COATED RGS CONDUIT	PVC-COATED	90	LF
2" PVC-COATED RGS MOGUL LB CONDUIT FITTING	PVC-COATED	3	EA
2" PVC-COATED RGS CONDUIT 45 ELBOW	PVC-COATED	9	EA
2" PVC-COATED RGS CONDUIT 90 ELBOW	PVC-COATED	6	EA
2" PVC-COATED RGS CONDUIT BOX HUB (MYERS HUB)	PVC-COATED	15	EA
2" PVC-COATED RGS CONDUIT COUPLINGS	PVC-COATED	18	EA
1-1/2" PVC-COATED RGS CONDUIT	PVC-COATED	20	LF
1-1/2" PVC-COATED RGS CONDUIT BOX HUB (MYERS HUB)	PVC-COATED	3	EA
16 AWG WIRE LABELS		50	EA
COLOR PHASE ELECTRICAL TAPE (B-O-Y)		4	ROLL
NO-OXIDATION SPRAY - CORROSION INHIBITOR		2	CAN
1.25 CABLE CLAMPS (INSIDE NEW UPPER JBOXES)		12	EA
2" CABLE CLAMPS (INSIDE NEW UPPER JBOXES)		6	EA

- 1 NEW UPPERMOST ELEVATION JUNCTION BOXES, 36" H X 30" W X 16" D, NEMA 4X, TYPE 304 STAINLESS STEEL WITH CONTINUOUSLY WELD TO DOOR (SEE KEYNOTE 13), BOLTED COVER CLAMPS AND PADLOCKABLE HASP. ALL MOUNTING HARDWARE MUST BE STAINLESS STEEL.
- 2 PROVIDE STAINLESS STEEL 33" H X 27" W INTERIOR BACK PANEL AS STANDARD OPTION WITH JUNCTION BOX.
- 3 PROVIDE 8 POLE TERMINAL STRIP. TERMINAL STRIP MUST BE 20 AMPS, 600 VOLTS, ACCEPTING 16 AWG SIZE CONDUCTORS ON BOTH SIDES. TERMINAL STRIP MUST BOLT DIRECTLY TO JUNCTION BOX INTERIOR BACK PANEL. BASIS OF DESIGN IS MARATHON SPECIAL PRODUCTS CATALOG NO. 621 RZ 08.
- 4 PROVIDE FOUR (4) POWER DISTRIBUTION BLOCKS. BLOCKS SHALL BE RATED 620 AMPERES, 600 VOLTS, ACCEPTING TWO (2) EACH 250 KCMIL PER PHASE ON THE LOAD SIDE AND ALSO ON THE LINE SIDE. BASIS OF DESIGN IS MARATHON SPECIAL PRODUCTS CATALOG NO. 1453129 FOR PHASE A, B, & C AND CATALOG NO. 1451129 FOR THE GROUNDING BLOCK. ALTERNATE BASIS OF DESIGN IS BURNDY VERSI-POLE CATALOG NO. BDBLHC223503 FOR PHASE A, B, & C AND CAT. NO. BDALHC22350 ADDER FOR GROUNDING BLOCK. PLASTIC COVERS SHALL BE PROVIDED AND INSTALLED ON POWER DISTRIBUTION BLOCKS SHALL BE PROVIDED WITH COVER.
- 5 TWO (2) EACH - 4" PVC-COATED RGS CONDUIT BOX HUB (MYERS HUB) AND CONDUITS CONTAINING POWER CONDUCTORS EXTENDED UP FROM MCC CONTROL BUILDING. INSTALL CONDUITS FRONT AND BACK.
- 6 TWO (2) EACH - 4" PVC-COATED RGS CONDUIT BOX HUB (MYERS HUB) AND CONDUITS CONTAINING PUMP LEAD MULTICONDUCTOR POWER CABLES FROM RESPECTIVE SUBMERSIBLE PUMP. INSTALL CONDUITS FRONT AND BACK.
- 7 TWO (2) EACH - 2" PVC-COATED RGS CONDUIT BOX HUB (MYERS HUB) AND CONDUIT, ONE CONDUIT MUST CONTAIN THE EXTENDED MULTICONDUCTOR CONTROL CABLE ROUTED FROM THE MCC CONTROL BUILDING AND THE OTHER CONDUIT MUST CONTAIN THE PUMP LEAD CONTROL MULTICONDUCTOR CABLE FROM RESPECTIVE SUBMERSIBLE PUMP. INSTALL CONDUITS FRONT AND BACK.
- 8 PROVIDE AND INSTALL ONE NEMA 4X STAINLESS STEEL ELECTRICAL ENCLOSURE DRAIN FITTING IN LEFT CENTER BOTTOM OF NEW JUNCTION BOXES. BASIS OF DESIGN IS PENTAIR - HOFFMAN CAT. NO. AVDR4554.
- 9 GUTTER SPACE. THIS DRAWING SHOWS 8" DISTANCE FROM POWER DISTRIBUTION BLOCKS TO INSIDE WALL OF JUNCTION BOX. THE MINIMUM DISTANCE FOR THE GUTTER SPACE IS ALLOW THE 250 KCMIL WIRES TO BEND INTO THE BLOCKS IS 6". THE POWER BLOCKS LOCATION MAY BE CHANGED OR DEEMED APPROPRIATE AS LONG AS ADEQUATE SPACE IS LEFT TO MANAGE THE 250 KCMIL BENDS AND ADEQUATE SPACE MANAGEMENT IS PROVIDED FOR THE 16 AWG TERMINAL STRIP AND THE CONTROL CABLES THAT TERMINATE ON IT.
- 10 ALL TERMINAL STRIPS AND POWER DISTRIBUTION BLOCKS MUST BE SPRAYED WITH ELECTRICAL NO-OXIDATION COMPOUND WHEN ELECTRICAL INSTALLATION IS NEARLY COMPLETED.
- 11 PROVIDE CABLE CLAMPS OR OTHER PHYSICAL SUPPORT TO KEEP HANGING WEIGHT OFF OF CABLES AND CONDUCTORS AS THEY ROUTE TO LOWER BOXES AND PUMPS.
- 12 CUSTOM LOCKOUT SIGNS SHALL BE 7" HIGH X 10" WIDE SUITABLE FOR INSTALLATION OUTDOORS WITH LABEL AS SHOWN. OUTDOOR SIGNS SHALL BE THE SELF-ADHESIVE, LAMINATED-VINYL MATERIAL TYPE WITH ESTIMATED EXPECTED OUTDOOR LIFE OF NOT LESS THAN FIVE YEARS, SMOOTHLY ADHERED TO THE COVER OF EACH ENCLOSURE. ONE CUSTOM "DANGER" SIGN SHALL BE INSTALLED ON EACH POWER JUNCTION BOX ENCLOSURE AND ON EACH I&C PULL BOX ENCLOSURE. THE BASIS OF DESIGN IS "MY LOCKOUT TAGS PART # S-3057". CUSTOM SIGNS THAT MEET OR EXCEED THE STATED INTENTION, CONTAIN SPECIFIC LABEL TEXT, MATERIAL, AND HAVE EXPECTED LIFE WILL BE ACCEPTABLE.
- 13 INSTALL NEW JUNCTION BOXES SO THAT HINGES ARE INSTALLED ON LANDWARD SIDE AS INDICATED.



U.S. ARMY CORPS OF ENGINEERS		DRAWING NO.		201600077	
ROCK ISLAND DISTRICT		SHEET NO.		1	
ROCK ISLAND, ILLINOIS		SUBMITTED BY		WPT/25K-1-R-3-2029	
		SUBMITTED DATE		CONTRACT NO.	
JOB NO.		CADD BY		PLOT DATE	
DESIGN NO.		CHECKED BY		PLOT CODE	
AS SHOWN		DATE		EPI02	
SIZE		FILE NAME			
ANSI D		EPI105R-A03.0pt			

Sheet  
ID  
E-503

AS-BUILT  
A-113







c:\pwworking\mrb5ed\10153756\EP102E-602.dgn  
3/23/17 PM  
BREDDLH

D

C

B

A

### CONDUIT AND CABLE SCHEDULE

CONDUIT NUMBER	ORIGIN	DESTINATION	ELECTRICAL LOAD DATA					FEEDERS CONDUCTORS						CONTROL CONDUCTORS		CONDUIT SIZE	REMARKS	CONDUIT NUMBER
			KW/KVA	HP	AMPS	VOLTS	PHASE	PHASE		NEUTRAL		GROUND		QTY.	SIZE			
								QTY.	SIZE	QTY.	SIZE	QTY.	SIZE					
101	UTILITY TRANSFORMER	MOTOR CONTROL CENTER MCC1 (UTILITY METERING SECT.)			1600	480Y/277	3	12	600 KCMIL	4	600 KCMIL					4 - 4"		101
102	MOTOR CONTROL CENTER MCC1 (UTILITY METERING SECT.)	UTILITY METER SOCKET														1 1/2"	EMPTY CONDUIT FOR UTILITY COMPANY USE.	102
103	MOTOR CONTROL CENTER MCC1	LIGHTING TRANSFORMER TR1	15		35	480	3	3	#8			1	#10			1"		103
104	LIGHTING TRANSFORMER TR1	LIGHTING PANEL LP1			60	208Y/120	3	3	#6	1	#6	1	#8			1 1/4"		104
105	MOTOR CONTROL CENTER MCC1	UNIT HEATER			20	480	3	3	#12			1	#12			3/4"		105
106	CONTROL BUILDING (SOUTH WALL)	ELECTRICAL MANHOLE EMH-2														3 - 2"	SPARE CONDUITS	106
107	MOTOR CONTROL CENTER MCC1	PUMP 1 POWER JUNCTION BOX		240	375	480	3	6	250 KCMIL			2	#1/0			2 - 3"		107
108	PUMP 1 POWER JUNCTION BOX	PUMP 1		240	375	480	3	(2) PUMP POWER CABLES BY PUMP MANUFACTURER (NOTE 1)								2 - 4"	(250 KCMIL) POWER CABLE IS OZOFLEX (PLUS) H07RN8-F 4G120	108
109	MOTOR CONTROL CENTER MCC1	PUMP 2 POWER JUNCTION BOX		240	375	480	3	6	250 KCMIL			2	#1/0			2 - 3"		109
110	PUMP 2 POWER JUNCTION BOX	PUMP 2		240	375	480	3	(2) PUMP POWER CABLES BY PUMP MANUFACTURER (NOTE 1)								2 - 4"	(250 KCMIL) POWER CABLE IS OZOFLEX (PLUS) H07RN8-F 4G120	110
111	MOTOR CONTROL CENTER MCC1	PUMP 3 POWER JUNCTION BOX		240	375	480	3	6	250 KCMIL			2	#1/0			2 - 3"		111
112	PUMP 3 POWER JUNCTION BOX	PUMP 3		240	375	480	3	(2) PUMP POWER CABLES BY PUMP MANUFACTURER (NOTE 1)								2 - 4"	(250 KCMIL) POWER CABLE IS OZOFLEX (PLUS) H07RN8-F 4G120	112
113	MOTOR CONTROL CENTER MCC1	PUMP 1 SENSOR PULL BOX						8 COND./ ONE (1) PUMP SENSOR CABLE BY PUMP MANUFACTURER (NOTE 1)								2"	CONNECT TO PLC UNIT IN STARTER	113
114	PUMP 1 SENSOR PULL BOX	PUMP 1						8 COND./ ONE (1) PUMP SENSOR CABLE BY PUMP MANUFACTURER (NOTE 1)								2"	CABLE SPLICING NOT PERMITTED. 16 AWG OZOFLEX (PLUS) H07RN8-F 8G1.5	114
115	MOTOR CONTROL CENTER MCC1	PUMP 2 SENSOR PULL BOX						8 COND./ ONE (1) PUMP SENSOR CABLE BY PUMP MANUFACTURER (NOTE 1)								2"	CONNECT TO PLC UNIT IN STARTER	115
116	PUMP 2 SENSOR PULL BOX	PUMP 2						8 COND./ ONE (1) PUMP SENSOR CABLE BY PUMP MANUFACTURER (NOTE 1)								2"	CABLE SPLICING NOT PERMITTED. 16 AWG OZOFLEX (PLUS) H07RN8-F 8G1.5	116
117	MOTOR CONTROL CENTER MCC1	PUMP 3 SENSOR PULL BOX						8 COND./ ONE (1) PUMP SENSOR CABLE BY PUMP MANUFACTURER (NOTE 1)								2"	CONNECT TO PLC UNIT IN STARTER	117
118	PUMP 3 SENSOR PULL BOX	PUMP 3						8 COND./ ONE (1) PUMP SENSOR CABLE BY PUMP MANUFACTURER (NOTE 1)								2"	CABLE SPLICING NOT PERMITTED. 16 AWG OZOFLEX (PLUS) H07RN8-F 8G1.5	118
NOTE 1: CONTRACTOR SHALL VERIFY THE DIAMETERS OF CABLES PROVIDED BY THE EQUIPMENT MANUFACTURERS AND SHALL PROVIDE AND INSTALL THE CORRECTLY-SIZED CONDUITS AS REQUIRED BY NFPA 70 TO ACCOMMODATE THE ACTUAL CABLES PROVIDED. MINIMUM RACEWAY SIZES ARE INDICATED.																		

PANELBOARD SCHEDULE				DESIGNATION:		PANEL "LP1"			MAINS:			60 AMP MAIN CIRCUIT BREAKER		
				LOCATION:		CONTROL BUILDING			BUS SIZE			100 AMP BUS; GND. BUS; SOLID NEUTRAL		
				VOLTAGE:		208Y/120 VOLT			PANEL MOUNTING:			SURFACE		
				PHASE:		3 PHASE, 4 WIRE			ALL BREAKERS:			10,000 A.I.C. (MINIMUM)		
CKT. NO.	LOAD DESCRIPTION	#	KVA	CKT. BKR AMPS	POLE	A	B	C	CKT. BKR AMPS	POLE	KVA	#	LOAD DESCRIPTION	CKT. NO.
1	LTG - BLDG INTERIOR	1	0.44	20	1	0.98			20	1	0.54	1	RECEPT - BLDG INTERIOR	2
3	LTG - BLDG EXTERIOR	1	0.18	20	1		0.36		20	1	0.18	1	RECEPT - BLDG EXTERIOR	4
5	SPARE BREAKER			20	1			0.88	20	1	0.88	1	EXHAUST FAN EF-1 AND MOD	6
7	SPARE BREAKER			20	1				20	1	0.36	1	MCC PANEL COMPART HEATERS	8
9	SPARE BREAKER			20	1		0.30		20	1			SPARE BREAKER	10
11	SPARE BREAKER			20	1			0.00	20	1			SPARE BREAKER	12
13	SPARE BREAKER			20	1	0.00			20	1			SPARE BREAKER	14
15	SPARE BREAKER			20	1		0.30		20	1			SPARE BREAKER	16
17	SPARE BREAKER			20	1			0.00	20	1			SPARE BREAKER	18
19	SPARE BREAKER			20	1	0.00			60	3	0.00	7	TVSS UNIT	20
21	SPARE BREAKER			20	1		0.30		--	--	0.00	--	"	--
23	SPARE BREAKER			20	1			0.00	--	--	0.00	--	"	--
25	SPARE BREAKER			20	1	0.00				1			BLANK SPACE	26
27	SPARE BREAKER			20	1		0.30			1			BLANK SPACE	--
29	SPARE BREAKER			20	1			0.00		1			BLANK SPACE	--
TOTAL CONNECTED LOAD:						0.98	0.36	0.88	TOTAL = 2.22 KVA					
# ONE (1) OR TWO (2) DIGIT NUMBERS REFER TO PANELBOARD BRANCH CIRCUIT CONDUIT AND CABLE SCHEDULE LOCATED BELOW ON THIS SHEET. SEPARATE CONSIDERATION, BUT NOTE THAT THREE (3) DIGIT CONDUIT NUMBERS REFER TO CONDUIT AND CABLE SCHEDULES LOCATED ABOVE ON THIS SHEET.														

PANELBOARD BRANCH CIRCUIT CONDUIT & CABLE SCHEDULE	
#	DESCRIPTION
1	3/4" CONDUIT WITH 2 #12 CONDUCTORS AND 1 #12 GROUND CONDUCTOR.
2	3/4" CONDUIT WITH 3 #12 CONDUCTORS AND 1 #12 GROUND CONDUCTOR.
3	3/4" CONDUIT WITH 4 #12 CONDUCTORS AND 1 #12 GROUND CONDUCTOR.
4	3/4" CONDUIT WITH 2 #10 CONDUCTORS AND 1 #10 GROUND CONDUCTOR.
5	3/4" CONDUIT WITH 3 #10 CONDUCTORS AND 1 #10 GROUND CONDUCTOR.
6	3/4" CONDUIT WITH 4 #10 CONDUCTORS AND 1 #10 GROUND CONDUCTOR.
7	1 1/4" CONDUIT WITH 4 #6 CONDUCTORS AND 1 #6 GROUND CONDUCTOR.



APPRO.

DATE

DESCRIPTION

AS-BUILT AS OF 20 SEPTEMBER 2017

DATE

2011/06/30

DESIGNED BY:

BGR

CHKD BY:

KRR

DATE

10/12/2017

DESIGNED BY:

DEE

CHKD BY:

KRR

DATE

10/12/2017

DESIGNED BY:

JMB

CHKD BY:

KRR

DATE

10/12/2017

DESIGNED BY:

AS SHOWN

DATE

10/12/2017

DESIGNED BY:

AS SHOWN



DATE

10/12/2017


DESIGNED BY:

AS SHOWN

DATE

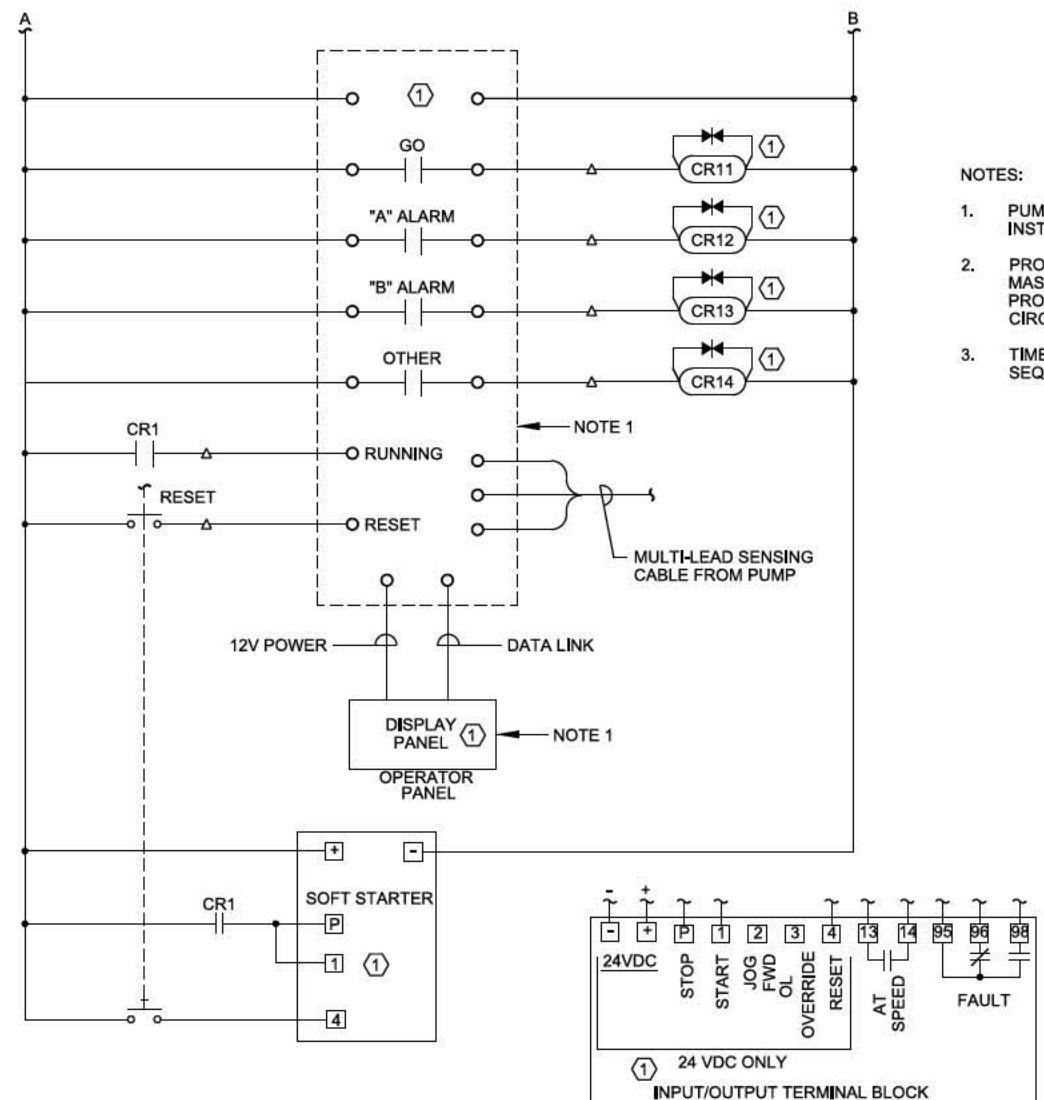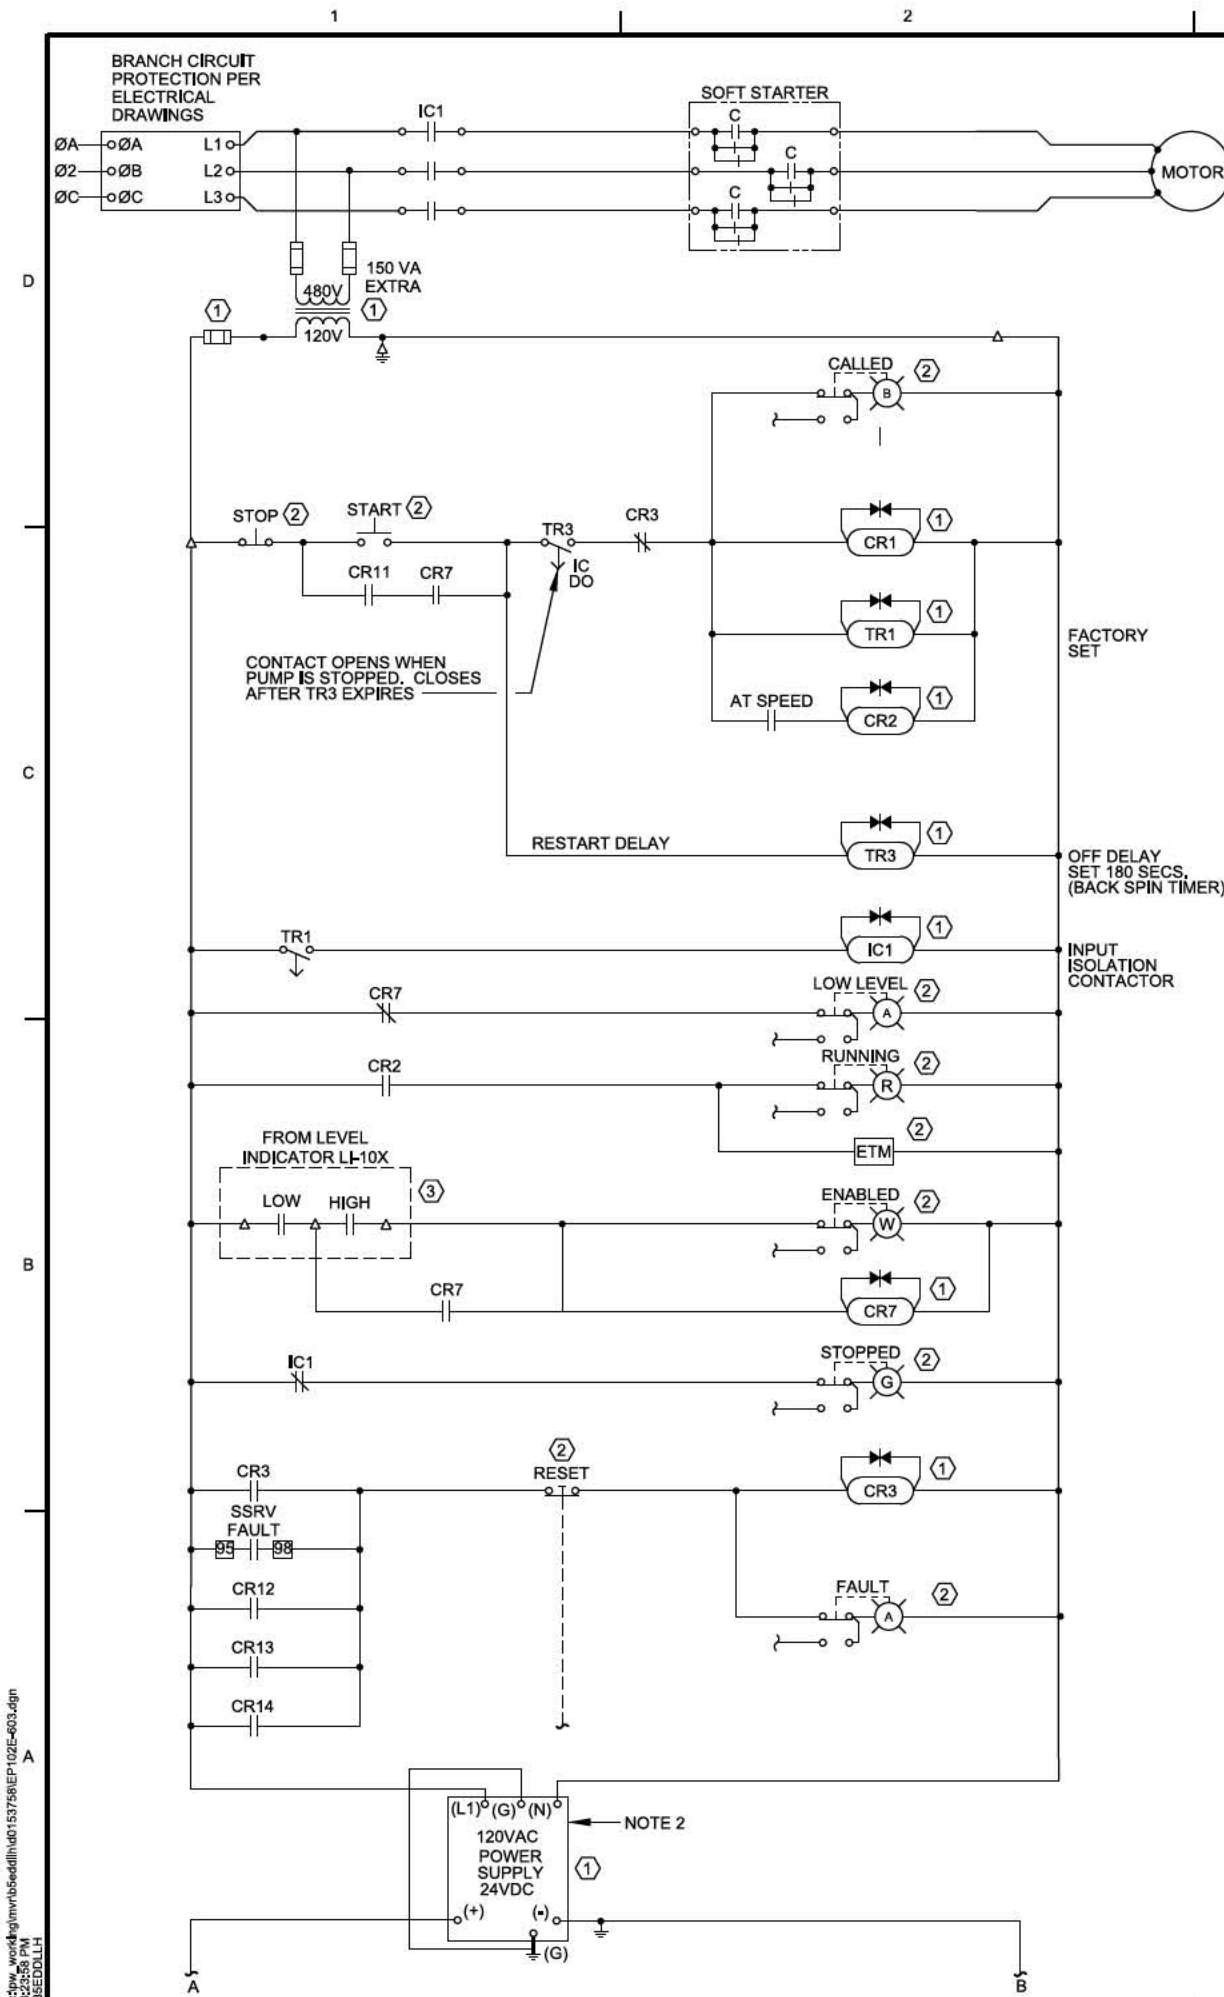

**PUMP NO. 1**  
**(TYPICAL FOR PUMPS NO. 2 & NO. 3)**  
NOT TO SCALE

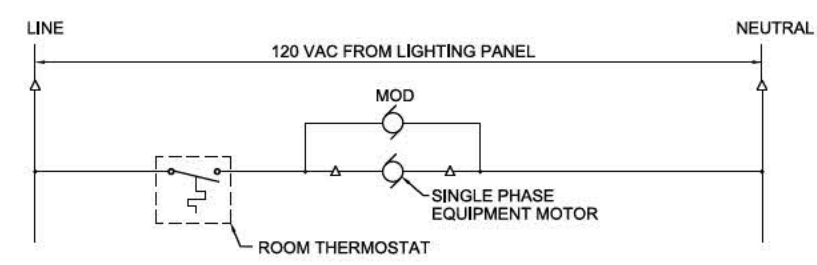

**CONTROL BUILDING EXHAUST FAN EF-1**  
NOT TO SCALE

- NOTES:
- PUMP MONITORING AND STATUS (MAS) UNIT SHALL BE INSTALLED IN MCC STARTER SECTION ENCLOSURE.
  - PROVIDE 0.5 AMP EXTRA CAPACITY FOR THE PUMP MAS UNIT (BASIS OF DESIGN IS FLYGT MAS UNIT). PROVIDE EITHER INTEGRAL OR SEPARATE SHORT CIRCUIT PROTECTION FOR THE DC CONTROL CIRCUIT.
  - TIMER AND CONTROL RELAY NUMBERING IS OUT OF SEQUENCE.

LOCATION CODE	
KEY	DESCRIPTION
①	STARTER INTERIOR
②	STARTER EXTERIOR
③	FIELD DEVICE

TERMINAL LEGEND	
KEY	DESCRIPTION
Δ	STARTER
⊠	CONTROL PANEL
◇	OTHER PANEL AS INDICATED

US Army Corps of Engineers

DATE:	20110930
DESIGNED BY:	ECR
DRAWN BY:	CDR BT
CHECKED BY:	CDR
APPROVED BY:	CDR
DATE:	20110930
PROJECT CODE:	EP102
FILE NAME:	EP102-603.dgn
SHEET:	1
TOTAL:	1

U.S. ARMY CORPS OF ENGINEERS  
ROCK ISLAND DISTRICT  
ROCK ISLAND, ILLINOIS

ILLINOIS WATERWAY  
JACKSON COUNTY, IL  
RICE LAKE HABITAT REHAB & ENHANCEMENT  
STAGE 1

ELEMENTARY WIRING  
DIAGRAMS


Sheet  
ID  
**E-603**

AS-BUILT  
**A-116**



FINAL SURVEY NO.	SURVEYED PLOTTED NO.	BY	DATE

ORIGINAL SURVEY NO.	SURVEYED PLOTTED NO.	BY	DATE

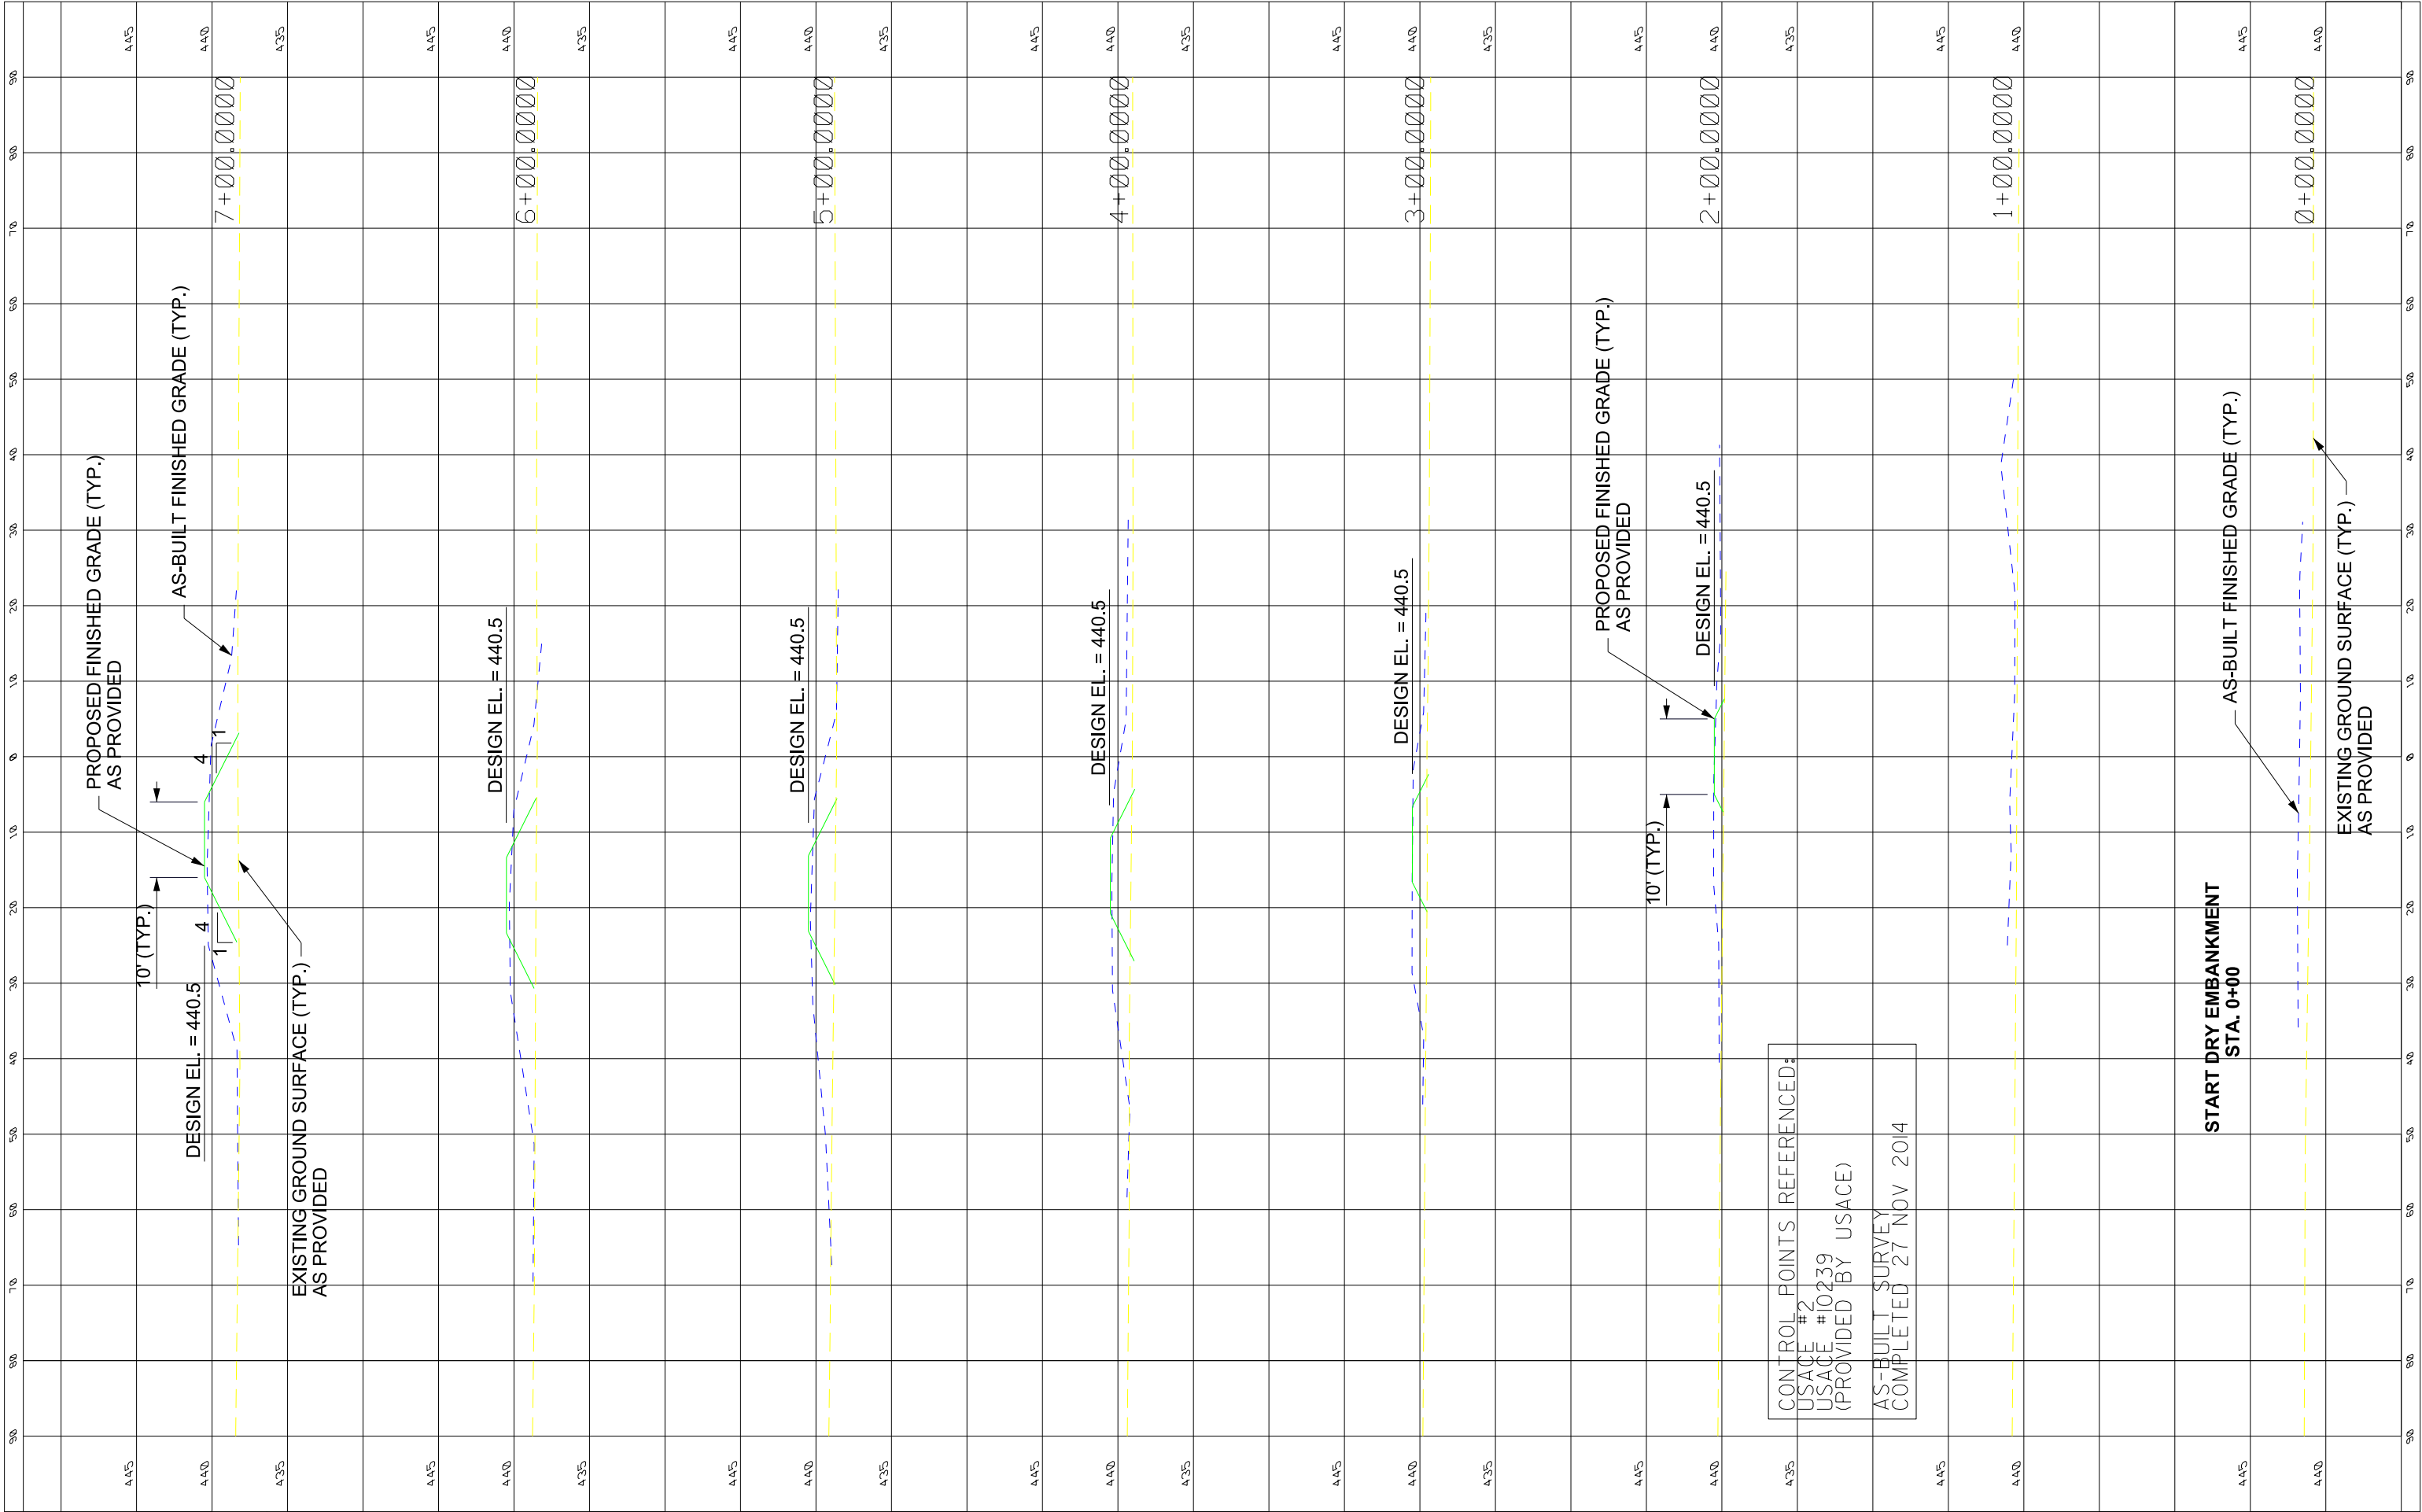

MSIPROJECT NUMBER:  
242-I2001.01 (FISCHER EXC.)  
242-II012.02 (LEANDER CONST.)  
PLOT DATE = 11 DEC 2014

SURVEYED - MAF/SNP  
DRAWN - SNP  
CHECKED - SPF  
DATE - 11 DEC 2014

SURVEYED ON: 26 NOV 2014  
HORIZ. DATUM: NAD 83  
VERT. DATUM: AS PROVIDED


UNITED STATES ARMY CORPS OF ENGINEERS  
RICE LAKE HABITAT REHAB & ENHANCEMENT  
FULTON CO., ILLINOIS

OVERFLOW SPILLWAY AS-BUILT CROSS SECTIONS  
STA. 0+00 TO 65+00 AT RICE LAKE

SCALE: AS SHOWN SHEET 1 OF 10 SHEETS STA. 0+00.0000 TO STA. 7+00.0000

FINAL SURVEY NOTE BOOK NO.	SURVEYED PLOTTED TEMPLATE AREAS CHECKED	BY	DATE

ORIGINAL SURVEY NOTE BOOK NO.	SURVEYED PLOTTED TEMPLATE AREAS CHECKED	BY	DATE

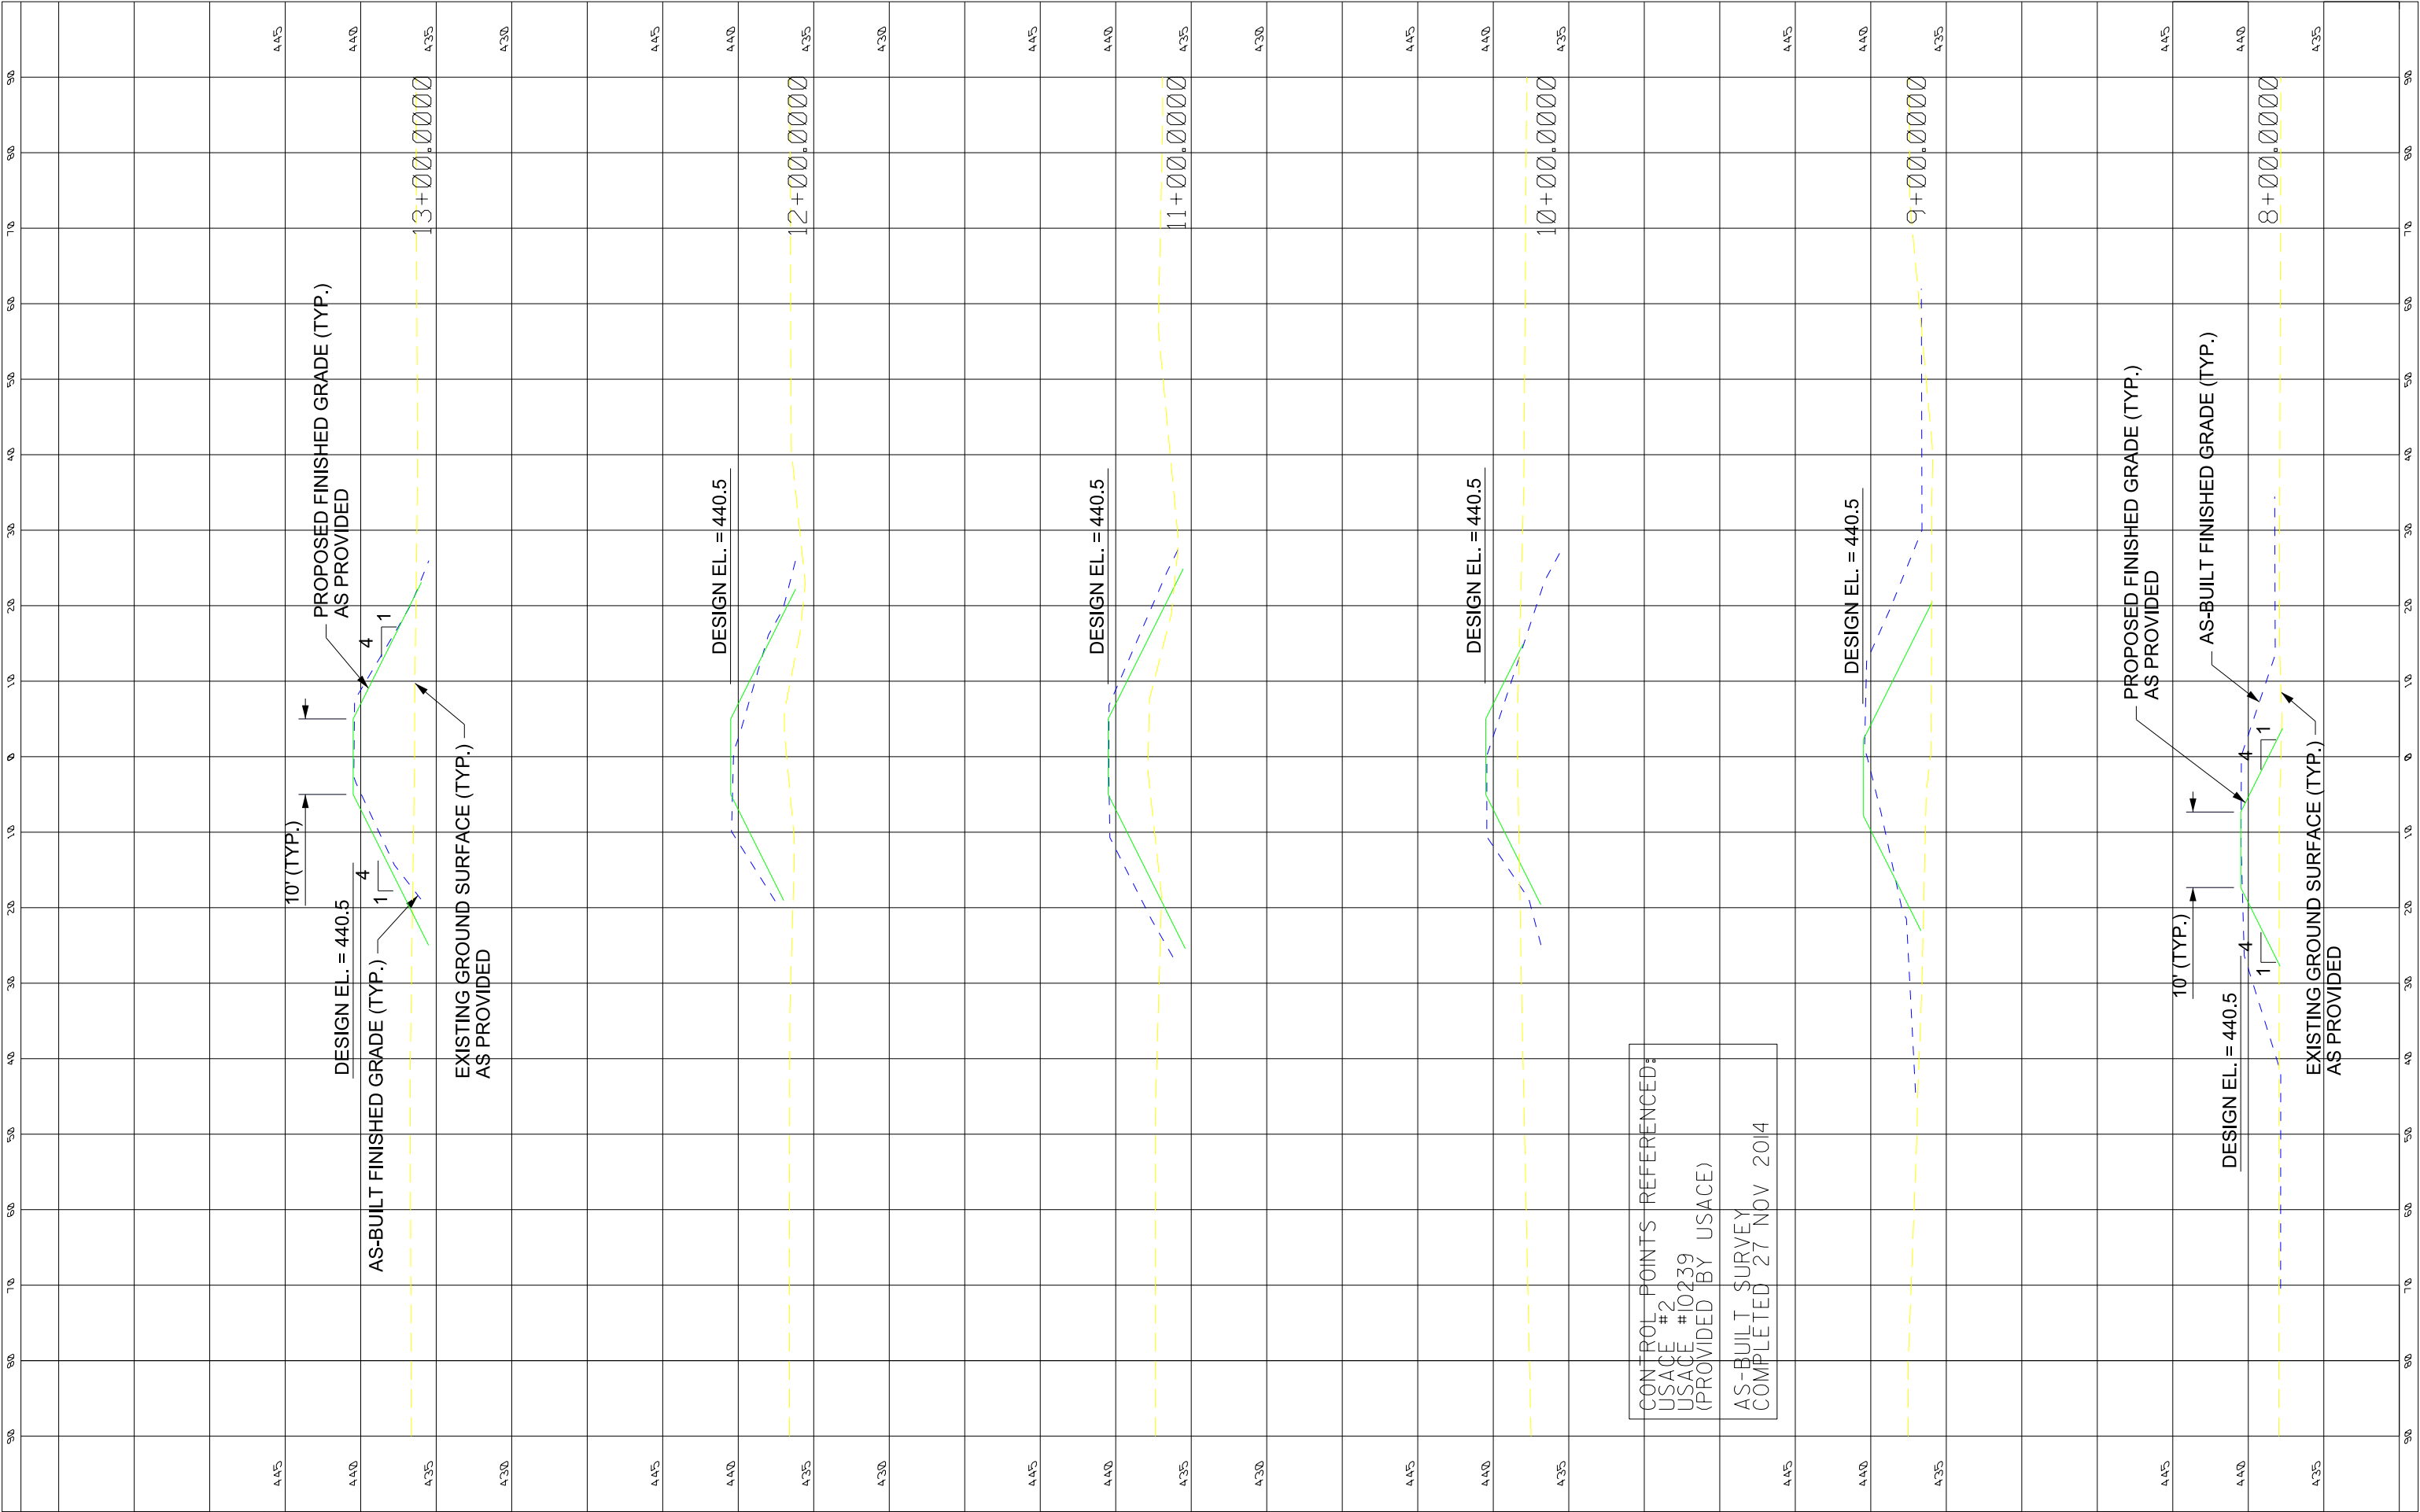

MSIPROJECT NUMBER:  
242-I200L01(FISCHER EXC.)  
242-II012.02 (LEANDER CONST.)  
PLOT DATE = 11 DEC 2014

SURVEYED - MAF/SNP  
DRAWN - SNP  
CHECKED - SPF  
DATE - 11 DEC 2014

SURVEYED ON: 26 NOV 2014  
HORIZ. DATUM: NAD 83  
VERT. DATUM: AS PROVIDED

UNITED STATES ARMY CORPS OF ENGINEERS  
RICE LAKE HABITAT REHAB & ENHANCEMENT  
FULTON CO., ILLINOIS


OVERFLOW SPILLWAY AS-BUILT CROSS SECTIONS  
STA. 0+00 TO 65+00 AT RICE LAKE

SCALE: AS SHOWN | SHEET 2 OF 10 SHEETS | STA. 8+00.0000 TO STA.13+00.0000



FINAL SURVEY NO.	SURVEYED NOTE BOOK	PLOTTED TEMPLATE AREAS CHECKED	BY	DATE

ORIGINAL SURVEY NO.	SURVEYED NOTE BOOK	PLOTTED TEMPLATE AREAS CHECKED	BY	DATE

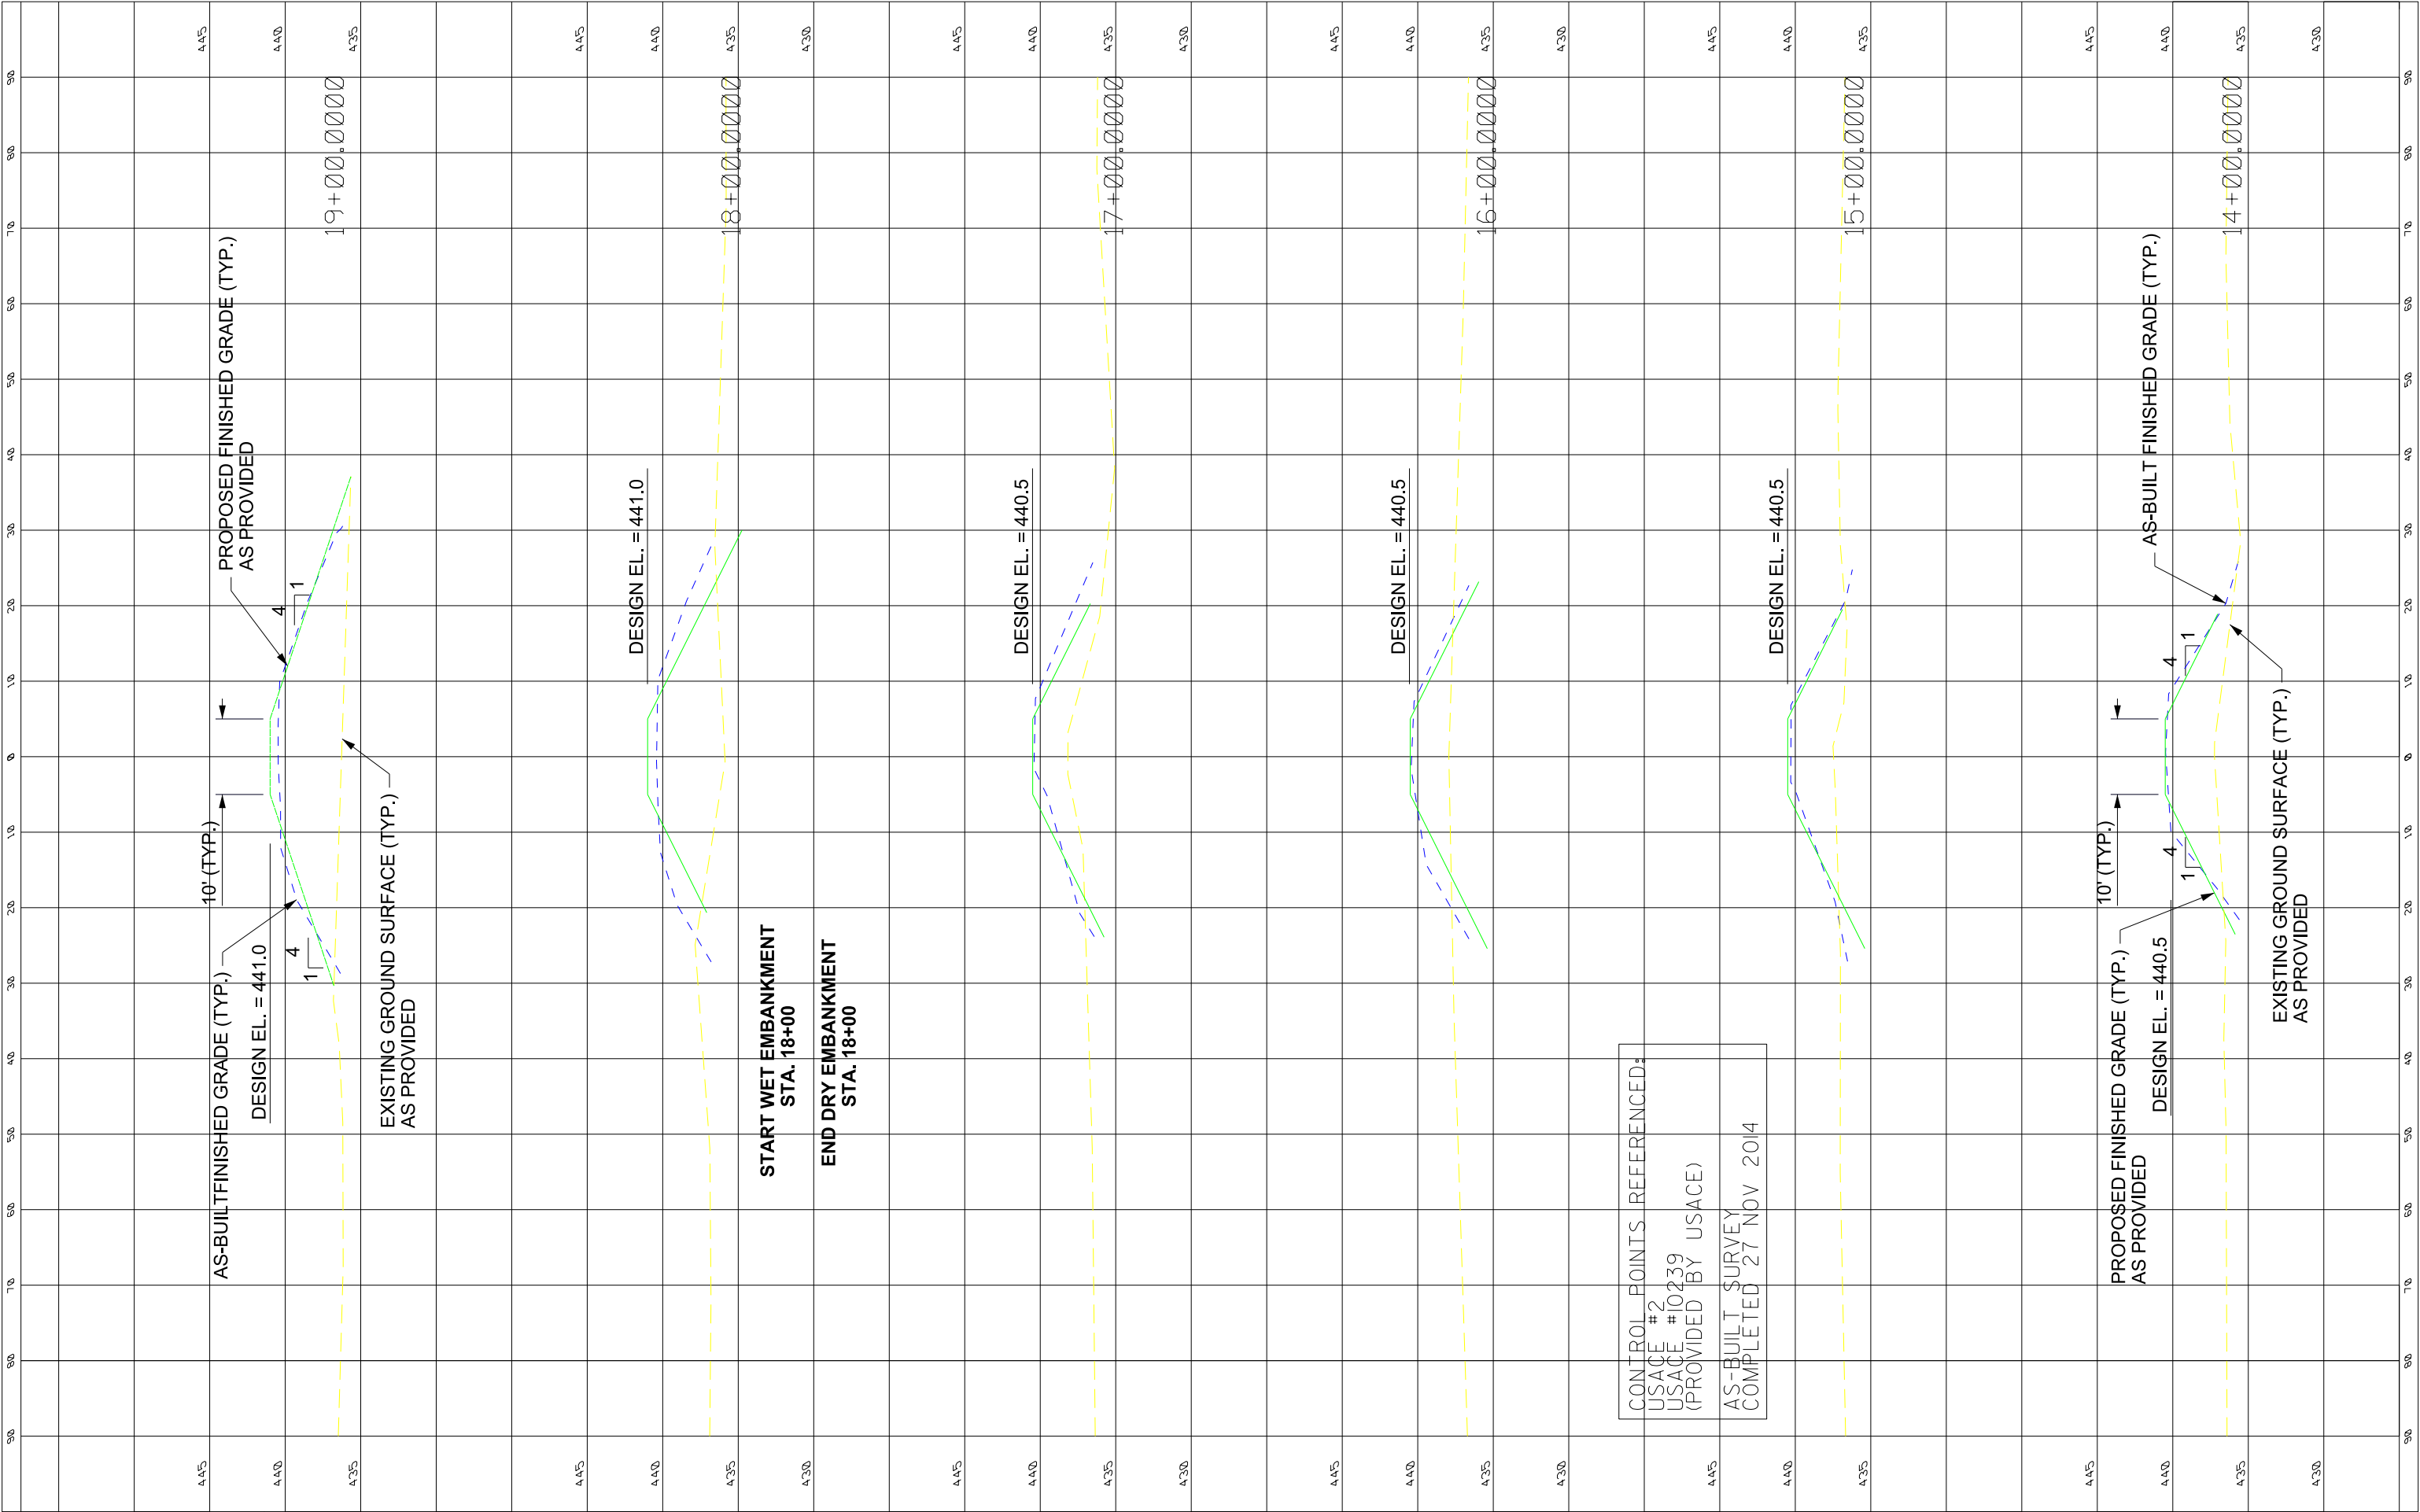

MSIPROJECT NUMBER:  
242-12001.01 (FISCHER EXC.)  
242-11012.02 (LEANDER CONST.)  
PLOT DATE = 11 DEC 2014

SURVEYED - MAF/SNP  
DRAWN - SNP  
CHECKED - SPF  
DATE - 11 DEC 2014

SURVEYED ON: 26 NOV 2014  
HORIZ. DATUM: NAD 83  
VERT. DATUM: AS PROVIDED


UNITED STATES ARMY CORPS OF ENGINEERS  
RICE LAKE HABITAT REHAB & ENHANCEMENT  
FULTON CO., ILLINOIS

OVERFLOW SPILLWAY AS-BUILT CROSS SECTIONS  
STA. 0+00 TO 65+00 AT RICE LAKE

SCALE: AS SHOWN | SHEET 3 OF 10 SHEETS | STA. 14+00.0000 TO STA. 19+00.0000

FINAL SURVEY NOTE BOOK NO.	SURVEYED PLOTTED TEMPLATE AREAS CHECKED	BY	DATE


ORIGINAL SURVEY NOTE BOOK NO.	SURVEYED PLOTTED TEMPLATE AREAS CHECKED	BY	DATE

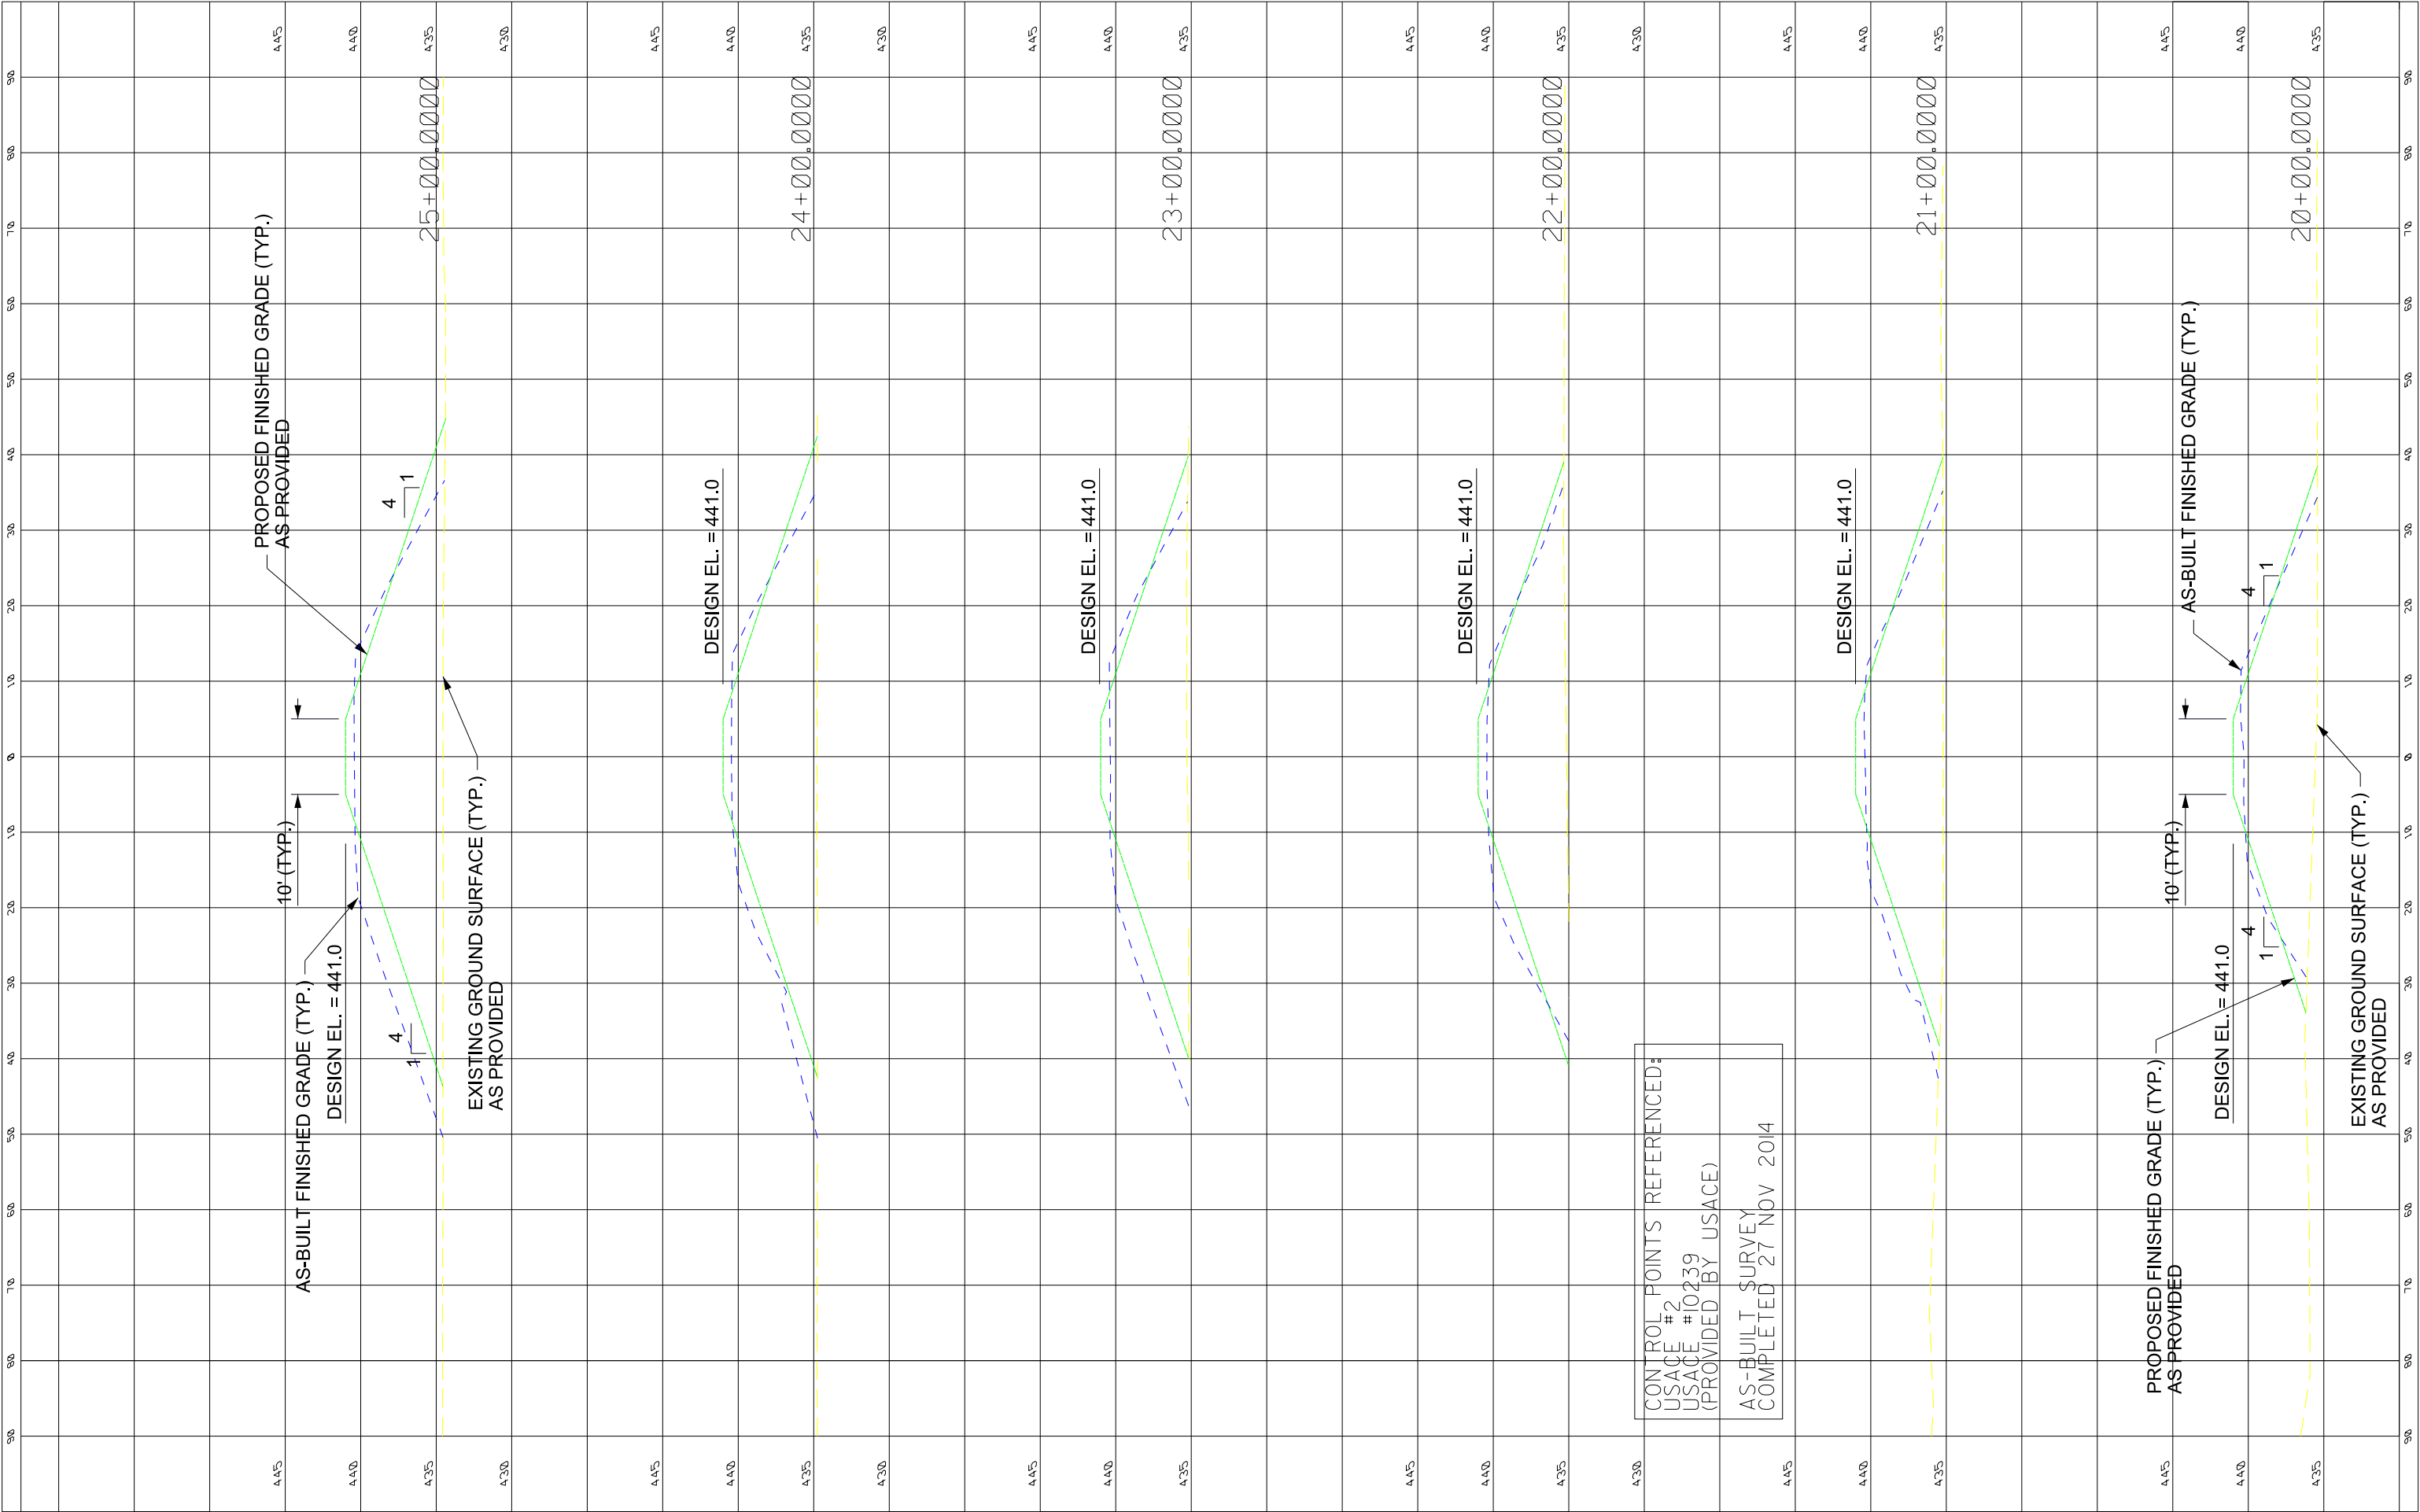



FINAL SURVEY NO.	SURVEYED PLOTTED NOTE BOOK AREAS CHECKED	BY	DATE

ORIGINAL SURVEY NO.	SURVEYED PLOTTED NOTE BOOK AREAS CHECKED	BY	DATE

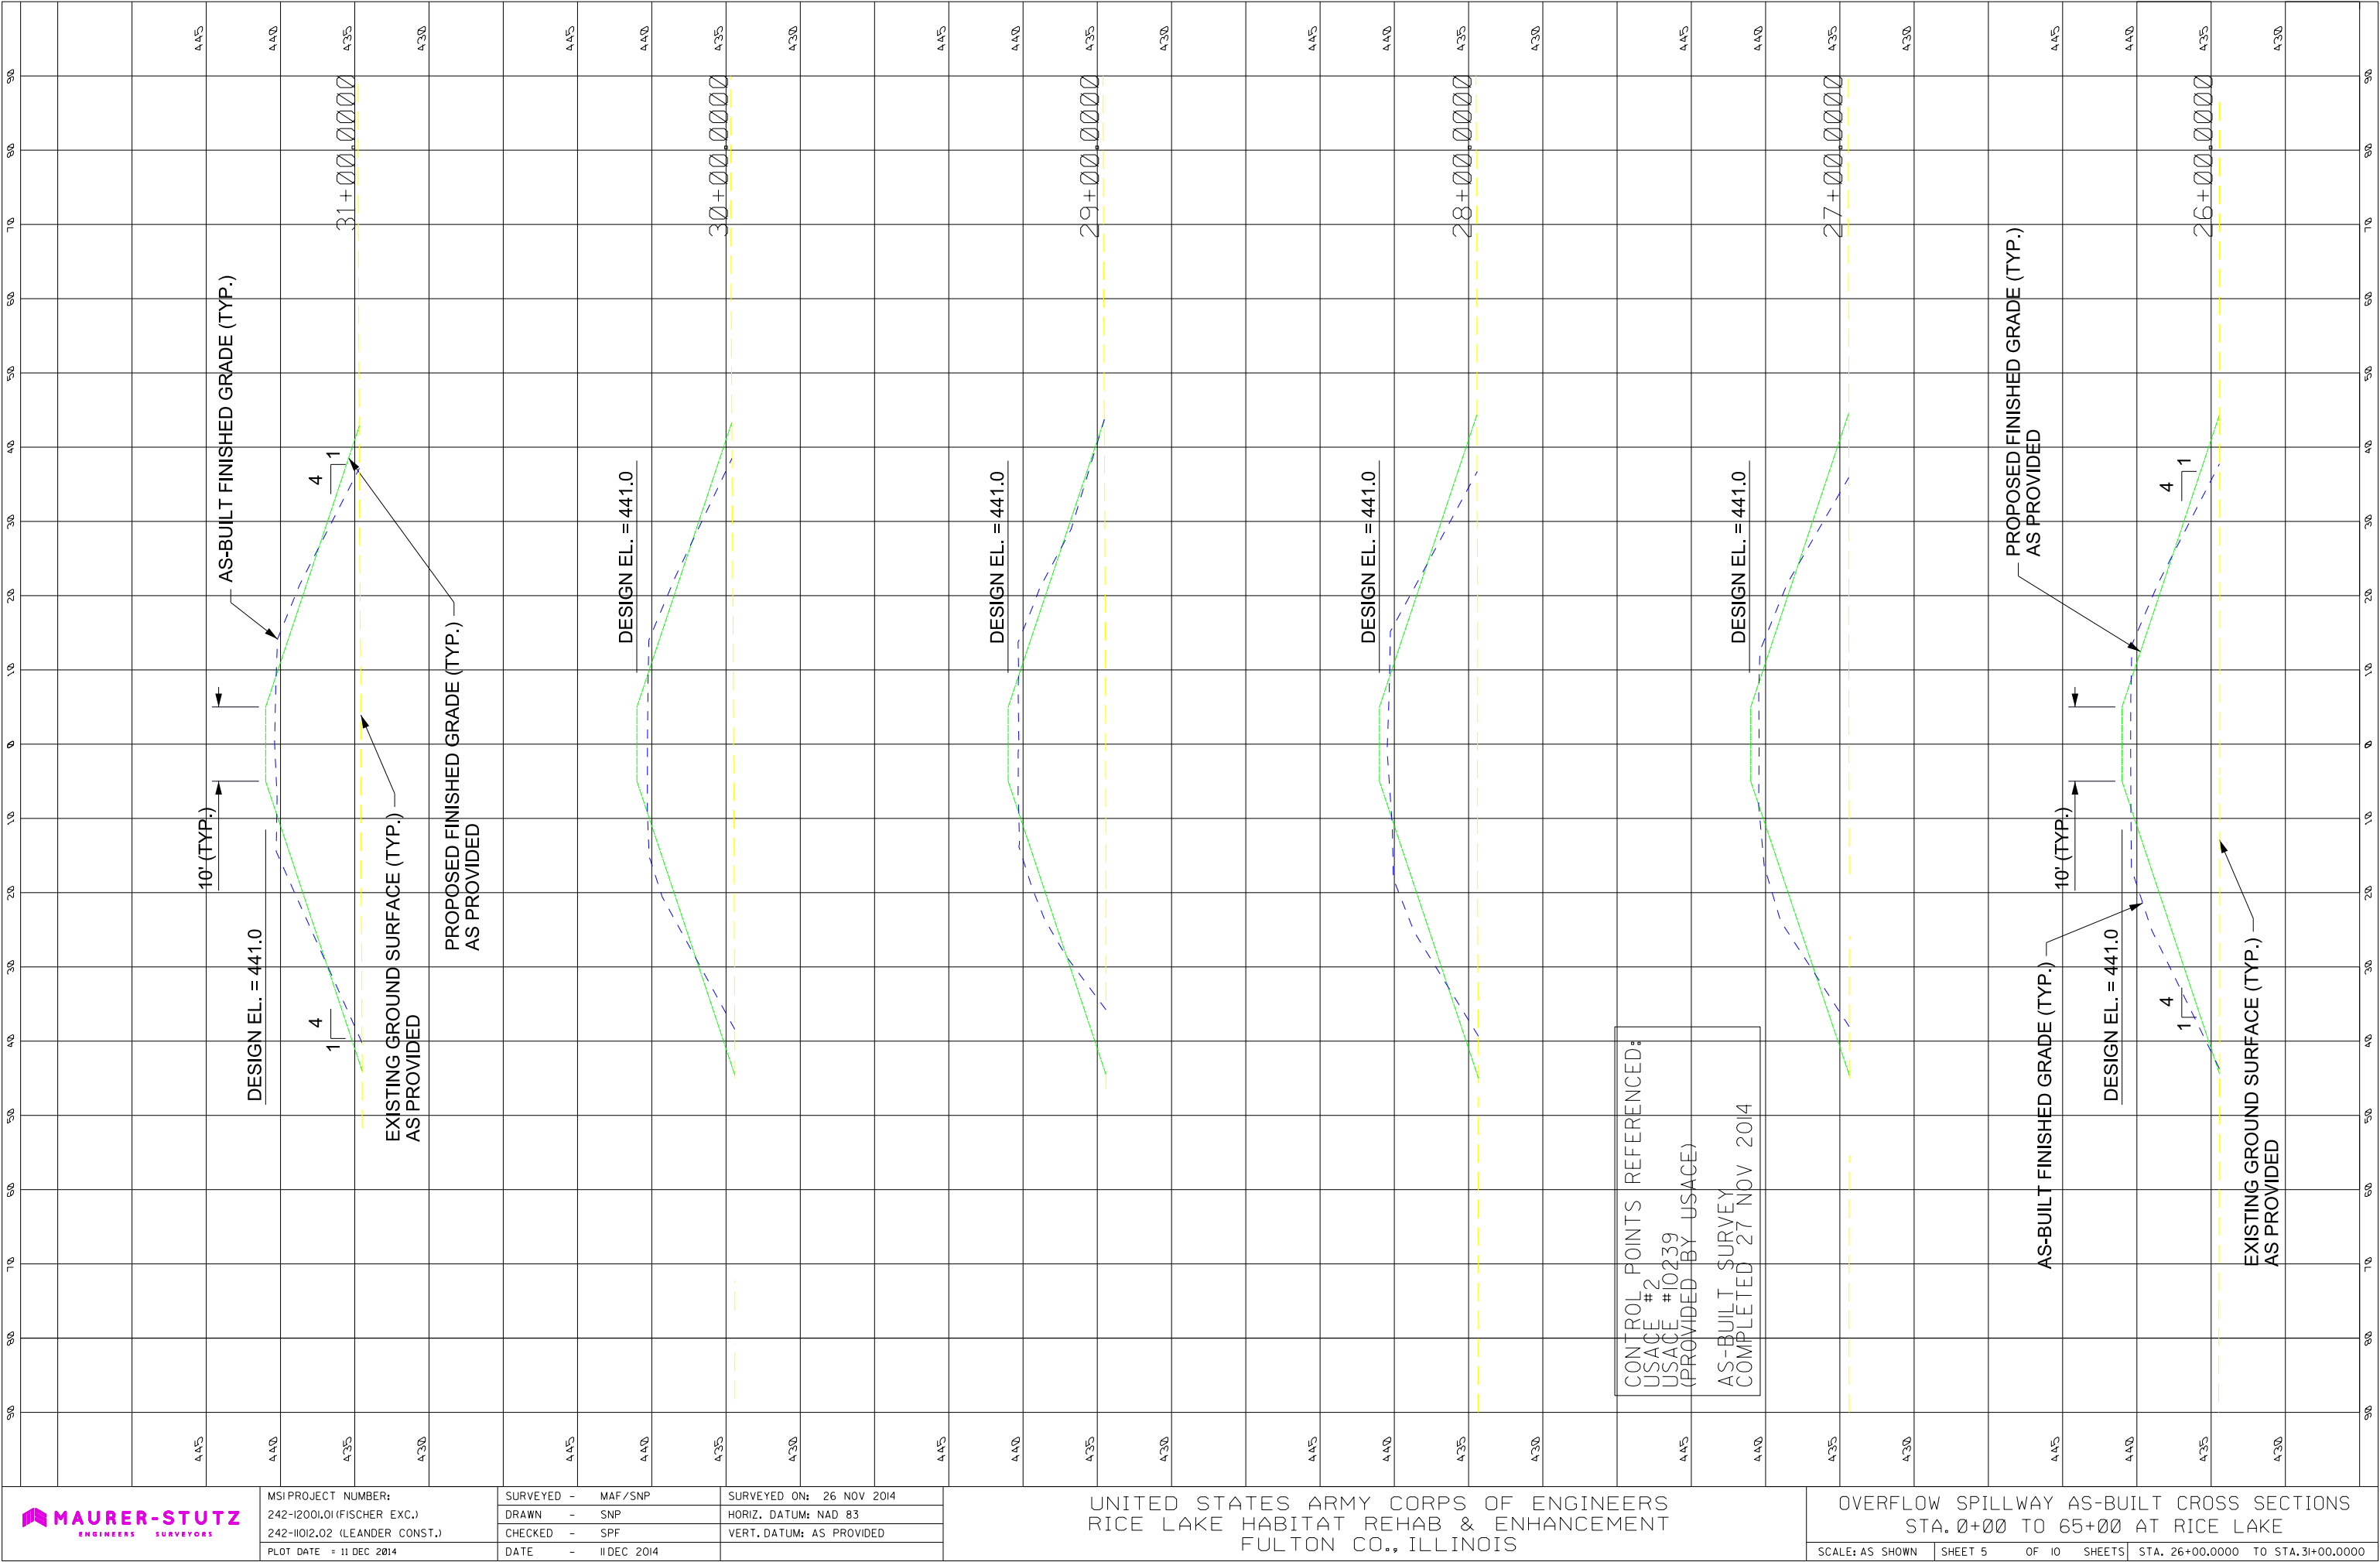

FINAL SURVEY NO.	NO.	SURVEYED PLOTTED AREAS CHECKED	BY	DATE

ORIGINAL SURVEY NO.	NO.	SURVEYED PLOTTED AREAS CHECKED	BY	DATE



MSIPROJECT NUMBER:  
242-I200I.0I (FISCHER EXC.)  
242-II0I2.02 (LEANDER CONST.)  
PLOT DATE = 11 DEC 2014


SURVEYED - MAF /SNP  
DRAWN - SNP  
CHECKED - SPF  
DATE - 11 DEC 2014

SURVEYED ON: 26 NOV 2014  
HORIZ. DATUM: NAD 83  
VERT. DATUM: AS PROVIDED

UNITED STATES ARMY CORPS OF ENGINEERS  
RICE LAKE HABITAT REHAB & ENHANCEMENT  
FULTON CO., ILLINOIS

CONTROL POINTS REFERENCED:  
USACE #2  
USACE #10239  
(PROVIDED BY USACE)  
AS-BUILT SURVEY  
COMPLETED 27 NOV 2014


OVERFLOW SPILLWAY AS-BUILT CROSS SECTIONS  
STA. 0+00 TO 65+00 AT RICE LAKE  
SCALE: AS SHOWN | SHEET 6 OF 10 SHEETS | STA. 32+00.0000 TO STA. 37+00.0000

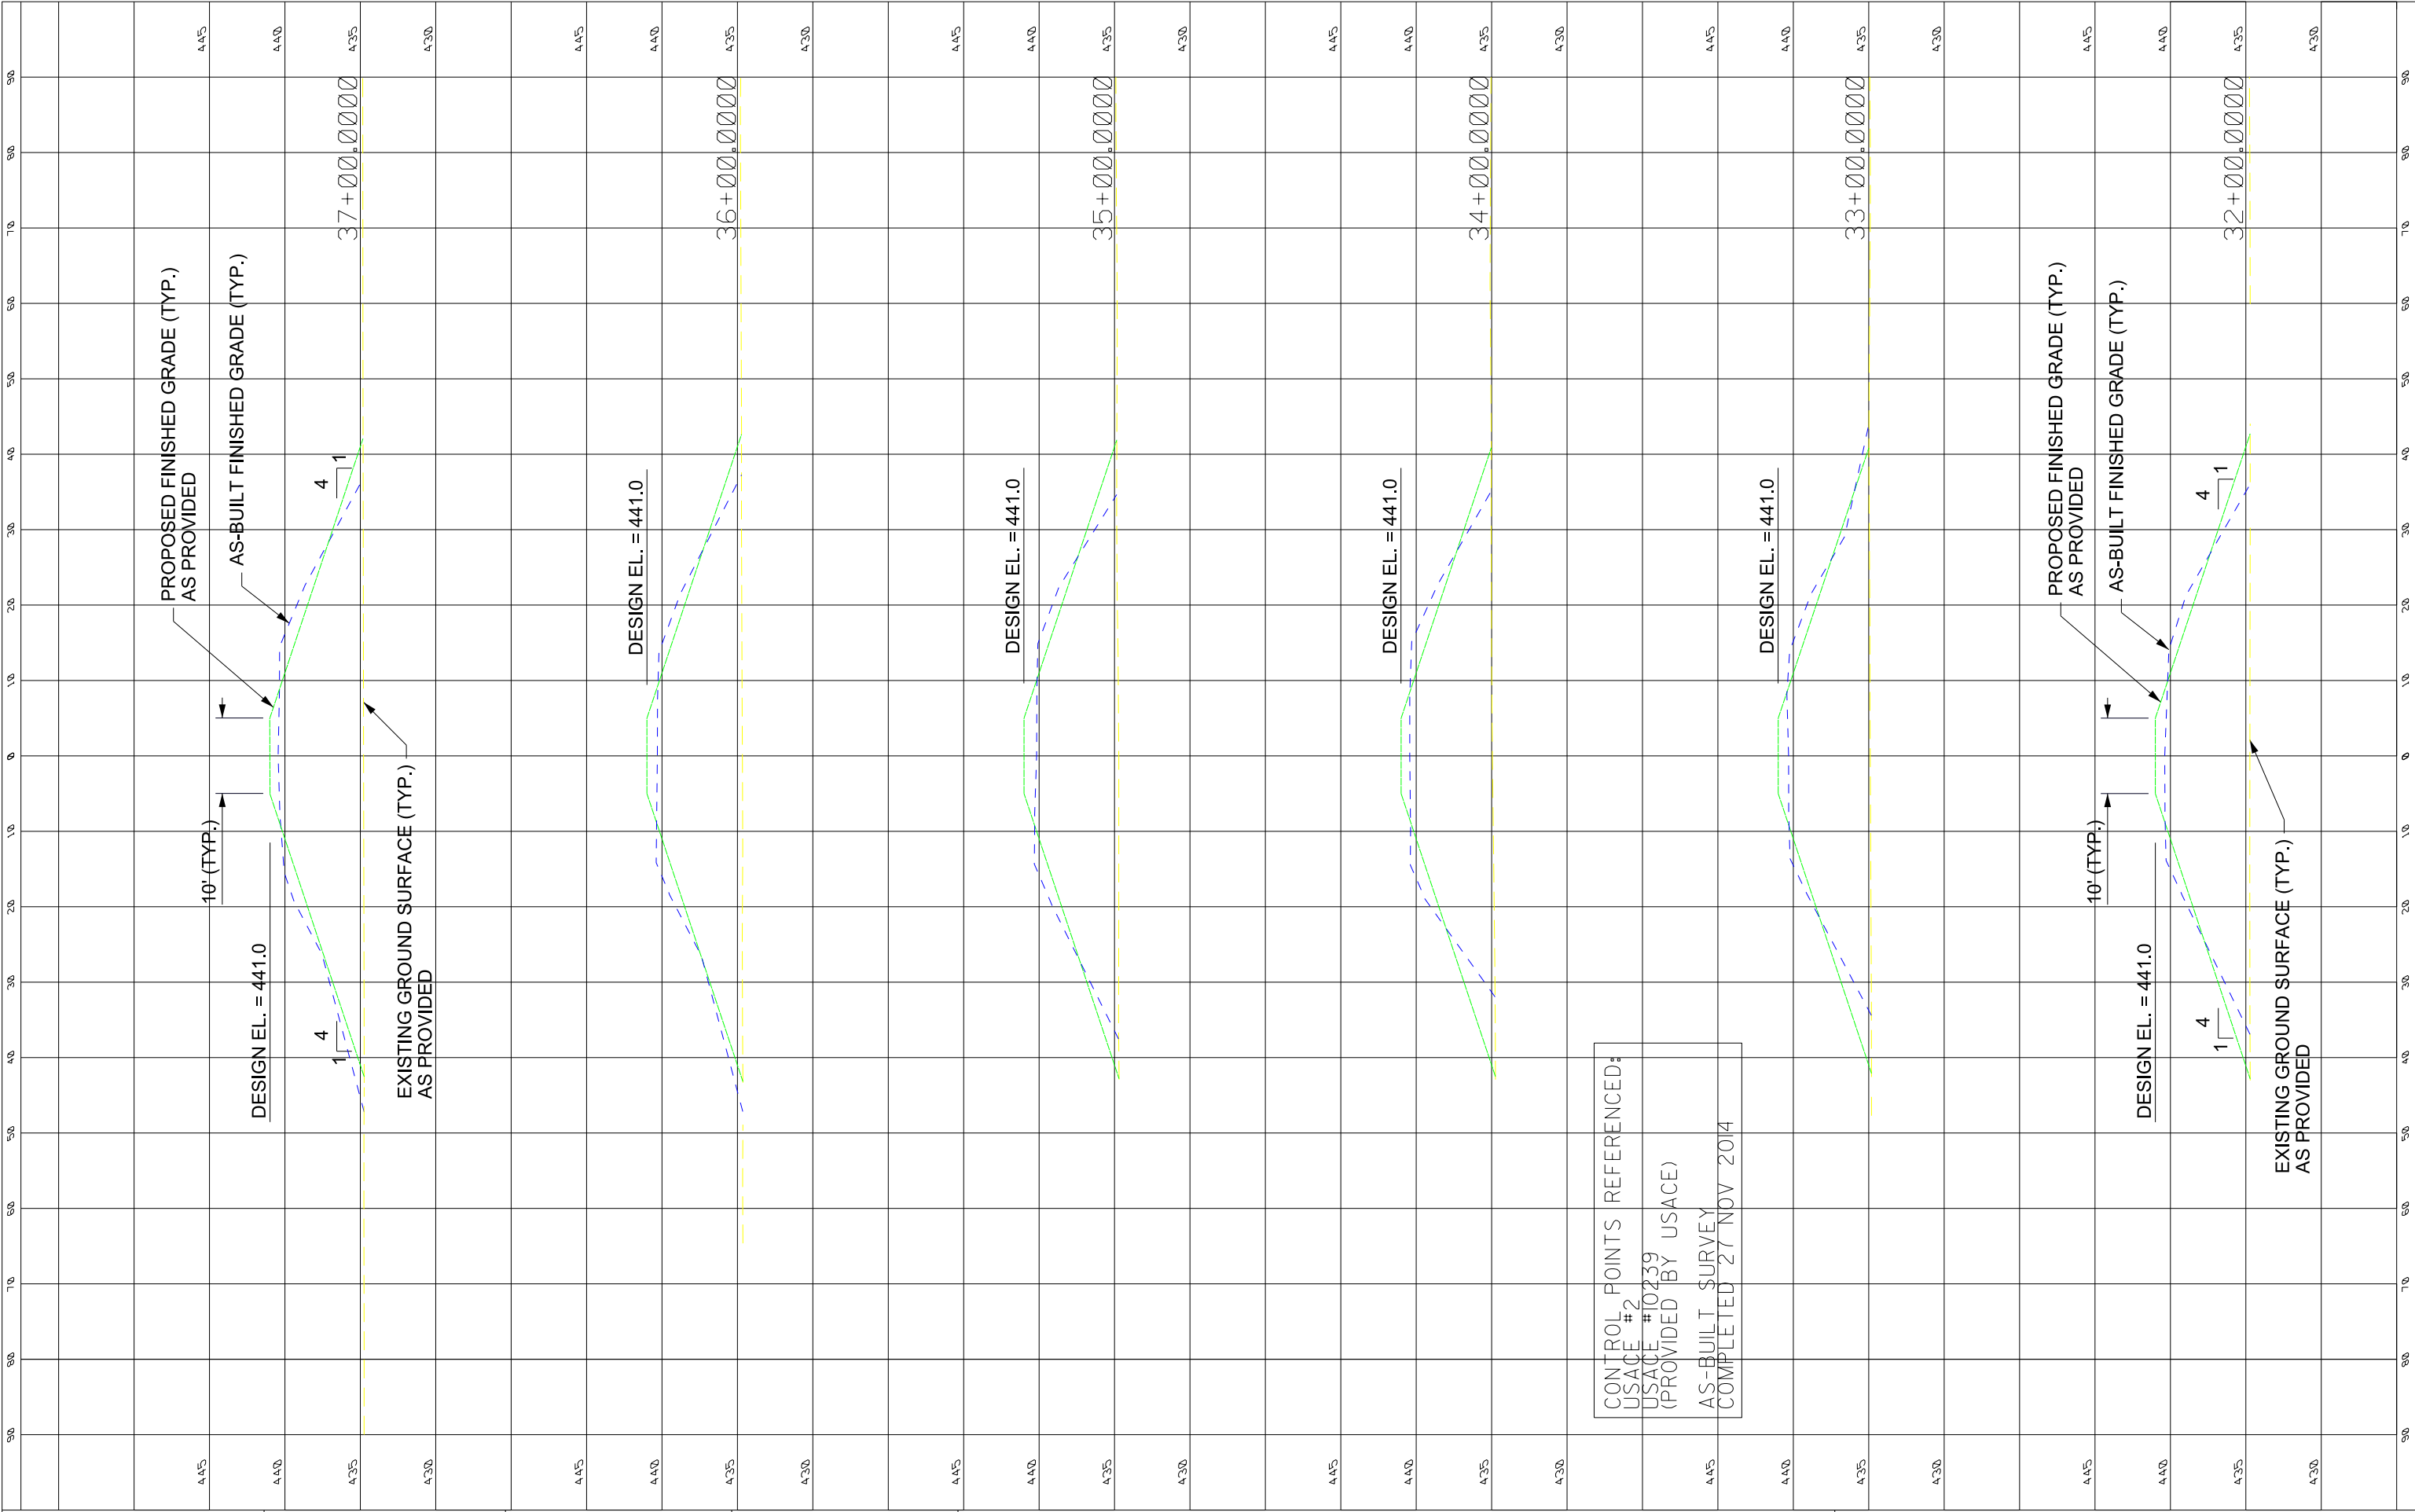



FINAL SURVEY NO.	NO.	NOTE BOOK	SURVEYED PLOTTED AREAS CHECKED	BY	DATE

ORIGINAL SURVEY NO.	NO.	NOTE BOOK	SURVEYED PLOTTED AREAS CHECKED	BY	DATE

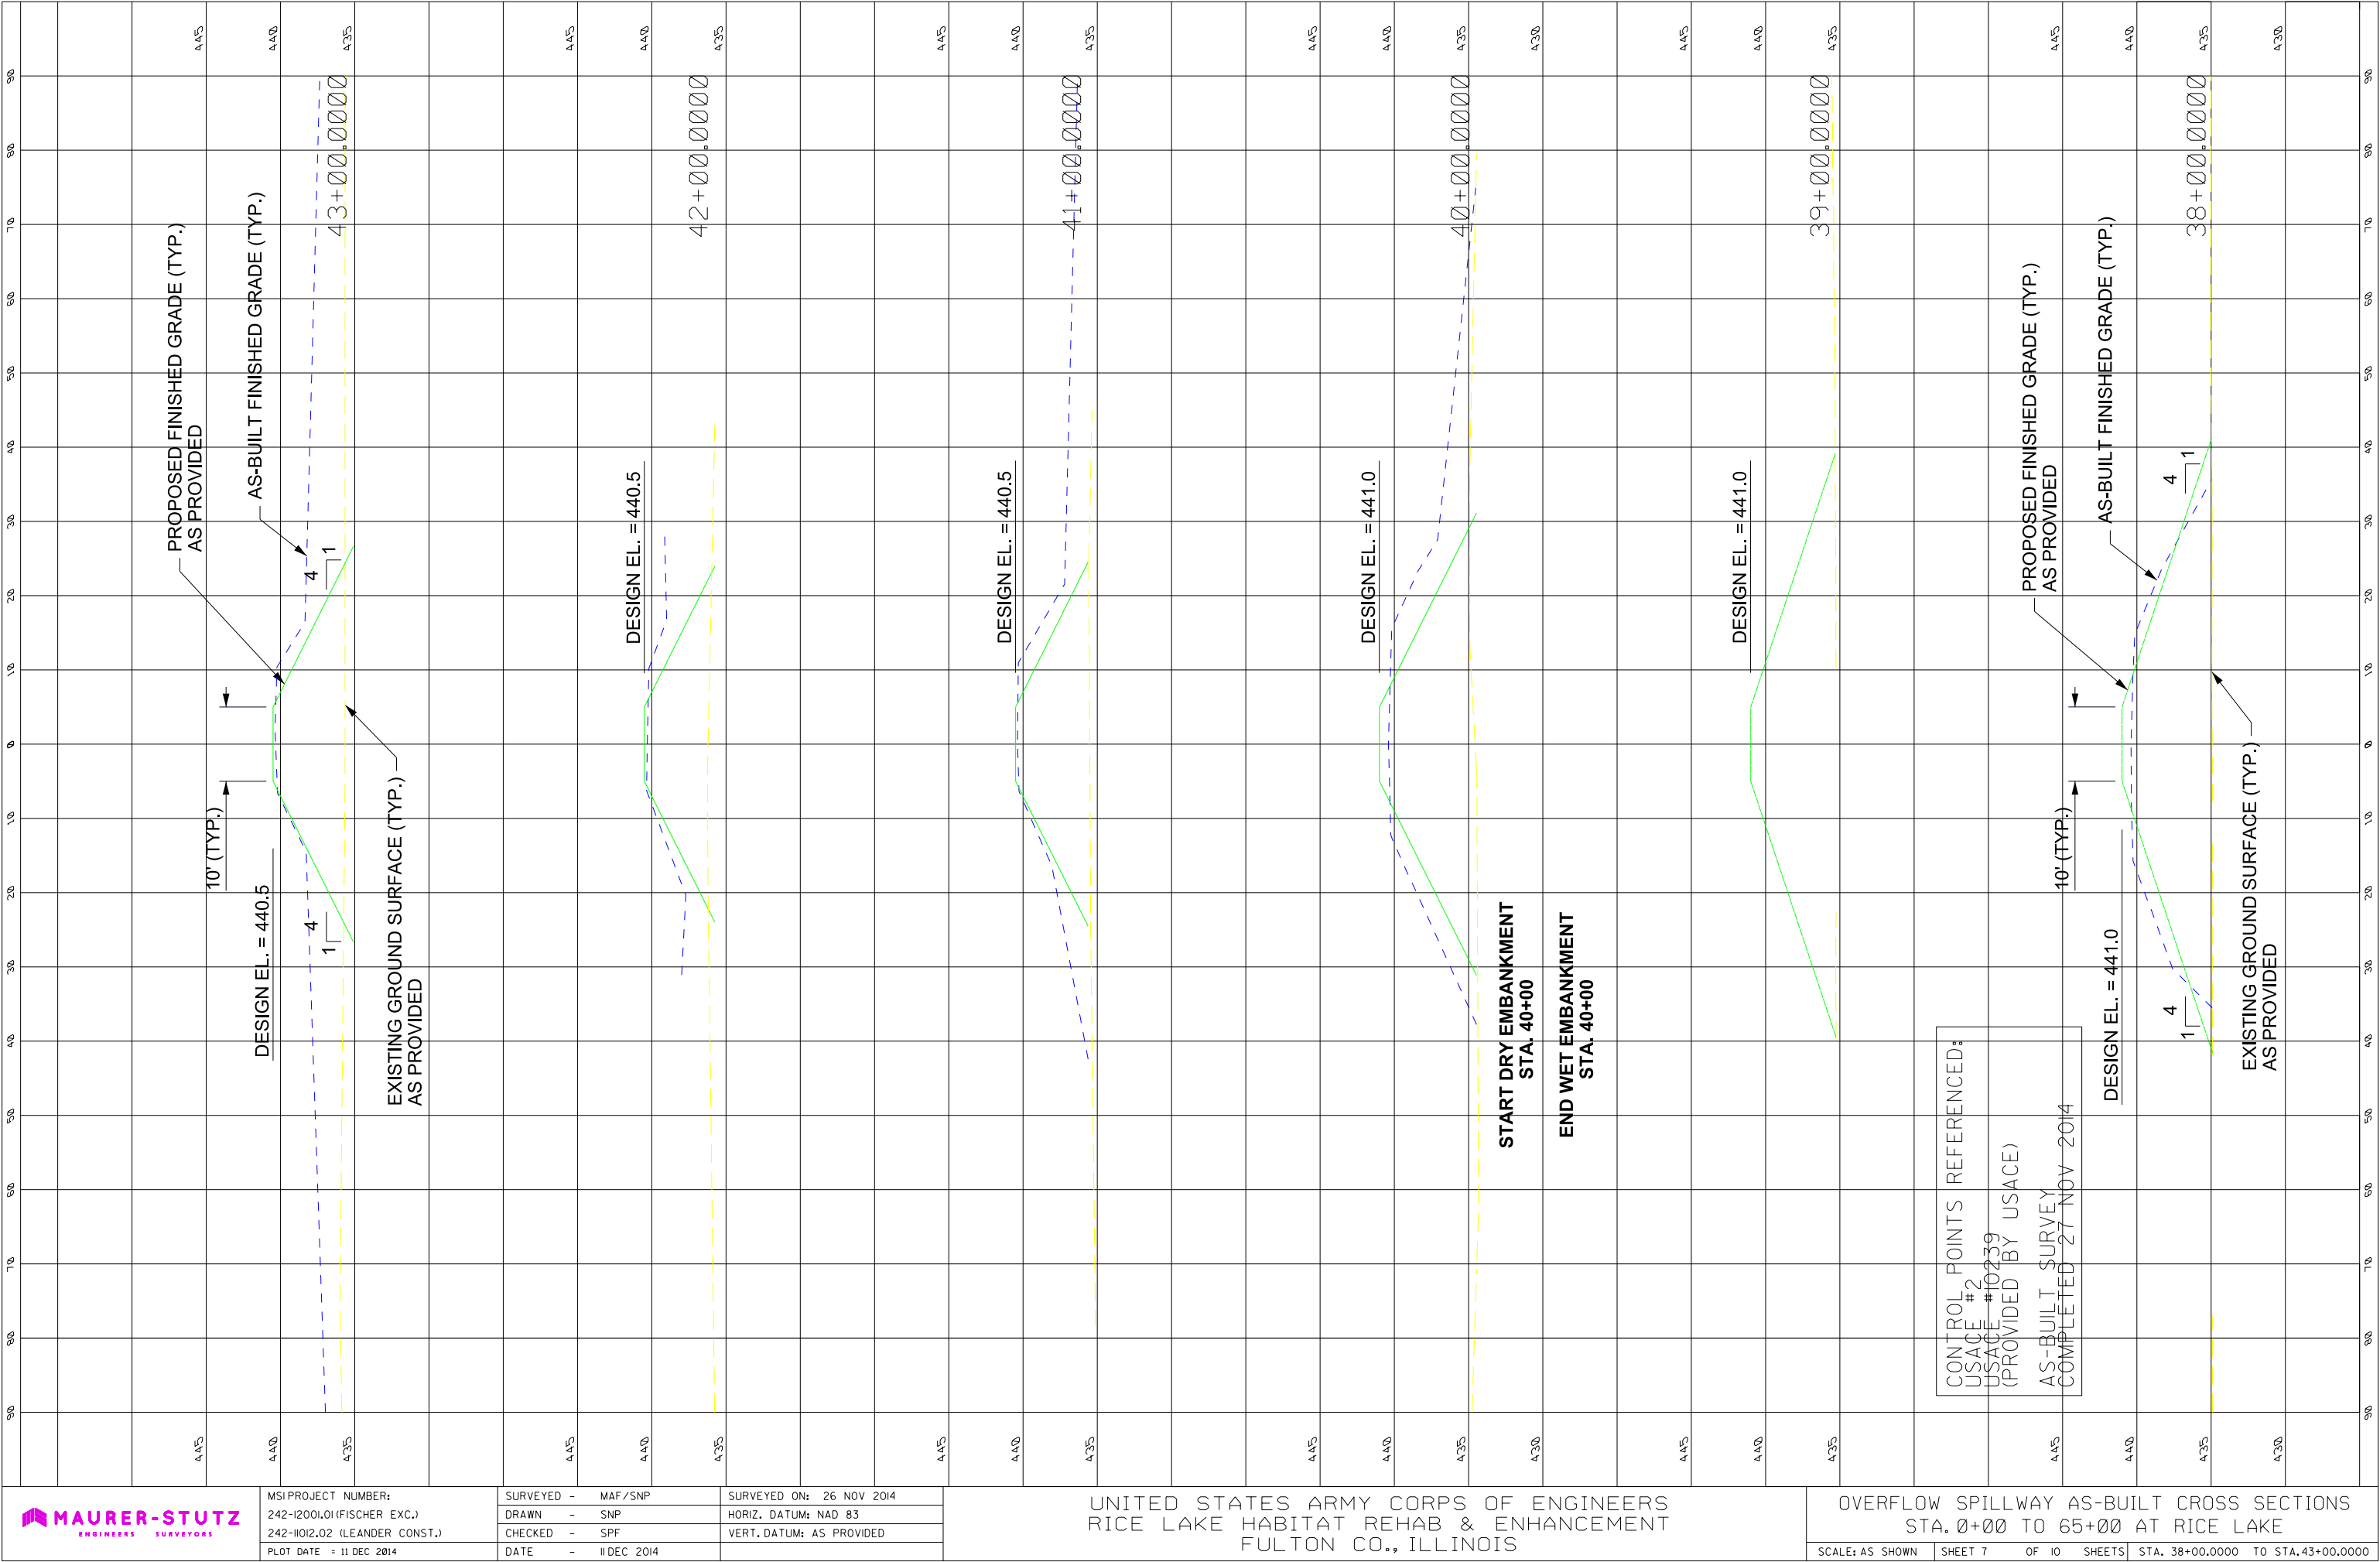

MSIPROJECT NUMBER:  
242-12001.01 (FISCHER EXC.)  
242-11012.02 (LEANDER CONST.)  
PLOT DATE = 11 DEC 2014

SURVEYED - MAF/SNP  
DRAWN - SNP  
CHECKED - SPF  
DATE - 11 DEC 2014

SURVEYED ON: 26 NOV 2014  
HORIZ. DATUM: NAD 83  
VERT. DATUM: AS PROVIDED

UNITED STATES ARMY CORPS OF ENGINEERS  
RICE LAKE HABITAT REHAB & ENHANCEMENT  
FULTON CO., ILLINOIS

OVERFLOW SPILLWAY AS-BUILT CROSS SECTIONS  
STA. 0+00 TO 65+00 AT RICE LAKE

SCALE: AS SHOWN | SHEET 7 OF 10 SHEETS | STA. 38+00.0000 TO STA. 43+00.0000







FINAL SURVEY NO.	SURVEYED PLOTTED NOTE BOOK AREAS CHECKED	BY	DATE

ORIGINAL SURVEY NO.	SURVEYED PLOTTED NOTE BOOK AREAS CHECKED	BY	DATE




MSIPROJECT NUMBER:  
242-12001.01 (FISCHER EXC.)  
242-11012.02 (LEANDER CONST.)  
PLOT DATE = 11 DEC 2014

SURVEYED - MAF /SNP  
DRAWN - SNP  
CHECKED - SPF  
DATE - 11 DEC 2014




SURVEYED ON: 26 NOV 2014  
HORIZ. DATUM: NAD 83  
VERT. DATUM: AS PROVIDED

UNITED STATES ARMY CORPS OF ENGINEERS  
RICE LAKE HABITAT REHAB & ENHANCEMENT  
FULTON CO., ILLINOIS

OVERFLOW SPILLWAY AS-BUILT CROSS SECTIONS  
STA. 0+00 TO 65+00 AT RICE LAKE  
SCALE: AS SHOWN | SHEET 10 OF 10 SHEETS | STA. 59+00.0000 TO STA. 65+00.0000

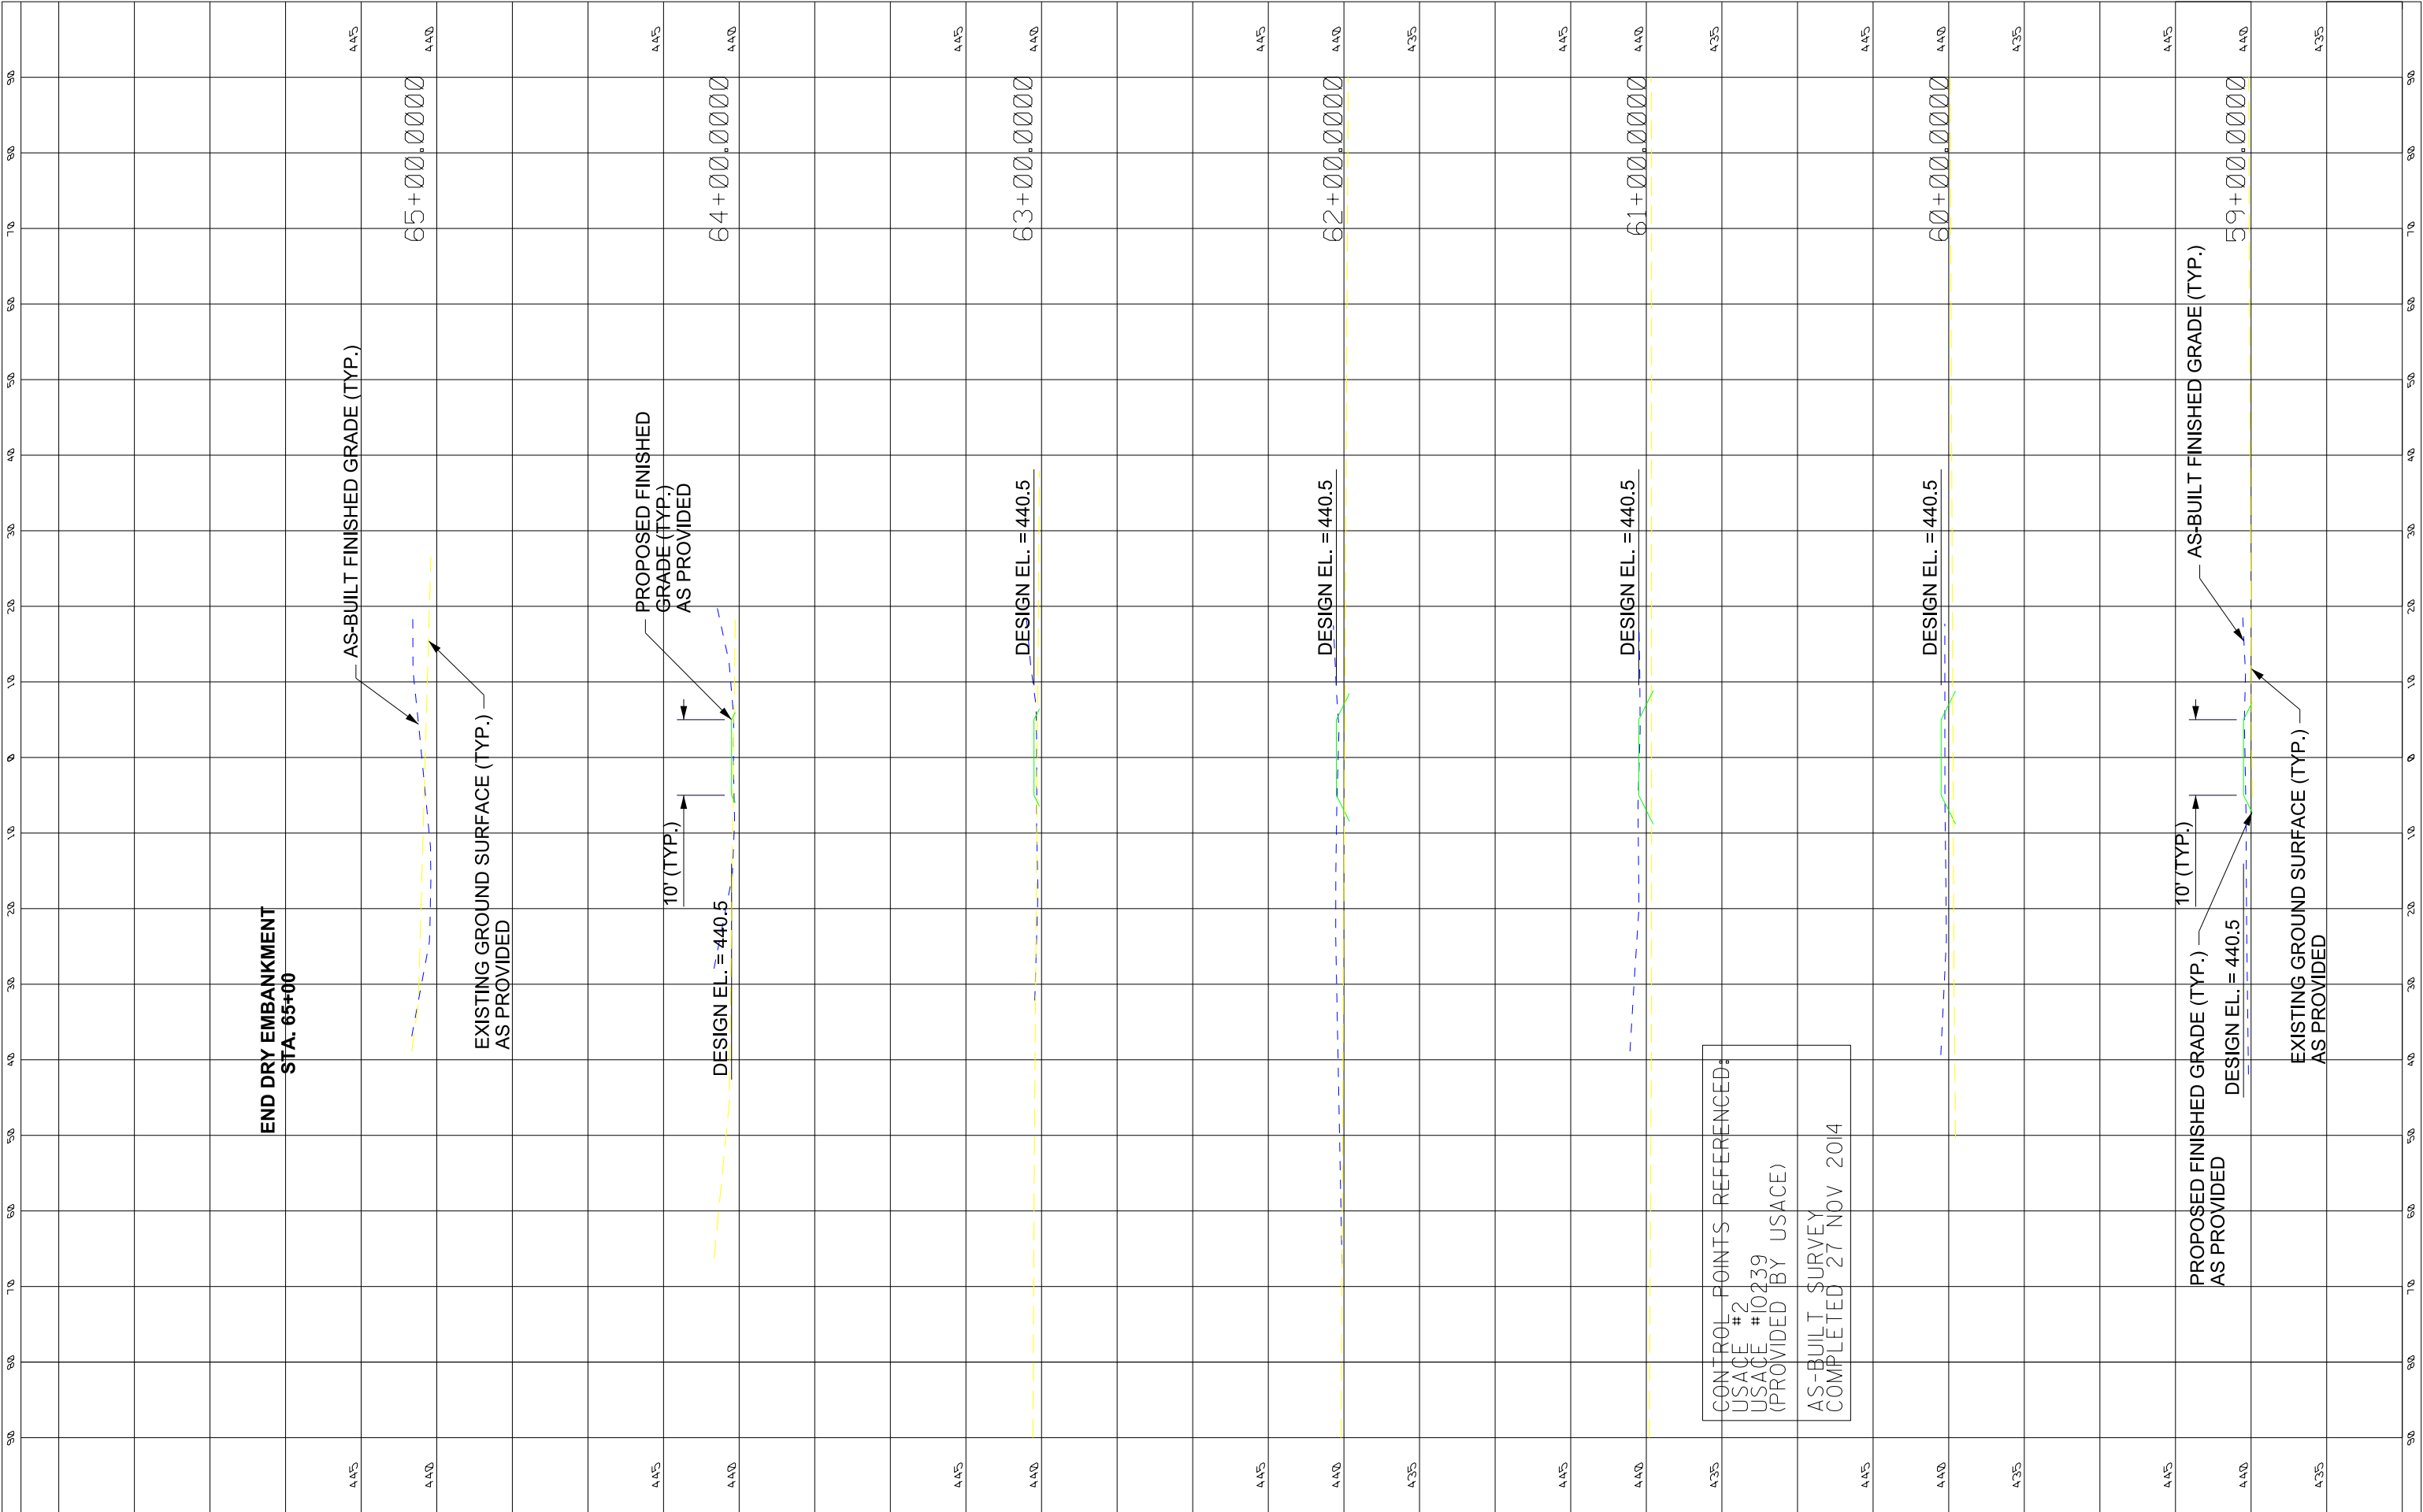



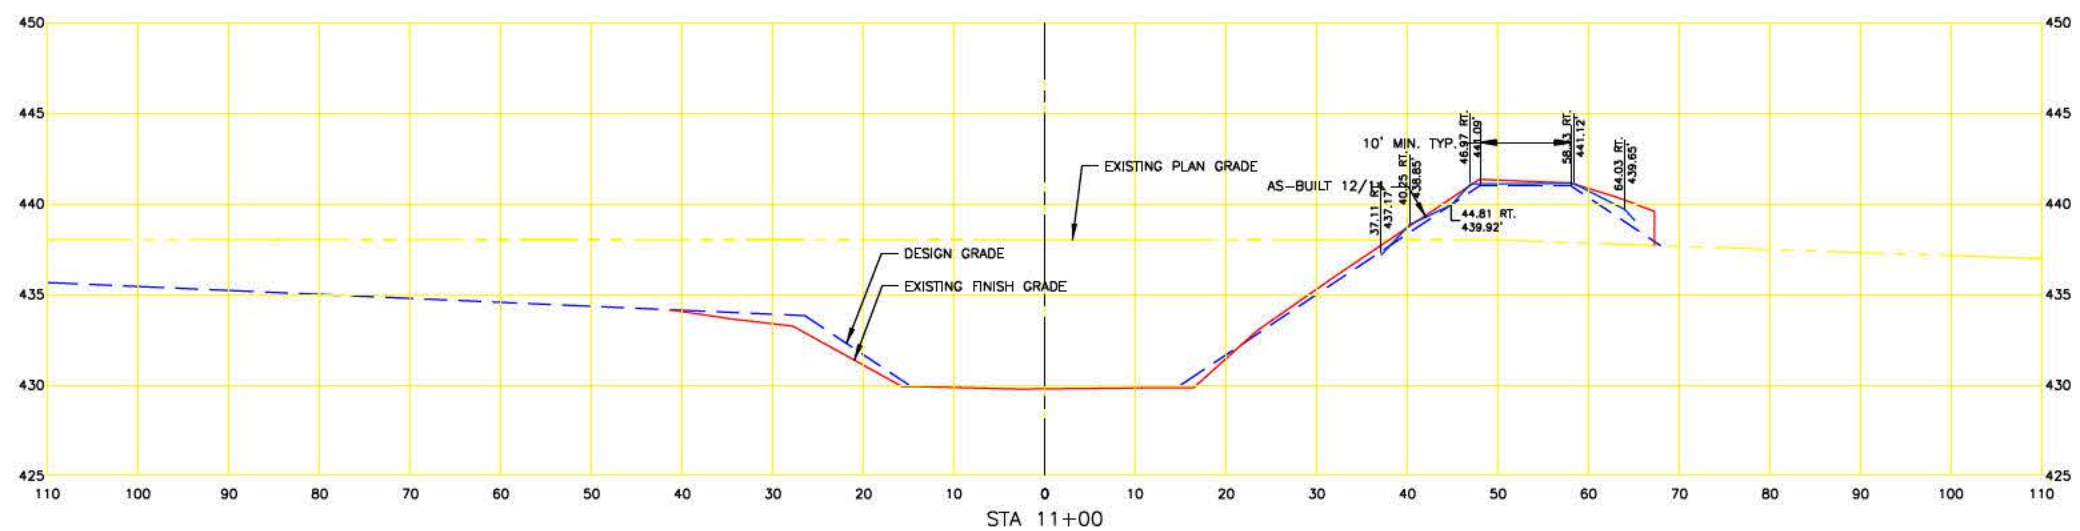
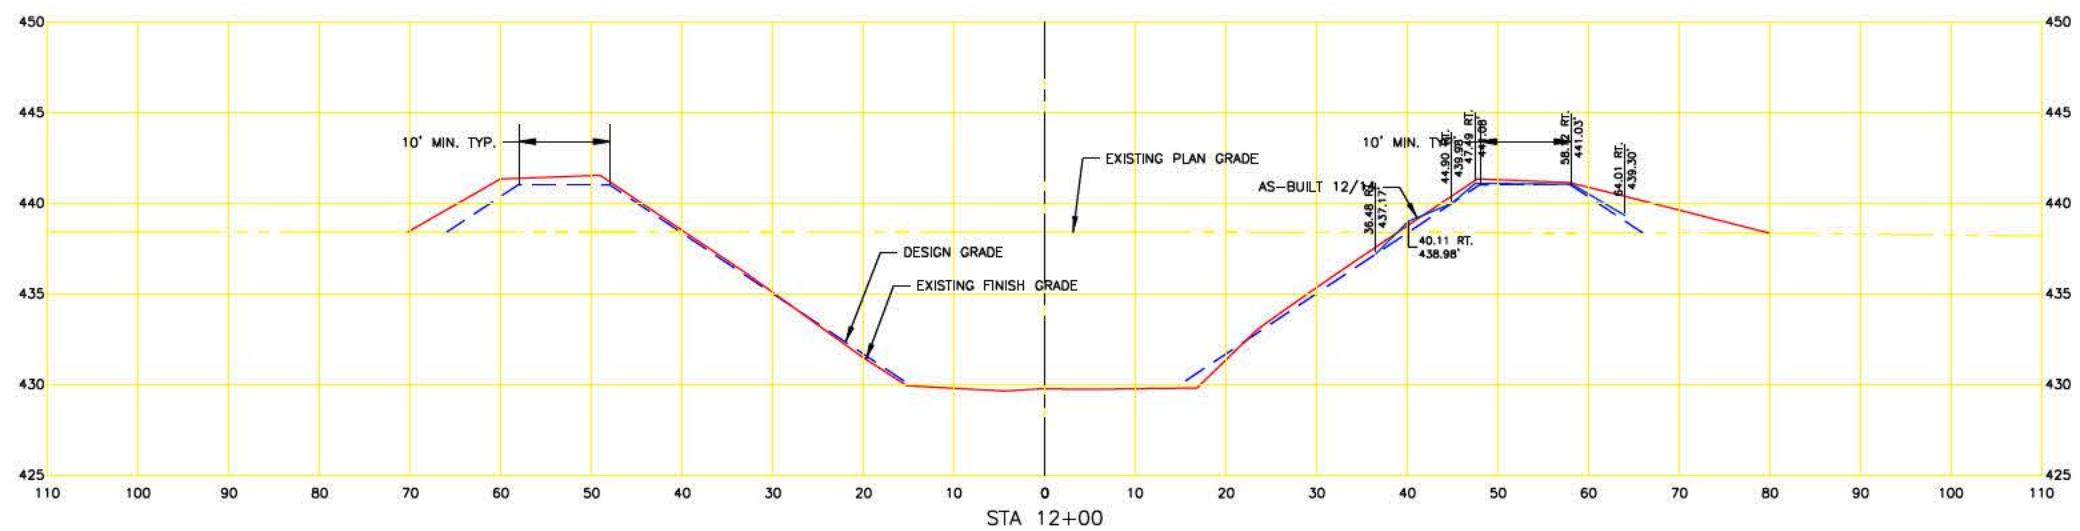
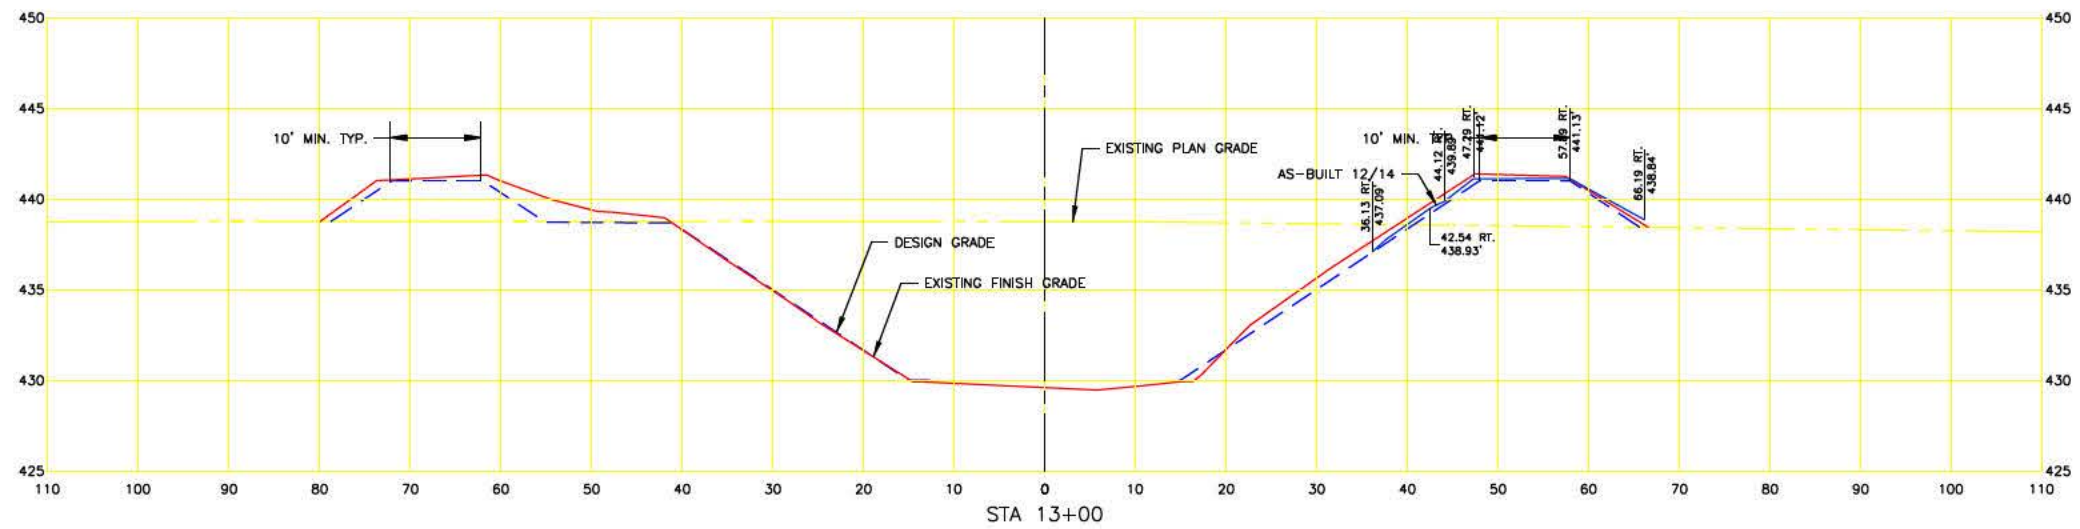


SURVEY DATA REFERENCES GEIOD 09.

CONTROL POINTS REFERENCED FOR THIS SURVEY:

CP 1, CP 2, CP 20 AND CP 21  
(AS SUPPLIED BY FISCHER EXCAVATING)



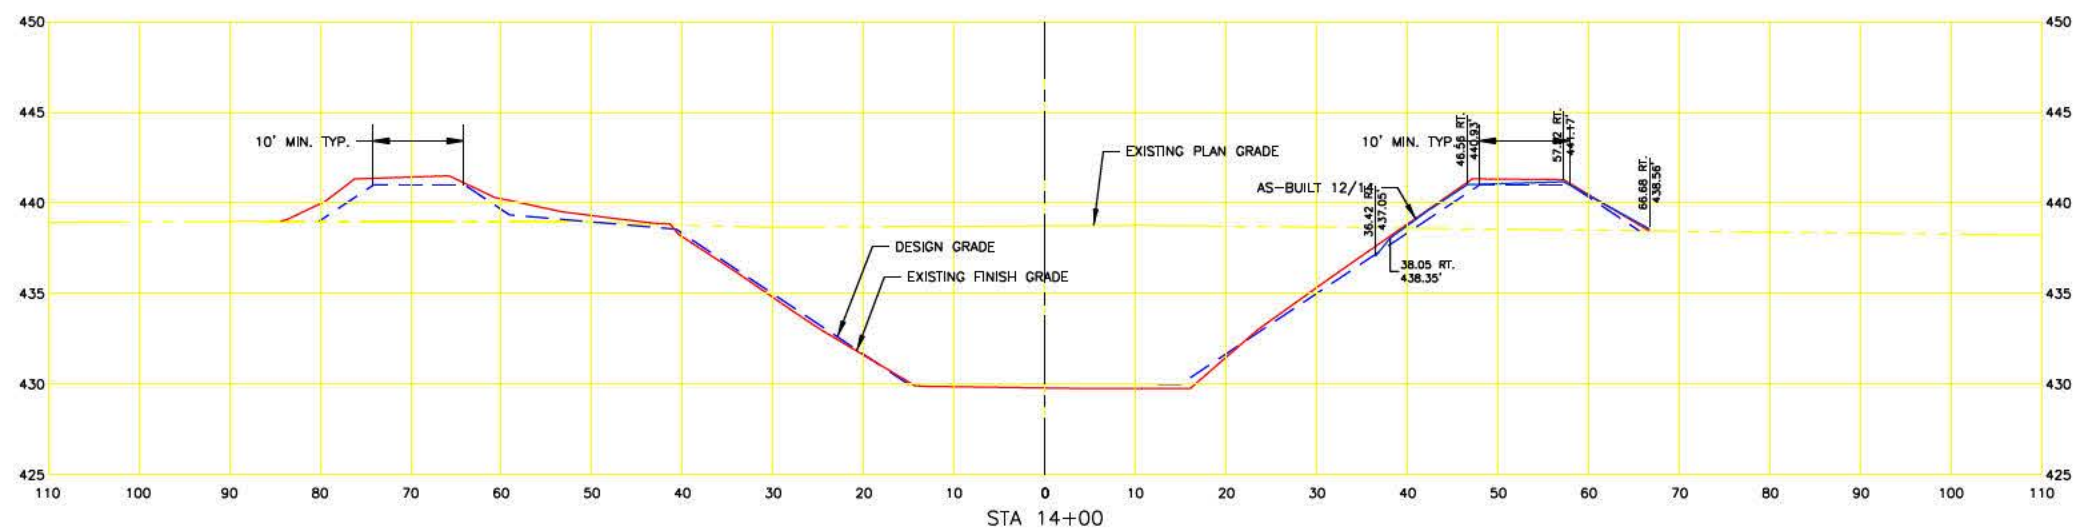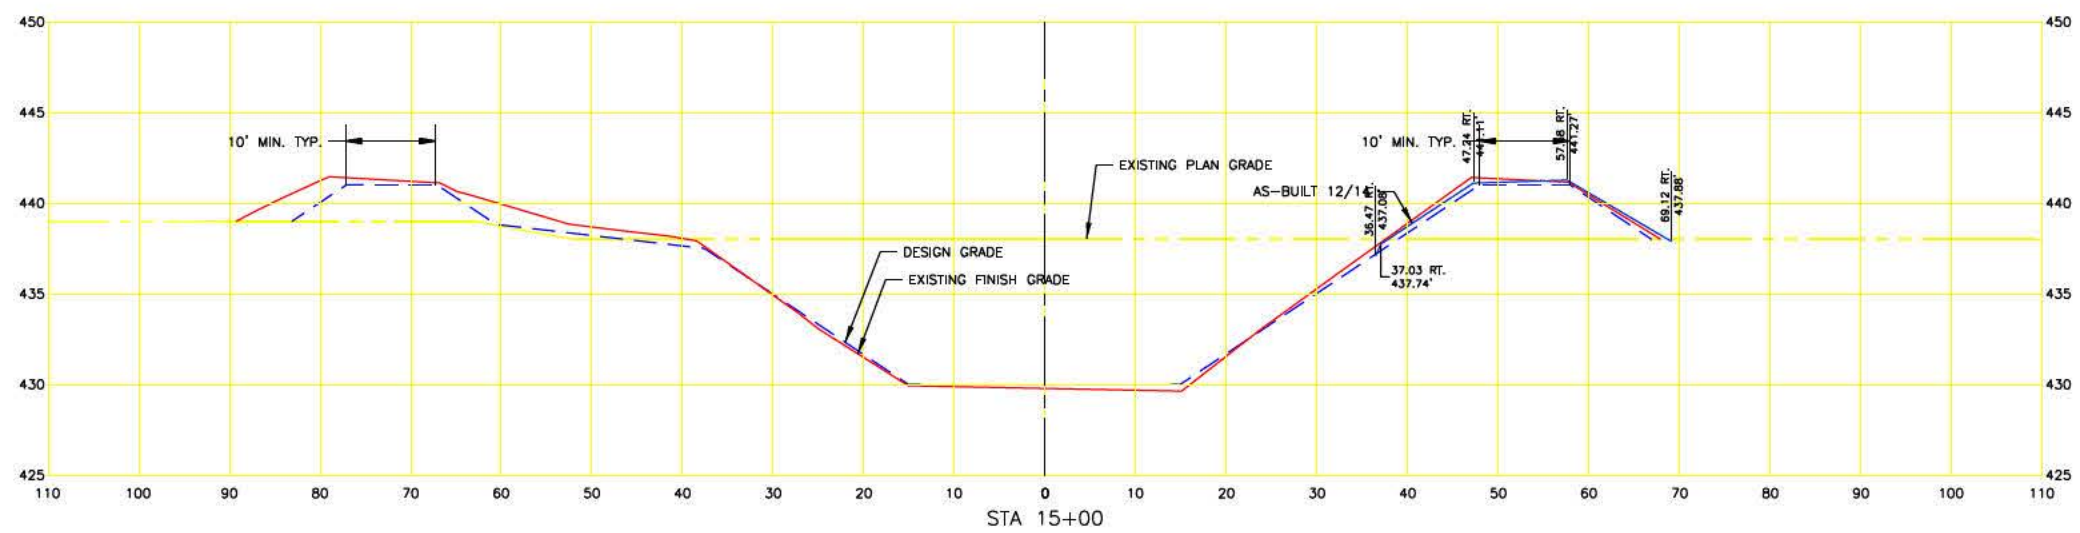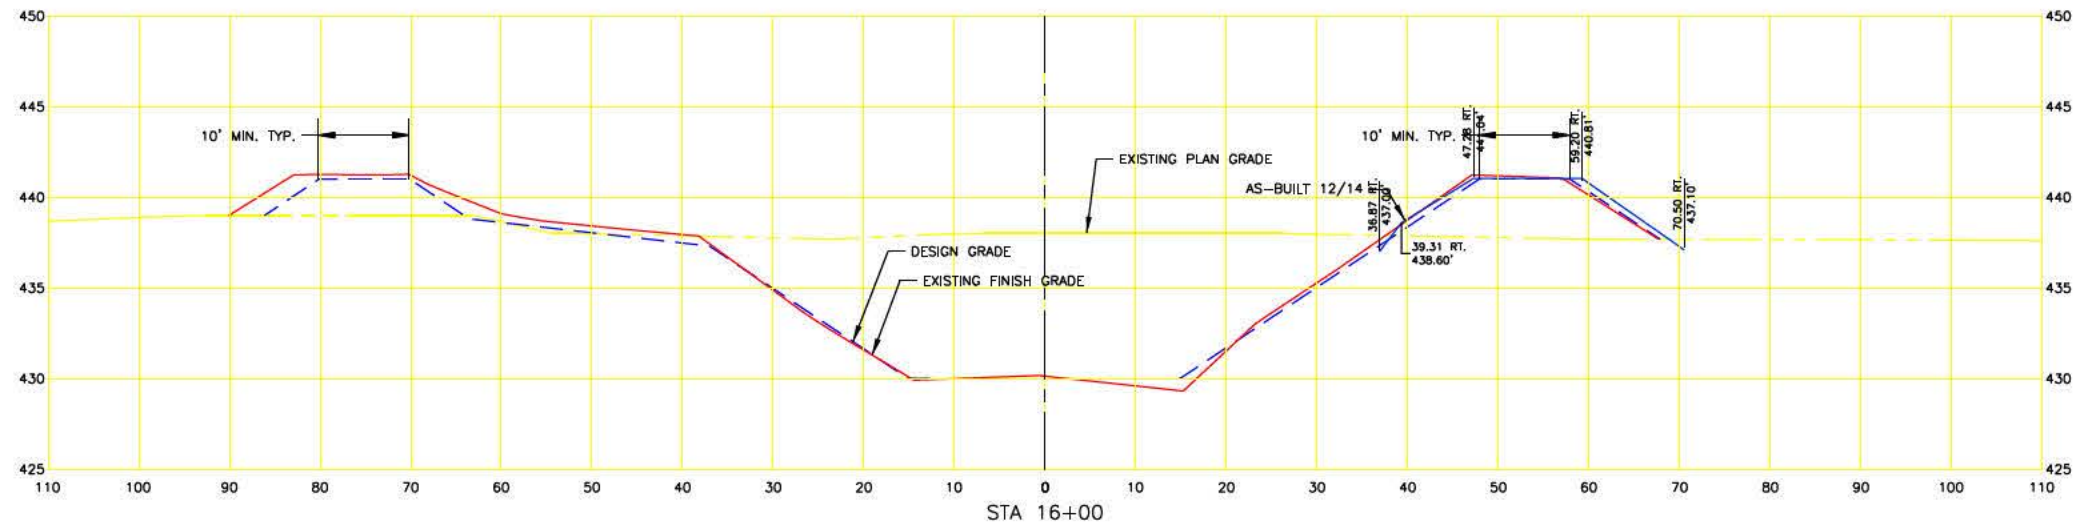


SURVEY DATA REFERENCES GEOD 09.

CONTROL POINTS REFERENCED FOR THIS SURVEY:

CP 1, CP 2, CP 20 AND CP 21

(AS SUPPLIED BY FISCHER EXCAVATING)

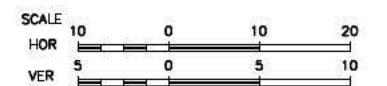

**FEHR GRAHAM**

ENGINEERING & ENVIRONMENTAL

ILLINOIS DESIGN FIRM NO. 184-003525

ILLINOIS

IOWA

WISCONSIN

OWNER/DEVELOPER:

FISCHER EXCAVATING

1567 HEINE ROAD

FREEPORT, IL 61032

PROJECT AND LOCATION:

RICE LAKE

DISCHARGE CHANNEL

FINAL CROSS SECTIONS

DRAWN BY: JJS

APPROVED BY: NAG

DATE: 1/20/15

SCALE: 1" = 10'

1" = 5'

REV. NO.	DESCRIPTION	DATE

DRAWING:

SECTION SHEET - (2)

JOB NUMBER:

14-1066




SHEET NUMBER:

2 of 20


PLOT DATE: 1/20/15

© 2015 FEHR GRAHAM



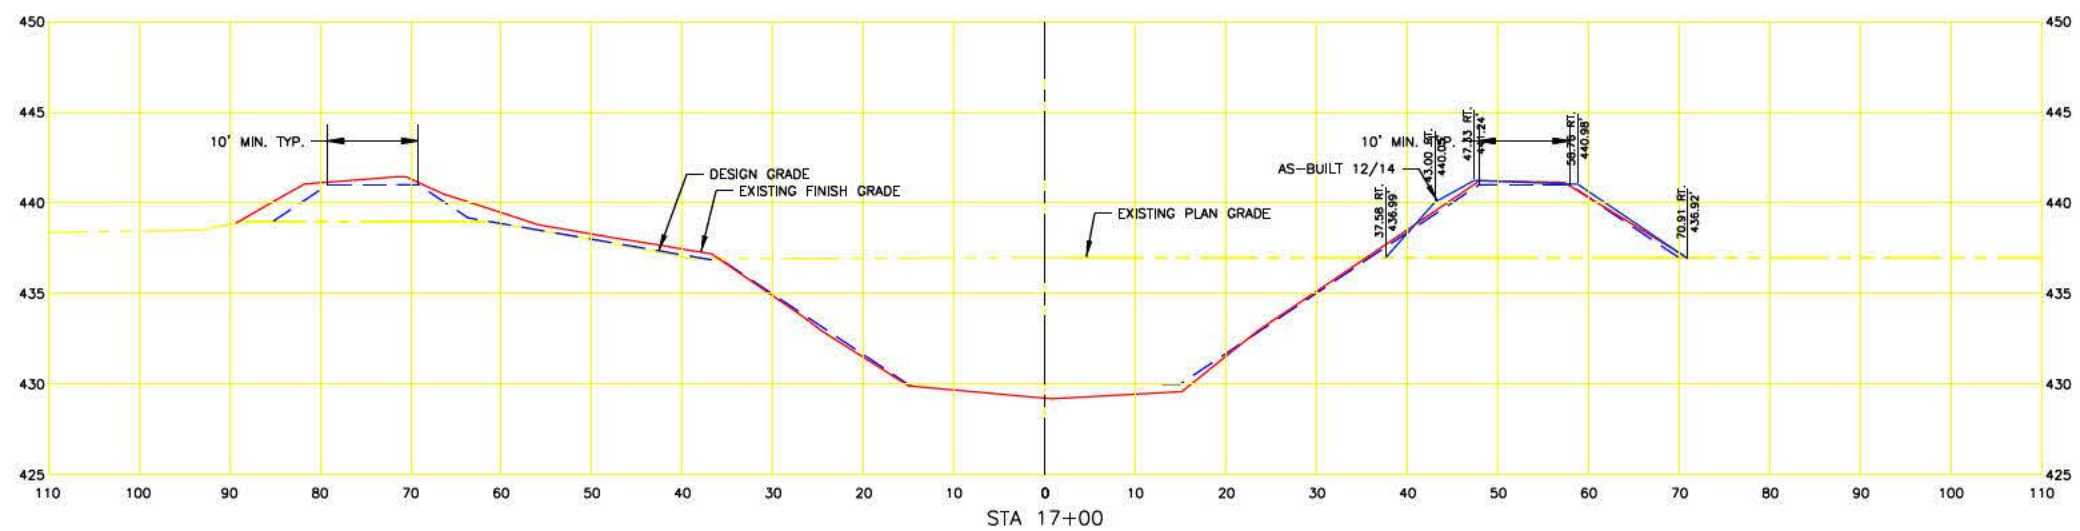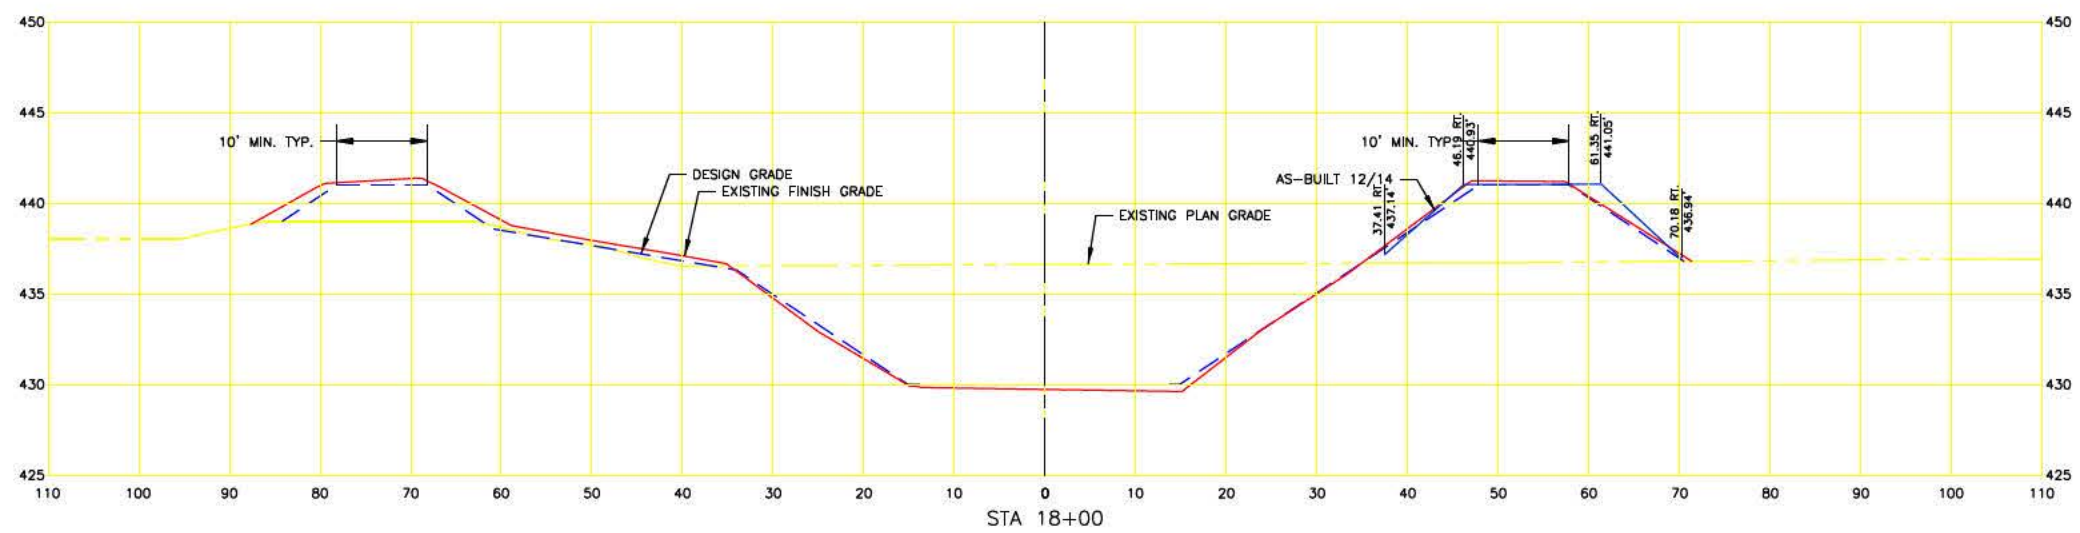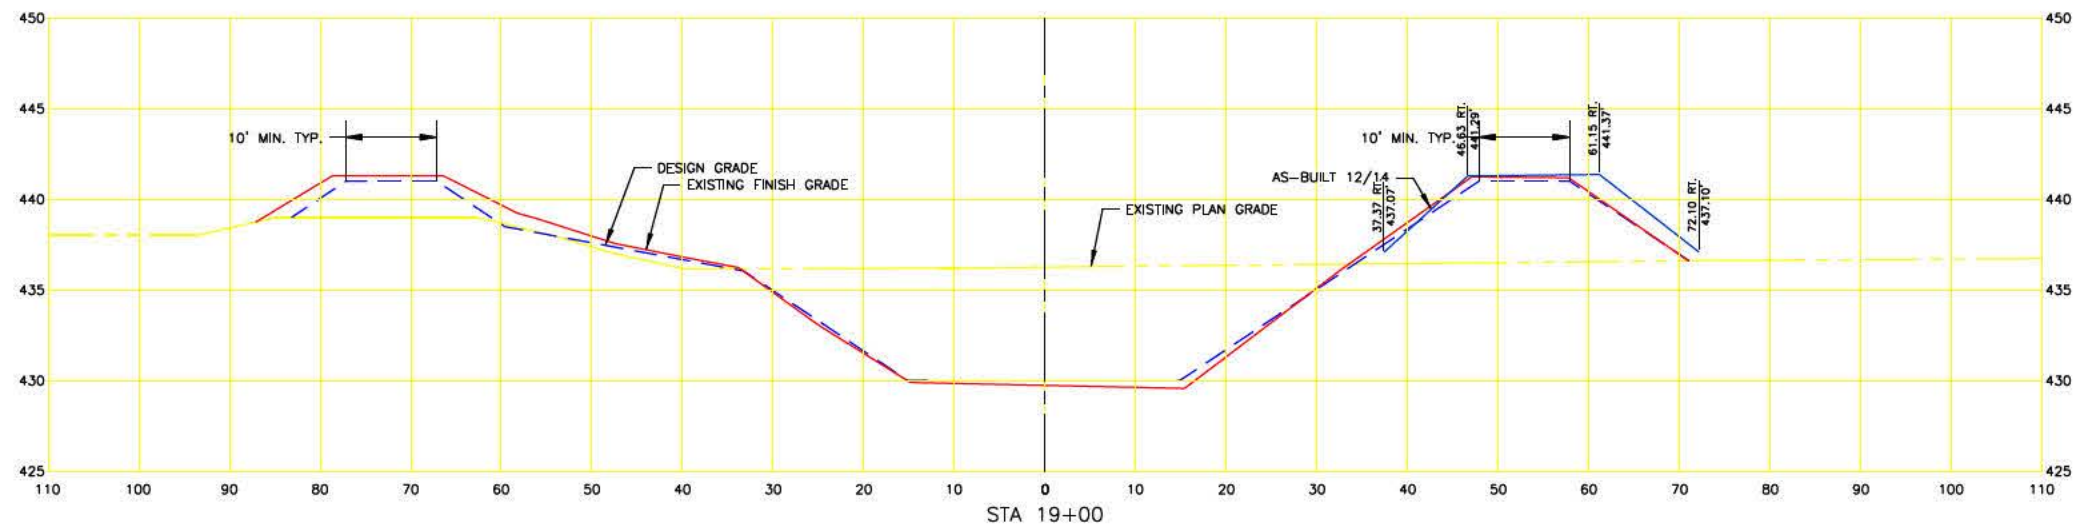

SURVEY DATA REFERENCES GEOD 09.  
CONTROL POINTS REFERENCED FOR THIS SURVEY:  
CP 1, CP 2, CP 20 AND CP 21  
(AS SUPPLIED BY FISCHER EXCAVATING)

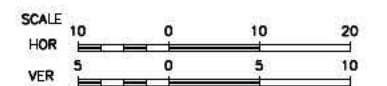

**FEHR GRAHAM**  
ENGINEERING & ENVIRONMENTAL  
ILLINOIS DESIGN FIRM NO. 184-003525

ILLINOIS  
IOWA  
WISCONSIN

OWNER/DEVELOPER:  
FISCHER EXCAVATING  
1567 HEINE ROAD  
FREEPORT, IL 61032

PROJECT AND LOCATION:  
RICE LAKE  
DISCHARGE CHANNEL  
FINAL CROSS SECTIONS

DRAWN BY: JJS  
APPROVED BY: NAG  
DATE: 1/20/15  
SCALE: 1" = 10'  
1" = 5'




REVISIONS		
REV. NO.	DESCRIPTION	DATE

DRAWING:  
SECTION SHEET - (3)


JOB NUMBER:  
14-1066

SHEET NUMBER:  
3 of 20

C:\Fischer Excavating, Inc\14-1066\Surf\14-1066 Survey - DGN\fig. Section Sheet - (3)

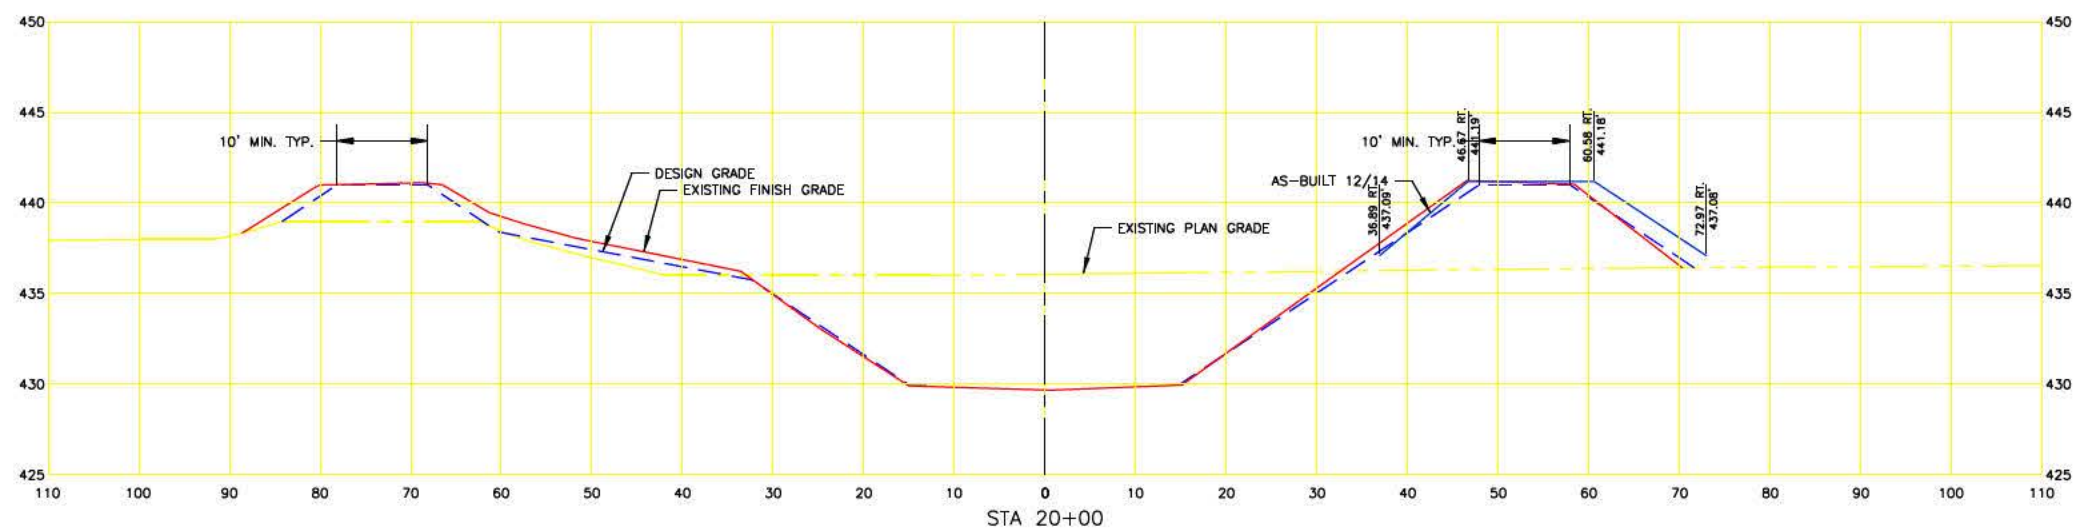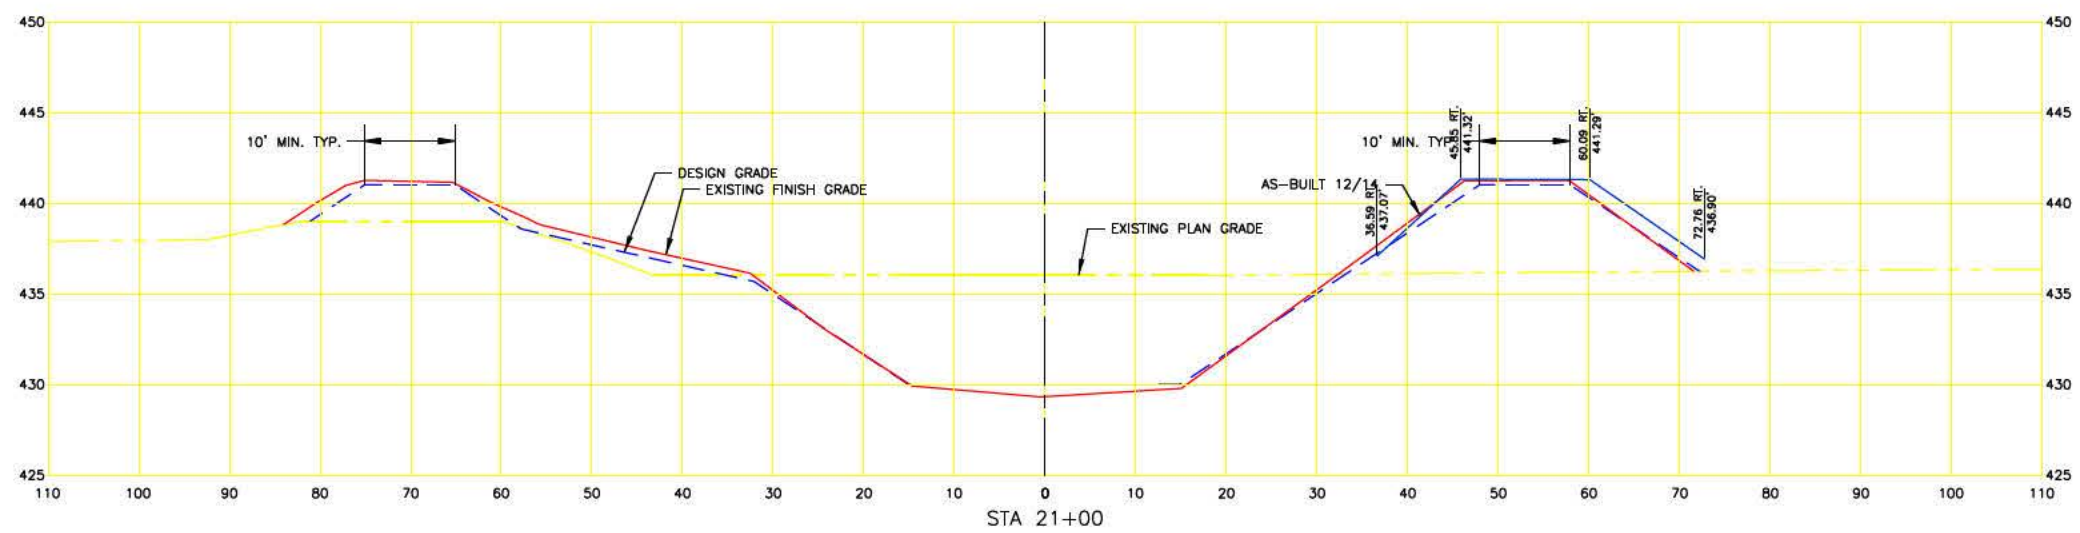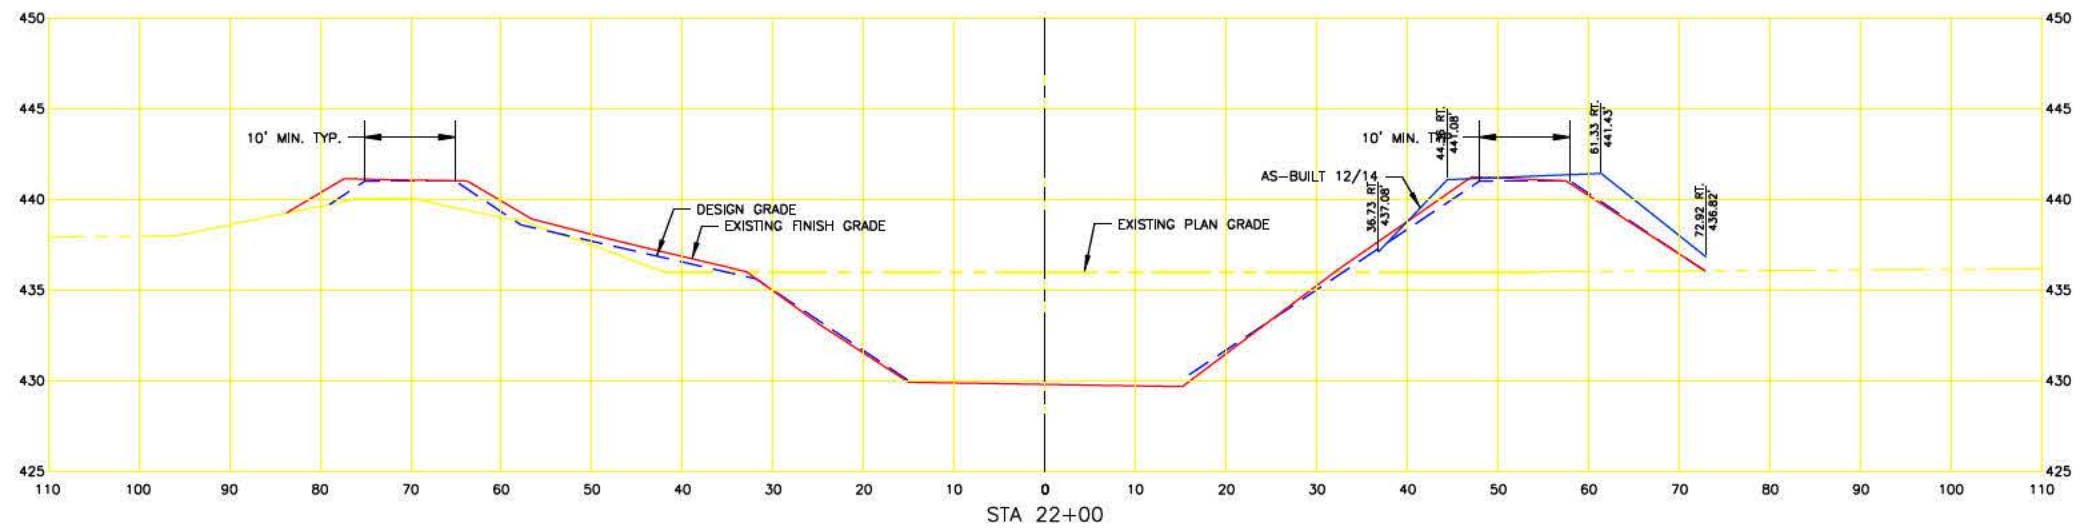

SURVEY DATA REFERENCES GEOD 09.  
CONTROL POINTS REFERENCED FOR THIS SURVEY:  
CP 1, CP 2, CP 20 AND CP 21  
(AS SUPPLIED BY FISCHER EXCAVATING)

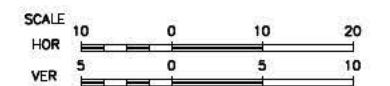

**FEHR GRAHAM**  
ENGINEERING & ENVIRONMENTAL  
ILLINOIS DESIGN FIRM NO. 184-003525

ILLINOIS  
IOWA  
WISCONSIN

OWNER/DEVELOPER:  
FISCHER EXCAVATING  
1567 HEINE ROAD  
FREEPORT, IL 61032

PROJECT AND LOCATION:  
RICE LAKE  
DISCHARGE CHANNEL  
FINAL CROSS SECTIONS

DRAWN BY: JJS  
APPROVED BY: NAG  
DATE: 1/20/15  
SCALE: 1" = 10'  
1" = 5'




REVISIONS		
REV. NO.	DESCRIPTION	DATE

DRAWING:  
SECTION SHEET - (4)

JOB NUMBER:  
14-1066

SHEET NUMBER:  
4 of 20



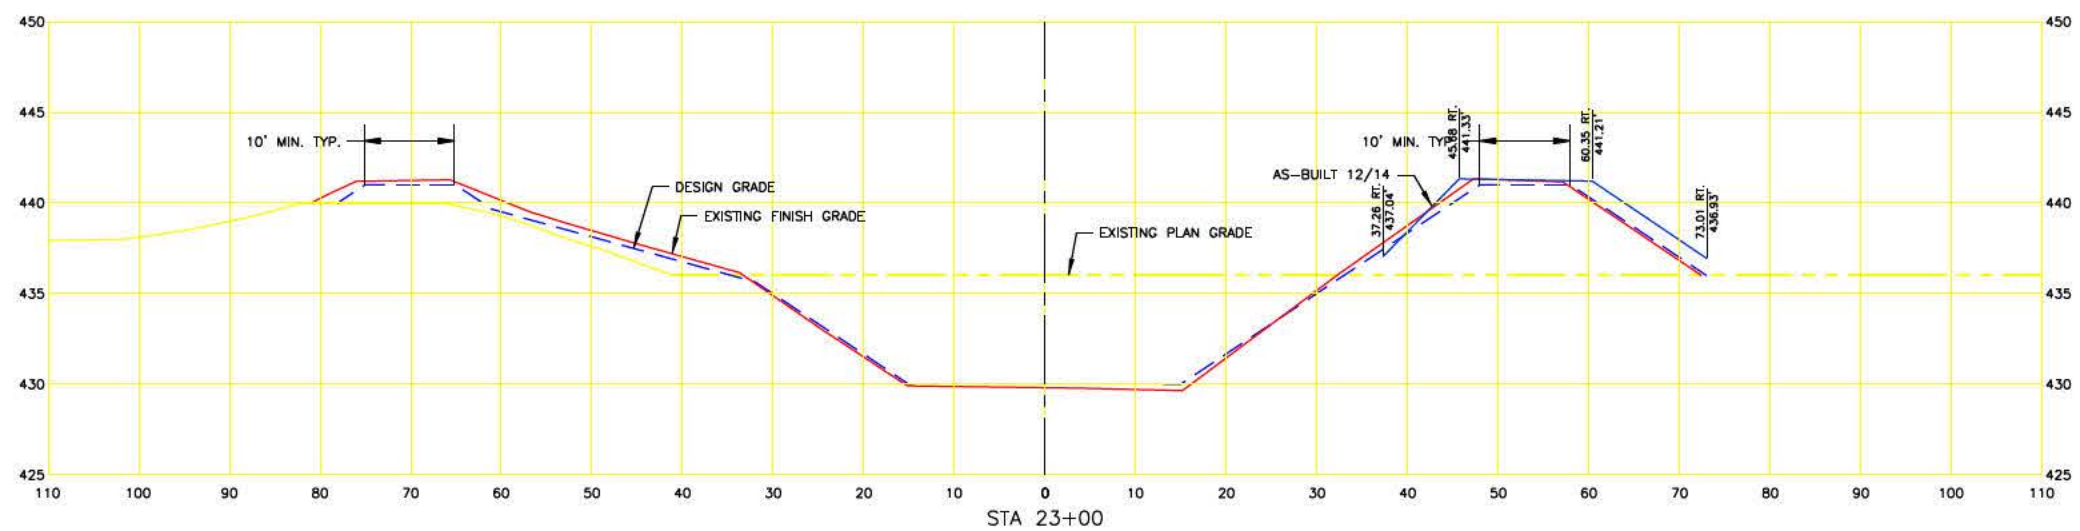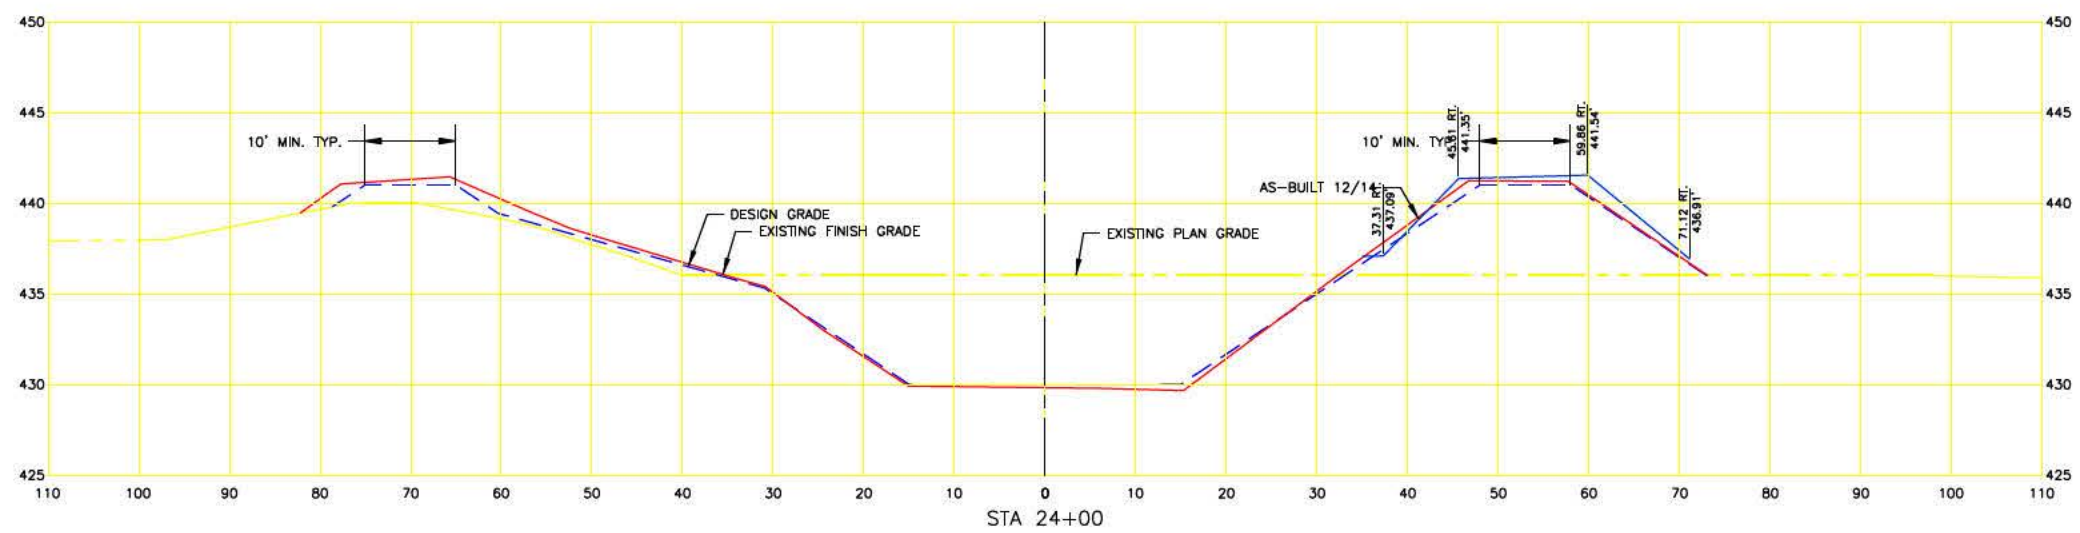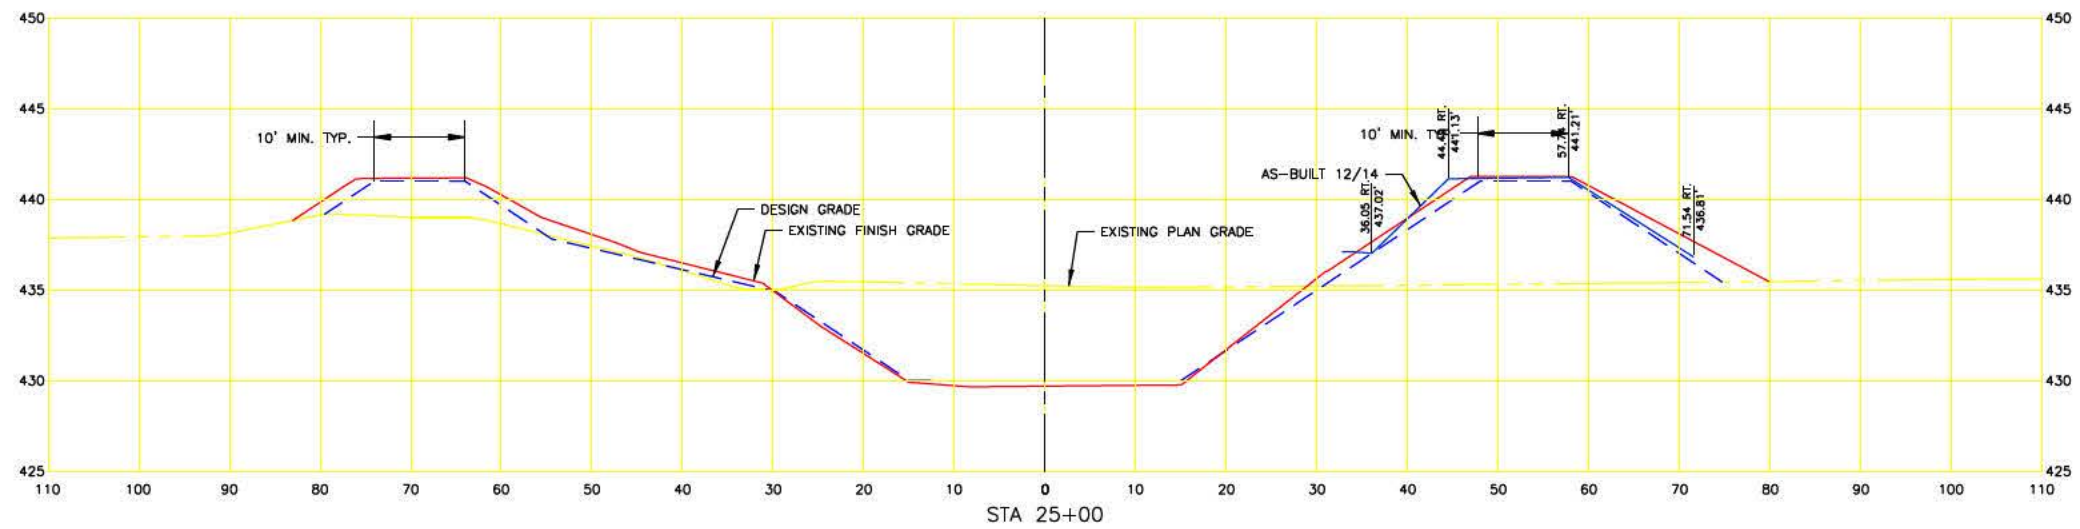


SURVEY DATA REFERENCES GEIOD 09.

CONTROL POINTS REFERENCED FOR THIS SURVEY:

CP 1, CP 2, CP 20 AND CP 21

(AS SUPPLIED BY FISCHER EXCAVATING)

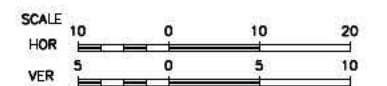

**FEHR GRAHAM**

ENGINEERING & ENVIRONMENTAL

ILLINOIS DESIGN FIRM NO. 184-003525

ILLINOIS

IOWA

WISCONSIN

OWNER/DEVELOPER:

FISCHER EXCAVATING

1567 HEINE ROAD

FREEPORT, IL 61032

PROJECT AND LOCATION:

RICE LAKE

DISCHARGE CHANNEL

FINAL CROSS SECTIONS

DRAWN BY: JJS

APPROVED BY: NAG

DATE: 1/20/15

SCALE: 1" = 10'

1" = 5'

REVISIONS		
REV. NO.	DESCRIPTION	DATE

DRAWING:




SECTION SHEET - (5)

JOB NUMBER:

14-1066

SHEET NUMBER:

5 of 20

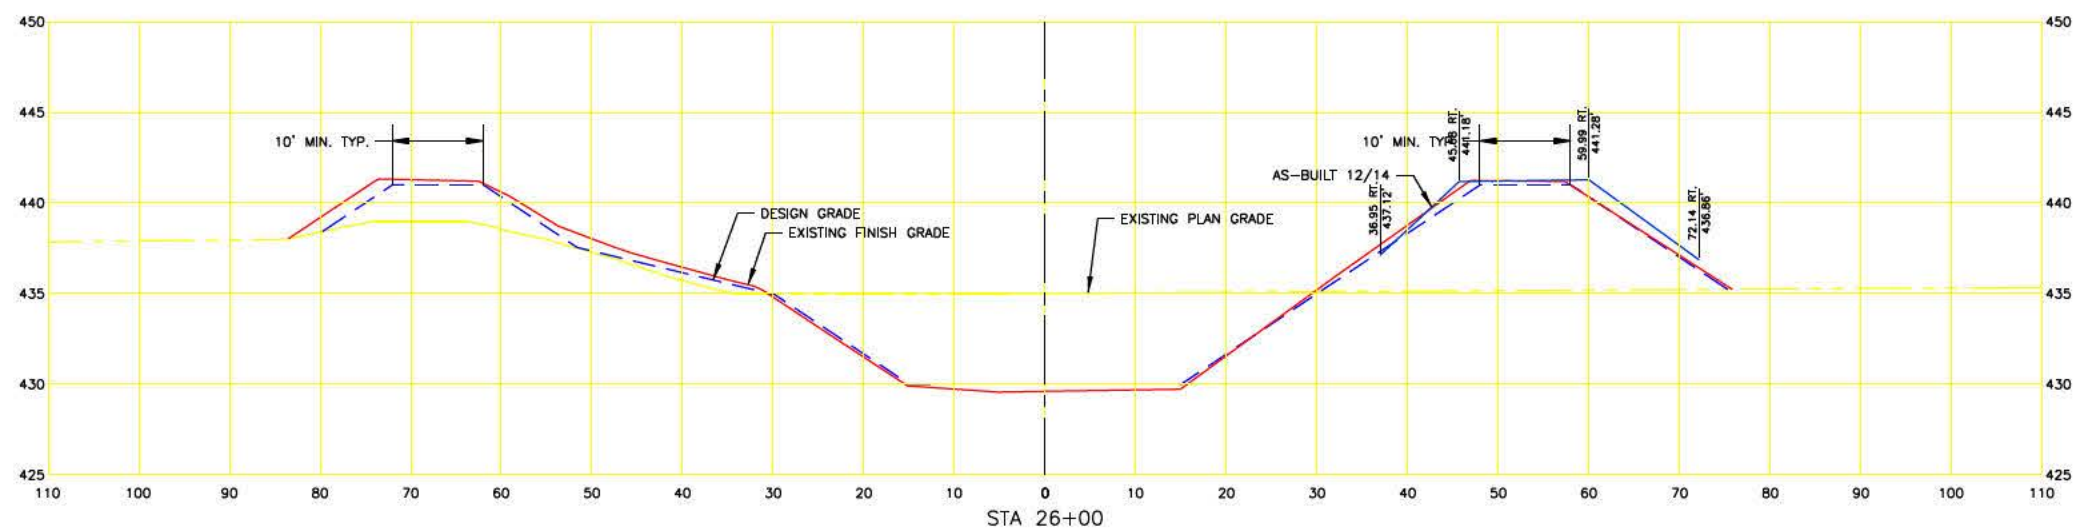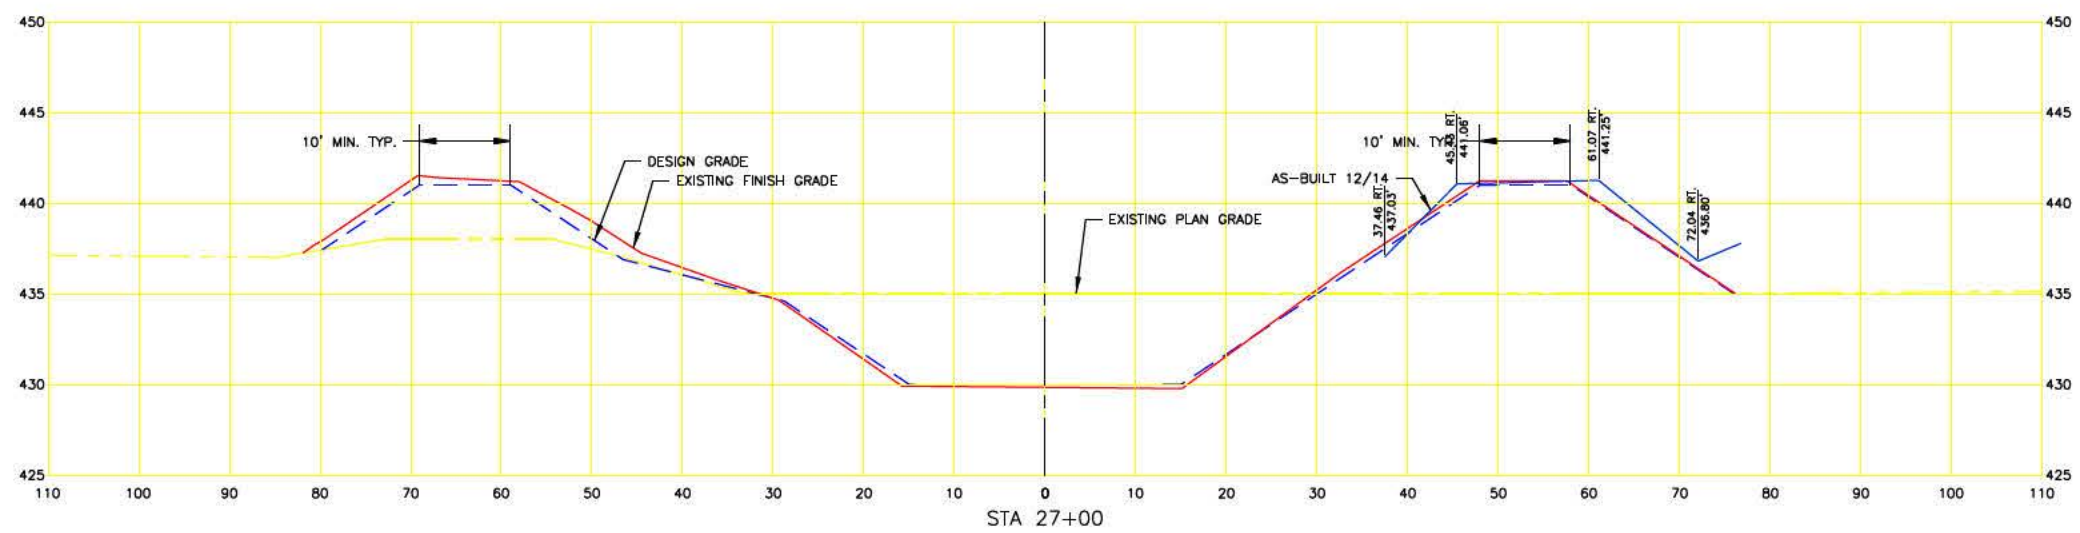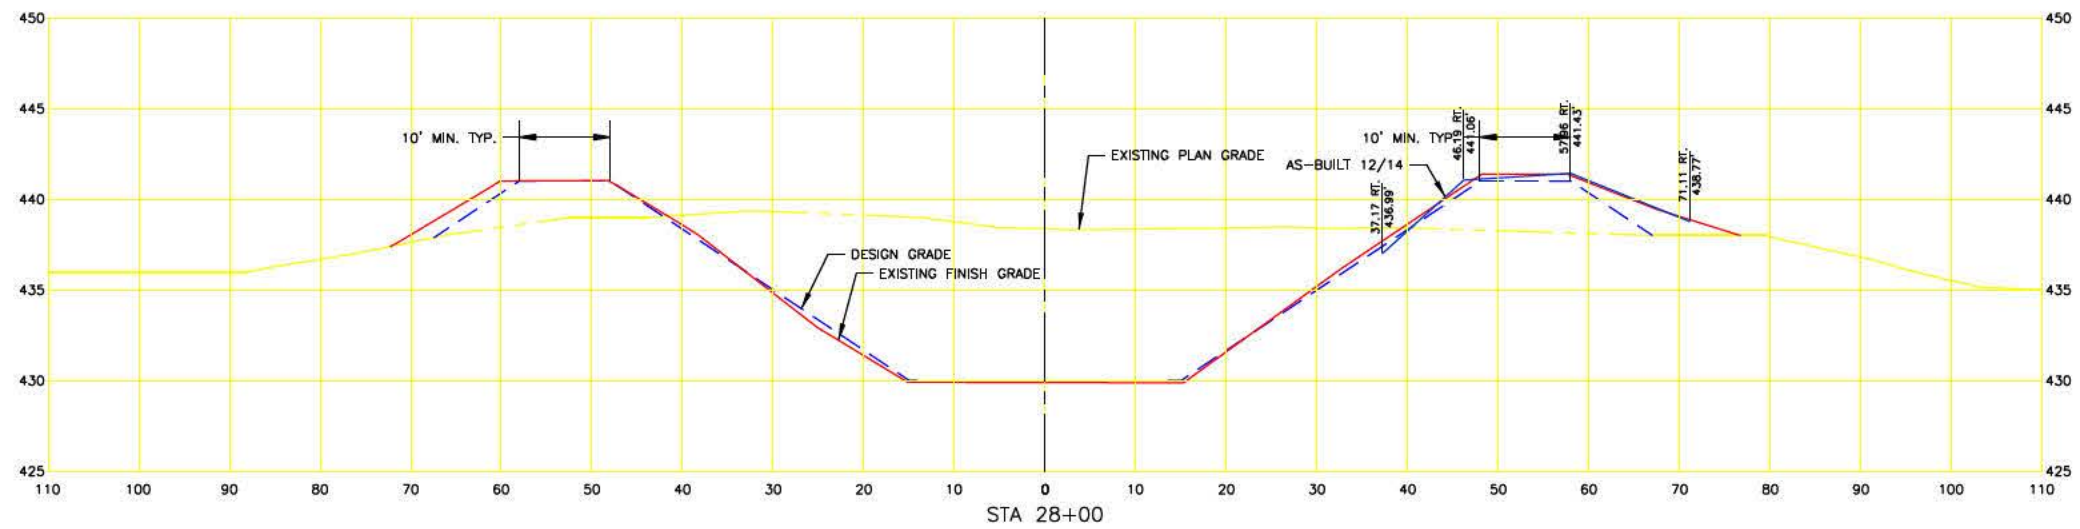


SURVEY DATA REFERENCES GEOD 09.

CONTROL POINTS REFERENCED FOR THIS SURVEY:

CP 1, CP 2, CP 20 AND CP 21

(AS SUPPLIED BY FISCHER EXCAVATING)

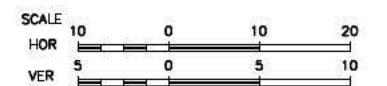

**FEHR GRAHAM**

ENGINEERING & ENVIRONMENTAL

ILLINOIS DESIGN FIRM NO. 184-003525

ILLINOIS

IOWA

WISCONSIN

OWNER/DEVELOPER:

FISCHER EXCAVATING

1567 HEINE ROAD

FREEPORT, IL 61032

PROJECT AND LOCATION:

RICE LAKE

DISCHARGE CHANNEL

FINAL CROSS SECTIONS

DRAWN BY: JJS

APPROVED BY: NAG

DATE: 1/20/15

SCALE: 1" = 10'

1" = 5'

REVISIONS		
REV. NO.	DESCRIPTION	DATE

DRAWING:

SECTION SHEET - (6)

JOB NUMBER:

14-1066




SHEET NUMBER:

6 of 20

PLOT DATE: 1/20/15

© 2015 FEHR GRAHAM



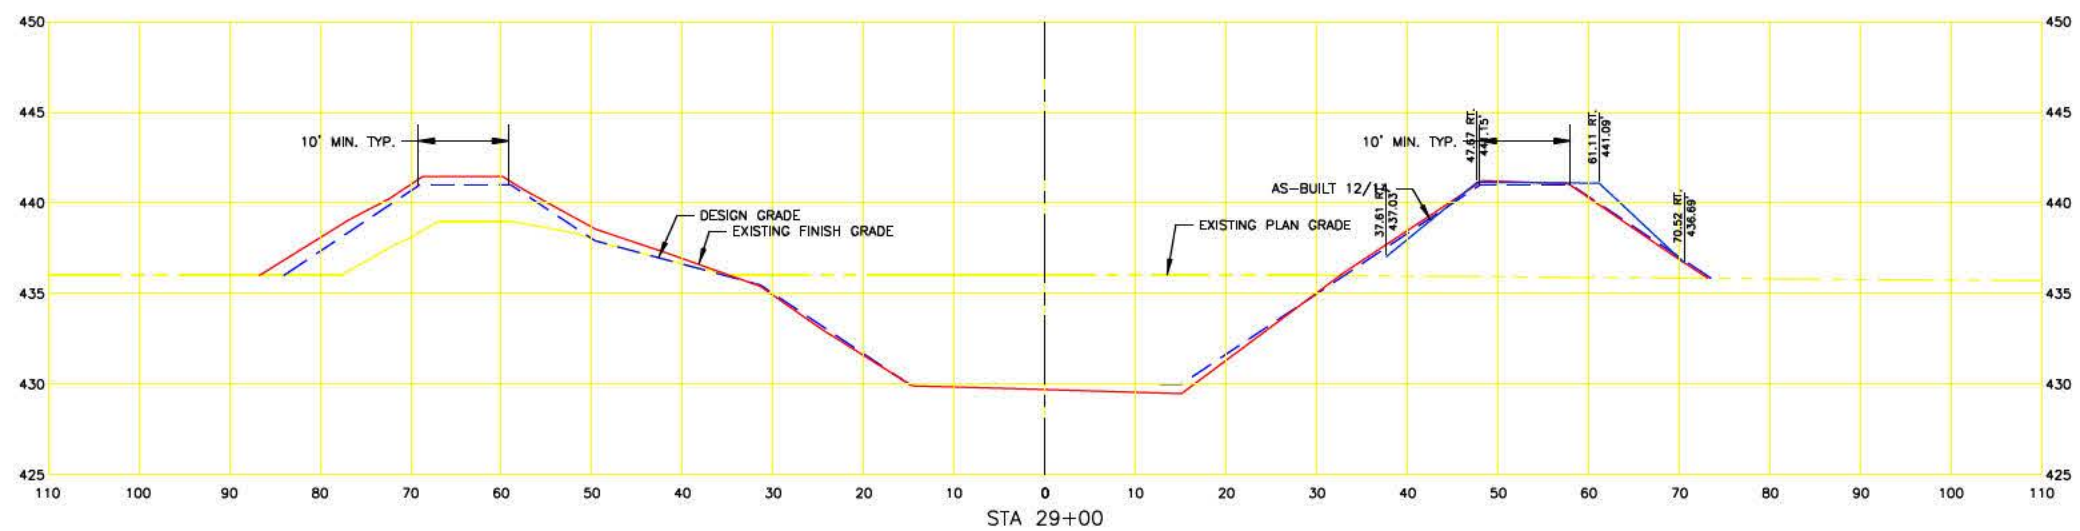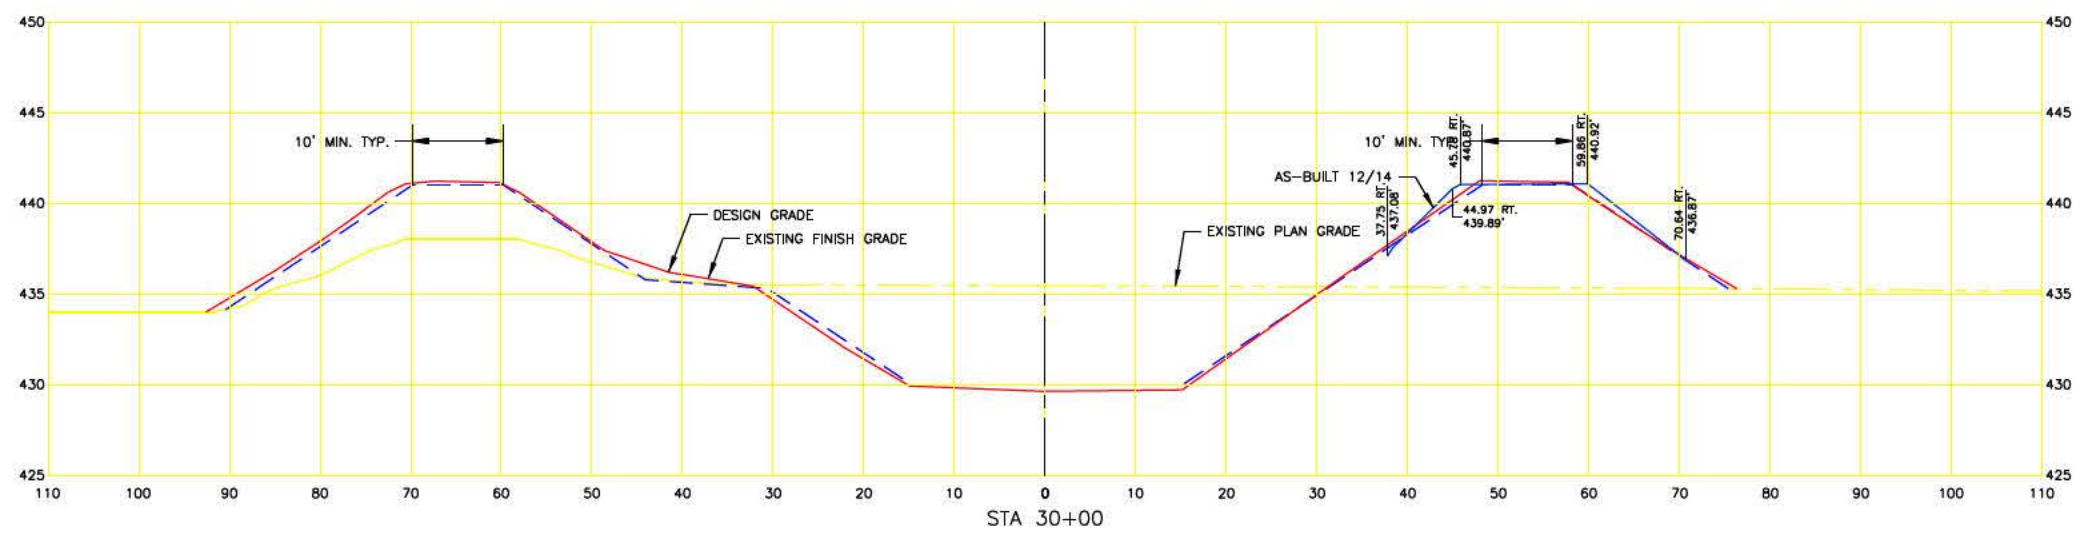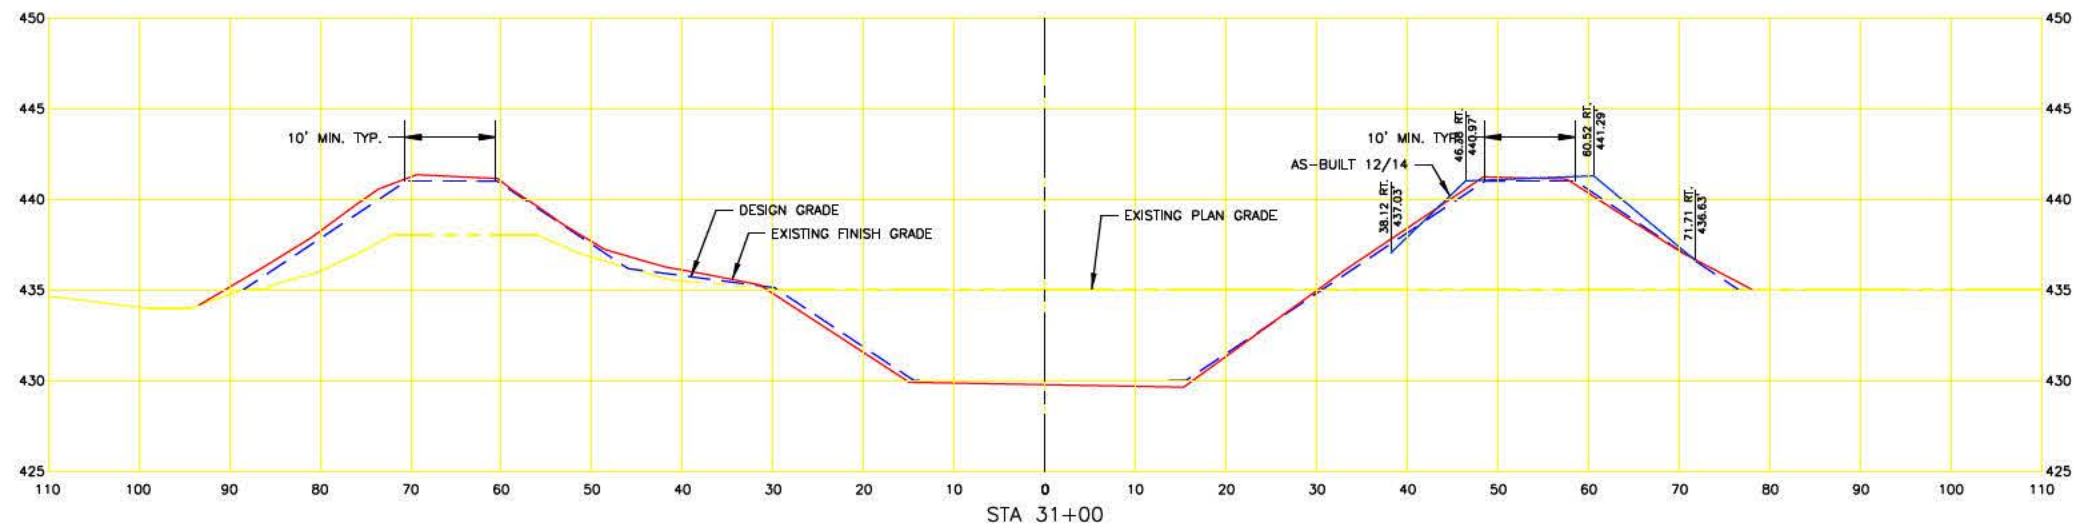


SURVEY DATA REFERENCES GEOD 09.

CONTROL POINTS REFERENCED FOR THIS SURVEY:

CP 1, CP 2, CP 20 AND CP 21

(AS SUPPLIED BY FISCHER EXCAVATING)

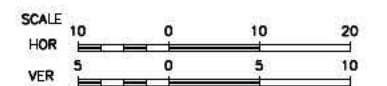

**FEHR GRAHAM**

ENGINEERING & ENVIRONMENTAL

ILLINOIS DESIGN FIRM NO. 184-003525

ILLINOIS

IOWA

WISCONSIN

OWNER/DEVELOPER:

FISCHER EXCAVATING

1567 HEINE ROAD

FREEPORT, IL 61032

PROJECT AND LOCATION:

RICE LAKE

DISCHARGE CHANNEL

FINAL CROSS SECTIONS

DRAWN BY: JJS

APPROVED BY: NAG

DATE: 1/20/15

SCALE: 1" = 10'

1" = 5'

REV. NO.	DESCRIPTION	DATE

DRAWING:




SECTION SHEET - (7)

JOB NUMBER:

14-1066

SHEET NUMBER:

7 of 20

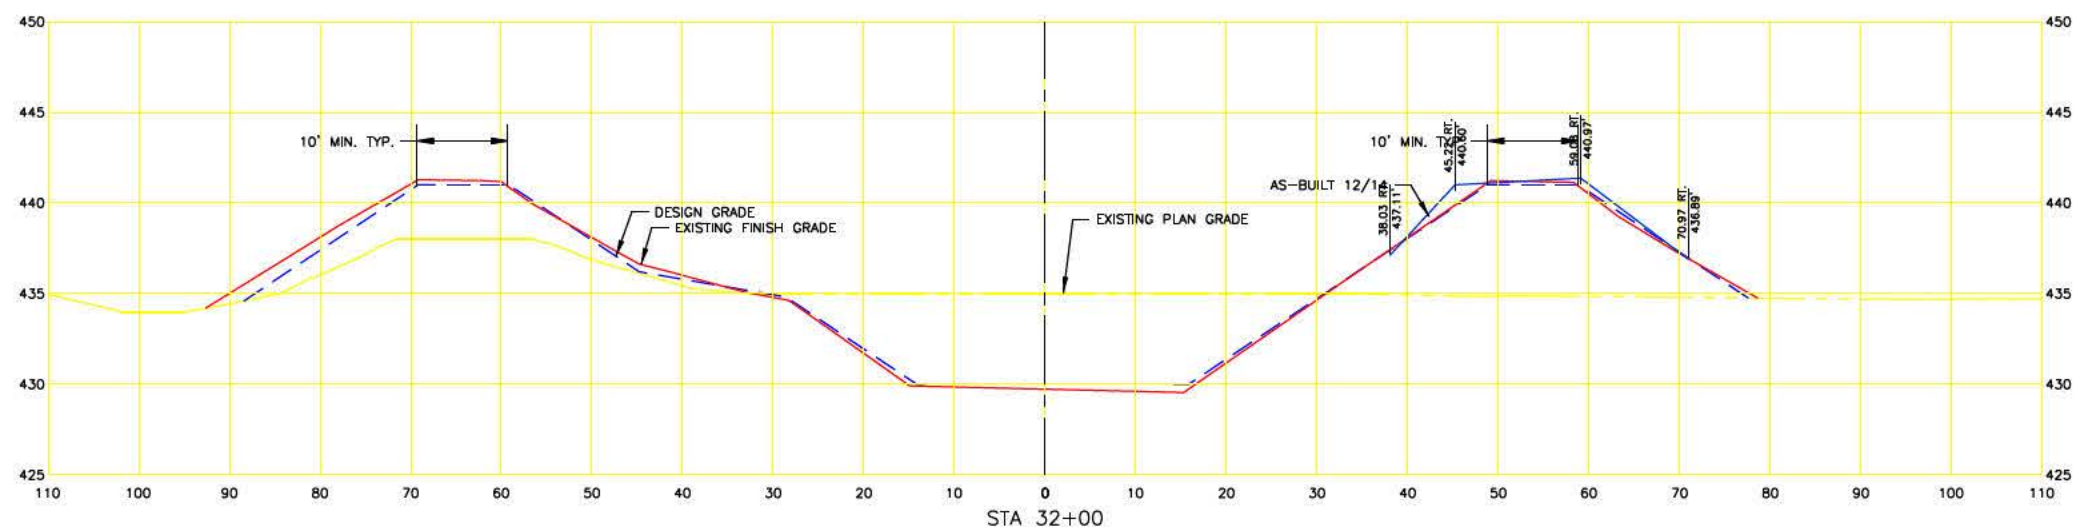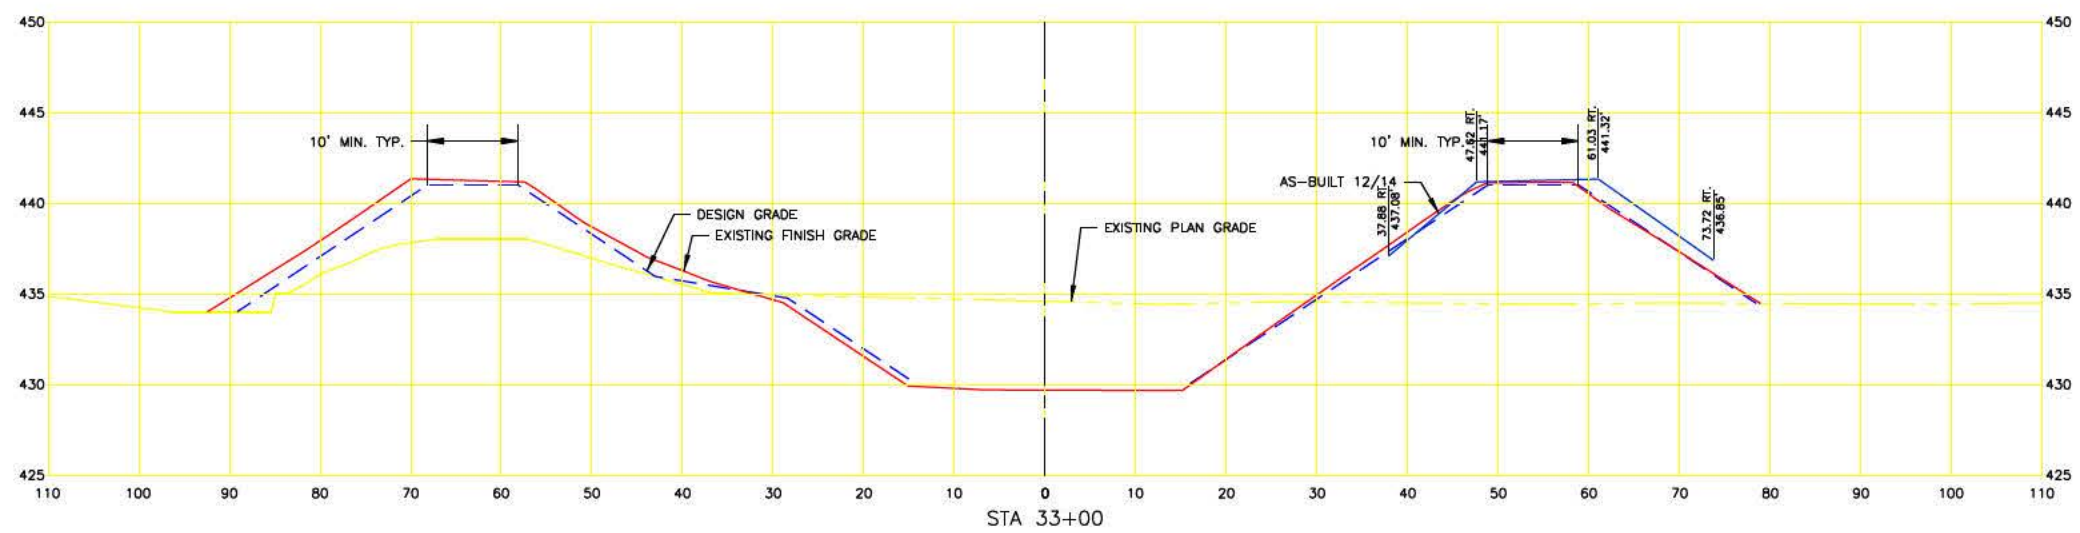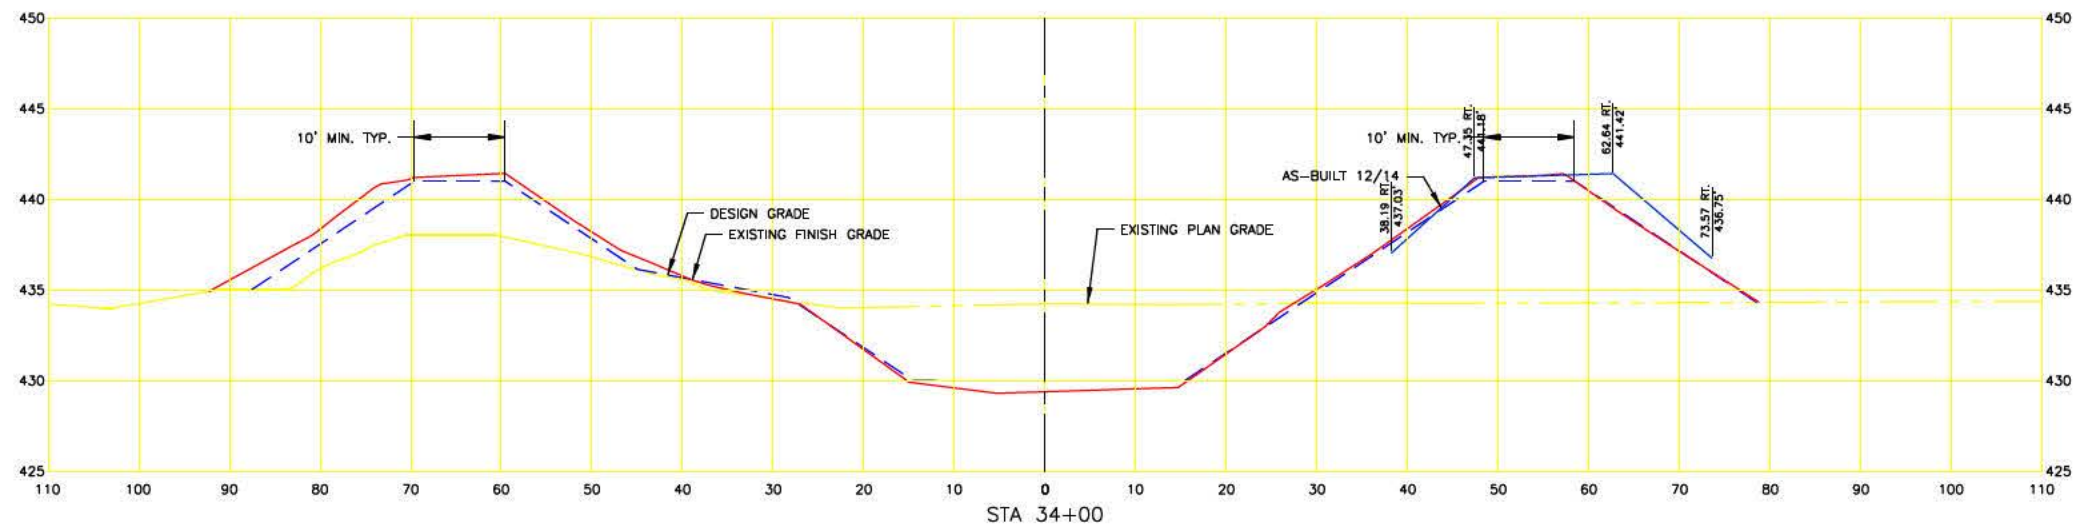


SURVEY DATA REFERENCES GEOD 09.

CONTROL POINTS REFERENCED FOR THIS SURVEY:

CP 1, CP 2, CP 20 AND CP 21

(AS SUPPLIED BY FISCHER EXCAVATING)

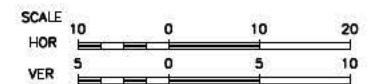

**FEHR GRAHAM**

ENGINEERING & ENVIRONMENTAL

ILLINOIS DESIGN FIRM NO. 184-003525

ILLINOIS

IOWA

WISCONSIN

OWNER/DEVELOPER:

FISCHER EXCAVATING

1567 HEINE ROAD

FREEPORT, IL 61032

PROJECT AND LOCATION:

RICE LAKE

DISCHARGE CHANNEL

FINAL CROSS SECTIONS

DRAWN BY: JJS

APPROVED BY: NAG

DATE: 1/20/15

SCALE: 1" = 10'

1" = 5'

REVISIONS		
REV. NO.	DESCRIPTION	DATE

DRAWING:

SECTION SHEET - (8)




JOB NUMBER:

14-1066

SHEET NUMBER:

8 of 20




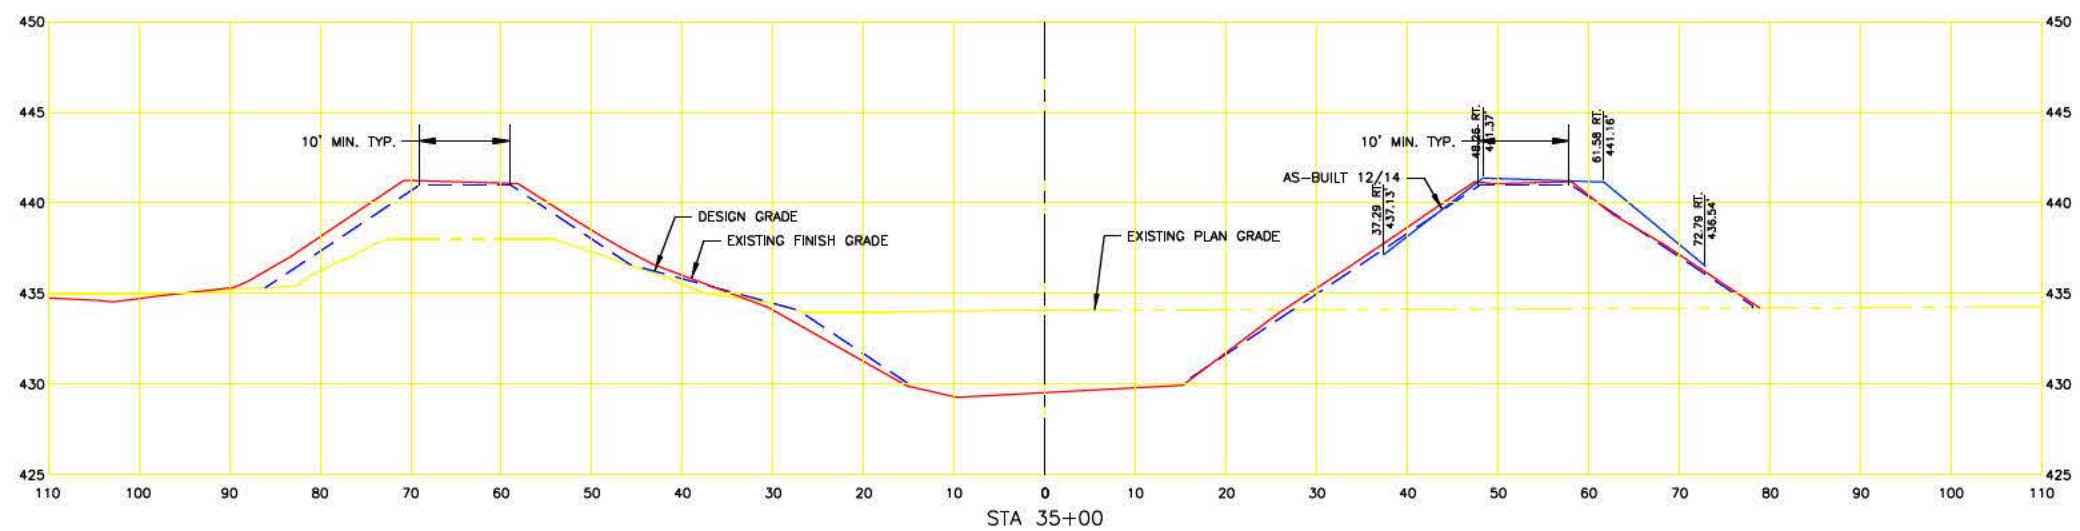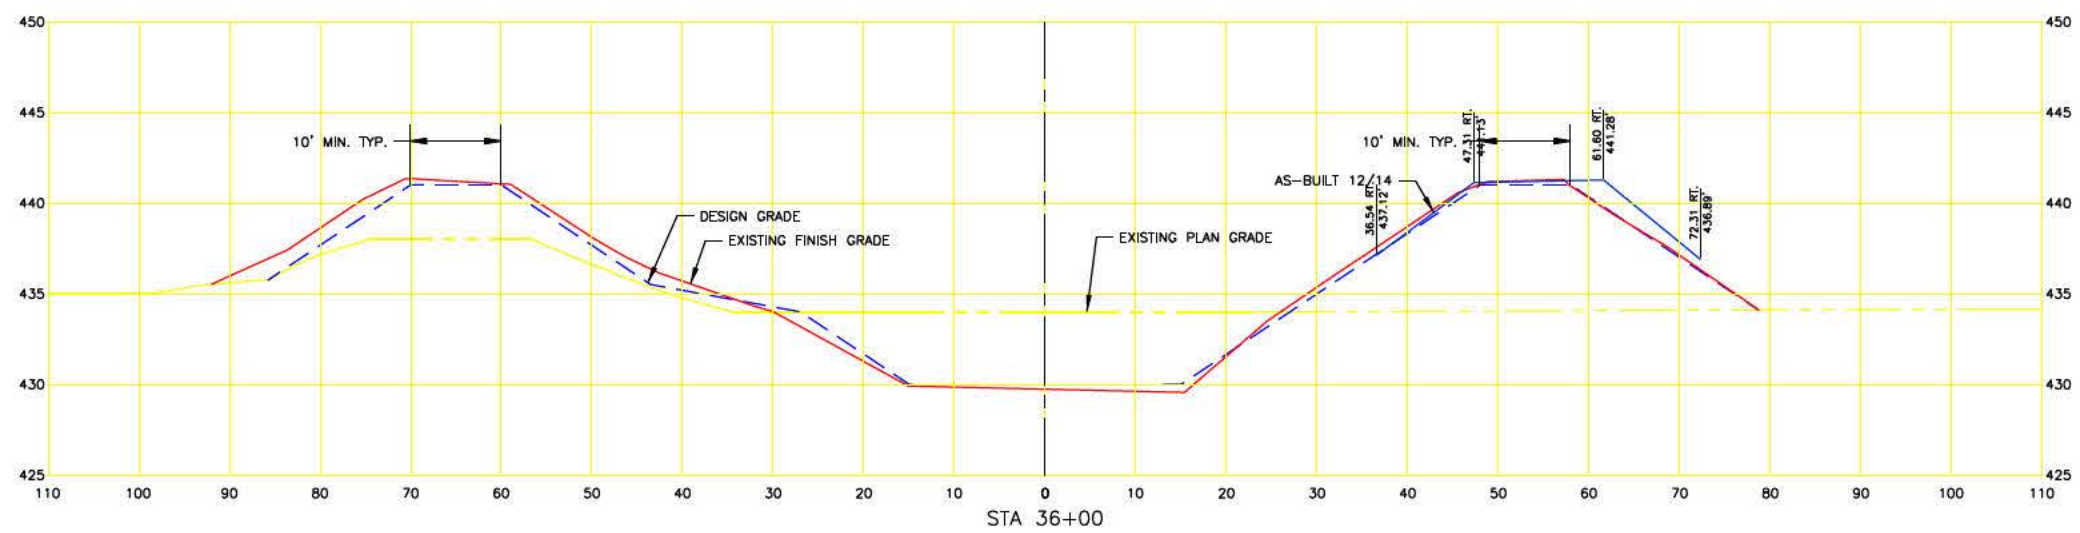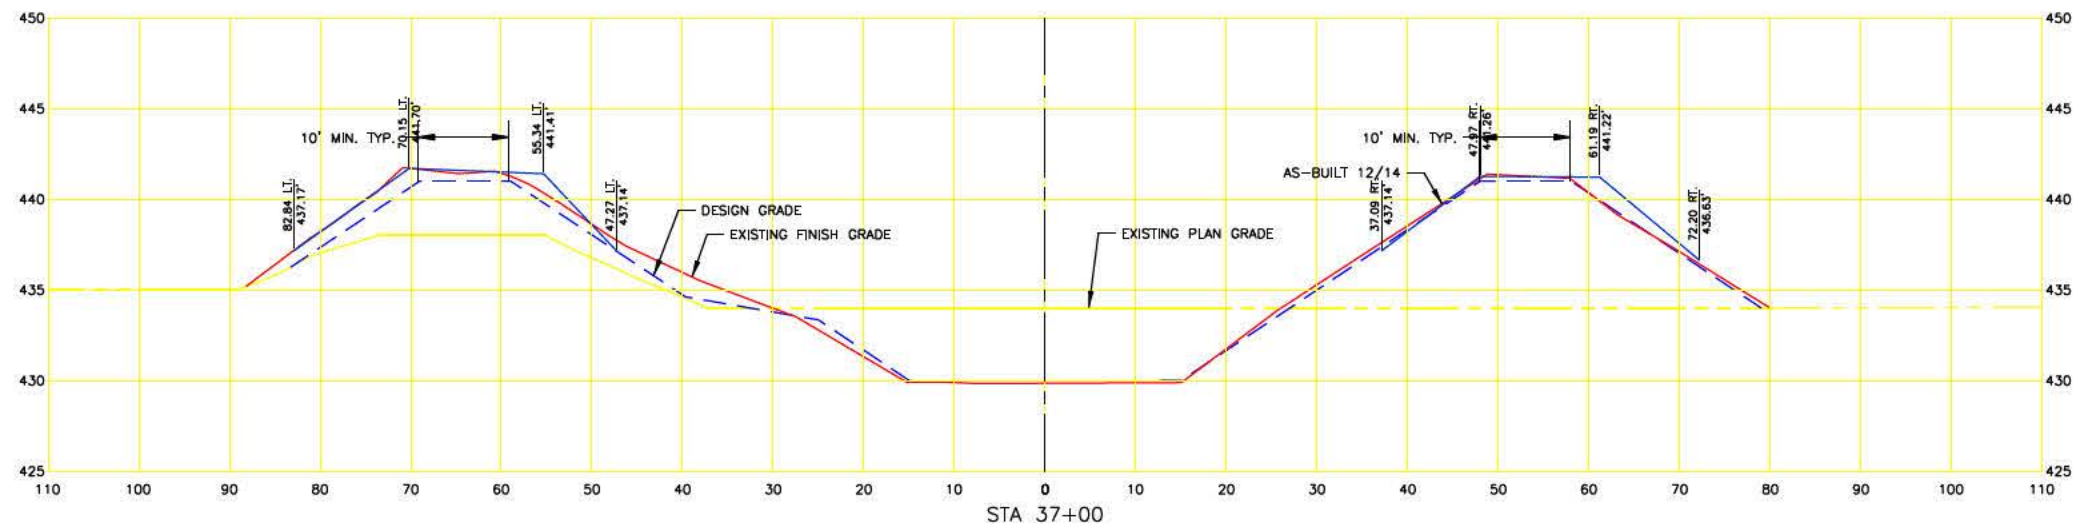

SURVEY DATA REFERENCES GEOD 09.

CONTROL POINTS REFERENCED FOR THIS SURVEY:

CP 1, CP 2, CP 20 AND CP 21  
(AS SUPPLIED BY FISCHER EXCAVATING)

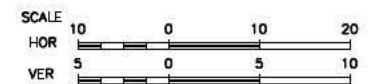

**FEHR GRAHAM**

ENGINEERING & ENVIRONMENTAL

ILLINOIS DESIGN FIRM NO. 184-003525

ILLINOIS

IOWA

WISCONSIN

OWNER/DEVELOPER:

FISCHER EXCAVATING

1567 HEINE ROAD

FREEPORT, IL 61032

PROJECT AND LOCATION:

RICE LAKE

DISCHARGE CHANNEL

FINAL CROSS SECTIONS

DRAWN BY: JJS

APPROVED BY: NAG

DATE: 1/20/15

SCALE: 1" = 10'

1" = 5'

REVISIONS		
REV. NO.	DESCRIPTION	DATE

DRAWING:

SECTION SHEET - (9)

JOB NUMBER:




14-1066

SHEET NUMBER:


9 of 20

C:\Fischer Excavating, Inc\14-1066\Set\14-1066 Survey\14-1066 Survey - DGN.dwg, Section Sheet - (9)

PLOT DATE: 1/20/15 © 2015 FEHR GRAHAM

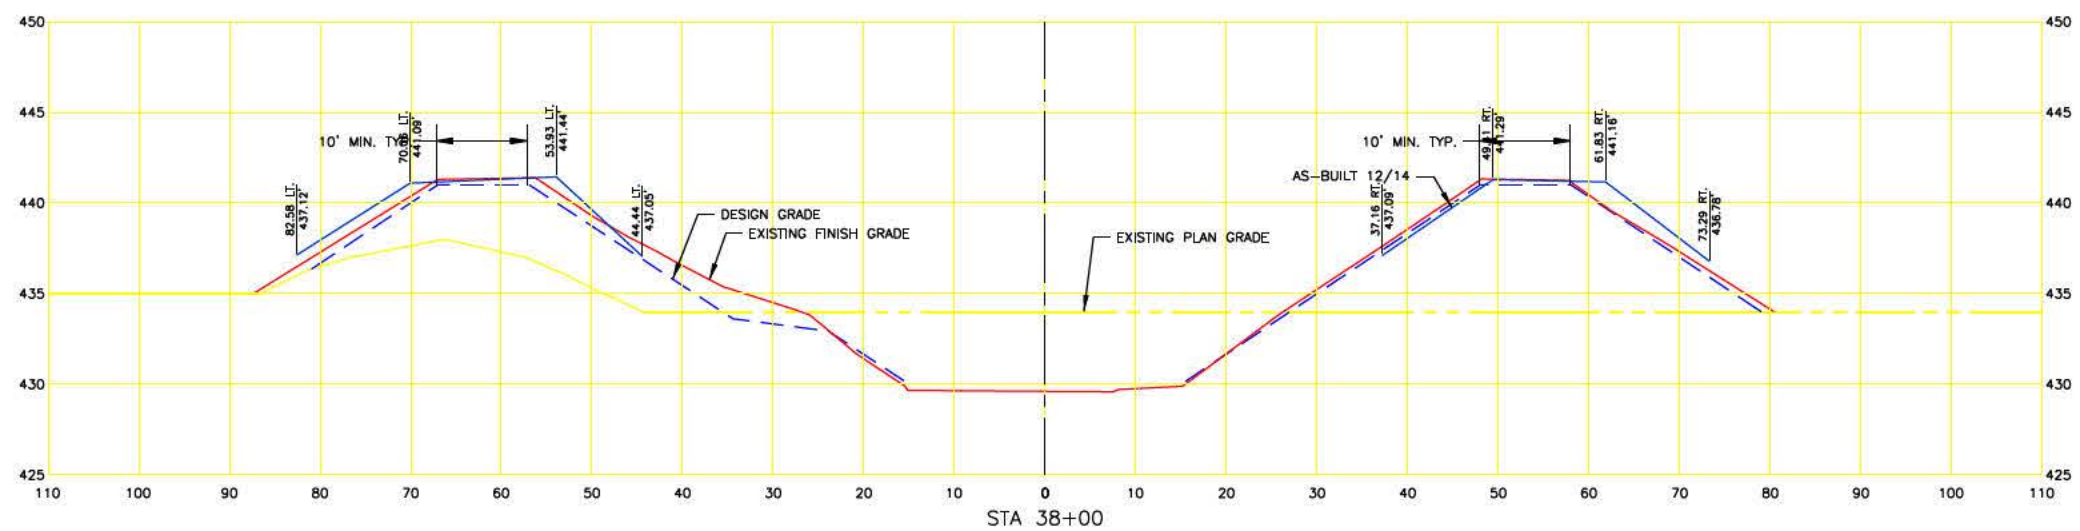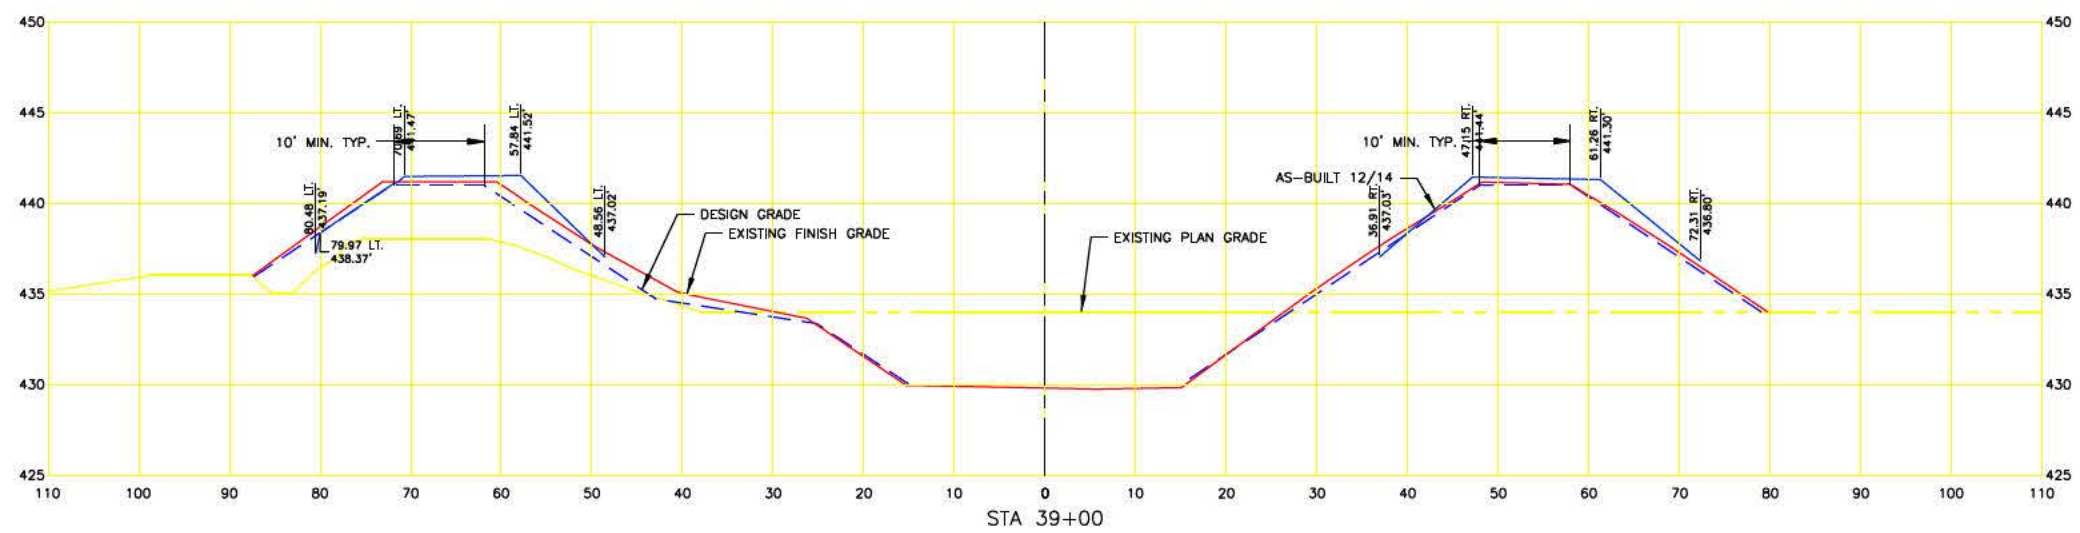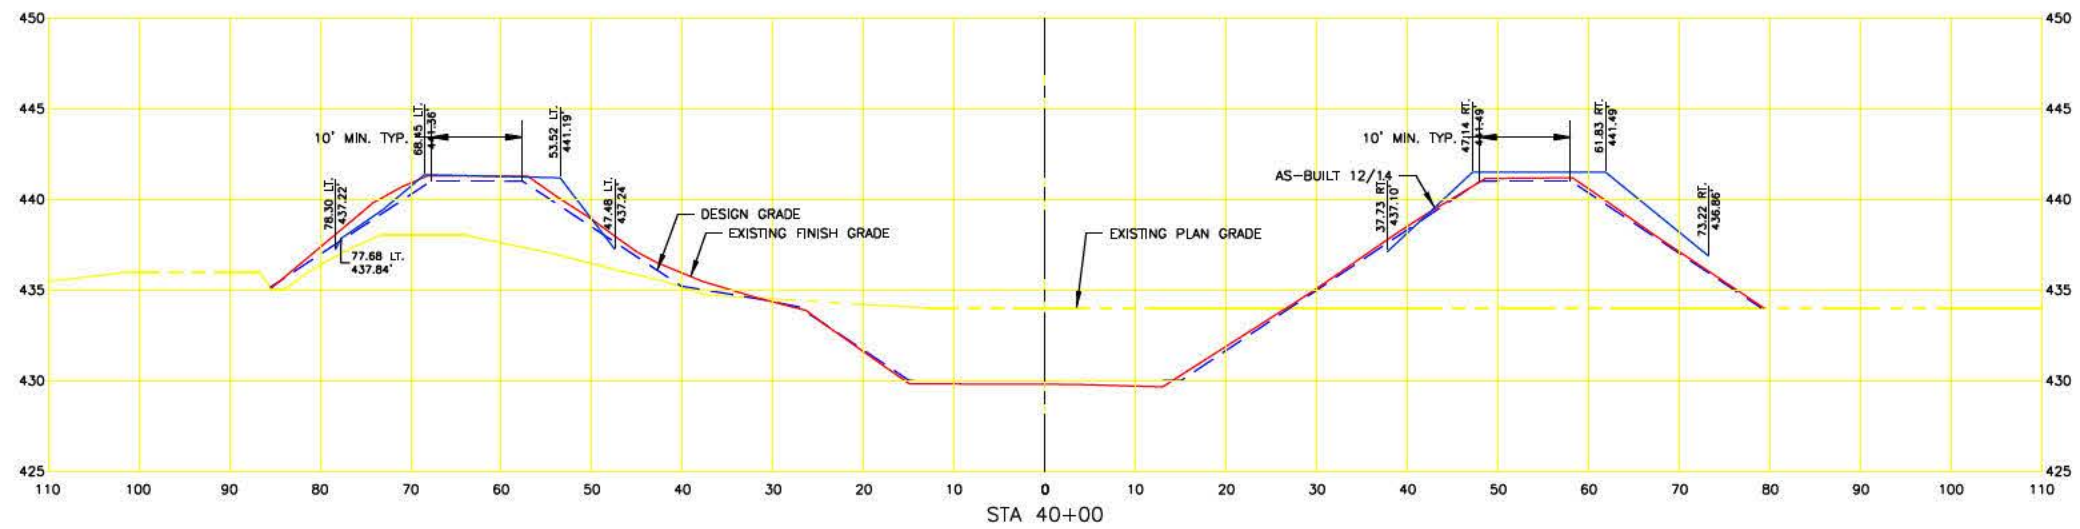

SURVEY DATA REFERENCES GEOD 09.  
 CONTROL POINTS REFERENCED FOR THIS SURVEY:  
 CP 1, CP 2, CP 20 AND CP 21  
 (AS SUPPLIED BY FISCHER EXCAVATING)

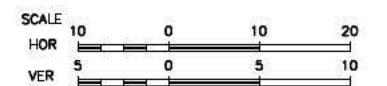

**FEHR GRAHAM**  
 ENGINEERING & ENVIRONMENTAL  
 ILLINOIS DESIGN FIRM NO. 184-003525

ILLINOIS  
 IOWA  
 WISCONSIN

OWNER/DEVELOPER:  
 FISCHER EXCAVATING  
 1567 HEINE ROAD  
 FREEPORT, IL 61032

PROJECT AND LOCATION:  
 RICE LAKE  
 DISCHARGE CHANNEL  
 FINAL CROSS SECTIONS

DRAWN BY: JJS  
 APPROVED BY: NAG  
 DATE: 1/20/15  
 SCALE: 1" = 10'  
 1" = 5'




REVISIONS		
REV. NO.	DESCRIPTION	DATE

DRAWING:  
 SECTION SHEET - (10)


JOB NUMBER:  
 14-1066

SHEET NUMBER:  
 10 of 20



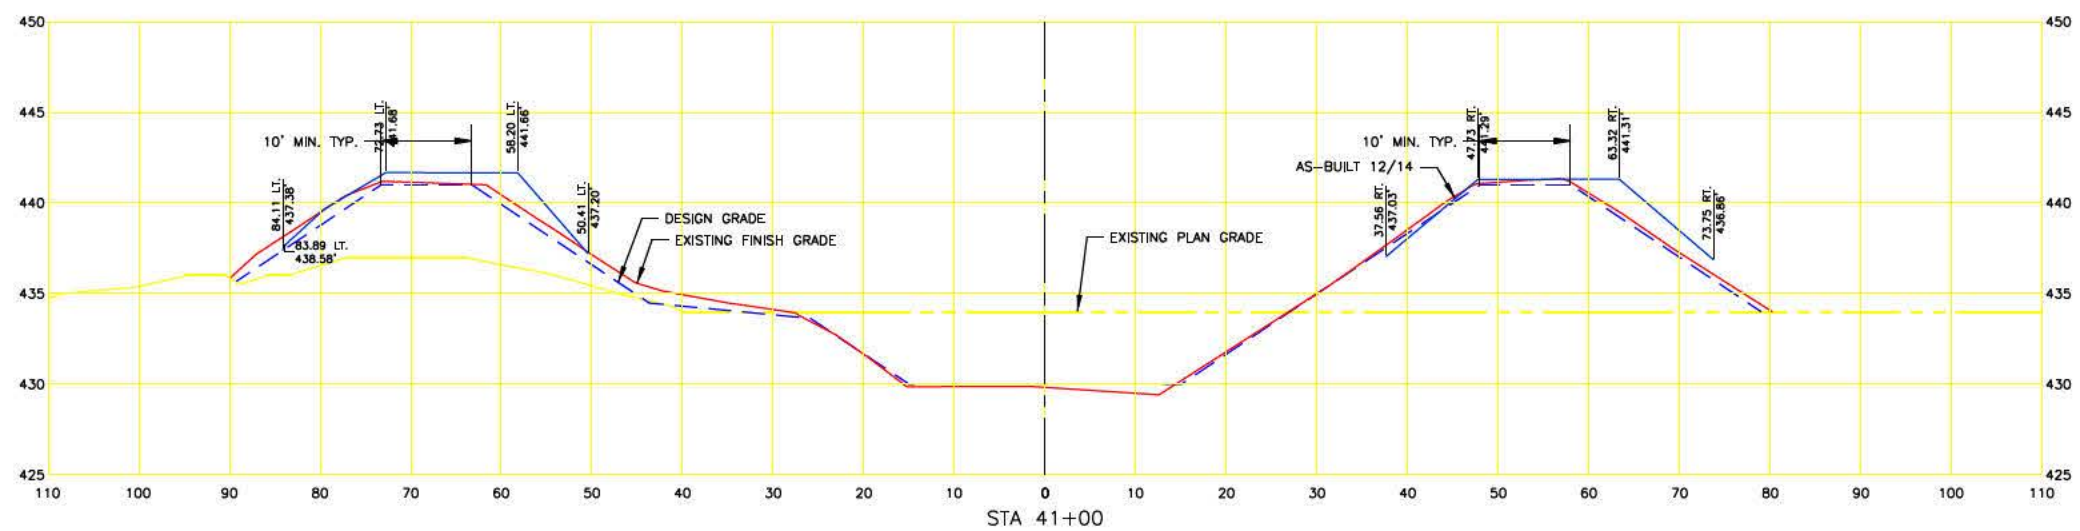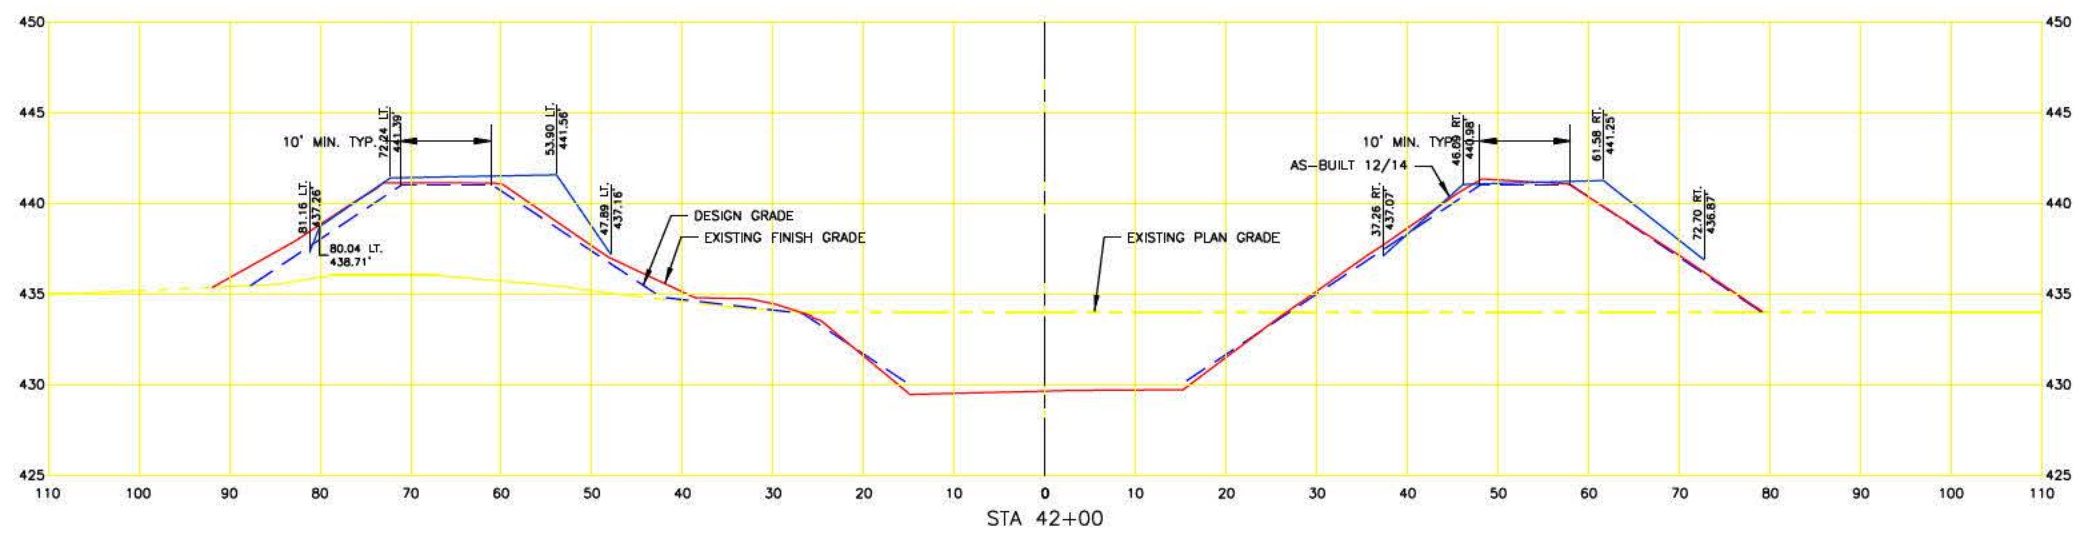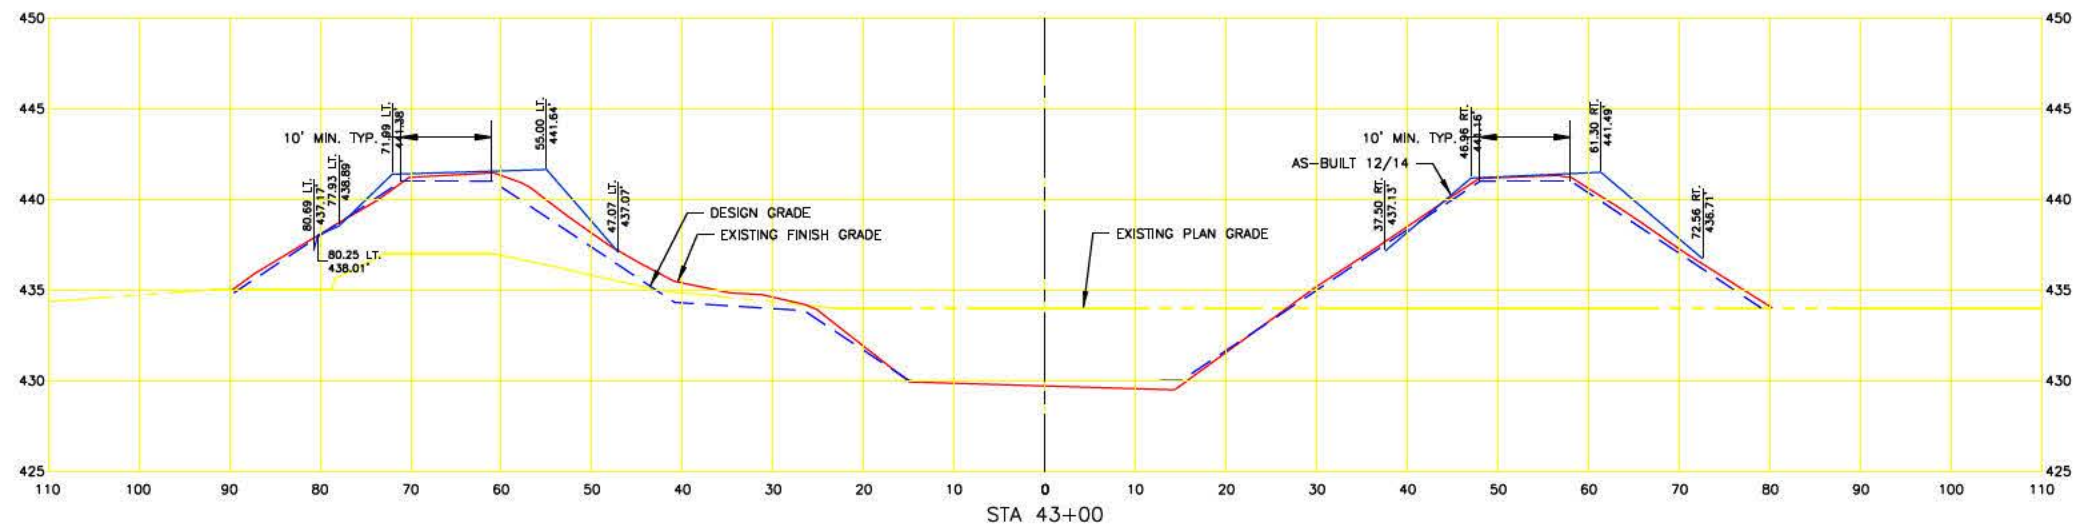

SURVEY DATA REFERENCES GEOD 09.  
 CONTROL POINTS REFERENCED FOR THIS SURVEY:  
 CP 1, CP 2, CP 20 AND CP 21  
 (AS SUPPLIED BY FISCHER EXCAVATING)

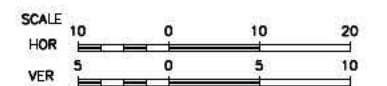

**FEHR GRAHAM**  
 ENGINEERING & ENVIRONMENTAL  
 ILLINOIS DESIGN FIRM NO. 184-003525

ILLINOIS  
 IOWA  
 WISCONSIN

OWNER/DEVELOPER:  
 FISCHER EXCAVATING  
 1567 HEINE ROAD  
 FREEPORT, IL 61032

PROJECT AND LOCATION:  
 RICE LAKE  
 DISCHARGE CHANNEL  
 FINAL CROSS SECTIONS

DRAWN BY: JJS  
 APPROVED BY: NAG  
 DATE: 1/20/15  
 SCALE: 1" = 10'  
 1" = 5'




REV. NO.	DESCRIPTION	DATE

DRAWING:  
 SECTION SHEET - (11)

JOB NUMBER:  
 14-1066

SHEET NUMBER:  
 11 of 20


PLOT DATE: 1/20/15 © 2015 FEHR GRAHAM

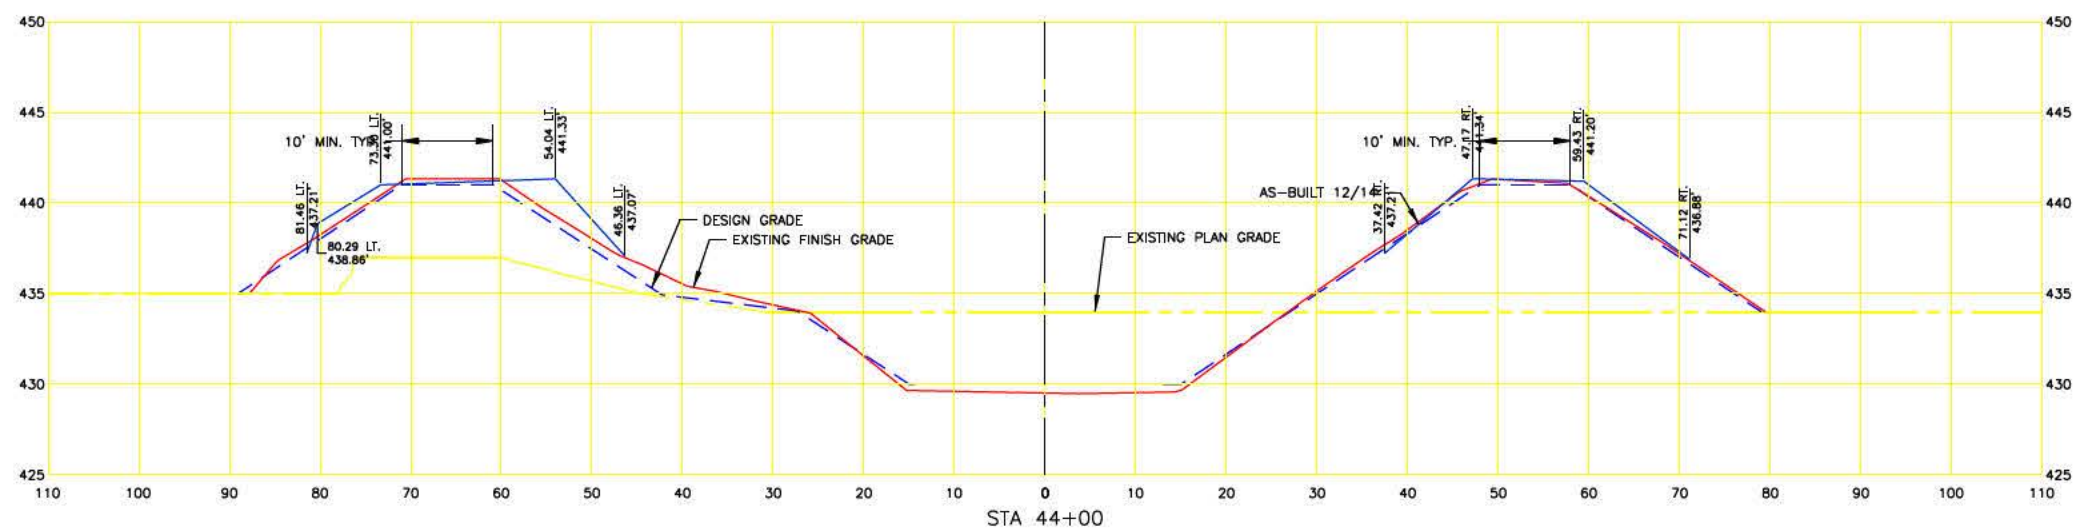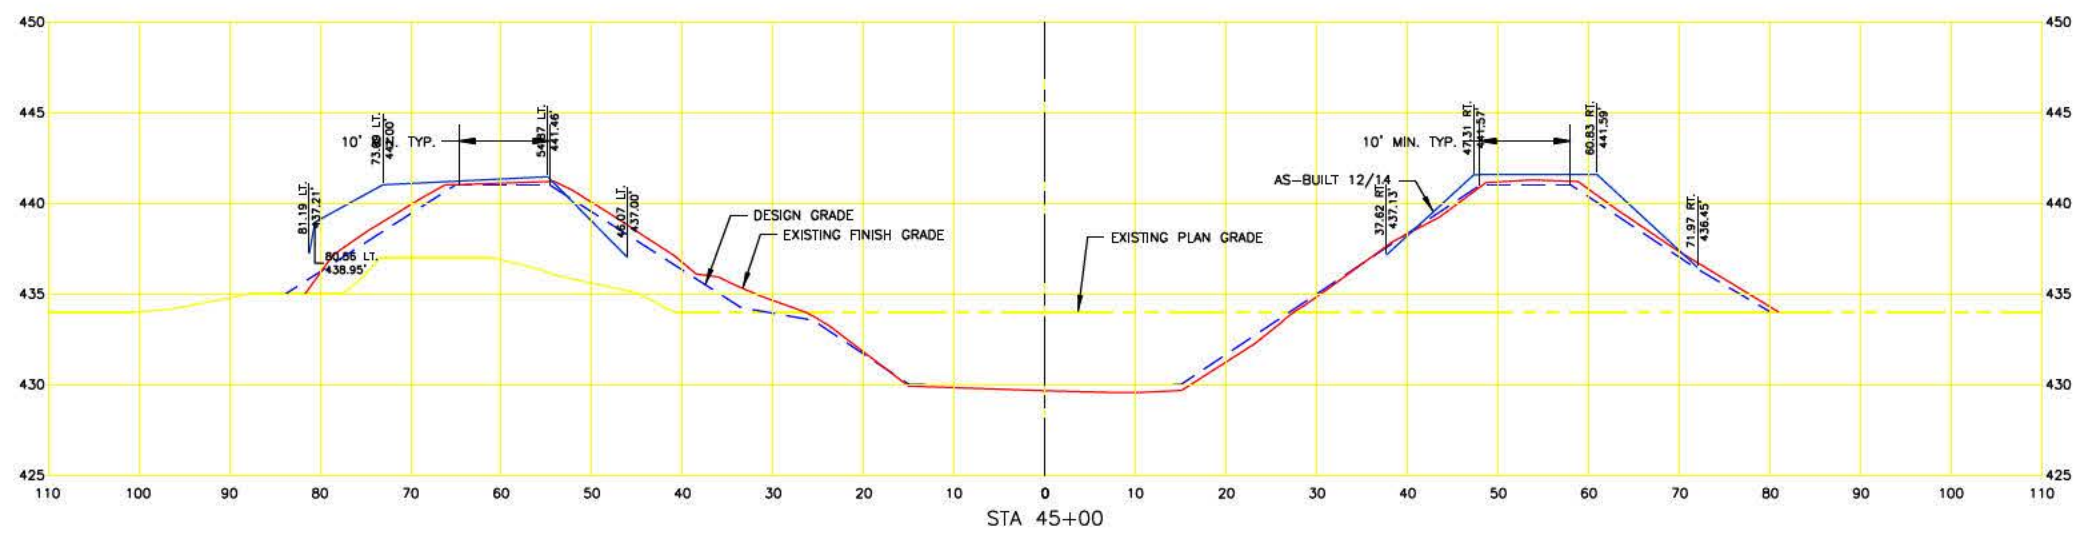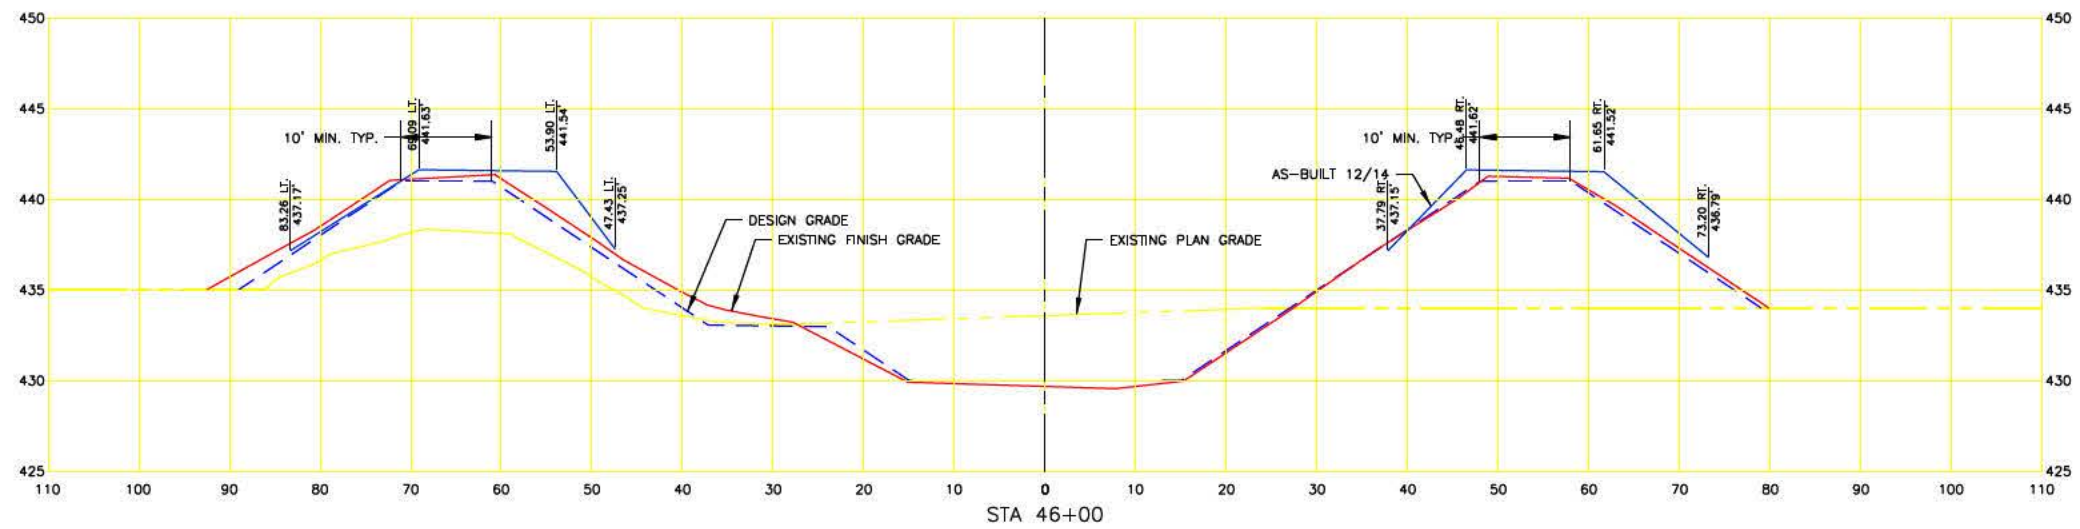

SURVEY DATA REFERENCES GEOD 09.

CONTROL POINTS REFERENCED FOR THIS SURVEY:

CP 1, CP 2, CP 20 AND CP 21  
(AS SUPPLIED BY FISCHER EXCAVATING)

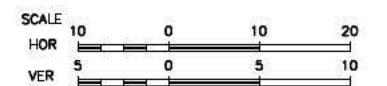

**FEHR GRAHAM**

ENGINEERING & ENVIRONMENTAL

ILLINOIS DESIGN FIRM NO. 184-003525

ILLINOIS

IOWA

WISCONSIN

OWNER/DEVELOPER:

FISCHER EXCAVATING

1567 HEINE ROAD

FREEPORT, IL 61032

PROJECT AND LOCATION:

RICE LAKE

DISCHARGE CHANNEL

FINAL CROSS SECTIONS

DRAWN BY: JJS

APPROVED BY: NAG

DATE: 1/20/15

SCALE: 1" = 10'

1" = 5'

REVISIONS		
REV. NO.	DESCRIPTION	DATE

DRAWING:

SECTION SHEET - (12)

JOB NUMBER:

14-1066




SHEET NUMBER:

12 of 20


PLOT DATE: 1/20/15

© 2015 FEHR GRAHAM



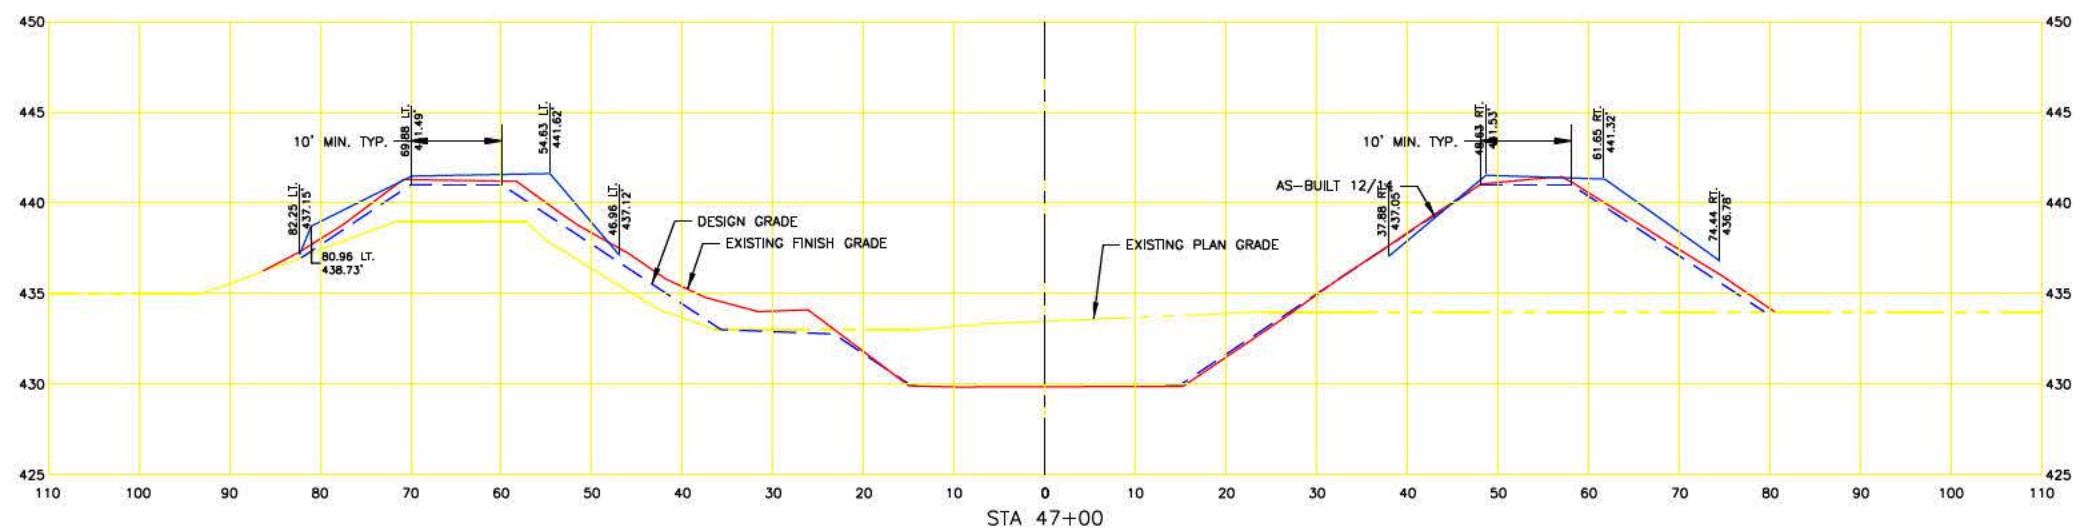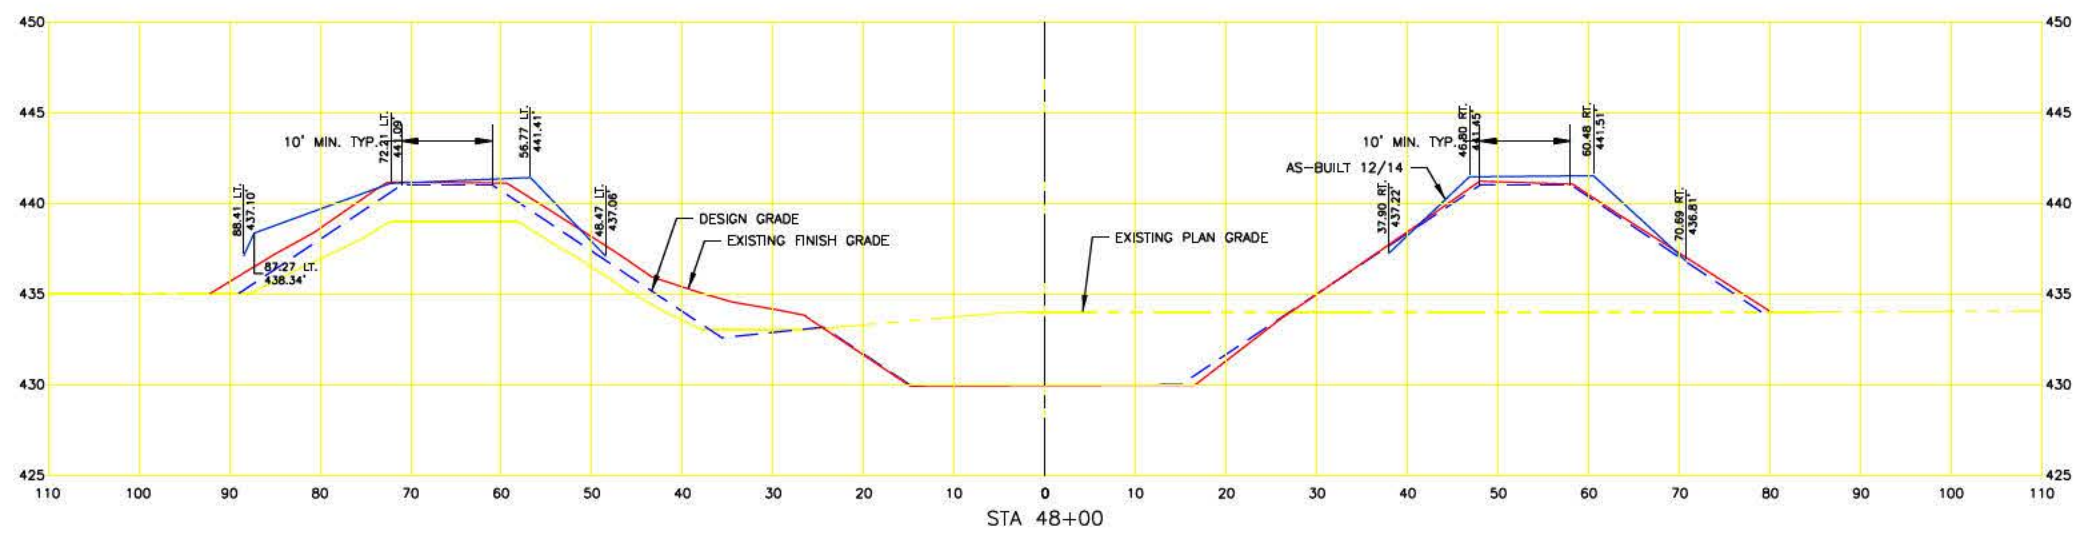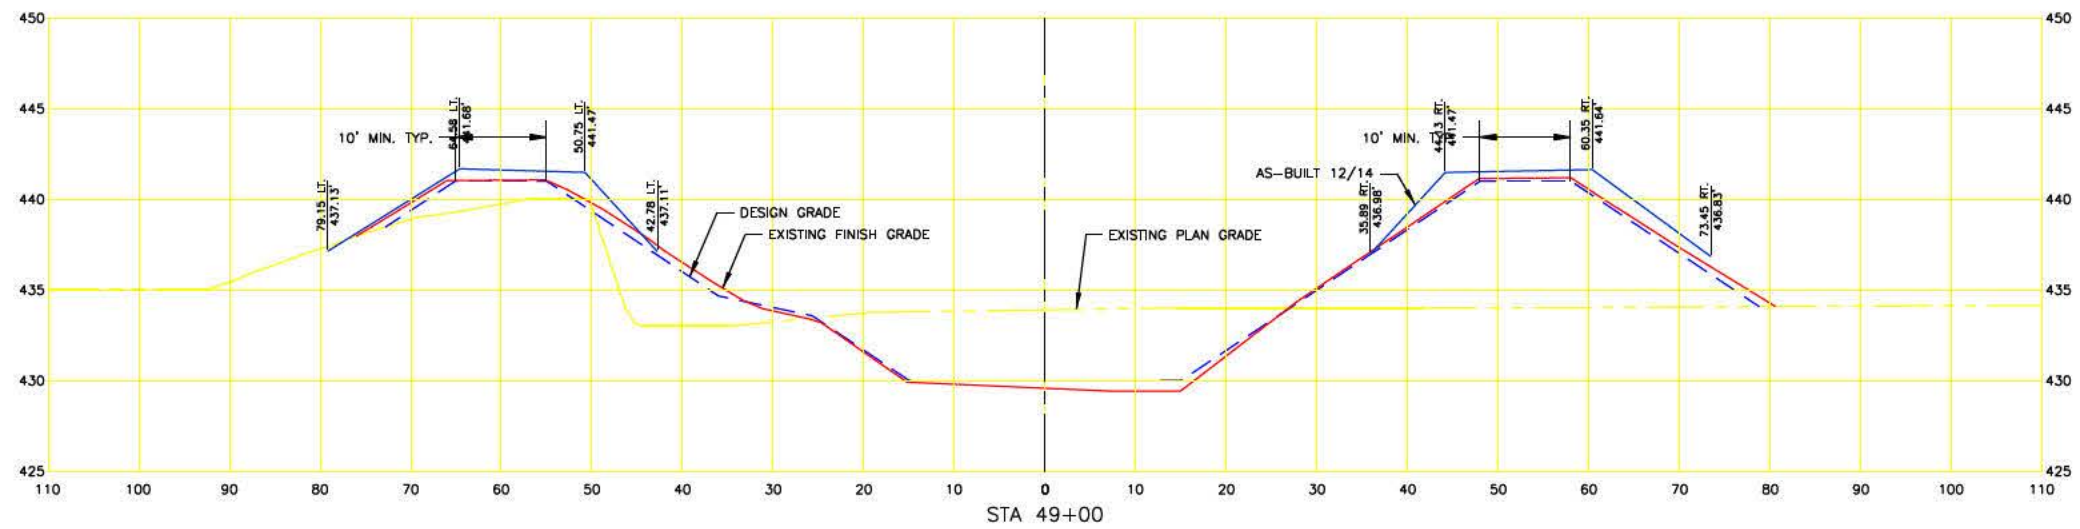

SURVEY DATA REFERENCES GEOID 09.  
CONTROL POINTS REFERENCED FOR THIS SURVEY:  
CP 1, CP 2, CP 20 AND CP 21  
(AS SUPPLIED BY FISCHER EXCAVATING)

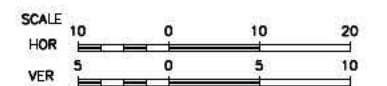

**FEHR GRAHAM**  
ENGINEERING & ENVIRONMENTAL  
ILLINOIS DESIGN FIRM NO. 184-003525

ILLINOIS  
IOWA  
WISCONSIN

OWNER/DEVELOPER:  
FISCHER EXCAVATING  
1567 HEINE ROAD  
FREEPORT, IL 61032

PROJECT AND LOCATION:  
RICE LAKE  
DISCHARGE CHANNEL  
FINAL CROSS SECTIONS




DRAWN BY: JJS  
APPROVED BY: NAG  
DATE: 1/20/15  
SCALE: 1" = 10'  
1" = 5'

REVISIONS		
REV. NO.	DESCRIPTION	DATE


DRAWING:  
SECTION SHEET - (13)

JOB NUMBER:  
14-1066

SHEET NUMBER:  
13 of 20

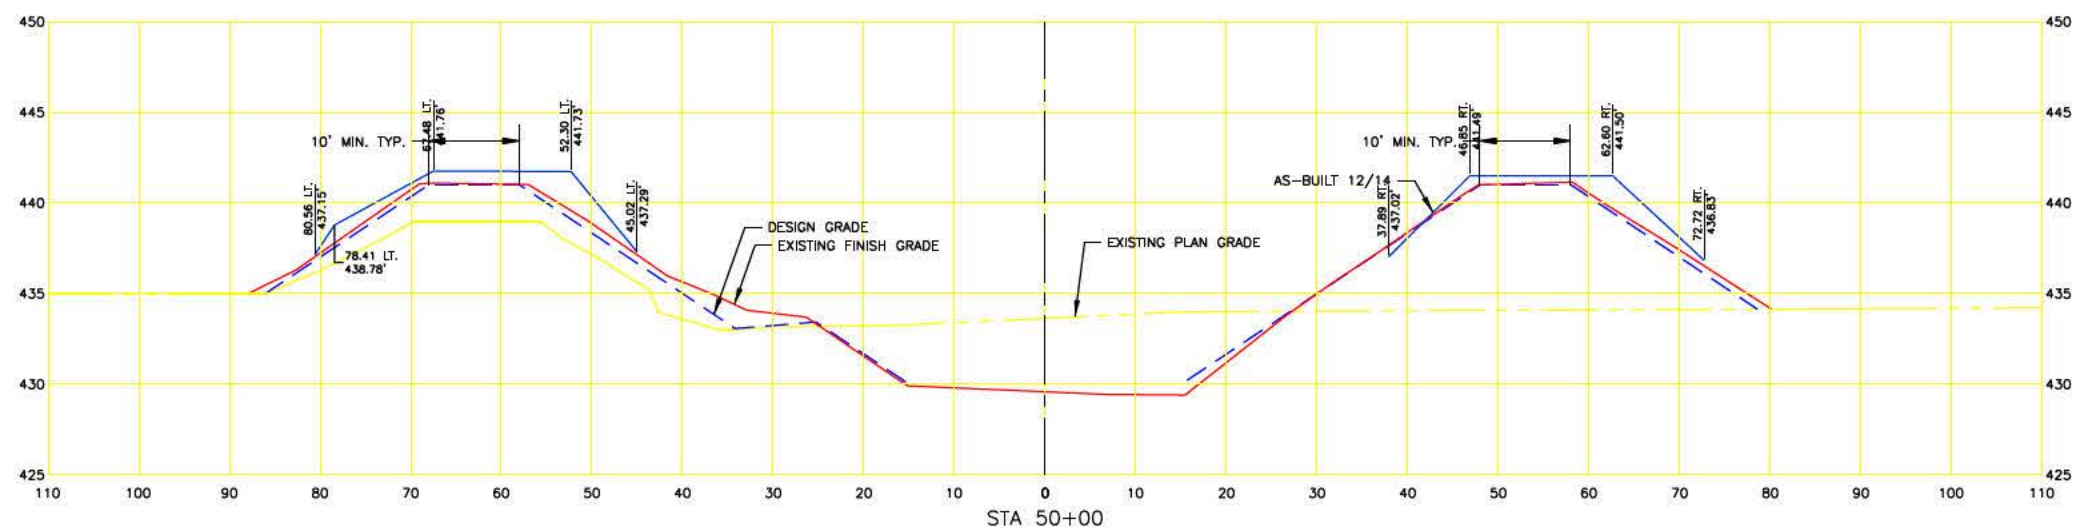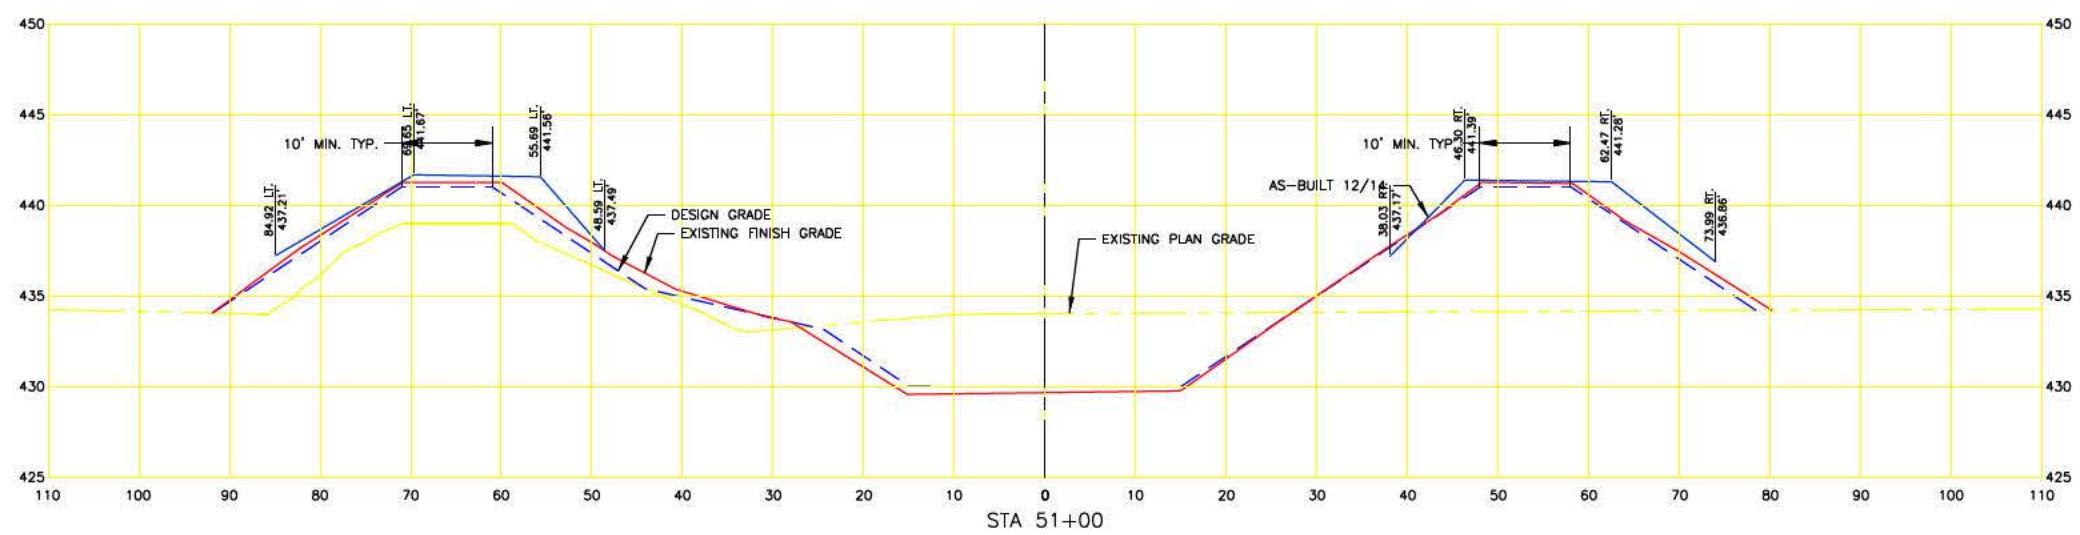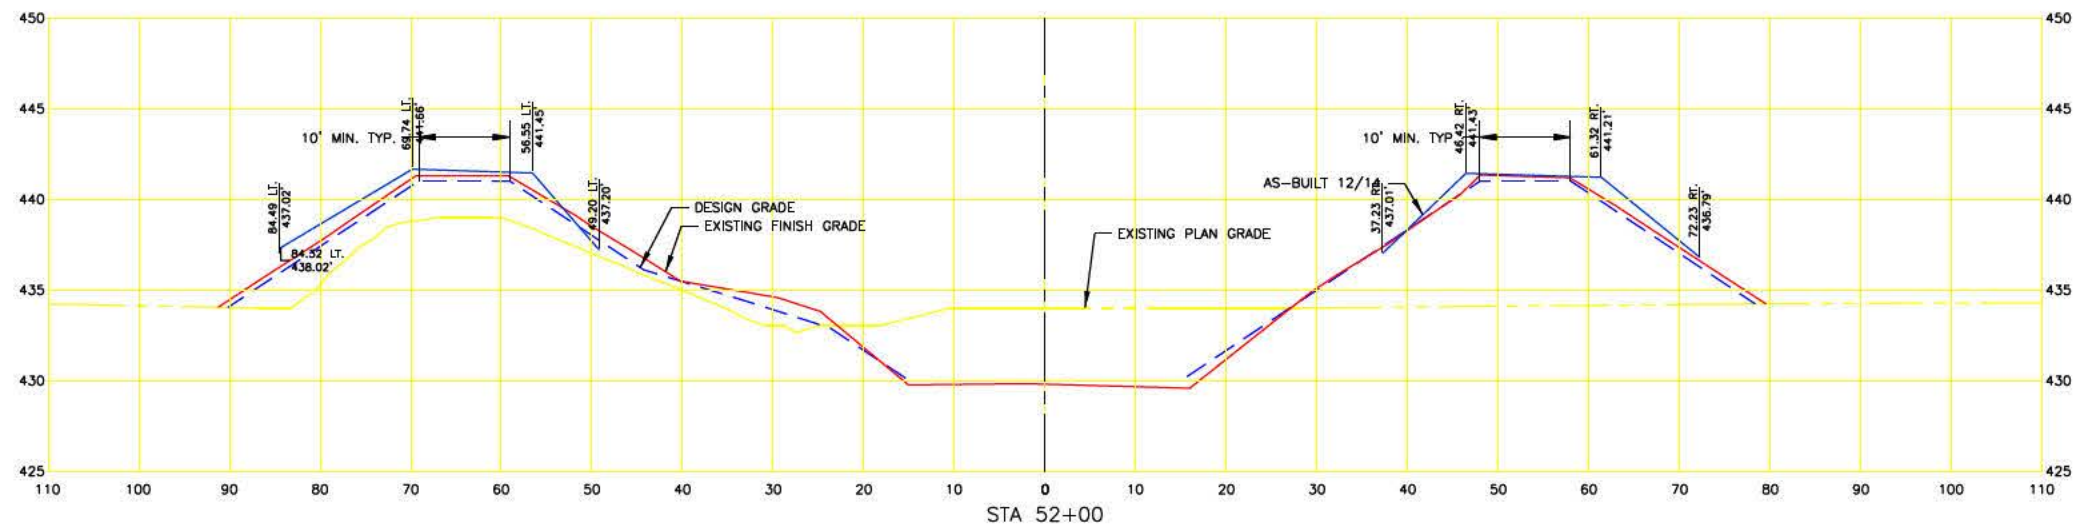

SURVEY DATA REFERENCES GEOD 09.  
CONTROL POINTS REFERENCED FOR THIS SURVEY:  
CP 1, CP 2, CP 20 AND CP 21  
(AS SUPPLIED BY FISCHER EXCAVATING)

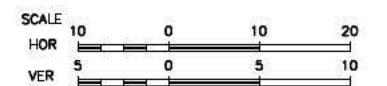

**FEHR GRAHAM**  
ENGINEERING & ENVIRONMENTAL  
ILLINOIS DESIGN FIRM NO. 184-003525

ILLINOIS  
IOWA  
WISCONSIN

OWNER/DEVELOPER:  
FISCHER EXCAVATING  
1567 HEINE ROAD  
FREEPORT, IL 61032

PROJECT AND LOCATION:  
RICE LAKE  
DISCHARGE CHANNEL  
FINAL CROSS SECTIONS

DRAWN BY: JJS  
APPROVED BY: NAG  
DATE: 1/20/15  
SCALE: 1" = 10'  
1" = 5'




REV. NO.	DESCRIPTION	DATE

DRAWING:  
SECTION SHEET - (14)


JOB NUMBER:  
14-1066

SHEET NUMBER:  
14 of 20



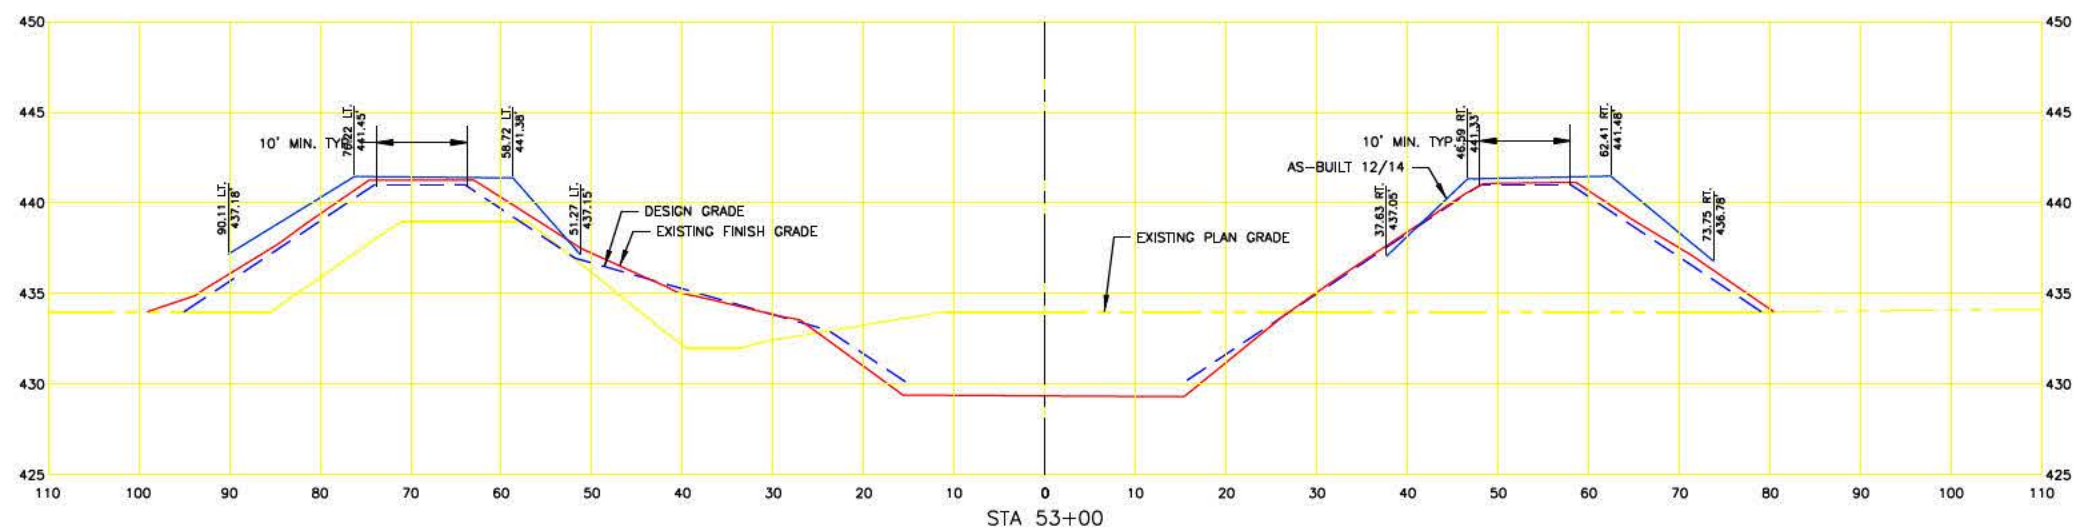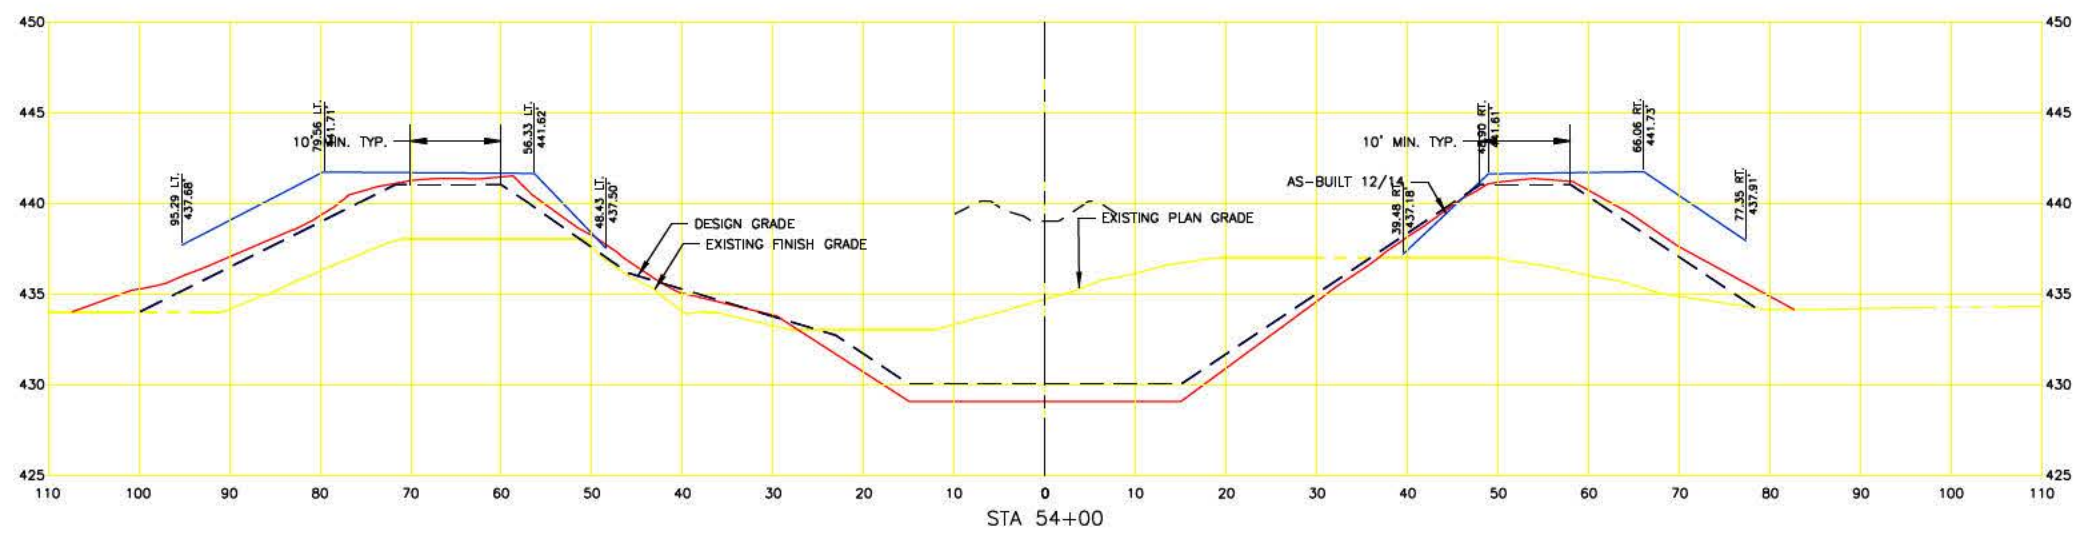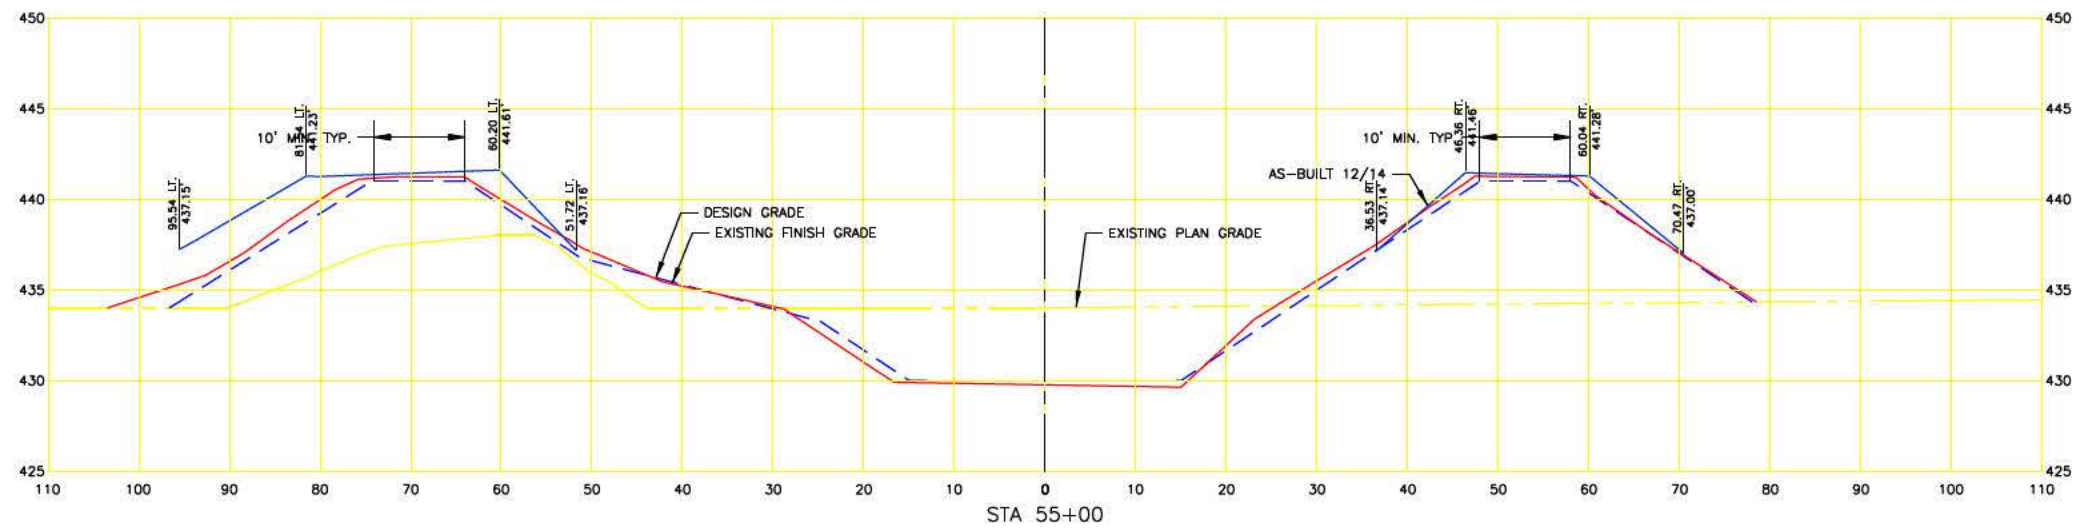

SURVEY DATA REFERENCES GEIOD 09.  
 CONTROL POINTS REFERENCED FOR THIS SURVEY:  
 CP 1, CP 2, CP 20 AND CP 21  
 (AS SUPPLIED BY FISCHER EXCAVATING)

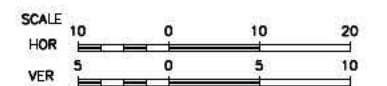

**FEHR GRAHAM**  
 ENGINEERING & ENVIRONMENTAL  
 ILLINOIS DESIGN FIRM NO. 184-003525

ILLINOIS  
 IOWA  
 WISCONSIN

OWNER/DEVELOPER:  
 FISCHER EXCAVATING  
 1567 HEINE ROAD  
 FREEPORT, IL 61032

PROJECT AND LOCATION:  
 RICE LAKE  
 DISCHARGE CHANNEL  
 FINAL CROSS SECTIONS




DRAWN BY: JJS  
 APPROVED BY: NAG  
 DATE: 1/20/15  
 SCALE: 1" = 10'  
 1" = 5'

REV. NO.	DESCRIPTION	DATE


DRAWING:  
 SECTION SHEET - (15)

JOB NUMBER:  
 14-1066

SHEET NUMBER:  
 15 of 20

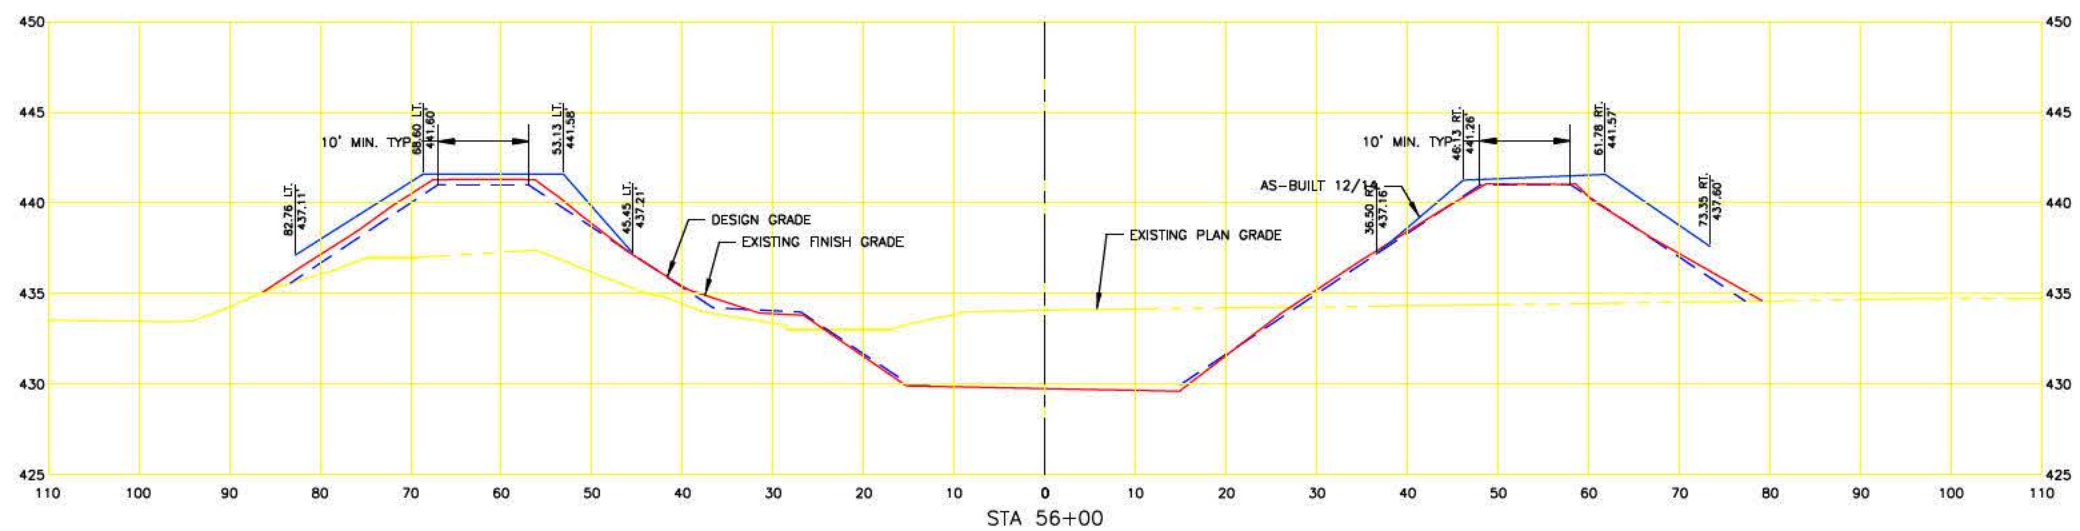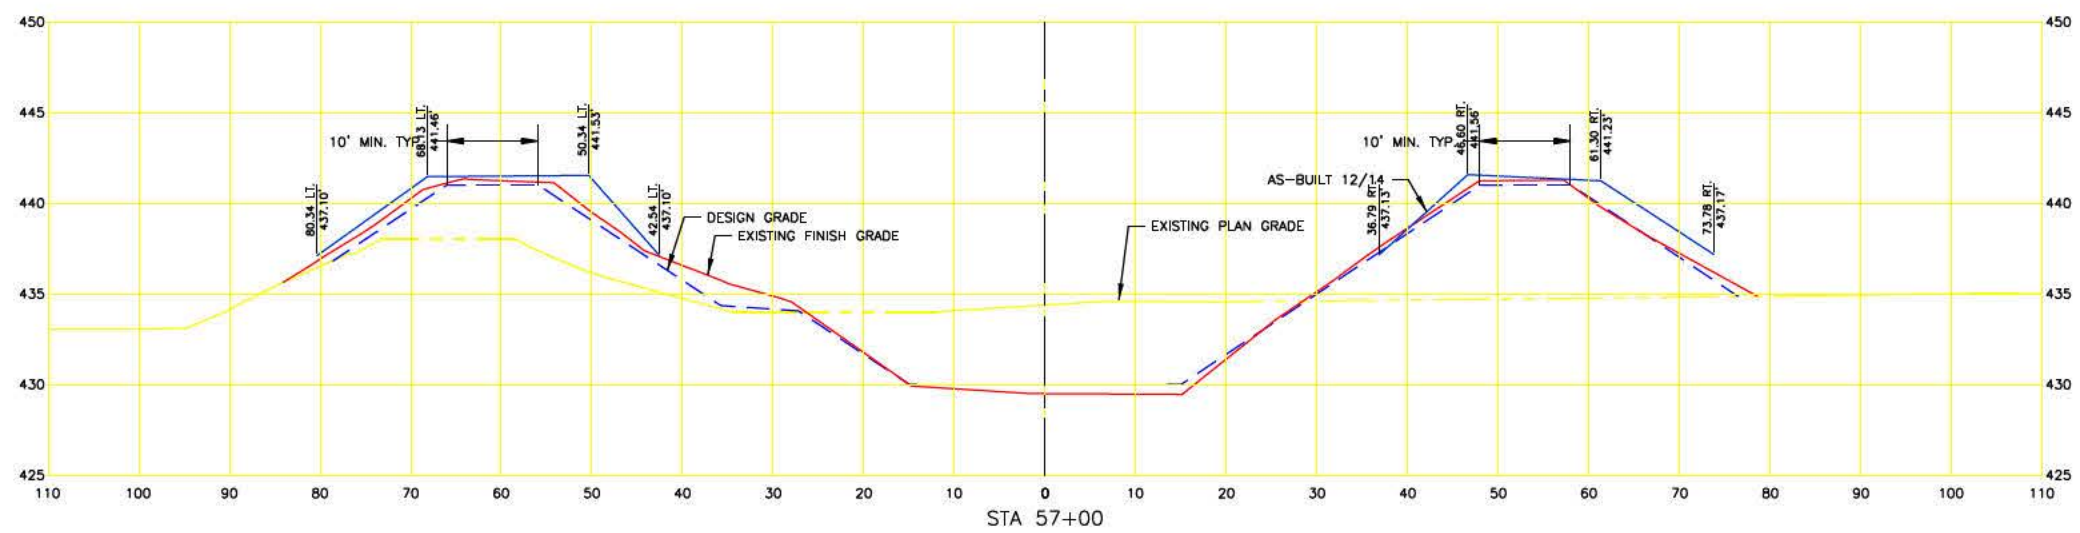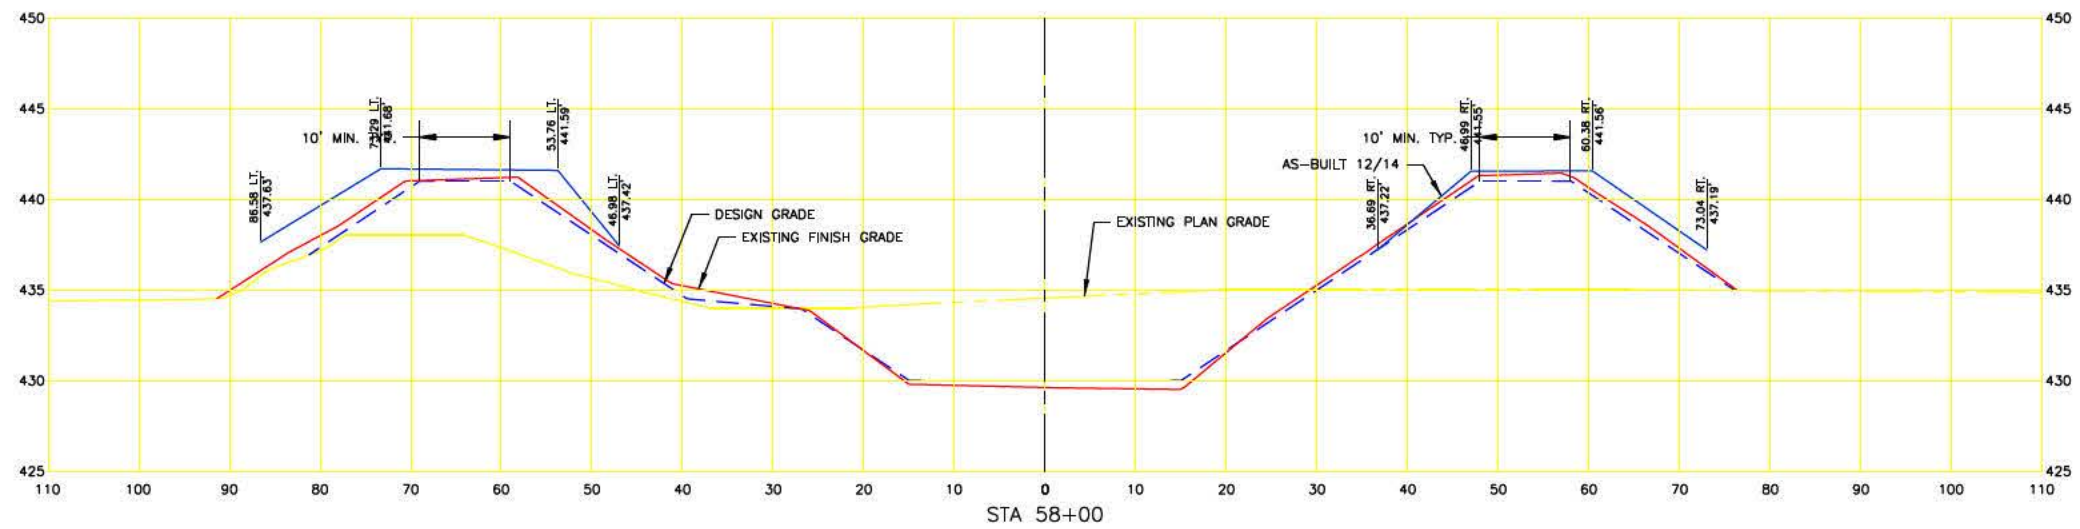

SURVEY DATA REFERENCES GEOD 09.  
CONTROL POINTS REFERENCED FOR THIS SURVEY:  
CP 1, CP 2, CP 20 AND CP 21  
(AS SUPPLIED BY FISCHER EXCAVATING)

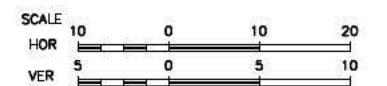

**FEHR GRAHAM**  
ENGINEERING & ENVIRONMENTAL  
ILLINOIS DESIGN FIRM NO. 184-003525

ILLINOIS  
IOWA  
WISCONSIN

OWNER/DEVELOPER:  
FISCHER EXCAVATING  
1567 HEINE ROAD  
FREEPORT, IL 61032

PROJECT AND LOCATION:  
RICE LAKE  
DISCHARGE CHANNEL  
FINAL CROSS SECTIONS

DRAWN BY: JJS  
APPROVED BY: NAG  
DATE: 1/20/15  
SCALE: 1" = 10'  
1" = 5'




REVISIONS		
REV. NO.	DESCRIPTION	DATE

DRAWING:  
SECTION SHEET - (16)


JOB NUMBER:  
14-1066

SHEET NUMBER:  
16 of 20



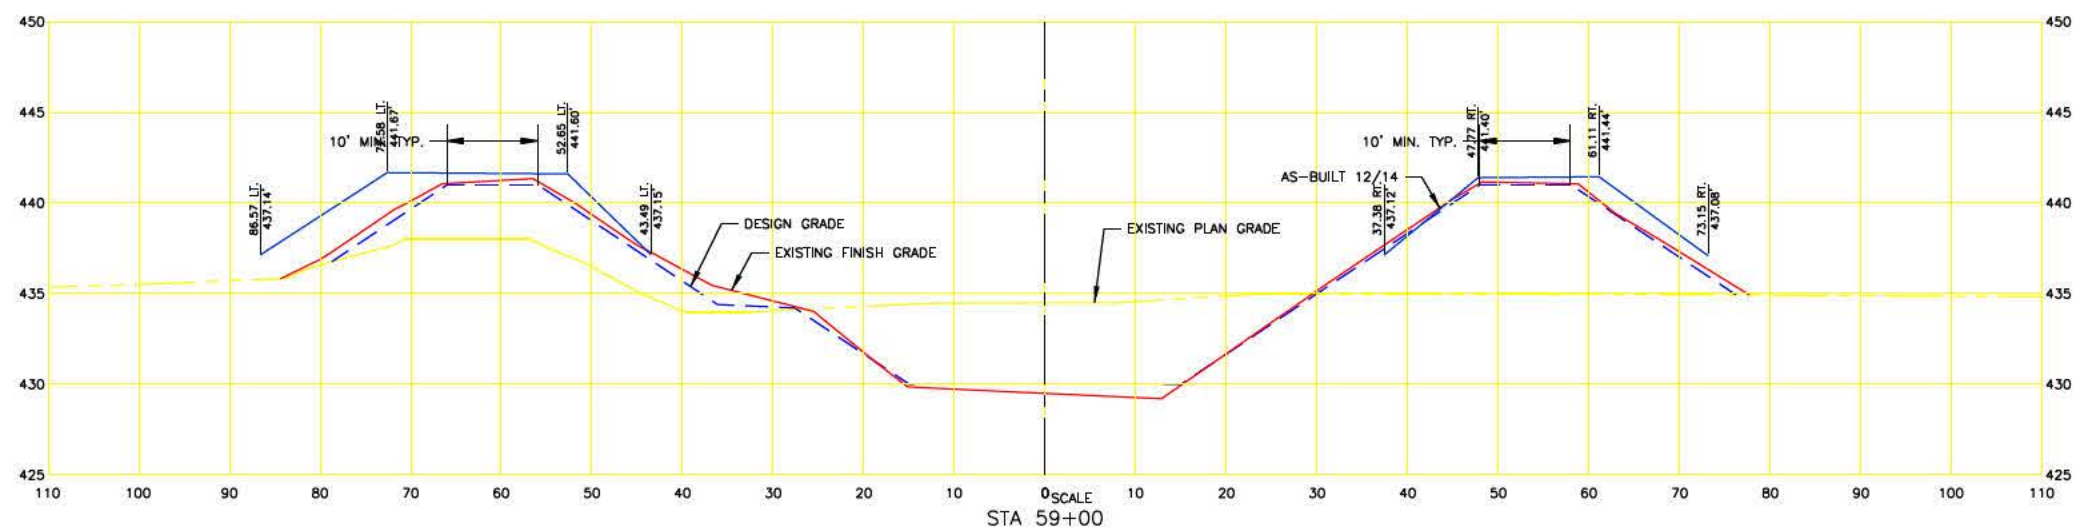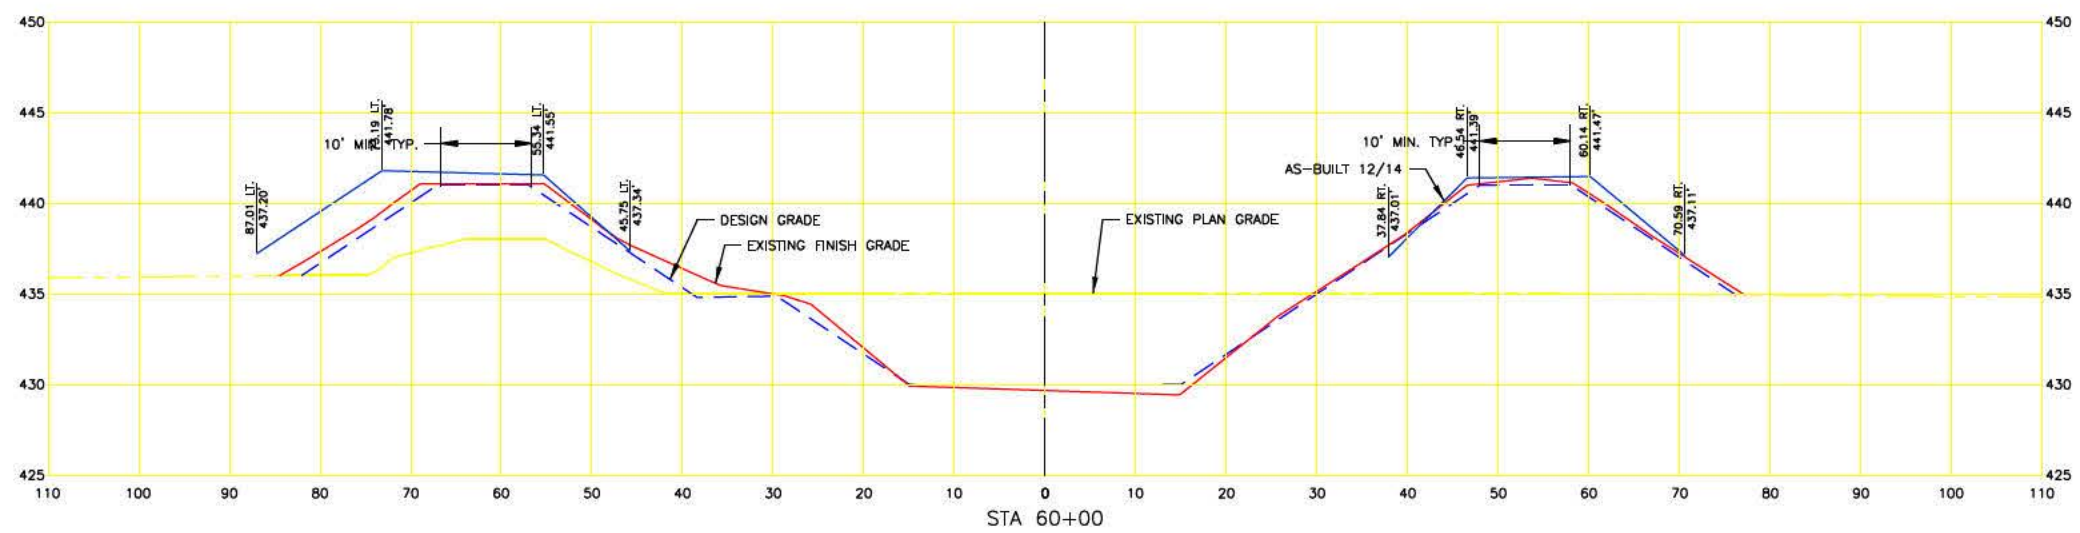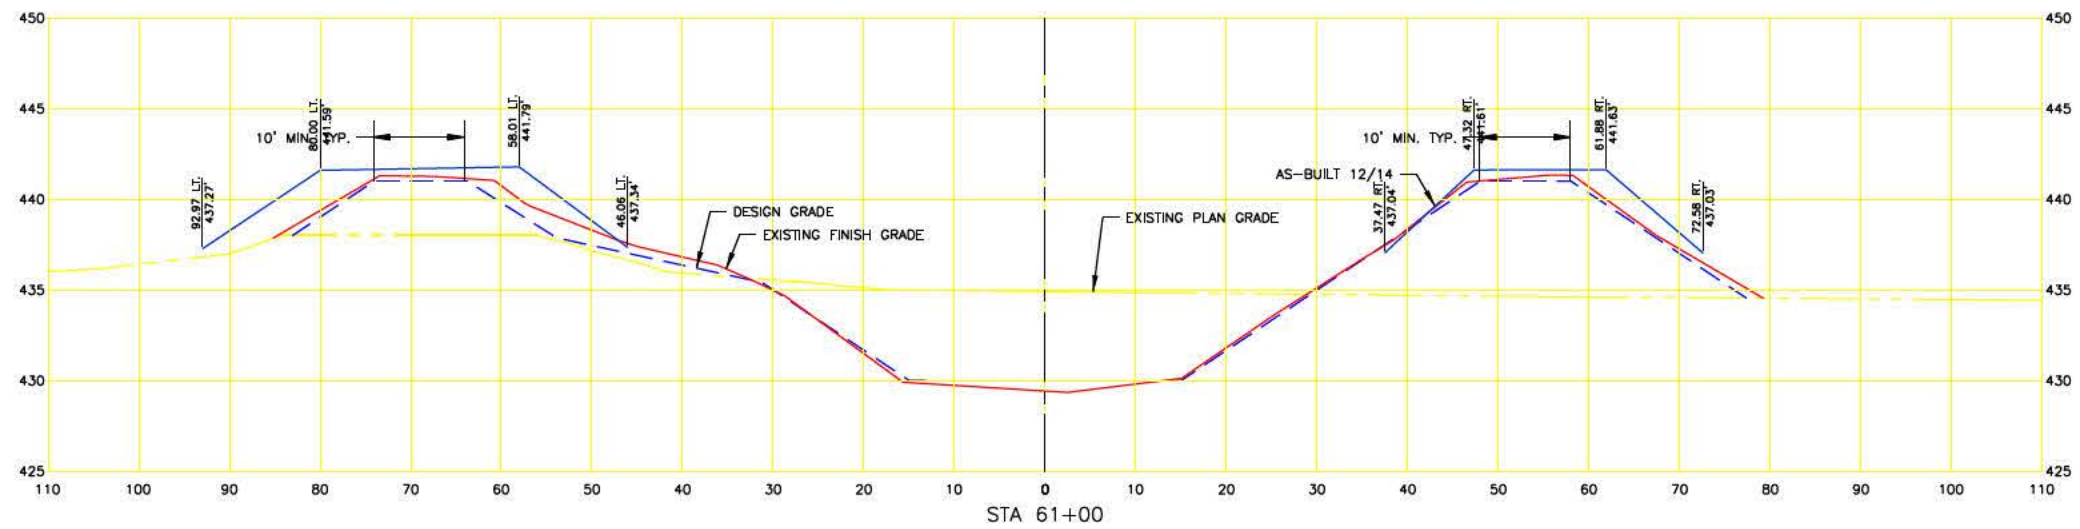

SURVEY DATA REFERENCES GEOD 09.  
CONTROL POINTS REFERENCED FOR THIS SURVEY:  
CP 1, CP 2, CP 20 AND CP 21  
(AS SUPPLIED BY FISCHER EXCAVATING)

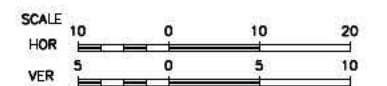

**FEHR GRAHAM**  
ENGINEERING & ENVIRONMENTAL  
ILLINOIS DESIGN FIRM NO. 184-003525

ILLINOIS  
IOWA  
WISCONSIN

OWNER/DEVELOPER:  
FISCHER EXCAVATING  
1567 HEINE ROAD  
FREEPORT, IL 61032

PROJECT AND LOCATION:  
RICE LAKE  
DISCHARGE CHANNEL  
FINAL CROSS SECTIONS




DRAWN BY: JJS  
APPROVED BY: NAG  
DATE: 1/20/15  
SCALE: 1" = 10'  
1" = 5'

REV. NO.	DESCRIPTION	DATE


DRAWING:  
SECTION SHEET - (17)

JOB NUMBER:  
14-1066

SHEET NUMBER:  
17 of 20

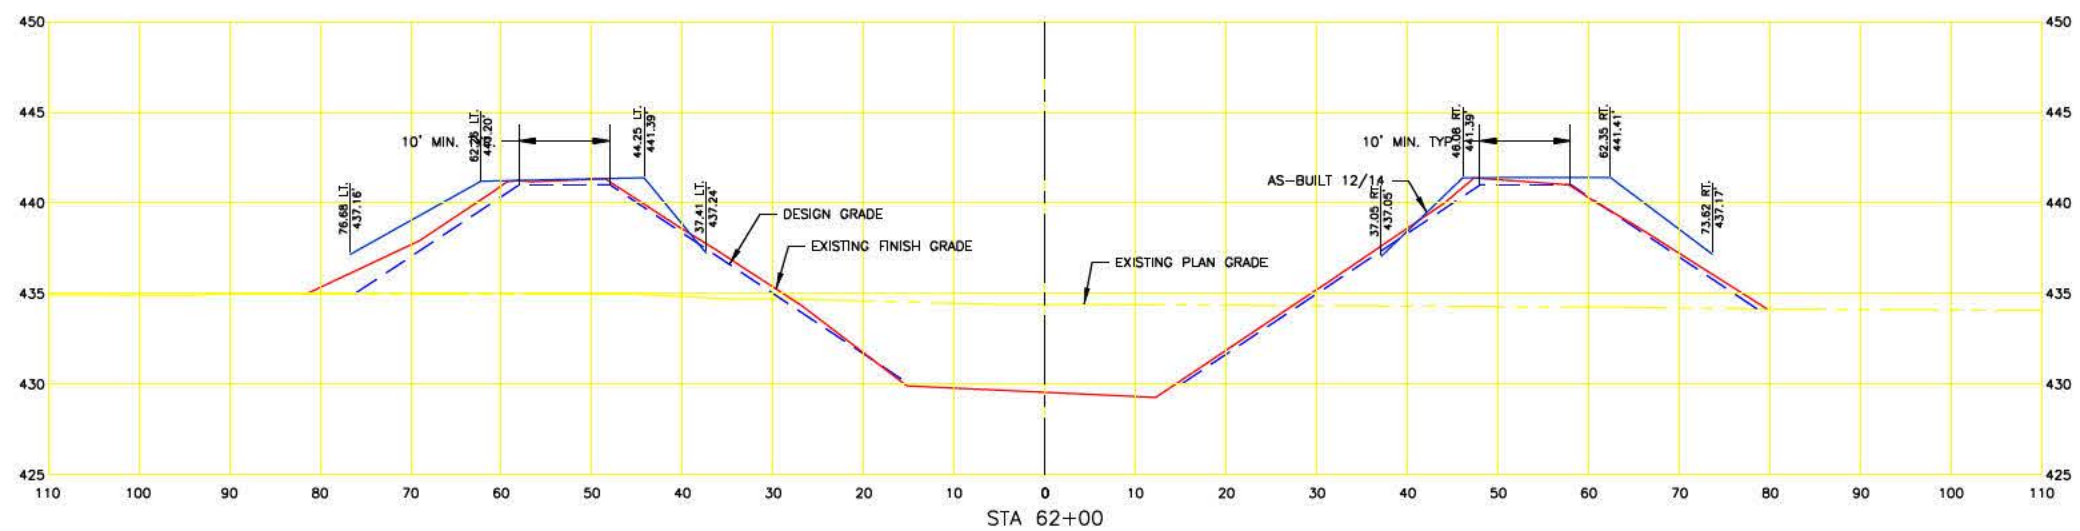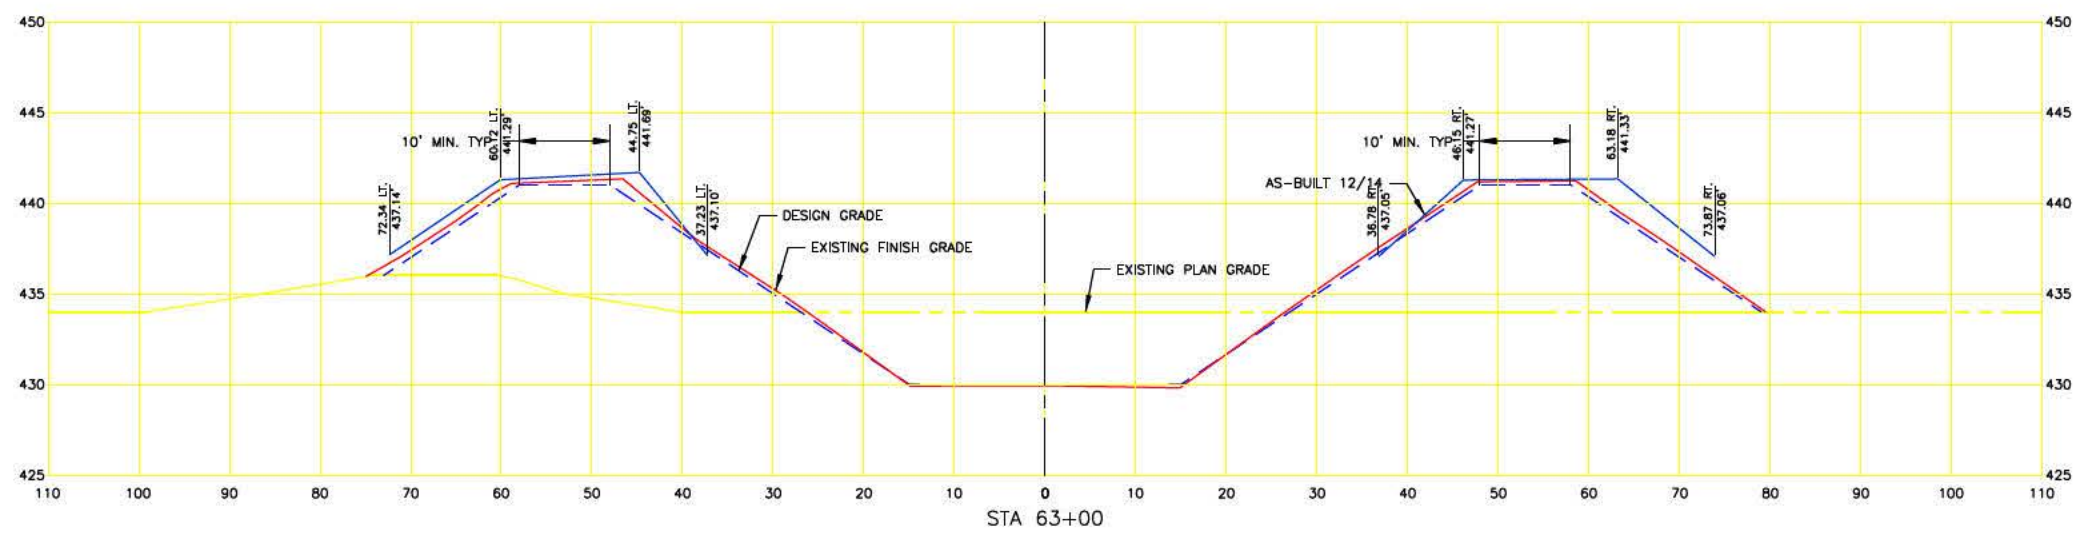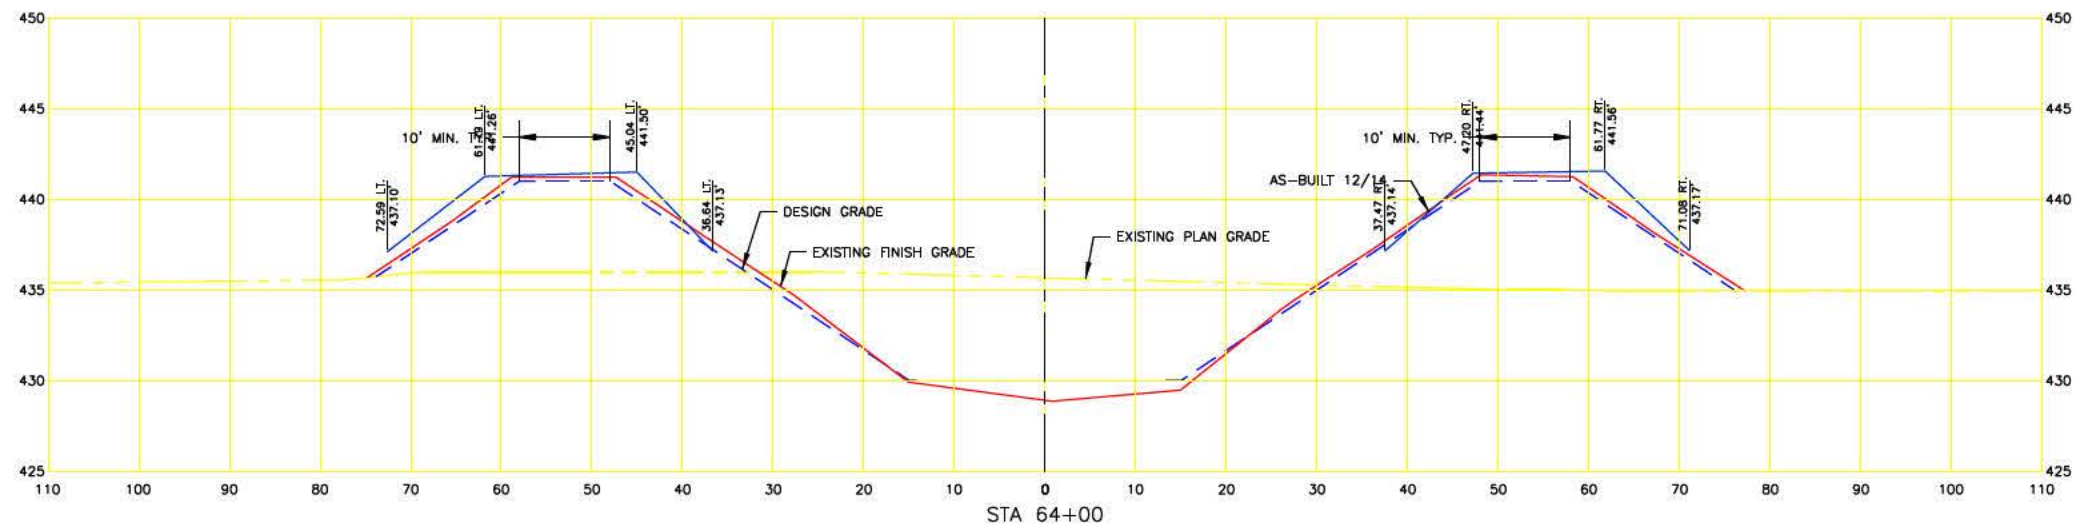

SURVEY DATA REFERENCES GEOD 09.  
 CONTROL POINTS REFERENCED FOR THIS SURVEY:  
 CP 1, CP 2, CP 20 AND CP 21  
 (AS SUPPLIED BY FISCHER EXCAVATING)

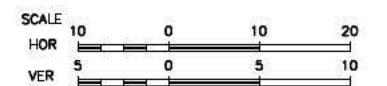

**FEHR GRAHAM**  
 ENGINEERING & ENVIRONMENTAL  
 ILLINOIS DESIGN FIRM NO. 184-003525

ILLINOIS  
 IOWA  
 WISCONSIN

OWNER/DEVELOPER:  
 FISCHER EXCAVATING  
 1567 HEINE ROAD  
 FREEPORT, IL 61032

PROJECT AND LOCATION:  
 RICE LAKE  
 DISCHARGE CHANNEL  
 FINAL CROSS SECTIONS

DRAWN BY: JJS  
 APPROVED BY: NAG  
 DATE: 1/20/15  
 SCALE: 1" = 10'  
 1" = 5'




REVISIONS		
REV. NO.	DESCRIPTION	DATE

DRAWING:  
 SECTION SHEET - (18)


JOB NUMBER:  
 14-1066

SHEET NUMBER:  
 18 of 20



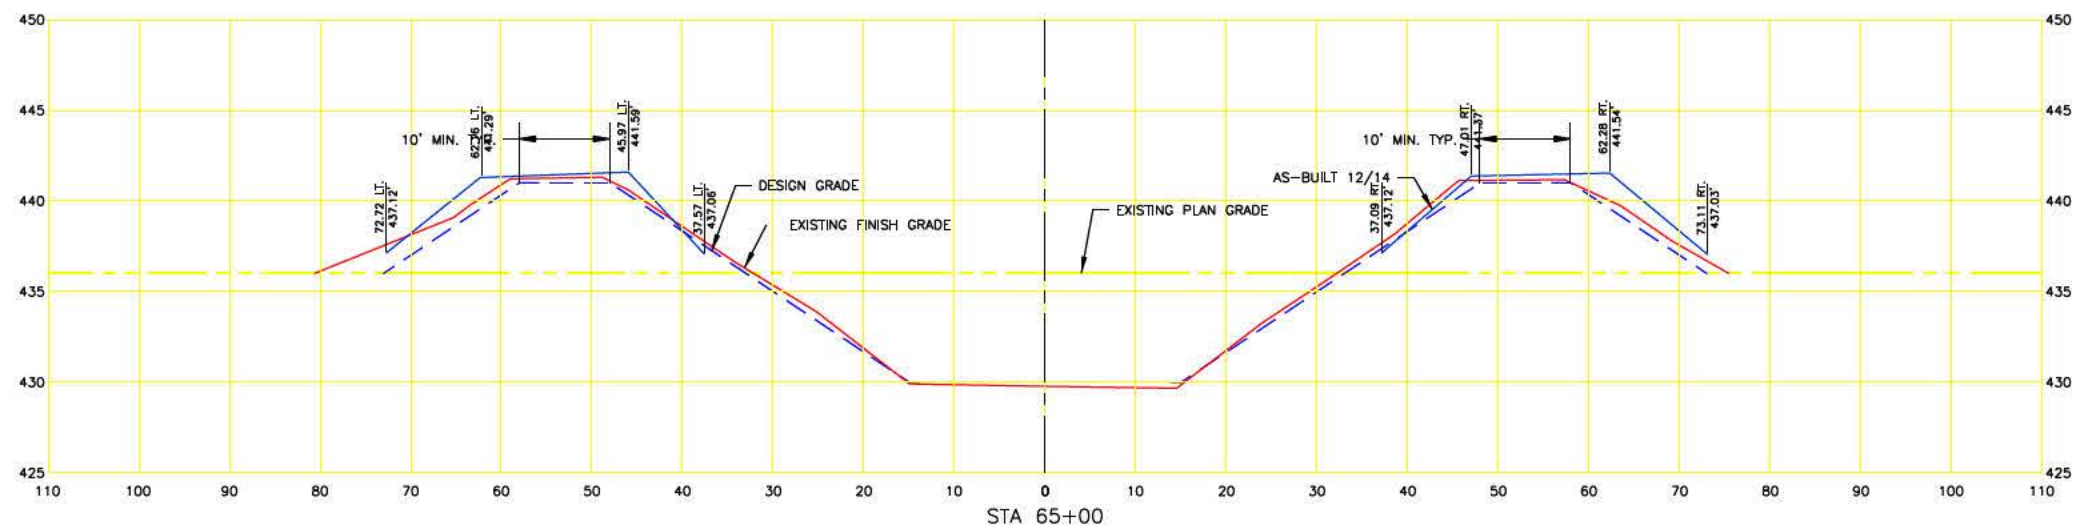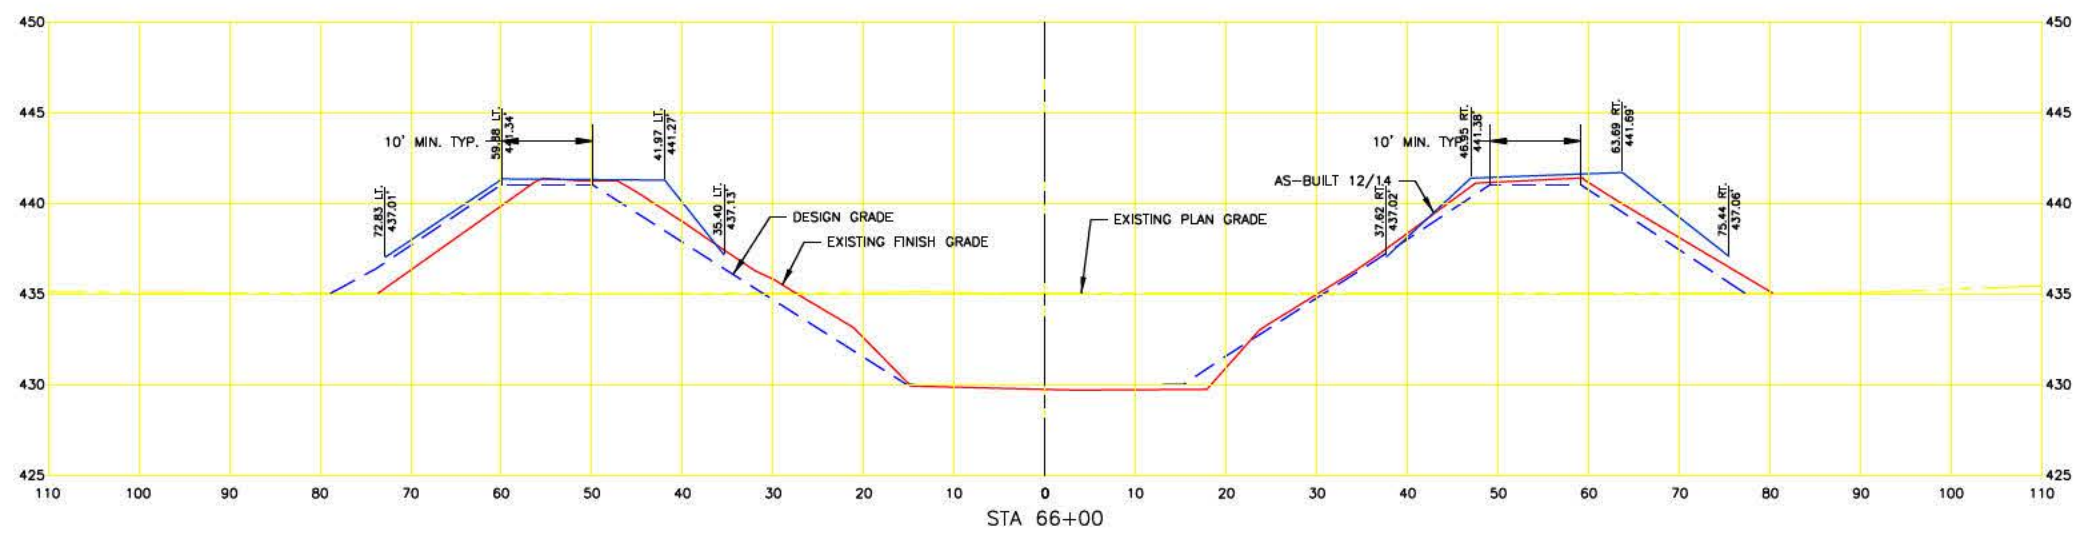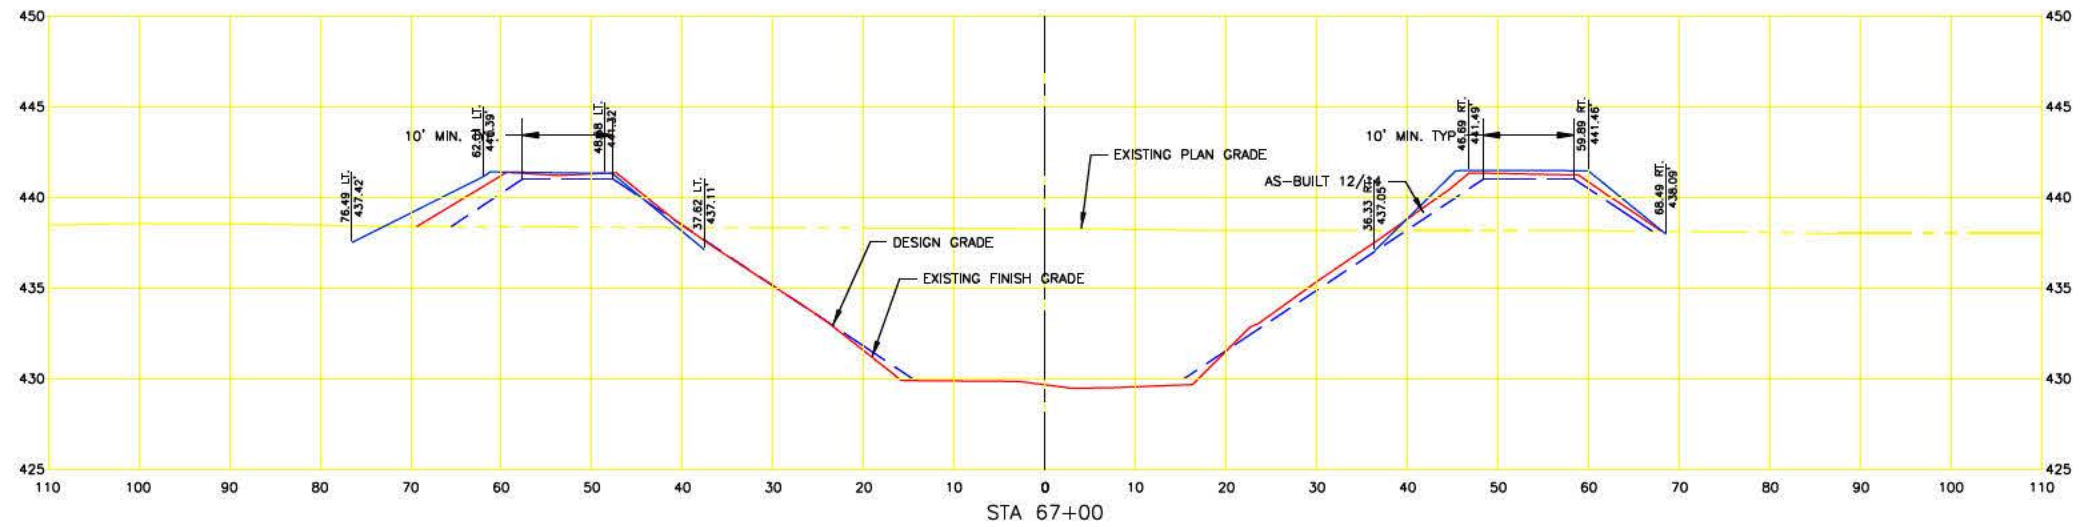

SURVEY DATA REFERENCES GEOD 09.  
 CONTROL POINTS REFERENCED FOR THIS SURVEY:  
 CP 1, CP 2, CP 20 AND CP 21  
 (AS SUPPLIED BY FISCHER EXCAVATING)

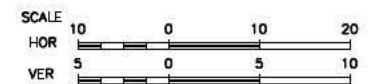

**FEHR GRAHAM**  
 ENGINEERING & ENVIRONMENTAL  
 ILLINOIS DESIGN FIRM NO. 184-003525

ILLINOIS  
 IOWA  
 WISCONSIN

OWNER/DEVELOPER:  
 FISCHER EXCAVATING  
 1567 HEINE ROAD  
 FREEPORT, IL 61032

PROJECT AND LOCATION:  
 RICE LAKE  
 DISCHARGE CHANNEL  
 FINAL CROSS SECTIONS


DRAWN BY: JJS  
 APPROVED BY: NAG  
 DATE: 1/20/15  
 SCALE: 1" = 10'  
 1" = 5'

REV. NO.	DESCRIPTION	DATE


DRAWING:  
 SECTION SHEET - (19)

JOB NUMBER:  
 14-1066

SHEET NUMBER:  
 19 of 20

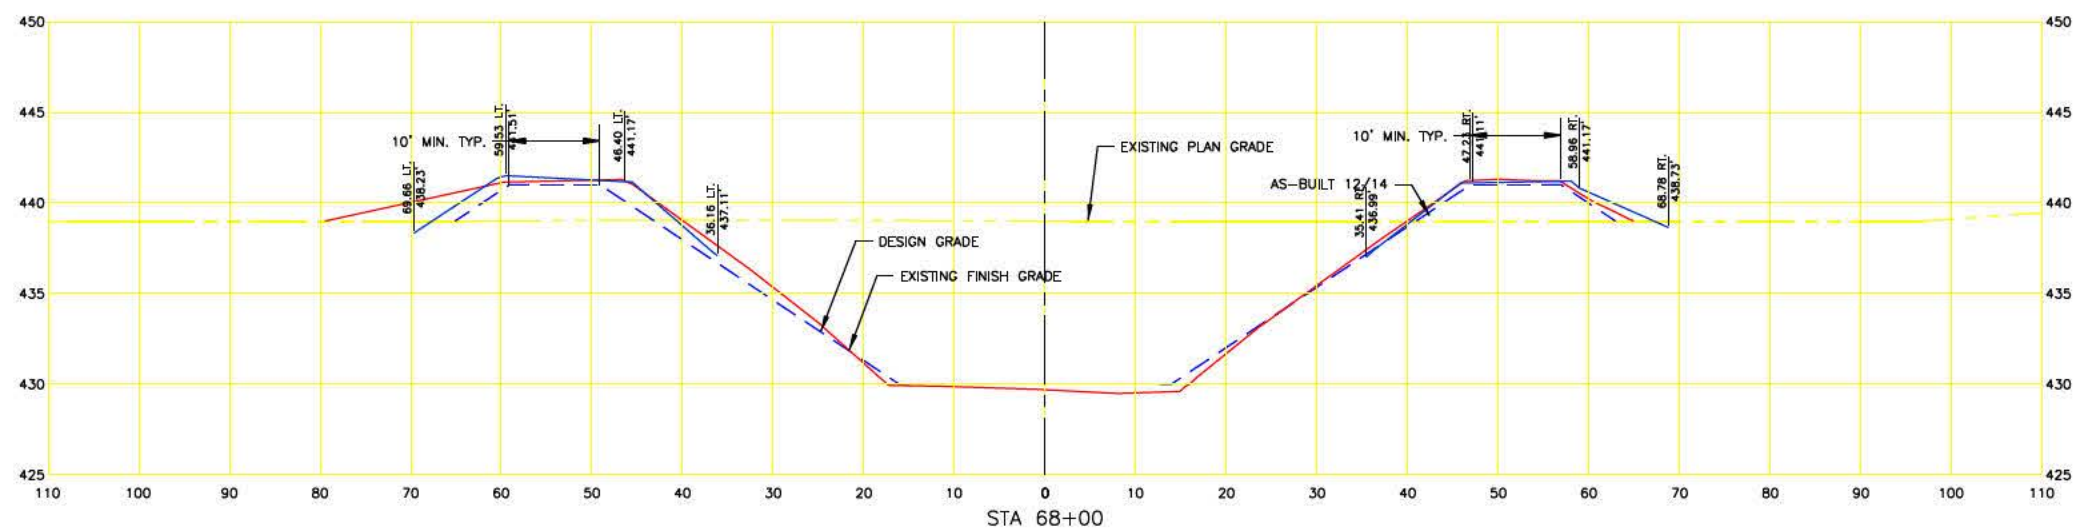

SURVEY DATA REFERENCES GEOID 09.  
 CONTROL POINTS REFERENCED FOR THIS SURVEY:  
 CP 1, CP 2, CP 20 AND CP 21  
 (AS SUPPLIED BY FISCHER EXCAVATING)

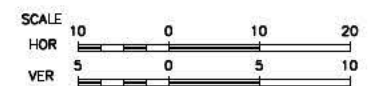

**FEHR GRAHAM**  
 ENGINEERING & ENVIRONMENTAL  
 ILLINOIS DESIGN FIRM NO. 184-003525

ILLINOIS  
 IOWA  
 WISCONSIN

OWNER/DEVELOPER:  
 FISCHER EXCAVATING  
 1567 HEINE ROAD  
 FREEPORT, IL 61032

PROJECT AND LOCATION:  
 RICE LAKE  
 DISCHARGE CHANNEL  
 FINAL CROSS SECTIONS

DRAWN BY: JJS  
 APPROVED BY: NAG  
 DATE: 1/20/15  
 SCALE: 1" = 10'  
 1" = 5'

REVISIONS		
REV. NO.	DESCRIPTION	DATE

DRAWING:  
 SECTION SHEET - (20)

JOB NUMBER:  
 14-1066

SHEET NUMBER:  
 20 of 20



**OPERATION AND MAINTENANCE MANUAL**  
**RICE LAKE STATE FISH AND WILDLIFE AREA**  
**UPPER MISSISSIPPI RIVER RESTORATION**  
**HABITAT REHABILITATION AND ENHANCEMENT PROJECT**  
**FULTON COUNTY, ILLINOIS**

**SEPTEMBER 2021**

**APPENDIX B**

**PROJECT PARTNERSHIP AGREEMENT**  
**AND**  
**RIGHT OF WAY DRAWINGS**



DEPARTMENT OF THE ARMY  
OFFICE OF THE ASSISTANT SECRETARY  
CIVIL WORKS  
108 ARMY PENTAGON  
WASHINGTON DC 20310-0108


JUL 20 2011

MEMORANDUM FOR THE DIRECTOR OF CIVIL WORKS

SUBJECT: Rice Lake, Illinois, Upper Mississippi River Restoration - Environmental Management Program, Project Partnership Agreement

This responds to a memorandum from the Chief of the Mississippi Valley Division Regional Integration Team dated July 6, 2011, requesting approval of subject draft agreement.

The draft agreement is approved. Authority to sign the final agreement on behalf of the Department of the Army is hereby delegated to the district commander.

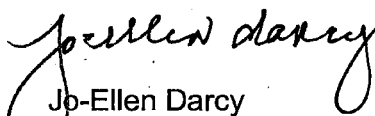  
Jo-Ellen Darcy  
Assistant Secretary of the Army  
(Civil Works)



PROJECT PARTNERSHIP AGREEMENT  
BETWEEN  
THE DEPARTMENT OF THE ARMY  
AND  
ILLINOIS DEPARTMENT OF NATURAL RESOURCES  
FOR  
DESIGN AND CONSTRUCTION  
OF THE  
RICE LAKE STATE FISH AND WILDLIFE AREA HABITAT REHABILITATION  
AND ENHANCEMENT PROJECT, FULTON COUNTY, ILLINOIS

THIS AGREEMENT is entered into this 27<sup>th</sup> day of July, 2011, by and between the Department of the Army (hereinafter the "Government"), represented by the Assistant Secretary of the Army (Civil Works) and Illinois Department of Natural Resources (hereinafter the "Non-Federal Sponsor"), represented by the Director.

WITNESSETH, THAT:

WHEREAS, design and construction of the Rice Lake State Fish and Wildlife Area Habitat Rehabilitation and Enhancement Project for fish and wildlife habitat rehabilitation and enhancement (hereinafter the "*Project*", as defined in Article I.A. of this Agreement) in Fulton County, Illinois, along the Illinois Waterway between river miles 132.0 and 138.0 was approved by the Commander, Mississippi Valley Division on April 10, 2011, pursuant to the authority contained in Section 1103(e)(1)(A)(i) of the Water Resources Development Act of 1986, Public Law 99-662, as amended (33 U.S.C. 652(e)(1)(A)(i); hereinafter "Section 1103 HREP");

WHEREAS, Section 1103(e)(3) of the Water Resources Development Act of 1986, Public Law 99-662, as amended (33 U.S.C. 652(e)(3)), provides that \$22,750,000 in Federal funds are authorized to be appropriated for Fiscal Year 1999 and each *fiscal year* thereafter for the purposes of carrying the Section 1103 HREP program for the planning, construction, and evaluation of measures for fish and wildlife habitat rehabilitation and enhancement;

WHEREAS, the Government and the Non-Federal Sponsor desire to enter into a Project Partnership Agreement (hereinafter the "Agreement") for design and construction of the *Project*;

WHEREAS, Section 1103(e)(7)(A) of the Water Resources Development Act of 1986, Public Law 99-662, as amended (33 U.S.C. 652(e)(7)(A)), specifies the cost-sharing requirements applicable to the *Project*;

WHEREAS, performance of *monitoring* (as defined in Article I.M. of this Agreement) of the *Project* will be conducted at Federal expense through the Upper Mississippi River Restoration-Environmental Management Program-Long Term Resource Monitoring Program pursuant to Section 1103(e)(1)(A)(ii) of the Water

Resources Development Act of 1986, Public Law 99-662, as amended (33 U.S.C. 652(e)(1)(A)(ii));

WHEREAS, Section 221 of the Flood Control Act of 1970, Public Law 91-611, as amended (42 U.S.C. 1962d-5b), and Section 103(j) of the Water Resources Development Act of 1986, Public Law 99-662, as amended (33 U.S.C. 2213(j)), provide, *inter alia*, that the Secretary of the Army shall not commence construction of any water resources project, or separable element thereof, until each non-Federal interest has entered into a written agreement to furnish its required cooperation for the project or separable element;

WHEREAS, the Government and Non-Federal Sponsor have the full authority and capability to perform as hereinafter set forth and intend to cooperate in cost-sharing and financing of the *Project* in accordance with the terms of this Agreement; and

WHEREAS, the Government and the Non-Federal Sponsor, in connection with this Agreement, desire to foster a partnering strategy and a working relationship between the Government and the Non-Federal Sponsor through a mutually developed formal strategy of commitment and communication embodied herein, which creates an environment where trust and teamwork prevent disputes, foster a cooperative bond between the Government and the Non-Federal Sponsor, and facilitate the successful implementation of the *Project*.

NOW, THEREFORE, the Government and the Non-Federal Sponsor agree as follows:

#### ARTICLE I - DEFINITIONS

A. The term "*Project*" shall mean a perimeter water control spillway and installing one gatewell structure, providing water control capability by constructing a pump station and excavating a discharge channel, installing two reinforced concrete fish egress structures, and enhancing floodplain habitat by planting 352 acres of mast producing trees and 57 acres of wet-mesic herbaceous plants on Duck Island on the right descending bank of the Illinois Waterway between river miles 132.0 and 138.0 in Fulton County, Illinois, as generally described in the Upper Mississippi River System Environmental Management Program Definite Project Report With Integrated Environmental Assessment (R-17F) for the Rice Lake State Fish and Wildlife Area Habitat Rehabilitation and Enhancement Project, dated March 2011, and approved by the Commander, Mississippi Valley Division on April 10, 2011.

B. The term "*total project costs*" shall mean the sum of all costs incurred by the Non-Federal Sponsor and the Government in accordance with the terms of this Agreement directly related to design and construction of the *Project* and the *pre-Agreement planning and design costs* incurred by the Government. Subject to the provisions of this Agreement, the term shall include, but is not necessarily limited to: the Government's *pre-Agreement planning and design costs* and the Government's design costs incurred after the effective date of this Agreement; the Government's costs of preparation of environmental



compliance documentation in accordance with Article II.A.2. of this Agreement; the Government's engineering and design costs during construction; the Non-Federal Sponsor's and the Government's costs of investigations to identify the existence and extent of hazardous substances in accordance with Article XIV.A. of this Agreement; the Government's costs of historic preservation activities in accordance with Article XVII.A. and Article XVII.B.1. of this Agreement; the Government's actual construction costs; the Government's supervision and administration costs; the Non-Federal Sponsor's and the Government's costs of participation in the Project Coordination Team in accordance with Article V of this Agreement; the Government's costs of contract dispute settlements or awards; the value of lands, easements, rights-of-way, *relocations*, and improvements required on lands, easements, and rights-of-way to enable the disposal of dredged or excavated material for which the Government affords credit in accordance with Article IV of this Agreement or for which reimbursement by the Government is required pursuant to Article II.B.3. of this Agreement; and the Non-Federal Sponsor's and the Government's costs of audit in accordance with Article X.B. and Article X.C. of this Agreement. The term does not include any costs of *monitoring*; any costs for operation, maintenance, repair, rehabilitation, or replacement of the *Project*; any costs of *betterments* under Article II.H.2. of this Agreement; any costs of dispute resolution under Article VII of this Agreement; the Government's costs for data recovery activities associated with historic preservation in accordance with Article XVII.B.2. and Article XVII.B.3. of this Agreement; or the Non-Federal Sponsor's costs of negotiating this Agreement.

C. The term "*period of design and construction*" shall mean the time from the effective date of this Agreement to the date that construction of the *Project* is complete, as determined by the Government, or the date that this Agreement is terminated in accordance with Article XIII or Article XIV.C. of this Agreement, whichever is earlier.

D. The term "*financial obligations for design and construction*" shall mean the financial obligations of the Government that result or would result in costs that are or would be included in *total project costs* except for obligations pertaining to the provision of lands, easements, and rights-of-way, the performance of *relocations*, and the construction of improvements required on lands, easements, and rights-of-way to enable the disposal of dredged or excavated material.

E. The term "*non-Federal proportionate share*" shall mean the ratio of the Non-Federal Sponsor's total contribution of funds required by Article II.B.2. of this Agreement to *financial obligations for design and construction*, as projected by the Government.

F. The term "*highway*" shall mean any highway, roadway, street, or way, including any bridge thereof, that is owned by a public entity.

G. The term "*relocation*" shall mean providing a functionally equivalent facility to the owner of a utility, cemetery, *highway*, railroad, or public facility when such action is authorized in accordance with applicable legal principles of just compensation. Providing a functionally equivalent facility may take the form of alteration, lowering, raising, or replacement and attendant demolition of the affected facility or part thereof.

H. The term “*functional portion of the Project*” shall mean a portion of the *Project* for which construction has been completed and that can function independently, as determined by the U.S. Army Engineer, Rock Island District (hereinafter the “District Engineer”) in writing, although the remainder of the *Project* is not complete.

I. The term “*betterment*” shall mean a difference in the design or construction of an element of the *Project* that results from the application of standards that the Government determines exceed those that the Government would otherwise apply to the design or construction of that element. The term does not include any design or construction for features not included in the *Project* as defined in paragraph A. of this Article.

J. The term “*Federal program funds*” shall mean funds provided by a Federal agency, other than the Department of the Army, plus any non-Federal contribution required as a matching share therefor.

K. The term “*fiscal year*” shall mean one year beginning on October 1 and ending on September 30.

L. The term “*pre-Agreement planning and design costs*” shall mean all costs that were incurred by the Government prior to the effective date of this Agreement for planning and design of the *Project*.

M. The term “*monitoring*” shall mean activities, including the collection and analysis of data, that are necessary to determine if predicted outputs of the *Project* are being achieved.

N. The term “*Section 1103 HREP Annual Program Limit*” shall mean the statutory limitation on the Government’s annual appropriations for planning, design, and construction of all projects implemented pursuant to Section 1103(e)(1)(A)(i) of the Water Resources Development Act of 1986, Public Law 99-662, as amended (33 U.S.C. 652(e)(1)(A)(i)). As of the effective date of this Agreement, such limitation is \$22,750,000.

## ARTICLE II - OBLIGATIONS OF THE GOVERNMENT AND THE NON-FEDERAL SPONSOR

A. The Government, subject to receiving funds appropriated by the Congress of the United States (hereinafter the “Congress”) and using those funds and funds provided by the Non-Federal Sponsor, expeditiously shall design and construct the *Project*, applying those procedures usually applied to Federal projects, in accordance with Federal laws, regulations, and policies.

1. The Government shall not issue the solicitation for the first contract for design of the *Project* or commence design of the *Project* using the Government’s own



forces until the Non-Federal Sponsor has confirmed in writing its willingness to proceed with the *Project*.

2. The Government shall develop and coordinate as required, an Environmental Assessment and Finding of No Significant Impact or an Environmental Impact Statement and Record of Decision, as necessary, to inform the public regarding the environmental impacts of the *Project* in accordance with the National Environmental Policy Act of 1969 (42 U.S.C. 4321–4347; hereinafter “NEPA”). However, the Government shall not issue the solicitation for the first construction contract for the *Project* or commence construction of the *Project* using the Government’s own forces until all applicable environmental laws and regulations have been complied with, including, but not limited to NEPA and Section 401 of the Federal Water Pollution Control Act (33 U.S.C. 1341).

3. The Government shall afford the Non-Federal Sponsor the opportunity to review and comment on the solicitations for all contracts, including relevant plans and specifications, prior to the Government’s issuance of such solicitations. To the extent possible, the Government shall afford the Non-Federal Sponsor the opportunity to review and comment on all proposed contract modifications, including change orders. In any instance where providing the Non-Federal Sponsor with notification of a contract modification is not possible prior to execution of the contract modification, the Government shall provide such notification in writing at the earliest date possible. To the extent possible, the Government also shall afford the Non-Federal Sponsor the opportunity to review and comment on all contract claims prior to resolution thereof. The Government shall consider in good faith the comments of the Non-Federal Sponsor, but the contents of solicitations, award of contracts or commencement of design or construction using the Government’s own forces, execution of contract modifications, resolution of contract claims, and performance of all work on the *Project* shall be exclusively within the control of the Government.

4. At the time the District Engineer furnishes the contractor with the Government’s Written Notice of Acceptance of Completed Work for each contract awarded by the Government for the *Project*, the District Engineer shall furnish a copy thereof to the Non-Federal Sponsor.

B. The Non-Federal Sponsor shall contribute 35 percent of *total project costs* in accordance with the provisions of this paragraph.

1. In accordance with Article III of this Agreement, the Non-Federal Sponsor shall provide all lands, easements, and rights-of-way, including those required for *relocations*, the borrowing of material, and the disposal of dredged or excavated material, shall perform or ensure performance of all *relocations*, and shall construct improvements required on lands, easements, and rights-of-way to enable the disposal of dredged or excavated material that the Government determines to be required or to be necessary for construction, operation, and maintenance of the *Project*.

2. The Non-Federal Sponsor shall provide funds in accordance with Article VI.B. of this Agreement in the amount necessary to meet the Non-Federal Sponsor's required share of 35 percent of *total project costs* if the Government projects at any time that the collective value of the following contributions will be less than such required share: (a) the value of the Non-Federal Sponsor's contributions under paragraph B.1. of this Article as determined in accordance with Article IV of this Agreement; and (b) the value of the Non-Federal Sponsor's contributions under Article V, Article X, and Article XIV.A. of this Agreement.

3. The Government, subject to the availability of funds and as limited by the *Section 1103 HREP Annual Program Limit*, shall refund or reimburse to the Non-Federal Sponsor any contributions in excess of 35 percent of *total project costs* if the Government determines at any time that the collective value of the following contributions has exceeded 35 percent of *total project costs*: (a) the value of the Non-Federal Sponsor's contributions under paragraph B.1. of this Article as determined in accordance with Article IV of this Agreement; (b) the value of the Non-Federal Sponsor's contributions under paragraph B.2. of this Article; and (c) the value of the Non-Federal Sponsor's contributions under Article V, Article X, and Article XIV.A. of this Agreement. After such a determination, the Government, in its sole discretion, may acquire any remaining lands, easements, and rights-of-way required for the *Project*, perform any remaining *relocations* necessary for the *Project*, or construct any remaining improvements required on lands, easements, and rights-of-way to enable the disposal of dredged or excavated material required for the *Project* on behalf of the Non-Federal Sponsor. Notwithstanding the acquisition of lands, easements, and rights-of-way, performance of *relocations*, or construction of improvements required on lands, easements, and rights-of-way to enable the disposal of dredged or excavated material by the Government under this paragraph, the Non-Federal Sponsor shall be responsible, as between the Government and the Non-Federal Sponsor, for any costs of cleanup and response in accordance with Article XIV.C. of this Agreement.

C. Notwithstanding any other provision of this Agreement, Federal financial participation in the *Project* is limited by the following provisions of this paragraph.

1. In the event the Government projects that the amount of Federal funds the Government will make available to the *Project* through the then-current *fiscal year*, or the amount of Federal funds the Government will make available for the *Project* through the upcoming *fiscal year*, is not sufficient to meet the Federal share of *total project costs* and the Federal share of costs for data recovery activities associated with historic preservation in accordance with Article XVII.B.2. and Article XVII.B.3. of this Agreement that the Government projects to be incurred through the then-current or upcoming *fiscal year*, as applicable, the Government shall notify the Non-Federal Sponsor in writing of such insufficiency of funds and of the date the Government projects that the Federal funds that will have been made available to the *Project* will be exhausted. Upon the exhaustion of Federal funds made available by the Government to the *Project*, future performance under this Agreement shall be suspended and the parties shall proceed in accordance with Article XIII.B. of this Agreement.



2. As of the effective date of this Agreement, \$13,495,099 is currently projected to be available for the *Project*. The Government makes no commitment to request Congress to provide additional Federal funds for the *Project*. Further, the Government's financial participation in the *Project* is limited to the Federal funds that the Government makes available to the *Project*.

D. When the District Engineer determines that the entire *Project*, or a *functional portion of the Project*, is complete, the District Engineer shall so notify the Non-Federal Sponsor in writing and furnish the Non-Federal Sponsor with a final Operation, Maintenance, Repair, Rehabilitation, and Replacement Manual (hereinafter the "OMRR&R Manual") or, if the final OMRR&R Manual is not available, an interim OMRR&R Manual for the entire *Project* or such completed portion. Upon such notification, the Government also shall furnish to the Non-Federal Sponsor a copy of all final as-built drawings for the entire *Project* or such completed portion if such drawings are available. Not later than 6 months after such notification by the Government that the entire *Project* is complete, the Government shall furnish the Non-Federal Sponsor with the final OMRR&R Manual and all final as-built drawings for the entire *Project*. In the event the final OMRR&R Manual or all final as-built drawings for the entire *Project* cannot be completed within the 6 month period, the Government shall provide written notice to the Non-Federal Sponsor, and the Government and the Non-Federal Sponsor shall negotiate an acceptable completion date for furnishing such documents. Further, after completion of all contracts for the *Project*, copies of all of the Government's Written Notices of Acceptance of Completed Work for all contracts for the *Project* that have not been provided previously shall be provided to the Non-Federal Sponsor.

E. Upon notification from the District Engineer in accordance with paragraph D. of this Article, the Non-Federal Sponsor shall operate, maintain, repair, rehabilitate, and replace the entire *Project*, or the *functional portion of the Project* as the case may be, in accordance with Article VIII of this Agreement.

F. Upon conclusion of the *period of design and construction*, the Government shall conduct an accounting, in accordance with Article VI.C. of this Agreement, and furnish the results to the Non-Federal Sponsor.

G. The Non-Federal Sponsor shall not use *Federal program funds* to meet any of its obligations for the *Project* under this Agreement unless the Federal agency providing the Federal portion of such funds verifies in writing that expenditure of such funds for such purpose is expressly authorized by Federal law.

H. The Non-Federal Sponsor may request the Government to perform or provide, on behalf of the Non-Federal Sponsor, one or more of the services (hereinafter the "additional work") described in this paragraph. Such requests shall be in writing and shall describe the additional work requested to be performed or provided. If in its sole discretion the Government elects to perform or provide the requested additional work or any portion thereof, it shall so notify the Non-Federal Sponsor in a writing that sets forth any applicable terms and conditions, which must be consistent with this Agreement. In

the event of conflict between such a writing and this Agreement, this Agreement shall control. The Non-Federal Sponsor shall be solely responsible for all costs of the additional work performed or provided by the Government under this paragraph and shall pay all such costs in accordance with Article VI.D. of this Agreement.

1. Acquisition of lands, easements, and rights-of-way; performance of *relocations*; or construction of improvements required on lands, easements, and rights-of-way to enable the disposal of dredged or excavated material for the *Project*. Notwithstanding acquisition of lands, easements, and rights-of-way, performance of *relocations*, or construction of improvements by the Government, the Non-Federal Sponsor shall be responsible, as between the Government and the Non-Federal Sponsor, for any costs of cleanup and response in accordance with Article XIV.C. of this Agreement.

2. Inclusion of *betterments* in the design or construction of the *Project*. In the event the Government elects to include any such *betterments*, the Government shall allocate the costs of the *Project* features that include *betterments* between *total project costs* and the costs of the *betterments*.

I. The Non-Federal Sponsor shall prevent obstructions or encroachments on the *Project* (including prescribing and enforcing regulations to prevent such obstructions or encroachments) such as any new developments on *Project* lands, easements, and rights-of-way or the addition of facilities which might reduce the outputs produced by the *Project*, hinder operation and maintenance of the *Project*, or interfere with the *Project's* proper function.

J. The Non-Federal Sponsor shall not use the *Project*, or the lands, easements, and rights-of-way required pursuant to Article III of this Agreement, as a wetlands bank or mitigation credit for any other project.

### ARTICLE III - LANDS, EASEMENTS, RIGHTS-OF-WAY, RELOCATIONS, DISPOSAL AREA IMPROVEMENTS, AND COMPLIANCE WITH PUBLIC LAW 91-646, AS AMENDED

A. The Government, after consultation with the Non-Federal Sponsor, shall determine the lands, easements, and rights-of-way required for construction, operation, and maintenance of the *Project*, including those required for *relocations*, the borrowing of material, and the disposal of dredged or excavated material. The Government in a timely manner shall provide the Non-Federal Sponsor with general written descriptions, including maps as appropriate, of the lands, easements, and rights-of-way that the Government determines the Non-Federal Sponsor must provide, in detail sufficient to enable the Non-Federal Sponsor to fulfill its obligations under this paragraph, and shall provide the Non-Federal Sponsor with a written notice to proceed with acquisition of such lands, easements, and rights-of-way. Prior to the issuance of the solicitation for each Government contract for construction of the *Project*, or prior to the Government initiating construction of a



portion of the *Project* using the Government's own forces, the Non-Federal Sponsor shall acquire all lands, easements, and rights-of-way the Government determines the Non-Federal Sponsor must provide for that work and shall provide the Government with authorization for entry thereto. Furthermore, prior to the end of the *period of design and construction*, the Non-Federal Sponsor shall acquire all lands, easements, and rights-of-way required for construction, operation, and maintenance of the *Project*, as set forth in such descriptions, and shall provide the Government with authorization for entry thereto. The Non-Federal Sponsor shall ensure that lands, easements, and rights-of-way that the Government determines to be required for the *Project* and that were provided by the Non-Federal Sponsor are retained in public ownership for uses compatible with the authorized purposes of the *Project*.

B. The Government, after consultation with the Non-Federal Sponsor, shall determine the *relocations* necessary for construction, operation, and maintenance of the *Project*, including those necessary to enable the borrowing of material or the disposal of dredged or excavated material. The Government in a timely manner shall provide the Non-Federal Sponsor with general written descriptions, including maps as appropriate, of such *relocations* in detail sufficient to enable the Non-Federal Sponsor to fulfill its obligations under this paragraph, and shall provide the Non-Federal Sponsor with a written notice to proceed with such *relocations*. Prior to the issuance of the solicitation for each Government contract for construction of the *Project*, or prior to the Government initiating construction of a portion of the *Project* using the Government's own forces, the Non-Federal Sponsor shall prepare or ensure the preparation of plans and specifications for, and perform or ensure the performance of, all *relocations* the Government determines to be necessary for that work. Furthermore, prior to the end of the *period of design and construction*, the Non-Federal Sponsor shall perform or ensure performance of all *relocations* as set forth in such descriptions.

C. The Government, after consultation with the Non-Federal Sponsor, shall determine the improvements required on lands, easements, and rights-of-way to enable the disposal of dredged or excavated material associated with construction, operation, and maintenance of the *Project*. Such improvements may include, but are not necessarily limited to, retaining dikes, wasteweirs, bulkheads, embankments, monitoring features, stilling basins, and de-watering pumps and pipes. The Government in a timely manner shall provide the Non-Federal Sponsor with general written descriptions, including maps as appropriate, of such improvements in detail sufficient to enable the Non-Federal Sponsor to fulfill its obligations under this paragraph, and shall provide the Non-Federal Sponsor with a written notice to proceed with construction of such improvements. Prior to the issuance of the solicitation for each Government contract for construction of the *Project*, or prior to the Government initiating construction of a portion of the *Project* using the Government's own forces, the Non-Federal Sponsor shall prepare plans and specifications for all improvements the Government determines to be required for the disposal of dredged or excavated material under that contract, submit such plans and specifications to the Government for approval, and provide such improvements in accordance with the approved plans and specifications. Furthermore, prior to the end of the *period of design and*

*construction*, the Non-Federal Sponsor shall provide all improvements set forth in such descriptions.

D. The Non-Federal Sponsor shall comply with the applicable provisions of the Uniform Relocation Assistance and Real Property Acquisition Policies Act of 1970, Public Law 91-646, as amended (42 U.S.C. 4601-4655), and the Uniform Regulations contained in 49 C.F.R. Part 24, in acquiring lands, easements, and rights-of-way required for construction, operation, and maintenance of the *Project*, including those required for *relocations*, the borrowing of material, or the disposal of dredged or excavated material, and shall inform all affected persons of applicable benefits, policies, and procedures in connection with said Act.

#### ARTICLE IV - CREDIT FOR VALUE OF LANDS, EASEMENTS, RIGHTS-OF-WAY, RELOCATIONS, AND DISPOSAL AREA IMPROVEMENTS

A. The Government shall include in *total project costs* and afford credit toward the Non-Federal Sponsor's share of *total project costs* for the value of the lands, easements, and rights-of-way that the Non-Federal Sponsor must provide pursuant to Article III.A. of this Agreement; for the value of the *relocations* that the Non-Federal Sponsor must perform or for which it must ensure performance pursuant to Article III.B. of this Agreement; and for the value of the improvements required on lands, easements, and rights-of-way to enable the disposal of dredged or excavated material that the Non-Federal Sponsor must provide pursuant to Article III.C. of this Agreement. However, no amount shall be included in *total project costs*, no credit shall be afforded, and no reimbursement shall be provided for the value of any lands, easements, rights-of-way, *relocations*, or improvements required on lands, easements, and rights-of-way to enable the disposal of dredged or excavated material that have been provided previously as an item of cooperation for another Federal project. In addition, no amount shall be included in *total project costs*, no credit shall be afforded, and no reimbursement shall be provided for the value of lands, easements, rights-of-way, *relocations*, or improvements required on lands, easements, and rights-of-way to enable the disposal of dredged or excavated material that were acquired or performed using *Federal program funds* unless the Federal agency providing the Federal portion of such funds verifies in writing that affording credit for the value of such items is expressly authorized by Federal law.

B. The Non-Federal Sponsor in a timely manner shall provide the Government with such documents as are sufficient to enable the Government to determine the value of any contribution provided pursuant to Article III.A., Article III.B., or Article III.C. of this Agreement. Upon receipt of such documents, the Government in a timely manner shall determine the value of such contributions for the purpose of including such value in *total project costs* and for determining the amount of credit to be afforded or reimbursement to be provided in accordance with the provisions of this Agreement.

C. For the purposes of determining the value to be included in *total project costs* and the amount of credit to be afforded or reimbursement to be provided in accordance



with this Agreement and except as otherwise provided in paragraph G. of this Article, the value of lands, easements, and rights-of-way, including those required for *relocations*, the borrowing of material, and the disposal of dredged or excavated material, shall be the fair market value of the real property interests, plus certain incidental costs of acquiring those interests, as determined in accordance with the provisions of this paragraph.

1. Date of Valuation.

a. The fair market value of lands, easements, or rights-of-way owned by the Non-Federal Sponsor on the effective date of this Agreement shall be the fair market value of such real property interests as of the date the Non-Federal Sponsor provides the Government with authorization for entry thereto.

b. The fair market value of lands, easements, or rights-of-way acquired by the Non-Federal Sponsor after the effective date of this Agreement shall be the fair market value of such real property interests at the time the interests are acquired.

2. General Valuation Procedure. Except as provided in paragraph C.3. or paragraph C.5. of this Article, the fair market value of lands, easements, or rights-of-way shall be determined in accordance with the provisions of this paragraph.

a. The Non-Federal Sponsor shall obtain, for each real property interest, an appraisal that is prepared by a qualified appraiser who is acceptable to the Non-Federal Sponsor and the Government. The Non-Federal Sponsor shall provide the Government with the appraisal no later than 6 months after the Non-Federal Sponsor provides the Government with an authorization for entry for such real property interest. The appraisal must be prepared in accordance with the applicable rules of just compensation, as specified by the Government. The fair market value shall be the amount set forth in the Non-Federal Sponsor's appraisal, if such appraisal is approved by the Government. In the event the Government does not approve the Non-Federal Sponsor's appraisal, the Non-Federal Sponsor may obtain a second appraisal, and the fair market value shall be the amount set forth in the Non-Federal Sponsor's second appraisal, if such appraisal is approved by the Government. In the event the Government does not approve the Non-Federal Sponsor's second appraisal, the Non-Federal Sponsor chooses not to obtain a second appraisal, or the Non-Federal Sponsor does not provide the first appraisal as required in this paragraph, the Government shall obtain an appraisal, and the fair market value shall be the amount set forth in the Government's appraisal, if such appraisal is approved by the Non-Federal Sponsor. In the event the Non-Federal Sponsor does not approve the Government's appraisal, the Government, after consultation with the Non-Federal Sponsor, shall consider the Government's and the Non-Federal Sponsor's appraisals and determine an amount based thereon, which shall be deemed to be the fair market value.

b. Where the amount paid or proposed to be paid by the Non-Federal Sponsor for the real property interest exceeds the amount determined pursuant to paragraph C.2.a. of this Article, the Government, at the request of the Non-Federal Sponsor, shall consider all factors relevant to determining fair market value and, in its sole discretion, after

consultation with the Non-Federal Sponsor, may approve in writing an amount greater than the amount determined pursuant to paragraph C.2.a. of this Article, but not to exceed the amount actually paid or proposed to be paid. If the Government approves such an amount, the fair market value shall be the lesser of the approved amount or the amount paid by the Non-Federal Sponsor, but no less than the amount determined pursuant to paragraph C.2.a. of this Article.

3. Eminent Domain Valuation Procedure. For lands, easements, or rights-of-way acquired by eminent domain proceedings instituted after the effective date of this Agreement, the Non-Federal Sponsor, prior to instituting such proceedings, shall submit to the Government notification in writing of its intent to institute such proceedings and an appraisal of the specific real property interests to be acquired in such proceedings. The Government shall have 60 calendar days after receipt of such a notice and appraisal within which to review the appraisal, if not previously approved by the Government in writing.

a. If the Government previously has approved the appraisal in writing, or if the Government provides written approval of, or takes no action on, the appraisal within such 60 day period, the Non-Federal Sponsor shall use the amount set forth in such appraisal as the estimate of just compensation for the purpose of instituting the eminent domain proceeding.

b. If the Government provides written disapproval of the appraisal, including the reasons for disapproval, within such 60 day period, the Government and the Non-Federal Sponsor shall consult in good faith to promptly resolve the issues or areas of disagreement that are identified in the Government's written disapproval. If, after such good faith consultation, the Government and the Non-Federal Sponsor agree as to an appropriate amount, then the Non-Federal Sponsor shall use that amount as the estimate of just compensation for the purpose of instituting the eminent domain proceeding. If, after such good faith consultation, the Government and the Non-Federal Sponsor cannot agree as to an appropriate amount, then the Non-Federal Sponsor may use the amount set forth in its appraisal as the estimate of just compensation for the purpose of instituting the eminent domain proceeding.

c. For lands, easements, or rights-of-way acquired by eminent domain proceedings instituted in accordance with paragraph C.3. of this Article, fair market value shall be either the amount of the court award for the real property interests taken, to the extent the Government determined such interests are required for construction, operation, and maintenance of the *Project*, or the amount of any stipulated settlement or portion thereof that the Government approves in writing.

4. Incidental Costs. For lands, easements, or rights-of-way acquired by the Non-Federal Sponsor within a five year period preceding the effective date of this Agreement, or at any time after the effective date of this Agreement, the value of the interest shall include the documented incidental costs of acquiring the interest, as determined by the Government, subject to an audit in accordance with Article X.C. of this Agreement to determine reasonableness, allocability, and allowability of such costs. In the event the



Government modifies its determination made pursuant to Article III.A. of this Agreement, the Government shall afford credit for the documented incidental costs associated with preparing to acquire the lands, easements, or rights-of-way identified in the original determination, subject to an audit in accordance with Article X.C. of this Agreement to determine reasonableness, allocability, and allowability of such costs. Such incidental costs shall include, but not necessarily be limited to, closing and title costs, appraisal costs, survey costs, attorney's fees, plat maps, mapping costs, actual amounts expended for payment of any relocation assistance benefits provided in accordance with Article III.D. of this Agreement, and other payments by the Non-Federal Sponsor for items that are generally recognized as compensable, and required to be paid, by applicable state law due to the acquisition of a real property interest in accordance with Article III of this Agreement. The value of the interests provided by the Non-Federal Sponsor in accordance with Article III.A. of this Agreement also shall include the documented costs of obtaining appraisals pursuant to paragraph C.2. of this Article, as determined by the Government, and subject to an audit in accordance with Article X.C. of this Agreement to determine reasonableness, allocability, and allowability of such costs.

5. Waiver of Appraisal. Except as required by paragraph C.3. of this Article, the Government may waive the requirement for an appraisal pursuant to this paragraph if it determines that an appraisal is unnecessary because the valuation is uncomplicated and that the estimated fair market value of the real property interest is \$10,000 or less based upon a review of available data. In such event, the Government and the Non-Federal Sponsor must agree in writing to the value of such real property interest in an amount not in excess of \$10,000.

D. After consultation with the Non-Federal Sponsor, the Government shall determine the value of *relocations* in accordance with the provisions of this paragraph.

1. For a *relocation* other than a *highway*, the value shall be only that portion of *relocation* costs that the Government determines is necessary to provide a functionally equivalent facility, reduced by depreciation, as applicable, and by the salvage value of any removed items.

2. For a *relocation* of a *highway*, the value shall be only that portion of *relocation* costs that would be necessary to accomplish the *relocation* in accordance with the design standard that the State of Illinois would apply under similar conditions of geography and traffic load, reduced by the salvage value of any removed items.

3. *Relocation* costs shall include, but not necessarily be limited to, actual costs of performing the *relocation*; planning, engineering and design costs; supervision and administration costs; and documented incidental costs associated with performance of the *relocation*, as determined by the Government. *Relocation* costs shall not include any costs due to *betterments*, as determined by the Government, nor any additional cost of using new material when suitable used material is available. *Relocation* costs shall be subject to an audit in accordance with Article X.C. of this Agreement to determine reasonableness, allocability, and allowability of such costs.

E. The value of the improvements required on lands, easements, and rights-of-way to enable the disposal of dredged or excavated material shall be the costs of the improvements, as determined by the Government, subject to an audit in accordance with Article X.C. of this Agreement to determine reasonableness, allocability, and allowability of such costs. Such costs shall include, but not necessarily be limited to, actual costs of providing the improvements; planning, engineering and design costs; supervision and administration costs; and documented incidental costs associated with providing the improvements, but shall not include any costs due to *betterments*, as determined by the Government.

F. Any credit afforded or reimbursement provided under the terms of this Agreement for the value of *relocations*, or improvements required on lands, easements, and rights-of-way to enable the disposal of dredged or excavated material, performed within the *Project* boundaries is subject to satisfactory compliance with applicable Federal labor laws covering non-Federal construction, including, but not limited to, 40 U.S.C. 3141-3148 and 40 U.S.C. 3701-3708 (revising, codifying and enacting without substantive change the provisions of the Davis-Bacon Act (formerly 40 U.S.C. 276a *et seq.*), the Contract Work Hours and Safety Standards Act (formerly 40 U.S.C. 327 *et seq.*) and the Copeland Anti-Kickback Act (formerly 40 U.S.C. 276c)). Notwithstanding any other provision of this Agreement, credit or reimbursement may be withheld, in whole or in part, as a result of the Non-Federal Sponsor's failure to comply with its obligations under these laws.

G. Where the Government, on behalf of the Non-Federal Sponsor pursuant to Article II.H.1. of this Agreement, acquires lands, easements, or rights-of-way, performs *relocations*, or constructs improvements required on lands, easements, or rights-of-way to enable the disposal of dredged or excavated material, the value to be included in *total project costs* and the amount of credit to be afforded or the amount of reimbursement provided in accordance with this Agreement shall be the costs of such work performed or provided by the Government that are paid by the Non-Federal Sponsor in accordance with Article VI.D. of this Agreement. In addition, the value to be included in *total project costs* and the amount of such credit to be afforded or the amount of reimbursement provided in accordance with this Agreement shall include the documented costs incurred by the Non-Federal Sponsor in accordance with the terms and conditions agreed upon in writing pursuant to Article II.H.1. of this Agreement subject to an audit in accordance with Article X.C. of this Agreement to determine reasonableness, allocability, and allowability of such costs.

## ARTICLE V - PROJECT COORDINATION TEAM

A. To provide for consistent and effective communication, the Non-Federal Sponsor and the Government, not later than 30 calendar days after the effective date of this Agreement, shall appoint named senior representatives to a Project Coordination Team. Thereafter, the Project Coordination Team shall meet regularly until the end of the *period of*



*design and construction.* The Government's Project Manager and a counterpart named by the Non-Federal Sponsor shall co-chair the Project Coordination Team.

B. The Government's Project Manager and the Non-Federal Sponsor's counterpart shall keep the Project Coordination Team informed of the progress of design and construction and of significant pending issues and actions, and shall seek the views of the Project Coordination Team on matters that the Project Coordination Team generally oversees.

C. Until the end of the *period of design and construction*, the Project Coordination Team shall generally oversee the *Project*, including matters related to: design; completion of all necessary environmental coordination and documentation; plans and specifications; scheduling; real property and *relocation* requirements; real property acquisition; contract awards and modifications; contract costs; the application of and compliance with 40 U.S.C. 3141-3148 and 40 U.S.C. 3701-3708 (revising, codifying and enacting without substantive change the provisions of the Davis-Bacon Act (formerly 40 U.S.C. 276a *et seq.*), the Contract Work Hours and Safety Standards Act (formerly 40 U.S.C. 327 *et seq.*) and the Copeland Anti-Kickback Act (formerly 40 U.S.C. 276c)) for *relocations* and improvements required on lands, easements, and rights-of-way to enable the disposal of dredged or excavated material; the investigations to identify the existence and extent of hazardous substances in accordance with Article XIV.A. of this Agreement; historic preservation activities in accordance with Article XVII of this Agreement; the Government's cost projections; final inspection of the entire *Project* or *functional portions of the Project*; preparation of the proposed OMRR&R Manual; anticipated requirements and needed capabilities for performance of operation, maintenance, repair, rehabilitation, and replacement of the *Project* including issuance of permits; and other matters related to the *Project*. This oversight of the *Project* shall be consistent with a project management plan developed by the Government after consultation with the Non-Federal Sponsor.

D. The Project Coordination Team may make recommendations to the District Engineer on matters related to the *Project* that the Project Coordination Team generally oversees, including suggestions to avoid potential sources of dispute. The Government in good faith shall consider the recommendations of the Project Coordination Team. The Government, having the legal authority and responsibility for design and construction of the *Project*, has the discretion to accept or reject, in whole or in part, the Project Coordination Team's recommendations.

E. The Non-Federal Sponsor's costs of participation in the Project Coordination Team shall be included in *total project costs* and shared in accordance with the provisions of this Agreement, subject to an audit in accordance with Article X.C. of this Agreement to determine reasonableness, allocability, and allowability of such costs. The Government's costs of participation in the Project Coordination Team shall be included in *total project costs* and shared in accordance with the provisions of this Agreement.

## ARTICLE VI - METHOD OF PAYMENT

A. In accordance with the provisions of this paragraph, the Government shall maintain current records and provide to the Non-Federal Sponsor current projections of costs, financial obligations, contributions provided by the parties, the value included in *total project costs* for lands, easements, rights-of-way, *relocations*, and improvements required on lands, easements, and rights-of-way to enable the disposal of dredged or excavated material determined in accordance with Article IV of this Agreement.

1. As of the effective date of this Agreement, *total project costs* are projected to be \$20,763,000; the Non-Federal Sponsor's contribution of funds required by Article II.B.2. of this Agreement is projected to be \$0; the *non-Federal proportionate share* is projected to be 0.0 percent; the Non-Federal Sponsor's contribution of funds required by Article XVII.B.3. of this Agreement is projected to be \$0; the value included in *total project costs* for lands, easements, rights-of-way, *relocations*, and improvements required on lands, easements, and rights-of-way to enable the disposal of dredged or excavated material determined in accordance with Article IV of this Agreement is projected to be \$7,573,000; and the Government's total financial obligations for the additional work to be incurred and the Non-Federal Sponsor's contribution of funds for such costs required by Article II.H. of this Agreement are projected to be \$0. These amounts and percentage are estimates subject to adjustment by the Government, after consultation with the Non-Federal Sponsor, and are not to be construed as the total financial responsibilities of the Government and the Non-Federal Sponsor.

2. By November 1, 2011 and by each quarterly anniversary thereof until the conclusion of the *period of design and construction* and resolution of all relevant claims and appeals and eminent domain proceedings, the Government shall provide the Non-Federal Sponsor with a report setting forth all contributions provided to date and the current projections of the following: *total project costs*; the Non-Federal Sponsor's total contribution of funds required by Article II.B.2. of this Agreement; the *non-Federal proportionate share*; the Non-Federal Sponsor's total contribution of funds required by Article XVII.B.3. of this Agreement; the value included in *total project costs* for lands, easements, rights-of-way, *relocations*, and improvements required on lands, easements, and rights-of-way to enable the disposal of dredged or excavated material determined in accordance with Article IV of this Agreement; and the Government's total financial obligations for additional work incurred and the Non-Federal Sponsor's contribution of funds for such costs required by Article II.H. of this Agreement.

B. The Non-Federal Sponsor shall provide the contributions of funds required by Article II.B.2. and Article XVII.B.3. of this Agreement in accordance with the provisions of this paragraph.

1. Not less than 60 calendar days prior to the scheduled date for issuance of the solicitation for the first contract for design of the *Project* or commencement of design of the *Project* using the Government's own forces, the Government shall notify the Non-Federal Sponsor in writing of such scheduled date and the funds the Government



determines to be required from the Non-Federal Sponsor to meet its projected share under Article II.B.2. and Article XVII.B.3. of this Agreement. Not later than such scheduled date, the Non-Federal Sponsor shall provide the Government with the full amount of such required funds by delivering a check payable to "FAO, USAED, Rock Island (B5)" to the District Engineer, or verifying to the satisfaction of the Government that the Non-Federal Sponsor has deposited such required funds in an escrow or other account acceptable to the Government, with interest accruing to the Non-Federal Sponsor, or by presenting the Government with an irrevocable letter of credit acceptable to the Government for such required funds, or by providing an Electronic Funds Transfer of such required funds in accordance with procedures established by the Government.

2. The Government shall draw from the funds provided by the Non-Federal Sponsor such sums as the Government deems necessary to cover: (a) the *non-Federal proportionate share of financial obligations for design and construction* incurred prior to the commencement of the *period of design and construction*; (b) the *non-Federal proportionate share of financial obligations for design and construction as financial obligations for design and construction* are incurred; and (c) the Non-Federal Sponsor's share of financial obligations for data recovery activities associated with historic preservation pursuant to Article XVII.B.3. of this Agreement as those financial obligations are incurred. If at any time the Government determines that additional funds will be needed from the Non-Federal Sponsor to cover the Non-Federal Sponsor's share of such financial obligations, the Government shall notify the Non-Federal Sponsor in writing of the additional funds required and provide an explanation of why additional funds are required. Within 60 calendar days from receipt of such notice, the Non-Federal Sponsor shall provide the Government with the full amount of such additional required funds through any of the payment mechanisms specified in paragraph B.1. of this Article.

C. Upon conclusion of the *period of design and construction* and resolution of all relevant claims and appeals and eminent domain proceedings, the Government shall conduct a final accounting and furnish the Non-Federal Sponsor with written notice of the results of such final accounting. If outstanding relevant claims and appeals or eminent domain proceedings prevent a final accounting from being conducted in a timely manner, the Government shall conduct an interim accounting and furnish the Non-Federal Sponsor with written notice of the results of such interim accounting. Once all outstanding relevant claims and appeals and eminent domain proceedings are resolved, the Government shall amend the interim accounting to complete the final accounting and furnish the Non-Federal Sponsor with written notice of the results of such final accounting. The interim or final accounting, as applicable, shall determine *total project costs* and the costs of any data recovery activities associated with historic preservation. In addition, for each set of costs, the interim or final accounting, as applicable, shall determine each party's required share thereof and each party's total contributions thereto as of the date of such accounting.

1. Should the interim or final accounting, as applicable, show that the Non-Federal Sponsor's total required shares of *total project costs* and the costs of any data recovery activities associated with historic preservation exceed the Non-Federal

Sponsor's total contributions provided thereto, the Non-Federal Sponsor, no later than 90 calendar days after receipt of written notice from the Government, shall make a payment to the Government in an amount equal to the difference by delivering a check payable to "FAO, USAED, Rock Island (B5)" to the District Engineer or by providing an Electronic Funds Transfer in accordance with procedures established by the Government.

2. Should the interim or final accounting, as applicable, show that the total contributions provided by the Non-Federal Sponsor for *total project costs* and the costs of any data recovery activities associated with historic preservation exceed the Non-Federal Sponsor's total required shares thereof, the Government, subject to the availability of funds and as limited by the *Section 1103 HREP Annual Program Limit*, shall refund or reimburse the excess amount to the Non-Federal Sponsor within 90 calendar days of the date of completion of such accounting. In the event the Non-Federal Sponsor is due a refund or reimbursement and funds are not available to refund or reimburse the excess amount to the Non-Federal Sponsor, the Government shall seek such appropriations as are necessary to make the refund or reimbursement.

D. The Non-Federal Sponsor shall provide the contribution of funds required by Article II.H. of this Agreement for additional work in accordance with the provisions of this paragraph.

1. Not less than 60 calendar days prior to the scheduled date for the first financial obligation for additional work, the Government shall notify the Non-Federal Sponsor in writing of such scheduled date and of the full amount of funds the Government determines to be required from the Non-Federal Sponsor to cover the costs of the additional work. No later than 30 calendar days prior to the Government incurring any financial obligation for additional work, the Non-Federal Sponsor shall provide the Government with the full amount of the funds required to cover the costs of such additional work through any of the payment mechanisms specified in paragraph B.1. of this Article.

2. The Government shall draw from the funds provided by the Non-Federal Sponsor such sums as the Government deems necessary to cover the Government's financial obligations for such additional work as they are incurred. If at any time the Government determines that the Non-Federal Sponsor must provide additional funds to pay for such additional work, the Government shall notify the Non-Federal Sponsor in writing of the additional funds required and provide an explanation of why additional funds are required. Within 30 calendar days from receipt of such notice, the Non-Federal Sponsor shall provide the Government with the full amount of such additional required funds through any of the payment mechanisms specified in paragraph B.1. of this Article.

3. At the time the Government conducts the interim or final accounting, as applicable, the Government shall conduct an accounting of the Government's financial obligations incurred for additional work and furnish the Non-Federal Sponsor with written notice of the results of such accounting. If outstanding relevant claims and



appeals or eminent domain proceedings prevent a final accounting of such financial obligations for additional work from being conducted in a timely manner, the Government shall conduct an interim accounting of such financial obligations for additional work and furnish the Non-Federal Sponsor with written notice of the results of such interim accounting. Once all outstanding relevant claims and appeals and eminent domain proceedings are resolved, the Government shall amend the interim accounting of such financial obligations for additional work to complete the final accounting of such financial obligations for additional work and furnish the Non-Federal Sponsor with written notice of the results of such final accounting. Such interim or final accounting, as applicable, shall determine the Government's total financial obligations for additional work and the Non-Federal Sponsor's contribution of funds provided thereto as of the date of such accounting.

a. Should the interim or final accounting, as applicable, show that the Government's total financial obligations for additional work exceed the total contribution of funds provided by the Non-Federal Sponsor for such additional work, the Non-Federal Sponsor, no later than 90 calendar days after receipt of written notice from the Government, shall make a payment to the Government in an amount equal to the difference by delivering a check payable to "FAO, USAED, Rock Island (B5)" to the District Engineer or by providing an Electronic Funds Transfer in accordance with procedures established by the Government.

b. Should the interim or final accounting, as applicable, show that the total contribution of funds provided by the Non-Federal Sponsor for additional work exceeds the Government's total financial obligations for such additional work, the Government, subject to the availability of funds, shall refund the excess amount to the Non-Federal Sponsor within 90 calendar days of the date of completion of such accounting. In the event the Non-Federal Sponsor is due a refund and funds are not available to refund the excess amount to the Non-Federal Sponsor, the Government shall seek such appropriations as are necessary to make the refund.

## ARTICLE VII - DISPUTE RESOLUTION

As a condition precedent to a party bringing any suit for breach of this Agreement, that party must first notify the other party in writing of the nature of the purported breach and seek in good faith to resolve the dispute through negotiation. If the parties cannot resolve the dispute through negotiation, they may agree to a mutually acceptable method of non-binding alternative dispute resolution with a qualified third party acceptable to both parties. Each party shall pay an equal share of any costs for the services provided by such a third party as such costs are incurred. The existence of a dispute shall not excuse the parties from performance pursuant to this Agreement.

## ARTICLE VIII - OPERATION, MAINTENANCE, REPAIR, REHABILITATION, AND REPLACEMENT (OMRR&R)

A. Upon receipt of the notification from the District Engineer in accordance with Article II.D. of this Agreement and for so long as the *Project* remains authorized, the Non-Federal Sponsor, pursuant to Article II.E. of this Agreement, shall operate, maintain, repair, rehabilitate, and replace the entire *Project* or *functional portion of the Project*, at no cost to the Government. The Non-Federal Sponsor shall conduct its operation, maintenance, repair, rehabilitation, and replacement responsibilities in a manner compatible with the *Project's* authorized purposes and in accordance with applicable Federal and State laws as provided in Article XI of this Agreement and specific directions prescribed by the Government in the interim or final OMRR&R Manual and any subsequent amendments thereto.

B. The Non-Federal Sponsor hereby gives the Government a right to enter, at reasonable times and in a reasonable manner, upon property that the Non-Federal Sponsor now or hereafter owns or controls for access to the *Project* for the purpose of inspection and, if necessary, for the purpose of completing, operating, maintaining, repairing, rehabilitating, or replacing the *Project*. If an inspection shows that the Non-Federal Sponsor for any reason is failing to perform its obligations under this Agreement, the Government shall send a written notice describing the non-performance to the Non-Federal Sponsor. If, after 30 calendar days from receipt of such written notice by the Government, the Non-Federal Sponsor continues to fail to perform, then the Government shall have the right to enter, at reasonable times and in a reasonable manner, upon property that the Non-Federal Sponsor now or hereafter owns or controls for the purpose of completing, operating, maintaining, repairing, rehabilitating, or replacing the *Project*. No completion, operation, maintenance, repair, rehabilitation, or replacement by the Government shall relieve the Non-Federal Sponsor of responsibility to meet the Non-Federal Sponsor's obligations as set forth in this Agreement, or to preclude the Government from pursuing any other remedy at law or equity to ensure faithful performance pursuant to this Agreement.

## ARTICLE IX – HOLD AND SAVE

Subject to the provisions of Article XIX of this Agreement, the Non-Federal Sponsor shall hold and save the Government free from all damages arising from design, construction, operation, maintenance, repair, rehabilitation, and replacement of the *Project* and any *betterments*, except for damages due to the fault or negligence of the Government or its contractors.

## ARTICLE X - MAINTENANCE OF RECORDS AND AUDIT

A. Not later than 60 calendar days after the effective date of this Agreement, the Government and the Non-Federal Sponsor shall develop procedures for keeping books, records, documents, or other evidence pertaining to costs and expenses incurred pursuant to

this Agreement. These procedures shall incorporate, and apply as appropriate, the standards for financial management systems set forth in the Uniform Administrative Requirements for Grants and Cooperative Agreements to State and Local Governments at 32 C.F.R. Section 33.20. The Government and the Non-Federal Sponsor shall maintain such books, records, documents, or other evidence in accordance with these procedures and for a minimum of three years after completion of the accounting for which such books, records, documents, or other evidence were required. To the extent permitted under applicable Federal laws and regulations, the Government and the Non-Federal Sponsor shall each allow the other to inspect such books, records, documents, or other evidence.

B. In accordance with 32 C.F.R. Section 33.26, the Non-Federal Sponsor is responsible for complying with the Single Audit Act Amendments of 1996 (31 U.S.C. 7501-7507), as implemented by Office of Management and Budget (OMB) Circular No. A-133 and Department of Defense Directive 7600.10. Upon request of the Non-Federal Sponsor and to the extent permitted under applicable Federal laws and regulations, the Government shall provide to the Non-Federal Sponsor and independent auditors any information necessary to enable an audit of the Non-Federal Sponsor's activities under this Agreement. The costs of any non-Federal audits performed in accordance with this paragraph shall be allocated in accordance with the provisions of OMB Circulars A-87 and A-133, and such costs as are allocated to the *Project* shall be included in *total project costs* and shared in accordance with the provisions of this Agreement.

C. In accordance with 31 U.S.C. 7503, the Government may conduct audits in addition to any audit that the Non-Federal Sponsor is required to conduct under the Single Audit Act Amendments of 1996. Any such Government audits shall be conducted in accordance with Government Auditing Standards and the cost principles in OMB Circular No. A-87 and other applicable cost principles and regulations. The costs of Government audits performed in accordance with this paragraph shall be included in *total project costs* and shared in accordance with the provisions of this Agreement.

## ARTICLE XI - FEDERAL AND STATE LAWS

In the exercise of their respective rights and obligations under this Agreement, the Non-Federal Sponsor and the Government shall comply with all applicable Federal and State laws and regulations, including, but not limited to: Section 601 of the Civil Rights Act of 1964, Public Law 88-352 (42 U.S.C. 2000d) and Department of Defense Directive 5500.11 issued pursuant thereto; Army Regulation 600-7, entitled "Nondiscrimination on the Basis of Handicap in Programs and Activities Assisted or Conducted by the Department of the Army"; and all applicable Federal labor standards requirements including, but not limited to, 40 U.S.C. 3141-3148 and 40 U.S.C. 3701-3708 (revising, codifying and enacting without substantive change the provisions of the Davis-Bacon Act (formerly 40 U.S.C. 276a *et seq.*), the Contract Work Hours and Safety Standards Act (formerly 40 U.S.C. 327 *et seq.*) and the Copeland Anti-Kickback Act (formerly 40 U.S.C. 276c)).



## ARTICLE XII - RELATIONSHIP OF PARTIES

A. In the exercise of their respective rights and obligations under this Agreement, the Government and the Non-Federal Sponsor each act in an independent capacity, and neither is to be considered the officer, agent, or employee of the other.

B. In the exercise of its rights and obligations under this Agreement, neither party shall provide, without the consent of the other party, any contractor with a release that waives or purports to waive any rights the other party may have to seek relief or redress against that contractor either pursuant to any cause of action that the other party may have or for violation of any law.

## ARTICLE XIII - TERMINATION OR SUSPENSION

A. If at any time the Non-Federal Sponsor fails to fulfill its obligations under this Agreement, the Assistant Secretary of the Army (Civil Works) shall terminate this Agreement or suspend future performance under this Agreement unless he determines that continuation of work on the *Project* is in the interest of the United States or is necessary in order to satisfy agreements with any other non-Federal interests in connection with the *Project*.

B. In the event future performance under this Agreement is suspended pursuant to Article II.C. of this Agreement, such suspension shall remain in effect until such time that the Government notifies the Non-Federal Sponsor in writing that sufficient Federal funds are available to meet the Federal share of *total project costs* and the Federal share of costs for data recovery activities associated with historic preservation in accordance with Article XVII.B.2. and Article XVII.B.3. of this Agreement the Government projects to be incurred through the then-current or upcoming *fiscal year*, or the Government or the Non-Federal Sponsor elects to terminate this Agreement.

C. In the event that the Government and the Non-Federal Sponsor determine to suspend future performance under this Agreement in accordance with Article XIV.C. of this Agreement, such suspension shall remain in effect until the Government and the Non-Federal Sponsor agree to proceed or to terminate this Agreement. In the event that the Government suspends future performance under this Agreement in accordance with Article XIV.C. of this Agreement due to failure to reach agreement with the Non-Federal Sponsor on whether to proceed or to terminate this Agreement, or the failure of the Non-Federal Sponsor to provide funds to pay for cleanup and response costs or to otherwise discharge the Non-Federal Sponsor's responsibilities under Article XIV.C. of this Agreement, such suspension shall remain in effect until: 1) the Government and Non-Federal Sponsor reach agreement on how to proceed or to terminate this Agreement; 2) the Non-Federal Sponsor provides funds necessary to pay for cleanup and response costs and otherwise discharges its responsibilities under Article XIV.C. of this Agreement; 3)

the Government continues work on the *Project*; or 4) the Government terminates this Agreement in accordance with the provisions of Article XIV.C. of this Agreement.

D. If after completion of the design portion of the *Project* the parties mutually agree in writing not to proceed with construction of the *Project*, the parties shall conclude their activities relating to the *Project* and conduct an accounting in accordance with Article VI.C. of this Agreement.

E. In the event that this Agreement is terminated pursuant to this Article or Article XIV.C. of this Agreement, both parties shall conclude their activities relating to the *Project* and conduct an accounting in accordance with Article VI.C. of this Agreement. To provide for this eventuality, the Government may reserve a percentage of total Federal funds made available for the *Project* and an equal percentage of the total funds contributed by the Non-Federal Sponsor in accordance with Article II.B.2. and Article XVII.B.3. of this Agreement as a contingency to pay costs of termination, including any costs of resolution of contract claims and contract modifications.

F. Any termination of this Agreement or suspension of future performance under this Agreement in accordance with this Article or Article II.C. or Article XIV.C. of this Agreement shall not relieve the parties of liability for any obligation previously incurred. Any delinquent payment owed by the Non-Federal Sponsor shall be charged interest at a rate, to be determined by the Secretary of the Treasury, equal to 150 per centum of the average bond equivalent rate of the 13 week Treasury bills auctioned immediately prior to the date on which such payment became delinquent, or auctioned immediately prior to the beginning of each additional 3 month period if the period of delinquency exceeds 3 months.

#### ARTICLE XIV - HAZARDOUS SUBSTANCES

A. After execution of this Agreement and upon direction by the District Engineer, the Non-Federal Sponsor shall perform, or ensure performance of, any investigations for hazardous substances that the Government or the Non-Federal Sponsor determines to be necessary to identify the existence and extent of any hazardous substances regulated under the Comprehensive Environmental Response, Compensation, and Liability Act (42 U.S.C. 9601-9675; hereinafter "CERCLA"), that may exist in, on, or under lands, easements, and rights-of-way that the Government determines, pursuant to Article III of this Agreement, to be required for construction, operation, and maintenance of the *Project*. However, for lands, easements, and rights-of-way that the Government determines to be subject to the navigation servitude, only the Government shall perform such investigations unless the District Engineer provides the Non-Federal Sponsor with prior specific written direction, in which case the Non-Federal Sponsor shall perform such investigations in accordance with such written direction.

1. All actual costs incurred by the Non-Federal Sponsor for such investigations for hazardous substances shall be included in *total project costs* and shared in accordance with the provisions of this Agreement, subject to an audit in accordance with

Article X.C. of this Agreement to determine reasonableness, allocability, and allowability of such costs.

2. All actual costs incurred by the Government for such investigations for hazardous substances shall be included in *total project costs* and shared in accordance with the provisions of this Agreement.

B. In the event it is discovered through any investigation for hazardous substances or other means that hazardous substances regulated under CERCLA exist in, on, or under any lands, easements, or rights-of-way that the Government determines, pursuant to Article III of this Agreement, to be required for construction, operation, and maintenance of the *Project*, the Non-Federal Sponsor and the Government, in addition to providing any other notice required by applicable law, shall provide prompt written notice to each other, and the Non-Federal Sponsor shall not proceed with the acquisition of the real property interests until the parties agree that the Non-Federal Sponsor should proceed.

C. The Government and the Non-Federal Sponsor shall determine whether to initiate construction of the *Project*, or, if already in construction, whether to continue with construction of the *Project*, suspend future performance under this Agreement, or terminate this Agreement for the convenience of the Government, in any case where hazardous substances regulated under CERCLA are found to exist in, on, or under any lands, easements, or rights-of-way that the Government determines, pursuant to Article III of this Agreement, to be required for construction, operation, and maintenance of the *Project*. Should the Government and the Non-Federal Sponsor determine to initiate or continue with construction of the *Project* after considering any liability that may arise under CERCLA, the Non-Federal Sponsor shall be responsible, as between the Government and the Non-Federal Sponsor, for the costs of cleanup and response, including the costs of any studies and investigations necessary to determine an appropriate response to the contamination. Such costs shall not be considered a part of *total project costs*. In the event the Non-Federal Sponsor does not reach agreement with the Government on whether to proceed or to terminate this Agreement under this paragraph, or fails to provide any funds necessary to pay for cleanup and response costs or to otherwise discharge the Non-Federal Sponsor's responsibilities under this paragraph upon direction by the Government, the Government, in its sole discretion, may either terminate this Agreement for the convenience of the Government, suspend future performance under this Agreement, or continue work on the *Project*.

D. The Non-Federal Sponsor and the Government shall consult with each other in accordance with Article V of this Agreement in an effort to ensure that responsible parties bear any necessary cleanup and response costs as defined in CERCLA. Any decision made pursuant to paragraph C. of this Article shall not relieve any third party from any liability that may arise under CERCLA.

E. As between the Government and the Non-Federal Sponsor, the Non-Federal Sponsor shall be considered the operator of the *Project* for purposes of CERCLA liability. To the maximum extent practicable, the Non-Federal Sponsor shall operate, maintain,



repair, rehabilitate, and replace the *Project* in a manner that will not cause liability to arise under CERCLA.

## ARTICLE XV - NOTICES

A. Any notice, request, demand, or other communication required or permitted to be given under this Agreement shall be deemed to have been duly given if in writing and delivered personally or sent by telegram or mailed by first-class, registered, or certified mail, as follows:

If to the Non-Federal Sponsor:

Director  
Illinois Department of Natural Resources  
One Natural Resources Way  
Springfield, Illinois 62702-1271

If to the Government:

District Engineer  
United States Army Corps of Engineers  
Clock Tower Building  
P.O. Box 2004  
Rock Island, IL 62104

B. A party may change the address to which such communications are to be directed by giving written notice to the other party in the manner provided in this Article.

C. Any notice, request, demand, or other communication made pursuant to this Article shall be deemed to have been received by the addressee at the earlier of such time as it is actually received or seven calendar days after it is mailed.

## ARTICLE XVI - CONFIDENTIALITY

To the extent permitted by the laws governing each party, the parties agree to maintain the confidentiality of exchanged information when requested to do so by the providing party.

## ARTICLE XVII - HISTORIC PRESERVATION

A. The Government, as it determines necessary for the *Project*, shall perform any identification, survey, or evaluation of historic properties. Any costs incurred by the Government for such work shall be included in *total project costs* and shared in accordance with the provisions of this Agreement.

B. The Government, as it determines necessary for the *Project*, shall perform or ensure the performance of any mitigation activities or actions for historic properties or that are otherwise associated with historic preservation including data recovery activities.

1. Any costs incurred by the Government for such mitigation activities, except for data recovery activities associated with historic preservation, shall be included in *total project costs* and shared in accordance with the provisions of this Agreement.

2. As specified in Section 7(a) of Public Law 86-523, as amended by Public Law 93-291 (16 U.S.C. 469c(a)), the costs of data recovery activities associated with historic preservation shall be borne entirely by the Government and shall not be included in *total project costs*, up to the statutory limit of one percent of *total project costs* for the *Project*.

3. The Government shall not incur costs for data recovery activities associated with historic preservation that exceed the statutory one percent limit specified in paragraph B.2. of this Article unless and until the Assistant Secretary of the Army (Civil Works) has waived that limit and the Secretary of the Interior has concurred in the waiver in accordance with Section 208(3) of Public Law 96-515, as amended (16 U.S.C. 469c-2(3)). Any costs of data recovery activities associated with historic preservation that exceed the one percent limit shall not be included in *total project costs* but shall be shared between the Non-Federal Sponsor and the Government consistent with the cost sharing requirements for the Section 1103 HREP Program, as follows: 35 percent will be borne by the Non-Federal Sponsor and 65 percent will be borne by the Government.

C. If, during its performance of *relocations* or construction of improvements required on lands, easements, and rights-of-way to enable the disposal of dredged or excavated material in accordance with Article III of this Agreement, the Non-Federal Sponsor discovers historic properties or other cultural resources that have not been evaluated by the Government pursuant to this Article, the Non-Federal Sponsor shall provide prompt written notice to the Government of such discovery. The Non-Federal Sponsor shall not proceed with performance of the *relocation* or construction of the improvement that is related to such discovery until the Government provides written notice to the Non-Federal Sponsor that it should proceed with such work.

#### ARTICLE XVIII - THIRD PARTY RIGHTS, BENEFITS, OR LIABILITIES

Nothing in this Agreement is intended, nor may be construed, to create any rights, confer any benefits, or relieve any liability, of any kind whatsoever in any third person not party to this Agreement.

## ARTICLE XIX - OBLIGATIONS OF FUTURE APPROPRIATIONS


A. Nothing herein shall constitute, nor be deemed to constitute, an obligation of future appropriations by the Department of Natural Resources of the State of Illinois, where creating such an obligation would be inconsistent with Illinois statutes, including but not limited to 30 ILCS 105/30, or Article VIII, Section 2 of the Constitution of the State of Illinois.


B. The Non-Federal Sponsor intends to fulfill its obligations under this Agreement. The Non-Federal Sponsor shall include in its budget request or otherwise propose appropriations of funds in amounts sufficient to fulfill these obligations for that year, and shall use all reasonable and lawful means to secure those appropriations. The Non-Federal Sponsor reasonably believes that funds in amounts sufficient to fulfill these obligations lawfully can and will be appropriated and made available for this purpose. In the event funds are not appropriated in amounts sufficient to fulfill these obligations, the Non-Federal Sponsor shall use its best efforts to satisfy any requirements for payments or contributions of funds under this Agreement from any other source of funds legally available for this purpose. Further, if the Non-Federal Sponsor is unable to fulfill these obligations, the Government may exercise any legal rights it has to protect the Government's interests related to this Agreement.

IN WITNESS WHEREOF, the parties hereto have executed this Agreement, which shall become effective upon the date it is signed by the Assistant Secretary of the Army (Civil Works).

DEPARTMENT OF THE ARMY

ILLINOIS DEPARTMENT OF NATURAL  
RESOURCES

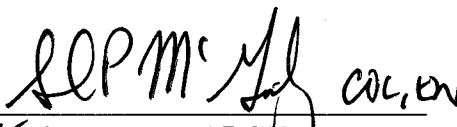BY:   
for JO-ELLEN DARCY  
Assistant Secretary of the Army  
(Civil Works)

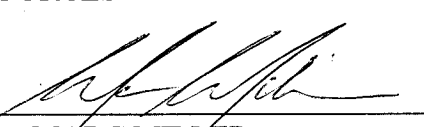BY:   
MARC MILLER  
Director

DATE: 27 Jul 2011

DATE: 07-25-2011



(20 ILCS 805/805-125) (was 20 ILCS 805/63b1)

Sec. 805-125. Agreements with federal agencies. The Department has the power and authority to enter into agreements with appropriate federal agencies in order to better effect cooperative undertakings in the conservation, preservation, distribution, and propagation of fish, mussels, frogs, turtles, game, wild animals, wild fowls, birds, trees, plants, and forests. The Department's agreements with the United States government may include general indemnification provisions.

(Source: P.A. 96-45, eff. 7-15-09.)

## CERTIFICATION REGARDING LOBBYING


The undersigned certifies, to the best of his or her knowledge and belief that:

(1) No Federal appropriated funds have been paid or will be paid, by or on behalf of the undersigned, to any person for influencing or attempting to influence an officer or employee of any agency, a Member of Congress, an officer or employee of Congress, or an employee of a Member of Congress in connection with the awarding of any Federal contract, the making of any Federal grant, the making of any Federal loan, the entering into of any cooperative agreement, and the extension, continuation, renewal, amendment, or modification of any Federal contract, grant, loan, or cooperative agreement.

(2) If any funds other than Federal appropriated funds have been paid or will be paid to any person for influencing or attempting to influence an officer or employee of any agency, a Member of Congress, an officer or employee of Congress, or an employee of a Member of Congress in connection with this Federal contract, grant, loan, or cooperative agreement, the undersigned shall complete and submit Standard Form-LLL, "Disclosure Form to Report Lobbying," in accordance with its instructions.

(3) The undersigned shall require that the language of this certification be included in the award documents for all subawards at all tiers (including subcontracts, subgrants, and contracts under grants, loans, and cooperative agreements) and that all subrecipients shall certify and disclose accordingly.

This certification is a material representation of fact upon which reliance was placed when this transaction was made or entered into. Submission of this certification is a prerequisite for making or entering into this transaction imposed by 31 U.S.C. 1352. Any person who fails to file the required certification shall be subject to a civil penalty of not less than \$10,000 and not more than \$100,000 for each such failure.

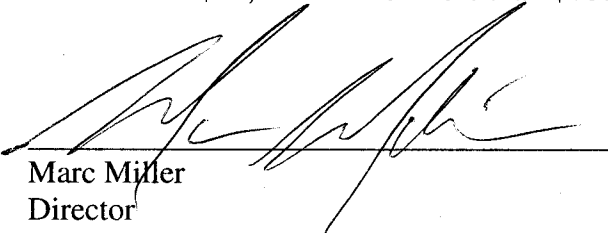

Marc Miller  
Director  
Illinois Department of Natural Resources

DATE: 07-25-2011



# LAGRANGE POOL

# RICE LAKE HREP RIGHT OF WAY

# STAGE I

Solicitation: W912EK-11-B-0011

## Contract:

June 2011

COL. EN, District Engineer XX Chief, Engineering & Construction Division <i>A. Z. P.E.</i>	APPROVED BY: Chief, Survey Section <i>SA D. Lee P.E.</i> APPROVAL RECOMMENDED BY:
---	--


Sheet  
ID  
V-001

ILLINOIS WATERWAY  
LAGRANGE POOL  
FULTON COUNTY, IL  
RICE LAKE TRAP RIGHT OF WAY  
STAGE I  
COVER SHEET


U.S. ARMY CORPS OF ENGINEERS ROCK ISLAND DISTRICT ROCK ISLAND, ILLINOIS	DESIGNED BY:	DATE:
	REF:	2011/07/15
	DRAWN BY:	
	CKD BY:	SOLICITATION NO.: W92ZK-11-4-0011
SUBMITTED BY:	CONTRACT NO.:	
PLOT SCALE: PLOT DATE:		PROJECT CODE:
AS SHOWN	EP102	
SIZE:	FILE NAME:	
A4/ISO	EP102X-001.dgn	

[illegible]



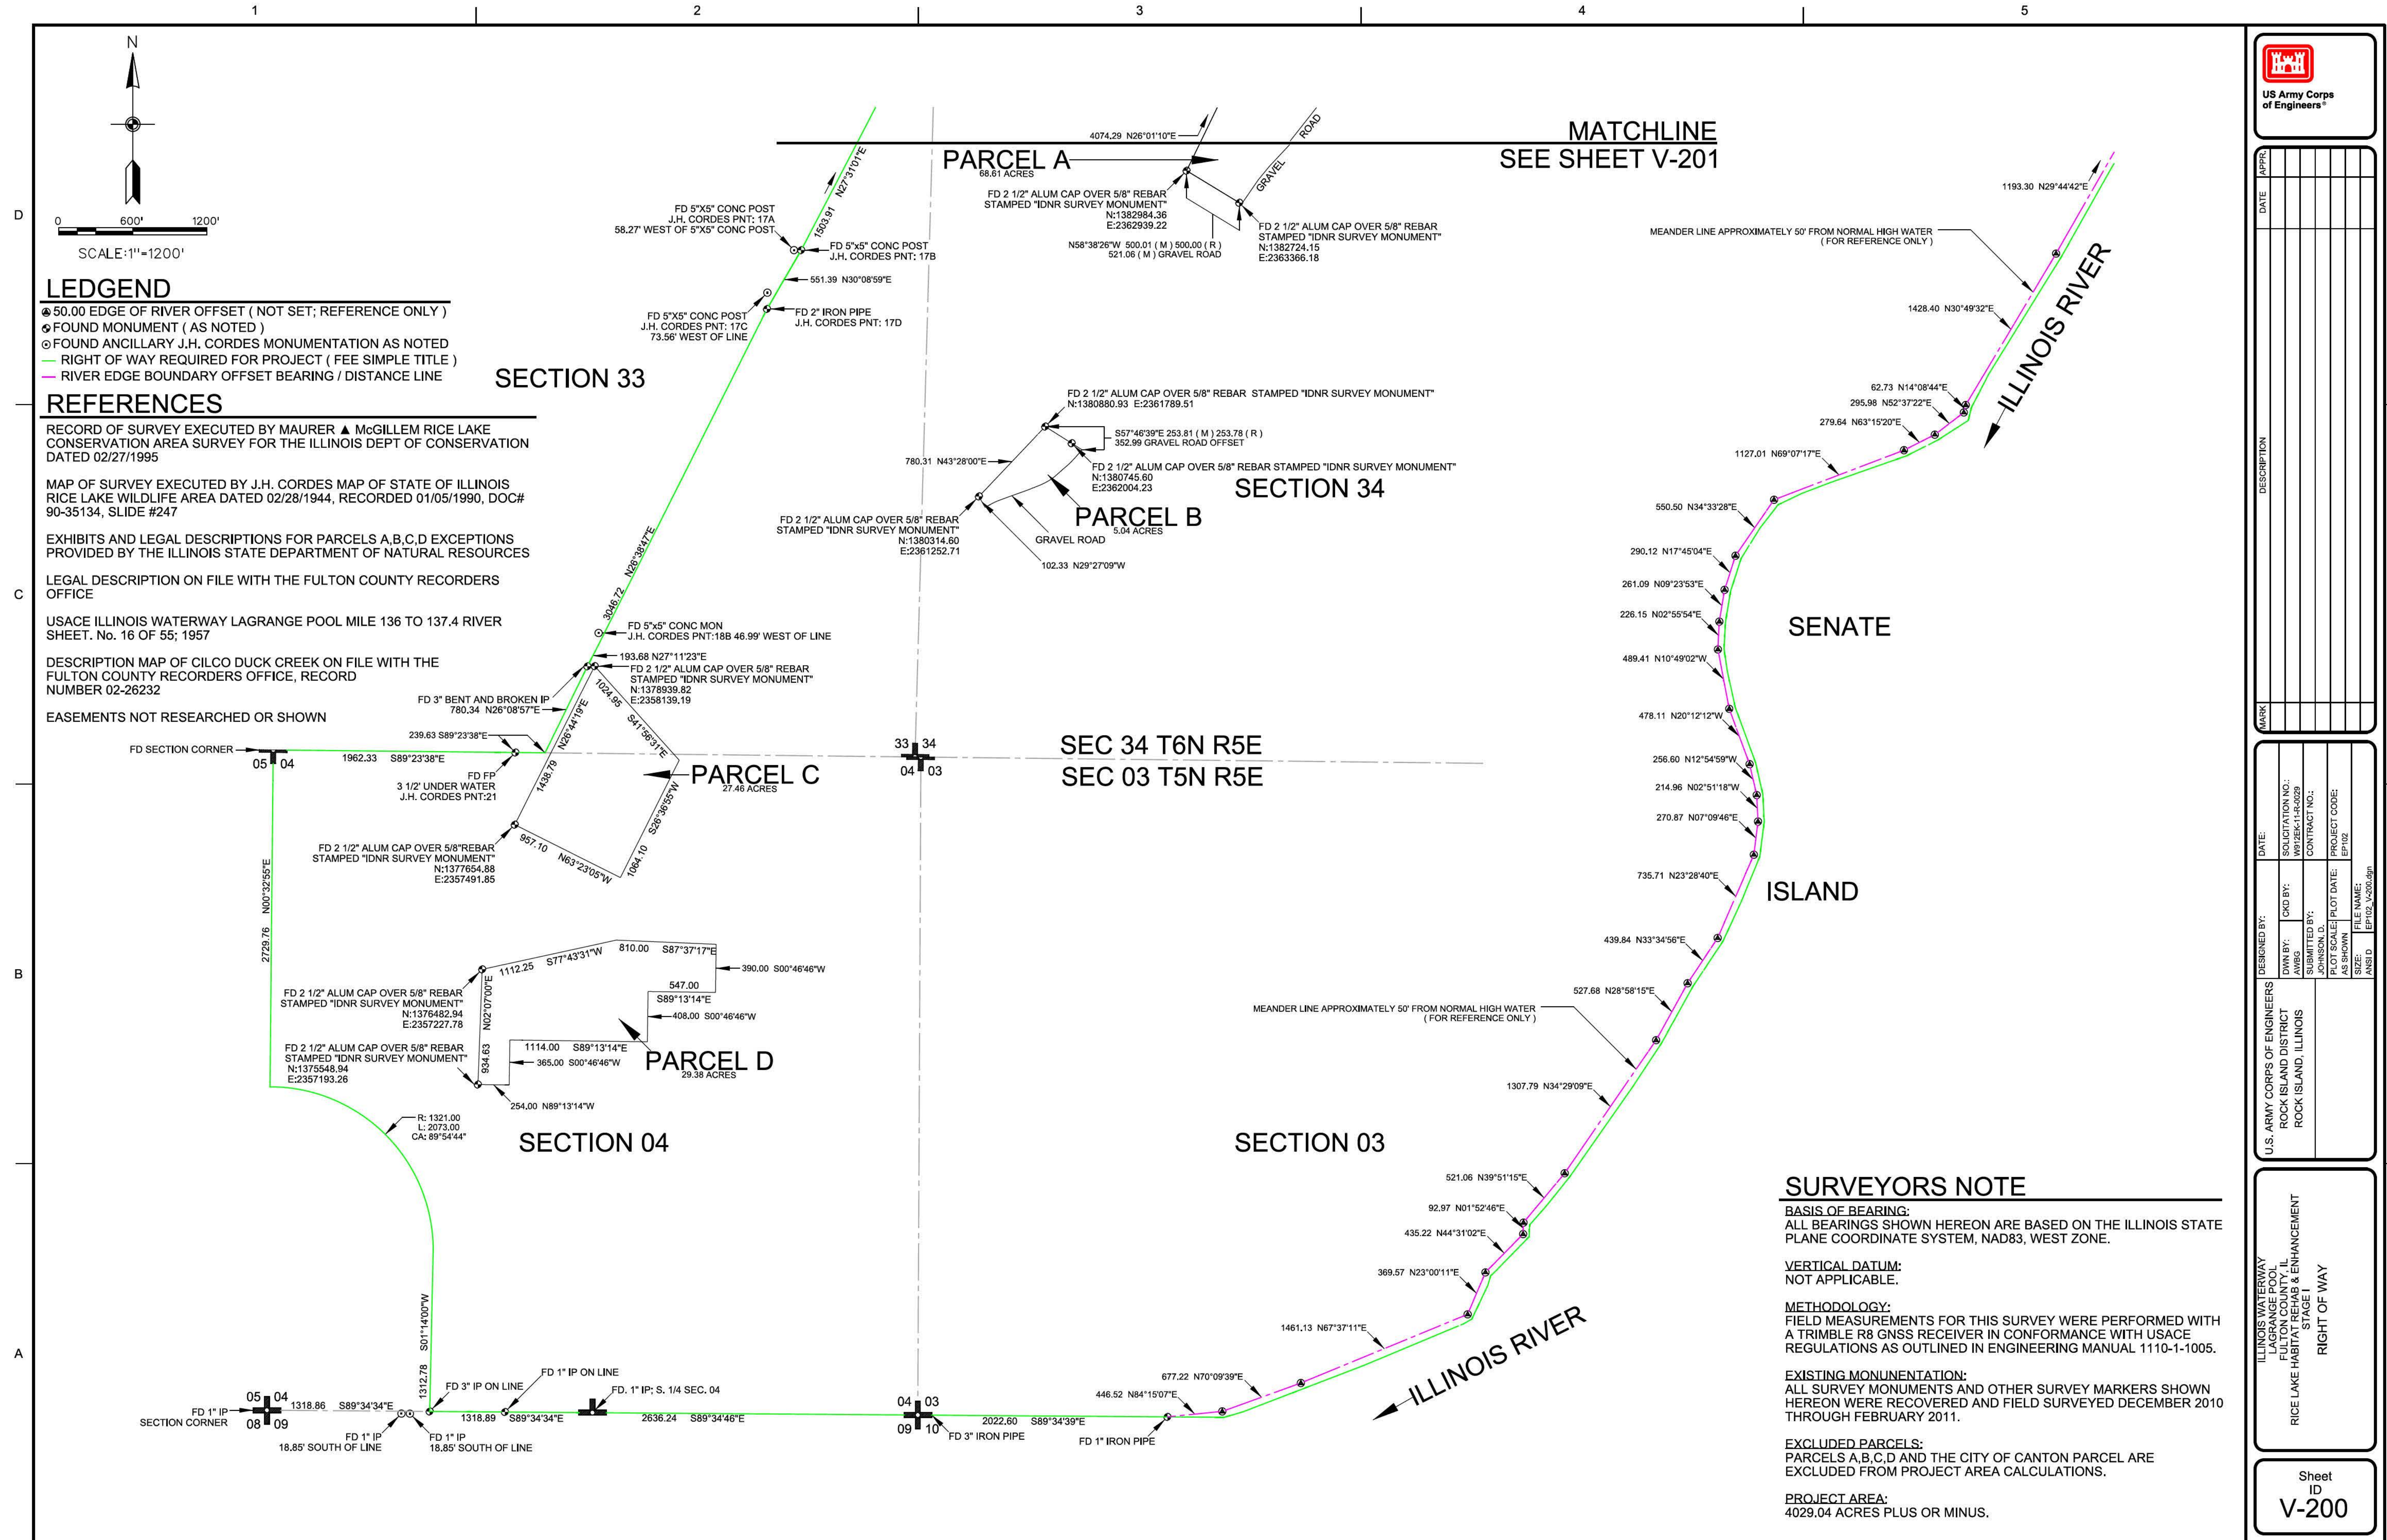



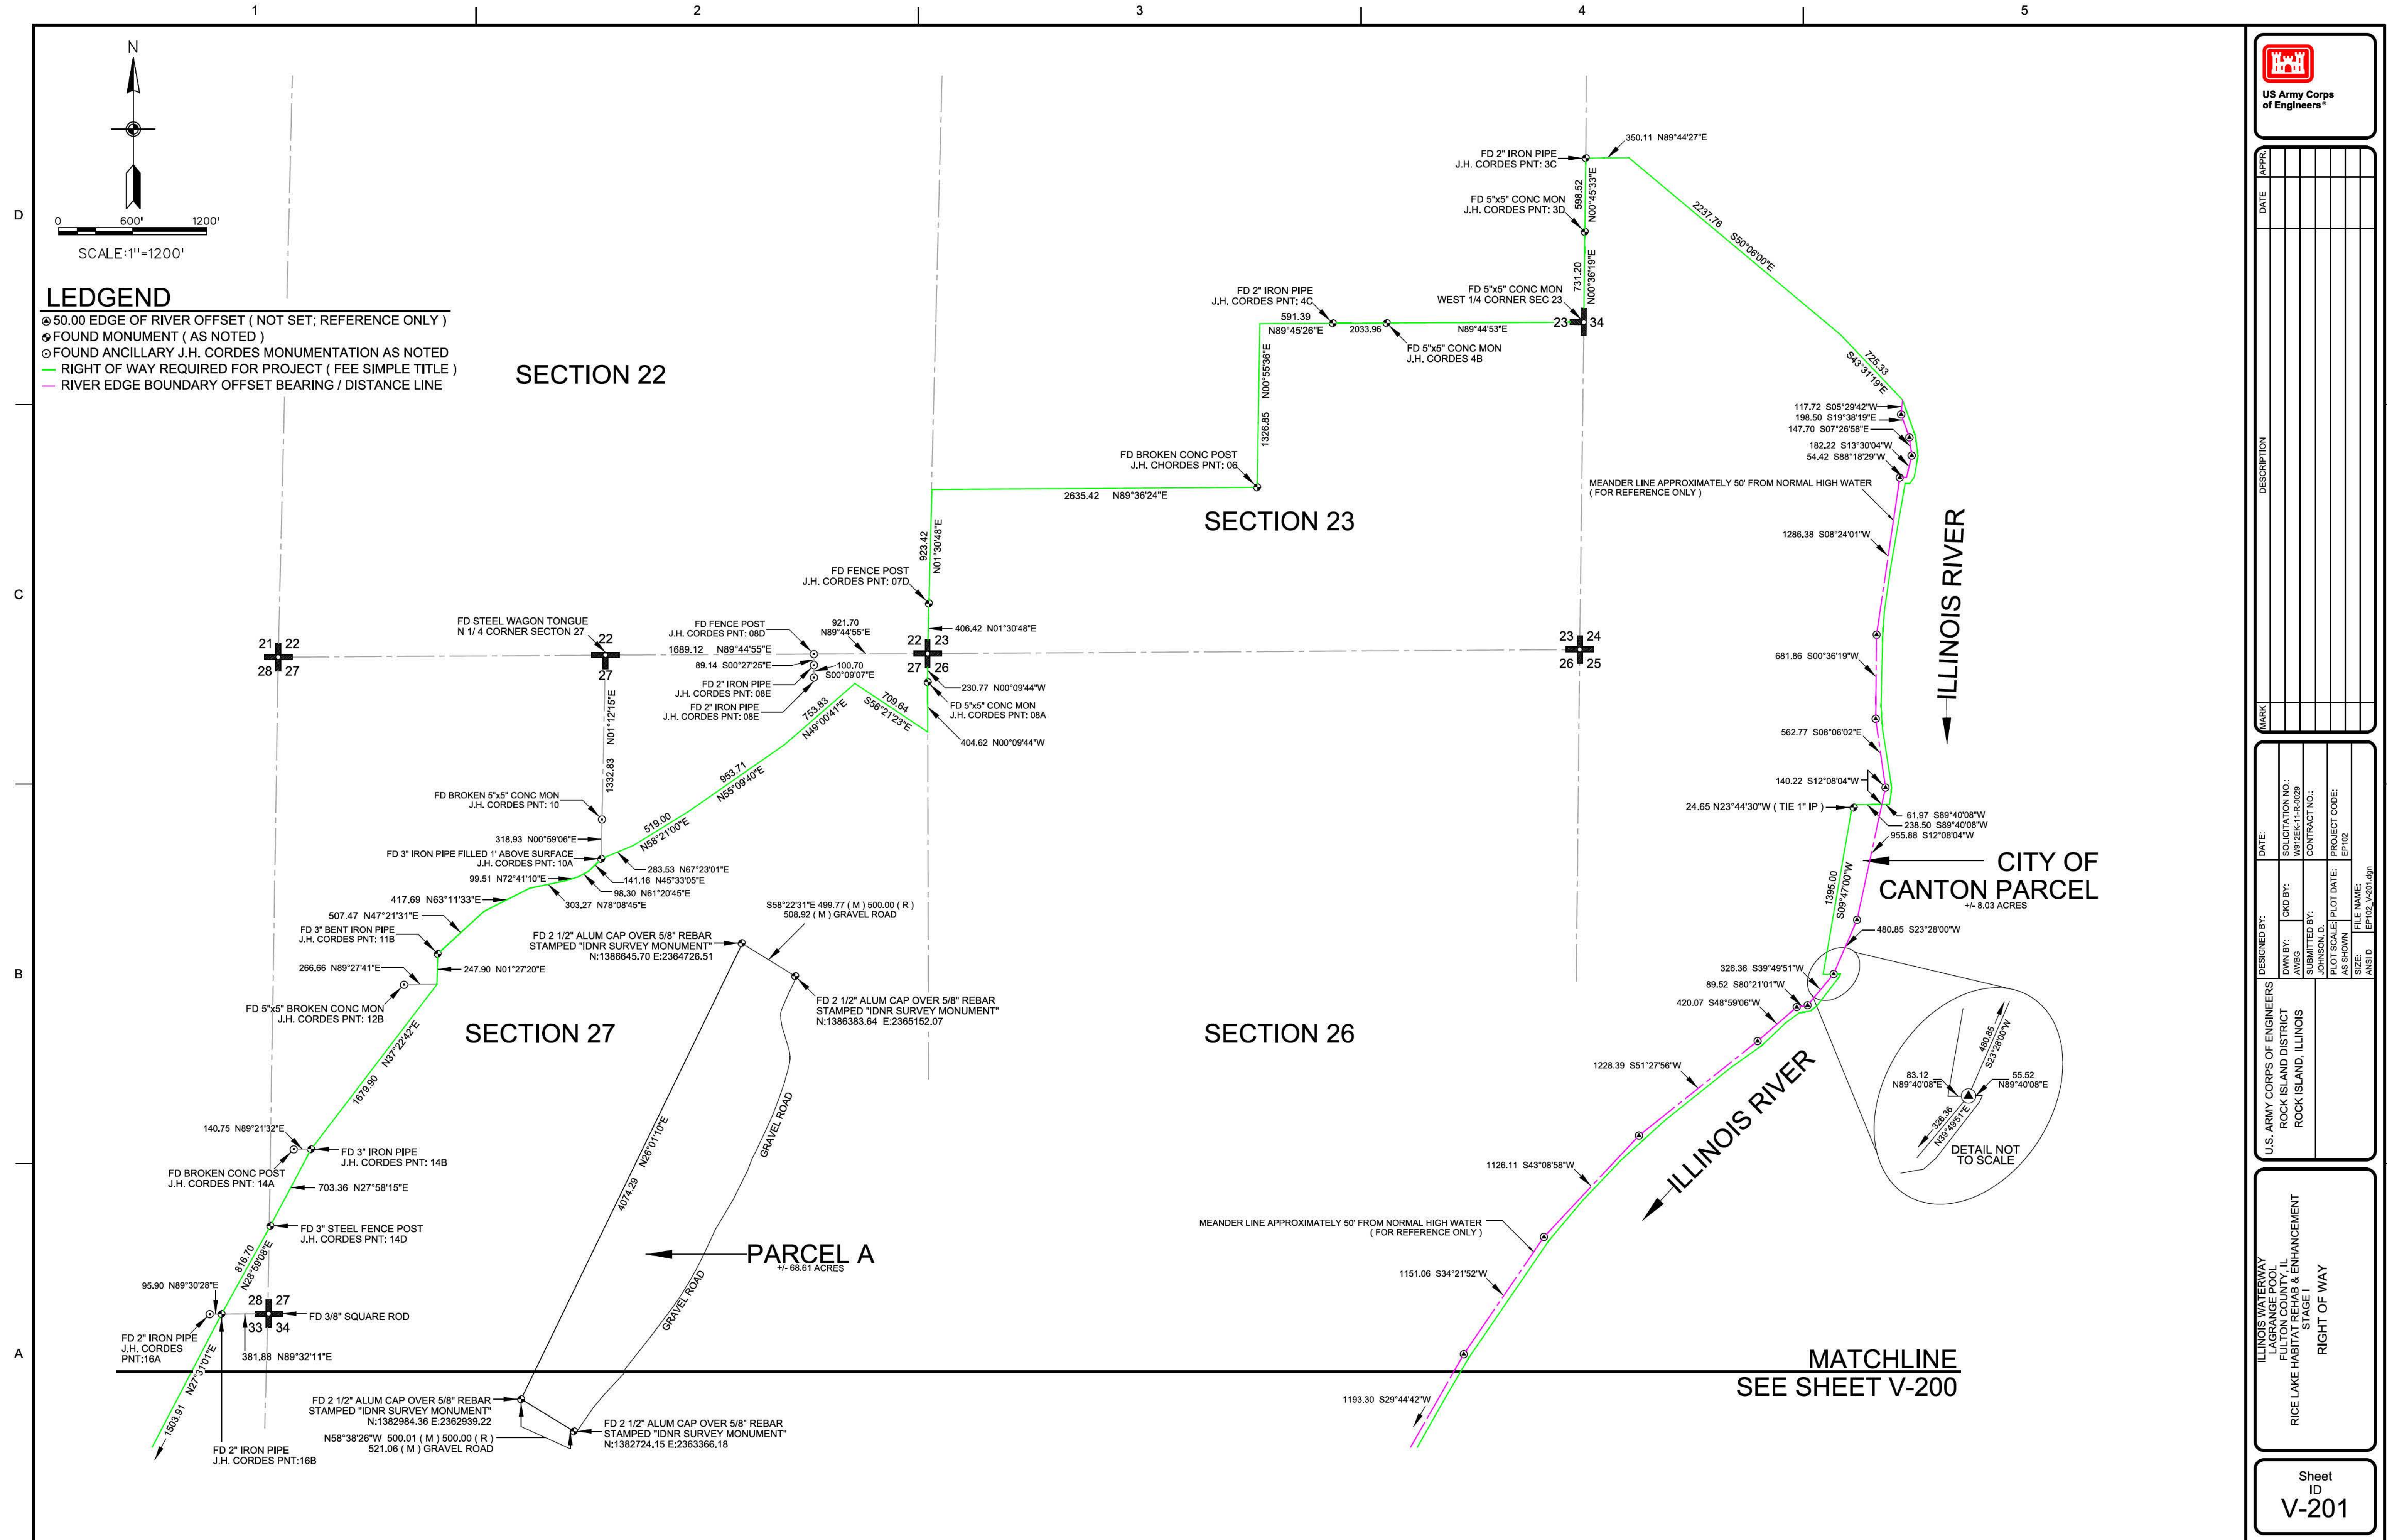



**OPERATION AND MAINTENANCE MANUAL**

**RICE LAKE STATE FISH AND WILDLIFE AREA**  
**UPPER MISSISSIPPI RIVER RESTORATION**  
**HABITAT REHABILITATION AND ENHANCEMENT PROJECT**  
**FULTON COUNTY, ILLINOIS**

**SEPTEMBER 2021**

**APPENDIX C**

**PROJECT REFERENCES AND REGULATIONS**



## **APPENDIX C**

### **PROJECT REFERENCES AND REGULATIONS**

#### **TABLE OF CONTENTS**

1. Engineering Regulation 500-1-1, Natural Disaster Procedures .....	C-1
2. Engineering Pamphlet 500-1-1, Civil Emergency Management Program Procedure .....	C-1
3. 33 USC 408 SECTION 408.....	C-1
4. Definite Project Report.....	C-1
5. Section 107, Water Resources Development Act of 1992 .....	C-1

**1. Engineering Regulation (ER) 500-1-1, Natural Disaster Procedures.** US Army Corps of Engineers, CECW-OE, 30 September 2001. This regulation prescribes policies for the Civil Emergency Management Program of the US Army Corps of Engineers under the authorities of the Robert T. Stafford Disaster Relief and Emergency Assistance Act (The Stafford Act; 42 U.S.C. 5121 et seq.); Army Regulation 500-60, Disaster Relief; and Engineer Regulation 1130-2-530, Flood Control Operation and Maintenance Policies. ER 500-1-1 can be found online at the following address:

[http://www.publications.usace.army.mil/Portals/76/Publications/EngineerRegulations/ER\\_500-1-1.pdf?ver=2013-09-08-233252-360](http://www.publications.usace.army.mil/Portals/76/Publications/EngineerRegulations/ER_500-1-1.pdf?ver=2013-09-08-233252-360)

**2. Engineering Pamphlet (EP) 500-1-1, Civil Emergency Management Program Procedure.** US Army Corps of Engineers, CECW-OE, 30 September 2001. This pamphlet prescribes processes and procedures for the management and execution of the Civil Emergency Management Program of the US Army Corps of Engineers under the authorities of the Robert T. Stafford Disaster Relief and Emergency Assistance Act (The Stafford Act; 42 U.S.C. 5121 et seq.); Army Regulation 500-60, Disaster Relief; Engineer Regulation 1130-2-530, Flood Control Operations and Maintenance Policies; and Engineering Regulation 500-1-1, Natural Disaster Procedures. This pamphlet is a companion document to, and must be used in conjunction with, ER 500-1-1. In case of a discrepancy between this pamphlet and ER 500-1-1, ER 500-1-1 governs. EP 500-1-1 can be found online at the following address:

[http://www.publications.usace.army.mil/Portals/76/Publications/EngineerPamphlets/EP\\_500-1-1.pdf](http://www.publications.usace.army.mil/Portals/76/Publications/EngineerPamphlets/EP_500-1-1.pdf)

**3. 33 USC 408 Section 408.** *March 3, 1899.* It shall not be lawful for any person or persons to take possession of or make use of for any purpose, or build upon, alter, deface, destroy, move, injure, obstruct by fastening vessels thereto or otherwise, or in any manner whatever impair the usefulness of any sea wall, bulkhead, jetty, dike, levee, wharf, pier, or other work built by the United States, or any piece of plant, floating or otherwise, used in the construction of such work under the control of the United States, in whole or in part, for the preservation and improvement of any of its navigable waters or to prevent floods, or as boundary marks, tide gauges, surveying stations, buoys, or other established marks, nor remove for ballast or other purposes any stone or other material composing such works: Provided, That the Secretary of the Army may, on the recommendation of the Chief of Engineers, grant permission for the temporary occupation or use of any of the aforementioned public works when in his judgment such occupation or use will not be injurious to the public interest: Provided further, That the Secretary may, on the recommendation of the Chief of Engineers, grant permission for the alteration or permanent occupation or use of any of the aforementioned public works when in the judgment of the Secretary such occupation or use will not be injurious to the public interest and will not impair the usefulness of such work.

**4. Definite Project Report.** *Upper Mississippi River System Environmental Management Program, Definite Project Report with Integrated Environmental Assessment (R-19F), Pool 12 Overwintering Habitat Rehabilitation and Enhancement, U.S. Army Corps of Engineers, Rock Island District, March 2013.* The DPR can be accessed through the UMRR database at the followings links:

DPR Main Report: [http://mvr-ap06roc.mvr.ds.usace.army.mil/pls/apex/UMRRDB.get\\_project\\_doc?p\\_project\\_doc\\_id=465](http://mvr-ap06roc.mvr.ds.usace.army.mil/pls/apex/UMRRDB.get_project_doc?p_project_doc_id=465)

DPR Plates: [http://mvr-ap06roc.mvr.ds.usace.army.mil/pls/apex/UMRRDB.get\\_project\\_doc?p\\_project\\_doc\\_id=697](http://mvr-ap06roc.mvr.ds.usace.army.mil/pls/apex/UMRRDB.get_project_doc?p_project_doc_id=697)

**5. Water Resources Development Act of 1992, Section 107, Upper Mississippi River Plan.**

(a) EXTENSION OF AUTHORIZATION- Section 1103(e) of the Water Resources Development Act of 1986 (33 U.S.C. 652(e)) is amended—

- (1) in paragraph (2) by striking “ten” each place it appears and inserting “15”;
- (2) by redesignating paragraphs (6) and (7) as paragraphs (7) and (8), respectively; and
- (3) by inserting after paragraph (5) the following new paragraph:

“(6) TRANSFER OF AMOUNTS-

“(A) GENERAL RULE- Subject to subparagraph (B), for each fiscal year beginning after September 30, 1992, the Secretary, in consultation with the Secretary of the Interior, and the States of Illinois, Iowa, Minnesota, Missouri, and Wisconsin, may transfer not to exceed 20 percent of the amount appropriated to carry out each of subparagraphs (A), (B), and (C) of paragraph (1) to carry out any other of such subparagraphs.

“(B) LIMITATION- The aggregate amounts obligated in fiscal years 1988 through 2002--

“(i) to carry out paragraph (1)(A) may not exceed \$189,600,000;

“(ii) to carry out paragraph (1)(B) may not exceed \$78,800,000; and

“(iii) to carry out paragraph (1)(C) may not exceed \$12,040,000.”.

(b) FISH AND WILDLIFE HABITAT REHABILITATION AND ENHANCEMENT PROJECTS-

Section 1103(e) of such Act is amended by striking paragraph (7)(A), as redesignated by subsection (a)(2), and inserting the following new paragraph:

“(7)(A) Notwithstanding the provisions of subsection (a)(2) of this section, the costs of each project carried out pursuant to paragraph (1)(A) of this subsection shall be allocated between the Secretary and the appropriate non-Federal sponsor in accordance with the provisions of section 906(e) of this Act; except that the costs of operation and maintenance of projects located on Federal lands or lands owned or operated by a State or local government shall be borne by the Federal, State, or local agency that is responsible for management activities for fish and wildlife on such lands.”.



**OPERATION AND MAINTENANCE MANUAL**  
**RICE LAKE STATE FISH AND WILDLIFE AREA**  
**UPPER MISSISSIPPI RIVER RESTORATION**  
**HABITAT REHABILITATION AND ENHANCEMENT PROJECT**  
**FULTON COUNTY, ILLINOIS**

**SEPTEMBER 2021**

**APPENDIX D**

**SITE MANAGER'S PROJECT INSPECTION AND MONITORING RESULTS**

## SITE MANAGER'S PROJECT INSPECTION AND MONITORING RESULTS

Inspected By: \_\_\_\_\_ Date: \_\_\_\_\_

Type of Inspection:     ( ) annual            ( ) emergency-disaster            ( ) other

River EL: \_\_\_\_\_ Interior EL: \_\_\_\_\_

RATING SCALE: **A**-ACCEPTABLE            **M**-MINIMALLY ACCEPTABLE            **U**-UNACCEPTABLE

### 1. PROJECT INSPECTION

<u>Item</u>	<u>Condition</u>	<u>Rating</u>
<u>Overflow &amp; Natural Spillway</u>		
( ) Settlement, slough or loss of section	_____	_____
( ) Wavewash, scouring	_____	_____
( ) Overtopping erosion	_____	_____
( ) Sufficient vegetative cover	_____	_____
( ) Unauthorized grazing or traffic	_____	_____
( ) Encroachments	_____	_____
( ) Unfavorable tree/shrub growth	_____	_____
( ) Seepage distress	_____	_____
<u>Spillway Access Road</u>		
( ) Displaced granular surfacing	_____	_____
( ) Ruts	_____	_____
<u>Outlet Structure</u>		
( ) Slide gate/stop log condition	_____	_____
( ) Unfavorable tree/shrub growth	_____	_____
( ) Displaced/missing riprap	_____	_____
( ) Blocked inlets/outlets	_____	_____
( ) Debris/trash accumulation	_____	_____
( ) Erosion adjacent to structure	_____	_____
<u>Pump Station</u>		
( ) Structure-steel condition	_____	_____
( ) Structure-concrete condition	_____	_____
( ) Displaced/missing riprap	_____	_____
( ) Sump sedimentation	_____	_____
( ) Submersible pumps operation	_____	_____
( ) Submersible pumps maintenance	_____	_____
( ) Vent/butterfly valves condition	_____	_____
( ) Electrical conduits/connections	_____	_____
( ) Bulkhead storage	_____	_____
( ) Trash rack debris accumulation	_____	_____

Pump Station Control Building

( ) Structure-steel condition	_____	_____
( ) Structure-concrete condition	_____	_____
( ) Electrical lighting condition	_____	_____
( ) Pump control system	_____	_____
( ) Ventilation-exhaust fan/louver	_____	_____
( ) Heaters-wall unit/MCC enclosures	_____	_____

Discharge Structure

( ) Unfavorable tree/shrub growth	_____	_____
( ) Displaced/missing riprap	_____	_____
( ) Blocked culvert outlet	_____	_____
( ) Debris/trash accumulation	_____	_____
( ) Erosion adjacent to structure	_____	_____

Discharge Channel

( ) Significant sedimentation	_____	_____
( ) Undesirable Debris	_____	_____

Discharge Channel Berms

( ) Settlement, slough or loss of section	_____	_____
( ) Wavewash, scouring	_____	_____
( ) Overtopping erosion	_____	_____
( ) Sufficient vegetative cover	_____	_____
( ) Unauthorized grazing or traffic	_____	_____
( ) Encroachments	_____	_____
( ) Unfavorable tree/shrub growth	_____	_____
( ) Seepage distress	_____	_____

Water Control Structures

( ) Stoplog condition	_____	_____
( ) Blocked inlets/outlets	_____	_____
( ) Debris/trash accumulation	_____	_____
( ) Erosion adjacent to structure	_____	_____

**2. COMMENTS**

\_\_\_\_\_  
Site Manager